

INDEX TO DRAWINGS	
SHEET NO.	DESCRIPTION
1	TITLE SHEET
2	STANDARD PLANS SUMMARY
3	GENERAL NOTES AND LEGEND
4 - 5	WATER POLLUTION AND EROSION CONTROL NOTES
6	TYPICAL SECTIONS AND DETAILS
7	DRAINAGE PLANS AND DETAILS
8 - 11	ROADWAY PLANS
12	PAVEMENT MARKING LEGEND, DETAILS, NOTES AND SIGN PANEL LAYOUT
13 - 16	SIGNING AND PAVEMENT MARKING PLANS
17 - 21	GUARDRAIL DETAILS AND NOTES

STATE OF HAWAII

DEPARTMENT OF TRANSPORTATION

HIGHWAYS DIVISION

HONOLULU, HAWAII

"AS-BUILT"

PLANS FOR

HANA HIGHWAY RESURFACING




KAHALAOWAKA BRIDGE TO OILOWAI BRIDGE

PROJECT NO. 360B-01-09M

DISTRICT OF HANA

ISLAND OF MAUI

FED. ROAD DIST. NO.	STATE	PROJ. NO.	FISCAL YEAR	SHEET NO.	TOTAL SHEETS
HAWAII	HAW.	360B-01-09M	2008	1	21

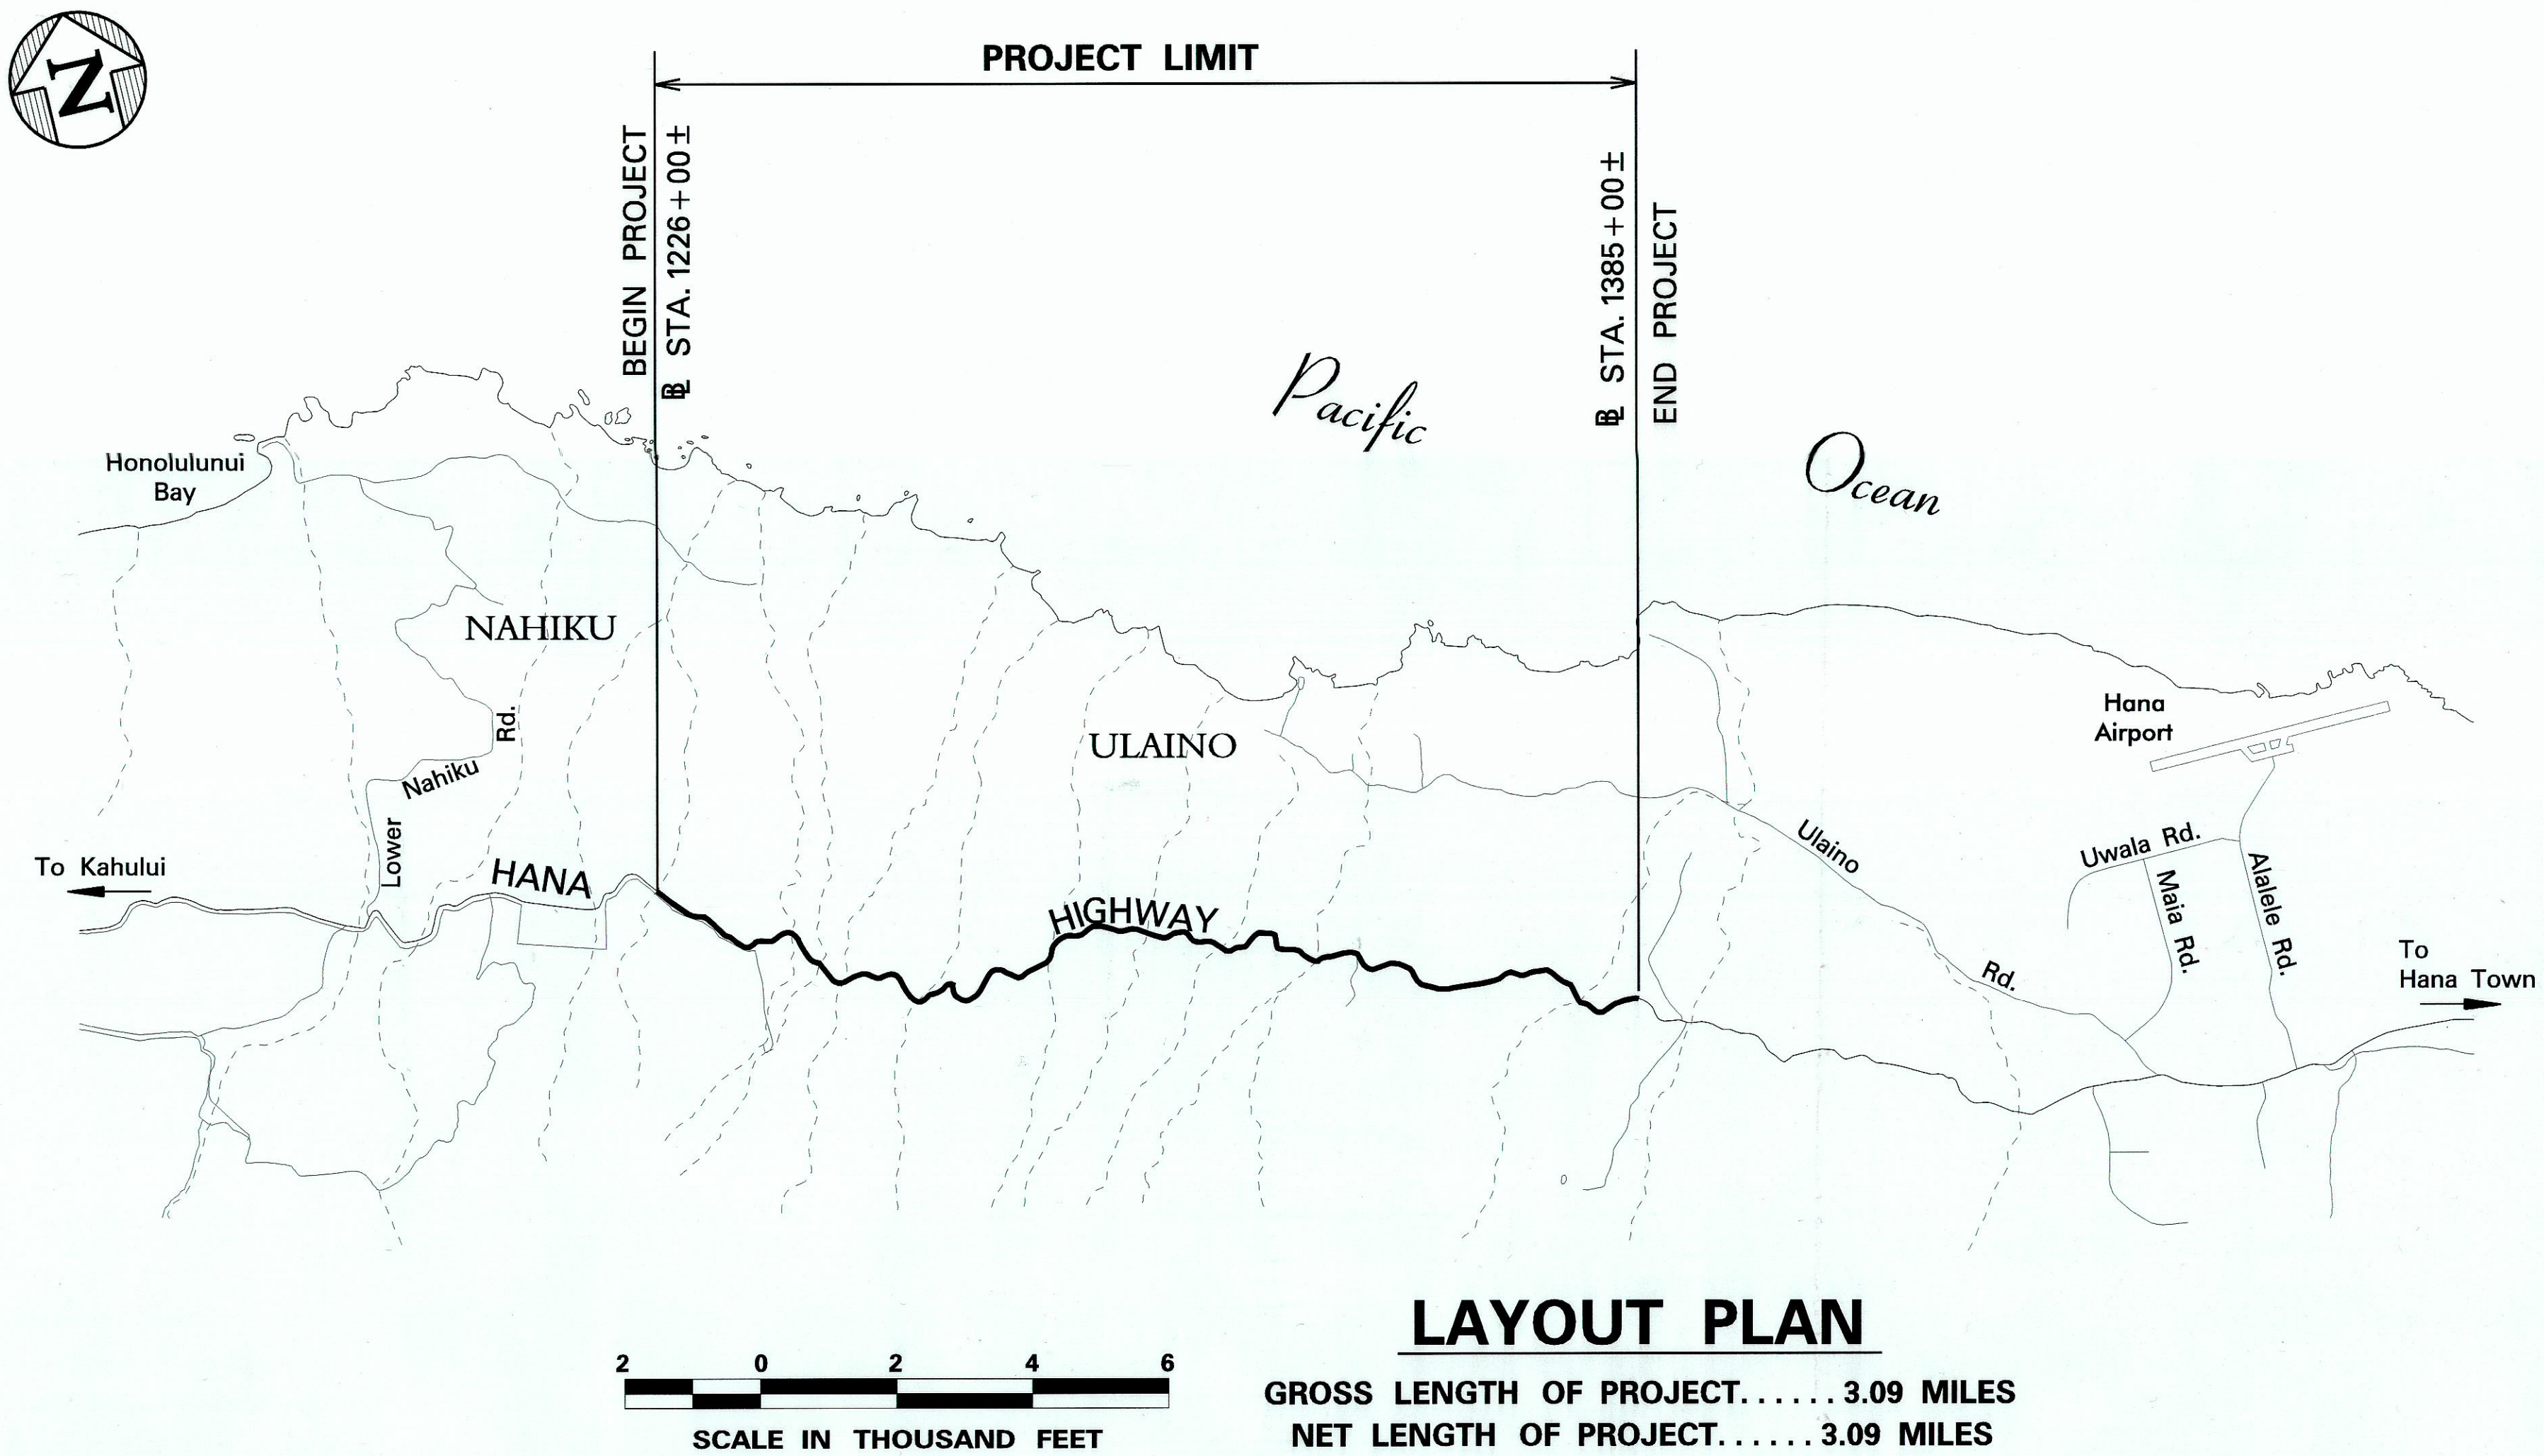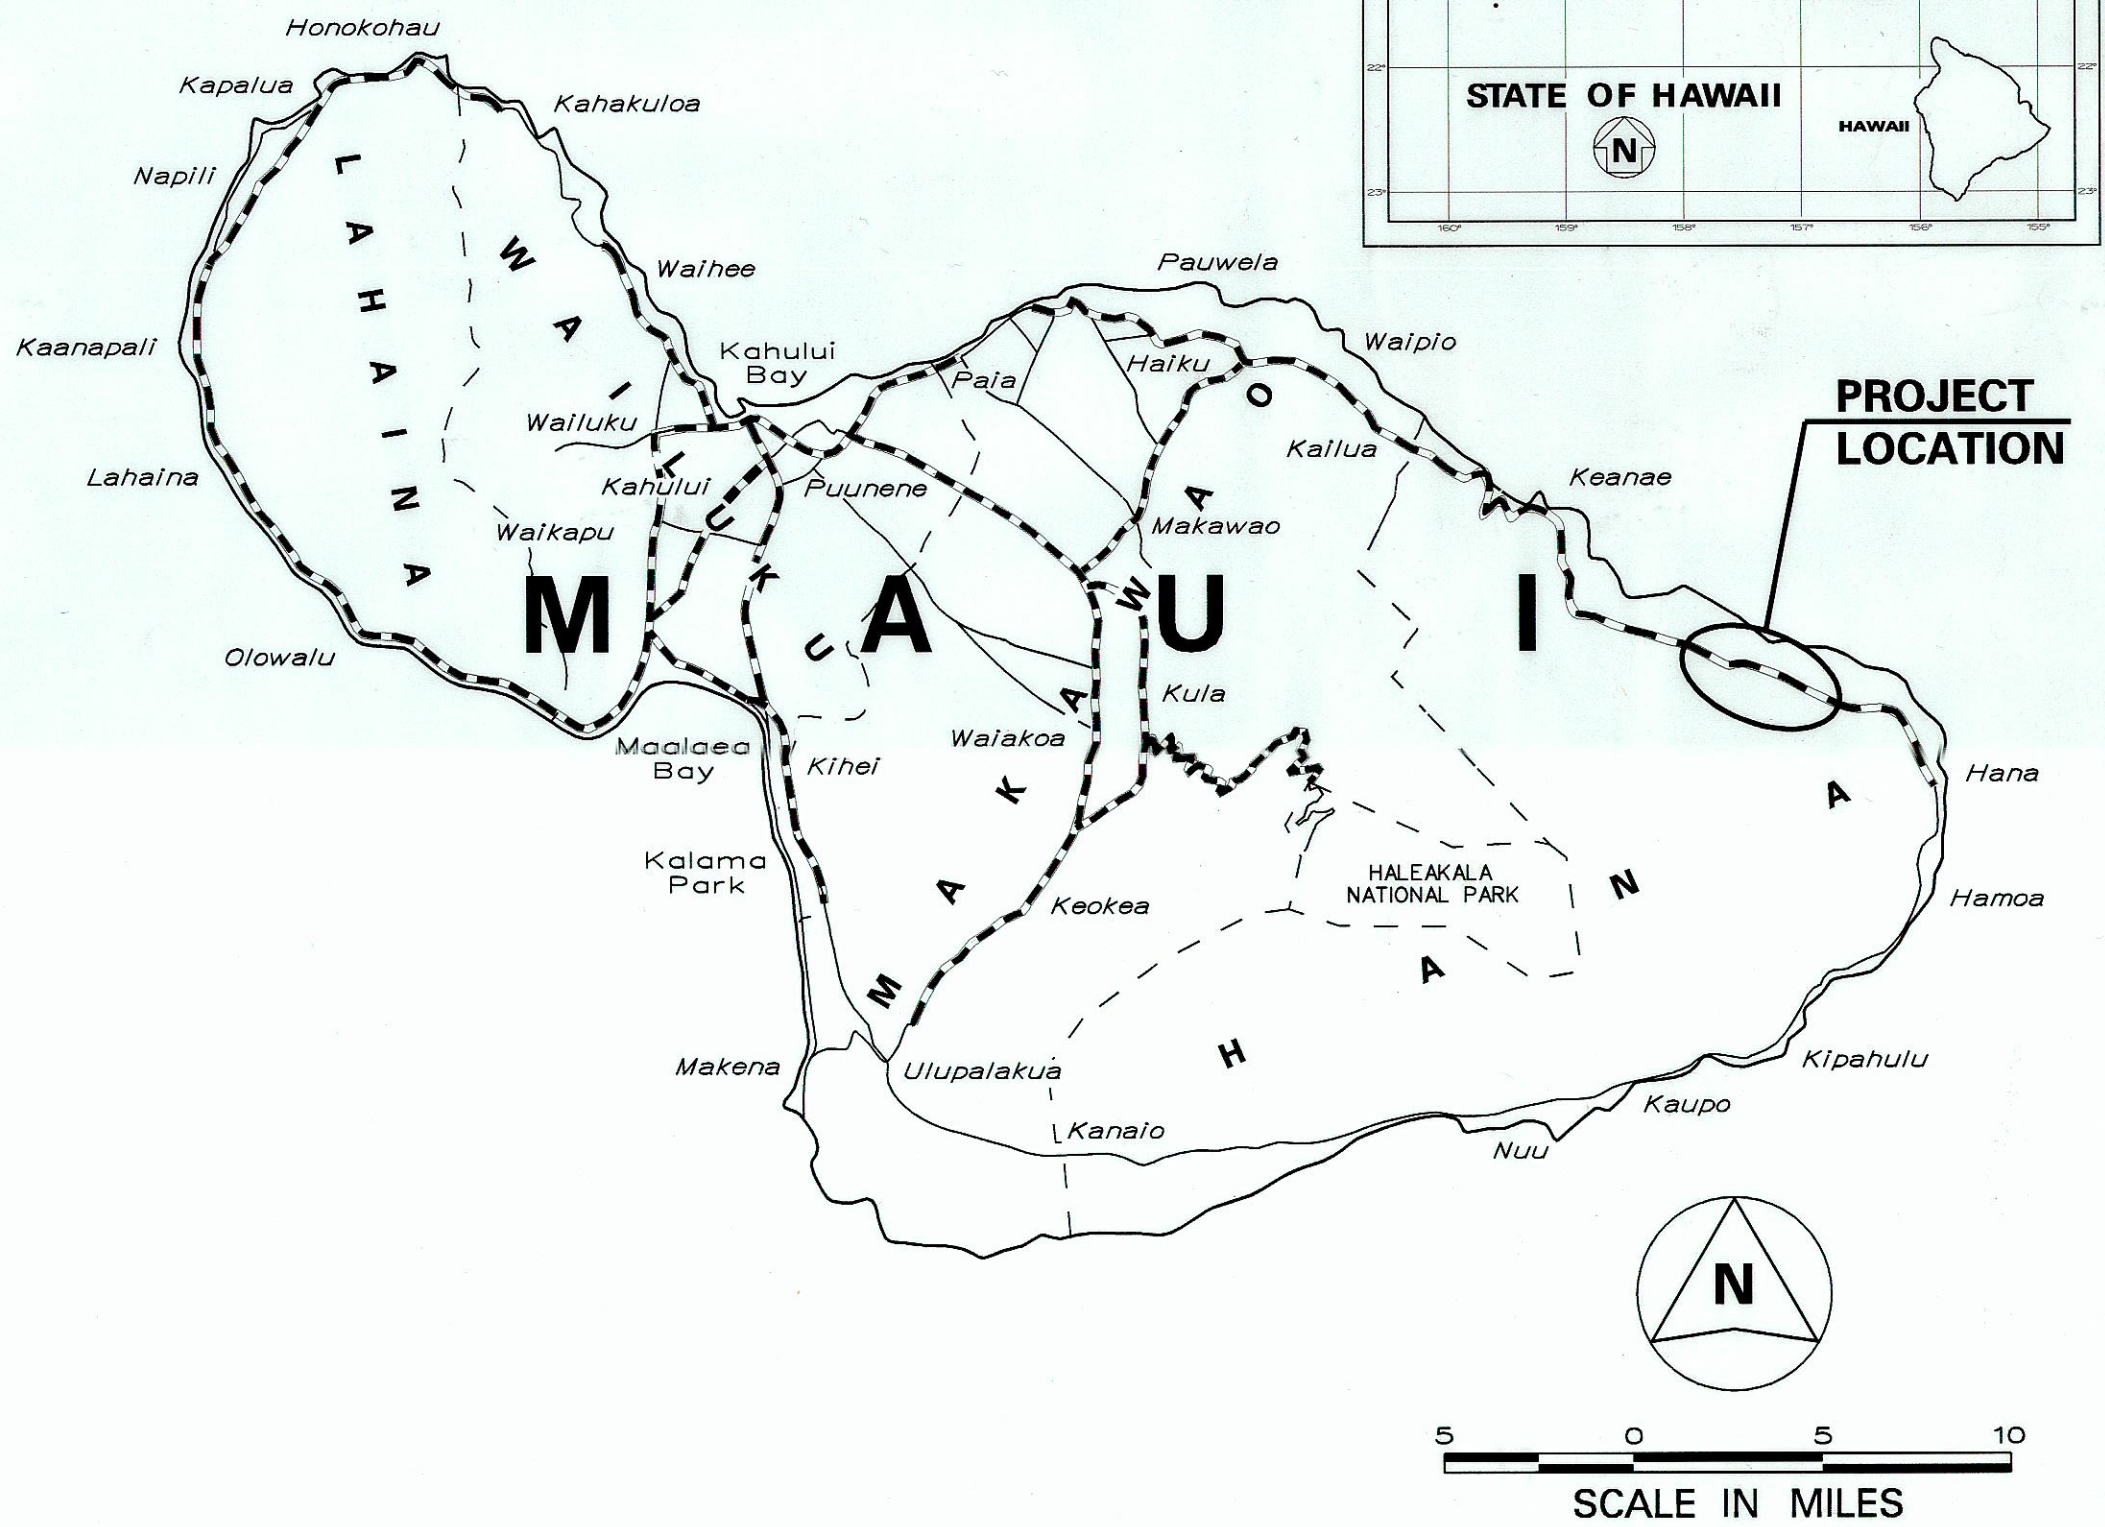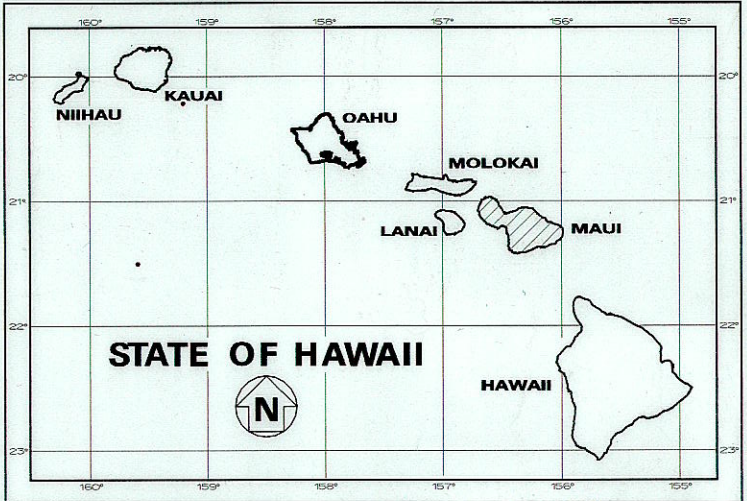

----- FEDERAL AID PROJECTS PREVIOUSLY CONSTRUCTED OR UNDER CONSTRUCTION

MILE POST 25.95 TO MILE POST 29.04

CHANGES MADE DURING CONSTRUCTION HAVE BEEN INCORPORATED ON THESE PLANS EXCEPT CHANGES IN THE ORIGINAL THEORETICAL QUANTITIES. FOR ACTUAL QUANTITIES, REFER TO PROJECT LEDGER AND/OR COMPUTATION BOOK.

[Signature] 9/13/13
RESIDENT ENGINEER DATE

DEPARTMENT OF TRANSPORTATION STATE OF HAWAII	
APPROVED:	
<i>[Signature]</i> DIR. OF TRANSPORTATION	3-5-09 DATE

DESIGNED BY _____
MANAGED BY _____
PHONE _____
DATE _____