


FED. ROAD DIST. NO.	STATE	FED. AID PROJ. NO.	FISCAL YEAR	SHEET NO.	TOTAL SHEETS
HAWAII	HAW.	ARR-0360(10)	2009	7	28

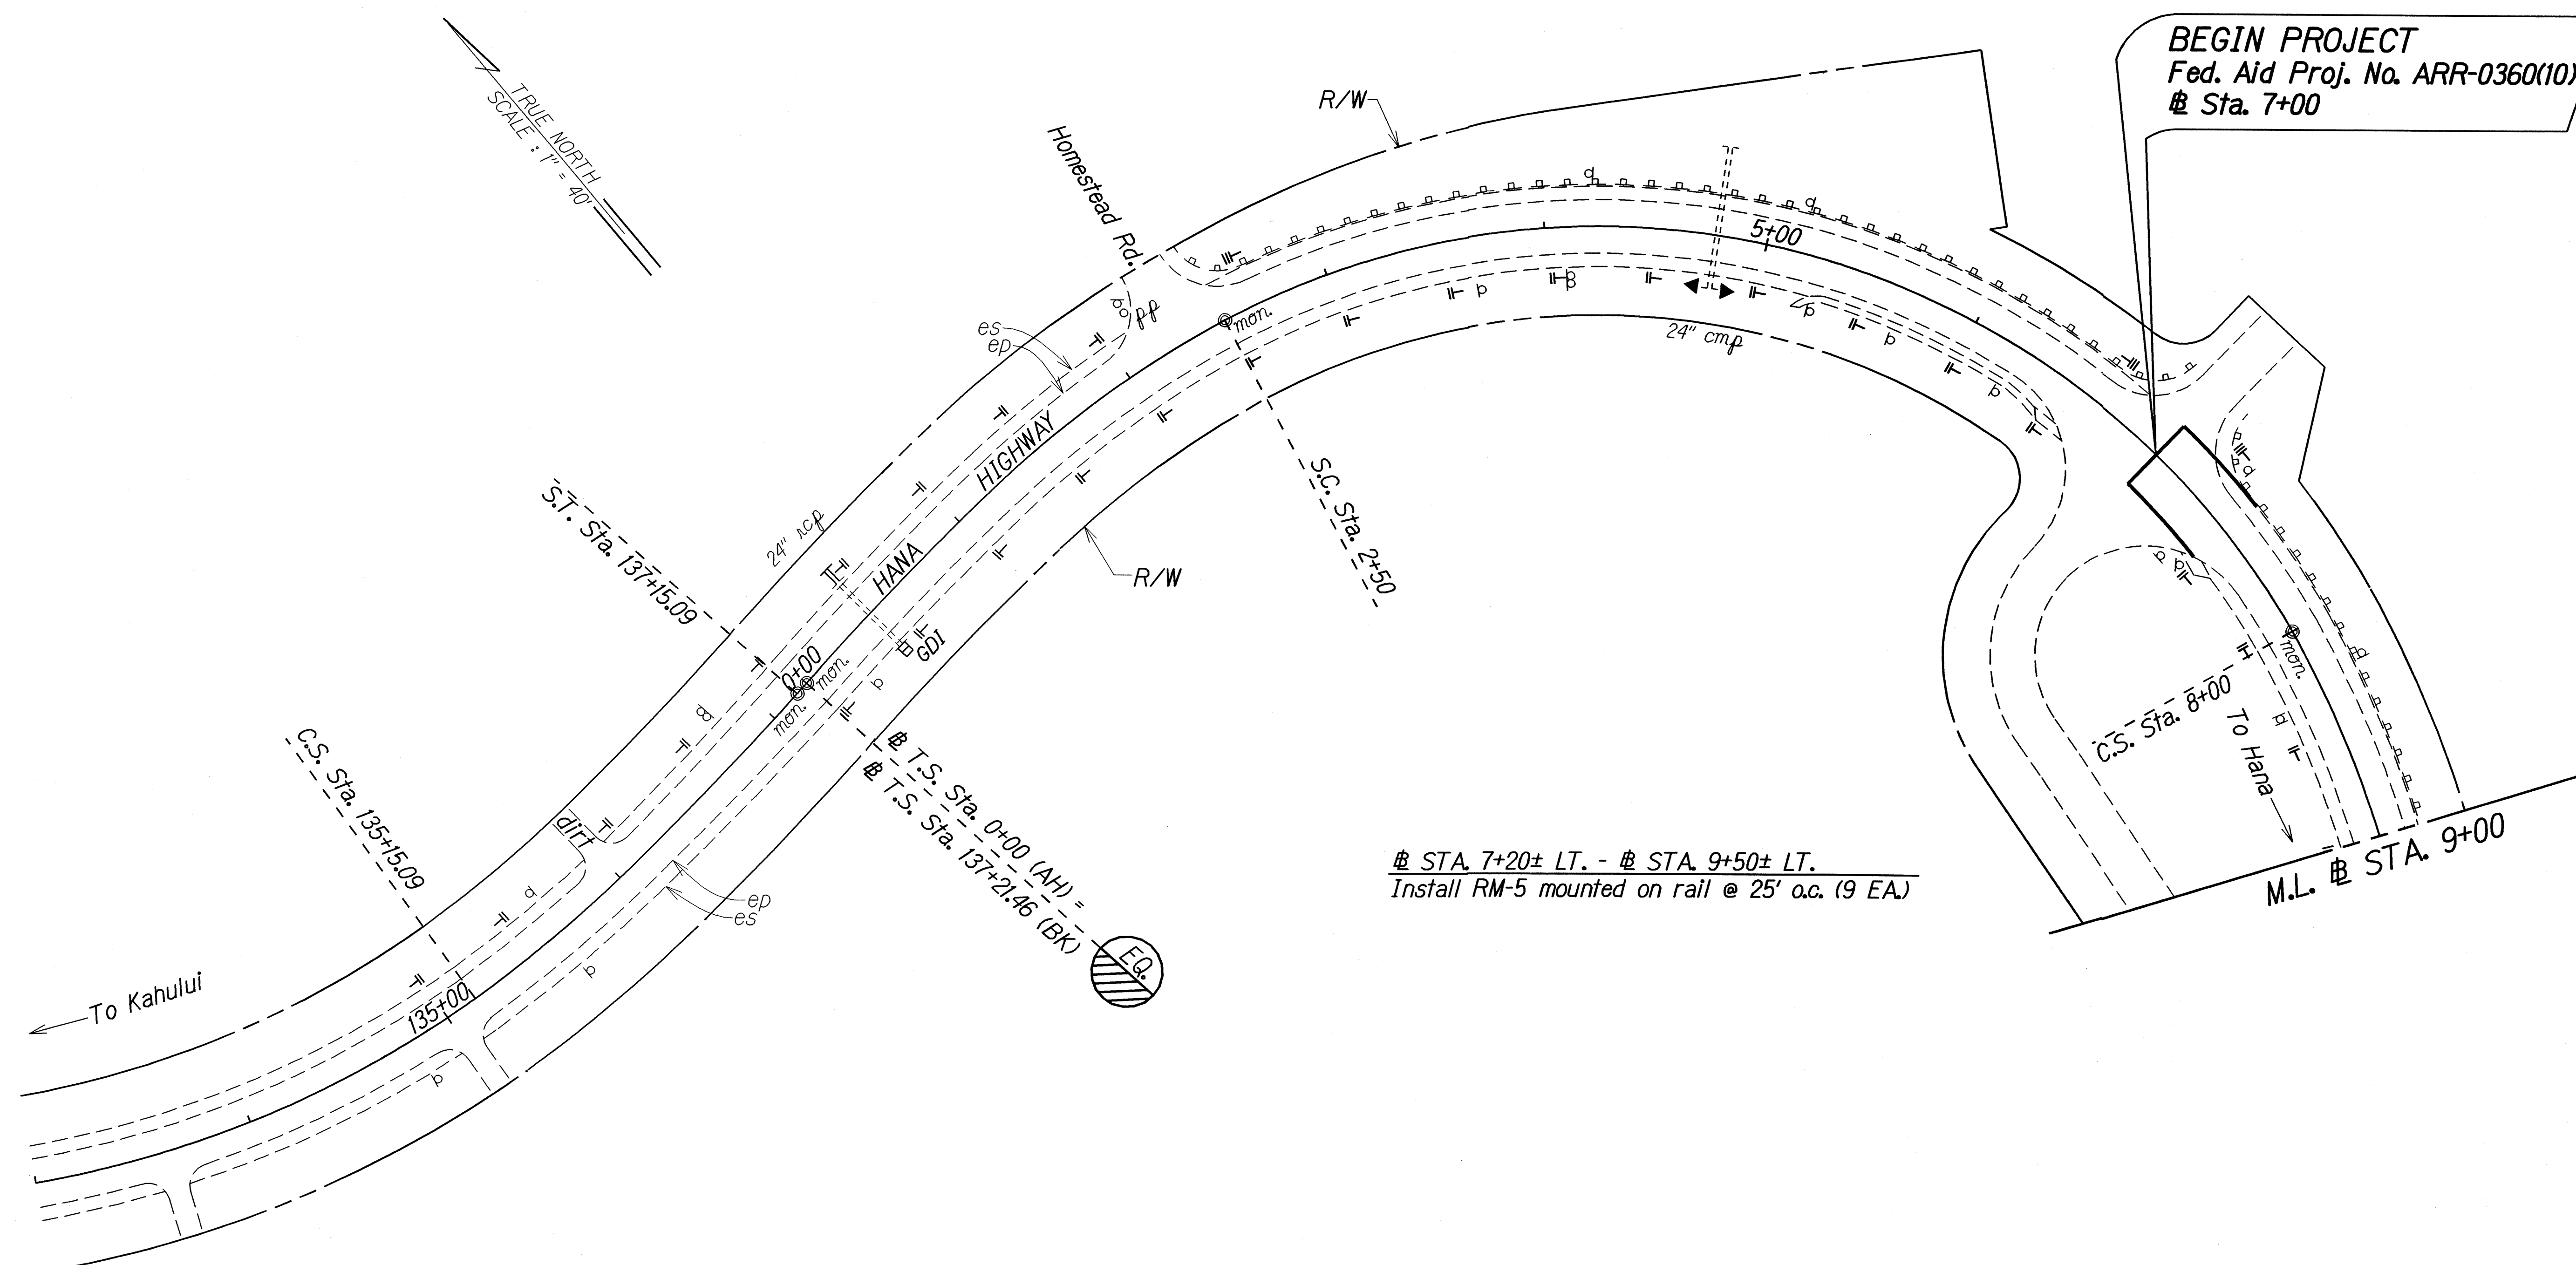

BEGIN PROJECT
 Fed. Aid Proj. No. ARR-0360(10)
 @ Sta. 7+00


@ STA. 7+20± LT. - @ STA. 9+50± LT.
 Install RM-5 mounted on rail @ 25' o.c. (9 EA.)

ORIGINAL PLAN	SURVEY PLOTTED BY	DATE
NOTE BOOK	DRAWN BY	11/08
TRANSFERS BY	TRACED BY	
CHECKED BY	DESIGNED BY	
	CHECKED BY	


STATE OF HAWAII
 DEPARTMENT OF TRANSPORTATION
 HIGHWAYS DIVISION

ROADWAY PLAN
HANA HIGHWAY PAVEMENT
PREVENTIVE MAINTENANCE
 Kaupakalua Road to Huelo
 Federal-Aid Project No. ARR-0360(10)
 Scale: 1" = 40' Date: October, 2008
 SHEET No. 1 OF 10 SHEETS

FED. ROAD DIST. NO.	STATE	FED. AID PROJ. NO.	FISCAL YEAR	SHEET NO.	TOTAL SHEETS
HAWAII	HAW.	ARR-0360(10)	2009	8	28

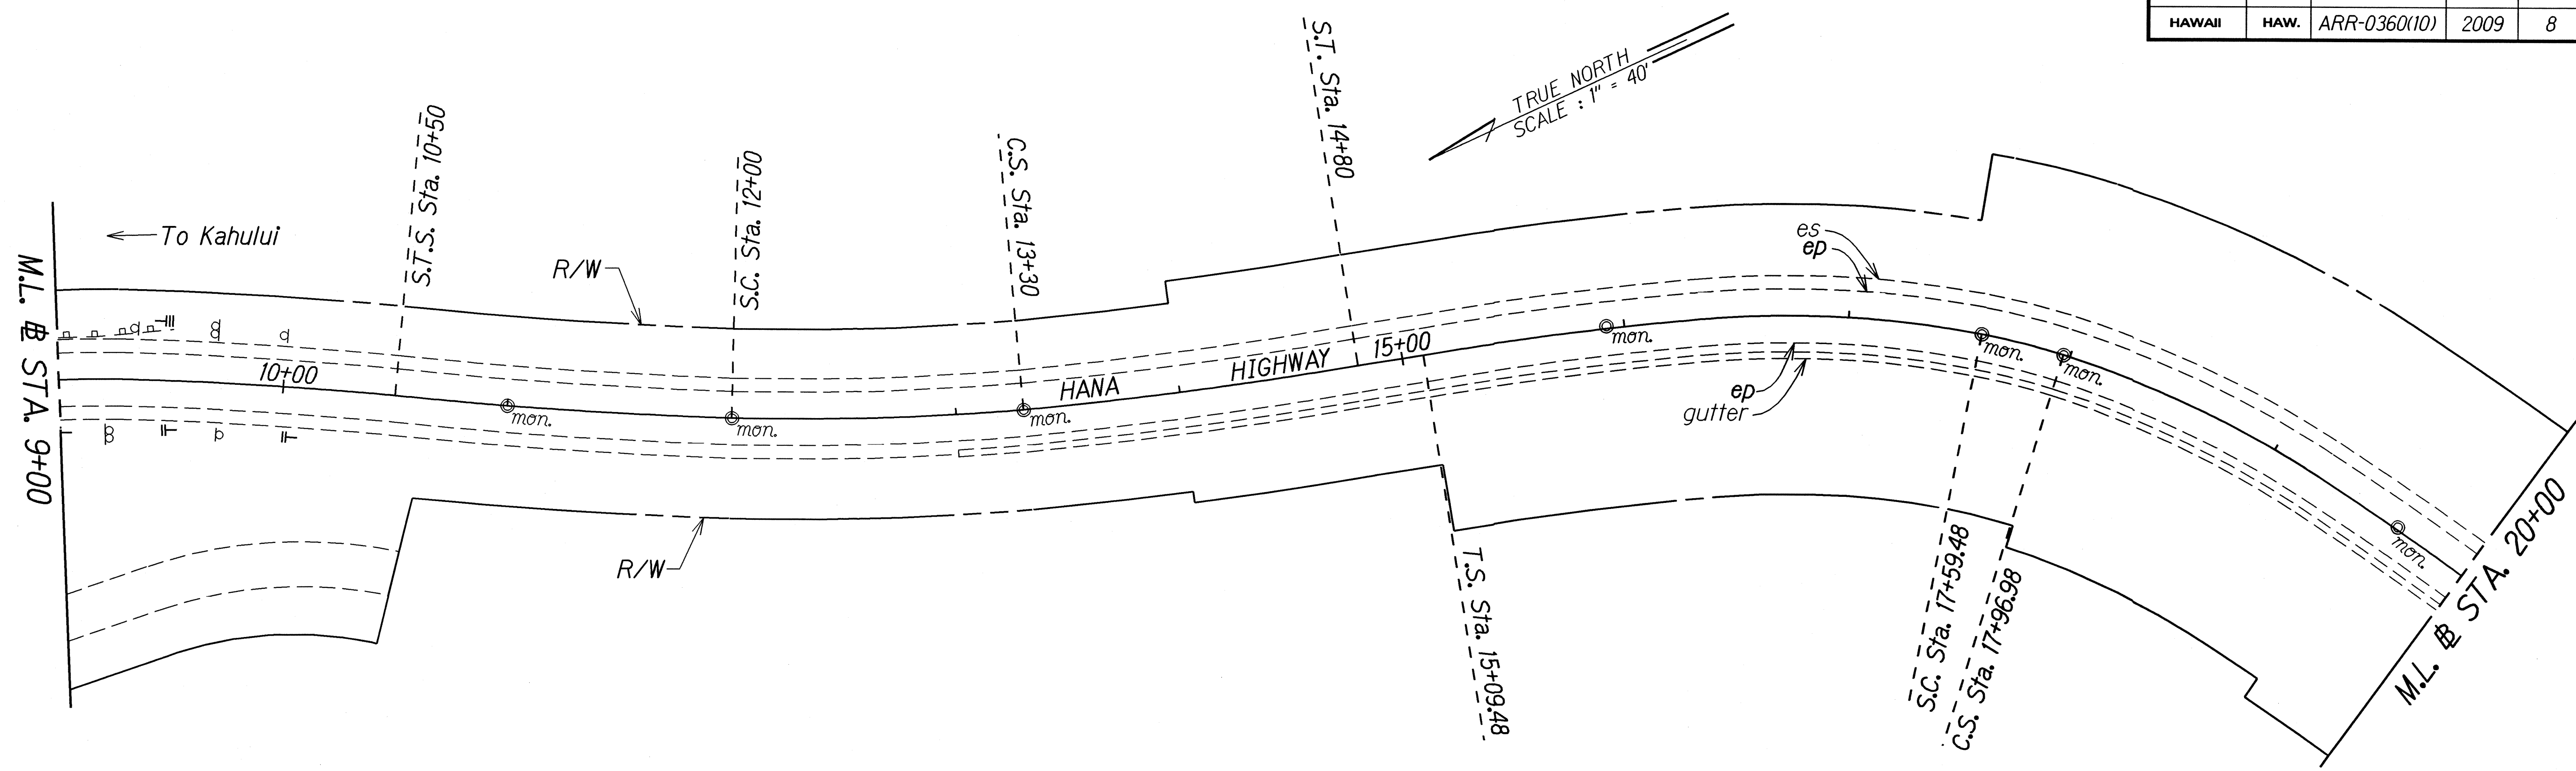

STA. 23+50± LT. - STA. 26+25± LT.
 Install RM-5 mounted on rail @ 25' o.c. (12 EA.)

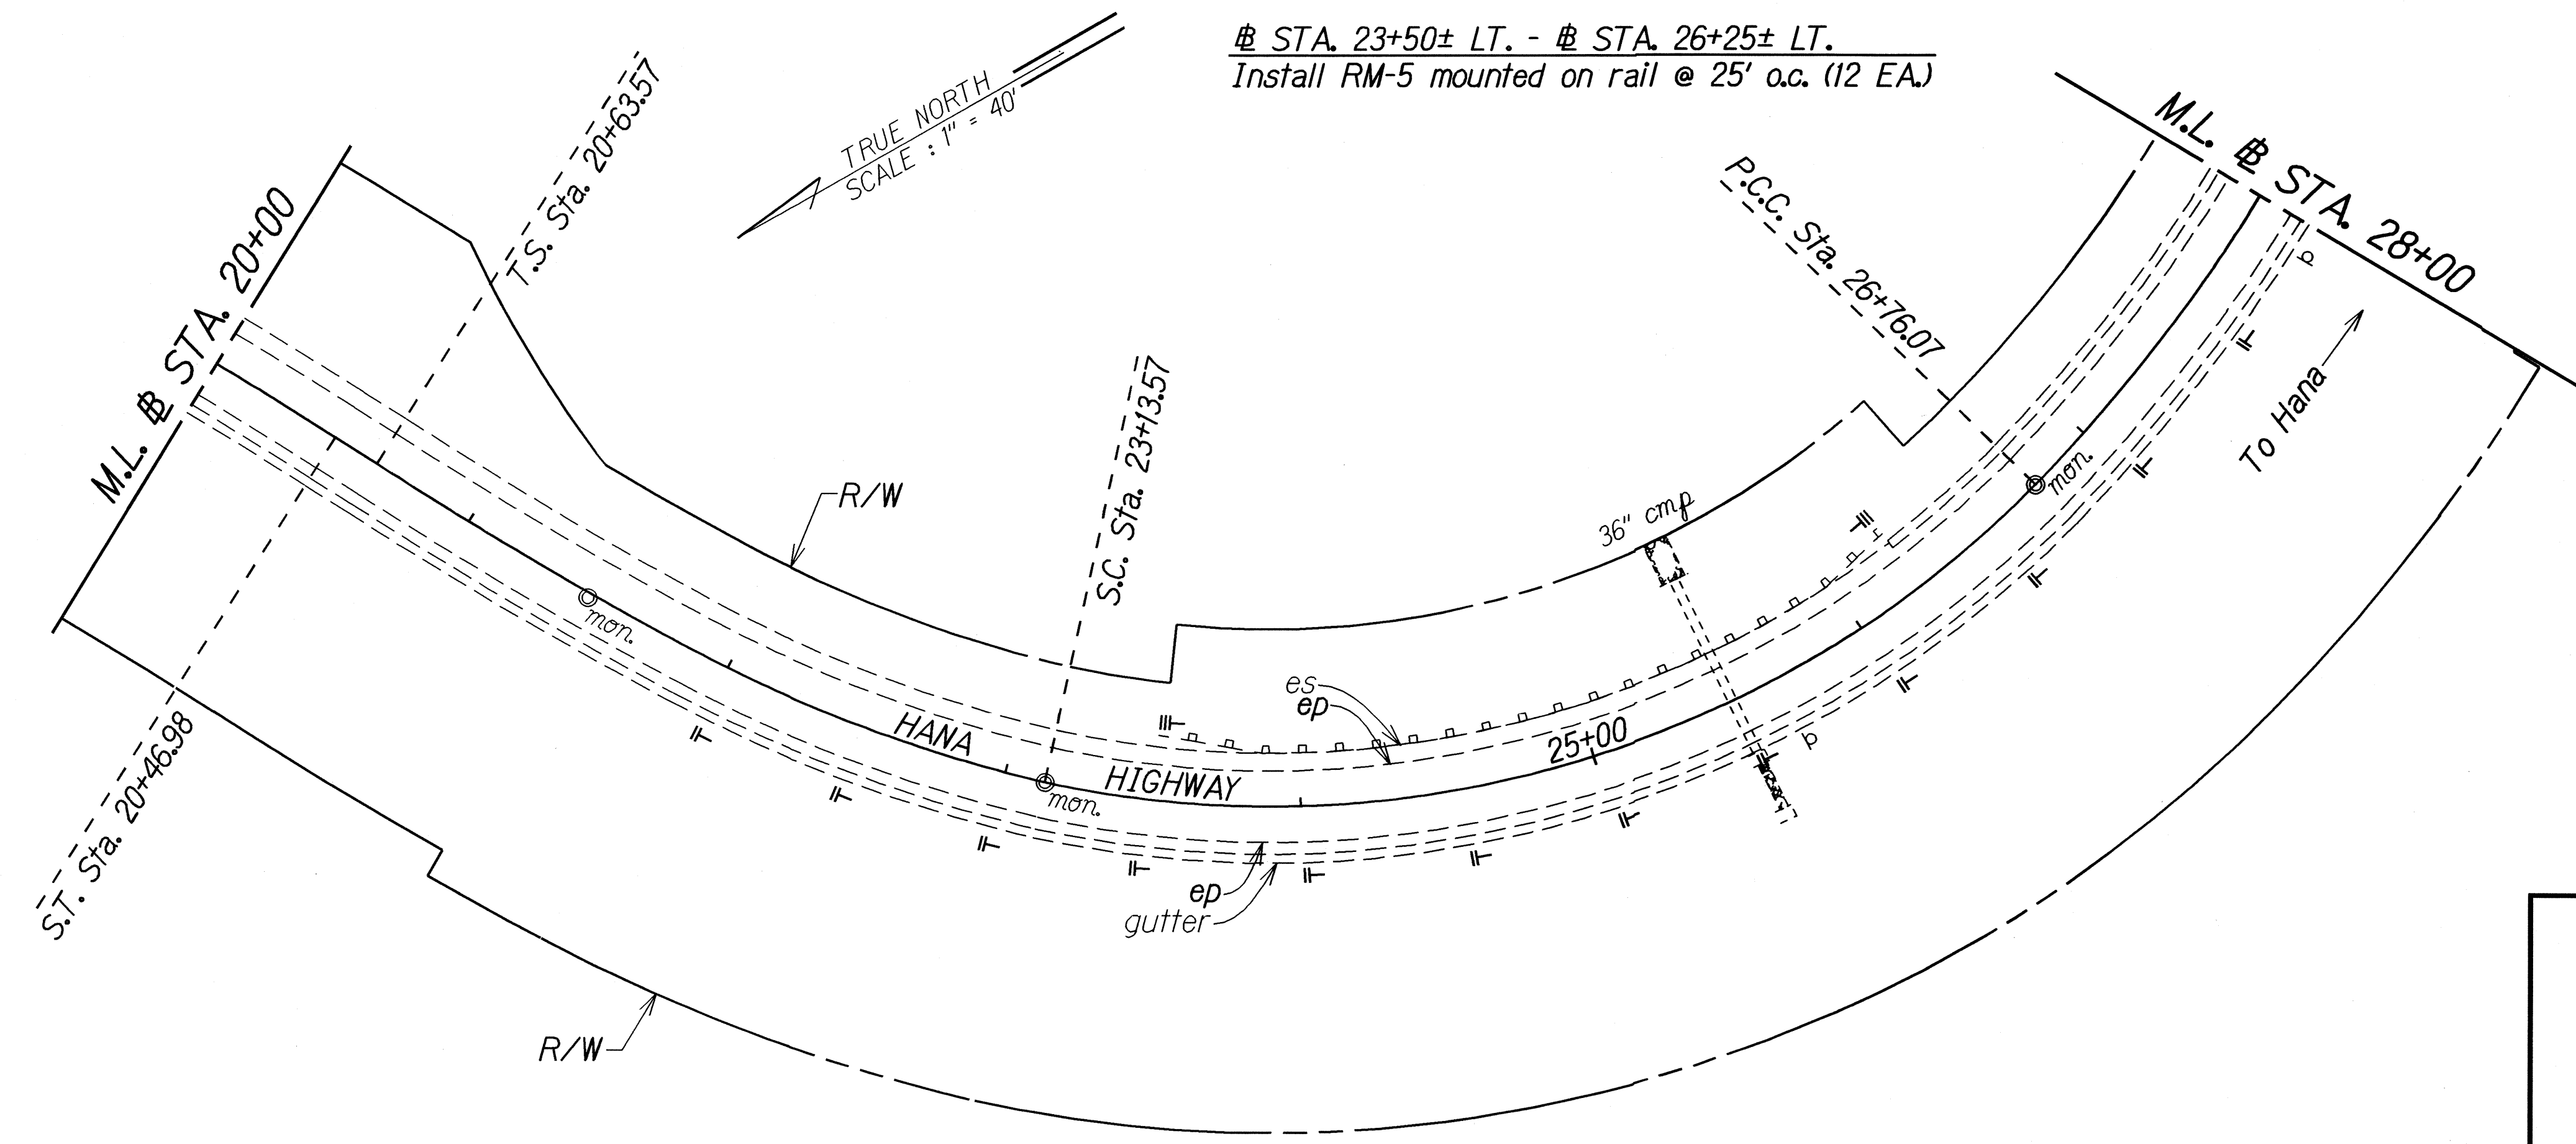

ORIGINAL PLAN	SURVEY PLOTTED BY	DATE
DESIGNED BY	DRAWN BY	11/08
CHECKED BY	NOTED BY	

STATE OF HAWAII
 DEPARTMENT OF TRANSPORTATION
 HIGHWAYS DIVISION

ROADWAY PLAN
 HANA HIGHWAY PAVEMENT
 PREVENTIVE MAINTENANCE
 Kaupakalua Road to Huelo
 Federal-Aid Project No. ARR-0360(10)
 Scale: 1" = 40' Date: October, 2008

SHEET No. 2 OF 10 SHEETS

FED. ROAD DIST. NO.	STATE	FED. AID PROJ. NO.	FISCAL YEAR	SHEET NO.	TOTAL SHEETS
HAWAII	HAW.	ARR-0360(10)	2009	9	28

± STA. 29+00± LT. - ± STA. 34+50± LT.
Install RM-5 mounted on rail @ 25' o.c. (23 EA.)

± STA. 30+10± RT. - ± STA. 34+00± RT.
Install RM-5 mounted on rail @ 25' o.c. (17 EA.)

± STA. 37+00± LT. - ± STA. 40+00± LT.
Install RM-5 mounted on rail @ 25' o.c. (13 EA.)

TRUE NORTH
SCALE: 1" = 40'

TRUE NORTH
SCALE: 1" = 40'

LEGEND FOR AS-BUILT POSTINGS	
	Squiggly line for as-built deletion
	Double line for as-built deletion
Roadway	Text for as-built posting

STATE OF HAWAII
DEPARTMENT OF TRANSPORTATION
HIGHWAYS DIVISION


ROADWAY PLAN
HANA HIGHWAY PAVEMENT PREVENTIVE MAINTENANCE
Kaupakalua Road to Huelo
Federal-Aid Project No. ARR-0360(10)

Scale: 1" = 40' Date: October, 2008

ORIGINAL PLAN	SURVEY PLOTTED BY	DATE
NOTE BOOK	DRAWN BY	11/08
DESIGNED BY	CHECKED BY	
QUANTITIES BY		
CHECKED BY		

"AS-BUILT"

FED. ROAD DIST. NO.	STATE	FED. AID PROJ. NO.	FISCAL YEAR	SHEET NO.	TOTAL SHEETS
HAWAII	HAW.	ARR-0360(10)	2009	10	28

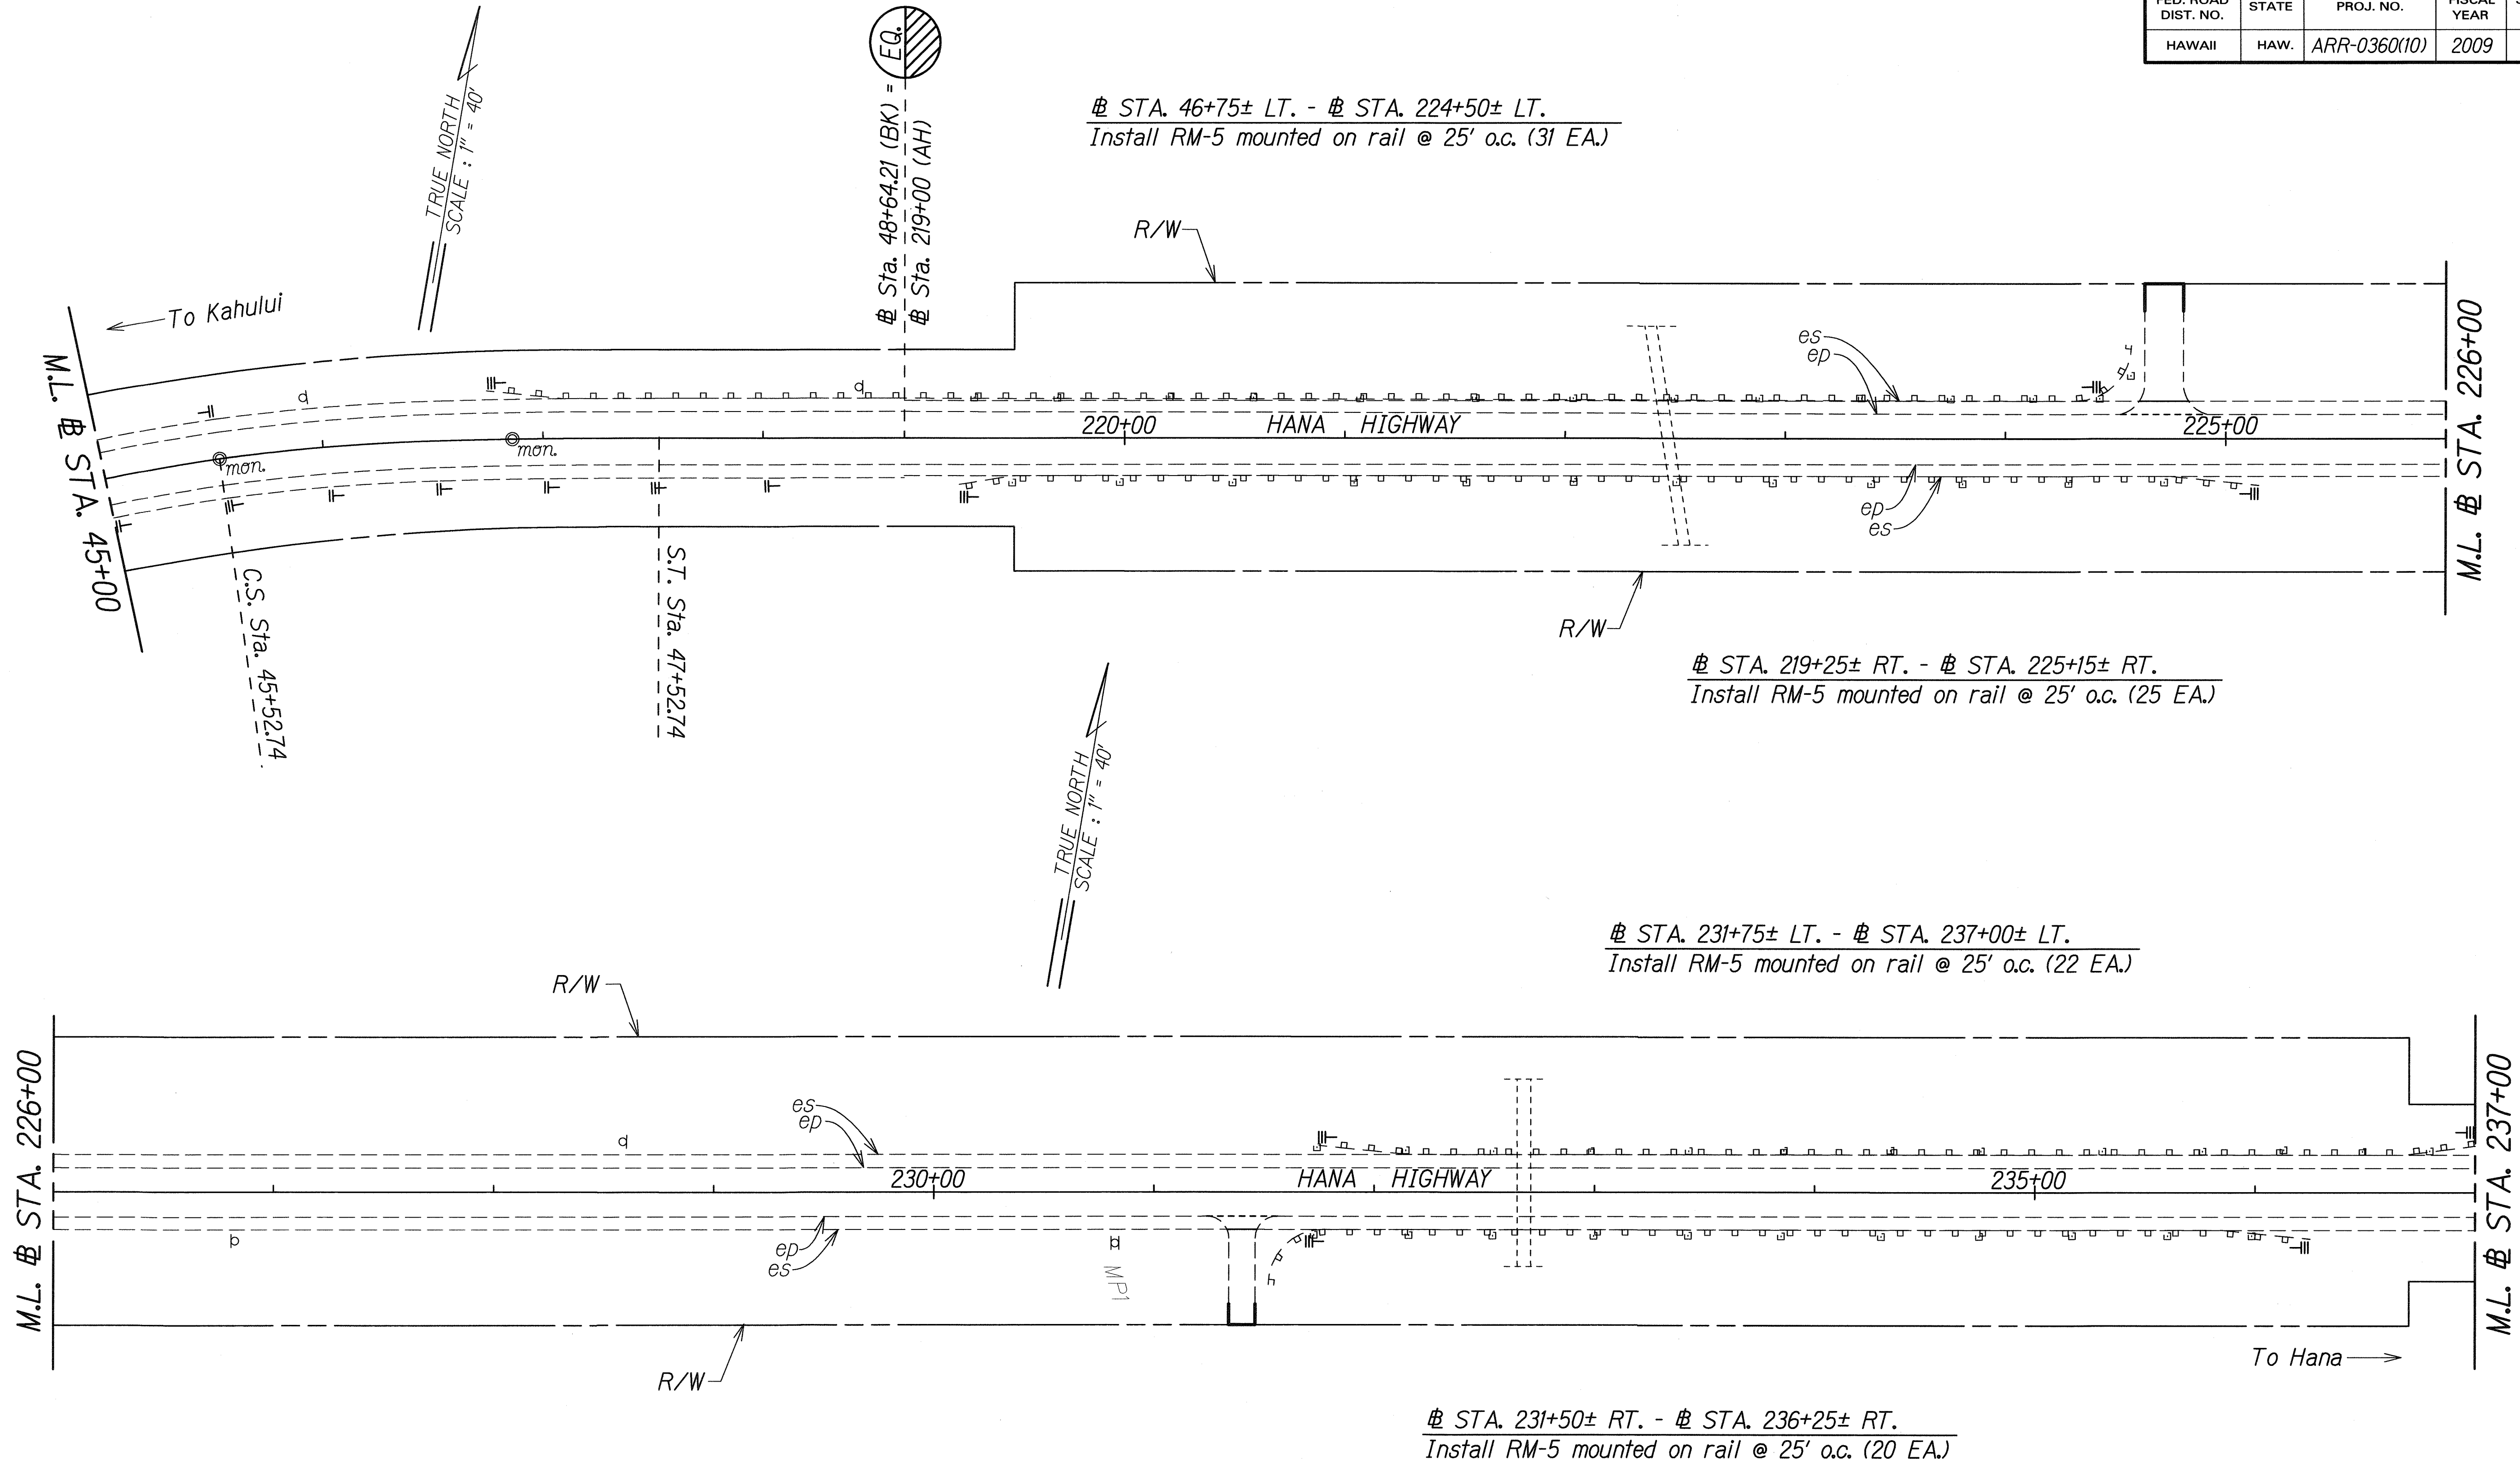

DESIGNED BY	DATE
DRAWN BY	
CHECKED BY	
NOTED BY	
QUANTITIES BY	
CHECKED BY	


LEGEND FOR AS-BUILT POSTINGS	
	Squiggly line for as-built deletion
	Double line for as-built deletion
Roadway	Text for as-built posting

STATE OF HAWAII
DEPARTMENT OF TRANSPORTATION
HIGHWAYS DIVISION

ROADWAY PLAN
HANA HIGHWAY PAVEMENT
PREVENTIVE MAINTENANCE
Kaupakalua Road to Huelo
Federal-Aid Project No. ARR-0360(10)
Scale: 1" = 40' Date: October, 2008
SHEET No. 4 OF 10 SHEETS

"AS-BUILT"

FED. ROAD DIST. NO.	STATE	FED. AID PROJ. NO.	FISCAL YEAR	SHEET NO.	TOTAL SHEETS
HAWAII	HAW.	ARR-0360(10)	2009	11	28

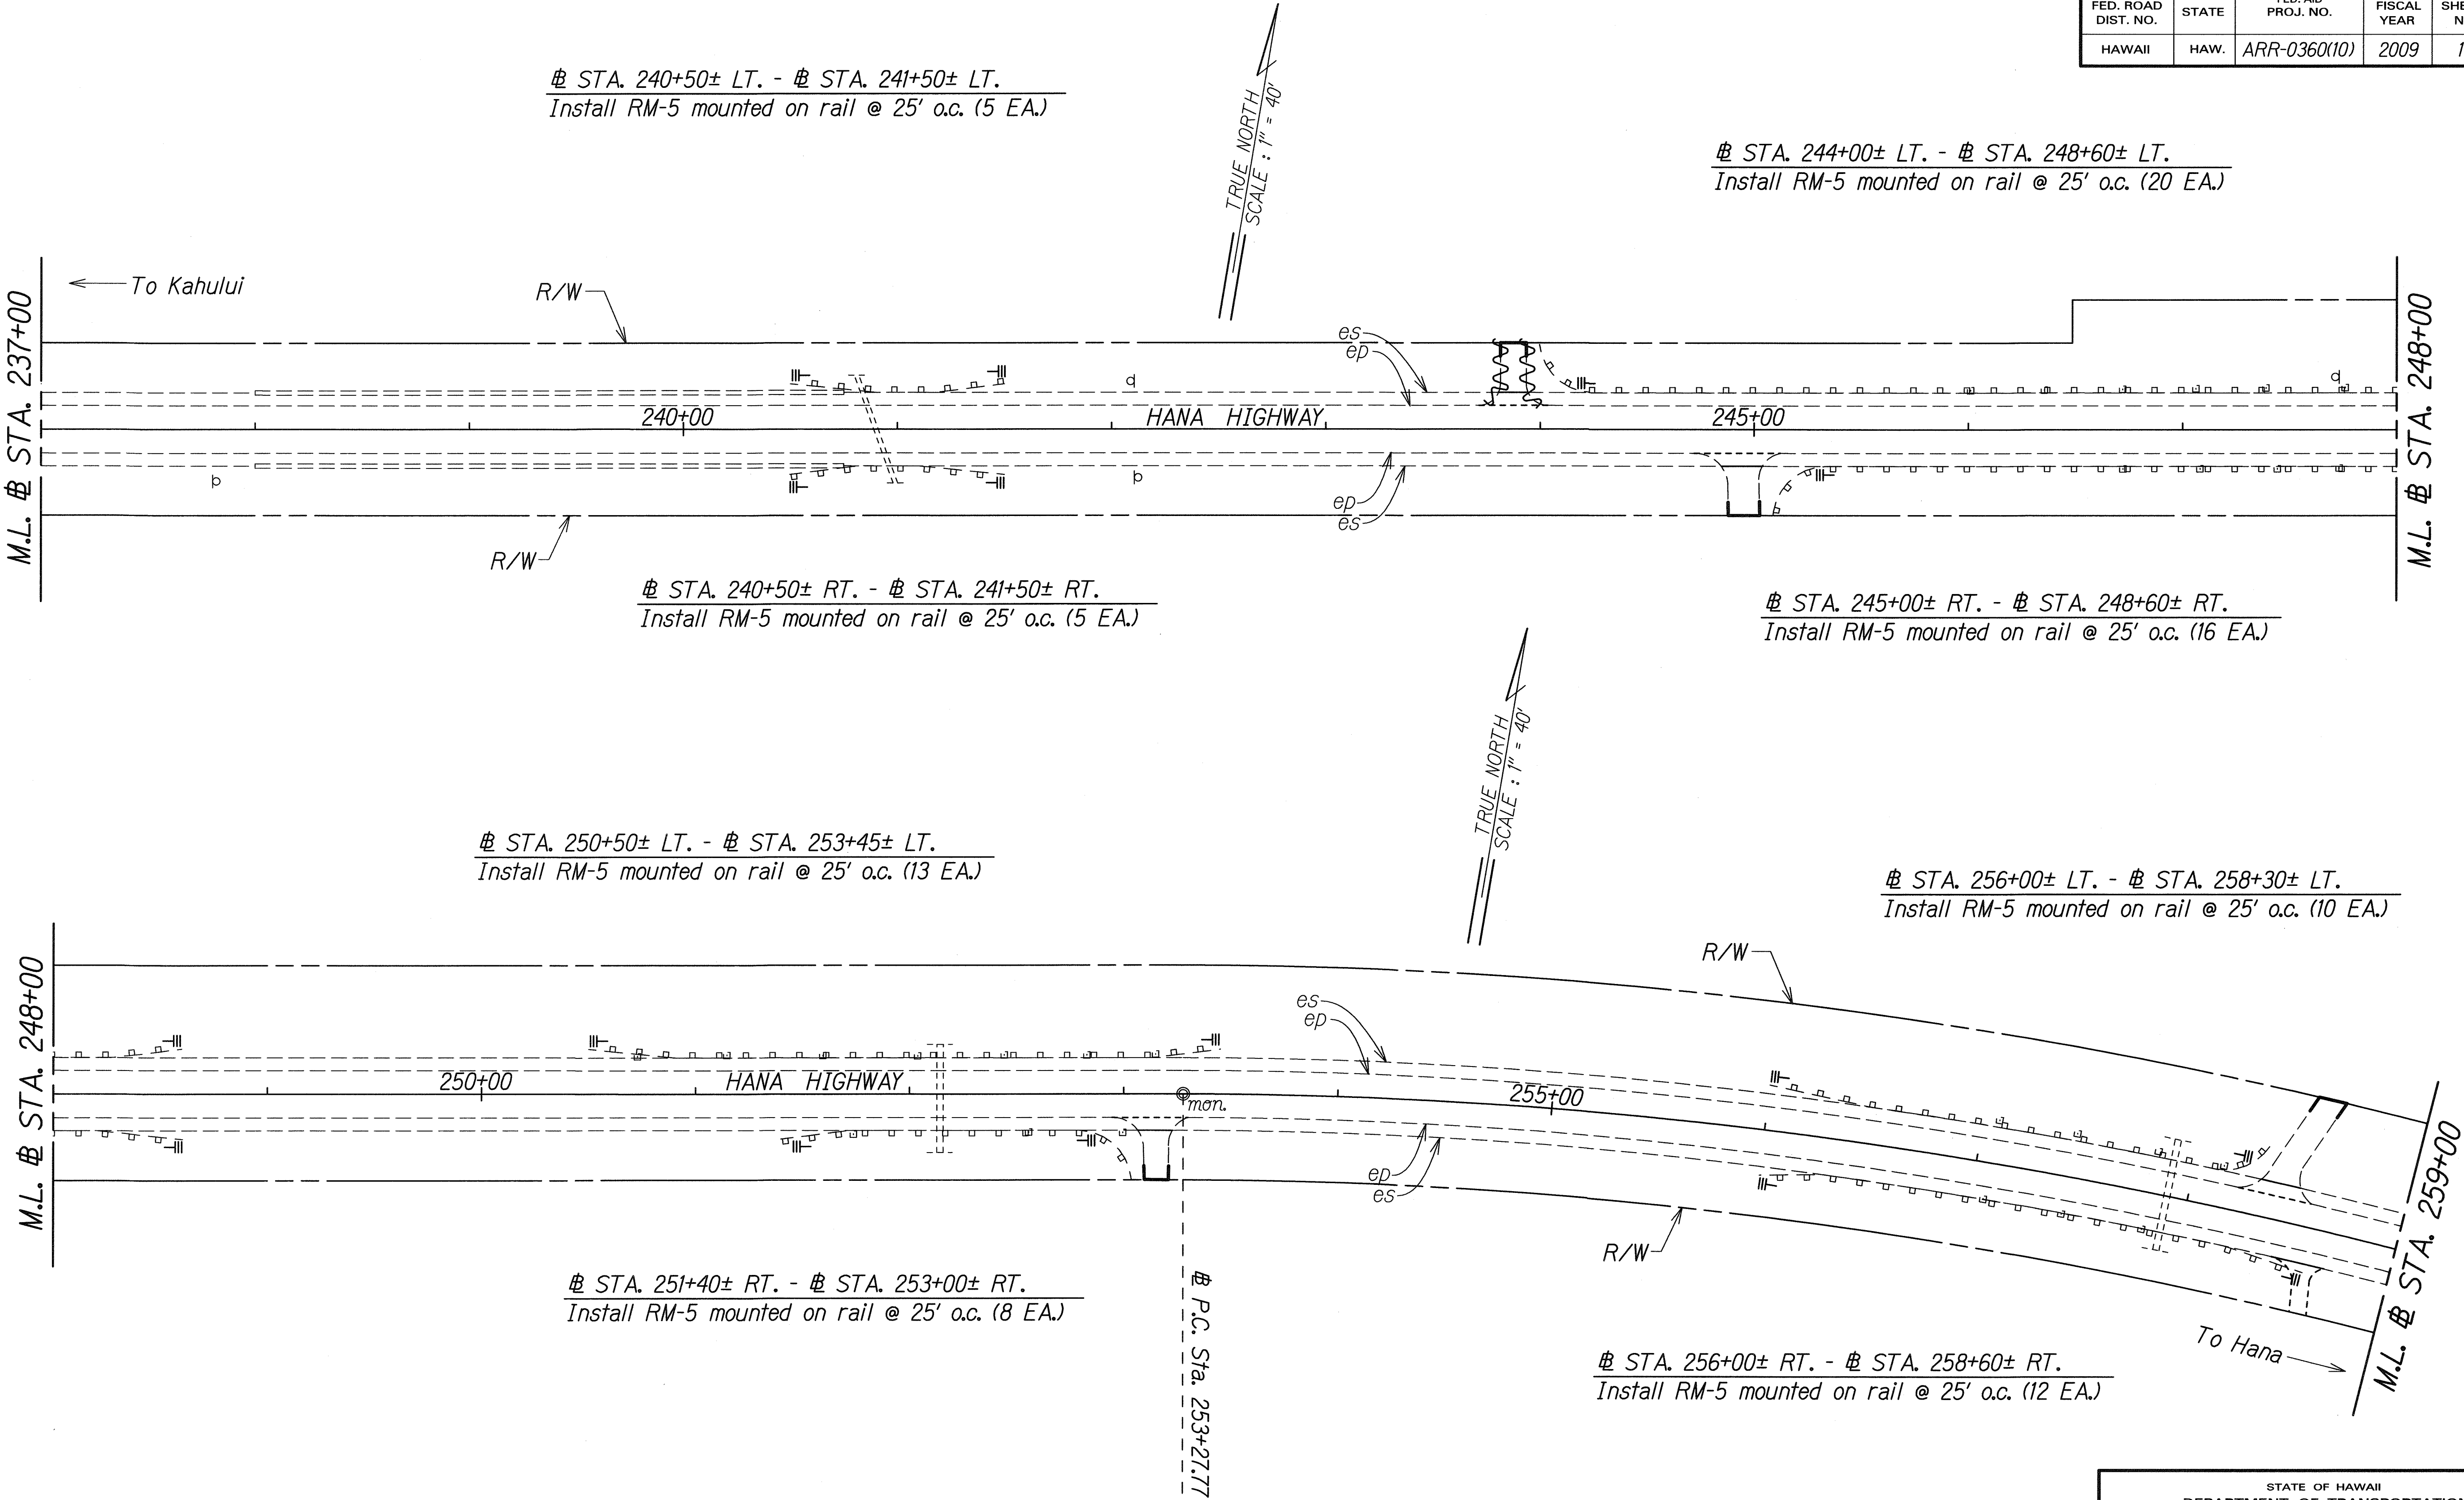


ORIGINAL PLAN	DATE
NOTED BY	11/08
DESIGNED BY	
QUANTITIES BY	
CHECKED BY	

LEGEND FOR AS-BUILT POSTINGS	
	Squiggly line for as-built deletion
	Double line for as-built deletion
Roadway	Text for as-built posting

STATE OF HAWAII
 DEPARTMENT OF TRANSPORTATION
 HIGHWAYS DIVISION

ROADWAY PLAN
 HANA HIGHWAY PAVEMENT
 PREVENTIVE MAINTENANCE
 Kaupakalua Road to Huelo
 Federal-Aid Project No. ARR-0360(10)
 Scale: 1" = 40' Date: October, 2008
 SHEET No. 5 OF 10 SHEETS

FED. ROAD DIST. NO.	STATE	FED. AID PROJ. NO.	FISCAL YEAR	SHEET NO.	TOTAL SHEETS
HAWAII	HAW.	ARR-0360(10)	2009	12	28

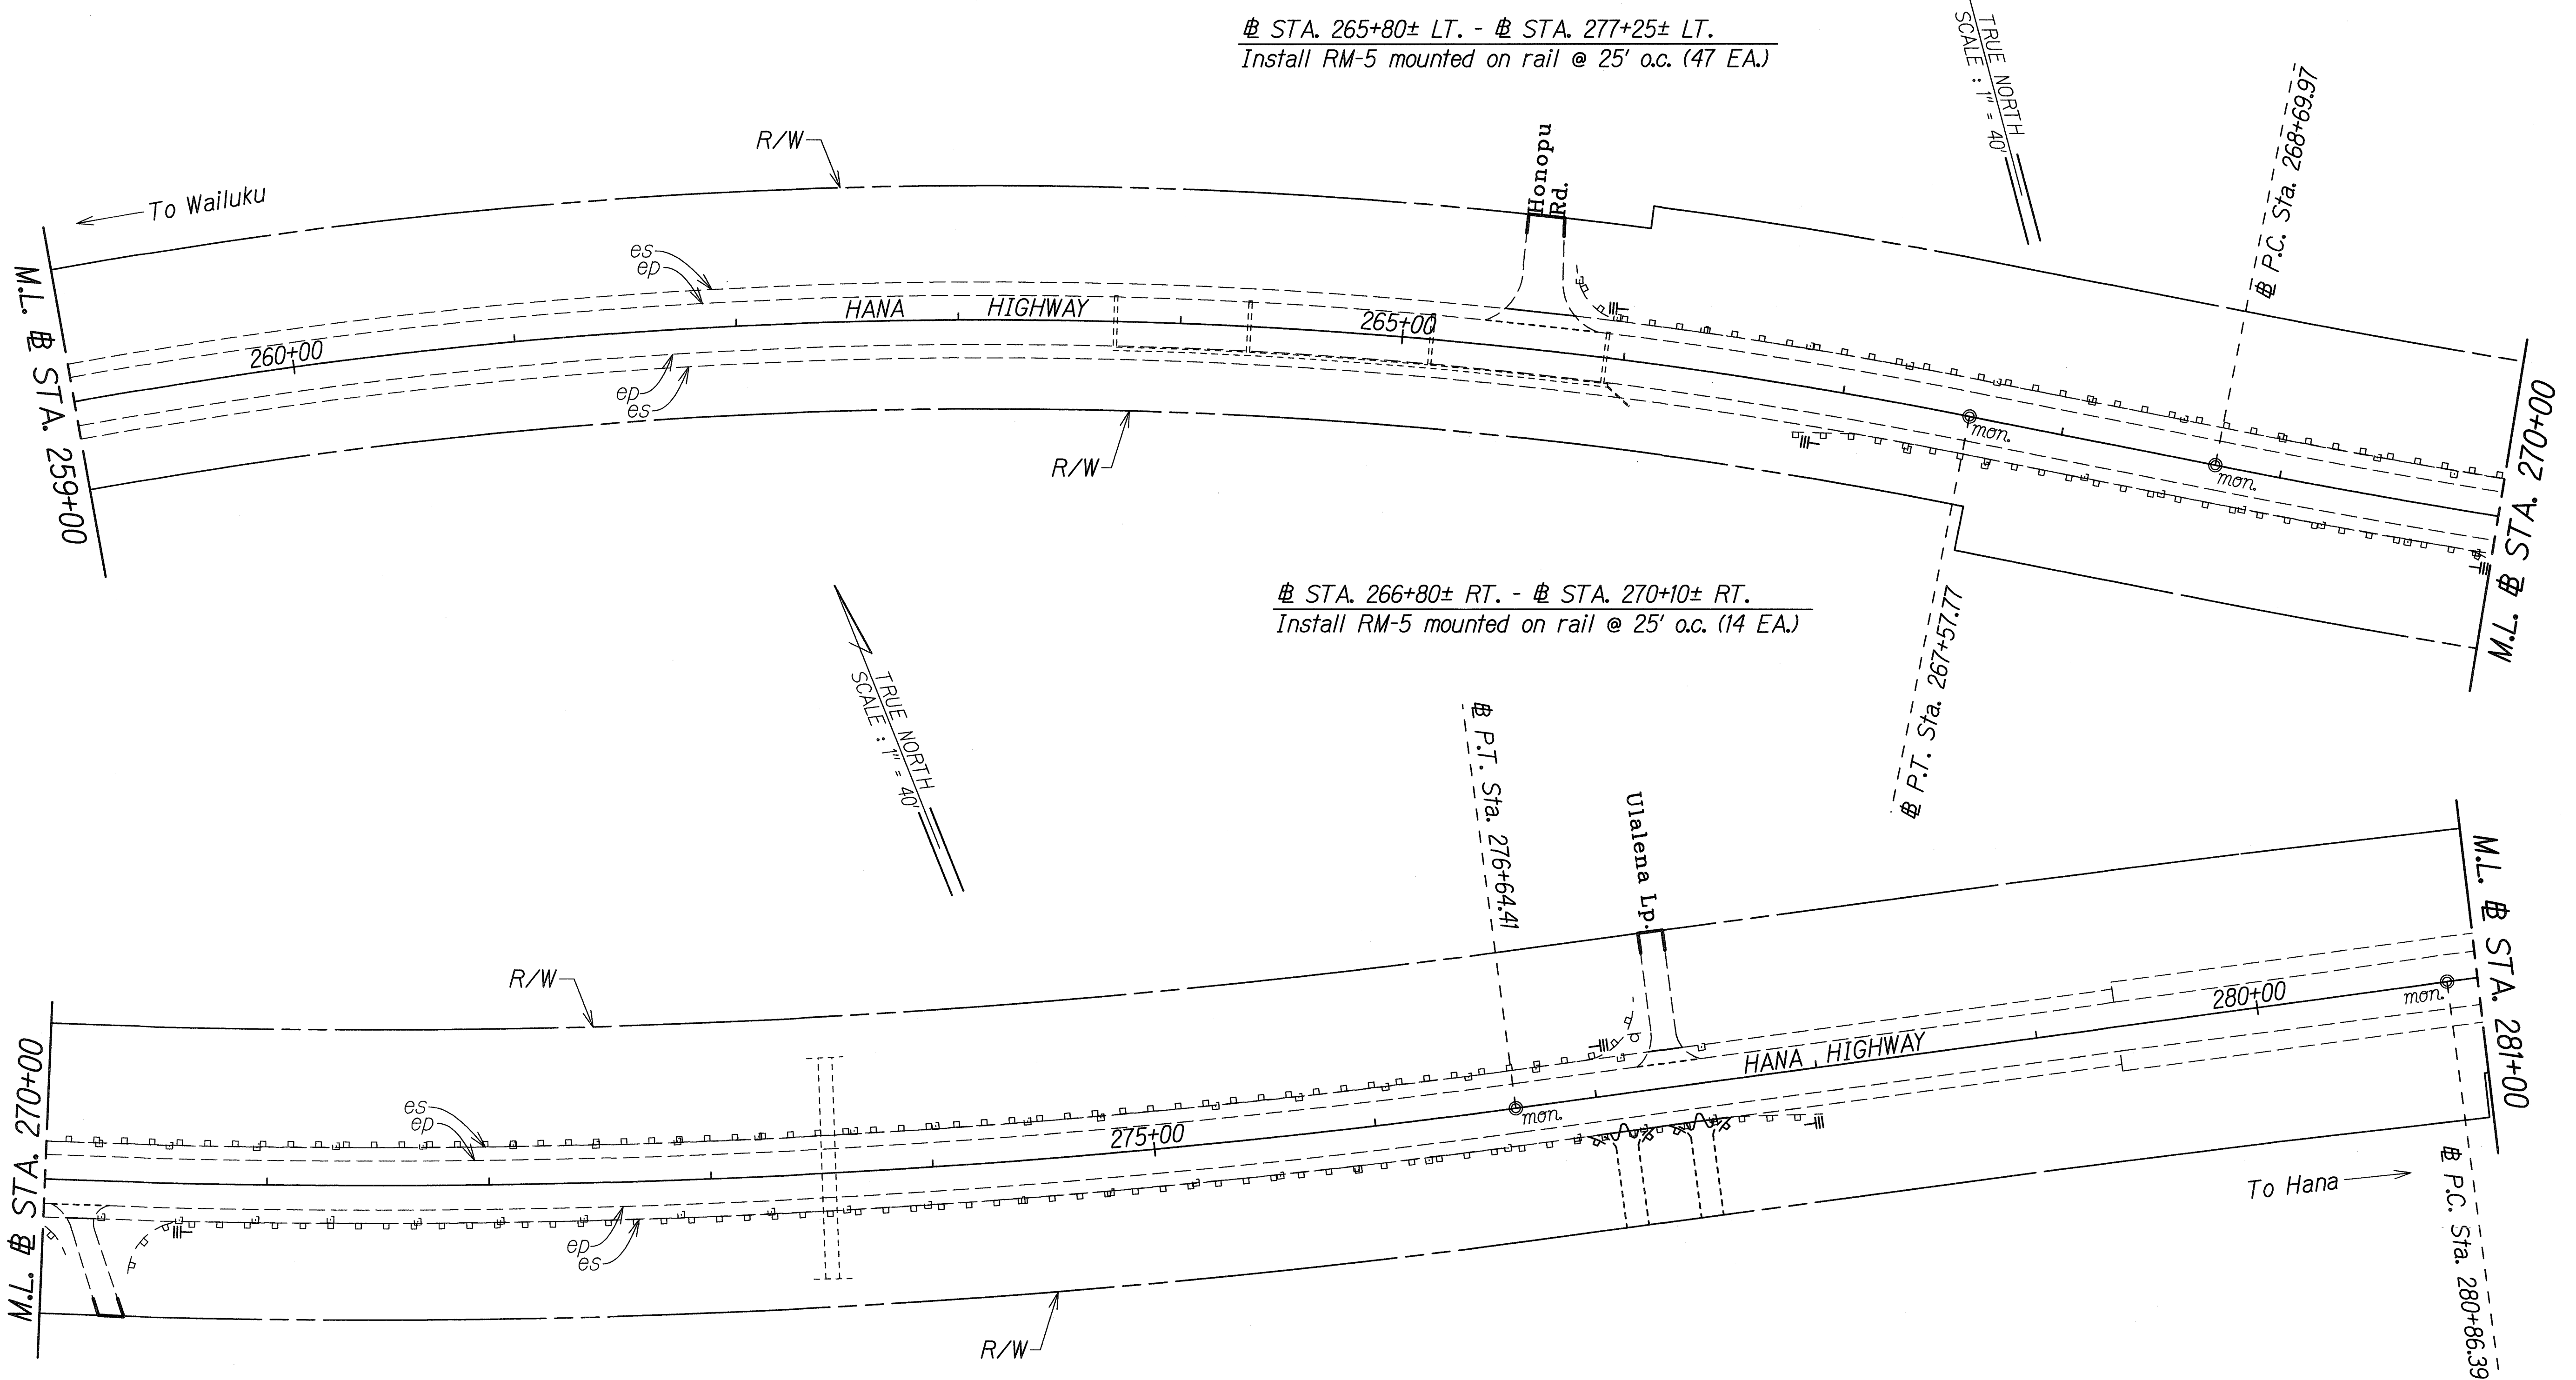


ORIGINAL PLAN	SURVEY PLOTTED BY	DATE
NOTE BOOK	DRAWN BY	11/08
me/ey	TRACED BY	
me/ey	QUANTITIES BY	
me/ey	CHECKED BY	

LEGEND FOR AS-BUILT POSTINGS	
	Squiggly line for as-built deletion
	Double line for as-built deletion
Roadway	Text for as-built posting

STATE OF HAWAII
DEPARTMENT OF TRANSPORTATION
HIGHWAYS DIVISION
ROADWAY PLAN
HANA HIGHWAY PAVEMENT
PREVENTIVE MAINTENANCE
Kaupakalua Road to Huelo
Federal-Aid Project No. ARR-0360(10)
Scale: 1" = 40' Date: October, 2008
SHEET No. 6 OF 10 SHEETS

"AS-BUILT"

FED. ROAD DIST. NO.	STATE	FED. AID PROJ. NO.	FISCAL YEAR	SHEET NO.	TOTAL SHEETS
HAWAII	HAW.	ARR-0360(10)	2009	14	28

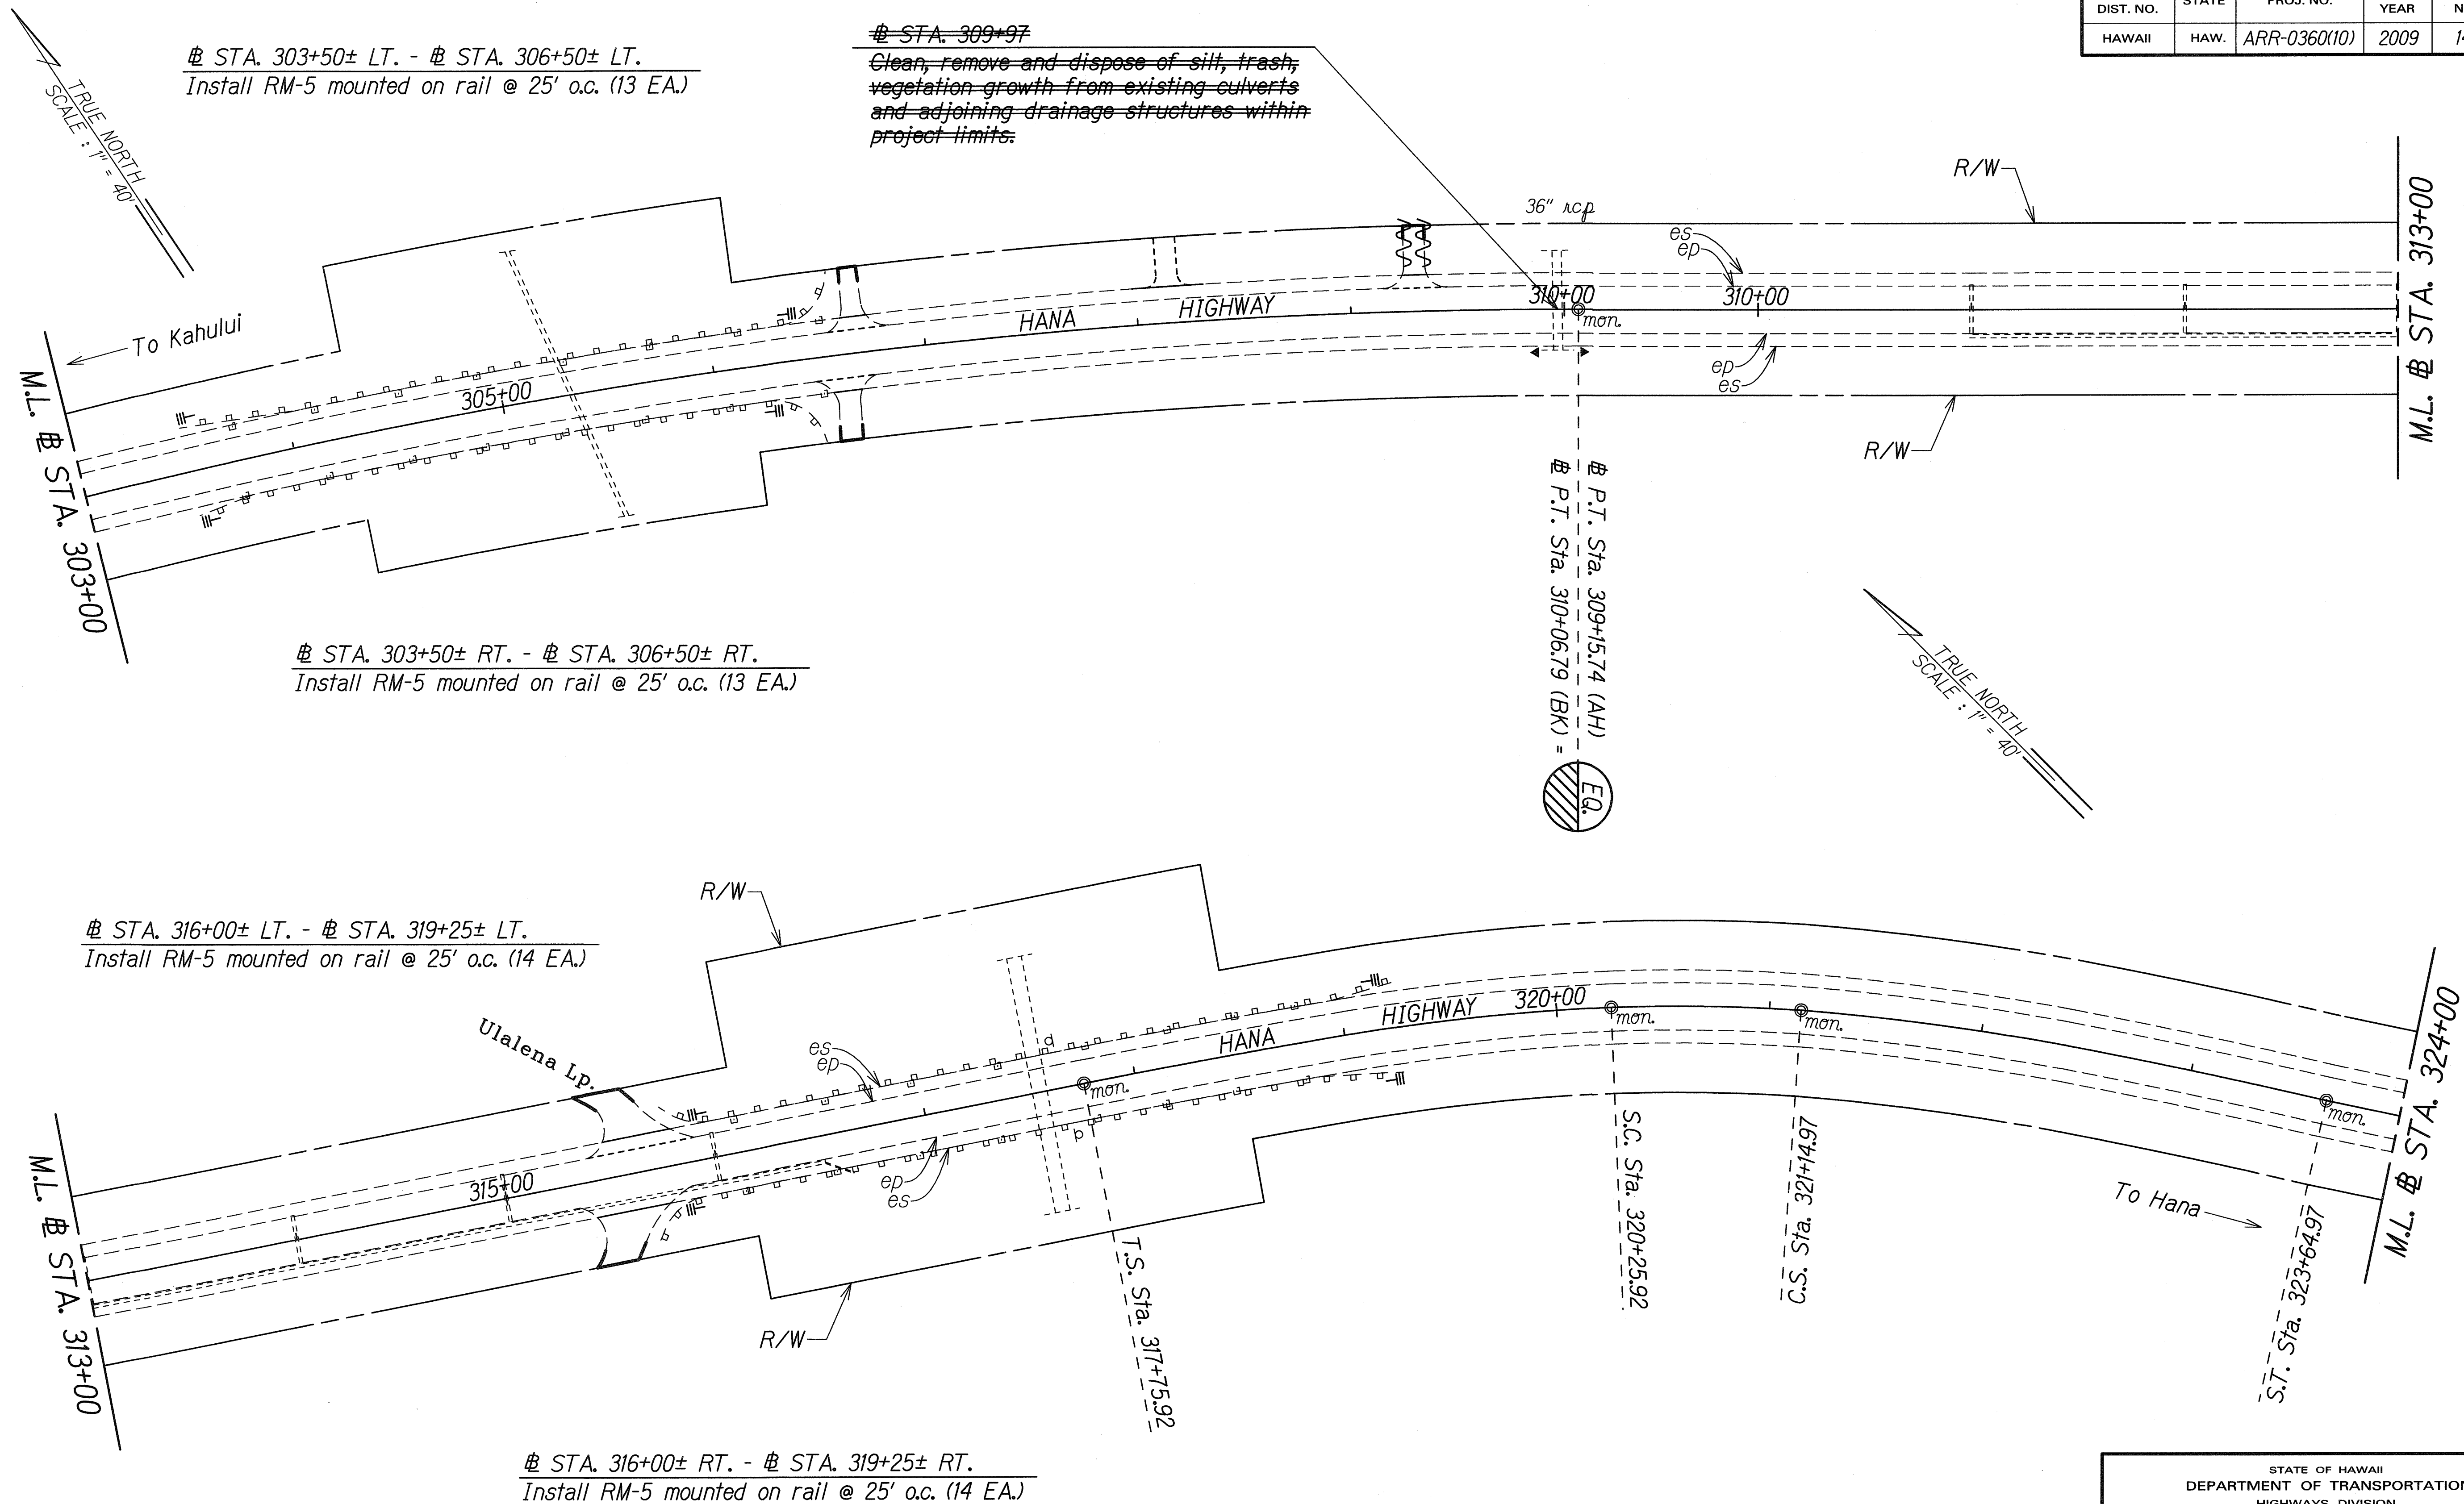

ORIGINAL PLAN	DATE	11/08
NOTE BOOK	DRAWN BY	me/ey
DESIGNED BY	QUANTITIES BY	me/ey
CHECKED BY		me/ey

LEGEND FOR AS-BUILT POSTINGS	
	Squiggly line for as-built deletion
	Double line for as-built deletion
Roadway	Text for as-built posting

STATE OF HAWAII
DEPARTMENT OF TRANSPORTATION
HIGHWAYS DIVISION


ROADWAY PLAN
HANA HIGHWAY PAVEMENT PREVENTIVE MAINTENANCE
Kaupakalua Road to Huelo
Federal-Aid Project No. ARR-0360(10)

Scale: 1" = 40' Date: October, 2008

SHEET No. 8 OF 10 SHEETS

"AS-BUILT"

FED. ROAD DIST. NO.	STATE	FED. AID PROJ. NO.	FISCAL YEAR	SHEET NO.	TOTAL SHEETS
HAWAII	HAW.	ARR-0360(10)	2009	15	28

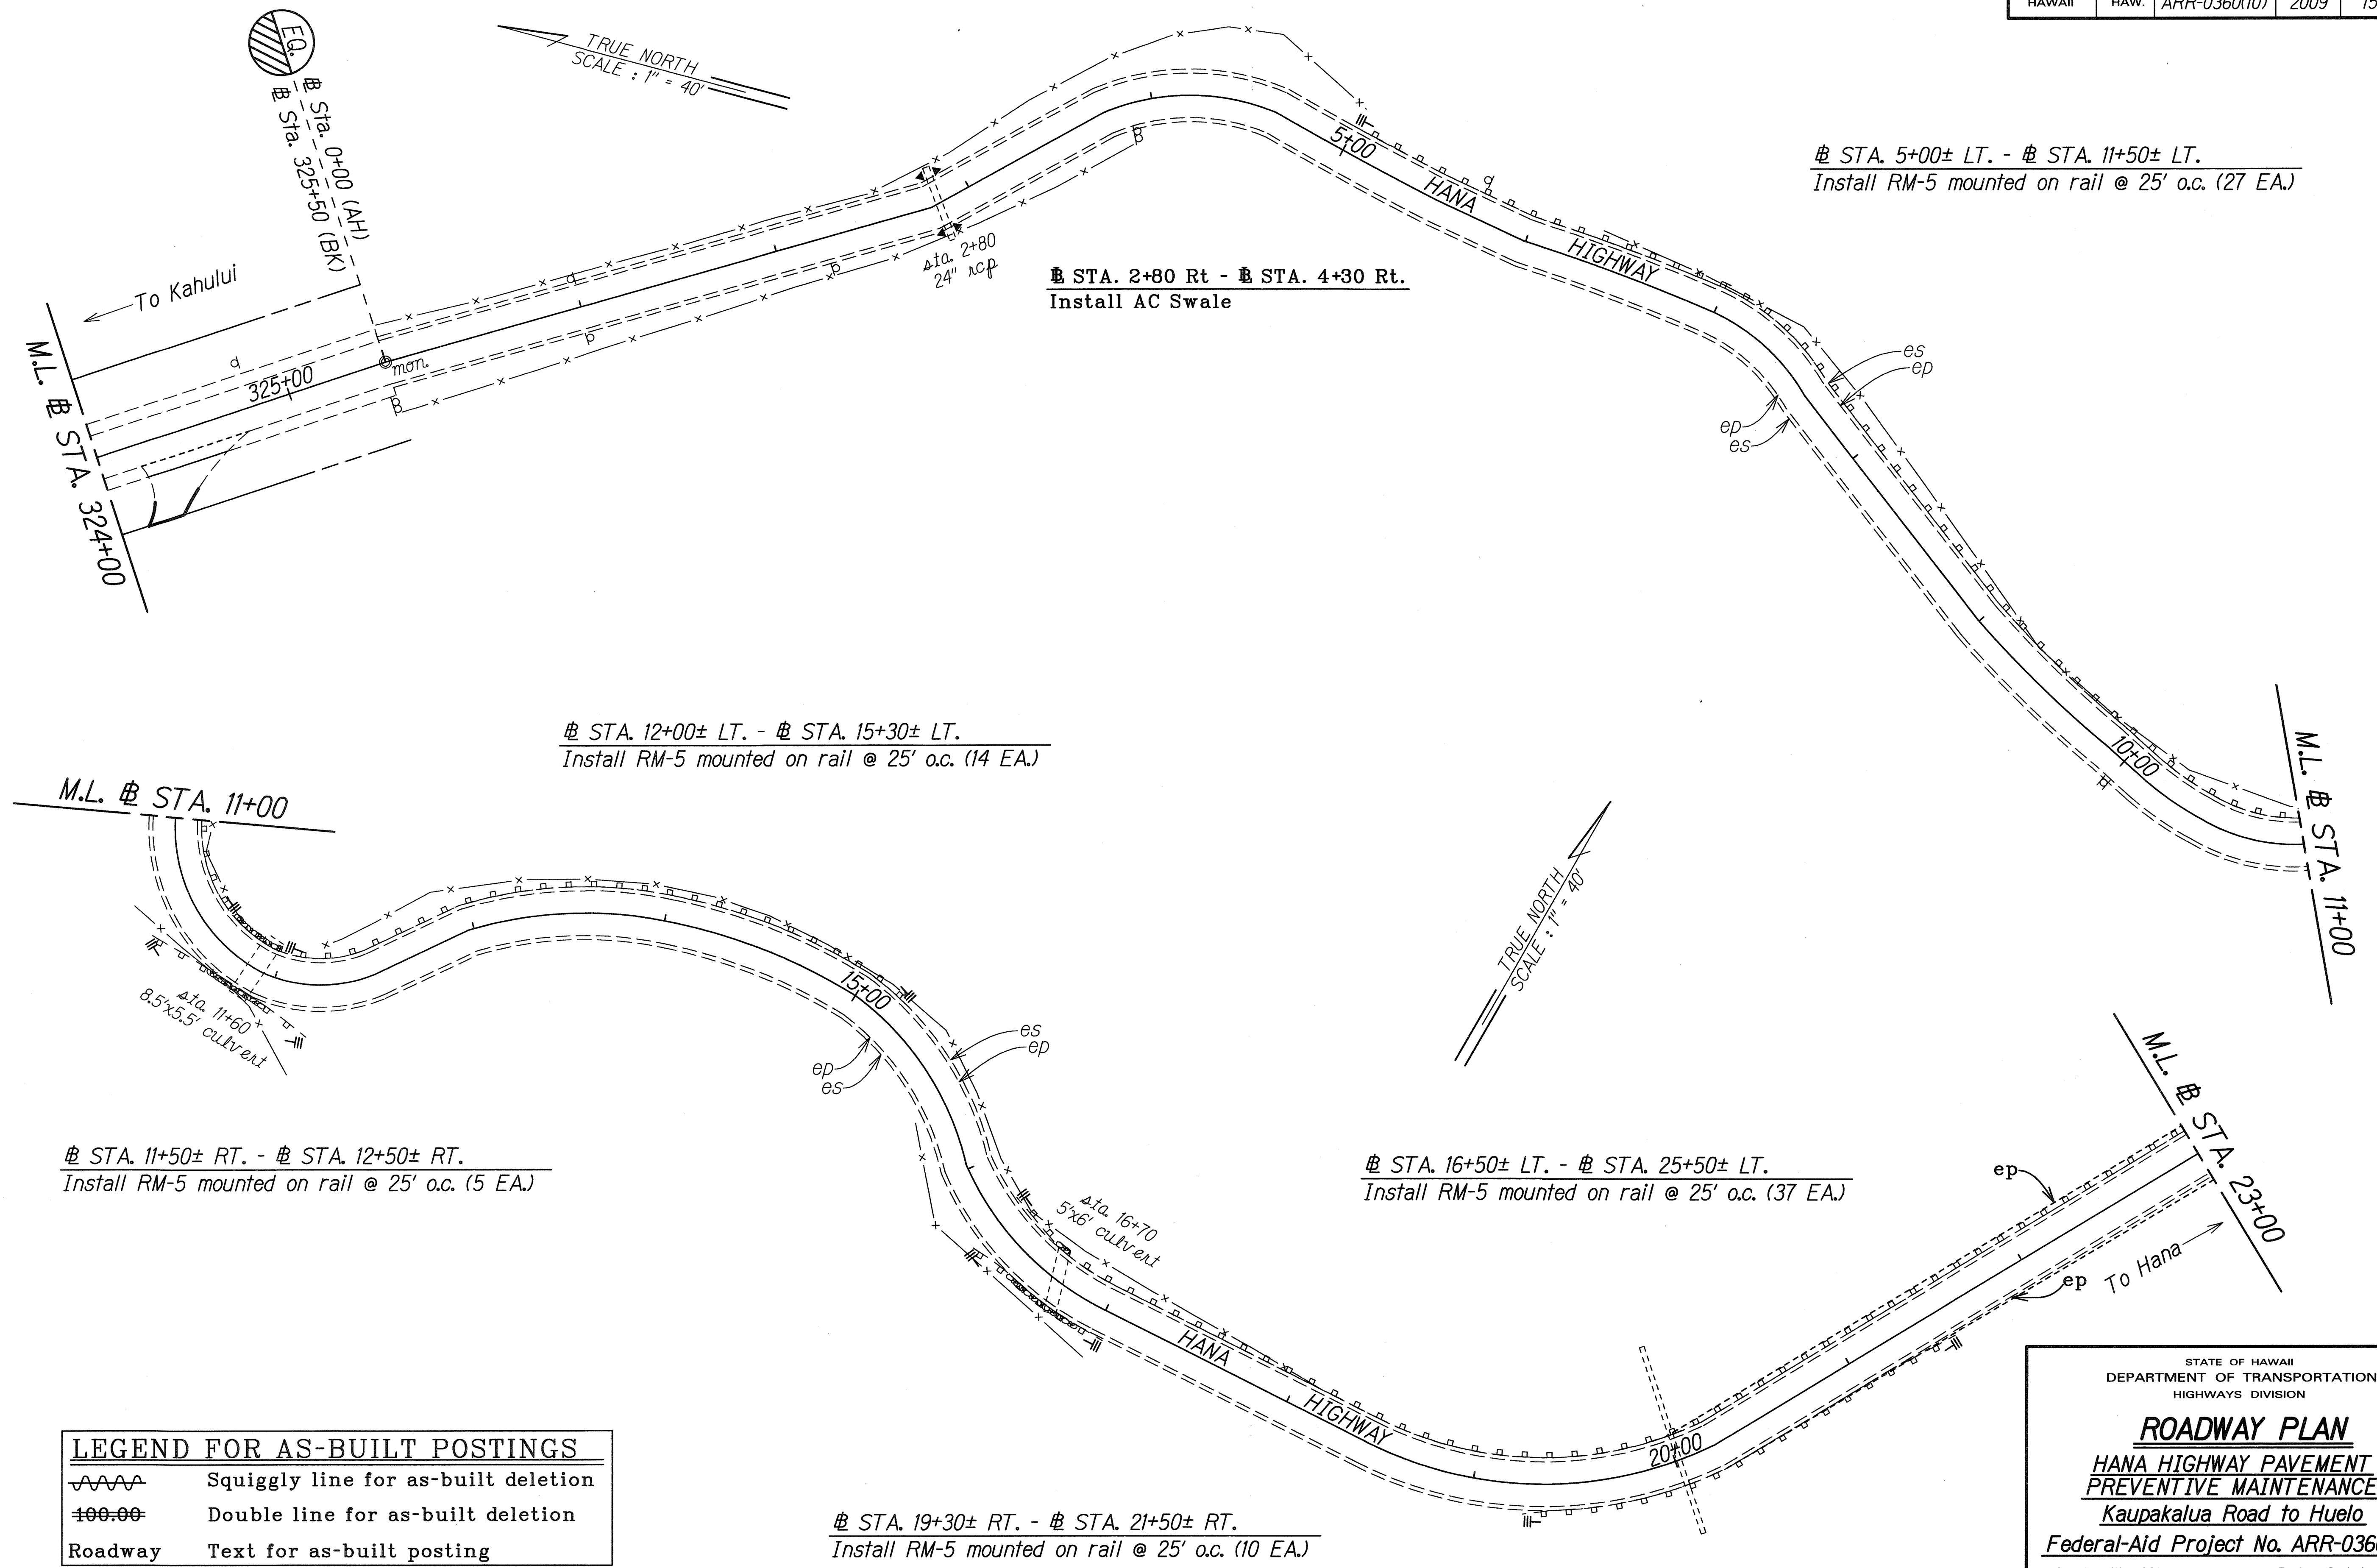

ORIGINAL PLAN	SURVEY PLOTTED BY _____	DATE _____
	DRAWN BY <i>gg</i>	<i>11/08</i>
	TRACED BY _____	*
	DESIGNED BY <i>gd</i>	*
NOTE BOOK <i>mal,jay</i> <i>whampg,dgn</i>	QUANTITIES BY _____	*
	CHECKED BY _____	*
	_____	_____
	_____	_____


LEGEND FOR AS-BUILT POSTINGS	
	Squiggly line for as-built deletion
	Double line for as-built deletion
Roadway	Text for as-built posting

STATE OF HAWAII
DEPARTMENT OF TRANSPORTATION
HIGHWAYS DIVISION

ROADWAY PLAN
HANA HIGHWAY PAVEMENT
PREVENTIVE MAINTENANCE
Kaupakalua Road to Huelo
Federal-Aid Project No. ARR-0360(10)
Scale: 1" = 40' Date: October, 2008
SHEET No. 9 OF 10 SHEETS

"AS-BUILT"

FED. ROAD DIST. NO.	STATE	FED. AID PROJ. NO.	FISCAL YEAR	SHEET NO.	TOTAL SHEETS
HAWAII	HAW.	ARR-0360(10)	2009	16	28

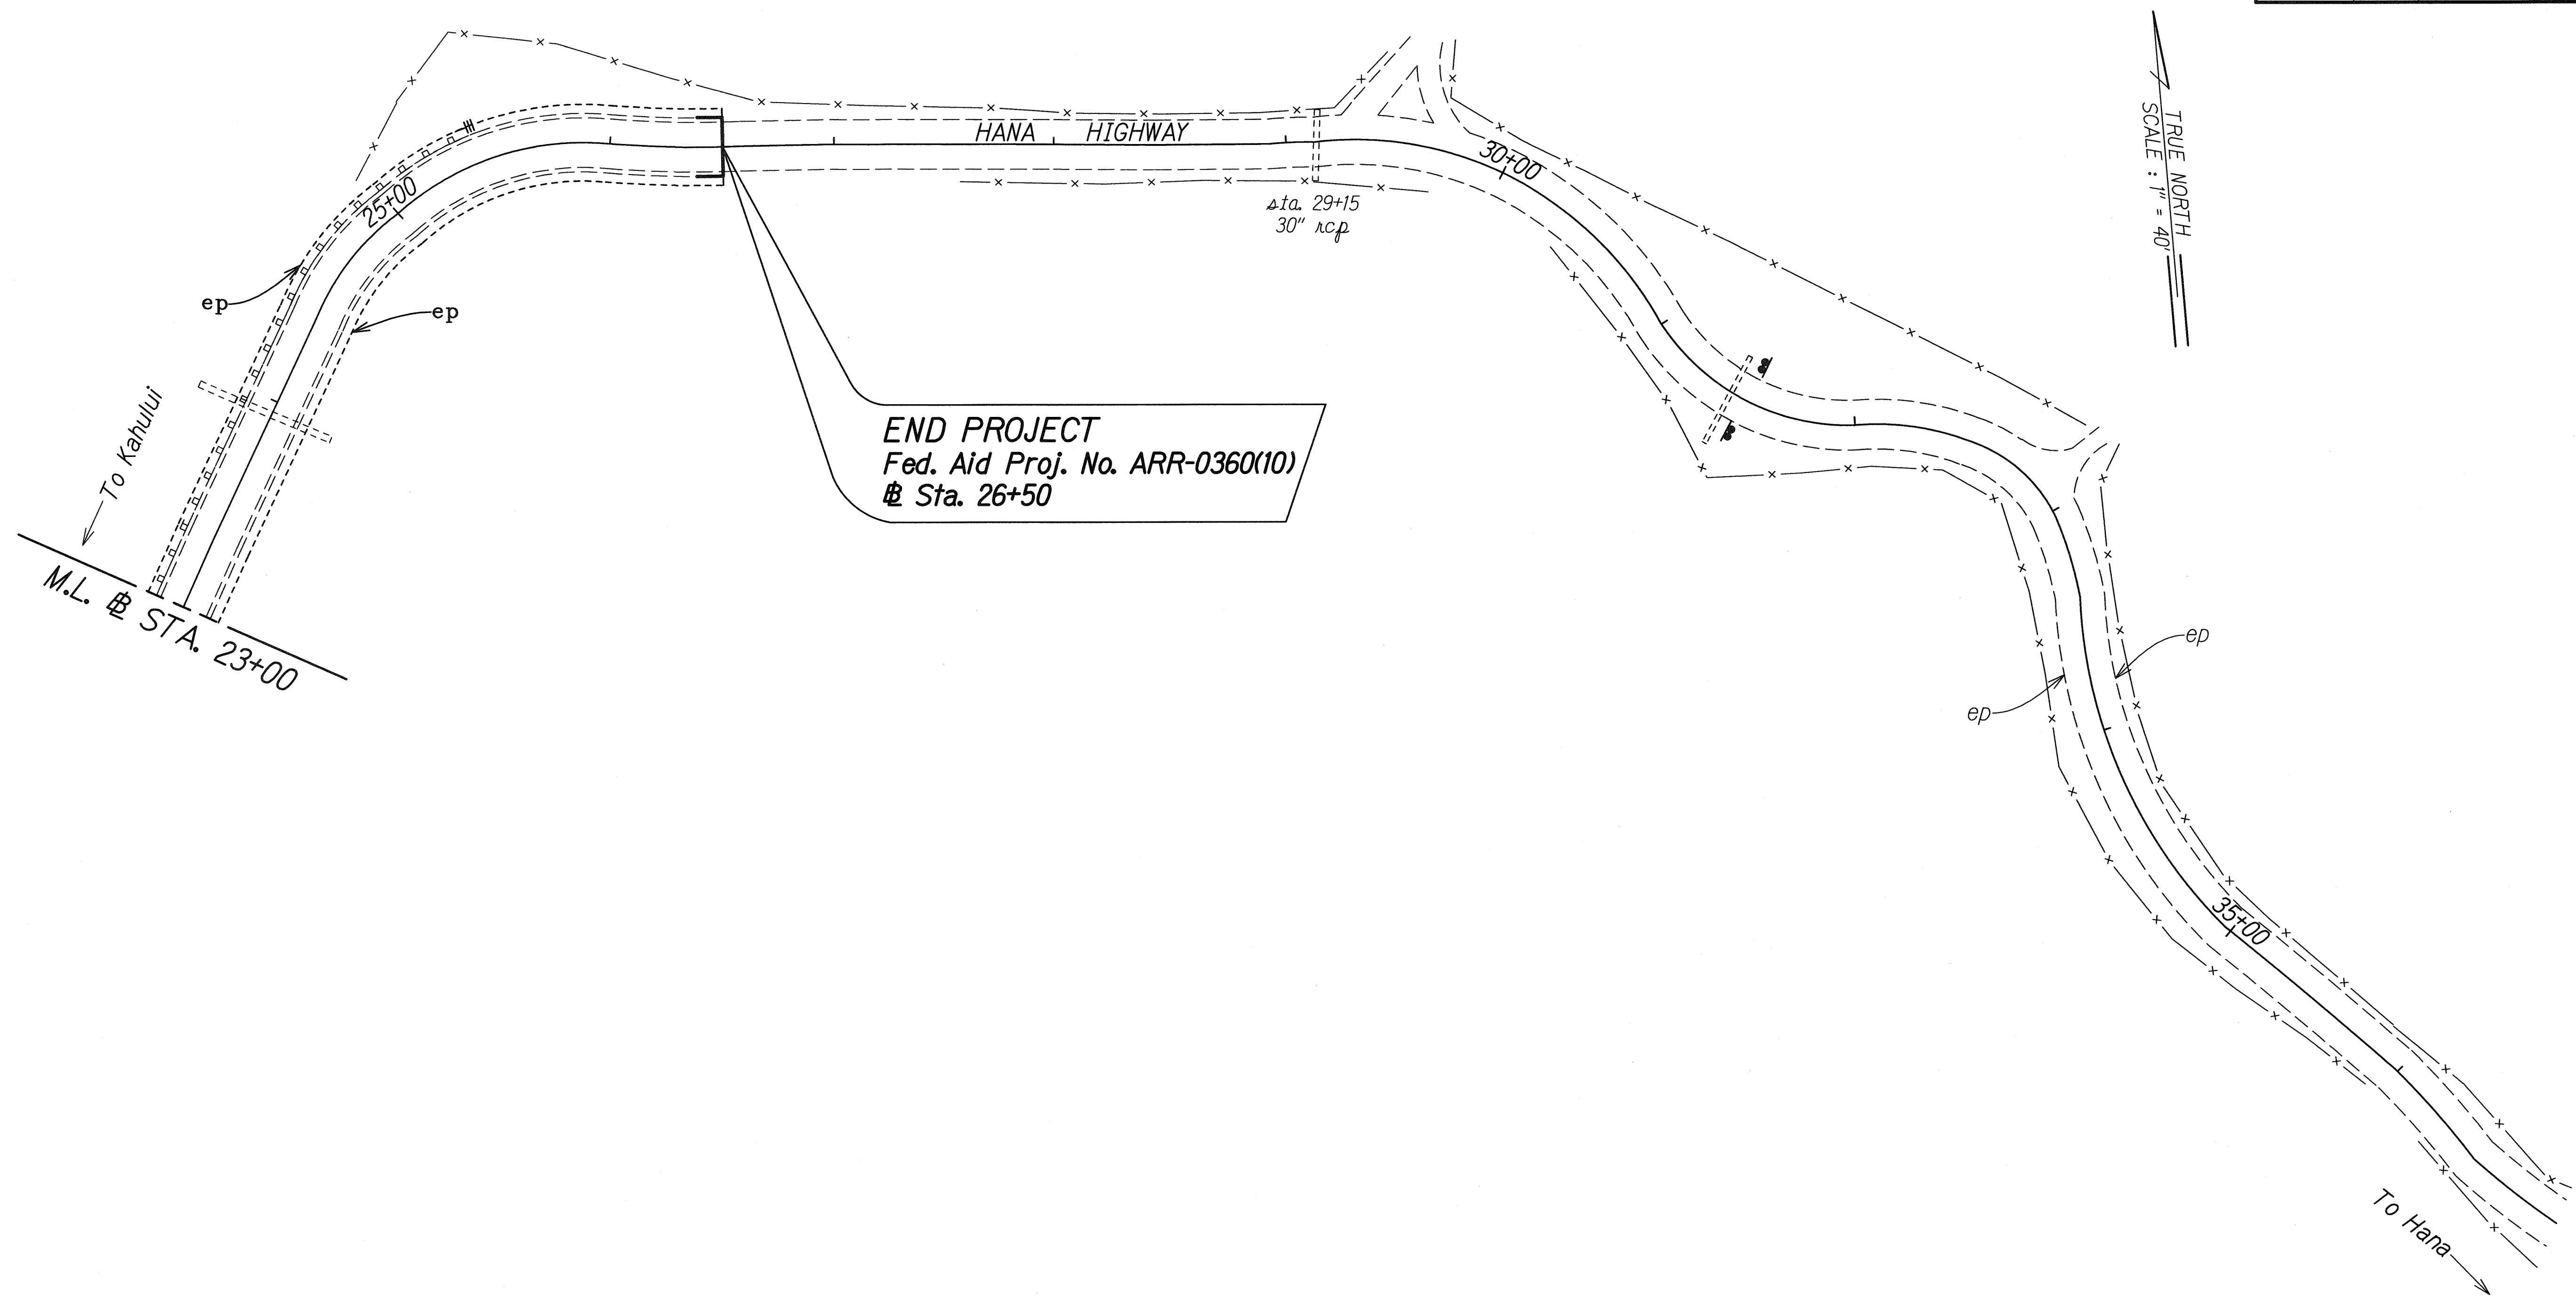

ORIGINAL PLAN	SURVEY PLOTTED BY	DATE
NOTE BOOK	DRAWN BY	11/08
DESIGNED BY	CHECKED BY	
BY		

LEGEND FOR AS-BUILT POSTINGS	
	Squiggly line for as-built deletion
	Double line for as-built deletion
Roadway	Text for as-built posting

STATE OF HAWAII
DEPARTMENT OF TRANSPORTATION
HIGHWAYS DIVISION

ROADWAY PLAN
HANA HIGHWAY PAVEMENT
PREVENTIVE MAINTENANCE
Kaupakalua Road to Huelo
Federal-Aid Project No. ARR-0360(10)
Scale: 1" = 40' Date: October, 2008

SHEET No. 10 OF 10 SHEETS

"AS-BUILT"