


FED. ROAD DIST. NO.	STATE	PROJ. NO.	FISCAL YEAR	SHEET NO.	TOTAL SHEETS
HAWAII	HAW.	360A-02-10	2012	9	14

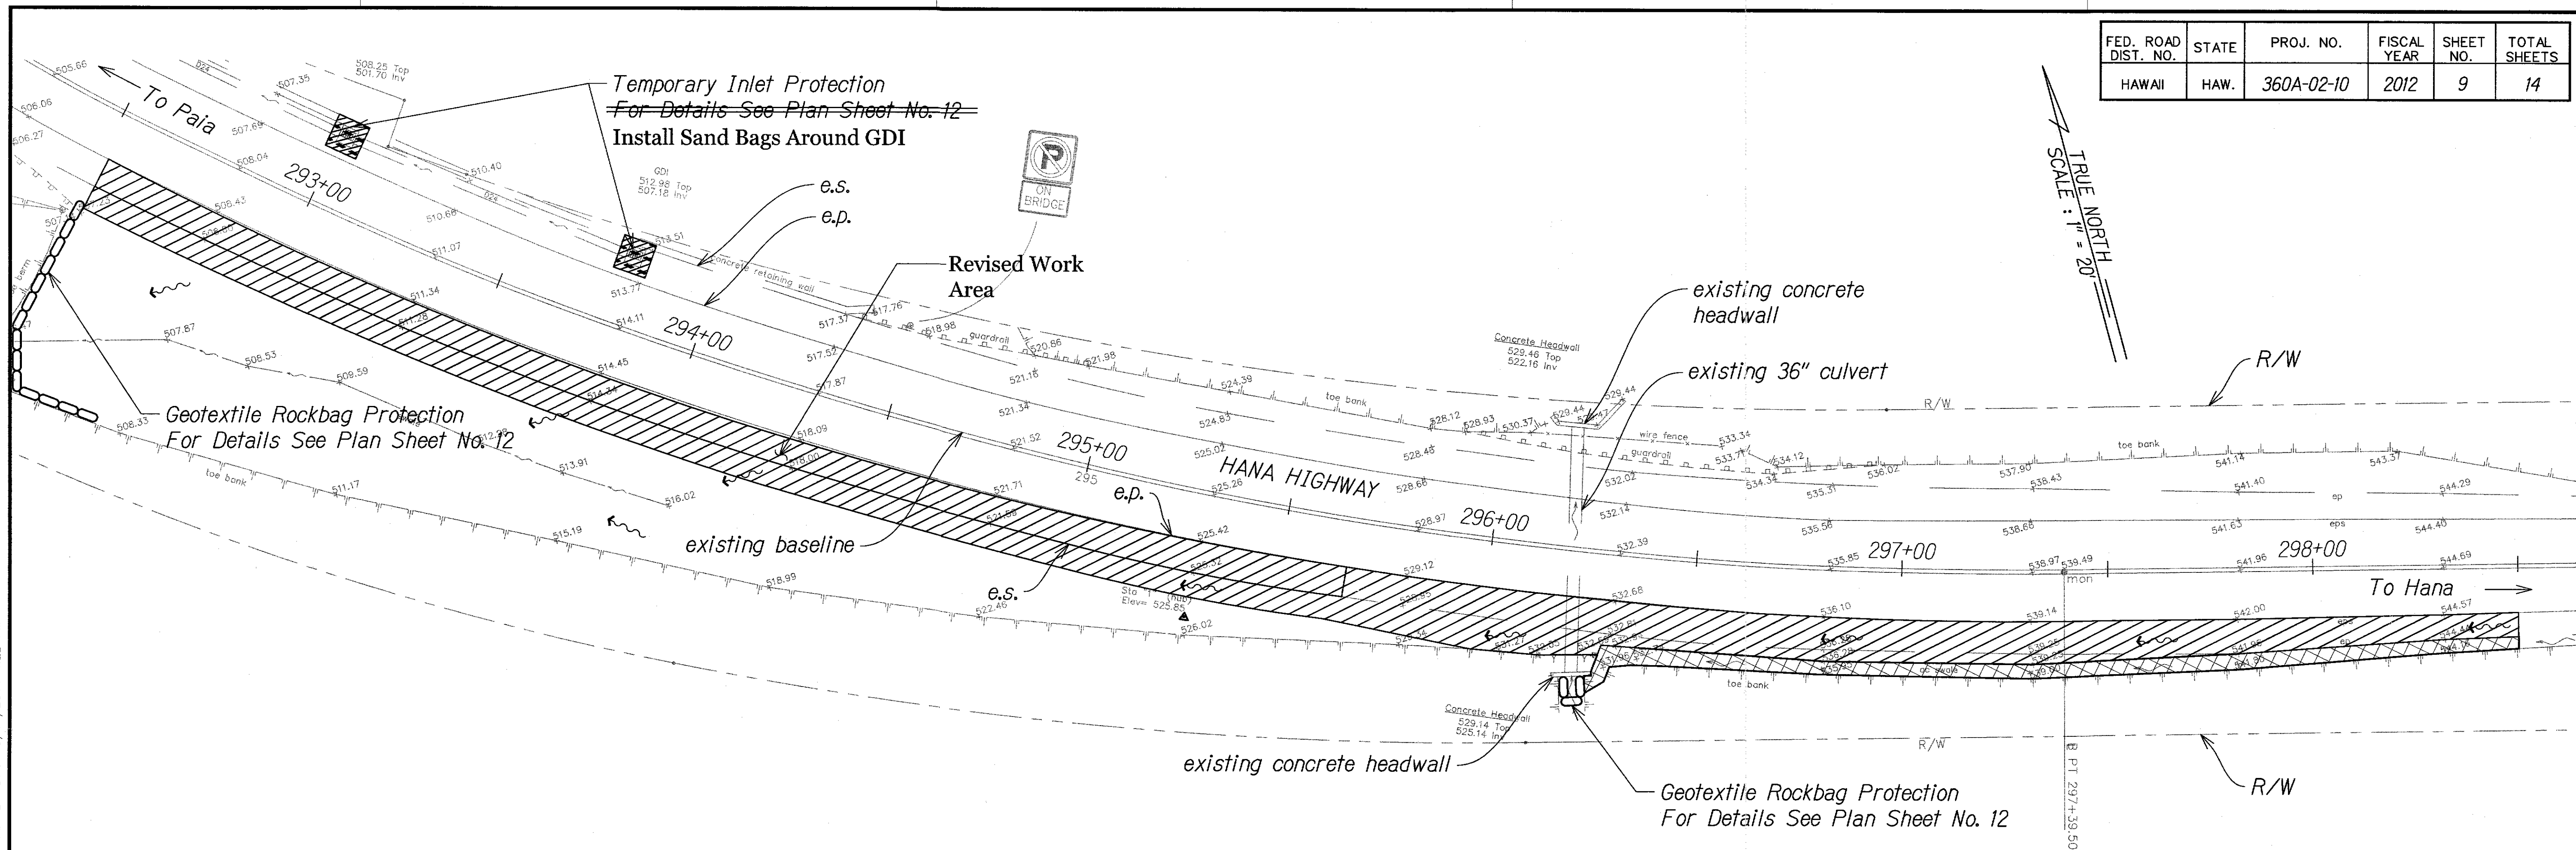

Demolition And Erosion Control Plan

NOTES:

- 1. Survey conducted by State Department of Transportation, Highways Division, Dated June 3, 2009.
- 2. Contractor shall sawcut existing A.C. pavement prior to removal.
- 3. Contractor shall remove and relocate sign post anchors with sign relocations.



LEGEND:

- Approx. Limits of A.C. Swale Removal And Reconstruction (Exact Limits To Be Determined By Engineer In Field)
- Approx. Limits Of Shoulder Removal And Reconstruction - Cold Plane Approx. 4" Asphalt Pavement and Excavate to Grade (Exact Limits To Be Determined By Engineer In Field)
- Geotextile Rockbag Protection
- Temporary Inlet Protection
- Direction of Flow

LEGEND FOR AS-BUILT POSTINGS

- Squiggly line for as-built deletion
- Double line for as-built deletion
- Roadway Text for as-built posting

GRAPHICAL SCALE:

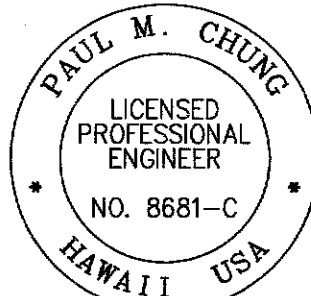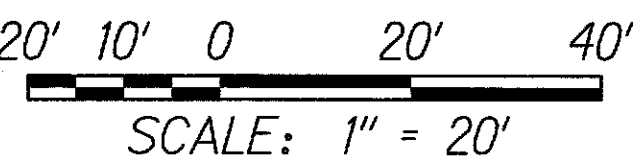

THIS WORK WAS PREPARED BY ME OR UNDER MY SUPERVISION

SIGNATURE: 04/30/12
EXPIRATION DATE OF THE LICENSE

STATE OF HAWAII
DEPARTMENT OF TRANSPORTATION
HIGHWAYS DIVISION

DEMOLITION AND EROSION CONTROL PLAN

HANA HIGHWAY DRAINAGE IMPROVEMENTS
Vicinity of Hoolawa Bridge
Project No. 360A-02-10

Scale: 1" = 20' Date: May 10, 2012

SHEET No. 1 OF 1 SHEETS

"AS-BUILT"

ORIGINAL PLAN	DATE
NOTE BOOK	
NO.	

W:_CIVIL 3D PROJECTS\2006-173-001 SCH HANA HWY DRAINAGE IMPROVEMENTS\AS-BUILT DRAWINGS\09 DEMOLITION AND EROSION CONTROL PLANDWG 3/17/2014 4:22 PM