



FED. ROAD DIST. NO.	STATE	PROJ. NO.	FISCAL YEAR	SHEET NO.	TOTAL SHEETS
HAWAII	HAW.	360A-02-10	2012	12	14

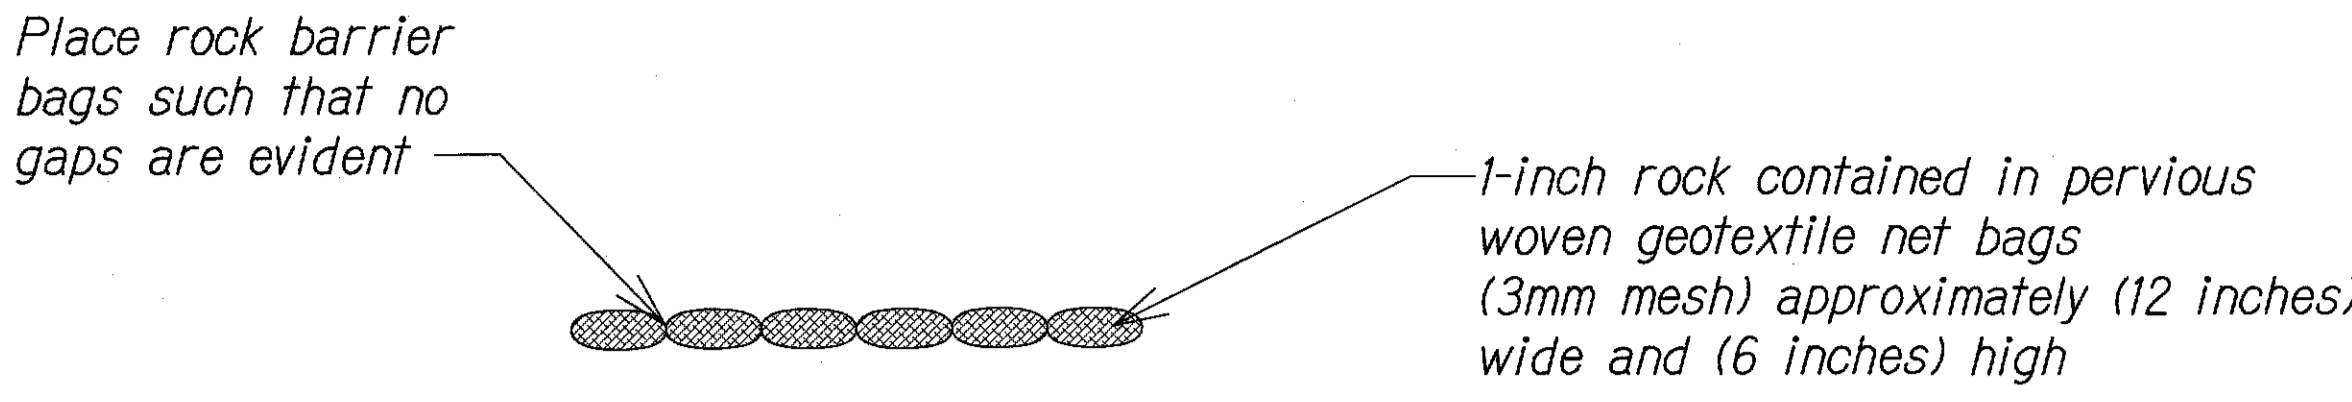


PLAN

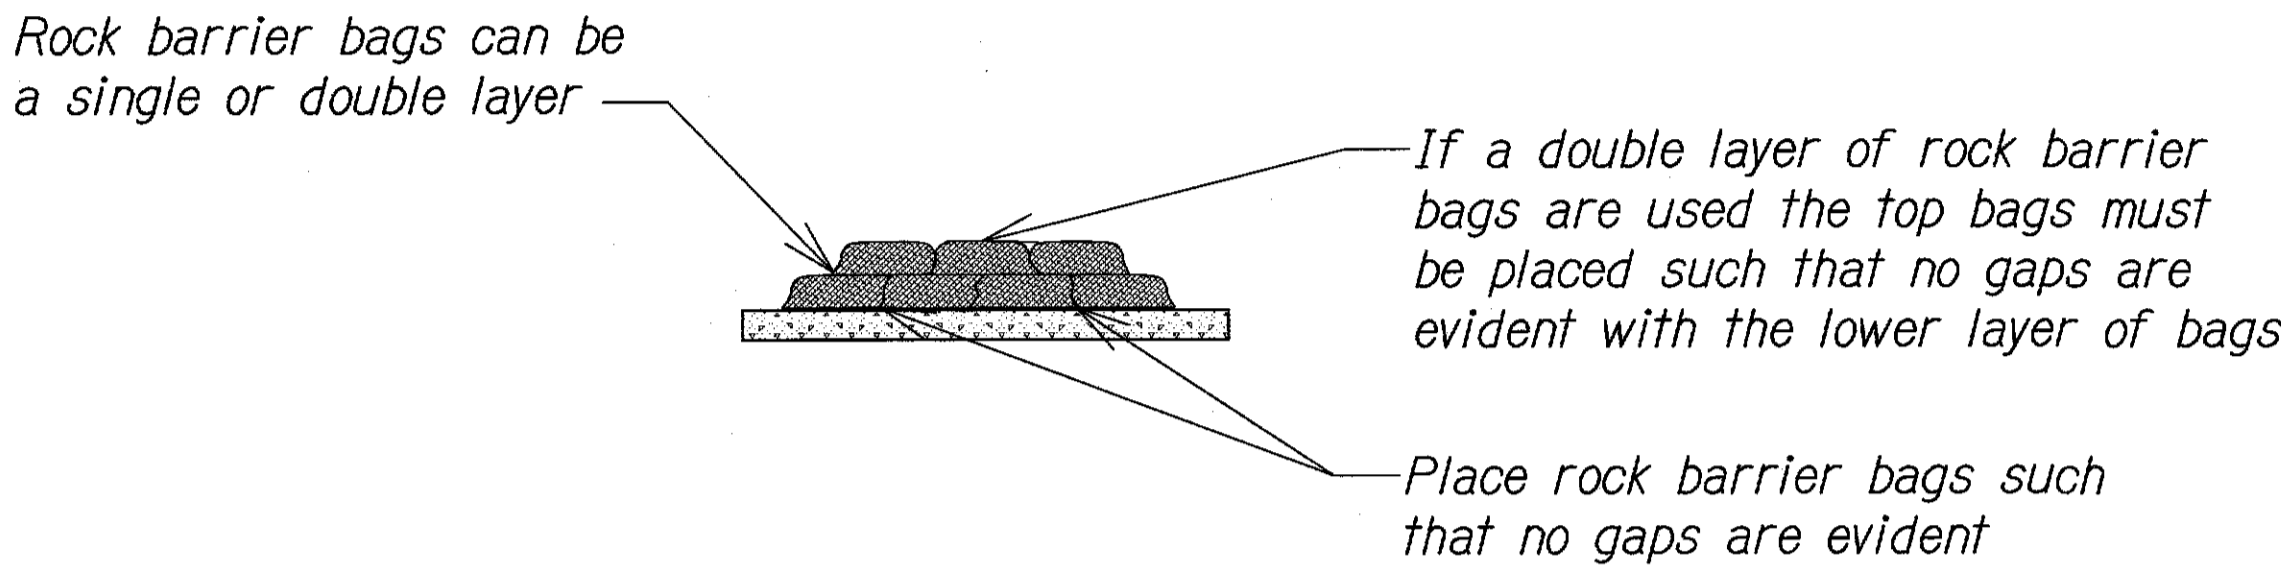

SIDE VIEW

NOTE:
In the event of above normal rainfall, contractor shall remove inlet protection and replace after event has passed. See Water Pollution and Erosion Control Notes on Plan Sheet No. 5.

GEOTEXTILE ROCKBAG PROTECTION
N.T.S.

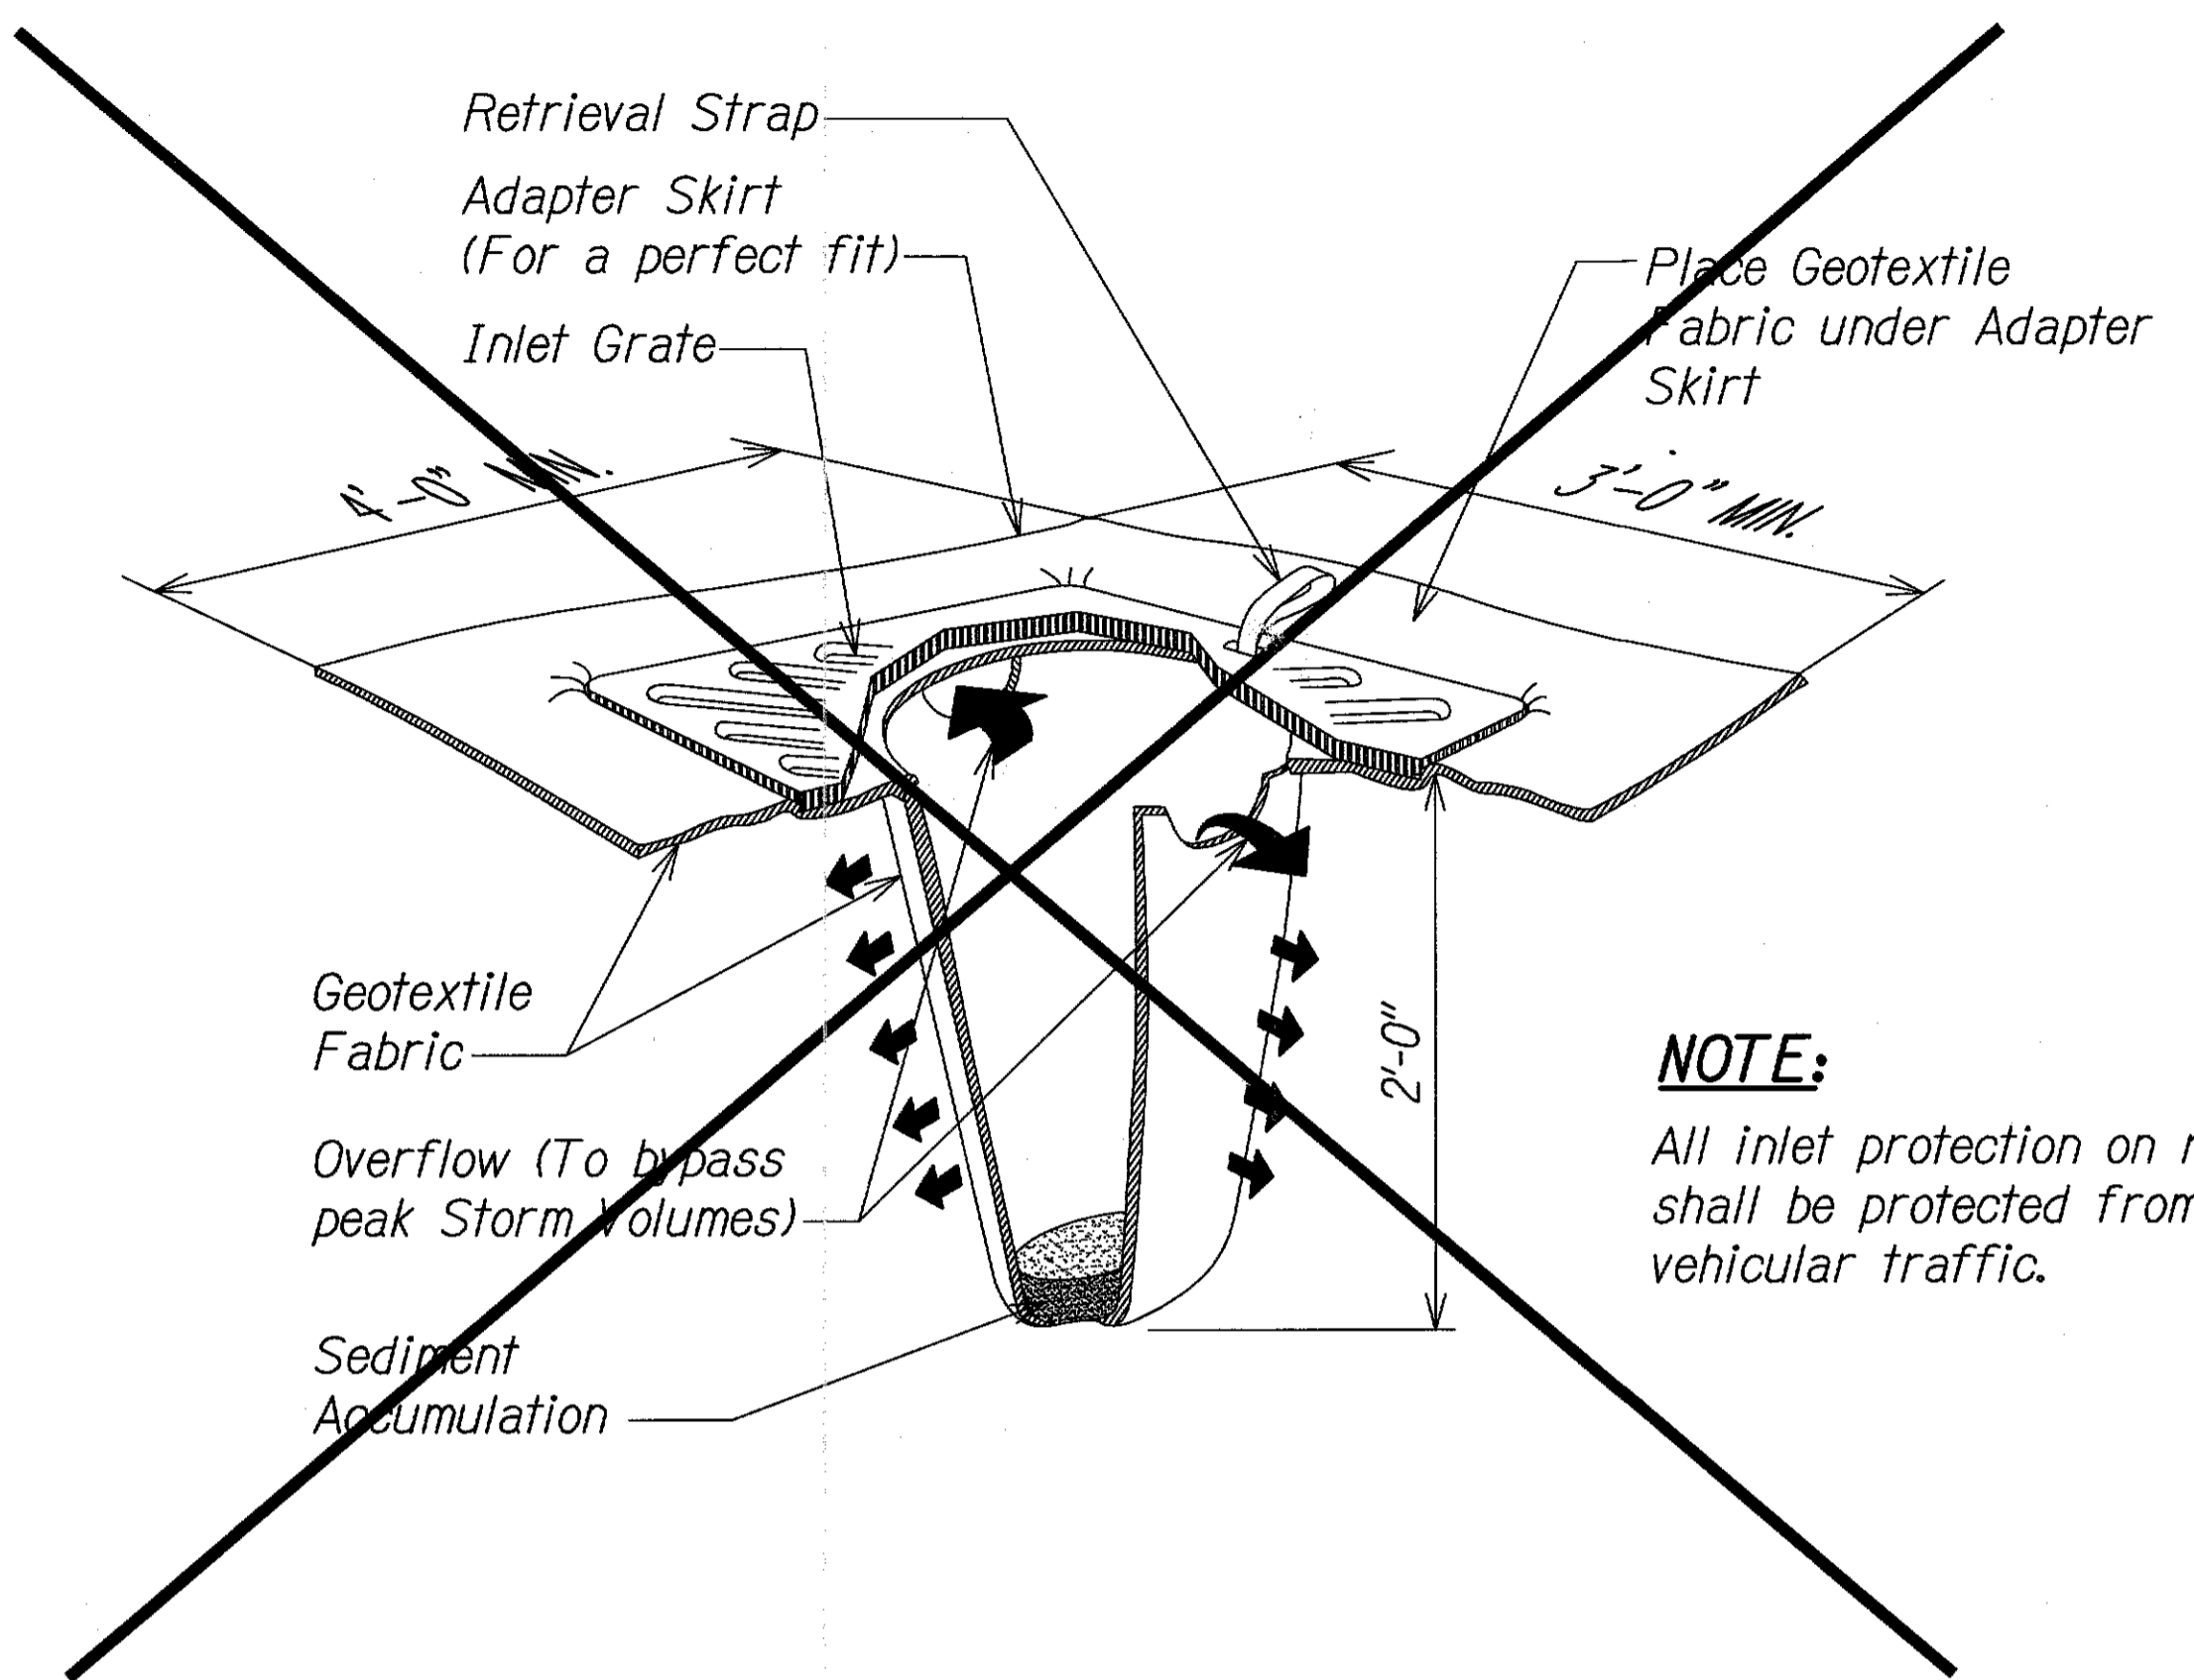


NOTE:
All inlet protection on road shoulders shall be protected from damage by vehicular traffic.

TEMPORARY INLET PROTECTION DETAIL
N.T.S.

LEGEND FOR AS-BUILT POSTINGS

	Squiggly line for as-built deletion
	Double line for as-built deletion
Roadway	Text for as-built posting

GRAPHICAL SCALE:
20' 10' 0 20' 40'
SCALE: 1" = 20'

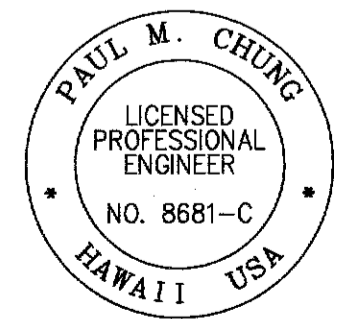

THIS WORK WAS PREPARED BY ME OR UNDER MY SUPERVISION

SIGNATURE: EXPIRATION DATE OF THE LICENSE: 04/30/12

STATE OF HAWAII
DEPARTMENT OF TRANSPORTATION
HIGHWAYS DIVISION

EROSION CONTROL DETAIL

HANA HIGHWAY DRAINAGE IMPROVEMENTS
Vicinity of Hoolawa Bridge
Project No. 360A-02-10

Scale: AS NOTED Date: May 10, 2012
SHEET No. 1 OF 1 SHEETS

"AS-BUILT"

ORIGINAL PLAN	SURVEY PLOTTED BY	DATE
NOTE BOOK	DRAWN BY	
No.	DESIGNED BY	
	QUANTITIES BY	
	CHECKED BY	

W:_CIVIL 3D PROJECTS\2006_173_001 SOH HANA HWY DRAINAGE IMPROVEMENTS\AS-BUILT DRAWINGS\12 EROSION CONTROL DETAIL.DWG 3/17/2014 4:51 PM