

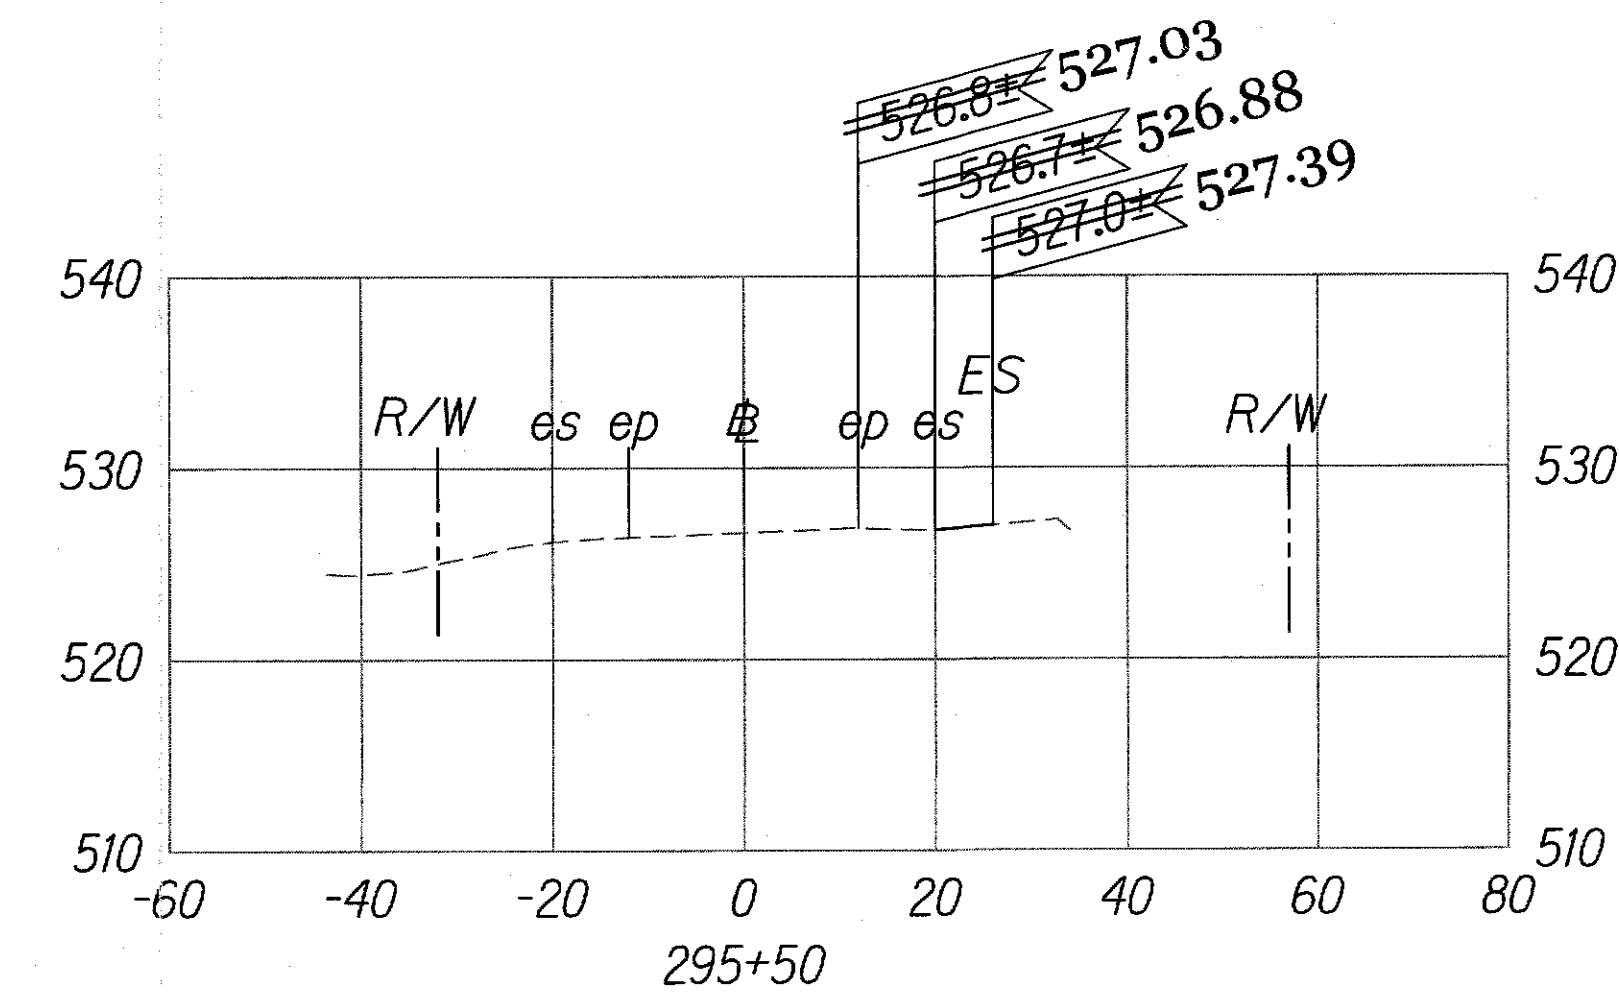
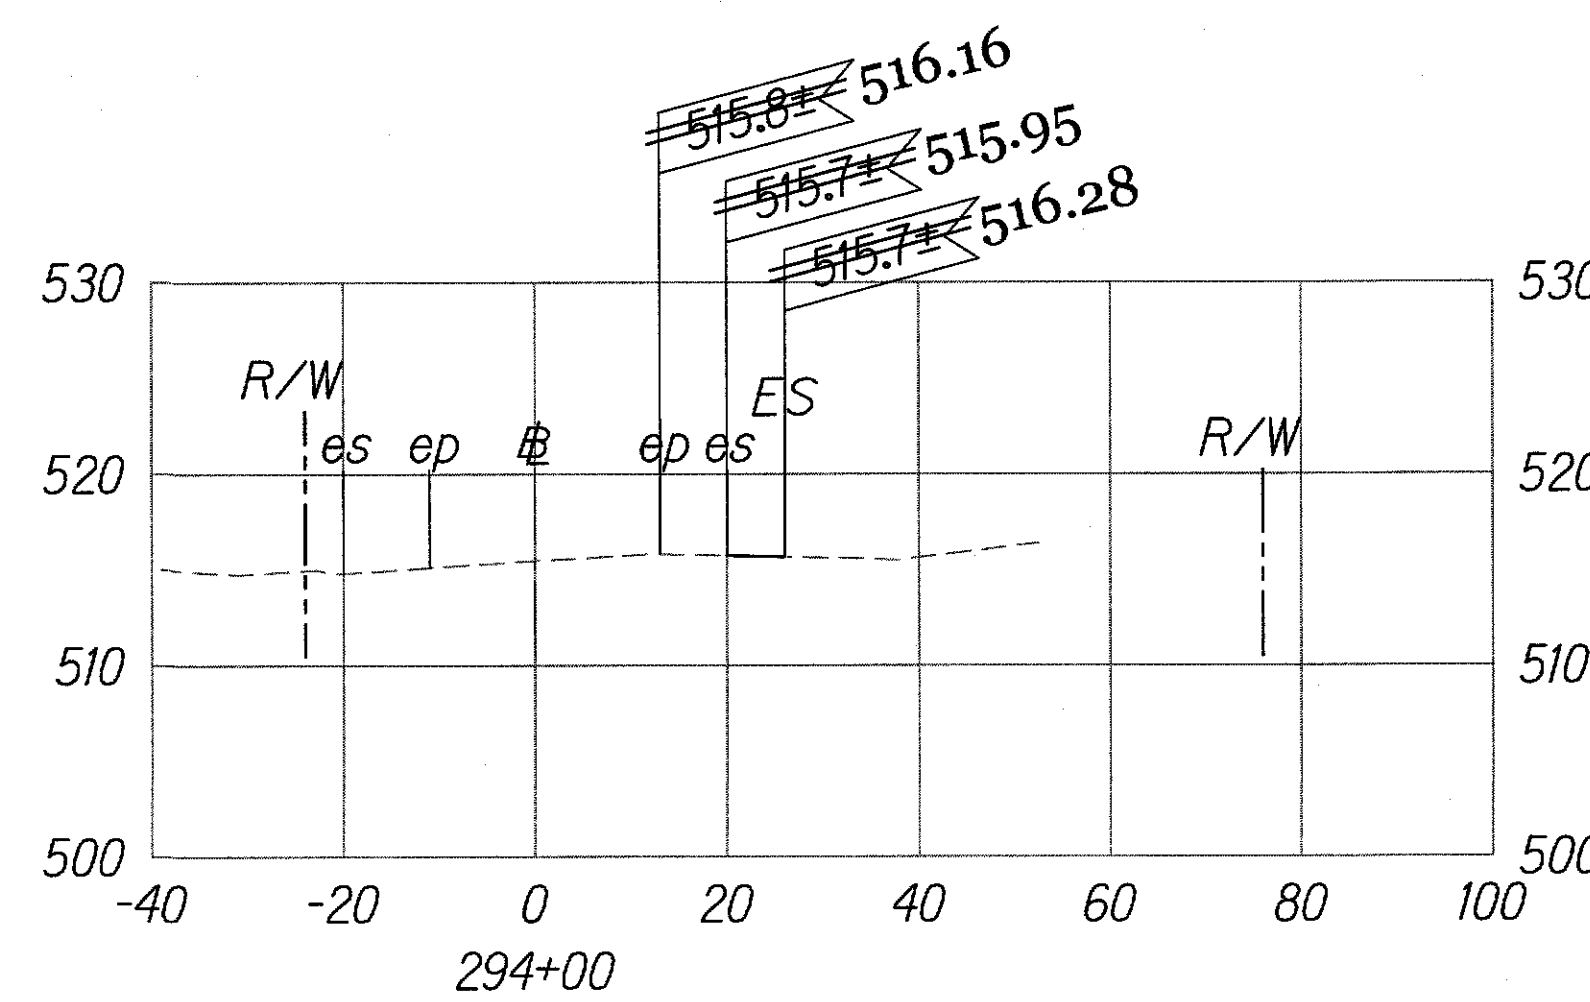
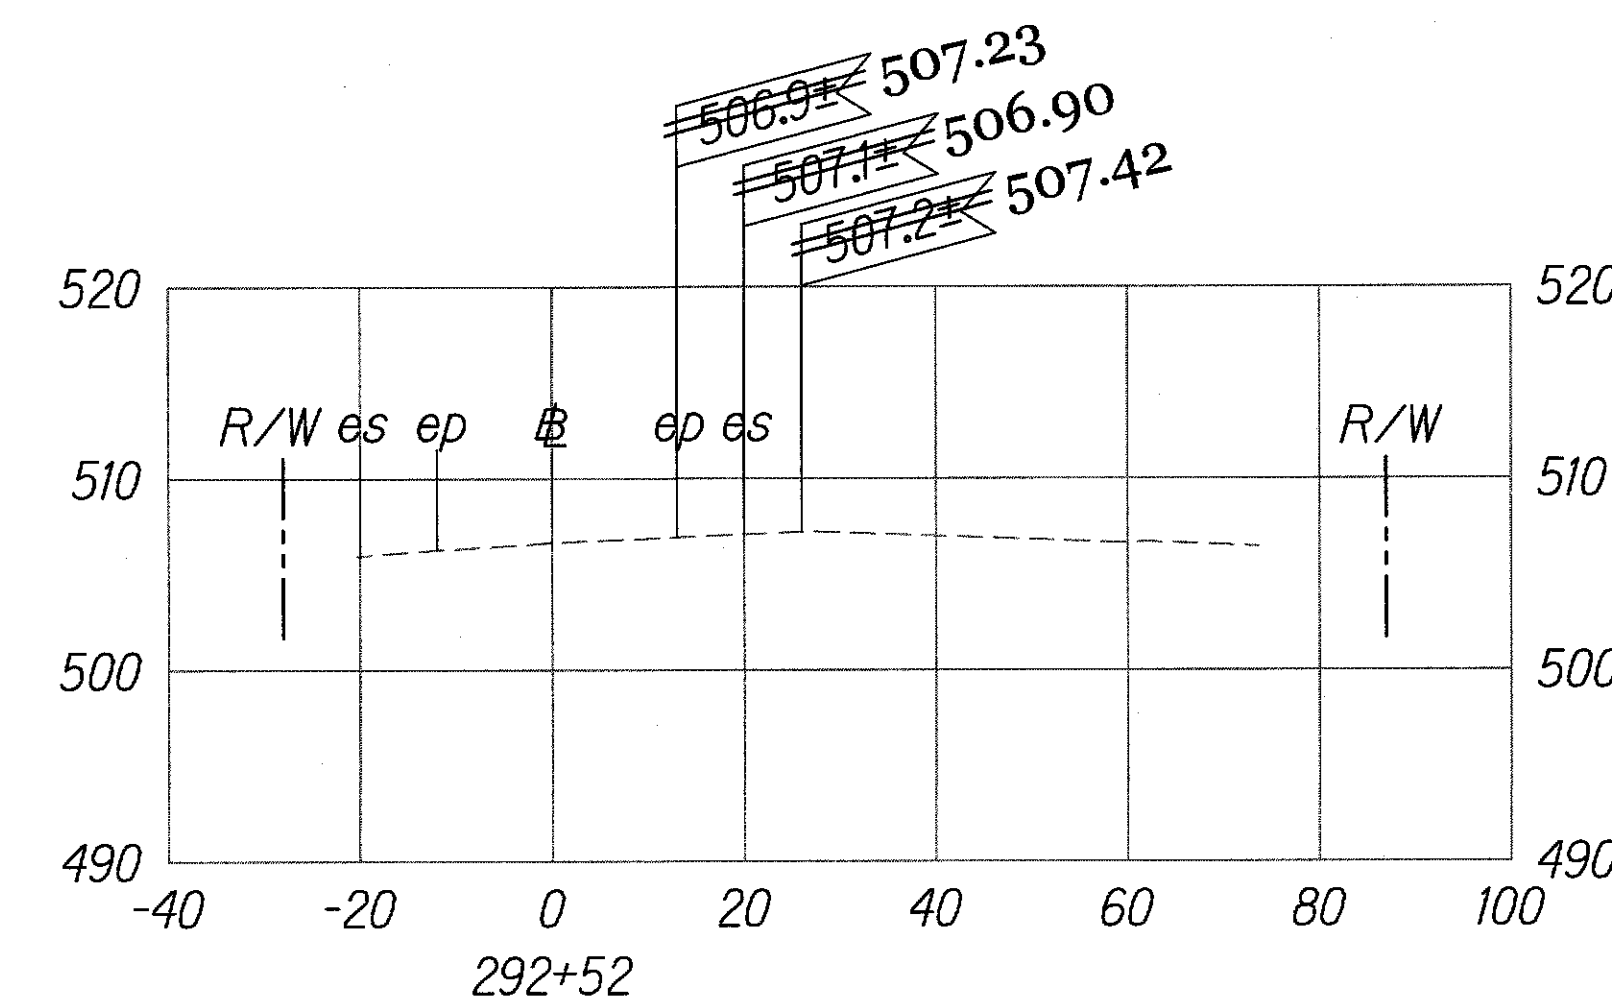
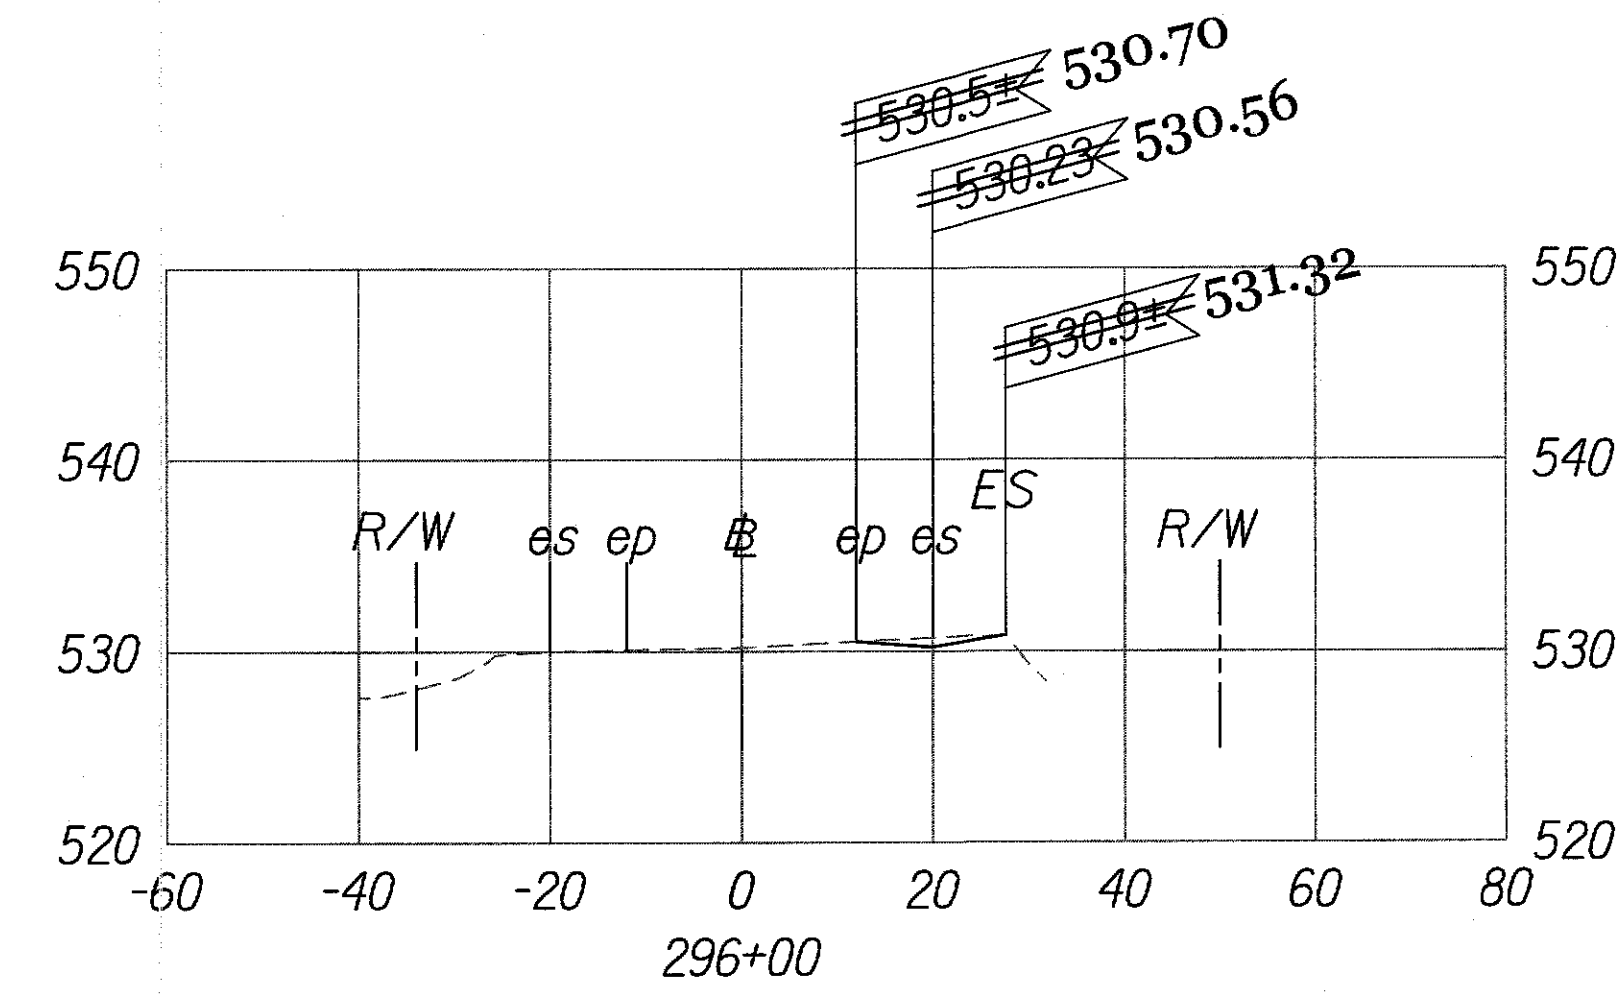
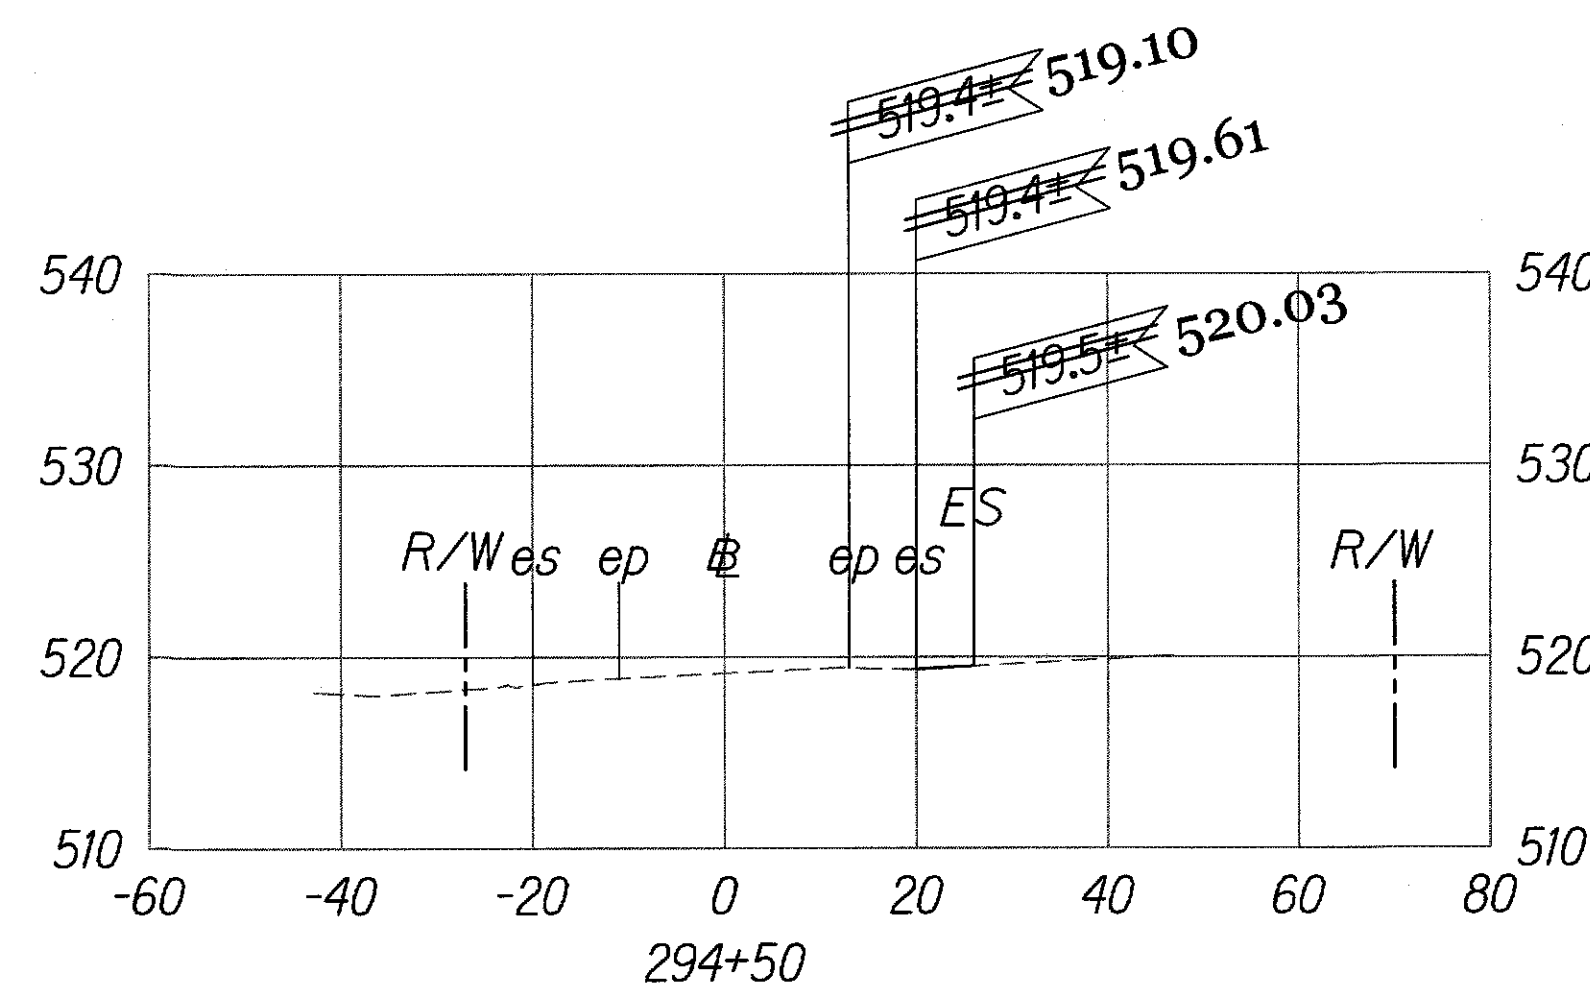
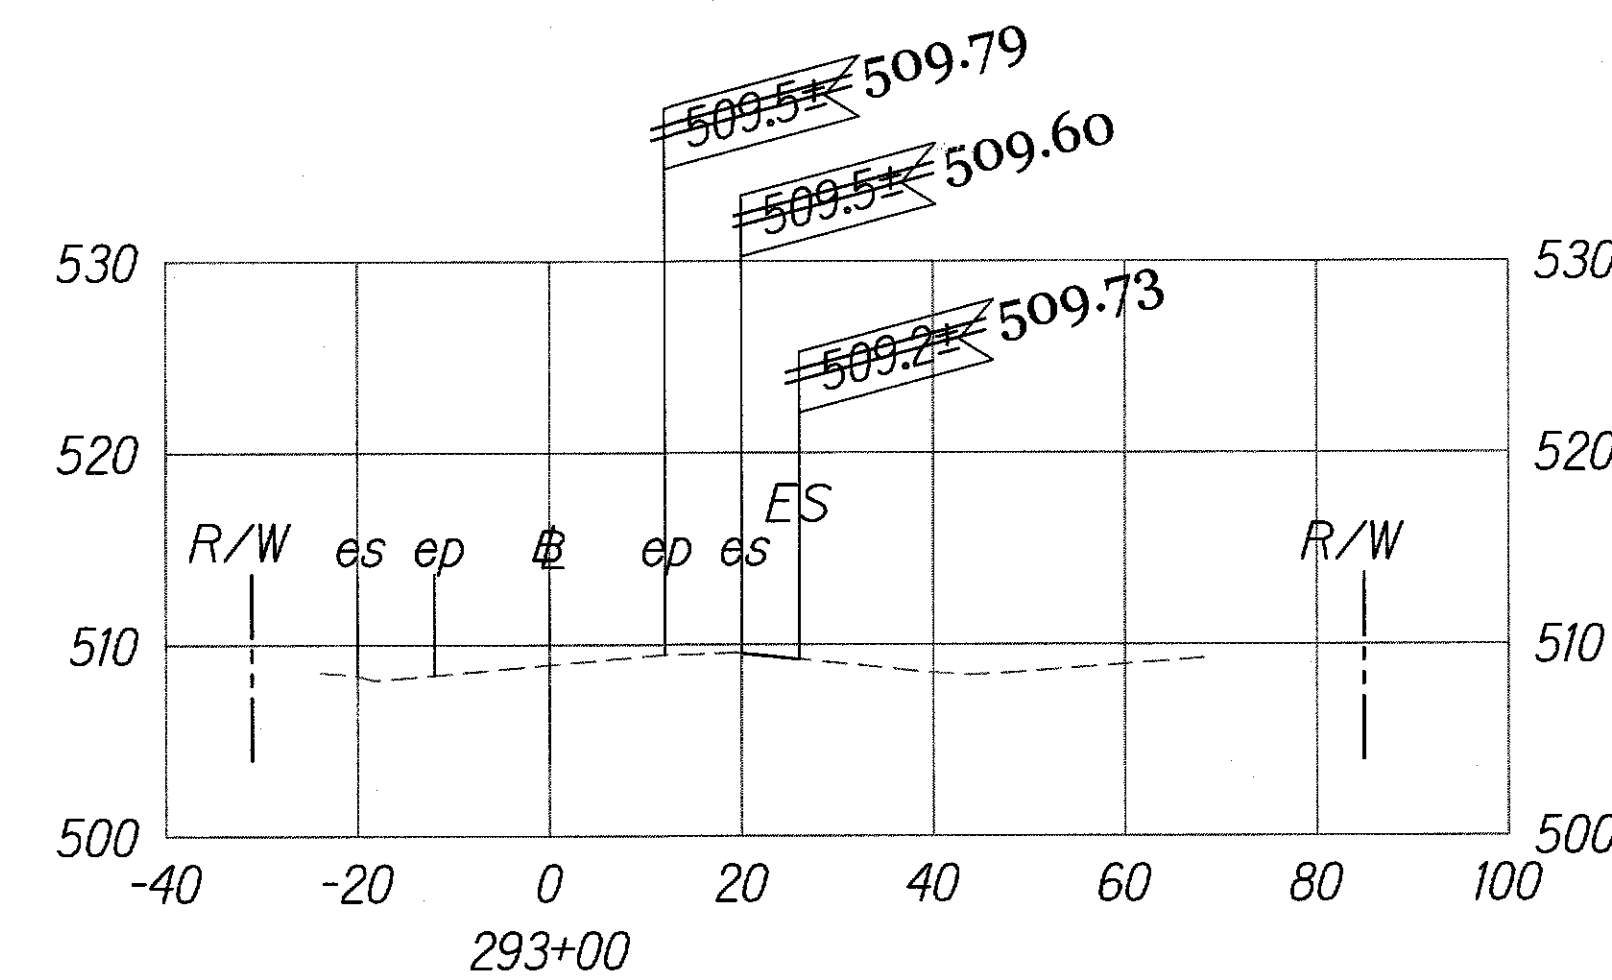
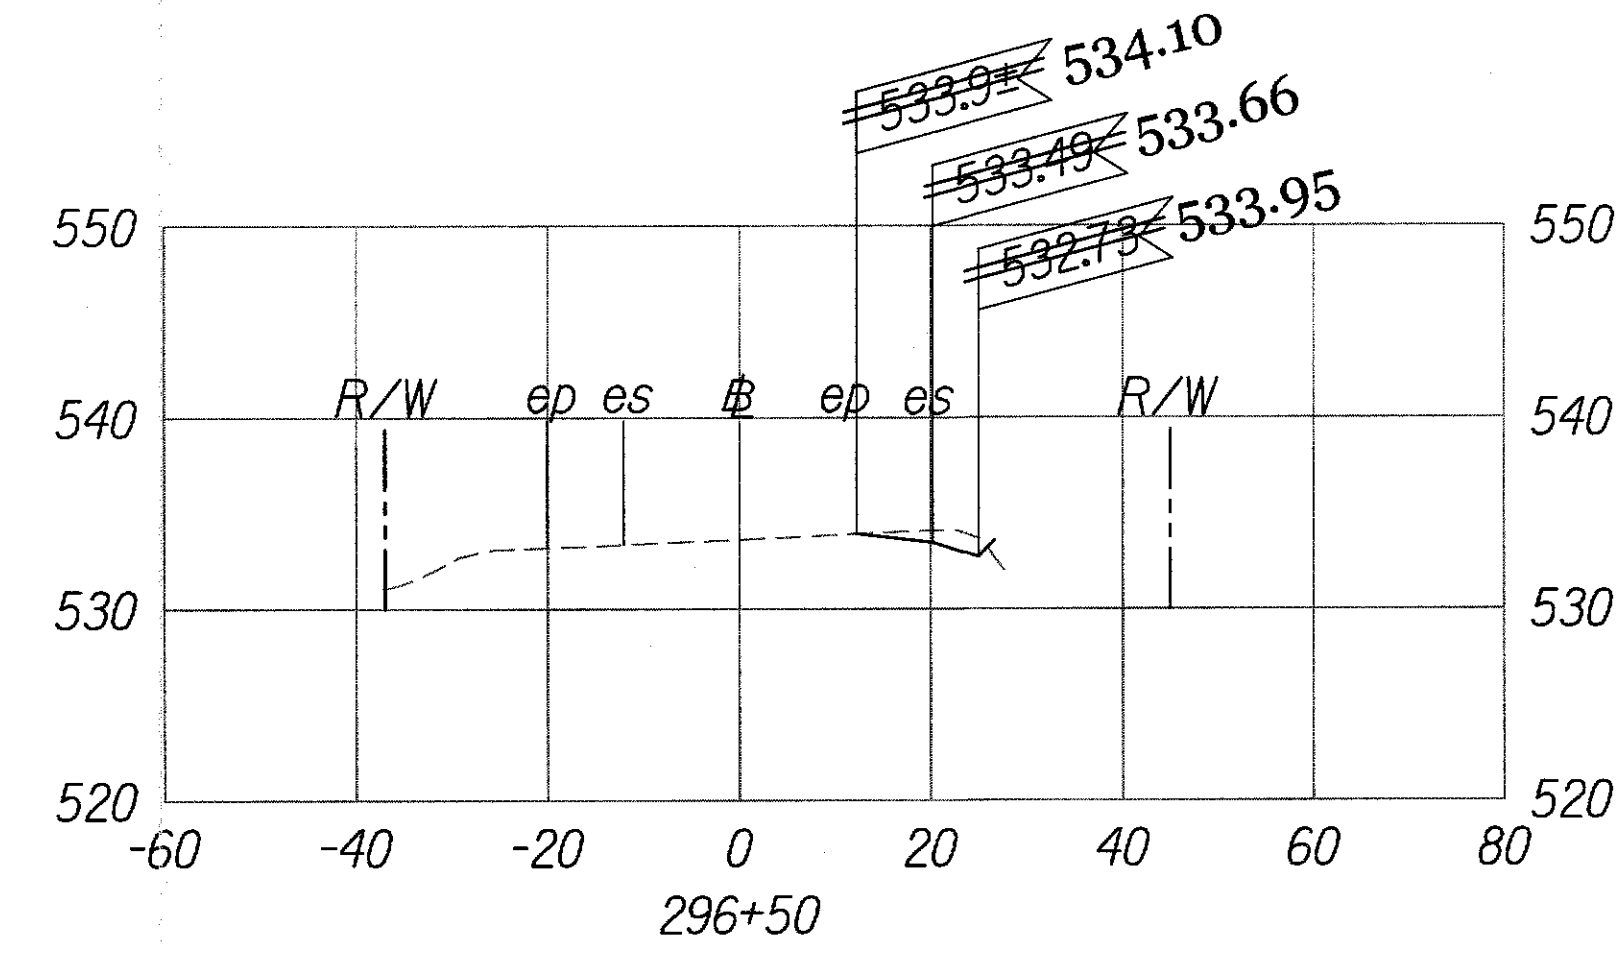
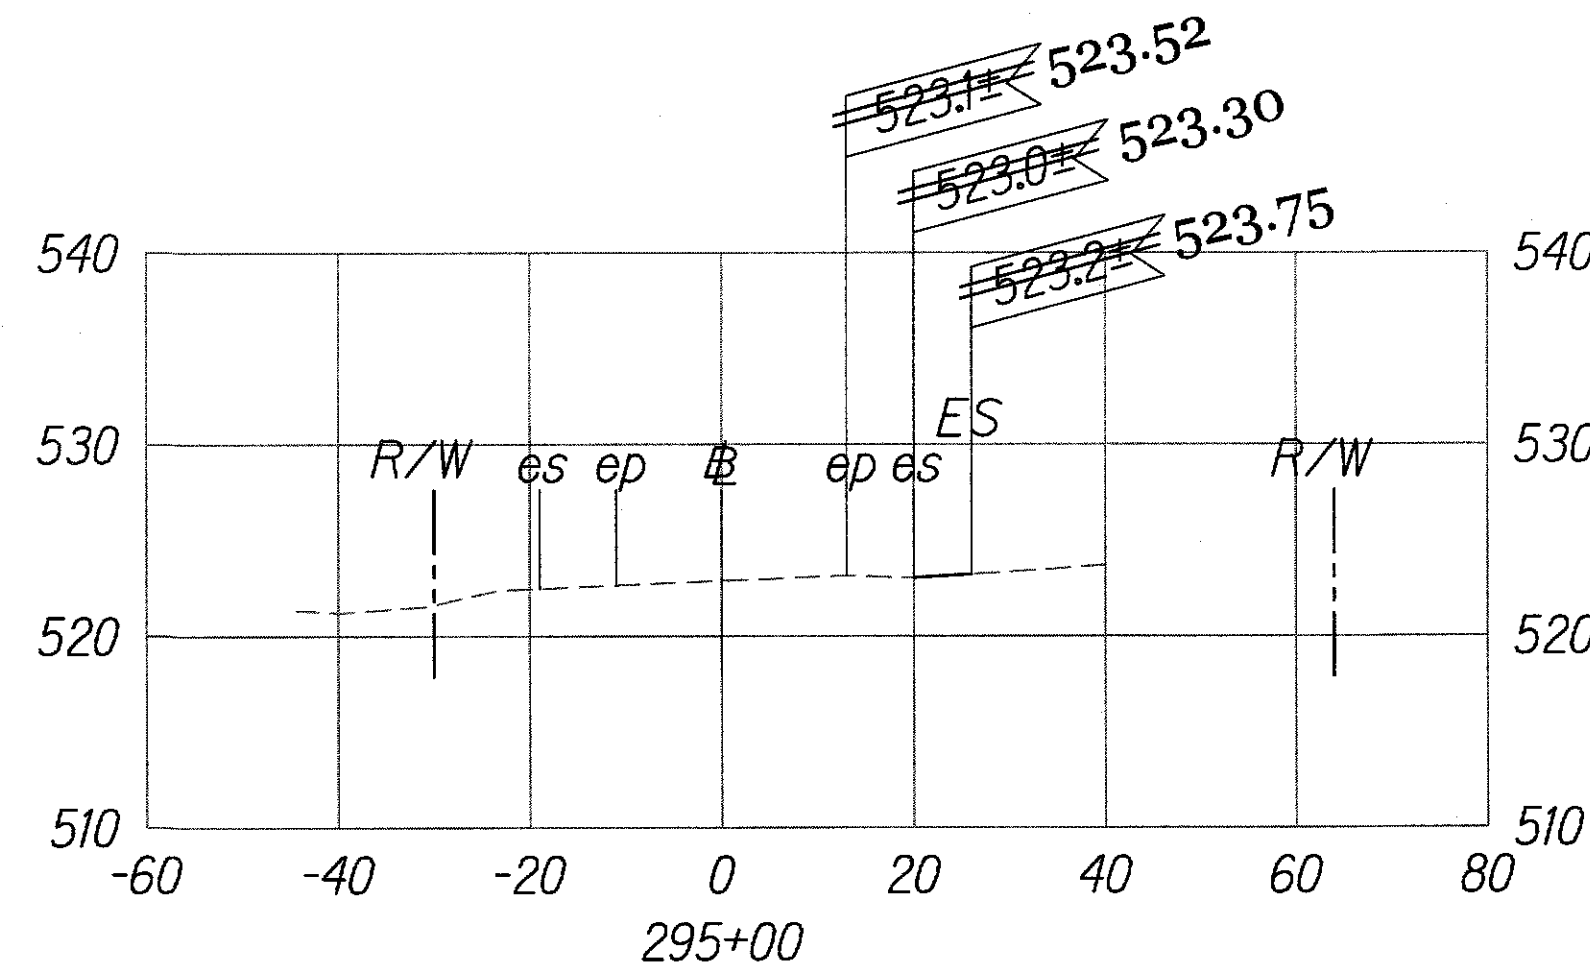


FED. ROAD DIST. NO.	STATE	PROJ. NO.	FISCAL YEAR	SHEET NO.	TOTAL SHEETS
HAWAII	HAW.	360A-02-10	2012	13	14

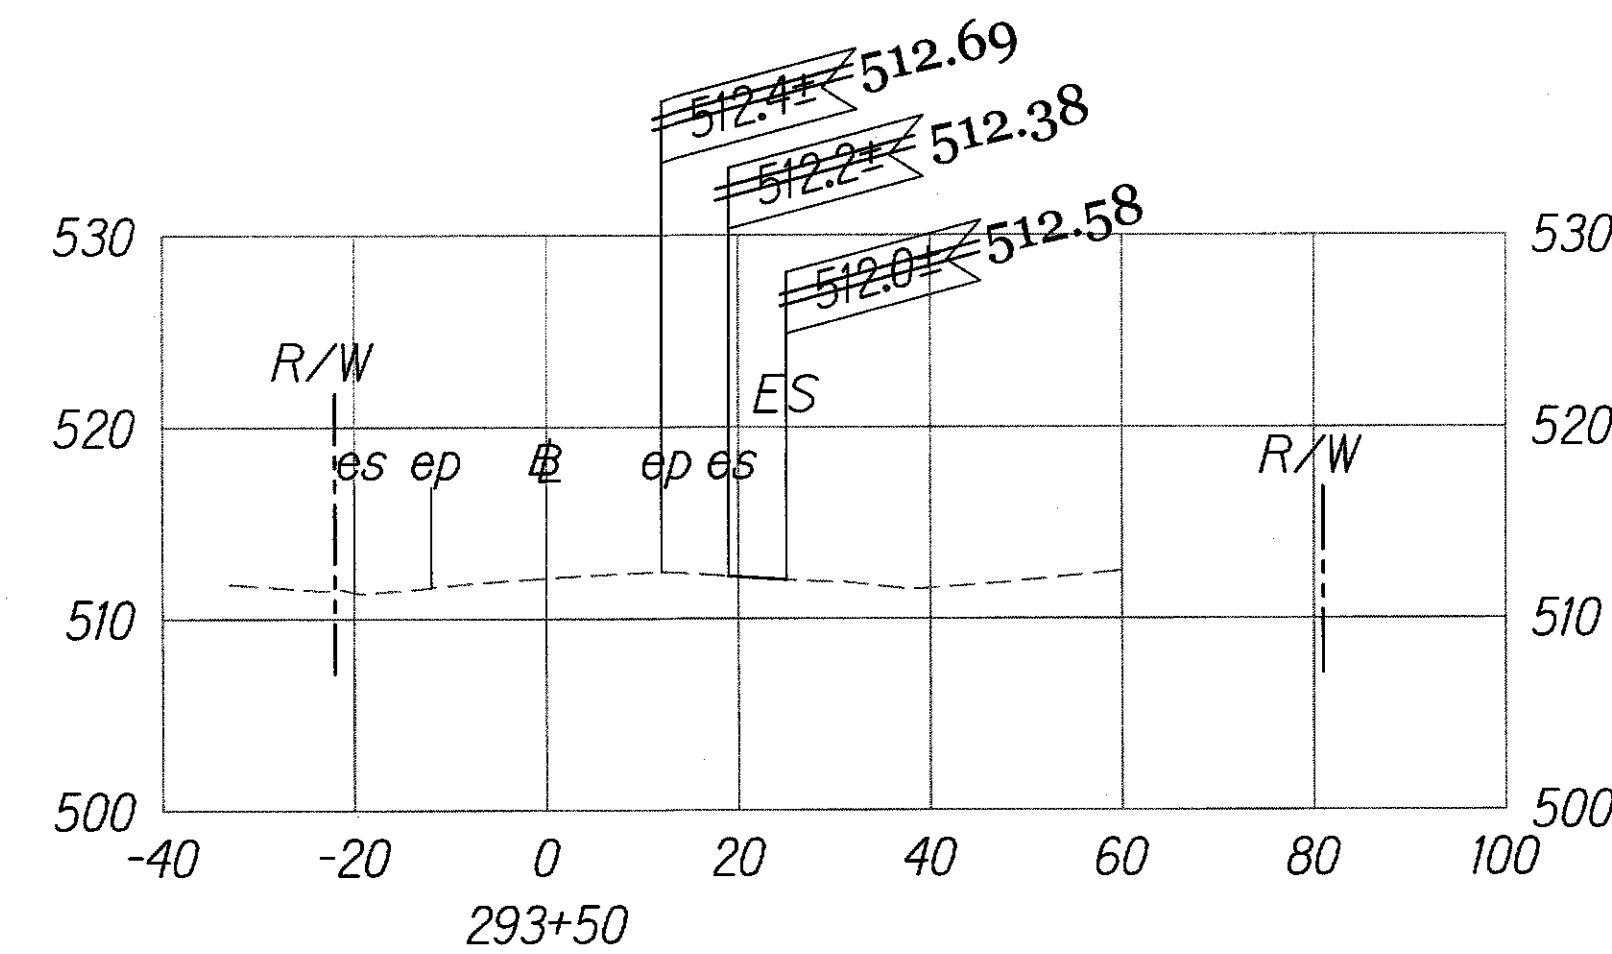


GRAPHICAL SCALE:

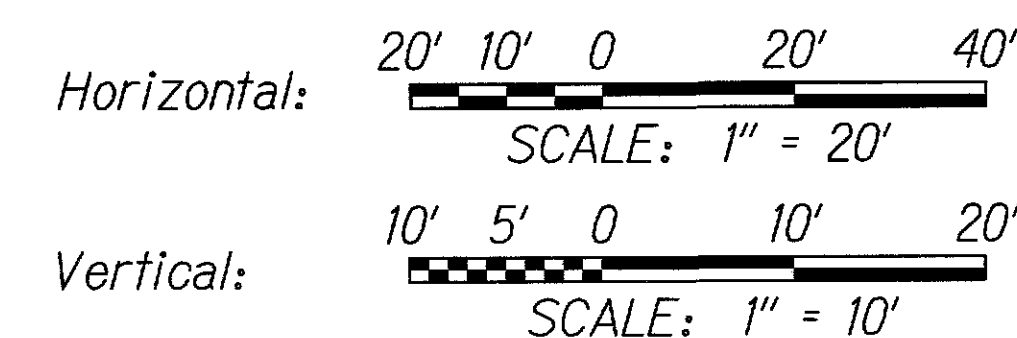

SECTIONS SCALE: HORIZ 1" = 20' VERT 1" = 10'

LEGEND FOR AS-BUILT POSTINGS

- Quiggly line for as-built deletion
- Double line for as-built deletion
- Text for as-built posting

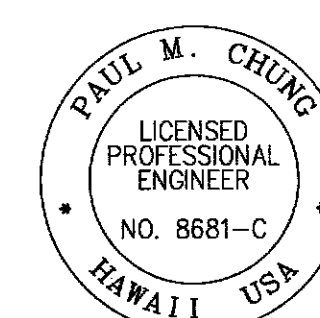

THIS WORK WAS PREPARED BY ME OR UNDER MY SUPERVISION

SIGNATURE: [Signature] EXPIRATION DATE OF THE LICENSE: 04/30/12

STATE OF HAWAII
DEPARTMENT OF TRANSPORTATION
HIGHWAYS DIVISION

ROAD CROSS SECTIONS

HANA HIGHWAY DRAINAGE IMPROVEMENTS
Vicinity of Hoolawa Bridge





Project No. 360A-02-10

Scale: AS NOTED Date: May 10, 2012
SHEET No. 1 OF 2 SHEETS


"AS-BUILT"


13

FED. ROAD DIST. NO.	STATE	PROJ. NO.	FISCAL YEAR	SHEET NO.	TOTAL SHEETS
HAWAII	HAW.	360A-02-10	2012	14	14

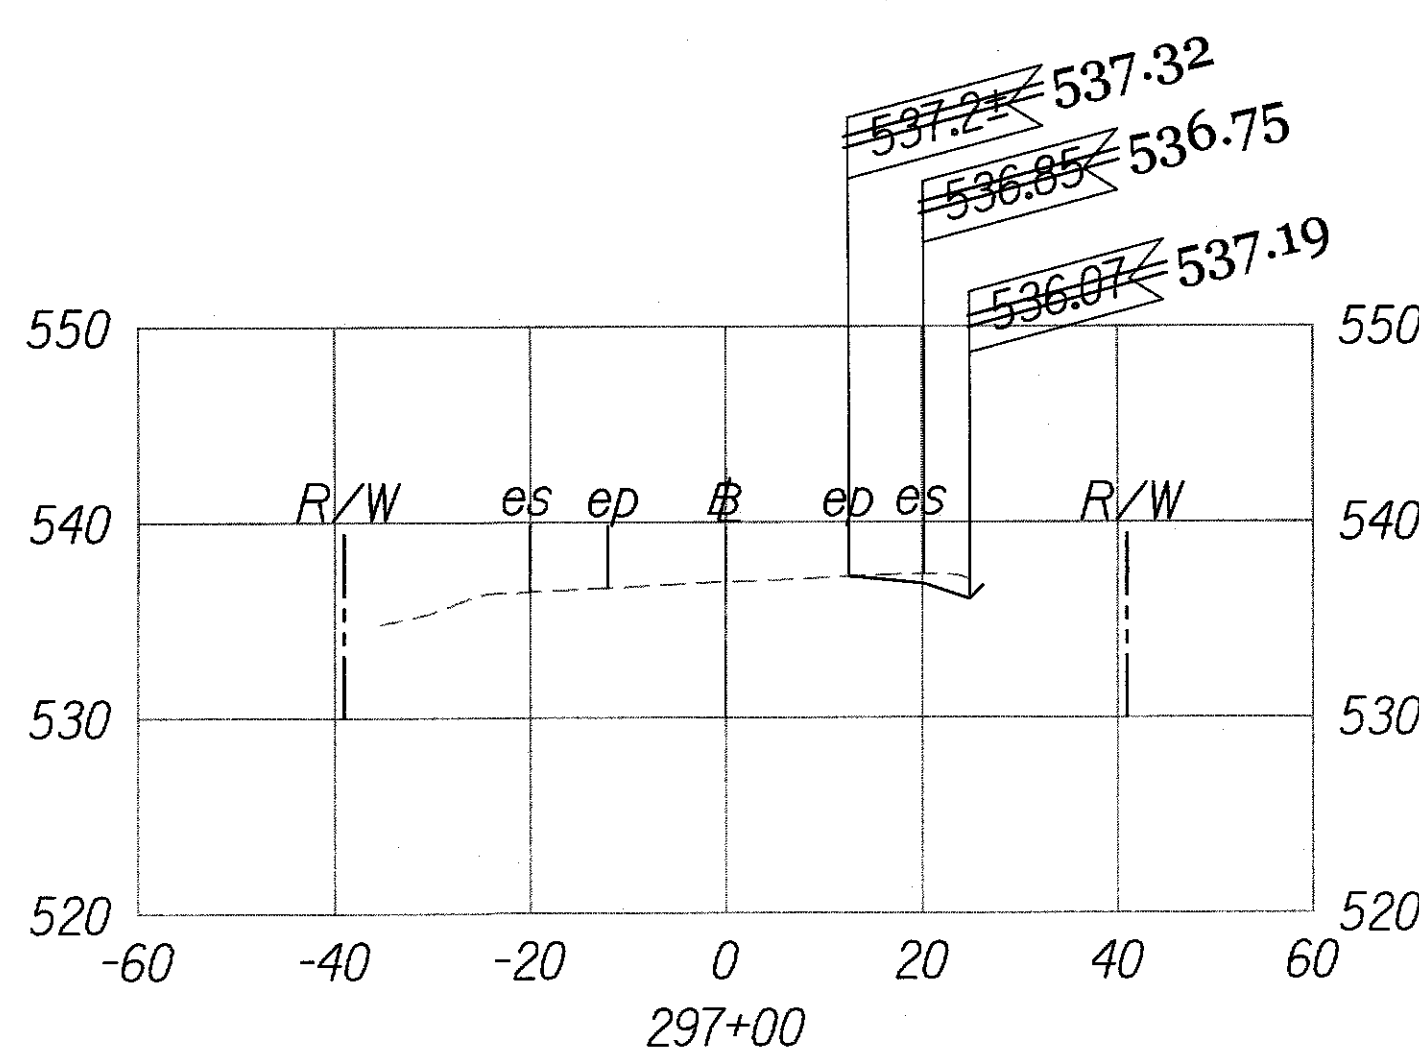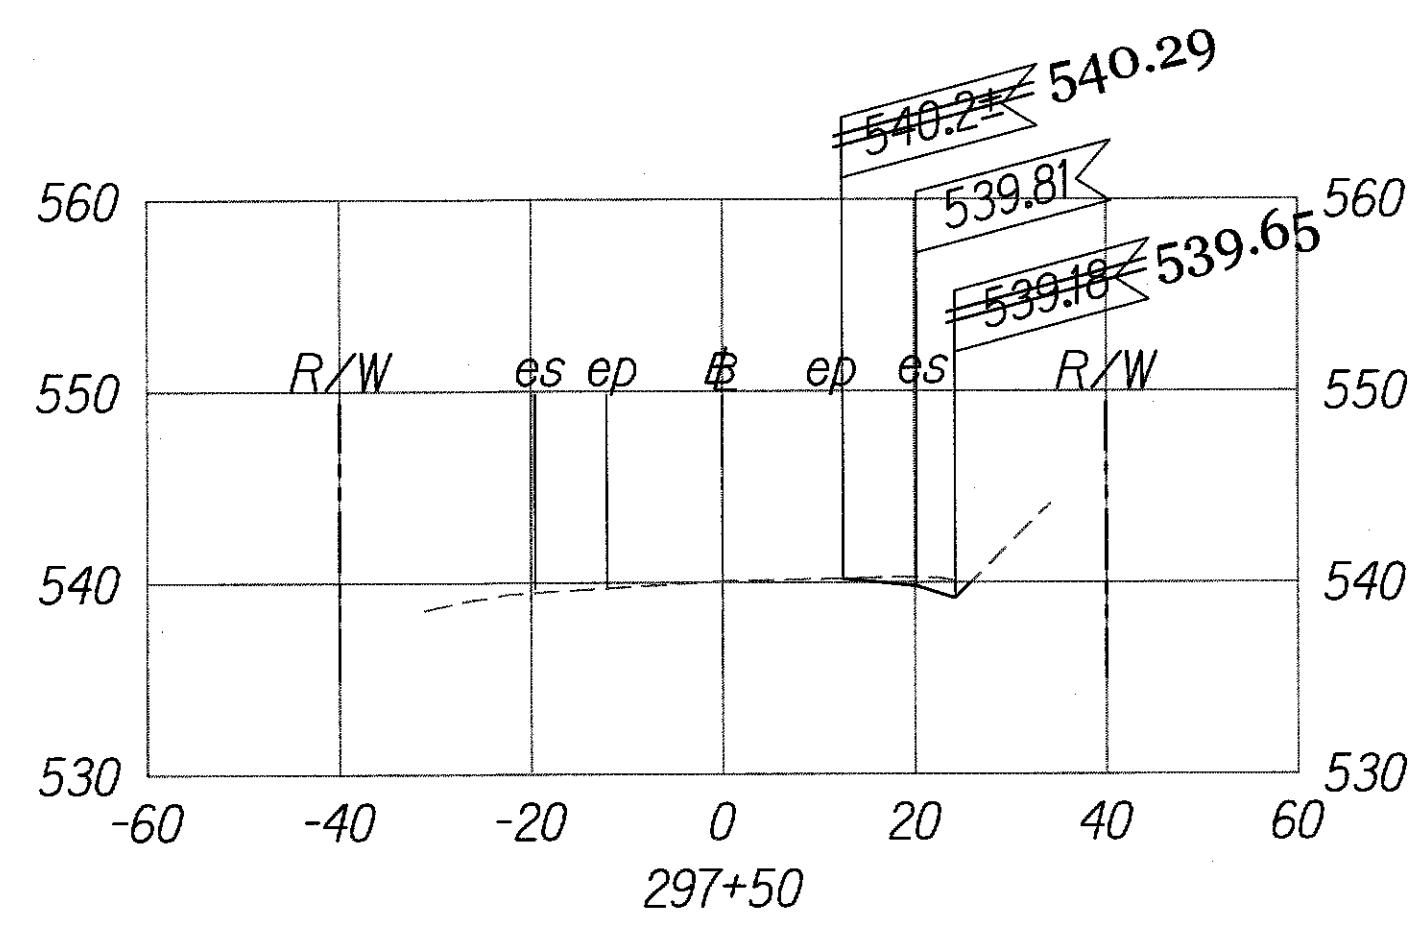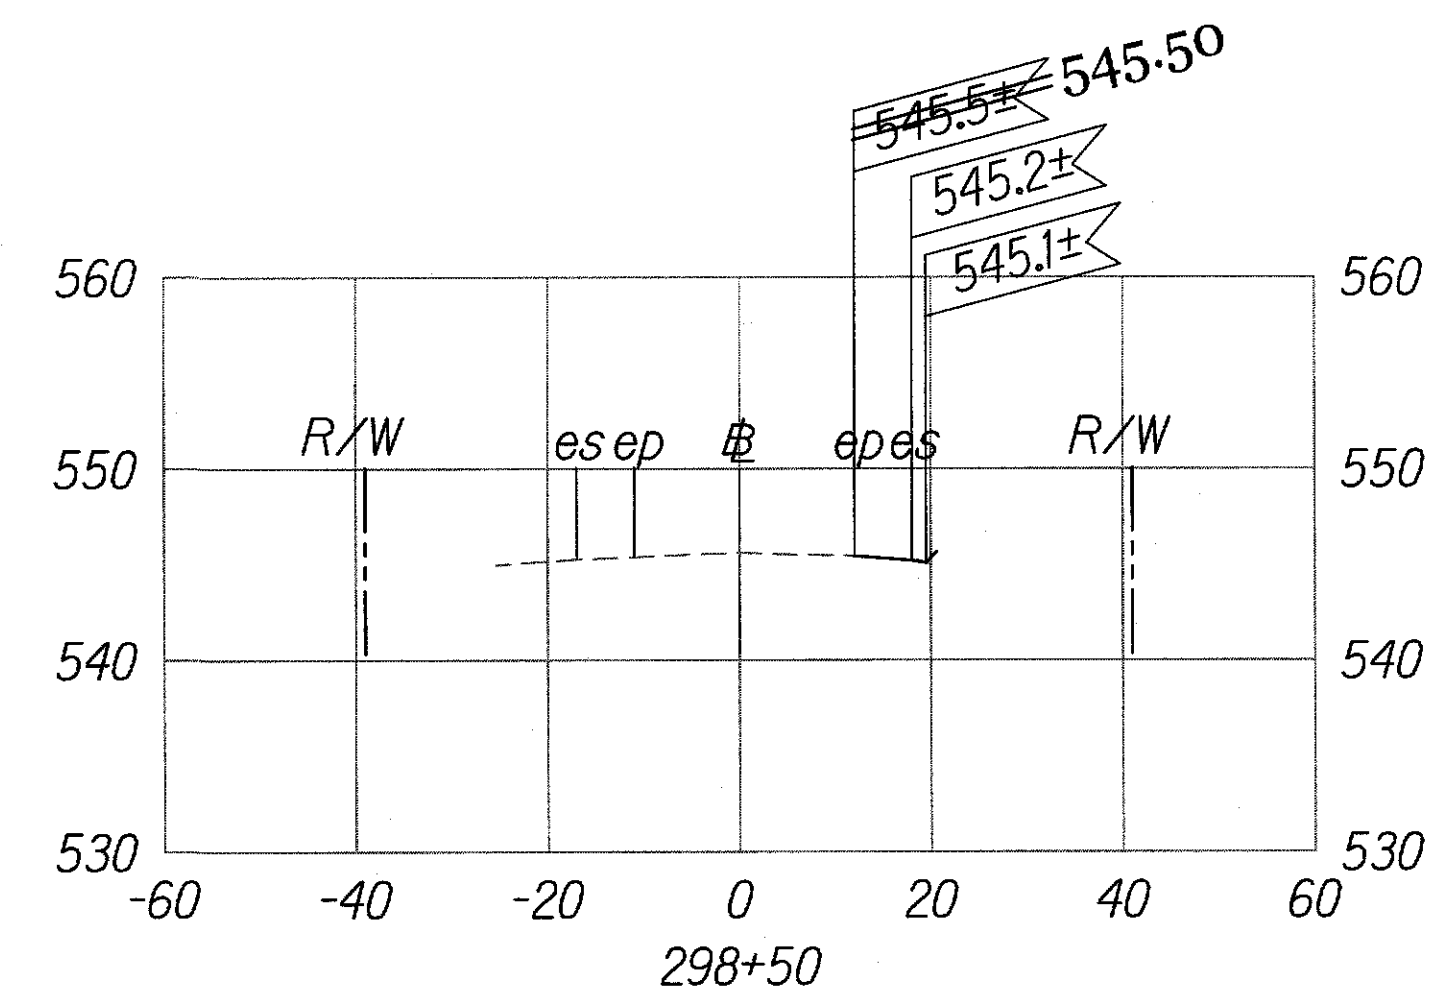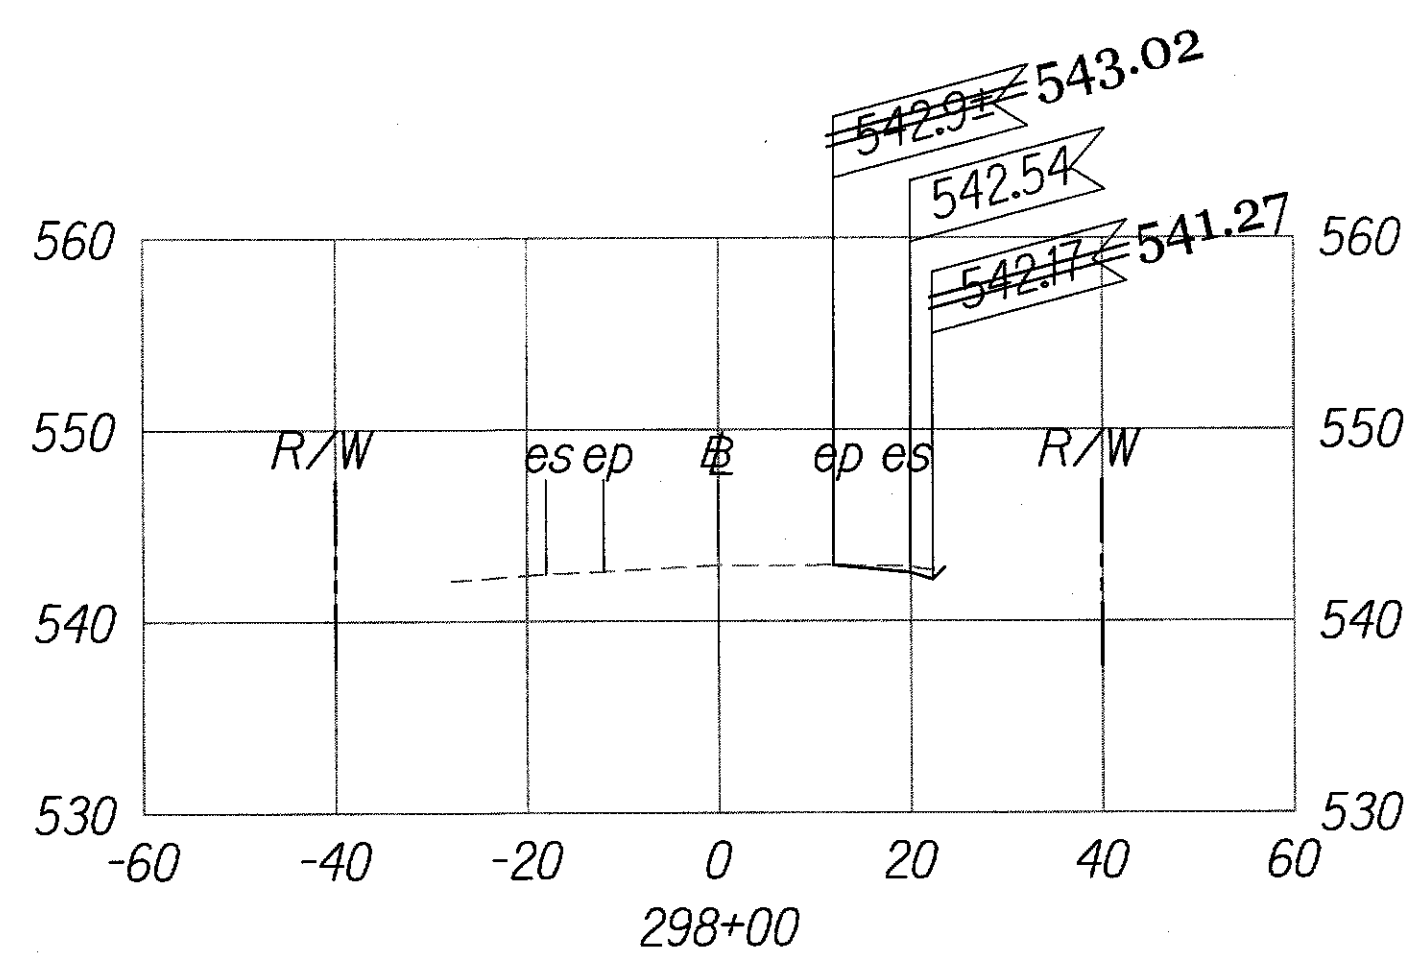


LEGEND FOR AS-BUILT POSTINGS

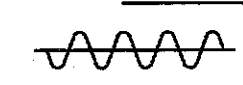 Squiggly line for as-built deletion

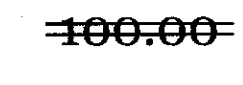
 Double line for as-built deletion

Roadway Text for as-built posting

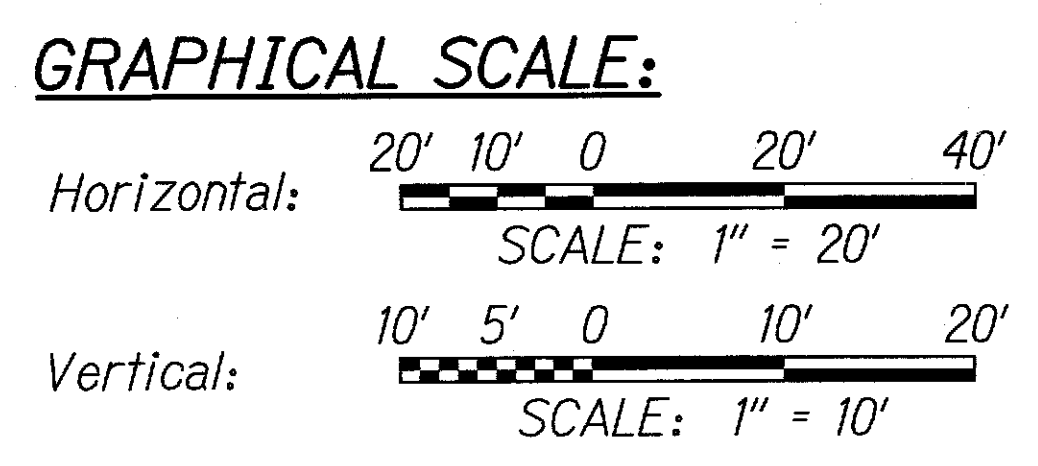


DATE	3/17/2014 4:22 PM
SURVEY DOTTED BY	
DRAWN BY	
TRACED BY	
DESIGNED BY	
QUANTITIES BY	
CHECKED BY	

SECTIONS
SCALE: HORIZ 1" = 20'
VERT 1" = 10'

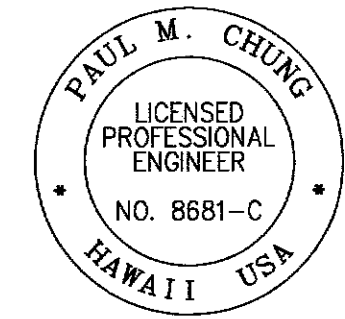

THIS WORK WAS PREPARED BY ME OR UNDER MY SUPERVISION

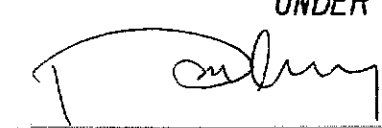 04/30/12
SIGNATURE EXPIRATION DATE OF THE LICENSE

STATE OF HAWAII
DEPARTMENT OF TRANSPORTATION
HIGHWAYS DIVISION

ROAD CROSS SECTIONS

HANA HIGHWAY DRAINAGE IMPROVEMENTS
Vicinity of Hoolawa Bridge
Project No. 360A-02-10

Scale: AS NOTED Date: May 10, 2012

SHEET No. 2 OF 2 SHEETS

"AS-BUILT"