
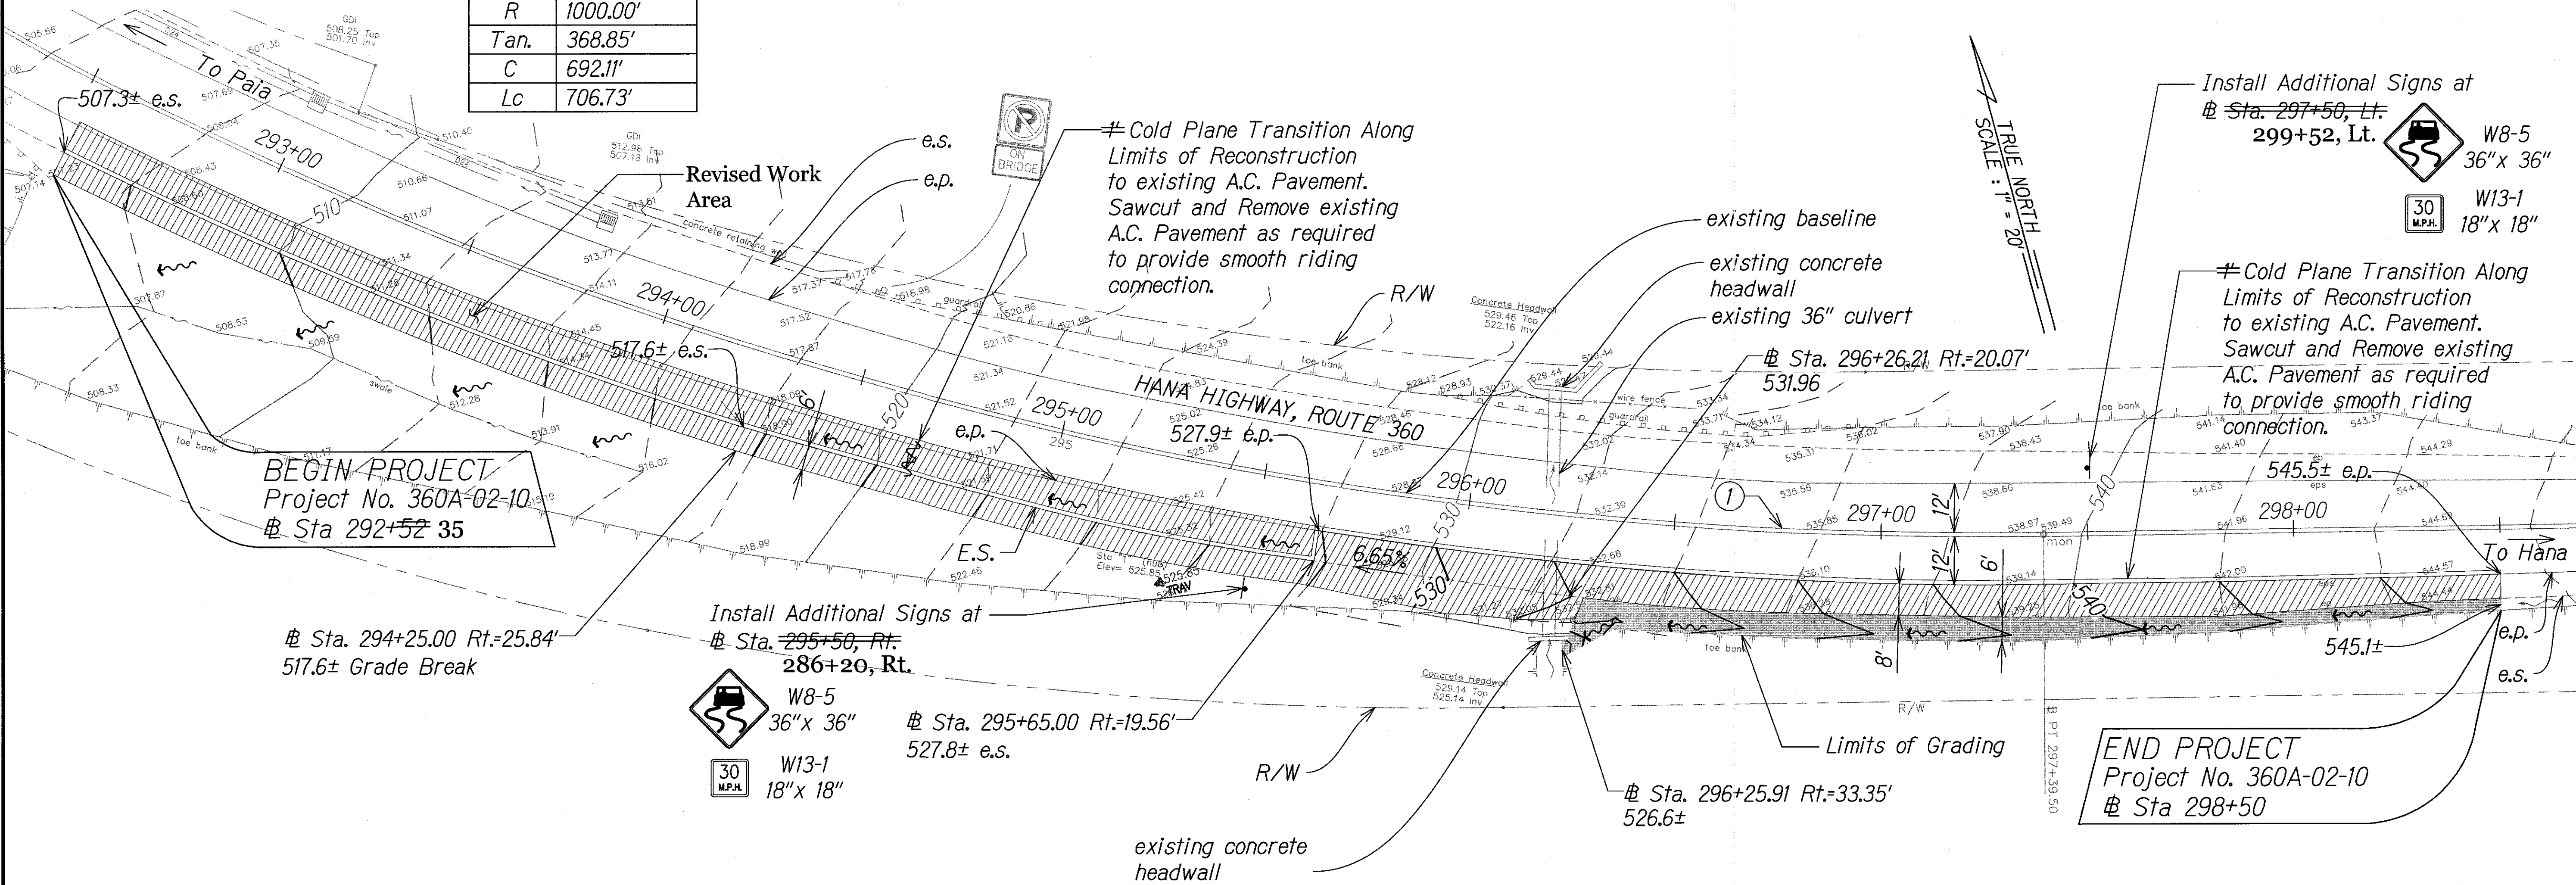
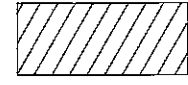
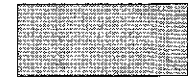
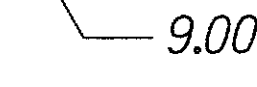
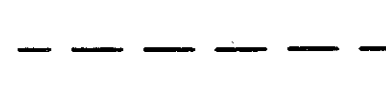


FED. ROAD DIST. NO.	STATE	PROJ. NO.	FISCAL YEAR	SHEET NO.	TOTAL SHEETS
HAWAII	HAW.	360A-02-10	2012	10	14

CURVE	①
Δ	40°29'32.76"
R	1000.00'
Tan.	368.85'
C	692.11'
Lc	706.73'

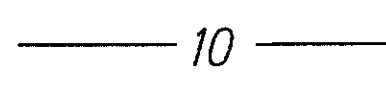

LEGEND:

-  AC Pavement Reconstruction
4" HMA Pavement (Mix IV)
8" AGB
-  New AC Swale
2" HMA Pavement (Mix IV)
-  9.0± existing elevation
-  9.00 Finished Elevation
-  Limits of Grading
-  10 New Contour
-  10 existing contour
-  Direction of Flow



NOTE:

The Contractor Shall Provide an 8" White Edge of Pavement Striping Along With Type C Raised Pavement Markers at 40' O.C. Temporary Striping Shall Be Used As Required During Construction.

Earthwork Summary:


Reconstruction Area: 0.15 Ac
Estimated Excavation: 160 Cu. Yd.

LEGEND FOR AS-BUILT POSTINGS

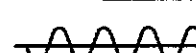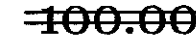-  Squiggly line for as-built deletion
-  Double line for as-built deletion
- Roadway Text for as-built posting

GRAPHICAL SCALE:

20' 10' 0 20' 40'
SCALE: 1" = 20'

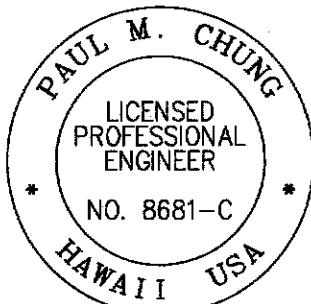

THIS WORK WAS PREPARED BY ME OR UNDER MY SUPERVISION

SIGNATURE

04/30/12
EXPIRATION DATE
OF THE LICENSE

STATE OF HAWAII
DEPARTMENT OF TRANSPORTATION
HIGHWAYS DIVISION
ROADWAY, GRADING AND DRAINAGE PLAN

HANA HIGHWAY DRAINAGE IMPROVEMENTS
Vicinity of Hoolawa Bridge
Project No. 360A-02-10

Scale: 1" = 20' Date: May 10, 2012
SHEET No. 1 OF 1 SHEETS

"AS-BUILT"