
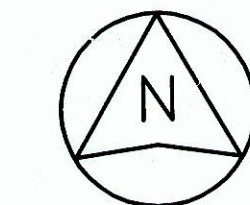
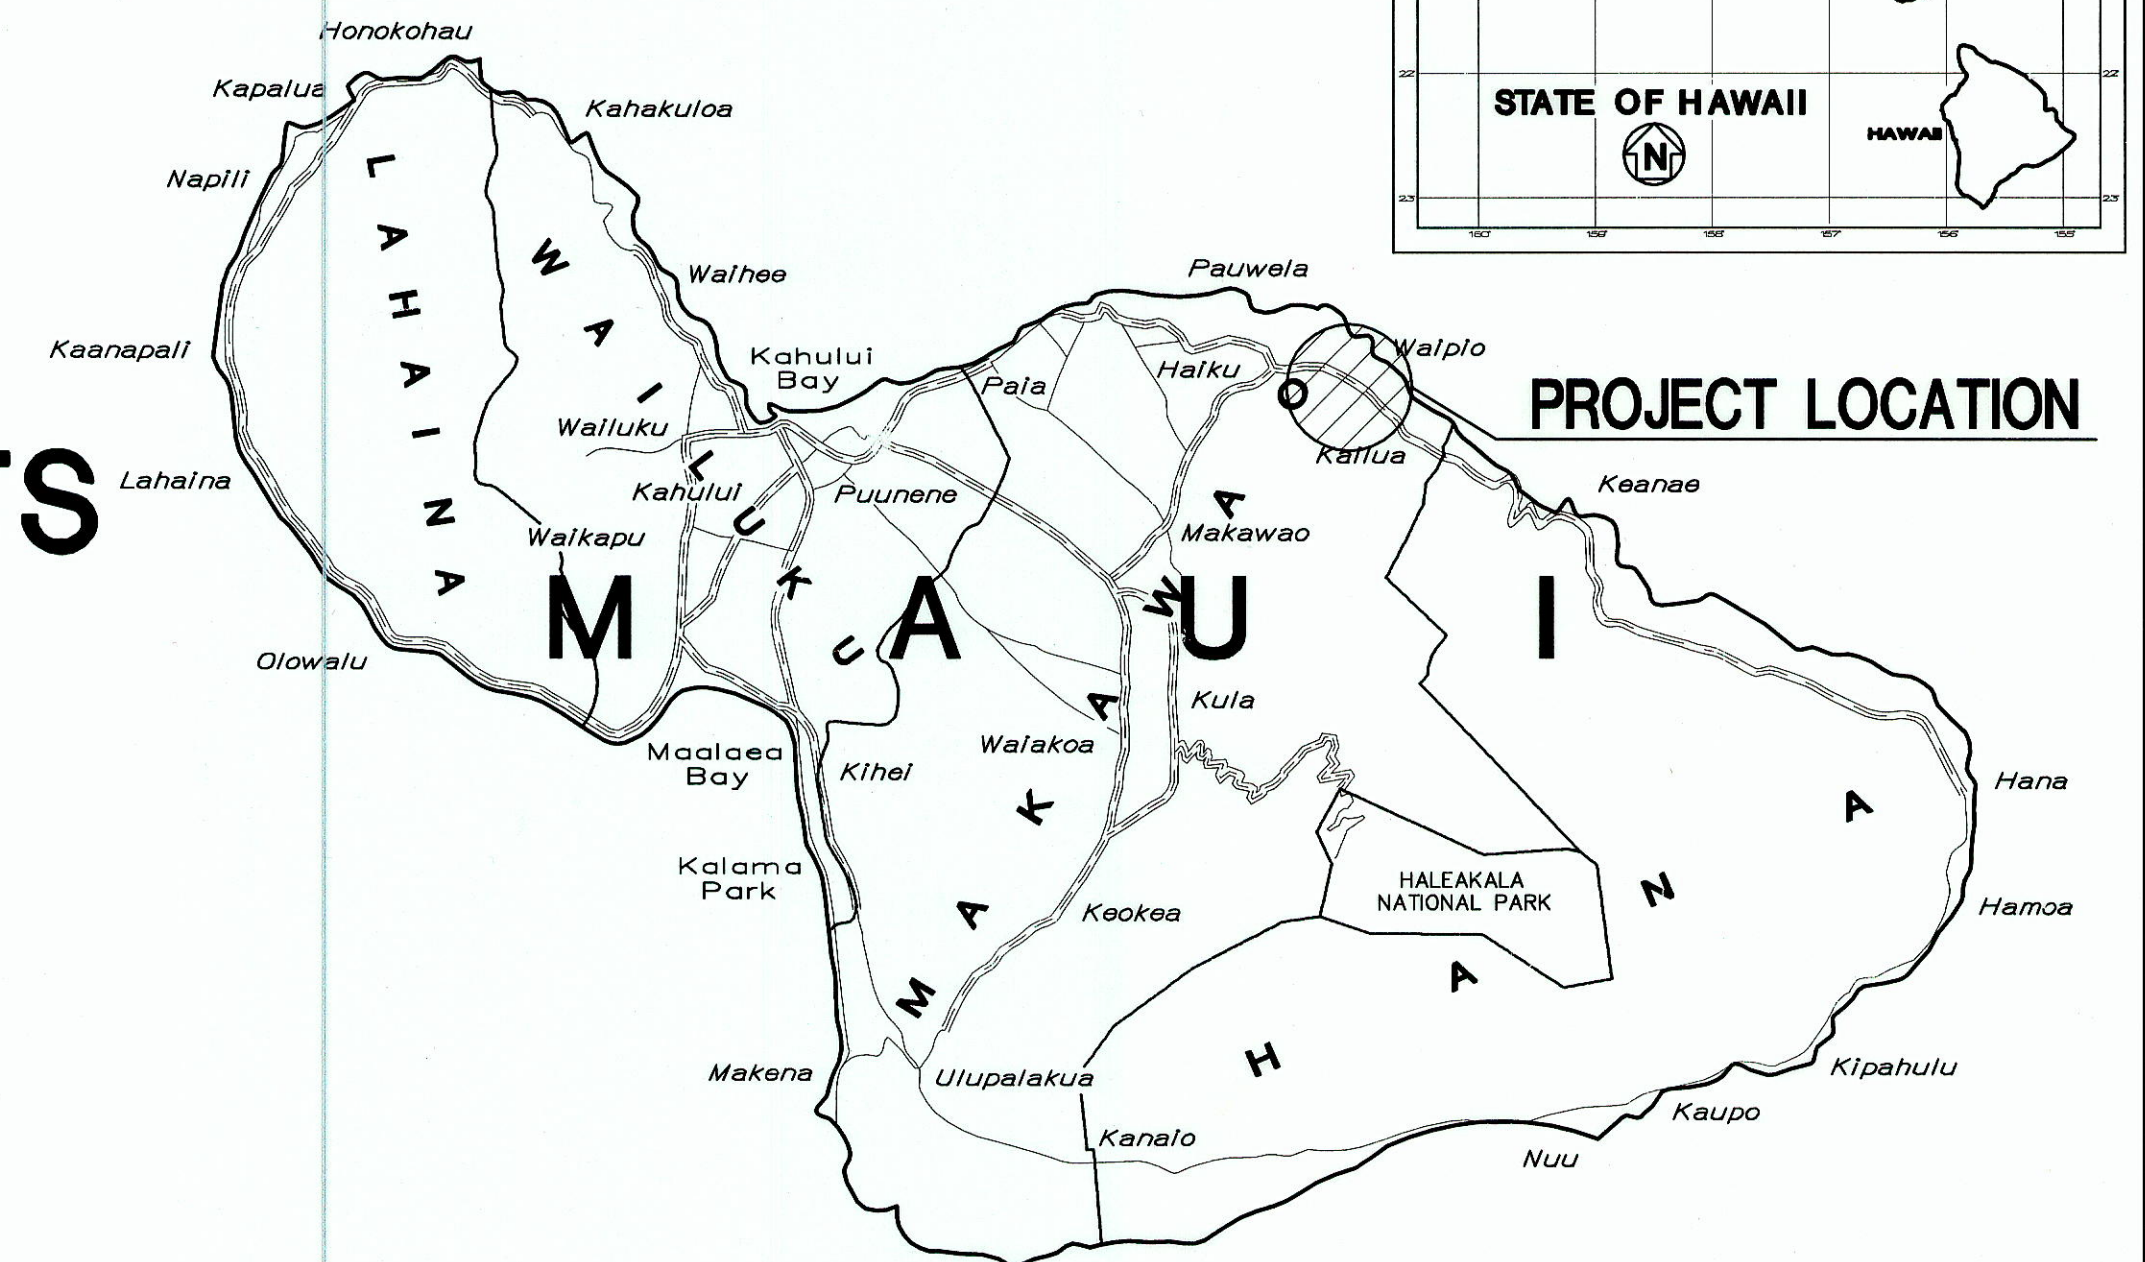


INDEX TO DRAWINGS	
SHEET NO.	DESCRIPTION
1	TITLE SHEET
2 - 3	GENERAL CONSTRUCTION NOTES
4	LEGEND & ABBREVIATIONS
5 - 6	WATER POLLUTION & EROSION CONTROL NOTES
7 - 8	TYPICAL SECTIONS
9	DEMOLITION & EROSION CONTROL PLANS
10	ROADWAY, GRADING AND DRAINAGE PLAN
11	TRAFFIC CONTROL PLAN
12	EROSION CONTROL DETAIL
13 - 14	ROAD CROSS SECTIONS

STATE OF HAWAII
DEPARTMENT OF TRANSPORTATION
HIGHWAYS DIVISION
HONOLULU, HAWAII
"AS-BUILT"
PLANS FOR
HANA HIGHWAY DRAINAGE IMPROVEMENTS
VICINITY OF HOOLAWA BRIDGE
PROJECT NO. 360A-02-10
DISTRICT OF MAKAWAO
ISLAND OF MAUI

FED. ROAD DIST. NO.	STATE	PROJ. NO.	FISCAL YEAR	SHEET NO.	TOTAL SHEETS
HAWAII	HAW.	360A-02-10	2012	1	14

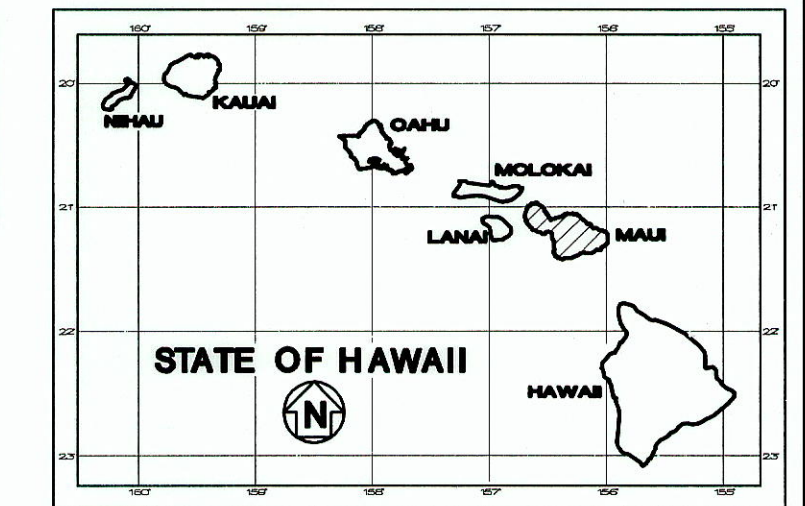

SCALE IN MILES


FEDERAL AID PROJECTS PREVIOUSLY CONSTRUCTED OR UNDER CONSTRUCTION

MILE POST 2.12 TO MILE POST 2.23

CHANGES MADE DURING CONSTRUCTION HAVE BEEN INCORPORATED ON THESE PLANS EXCEPT CHANGES IN THE ORIGINAL THEORETICAL QUANTITIES. FOR ACTUAL QUANTITIES, REFER TO PROJECT LEDGER AND/OR COMPUTATION BOOK.


RESIDENT ENGINEER DATE 1-27-14

DEPARTMENT OF TRANSPORTATION
STATE OF HAWAII
APPROVED:
for DIR. OF TRANSPORTATION DATE 12/13/11

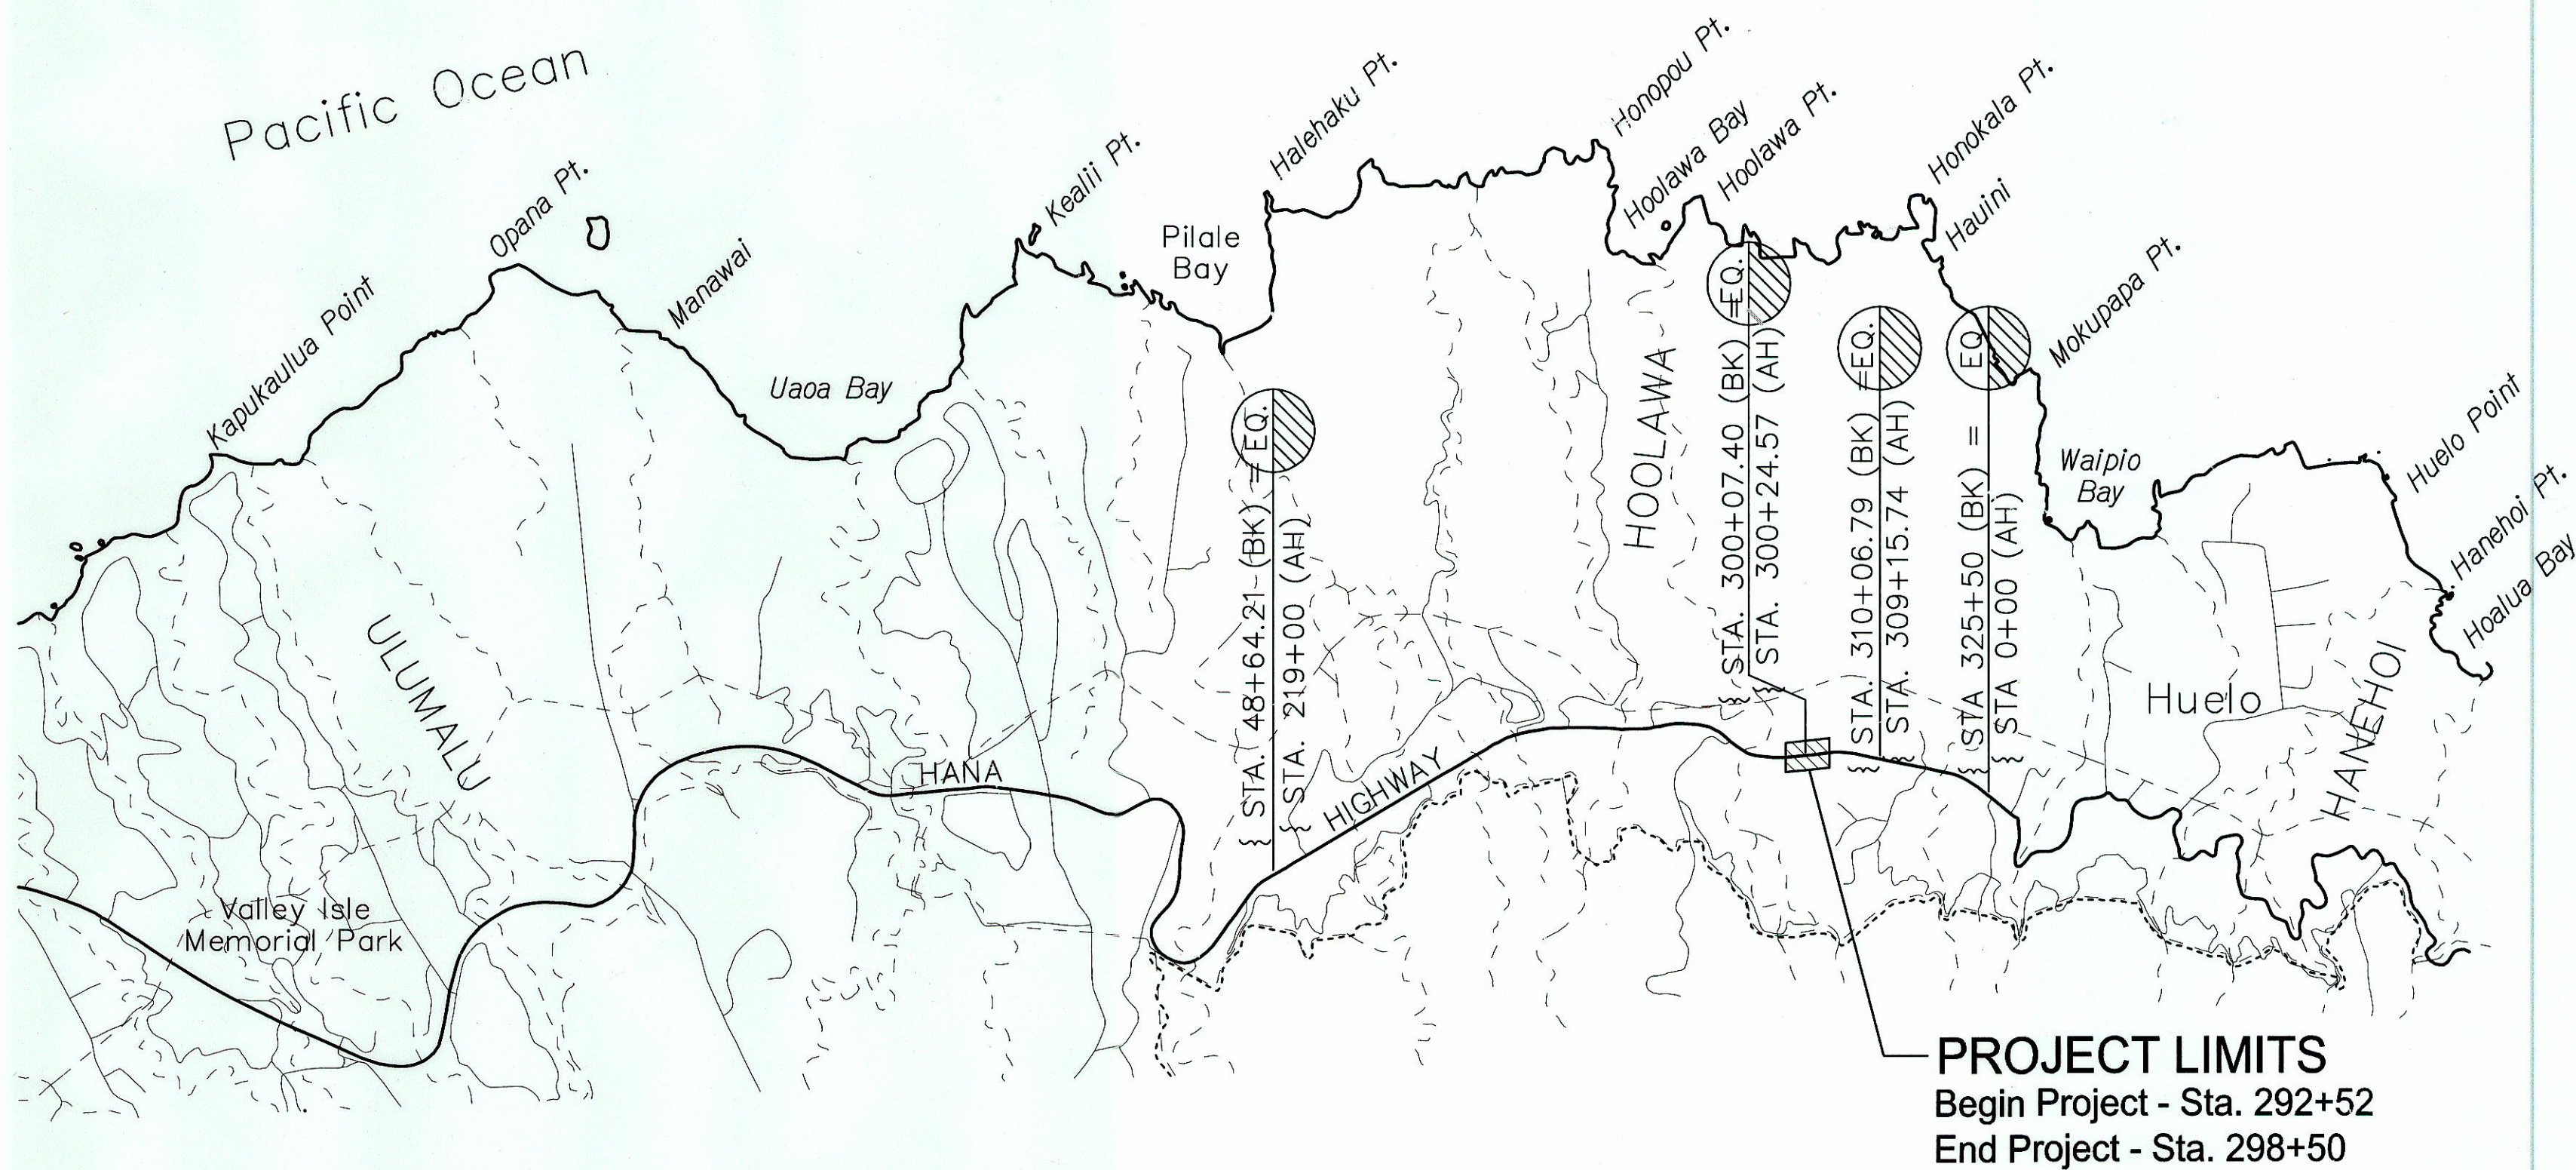

SCALE IN THOUSAND FEET

LOCATION PLAN
GROSS LENGTH OF PROJECT.....0.11 MILES
NET LENGTH OF PROJECT.....0.11 MILES

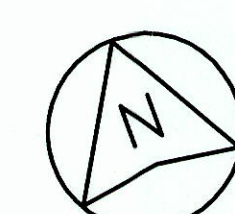

ORIGINAL PLAN	DATE
DESIGNED BY	
TRACED BY	
DESIGNED BY	
QUANTITIES BY	
CHECKED BY	

MAY 10, 2012
DATE

873-3535
PHONE

HWY-M
MANAGED BY

SSFM INTERNATIONAL, INC.
DESIGNED BY

W:\CIVIL 3D PROJECTS\2006_173_001 SOH HANA HWY DRAINAGE IMPROVEMENTS\01 TITLE SHEET.DWG 7/28/2011 3:40 PM