
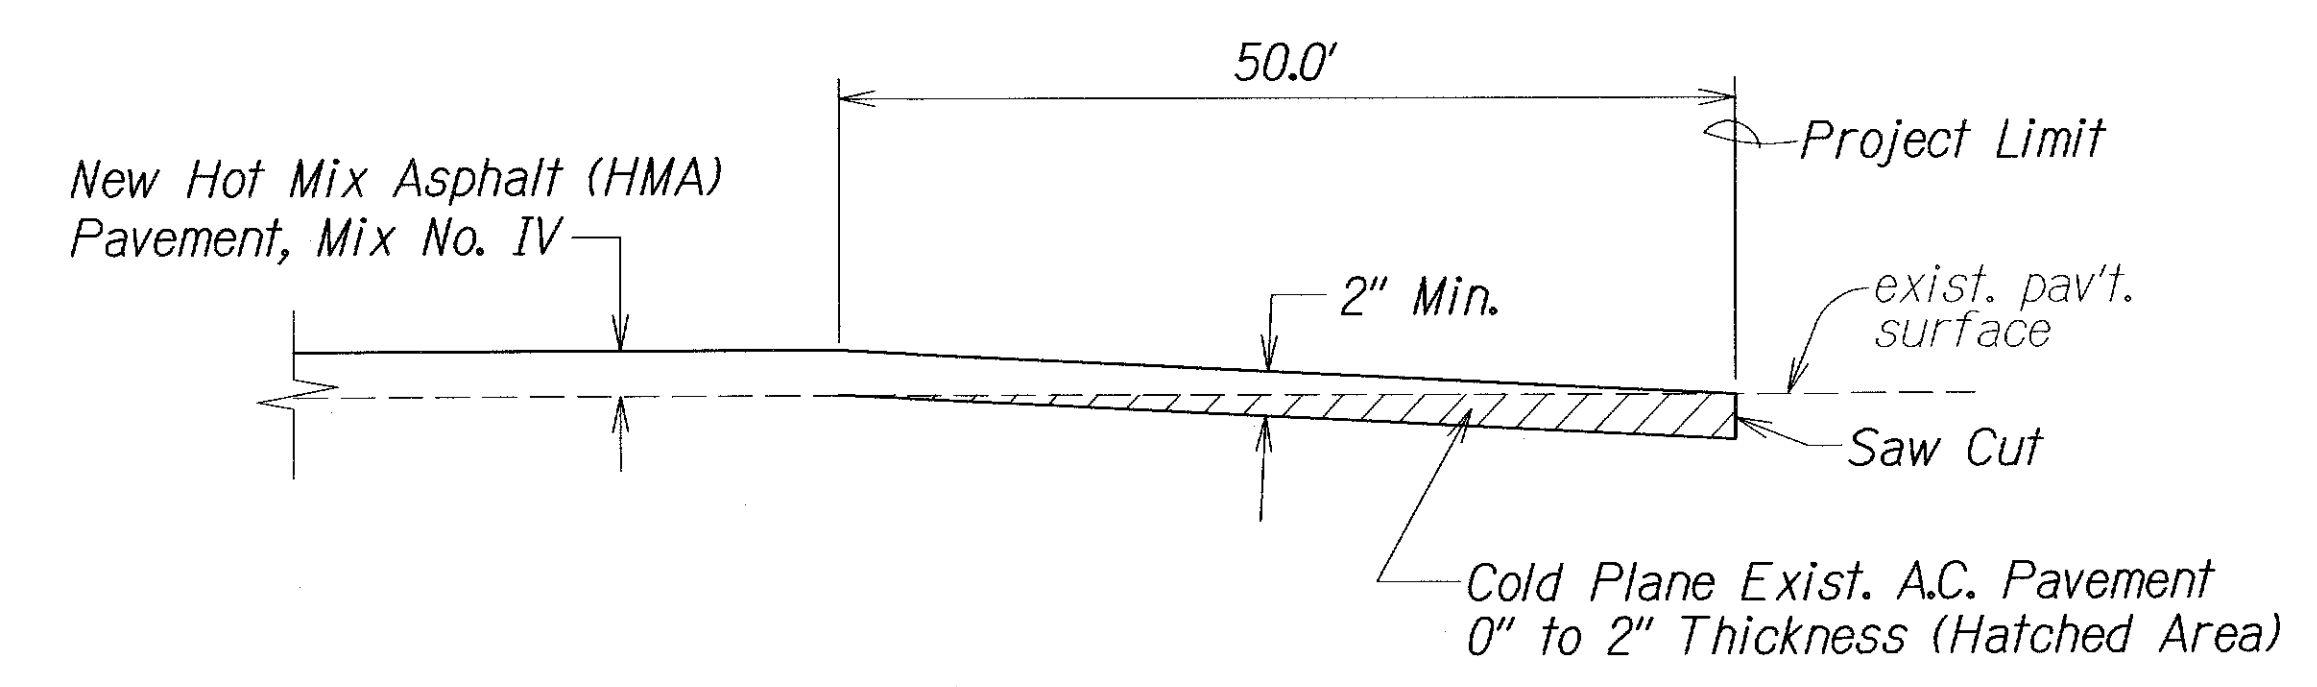
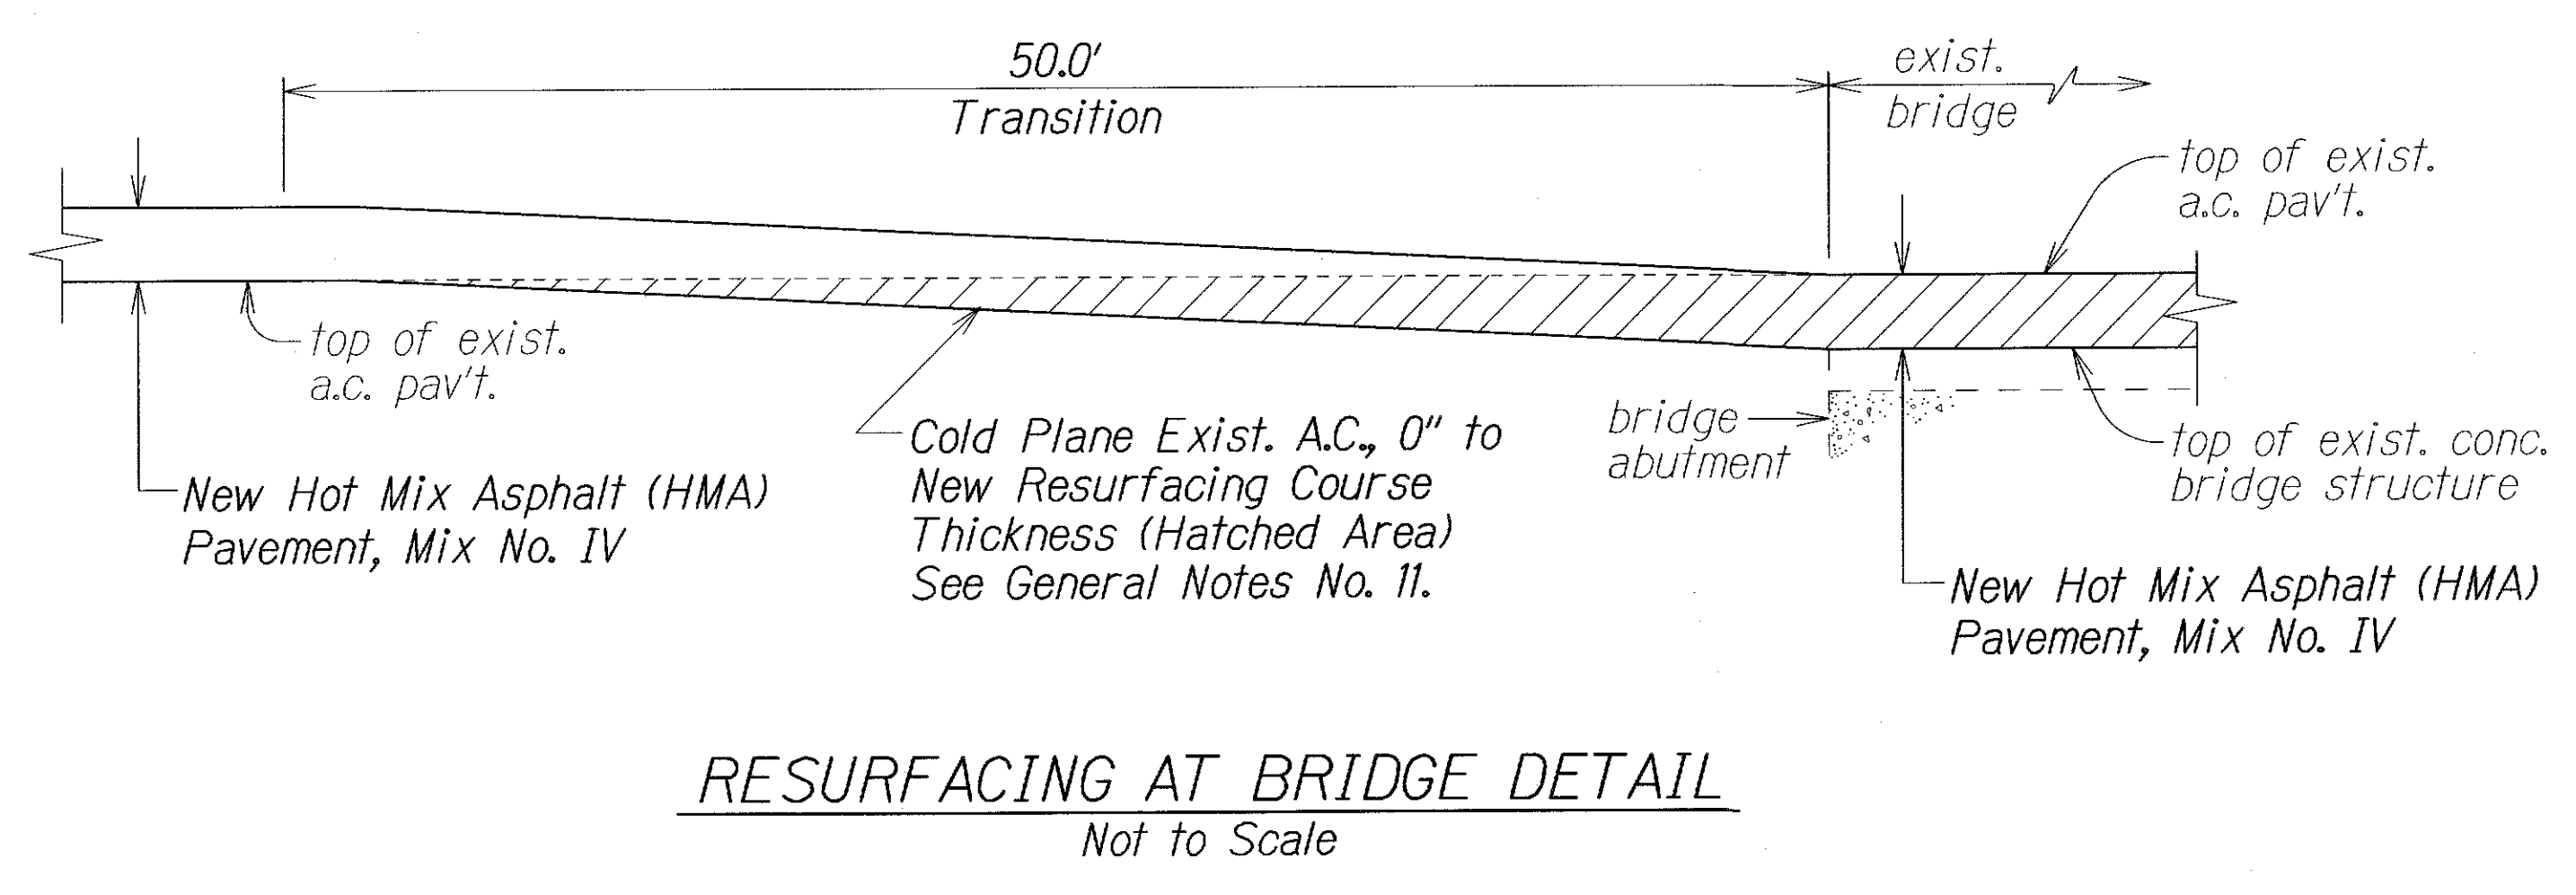
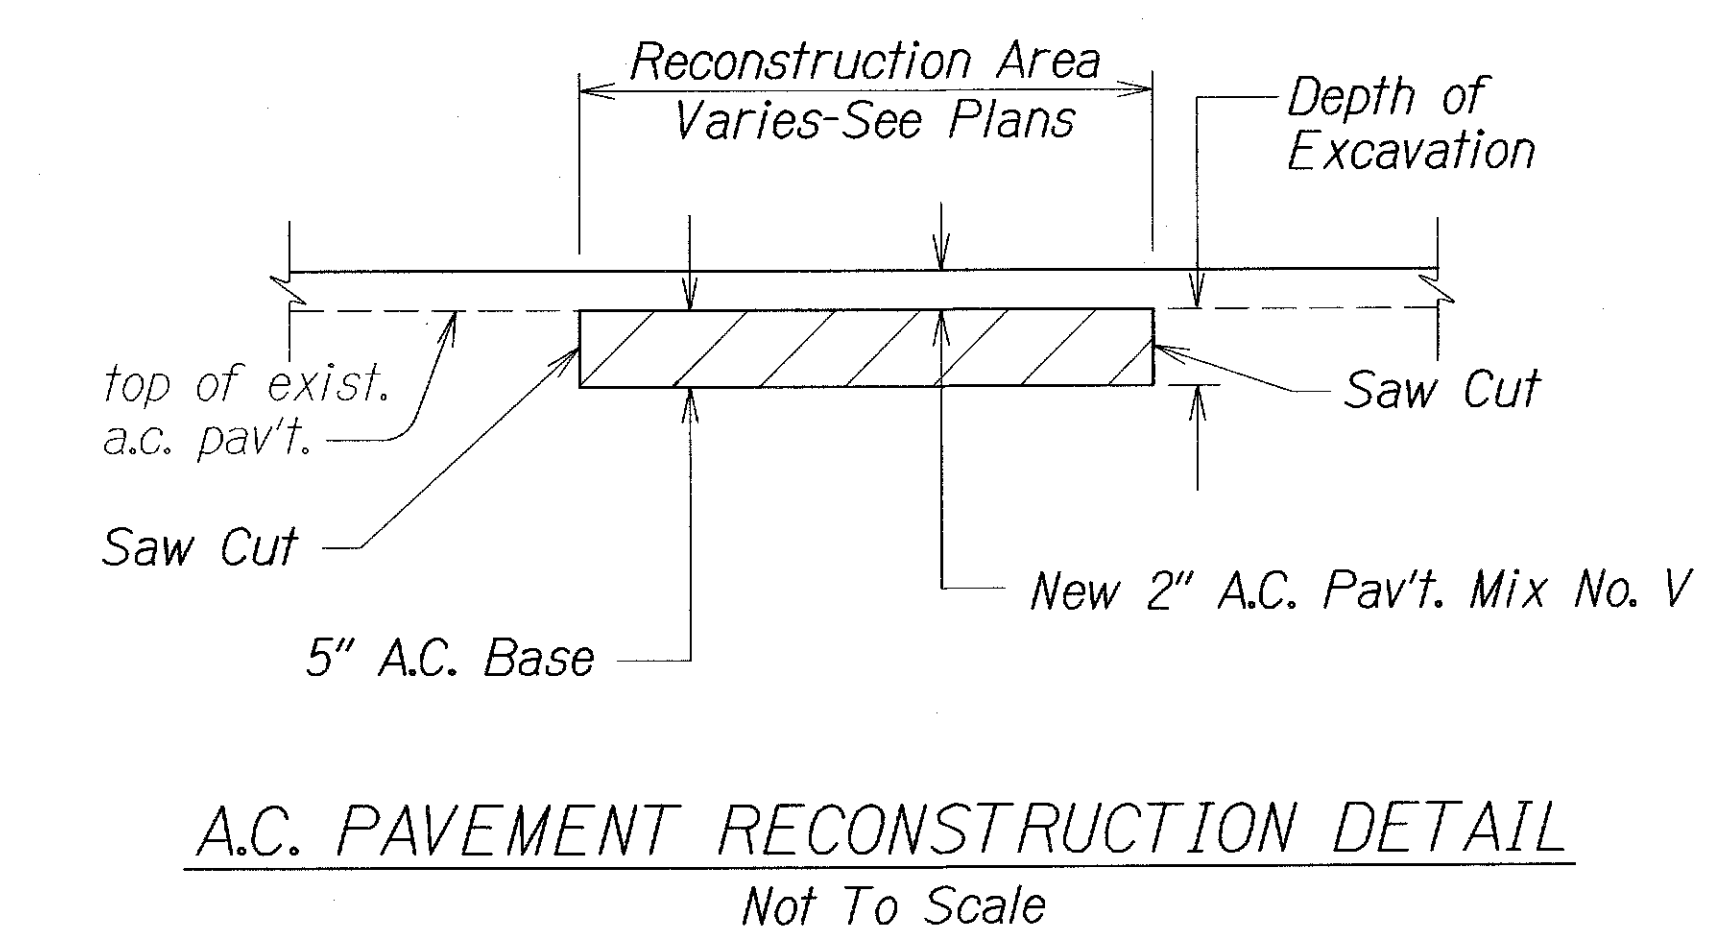
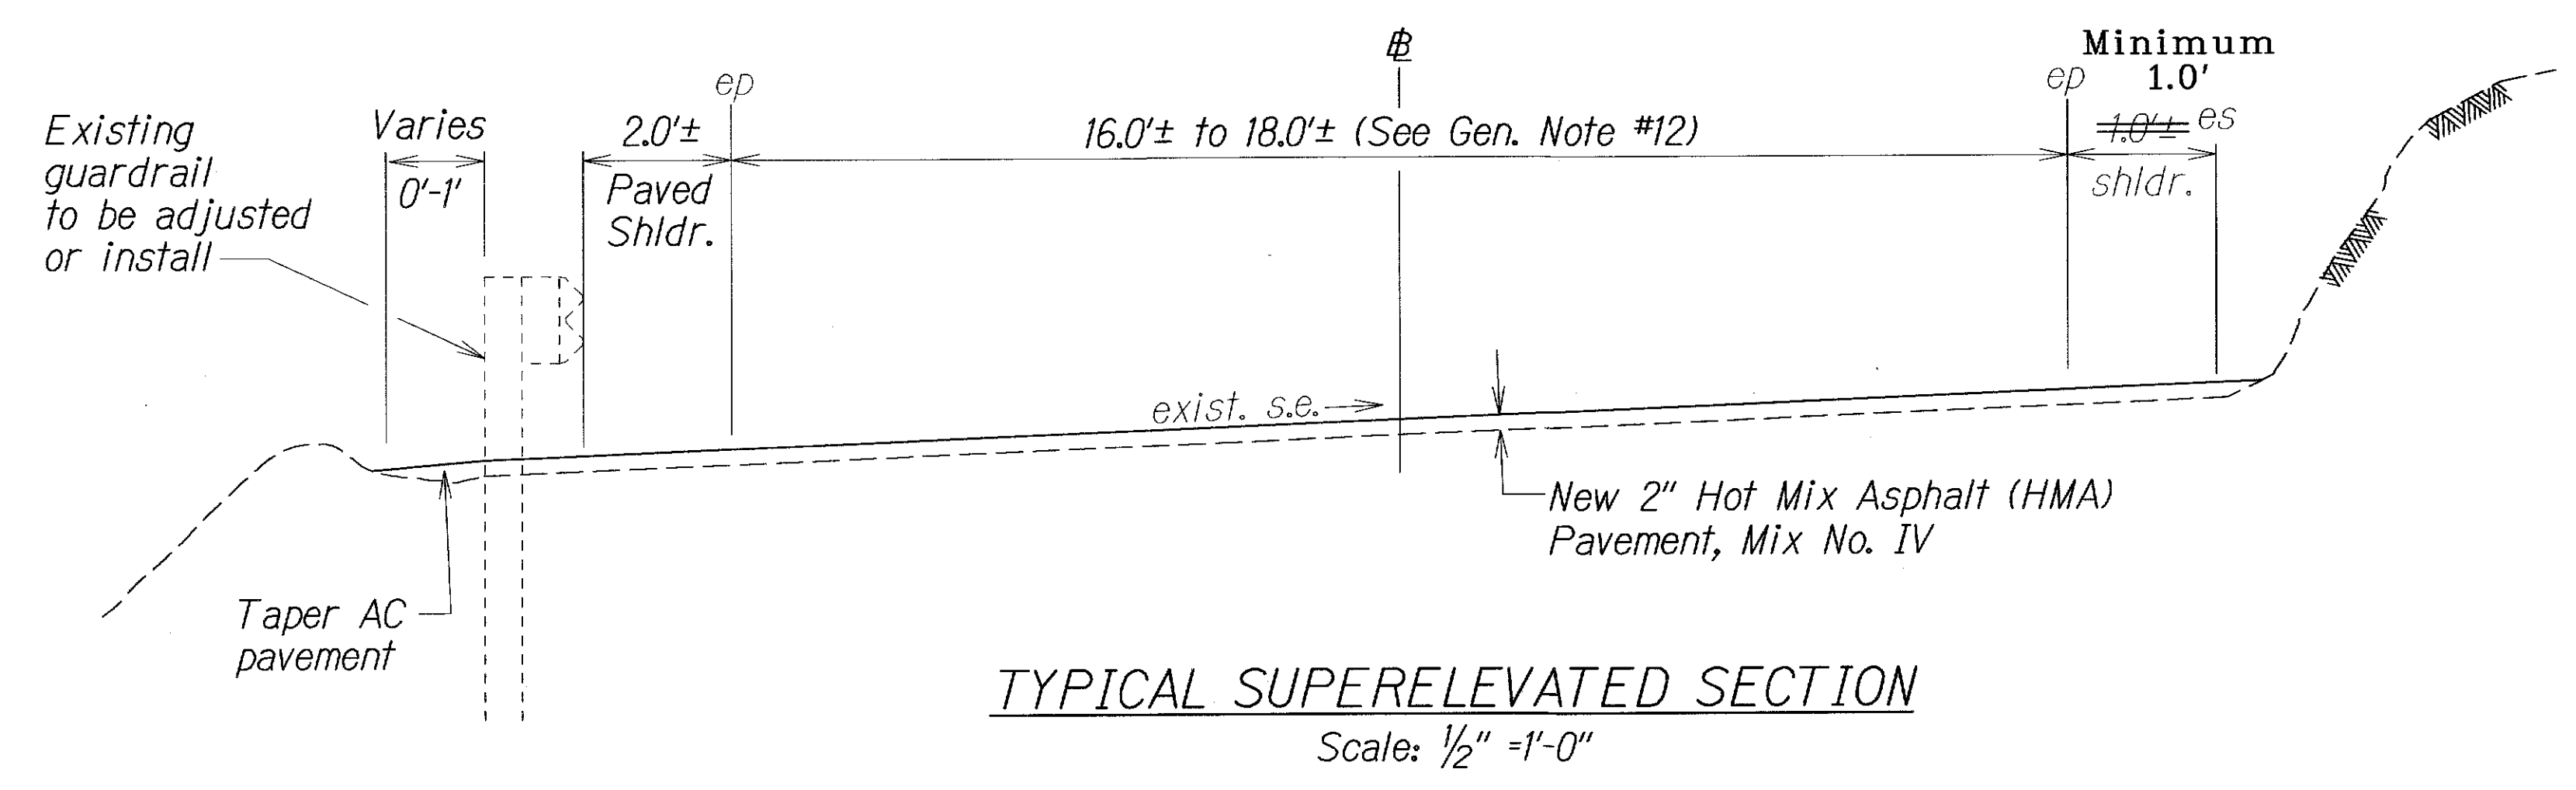
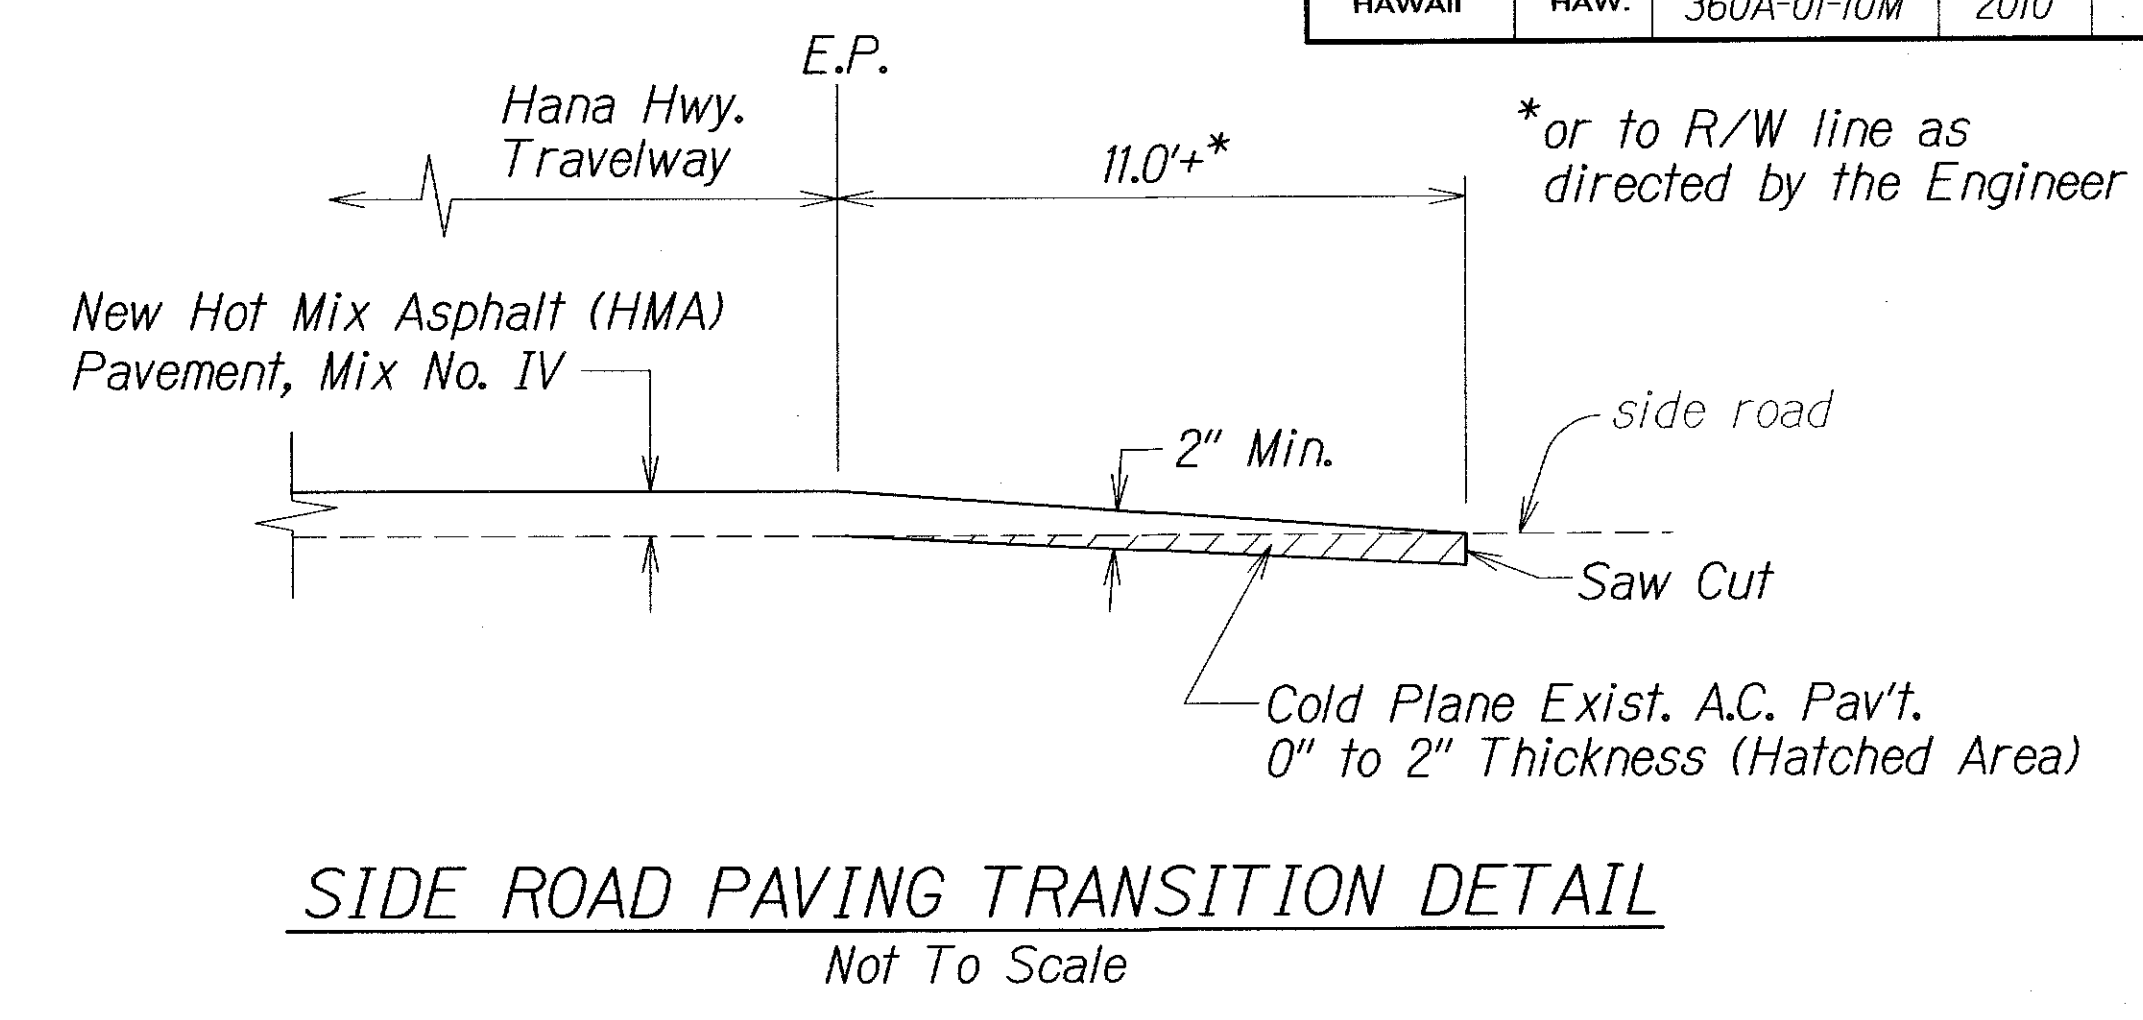


FED. ROAD DIST. NO.	STATE	PROJ. NO.	FISCAL YEAR	SHEET NO.	TOTAL SHEETS
HAWAII	HAW.	360A-01-10M	2010	6	25

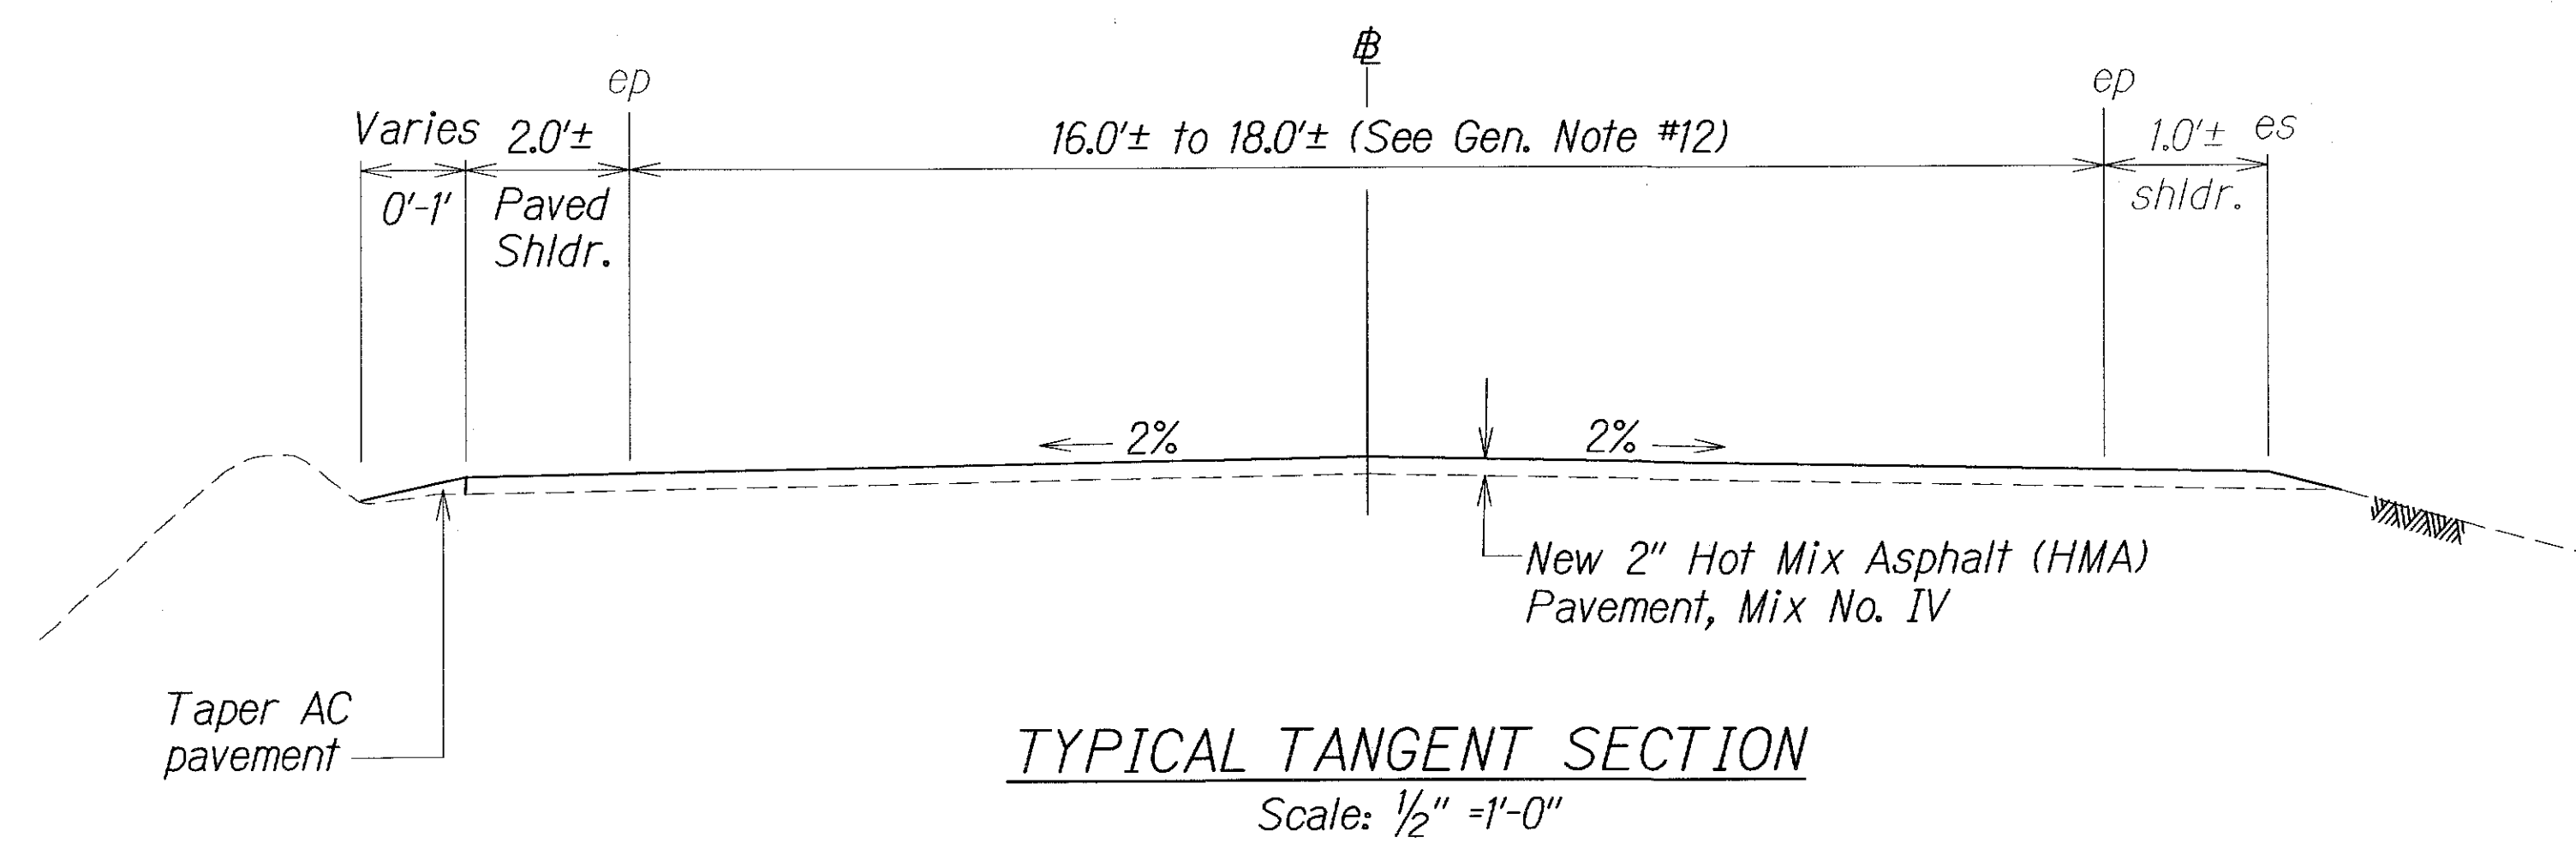

PAVEMENT TRANSITION DETAIL
BEGIN & END PROJECT
Not to Scale

LEGEND FOR AS-BUILT POSTINGS

~~~~~ Squiggly line for as-built deletion

==== Double line for as-built deletion

Roadway Text for as-built posting

STATE OF HAWAII  
DEPARTMENT OF TRANSPORTATION  
HIGHWAYS DIVISION

**TYPICAL SECTIONS & DETAILS**


**HANA HIGHWAY RESURFACING**  
**Huelo to Koloa**  
**Project No. 360A-01-10M**

Scale: As Shown Date: April, 2010

SHEET No. 1 OF 2 SHEETS

|                   |      |       |
|-------------------|------|-------|
| ORIGINAL PLAN     | DATE | 02/02 |
| SURVEY PLOTTED BY |      |       |
| DRAWN BY          |      |       |
| NOTED BY          |      |       |
| CHECKED BY        |      |       |

| FED. ROAD DIST. NO. | STATE | PROJ. NO.   | FISCAL YEAR | SHEET NO. | TOTAL SHEETS |
|---------------------|-------|-------------|-------------|-----------|--------------|
| HAWAII              | HAW.  | 360A-01-10M | 2010        | 7         | 25           |

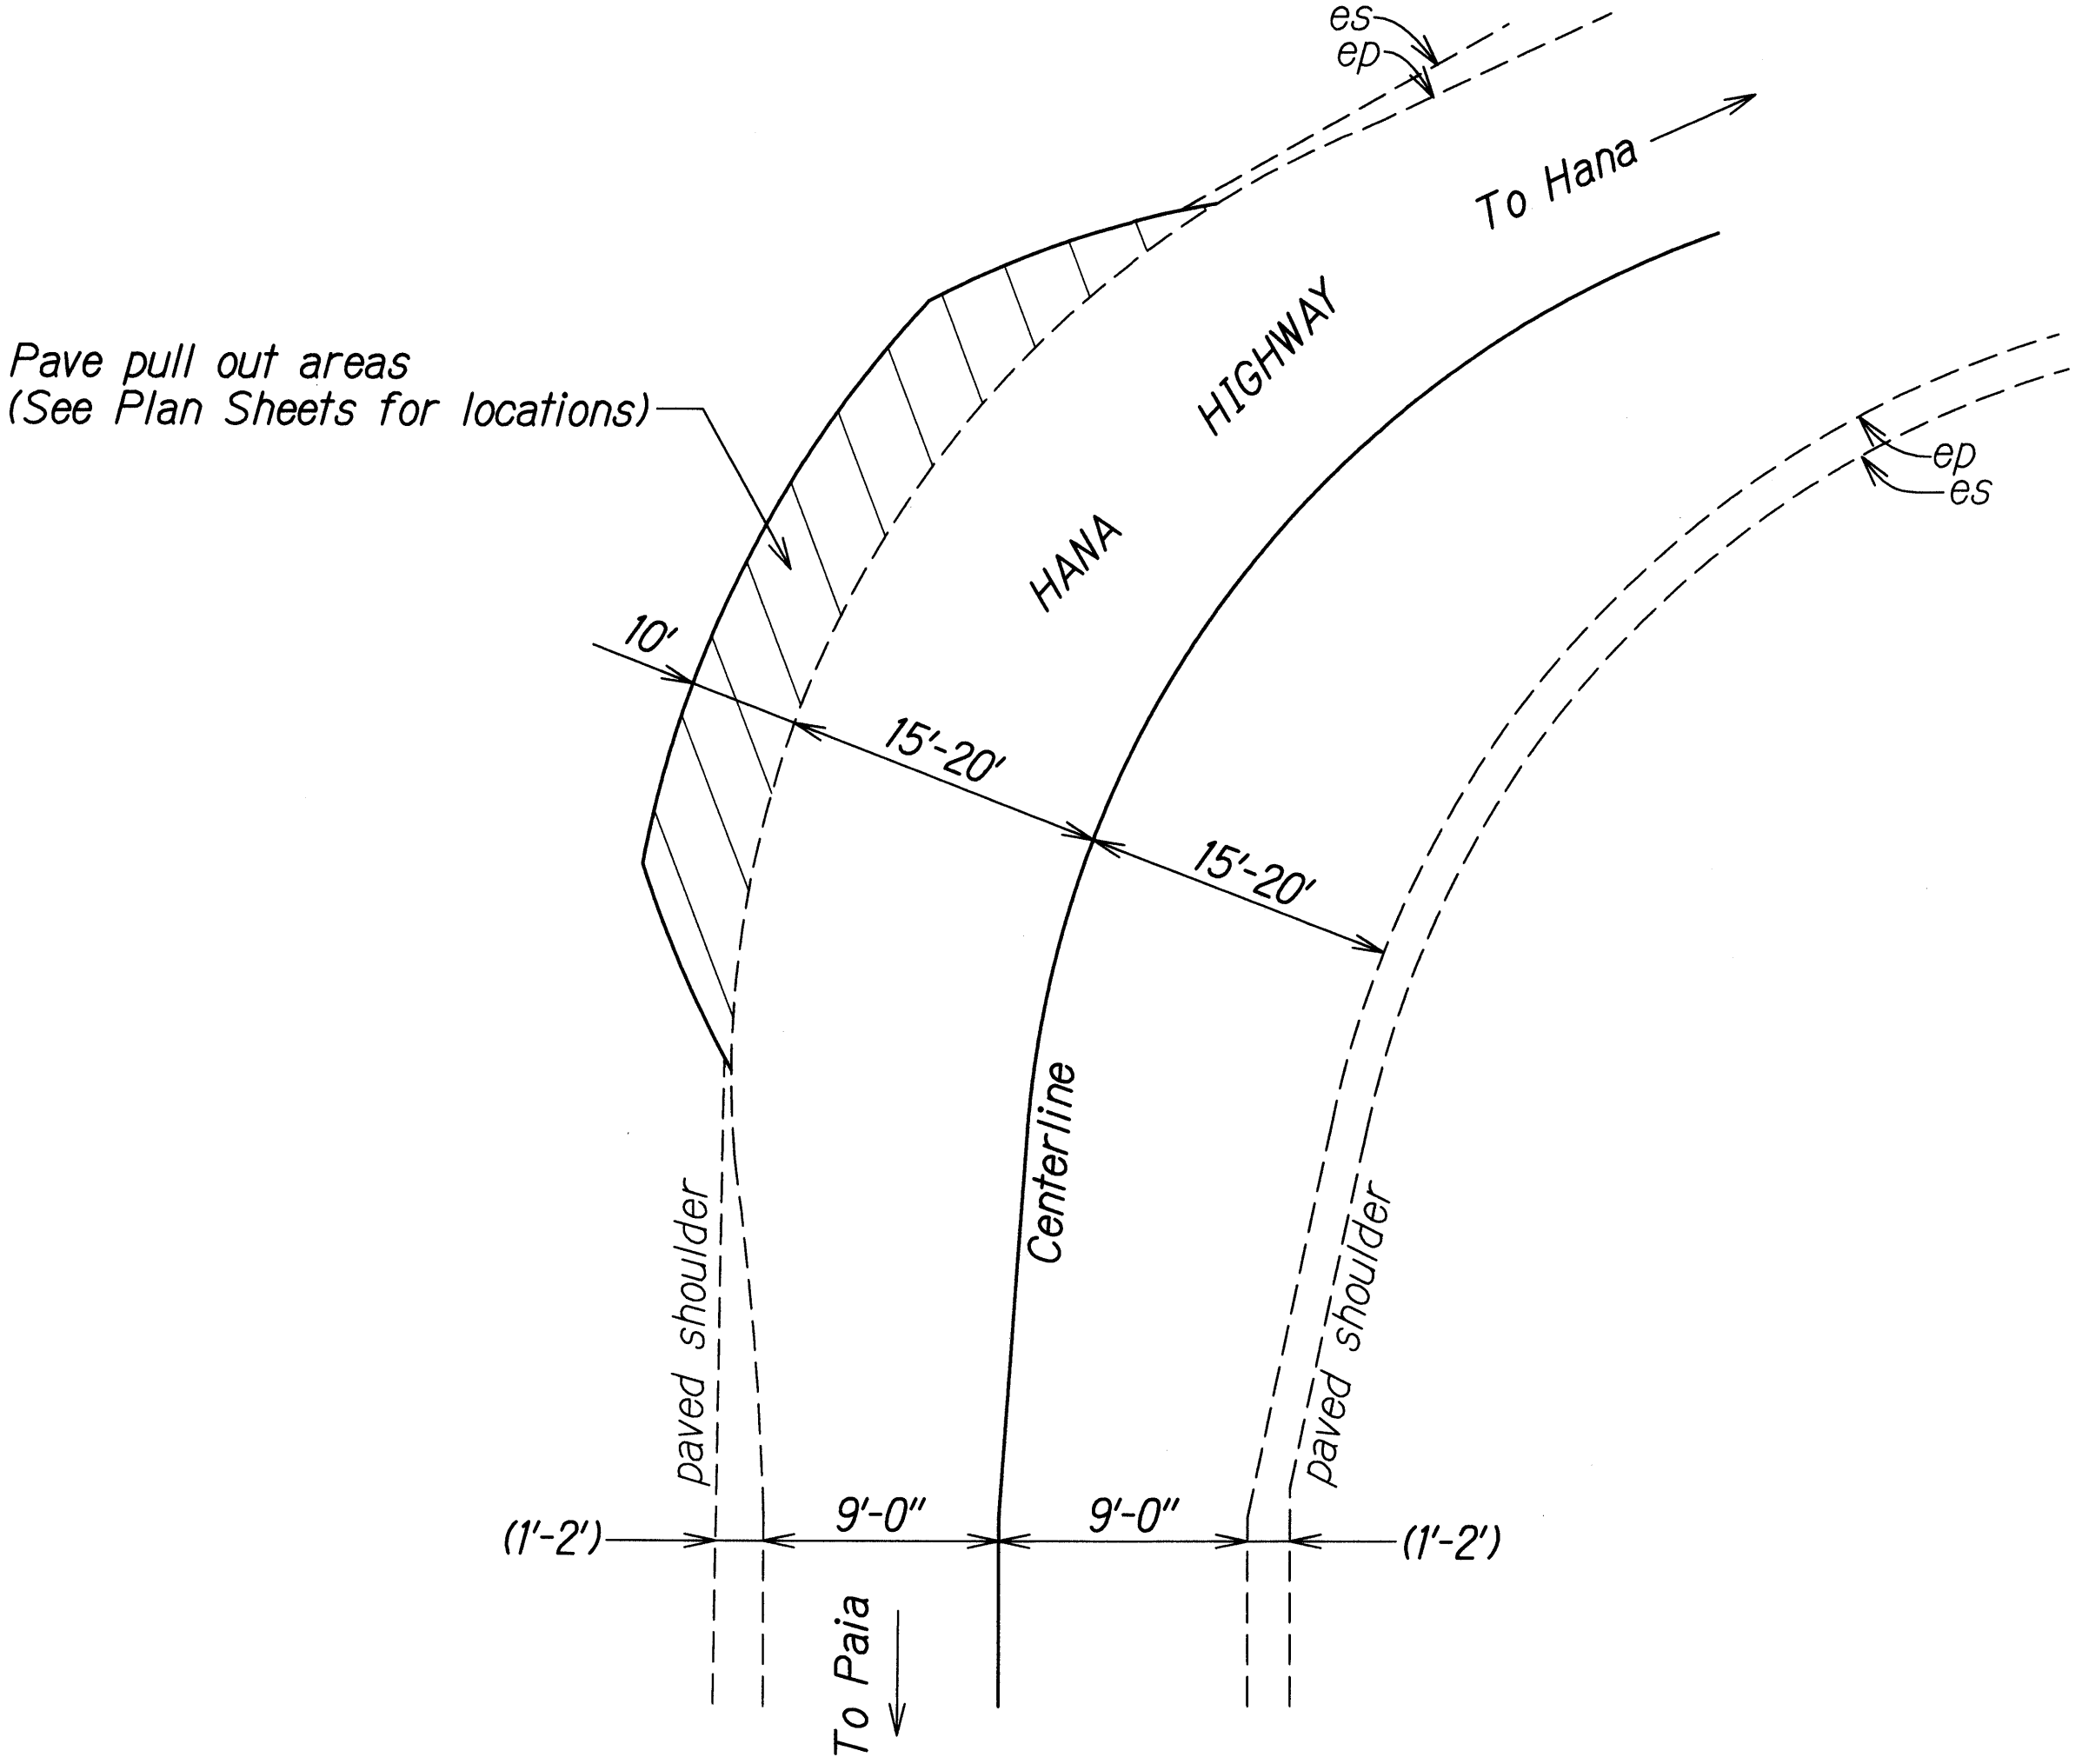

TYPICAL DETAIL FOR PULL OUT AREAS @  
STA. 40+50 - STA. 41+35; STA. 56+00 - STA. 57+75;  
STA. 79+45 - STA. 80+15; STA. 80+75 - STA. 81+75  
*Not To Scale*

|               |                   |      |
|---------------|-------------------|------|
| ORIGINAL PLAN | SURVEY PLOTTED BY | DATE |
| NOTE BOOK     | DESIGNED BY       |      |
|               | QUANTITIES BY     |      |
|               | CHECKED BY        |      |

STATE OF HAWAII  
DEPARTMENT OF TRANSPORTATION  
HIGHWAYS DIVISION

**TYPICAL SECTIONS & DETAILS**

HANA HIGHWAY RESURFACING  
Huelo to Koloa  
Project No. 360A-01-10M

Scale: As Shown      Date: April, 2010

SHEET No. 2 OF 2 SHEETS