

STATE OF HAWAII

DEPARTMENT OF TRANSPORTATION

HIGHWAYS DIVISION HONOLULU, HAWAII


"AS-BUHT"


PLANS FOR

HANA HIGHWAY RESURFACING

VICINITY OF WAIKANI BRIDGE TO KAPAULA BRIDGE PROJECT NO. 360B-01-12M

DISTRICT OF HANA
ISLAND OF MAUI

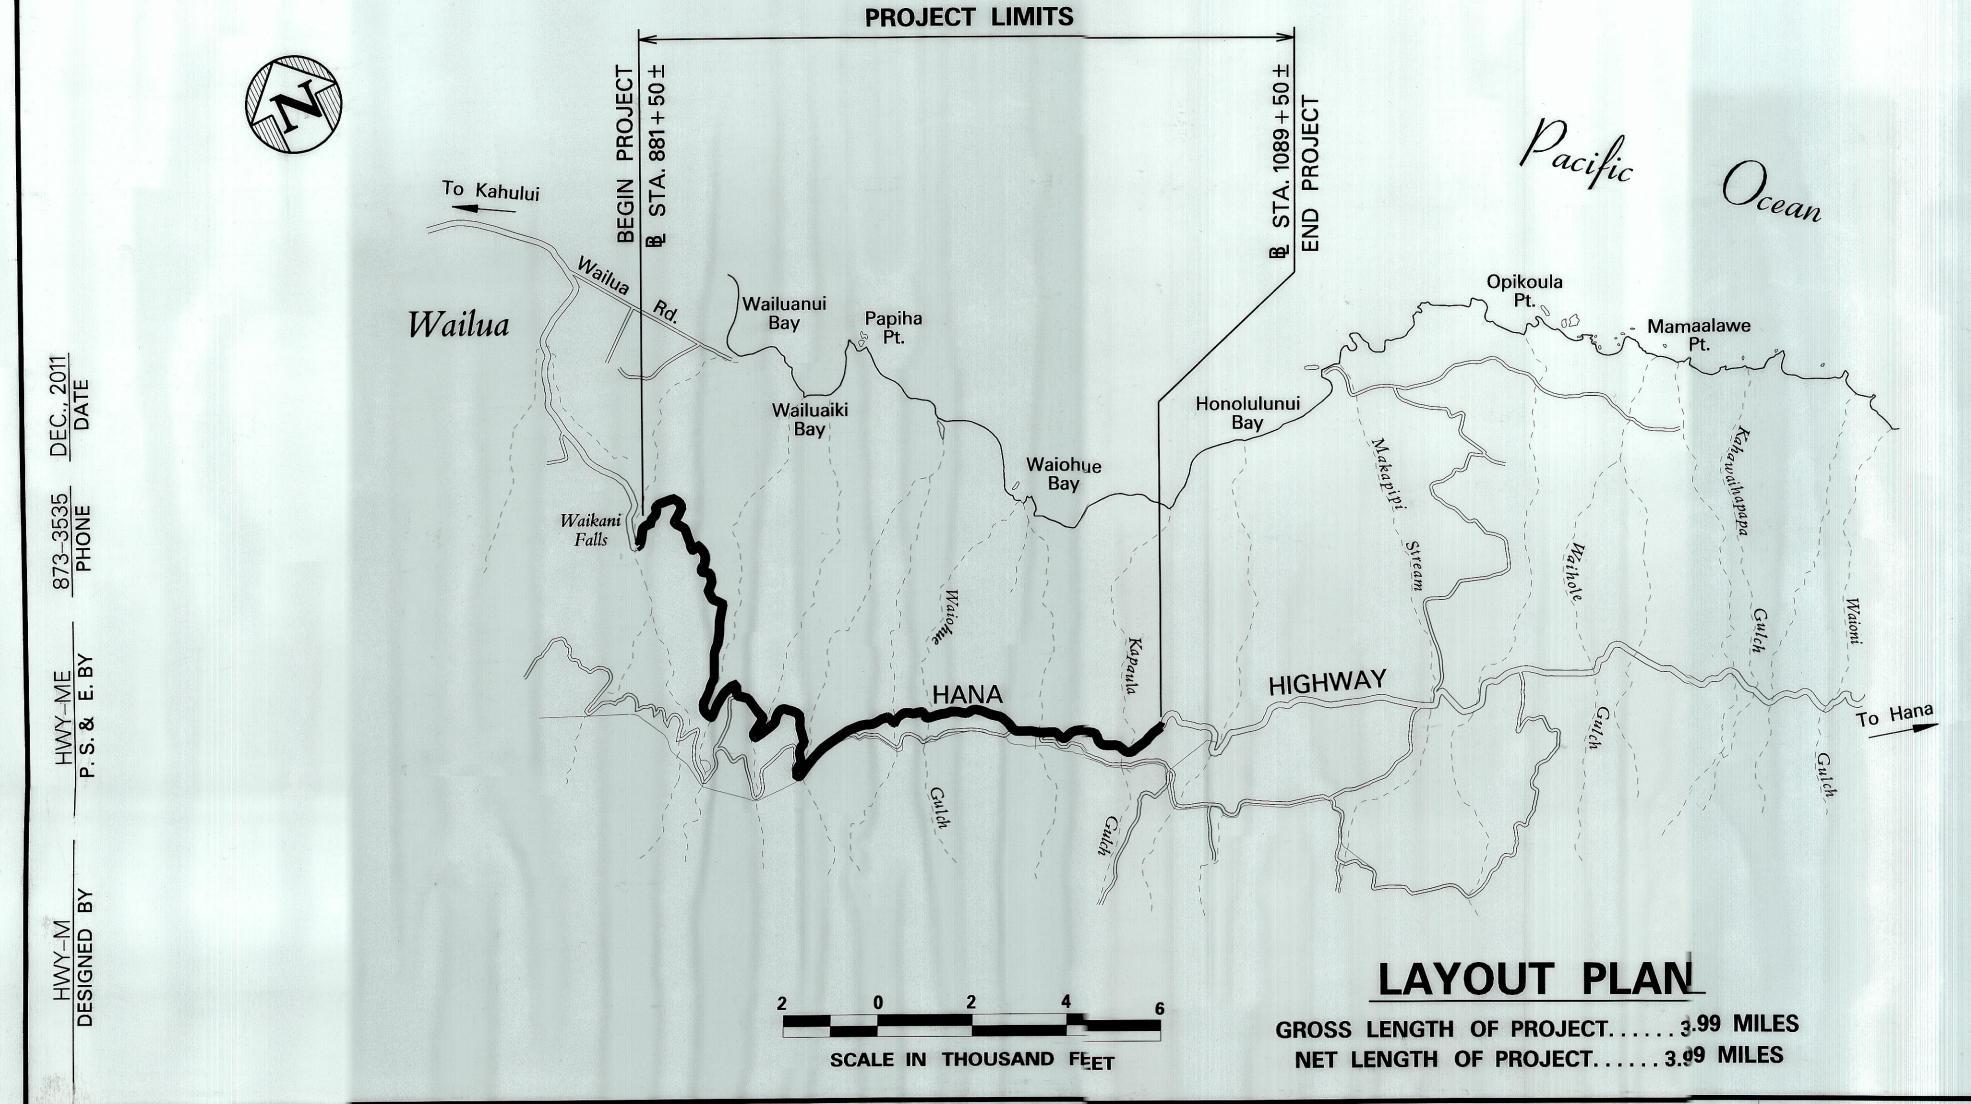

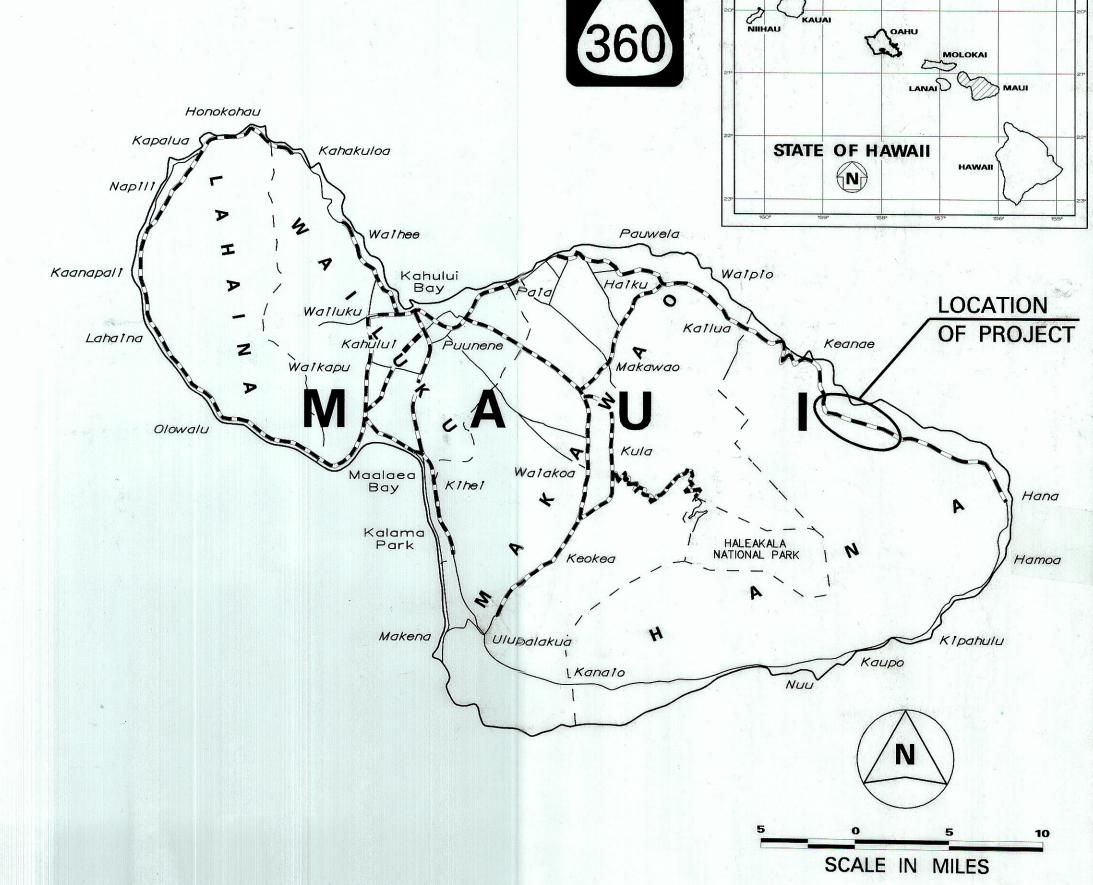

FED. ROAD DIST. NO. FISCAL SHEET YEAR NO.

360B-01-12M

FEDERAL AID PROJECTS PREVIOUSLY CONSTRUCTED OR UNDER CONSTRUCTION

MILE POST 19.39 TO MILE POST 23.38

CHANGES MADE DURING CONSTRUCTION HAVE BEEN INCORPORATED ON THESE PLANS EXCEPT CHANGES IN THE ORIGINAL THEORETICAL QUANTITIES. FOR ACTUAL QUANTITIES, REFER TO PROJECT LEDGER AND/OR COMPUTATION BOOK.

RESIDENT ENGINEER

DATE

DEPARTMENT OF TRANSPORTATION STATE OF HAWAII

APPROVED:

Min A. Jelusti Foodir. OF TRANSPORTATION

2/13/12 N DATE