
FED. ROAD DIST. NO.	STATE	PROJ. NO.	FISCAL YEAR	SHEET NO.	TOTAL SHEETS
MAUI	HAW.	ER-20(006)	2018	6	16

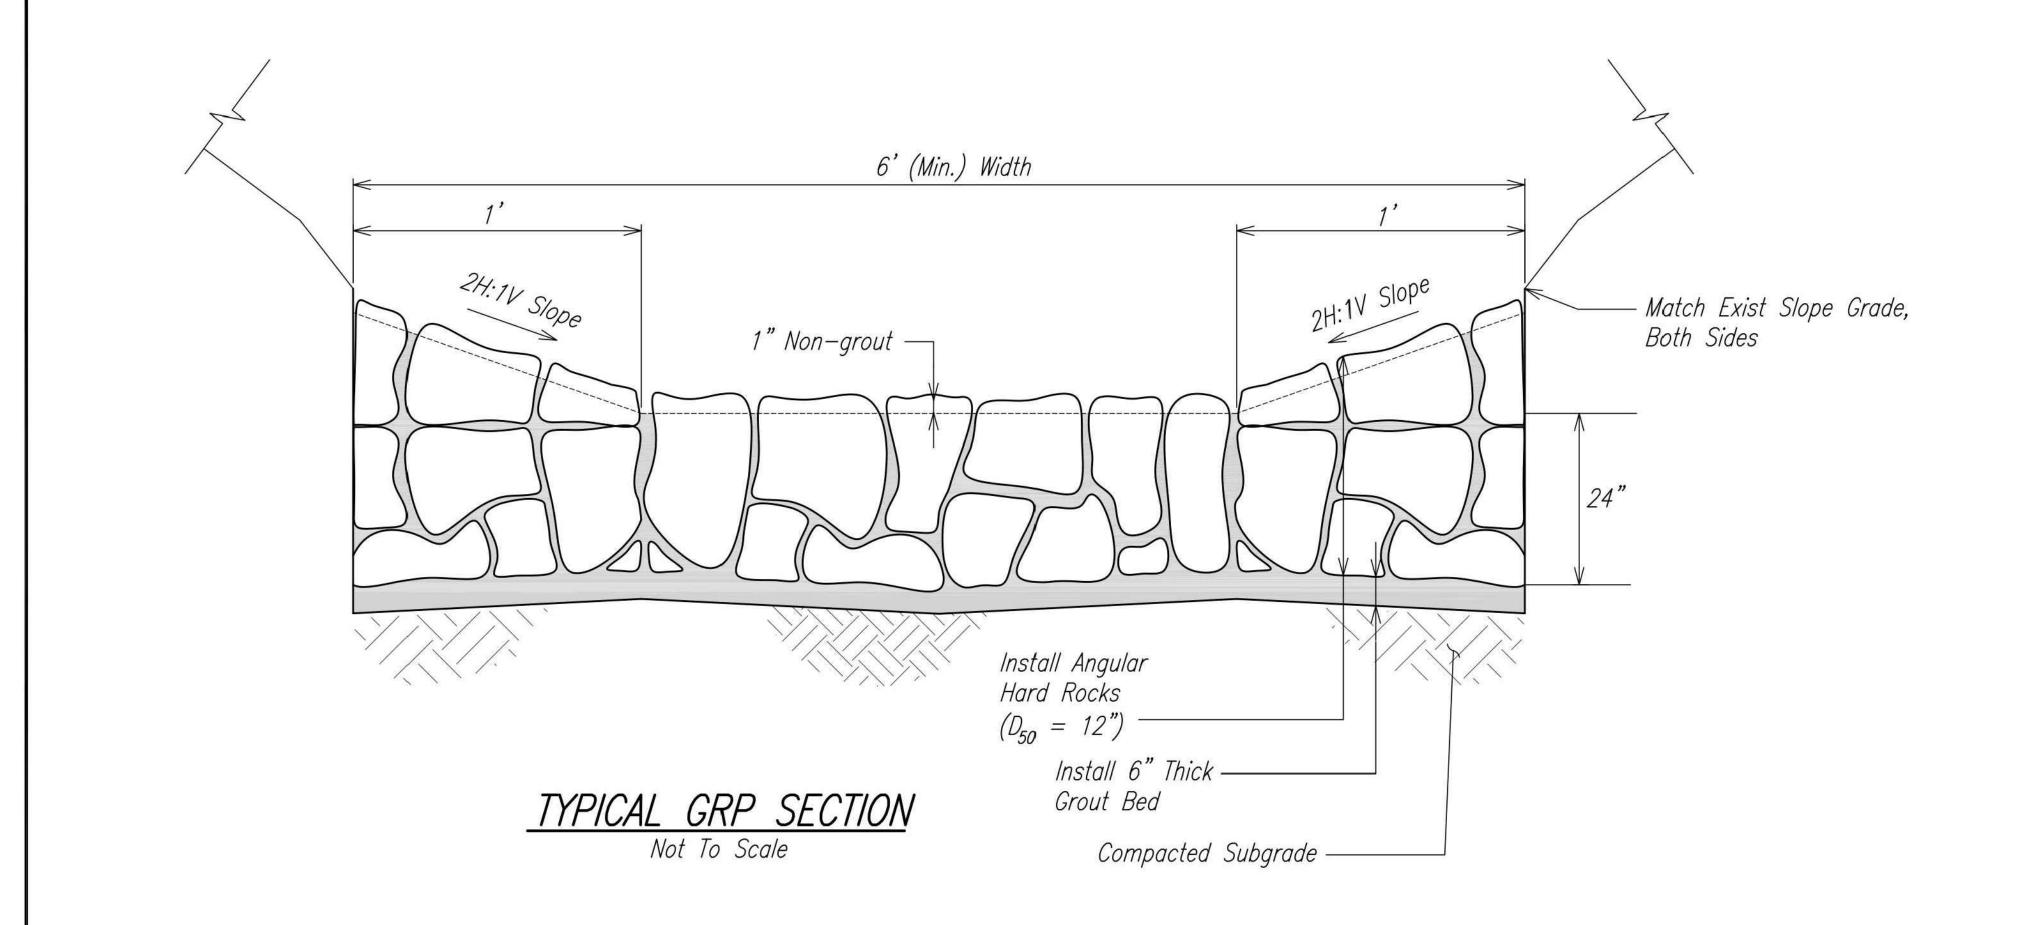

GRP Notes:

- Prior to laying stones, Contractor shall notify the Engineer 3 working days in advance for inspection of foundation bed. Work shall commence only after foundation is acceptable to the Engineer.
- Contractor shall submit well—graded stone gradation information from the quarry to the Engineer for review and approval prior to laying of stone..
- 3. See Standard Specifications Section 612 for more information.

LEGEND FOR AS-BUILT POSTINGS Squiggly line for as-built deletion

Double line for as-built deletion Text for as-built posting

STATE OF HAWAII
DEPARTMENT OF TRANSPORTATION HIGHWAYS DIVISION

<u>Details</u>

EMERGENCY REPAIRS AT PIINAAU BRIDGE HANA HIGHWAY, NEAR MILEPOST 17.0 PROJECT NO. ER-20(006), UNIT 1
Scale: As Noted Date: September 2018

SHEET No. 6 OF 16 SHEETS