



FED. ROAD DIST. NO.	STATE	PROJ. NO.	FISCAL YEAR	SHEET NO.	TOTAL SHEETS
MAUI	HAW.	ER-20(006)	2018	11	16

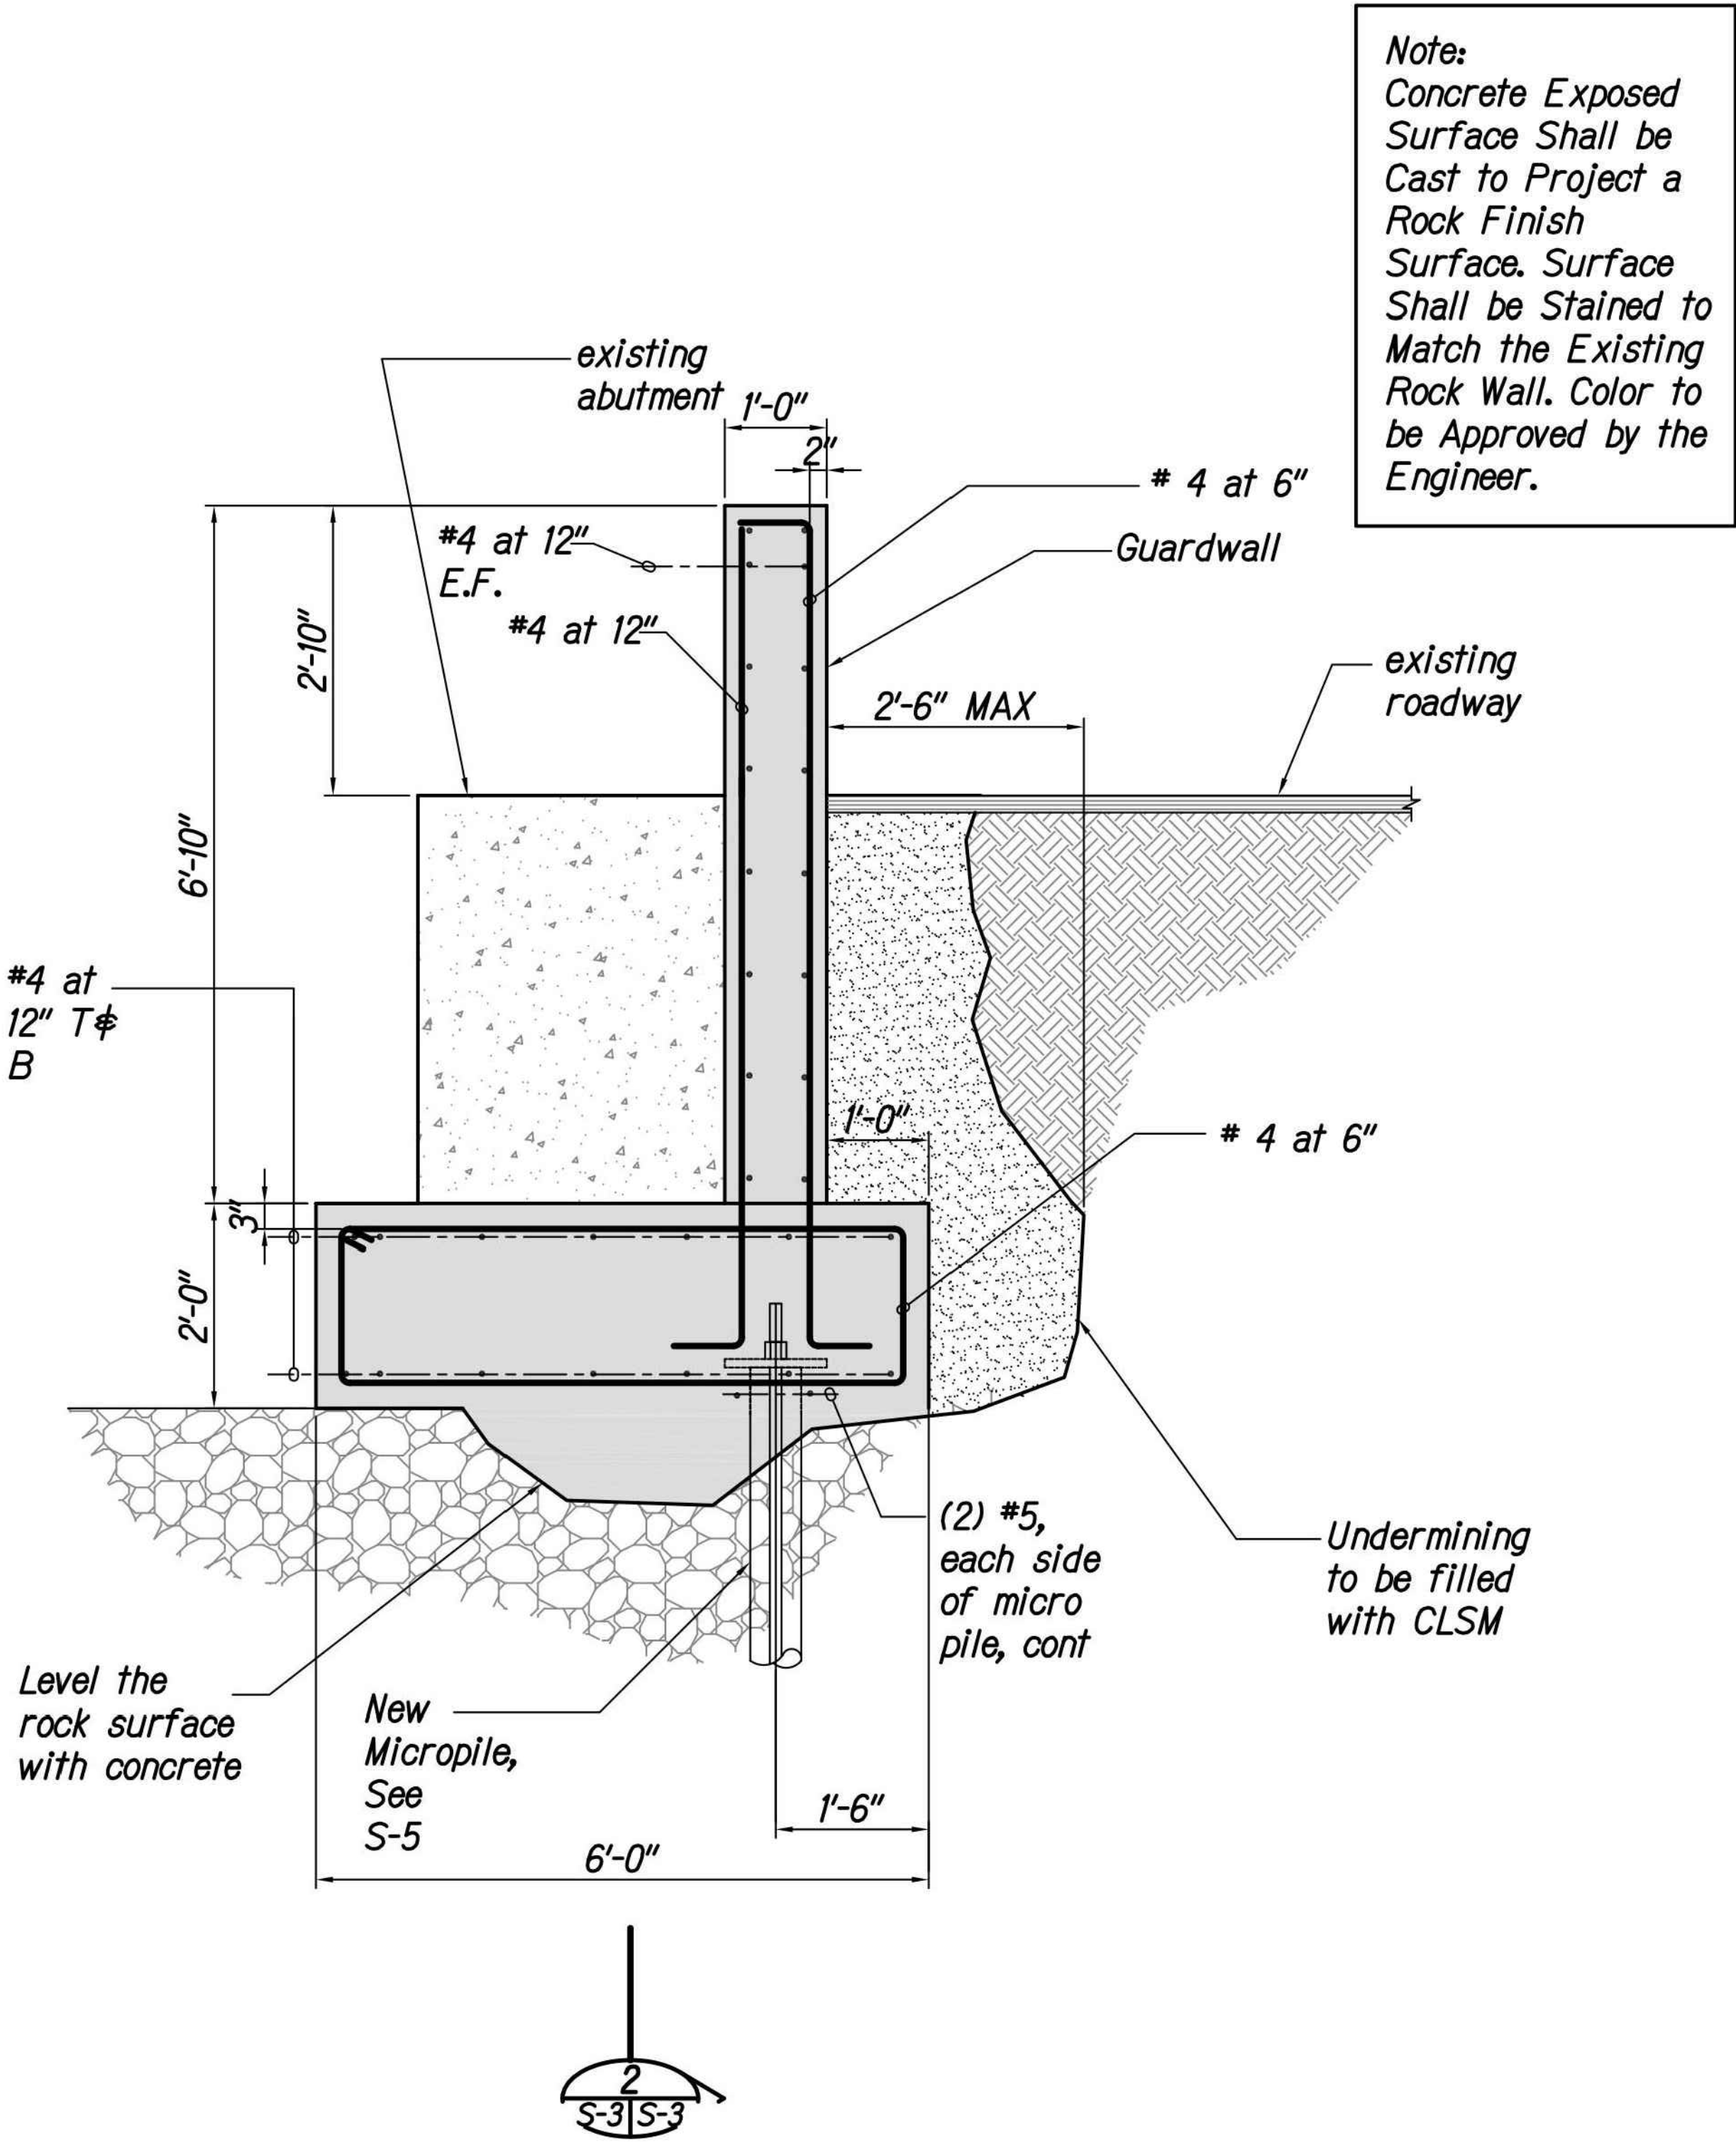

**DOWNSTREAM KAHULUI
NEW WALL SECTION**
Scale: 3/4" = 1'-0"

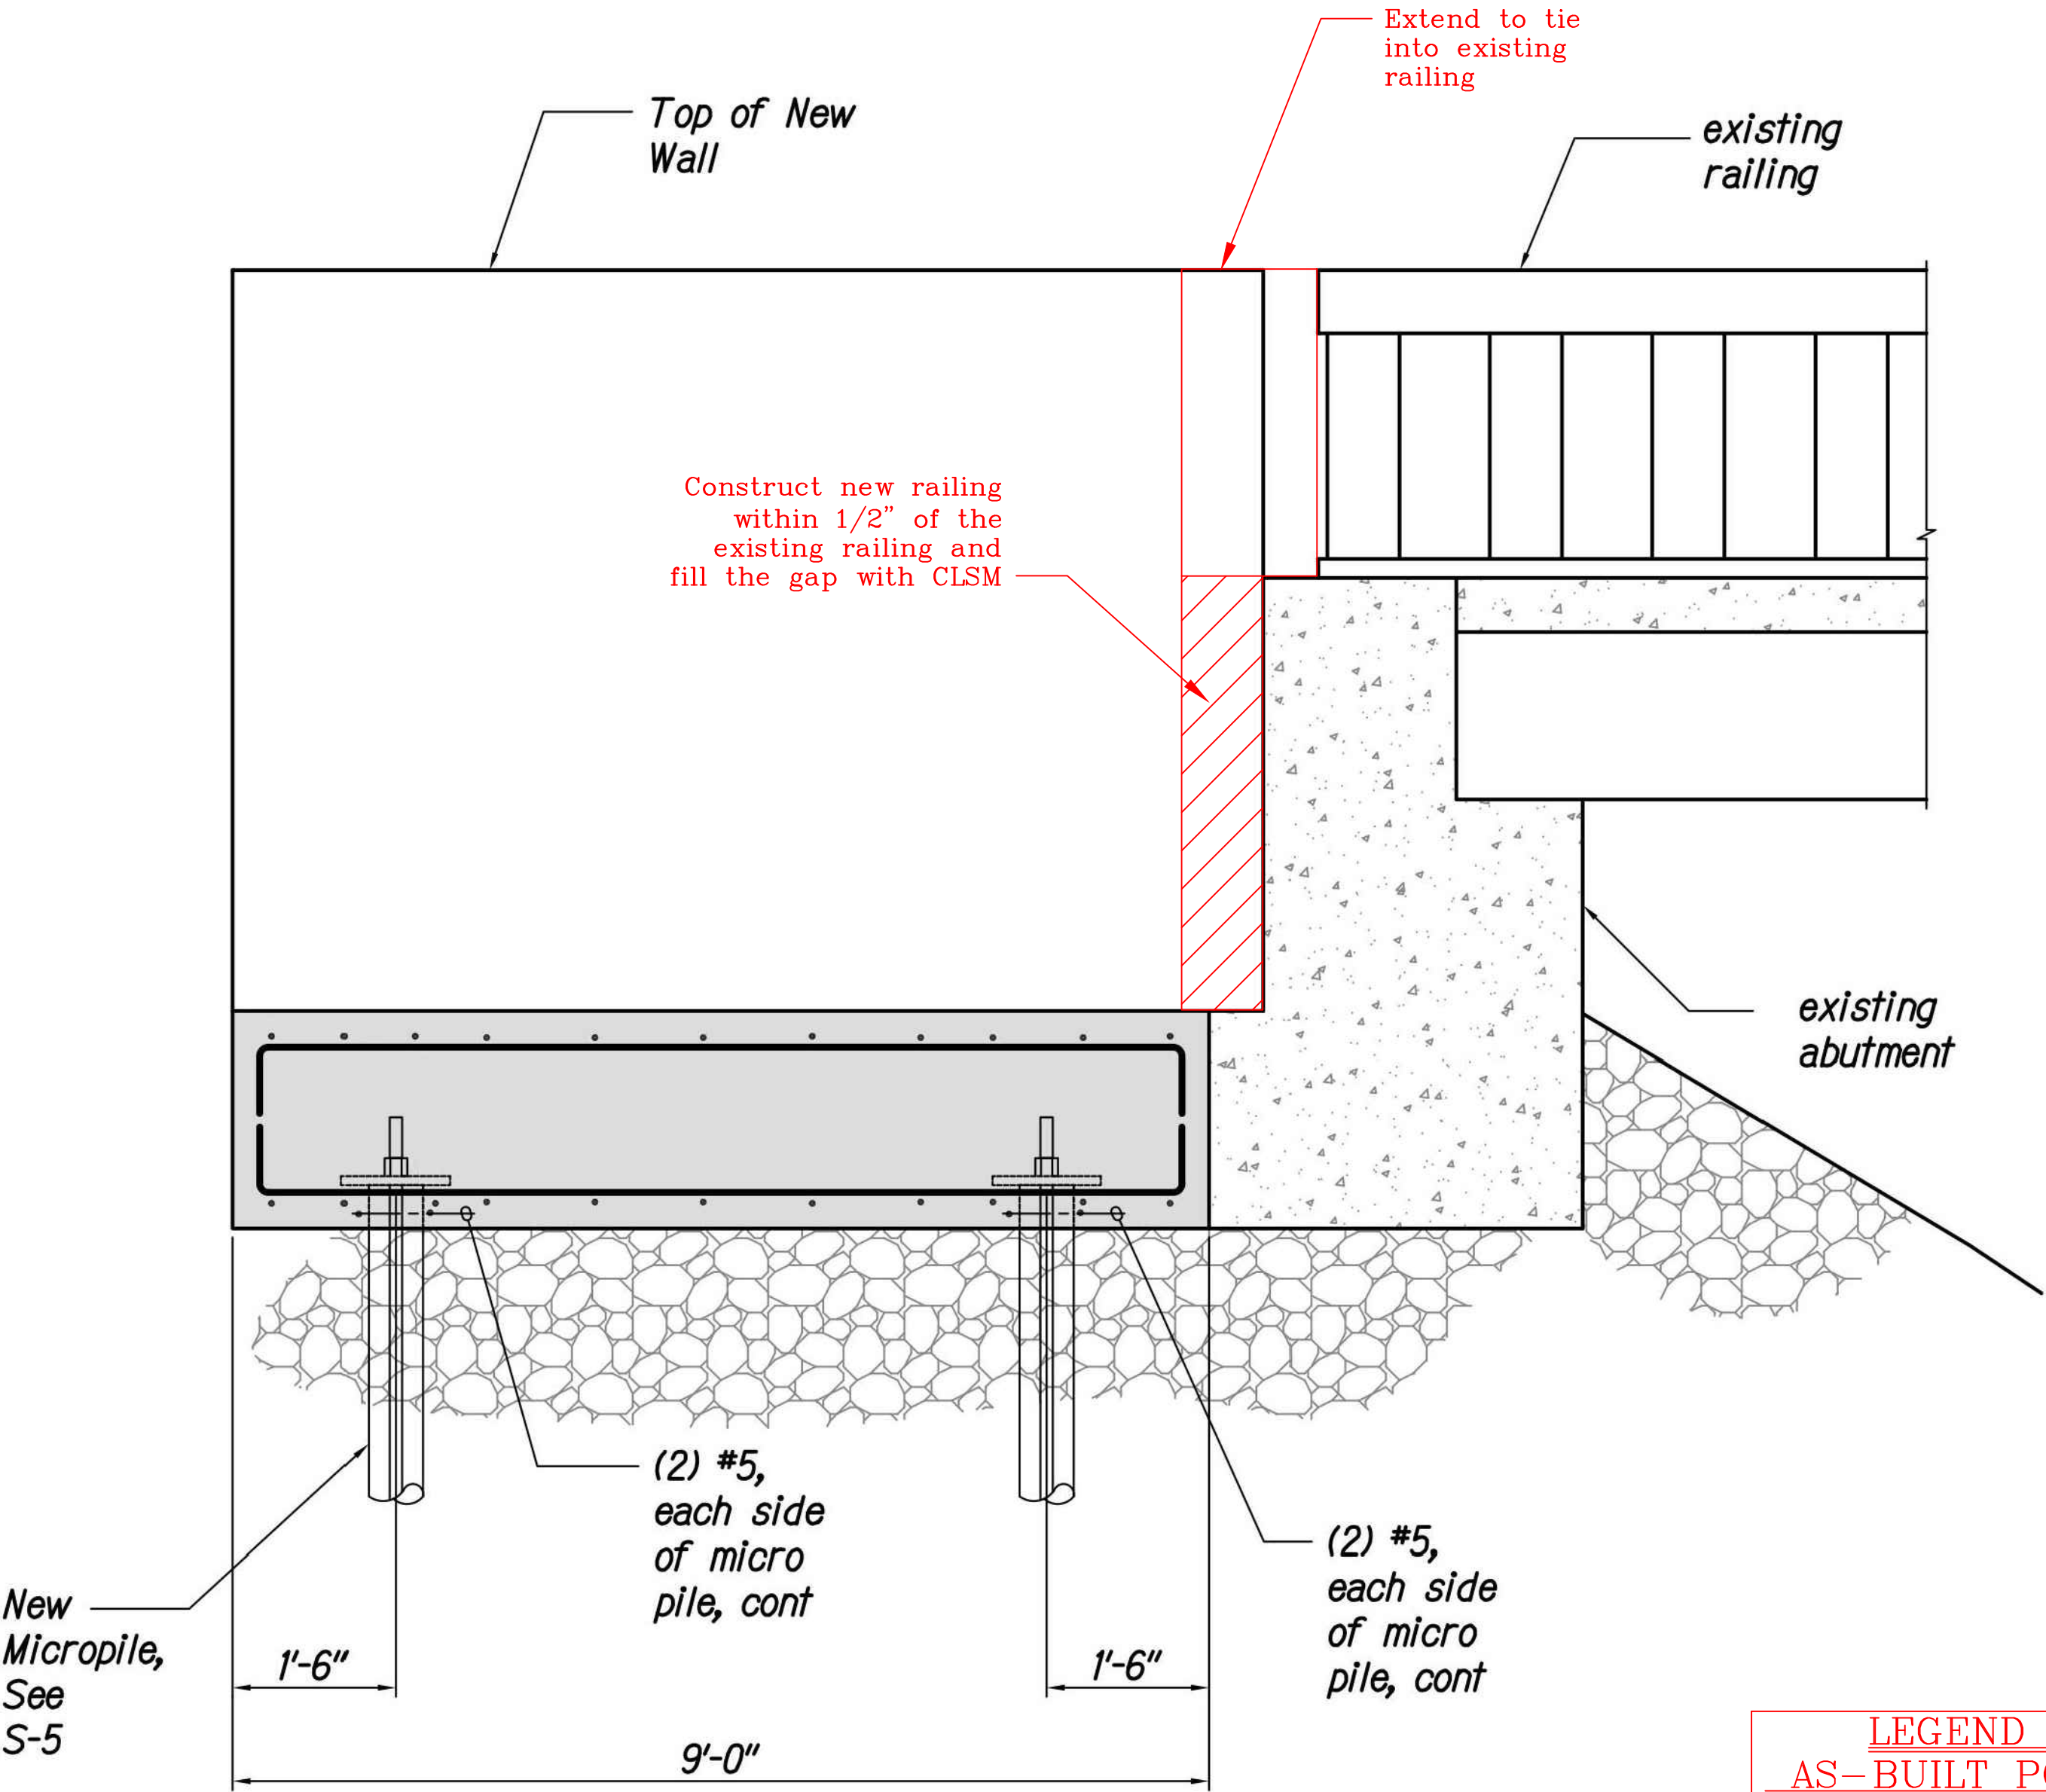

SECTION
Scale: 3/4" = 1'-0"

LEGEND FOR AS-BUILT POSTINGS	
~~~~~	Squiggly line for as-built deletion
==	Double line for as-built deletion
Roadway	Text for as-built posting

STATE OF HAWAII  
DEPARTMENT OF TRANSPORTATION  
HIGHWAYS DIVISION  
**Kahului Wall Details**

EMERGENCY REPAIRS AT PIINAU BRIDGE  
HANA HIGHWAY, NEAR MILEPOST 17.0  
PROJECT NO. ER-20(006), UNIT 1  
Scale: As Noted Date: September 2018  
SHEET No. S-3 OF 16 SHEETS