



\\Honolulu.na.aecomnet.com\Projects\SOH DOT HIGHWAYS\6058276_PiinauBrd\300-Work\910 CAD\20-SHEETS\1 Title Sheet.dwg 03/11/19 10:39 AM nakanor

DESIGNED BY _____ AECOM
MANAGED BY _____ HWY-M
PHONE (808) 873-3535
DATE SEPTEMBER 2018

INDEX TO DRAWINGS	
SHEET NO.	DESCRIPTION
1	TITLE SHEET
2	GENERAL AND CONSTRUCTION NOTES
3	WATER POLLUTION AND EROSION CONTROL NOTES
4	SITE PLAN
5	EROSION MAT DETAILS
6	DETAILS
7	EROSION CONTROL PLAN AND DETAILS
8	TRAFFIC CONTROL PLAN
9	STRUCTURAL NOTES
10	BRIDGE PLAN VIEW
11	KAHULUI WALL DETAILS
12	HANA WALL DETAILS
13	HANA WALL DETAILS
14	MICROPILE DETAIL
15	SOIL ANCHOR DETAILS
16	SOIL ANCHORS DETAILS

CHANGES MADE DURING CONSTRUCTION HAVE BEEN INCORPORATED ON THESE PLANS EXCEPT CHANGES IN THE ORIGINAL THEORETICAL QUANTITIES. FOR ACTUAL QUANTITIES REFER TO PROJECT LEDGER AND/OR COMPUTATION BOOK.

LEGEND FOR AS-BUILT POSTINGS	
	Squiggly line for as-built deletion
	Double line for as-built deletion
Roadway	Text for as-built posting

STATE OF HAWAII
DEPARTMENT OF TRANSPORTATION
HIGHWAYS DIVISION
HONOLULU, HAWAII
"AS-BUILT"
PLANS FOR



**EMERGENCY REPAIRS
AT PIINAAU BRIDGE**
HANA HIGHWAY, NEAR MILEPOST 17.0
PROJECT NO. ER-20(006), UNIT 1

DISTRICT OF HANA
ISLAND OF MAUI



LAYOUT PLAN
0 400 800 1200
SCALE: 1" = 400' FEET

FED. ROAD DIST. NO.	STATE	PROJ. NO.	FISCAL YEAR	SHEET NO.	TOTAL SHEETS
MAUI	HAWAII	ER-20(006)	2018	1	16

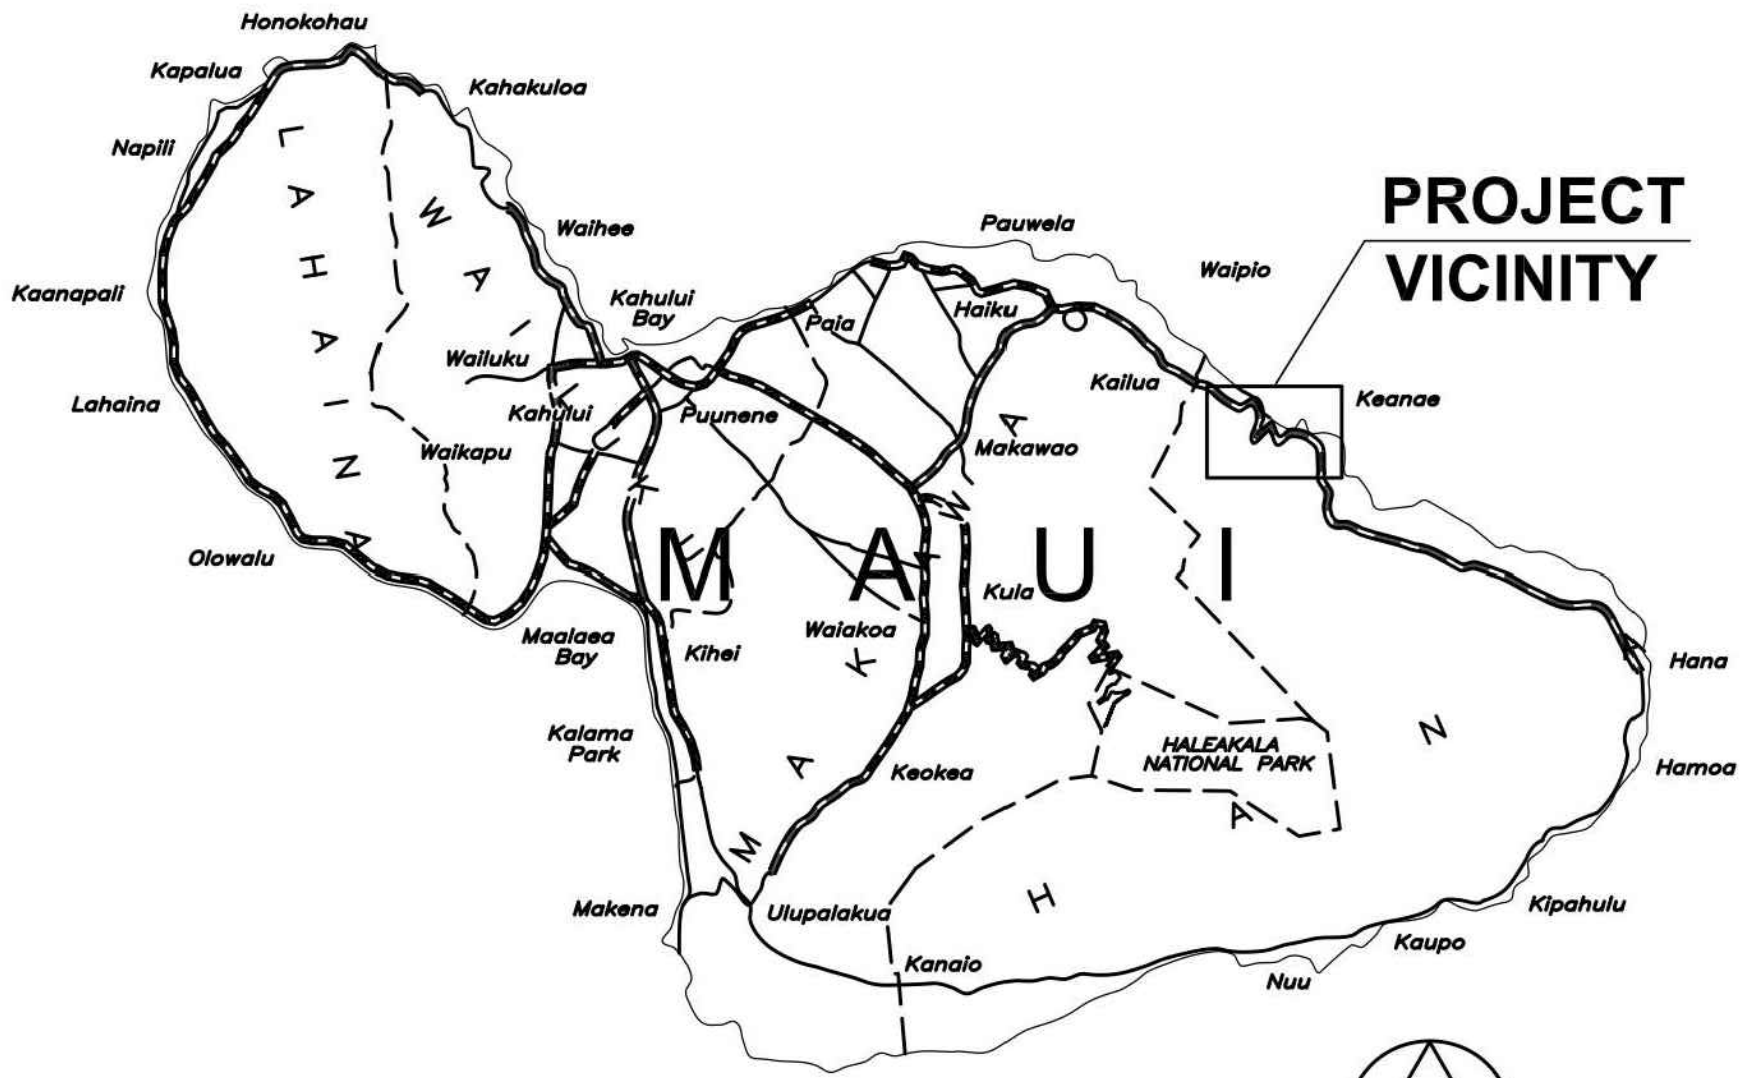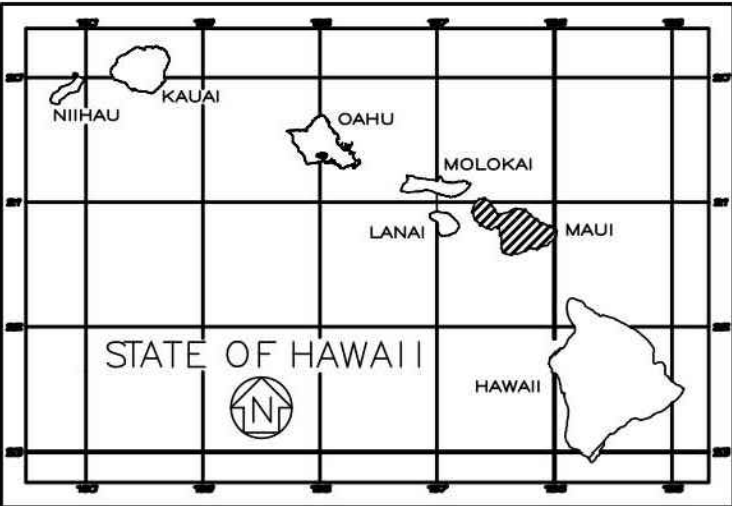

ISLAND OF MAUI
5 0 5 10
SCALE IN MILES

DEPARTMENT OF TRANSPORTATION STATE OF HAWAII	
APPROVED:	
DIR. OF TRANSPORTATION	DATE