




FED. ROAD DIST. NO.	STATE	FED. AID PROJ. NO.	FISCAL YEAR	SHEET NO.	TOTAL SHEETS
HAWAII	HAW.	STP-0360(9)	2006	11	16

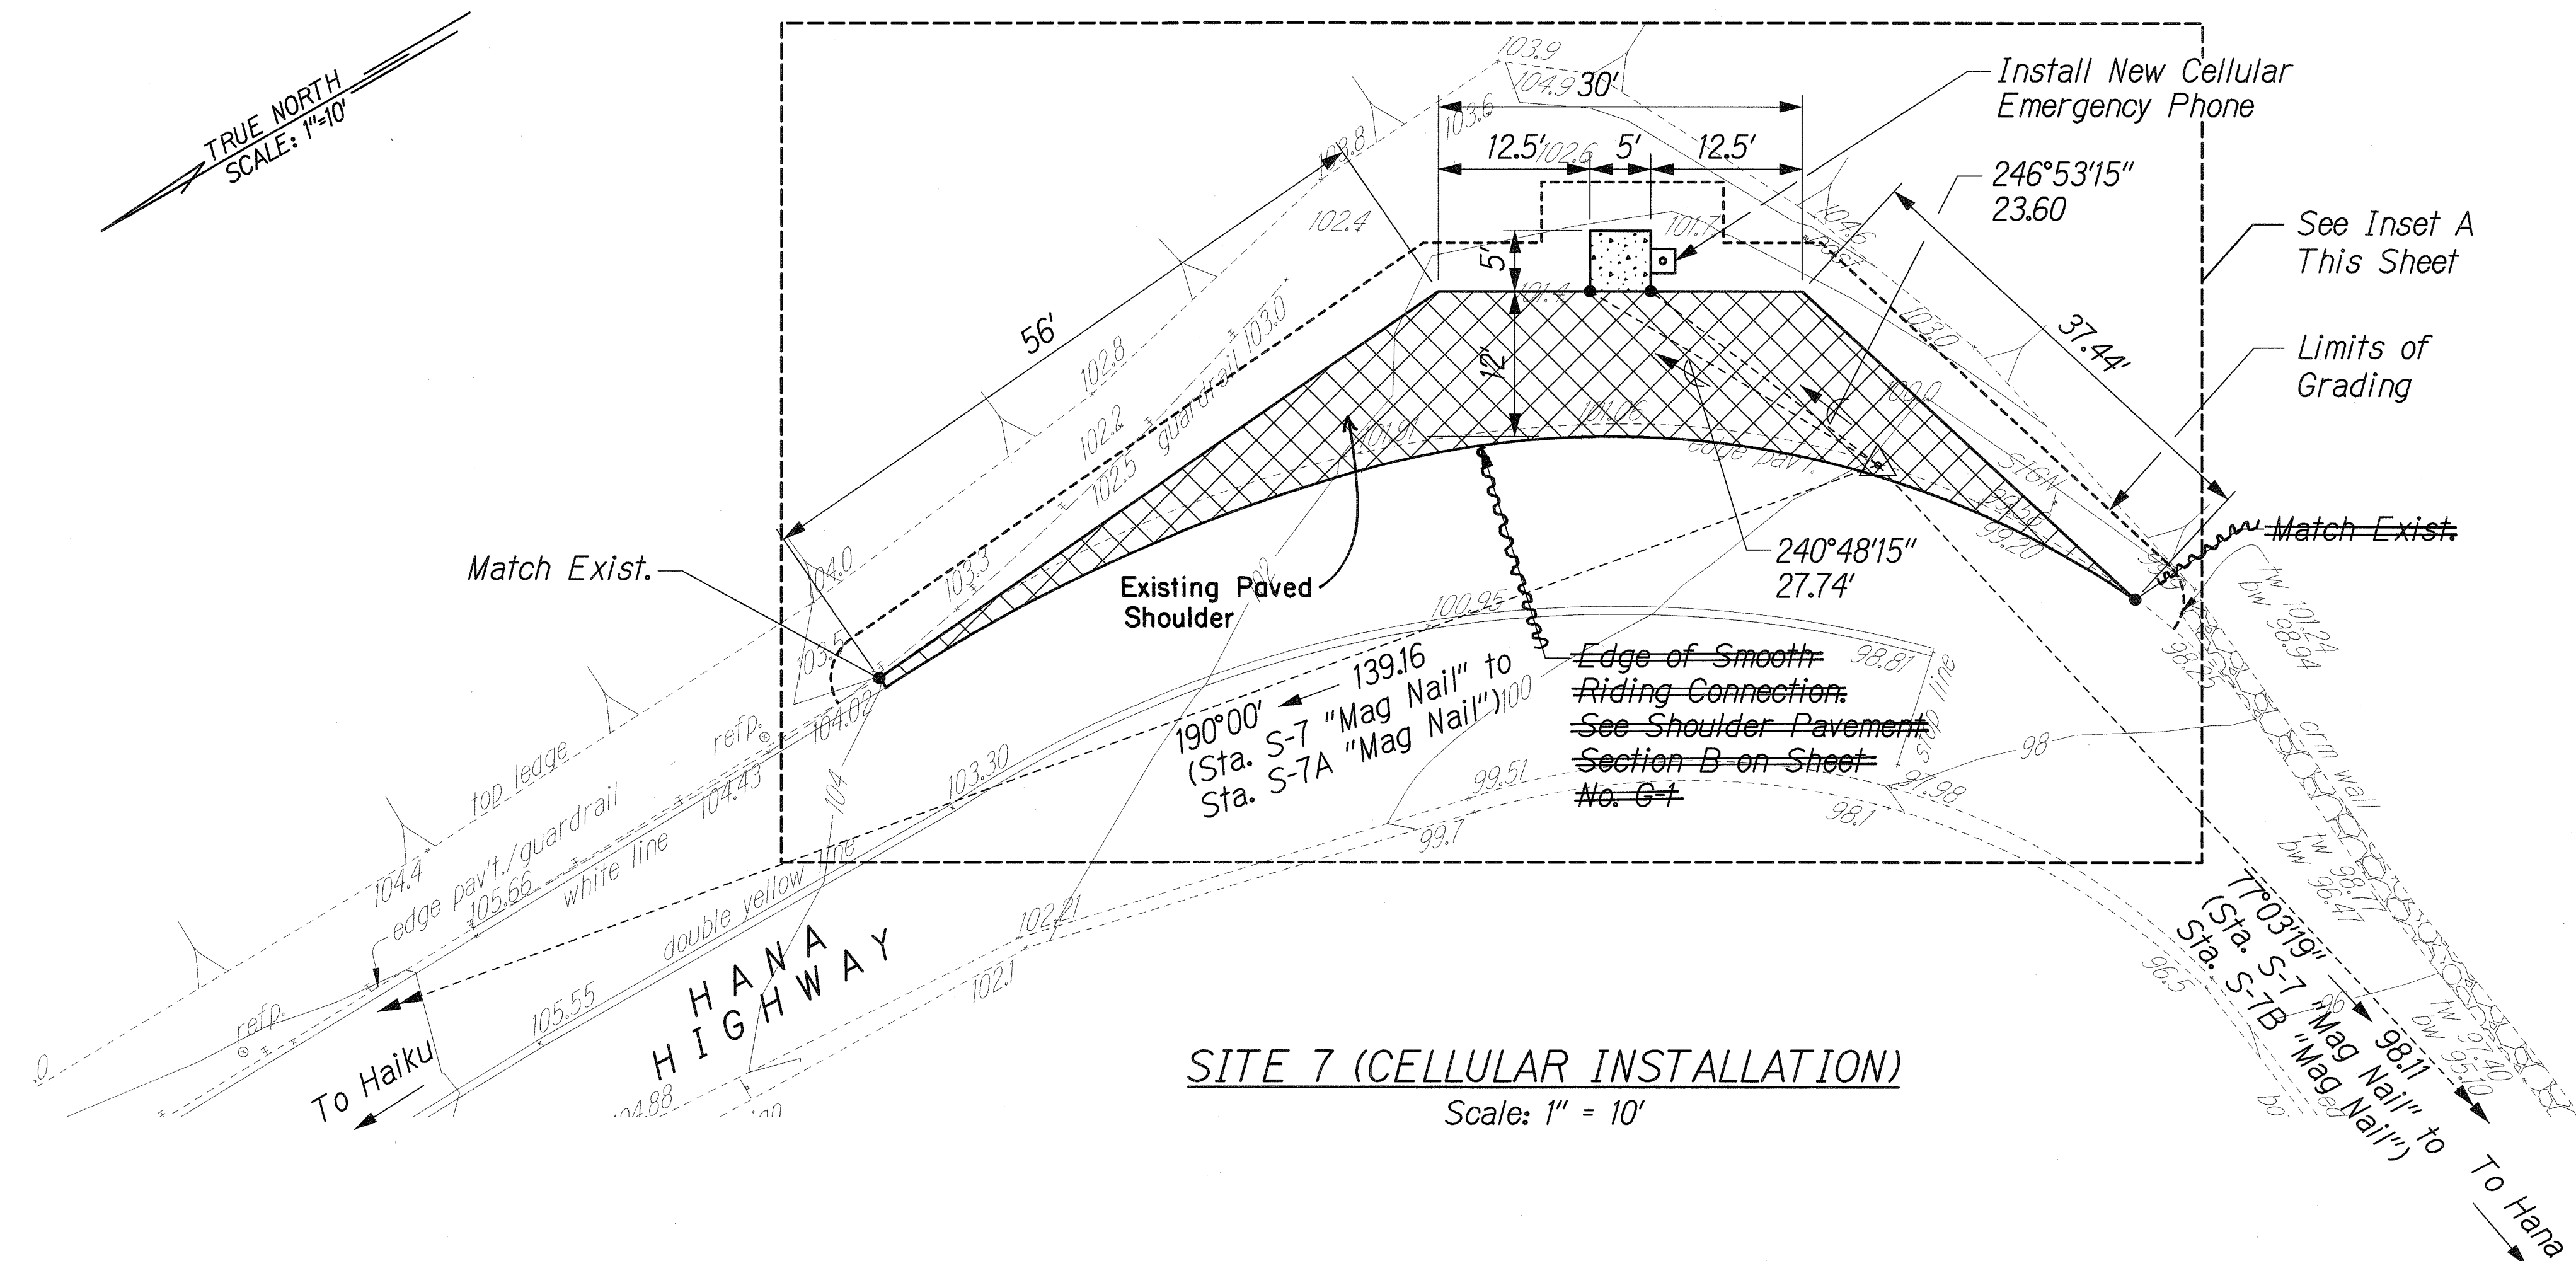

FED. ROAD DIST. NO.	STATE	FED. AID PROJ. NO.	FISCAL YEAR	SHEET NO.	TOTAL SHEETS
HAWAII	HAW.	STP-0360(9)	2006	12	16

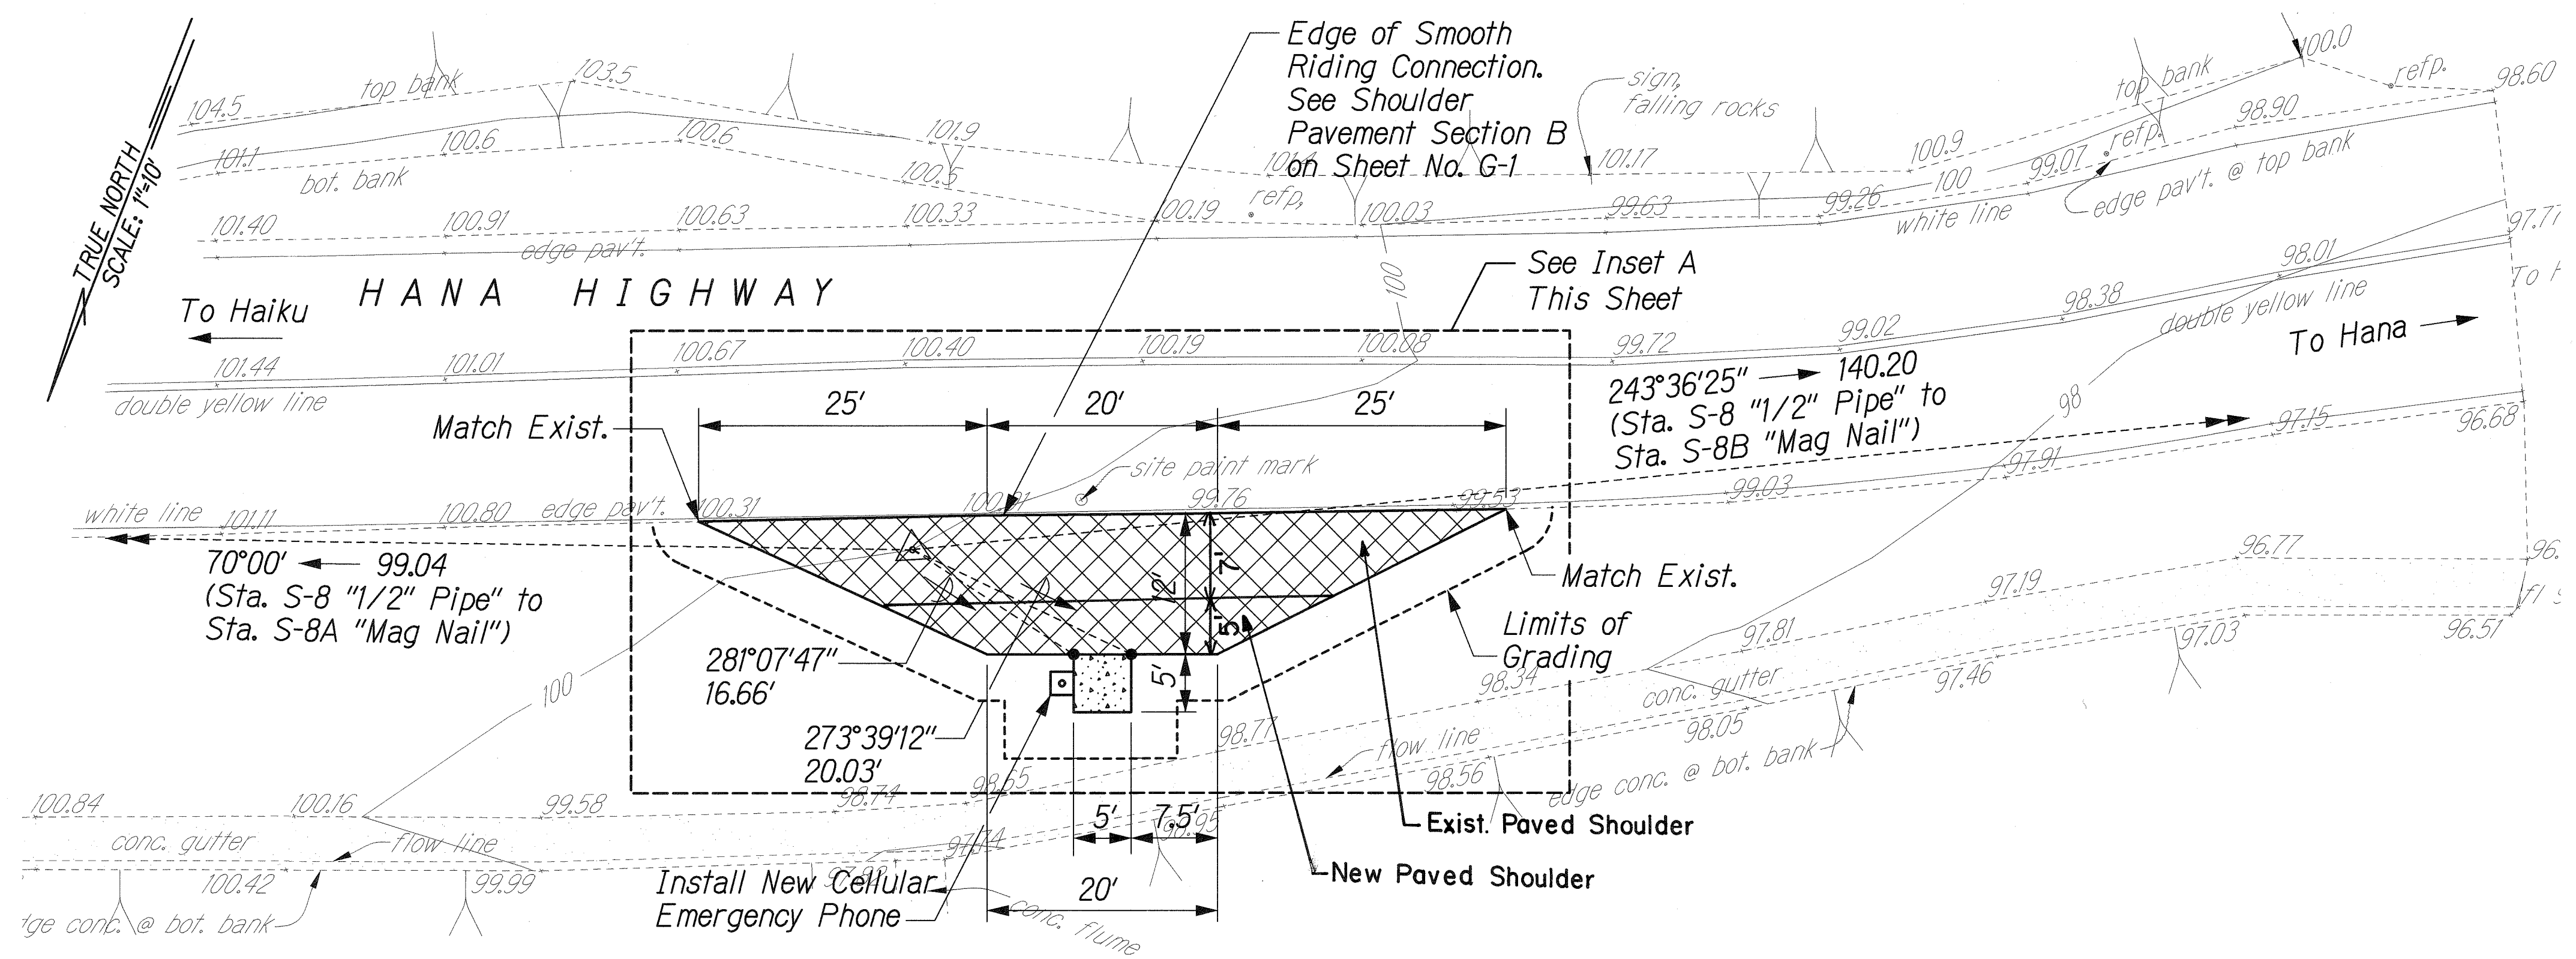

SITE 8 (CELLULAR INSTALLATION)
Scale: 1" = 10'

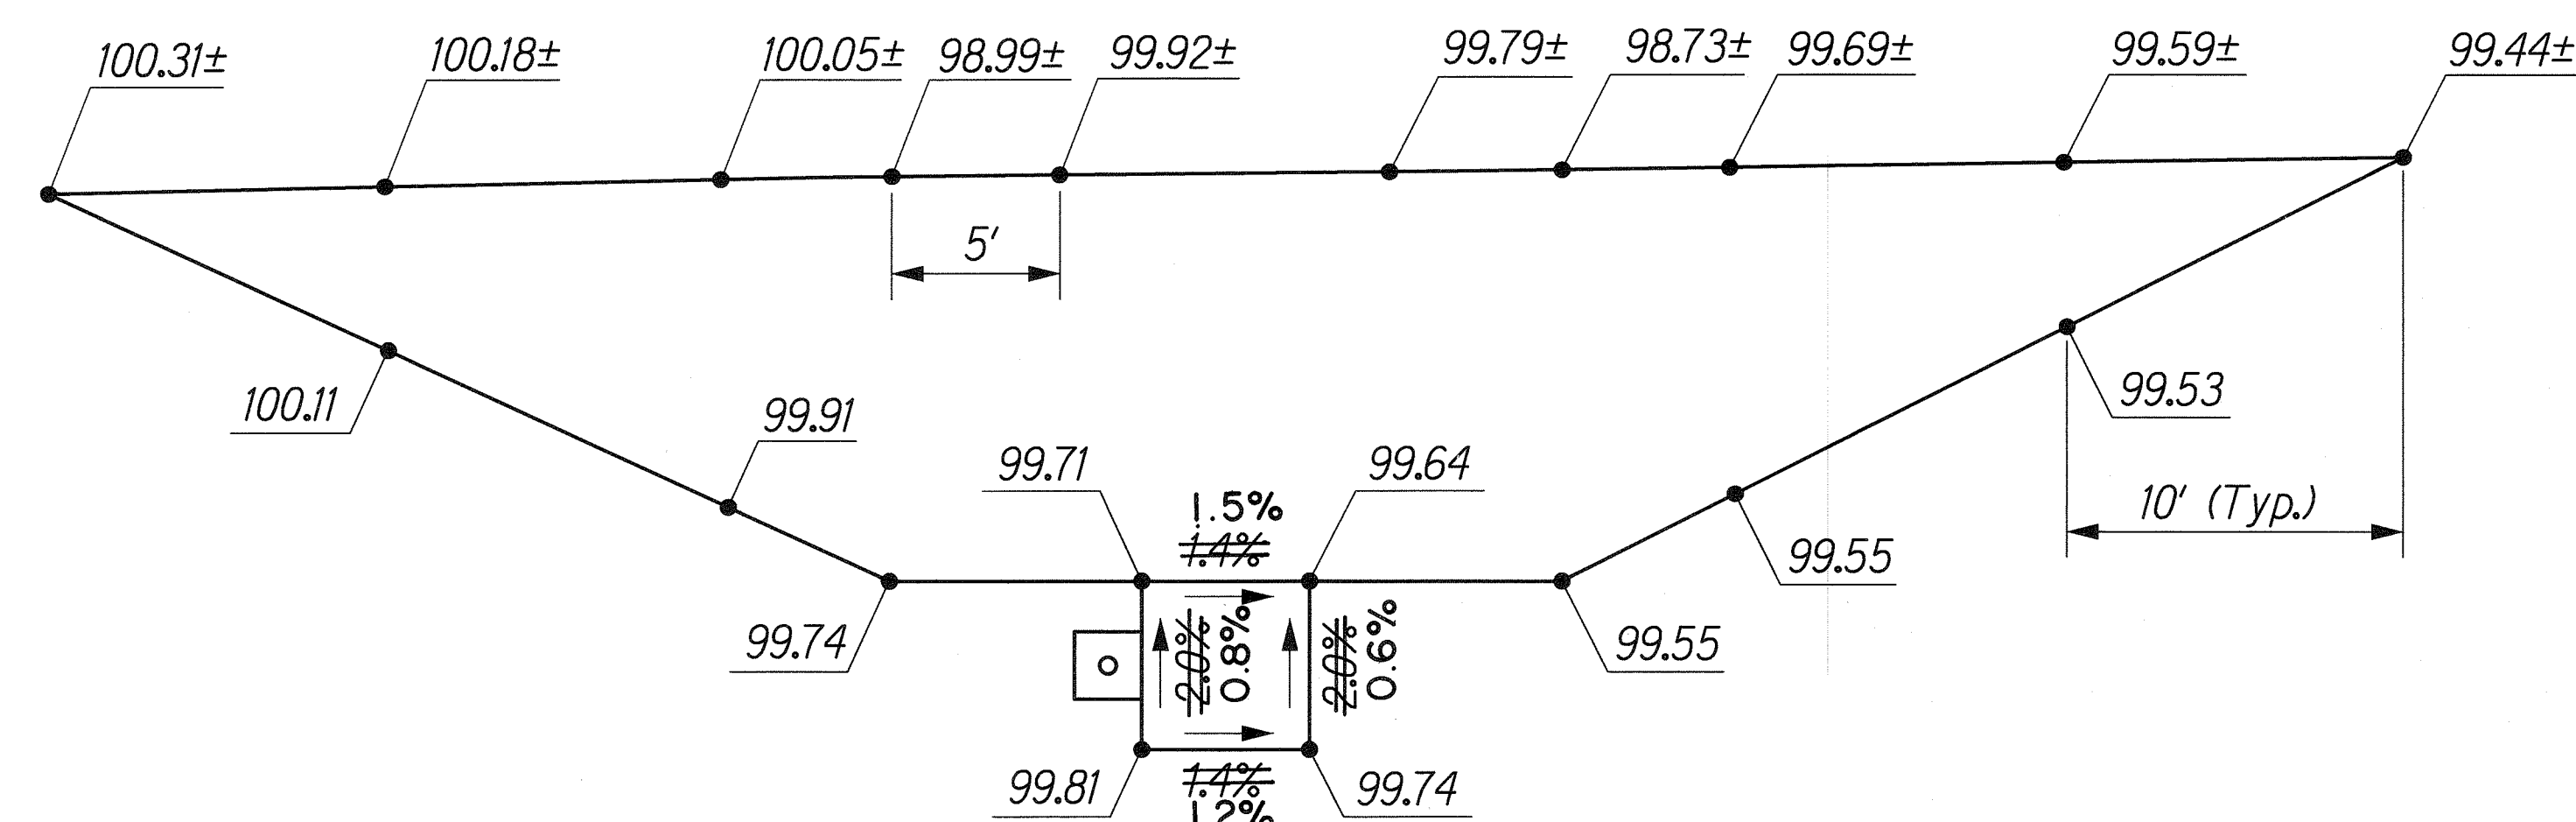


INSET A
Scale: 1" = 5'

- LEGEND**
- 3" AC Mix No. IV w/ 6" Aggregate Base Course See Shoulder Pavement Section A on Sheet No. G1.
 - 3" AC Mix No. IV w/ 18" Aggregate Base Course See Shoulder Pavement Section B on Sheet No. G1.
 - 4" Concrete Pad w/ 6" Aggregate Base Course See Detail on Sheet No. G4.

SURVEY PLOTTED BY	DATE
DESIGNED BY	
CHECKED BY	
ORIGINAL PLAN	
NOTE BOOK	
QUANTITIES BY	
CHECKED BY	
No.	

L:\HAWAII\HIGHWAY\MICROSTATION\PLANS\PLAN08.dgn

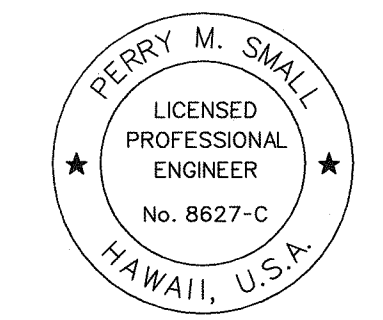


THIS WORK WAS PREPARED BY ME OR UNDER MY SUPERVISION.
Perry M. Small


STATE OF HAWAII
DEPARTMENT OF TRANSPORTATION
HIGHWAYS DIVISION

SITE PLAN - 4
HANA HIGHWAY
INSTALLATION OF EMERGENCY TELEPHONES
KAUPAKALUA ROAD TO UA KEA ROAD
FEDERAL-AID PROJECT STP-0360(9)
SCALE: As Shown DATE: October, 2005

FED. ROAD DIST. NO.	STATE	FED. AID PROJ. NO.	FISCAL YEAR	SHEET NO.	TOTAL SHEETS
HAWAII	HAW.	STP-0360(9)	2006	15	16

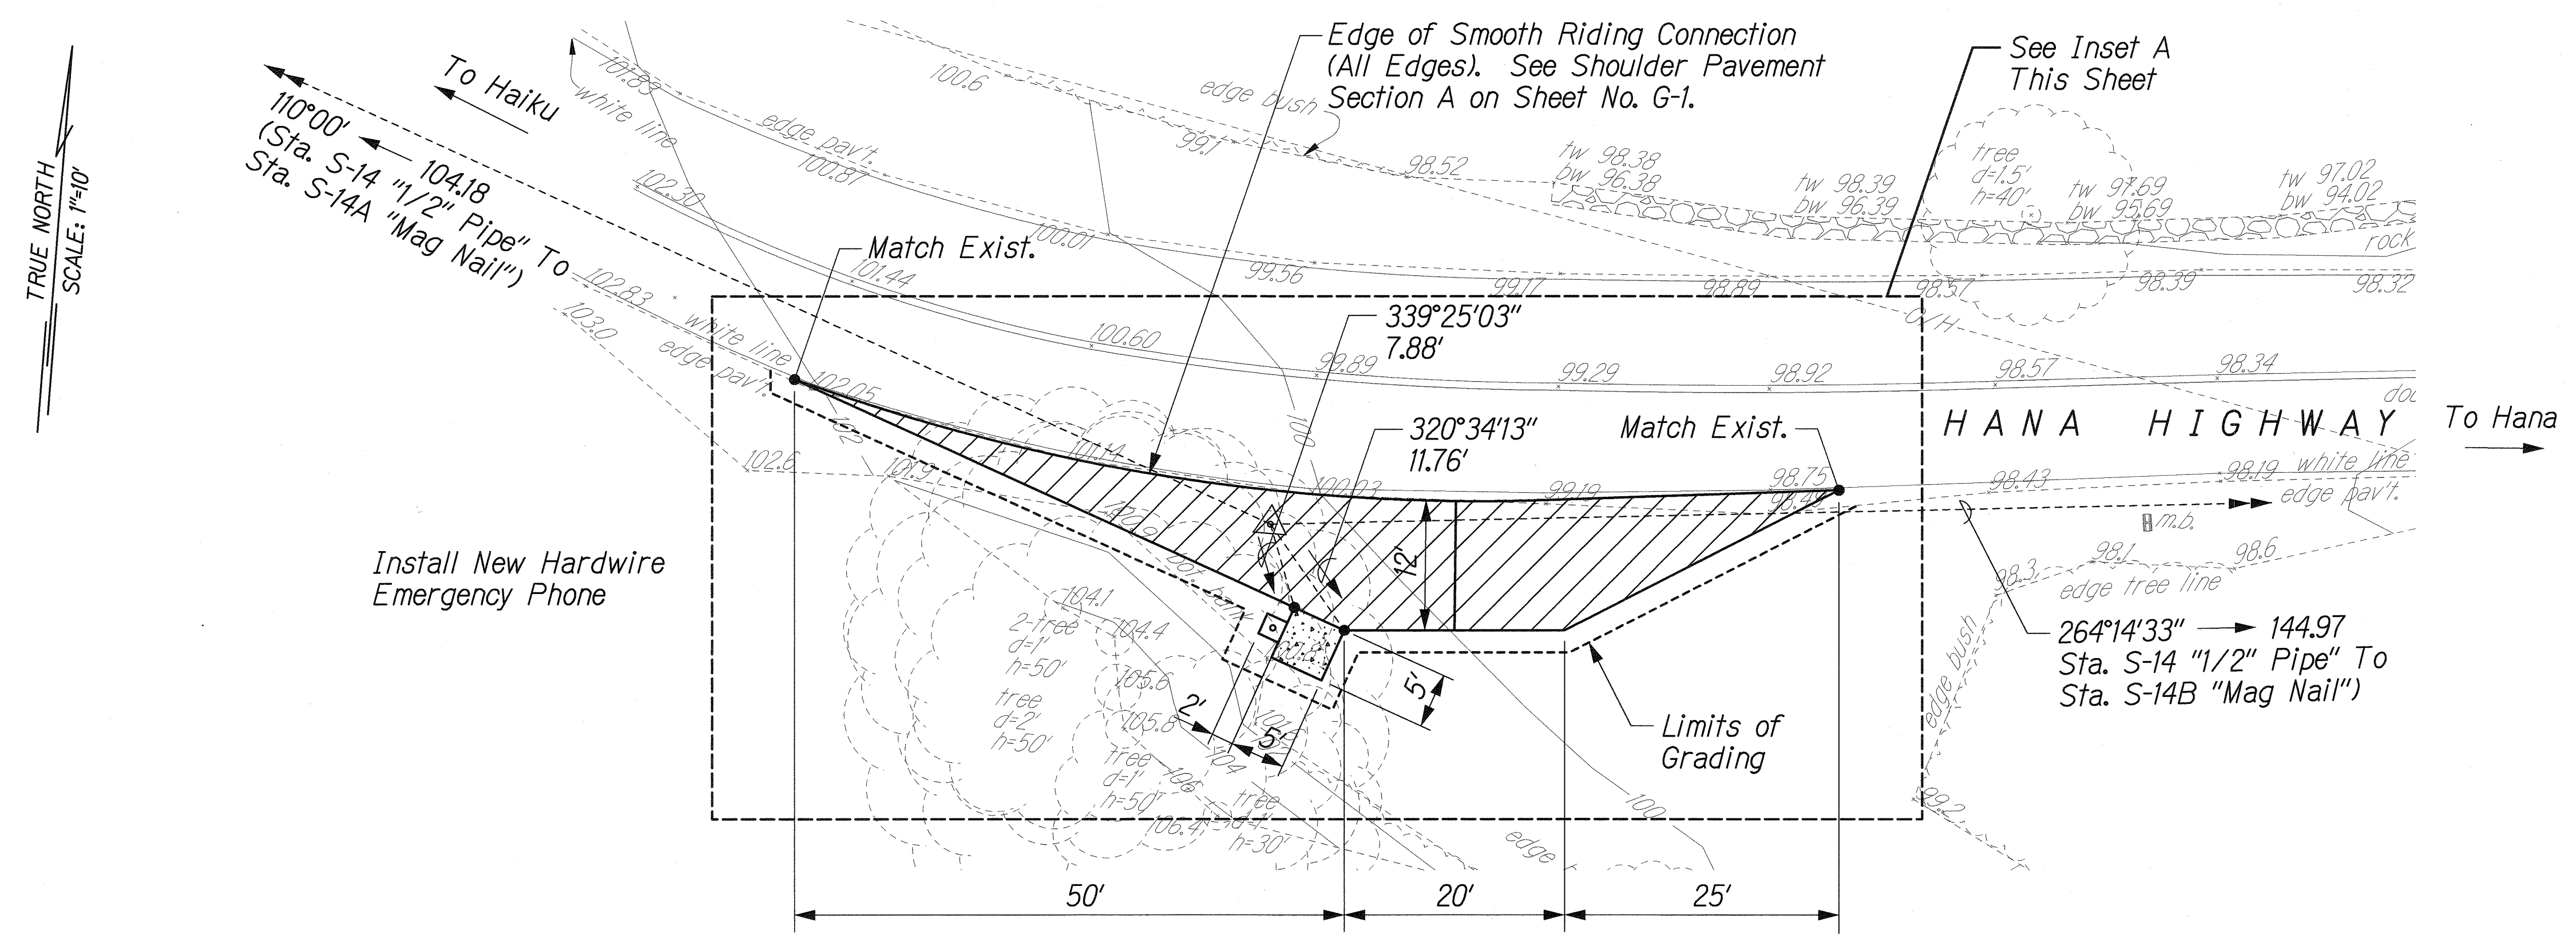


SITE 14 (HARDWIRE INSTALLATION)
Scale: 1" = 10'

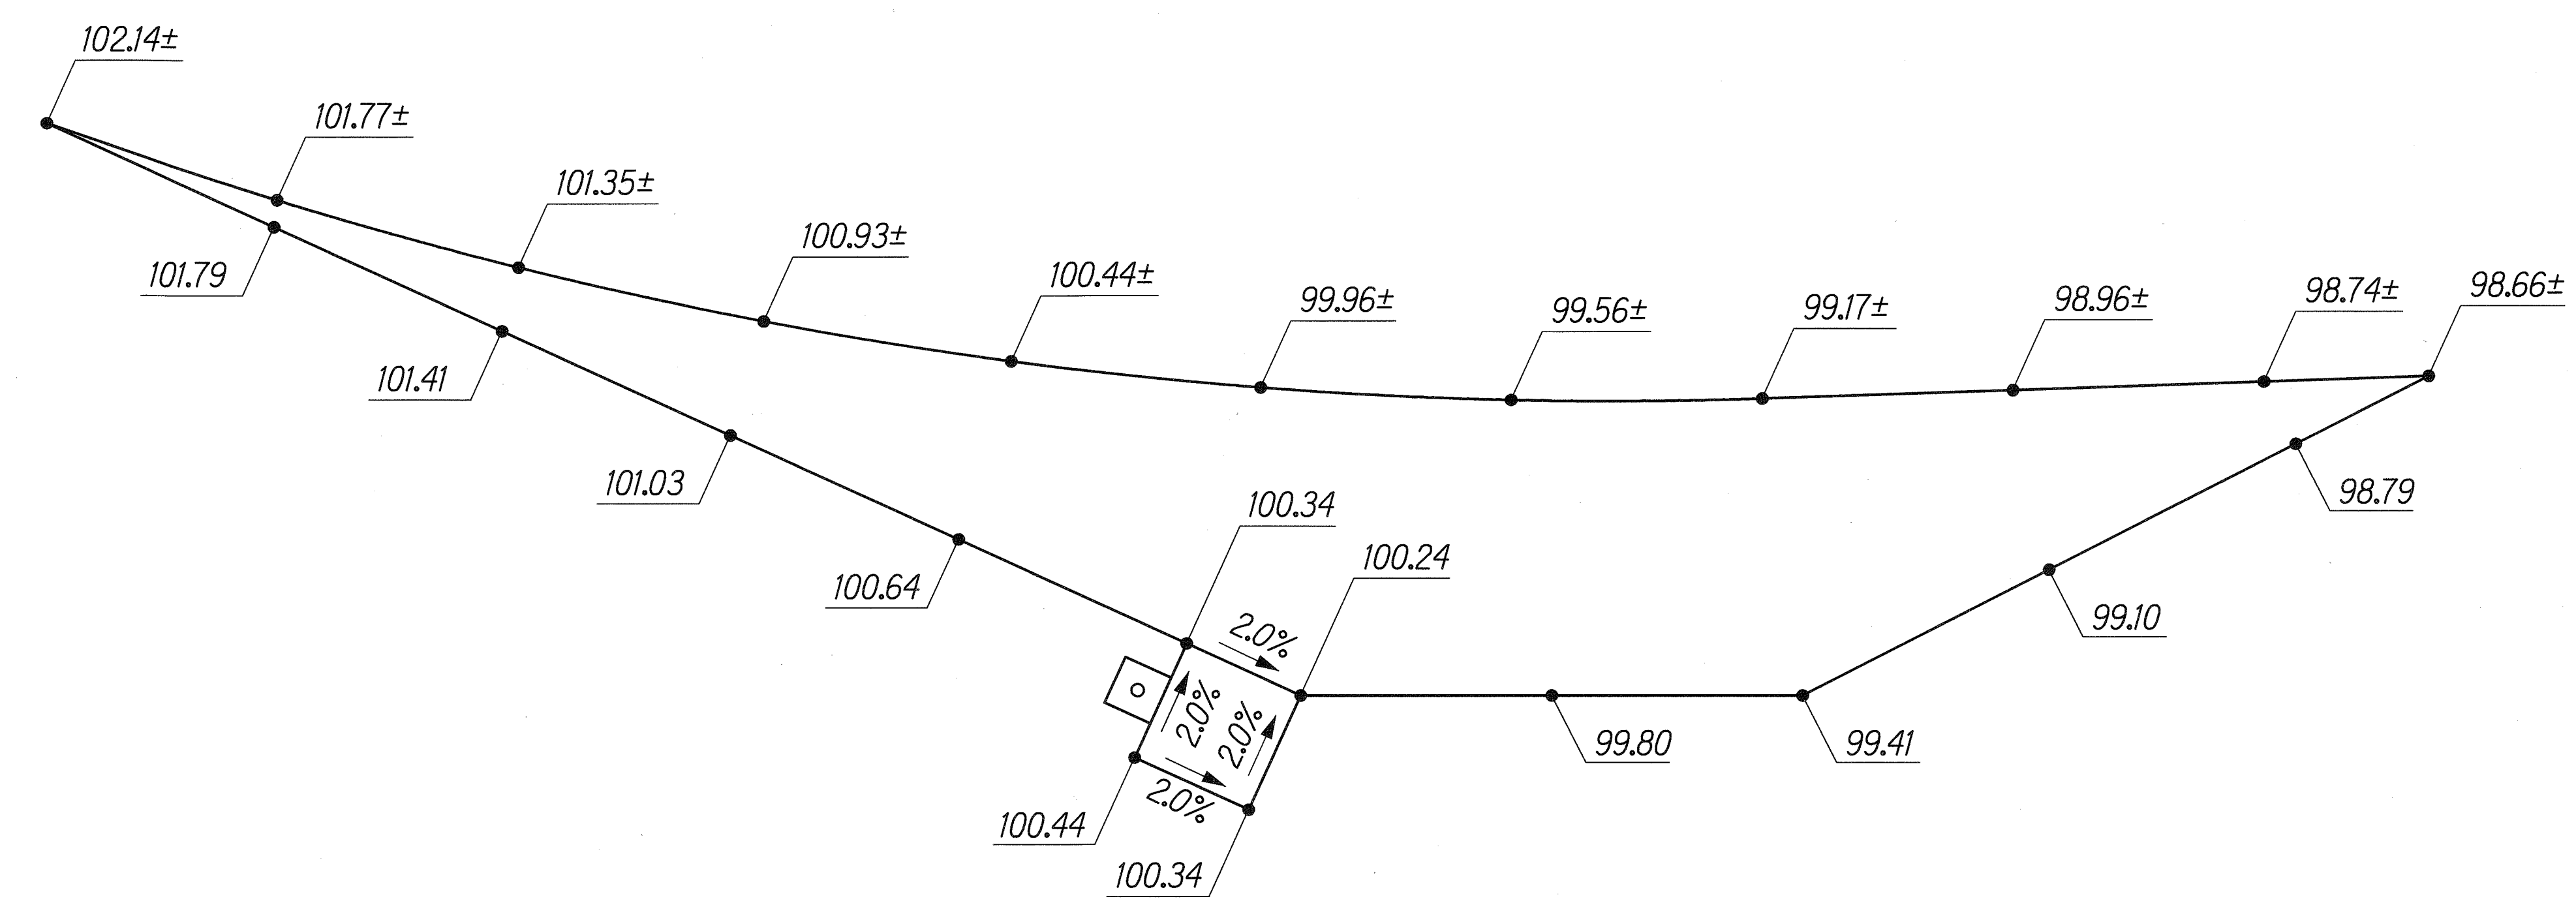

INSET A
Scale: 1" = 5'

- LEGEND**
- 3" AC Mix No. IV w/ 6" Aggregate Base Course See Shoulder Pavement Section A on Sheet No. G1.
 - 3" AC Mix No. IV w/ 18" Aggregate Base Course See Shoulder Pavement Section B on Sheet No. G1.
 - 4" Concrete Pad w/ 6" Aggregate Base Course See Detail on Sheet No. G4.

SURVEY PLOTTED BY	DATE
DRAWN BY	
DESIGNED BY	
QUANTITIES BY	
CHECKED BY	

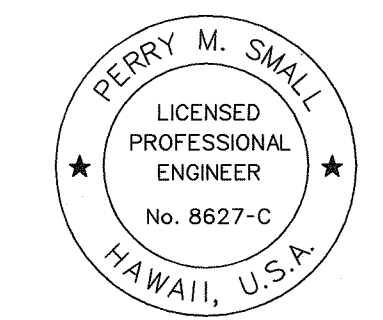

THIS WORK WAS PREPARED BY ME OR UNDER MY SUPERVISION.
Perry M. Small

STATE OF HAWAII
DEPARTMENT OF TRANSPORTATION
HIGHWAYS DIVISION

SITE PLAN - 7
HANA HIGHWAY
INSTALLATION OF EMERGENCY TELEPHONES
KAUPAKALUA ROAD TO UA KEA ROAD
FEDERAL-AID PROJECT STP-0360(9)
SCALE: As Shown DATE: October, 2005

SHEET No. C7 OF 8 SHEETS

