

INDEX TO DRAWINGS	
SHEET NO.	DESCRIPTION
1	TITLE SHEET
2	LOCATION SUMMARY
3	GENERAL NOTES & TYPICAL INSTALLATION DETAILS
4 - 5	WATER POLLUTION AND EROSION CONTROL NOTES
6-7	MISCELLANEOUS DETAILS
8	LOW SPEED UNDIVIDED HIGHWAY WORK ZONE SIGNING PLAN, NOTES & DETAILS
9 - 16	SITE PLAN

STATE OF HAWAII

DEPARTMENT OF TRANSPORTATION

HIGHWAYS DIVISION

HONOLULU, HAWAII

"AS-BUILT"

PLANS FOR


HANA HIGHWAY

INSTALLATION OF EMERGENCY TELEPHONES



KAUPAKALUA ROAD TO UA KEA ROAD

FEDERAL-AID PROJECT NO. STP-0360(9)

FED. ROAD DIST. NO.	STATE	FED. AID PROJ. NO.	FISCAL YEAR	SHEET NO.	TOTAL SHEETS
HAWAII	HAW.	STP-0360(9)	2006	1	16

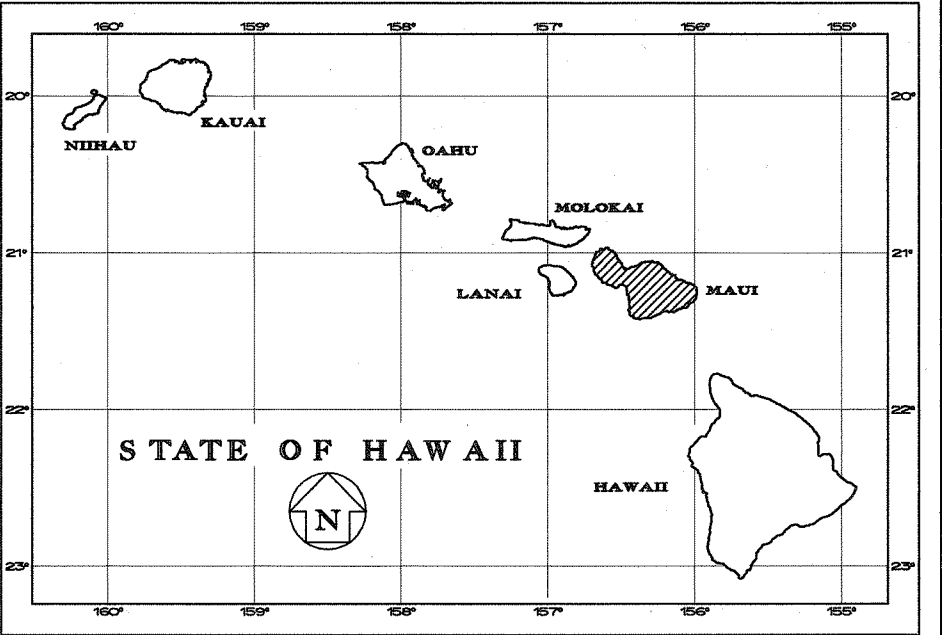

DISTRICTS OF MAKAWAO AND HANA
ISLAND OF MAUI

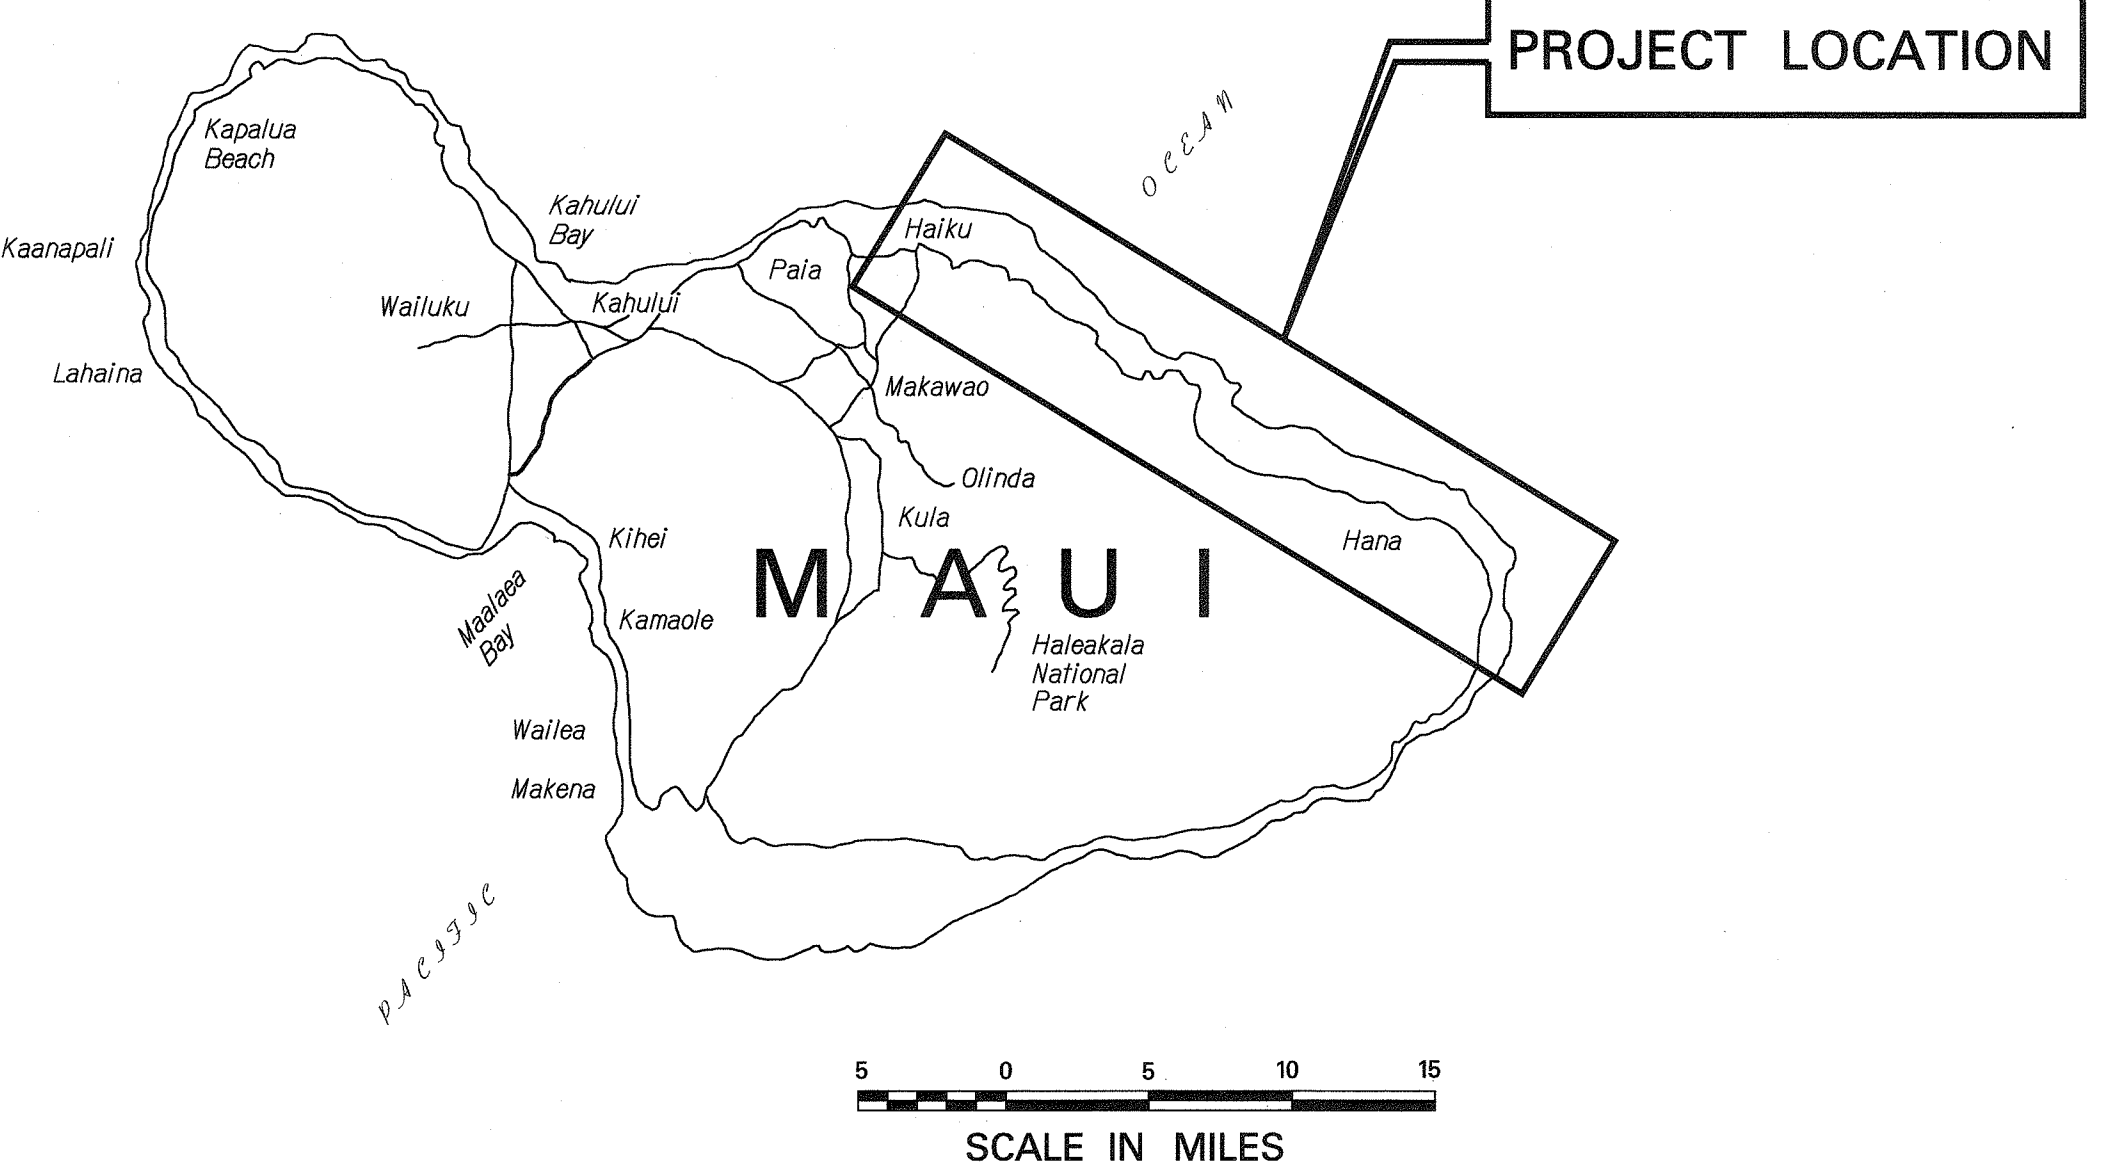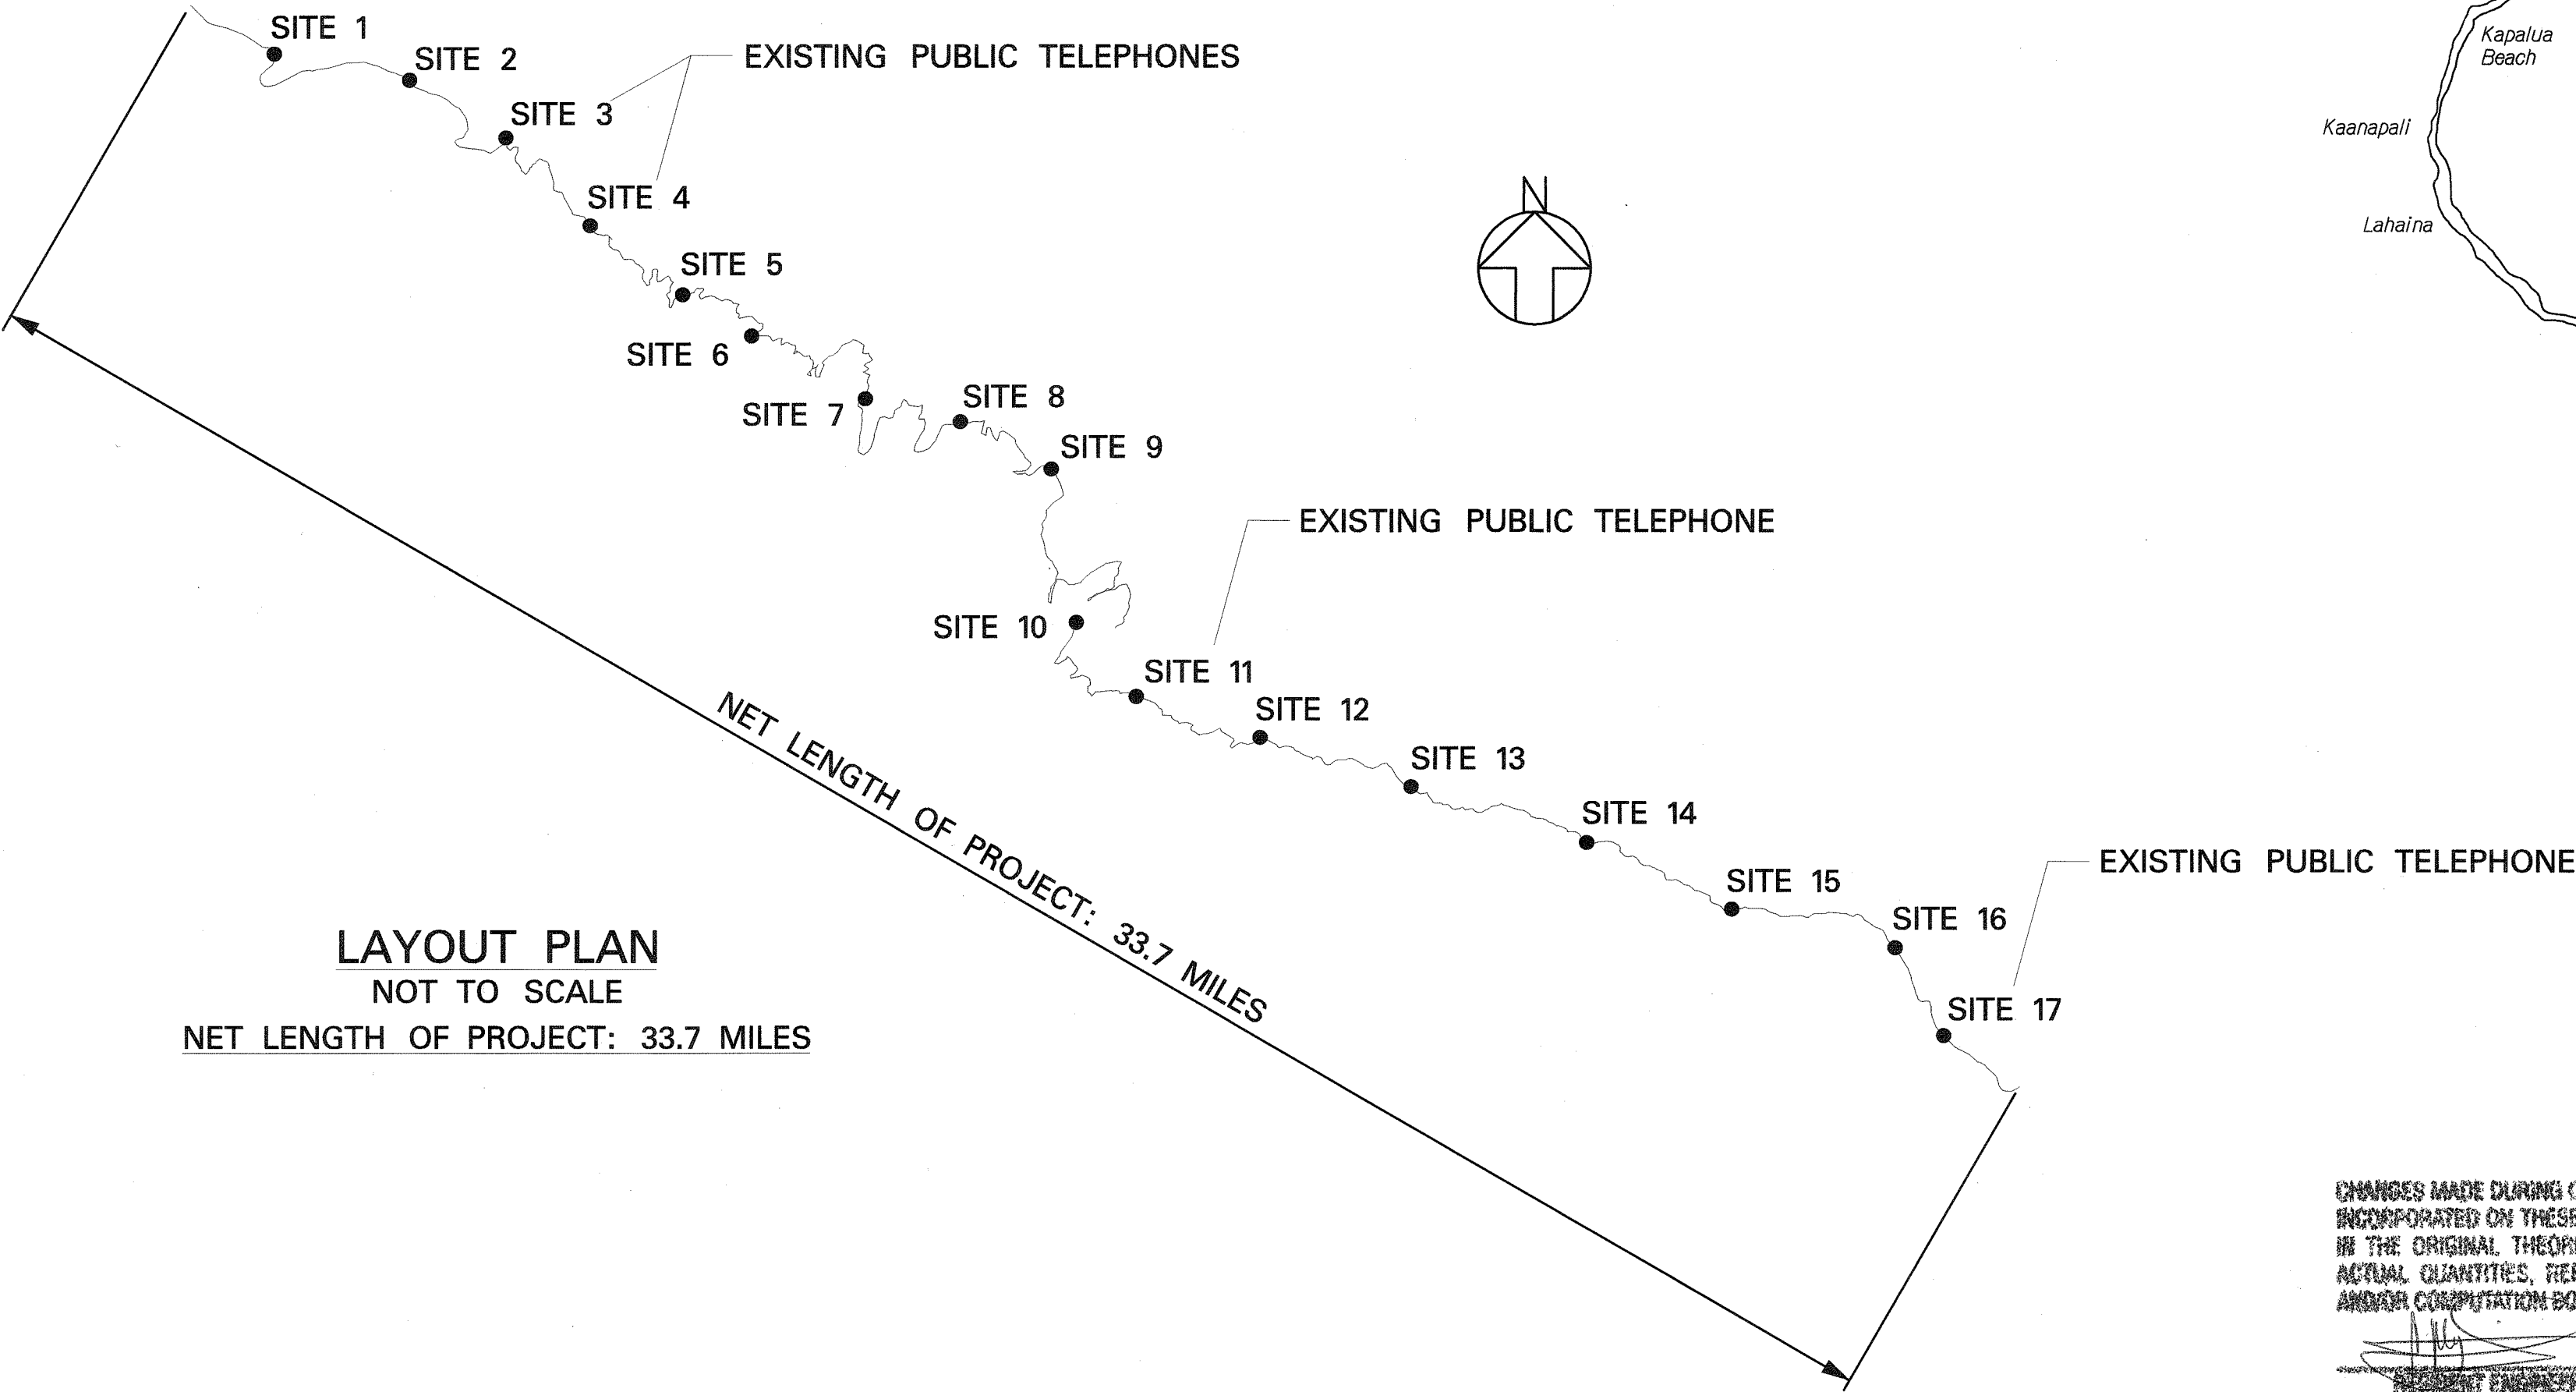

FEDERAL AID INTERSTATE PROJECTS PREVIOUSLY
CONSTRUCTED OR UNDER CONSTRUCTION

MILEPOST 0.0 TO MILEPOST 33.7

CHANGES MADE DURING CONSTRUCTION HAVE BEEN
INCORPORATED ON THESE PLANS EXCEPT CHANGES
IN THE ORIGINAL THEORETICAL QUANTITIES. FOR
ACTUAL QUANTITIES, REFER TO PROJECT LEADER
AND/OR COMPUTATION BOOK.

10/15/10
DATE

DEPARTMENT OF TRANSPORTATION STATE OF HAWAII	
APPROVED:	
<i>[Signature]</i> DIRECTOR OF TRANSPORTATION	8-15-06 DATE