
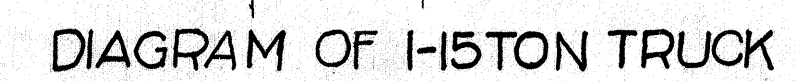


DESIGNED BY: A.H.W.
DRAWN BY: D.K.K.
TRACED BY: D.K.K.
CHECKED BY:

TRUE NORTH

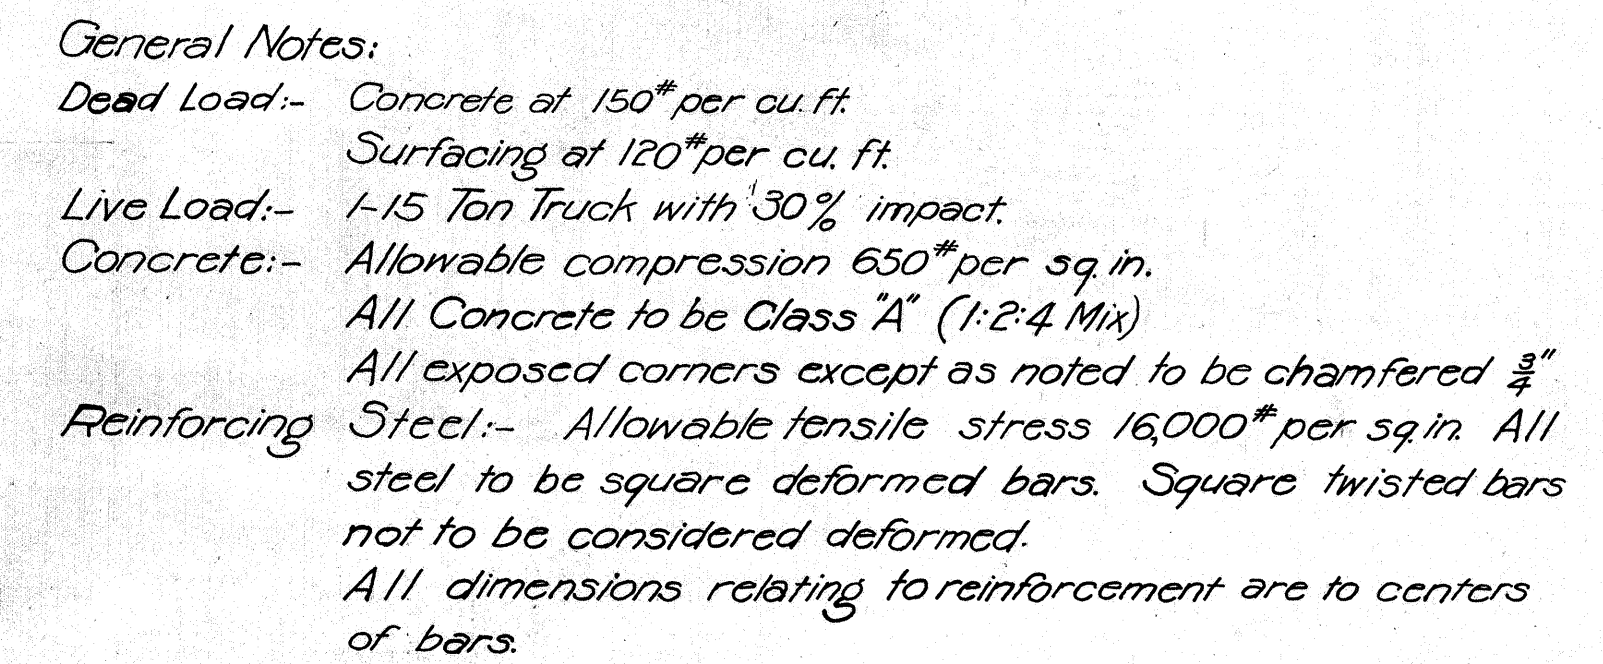

Scale: $\frac{3}{8}'' = 1'$

Jan. 1931.

4187.7

Plan File	Pocket	Folder	Plan
No. 6	No. 15	No. 2	No.

