


| FED. ROAD DIST. NO. | STATE | PROJ. NO.   | FISCAL YEAR | SHEET NO. | TOTAL SHEETS |
|---------------------|-------|-------------|-------------|-----------|--------------|
| HAWAII              | HAW.  | 377A-02-81M | 1981        | 3         | 15           |

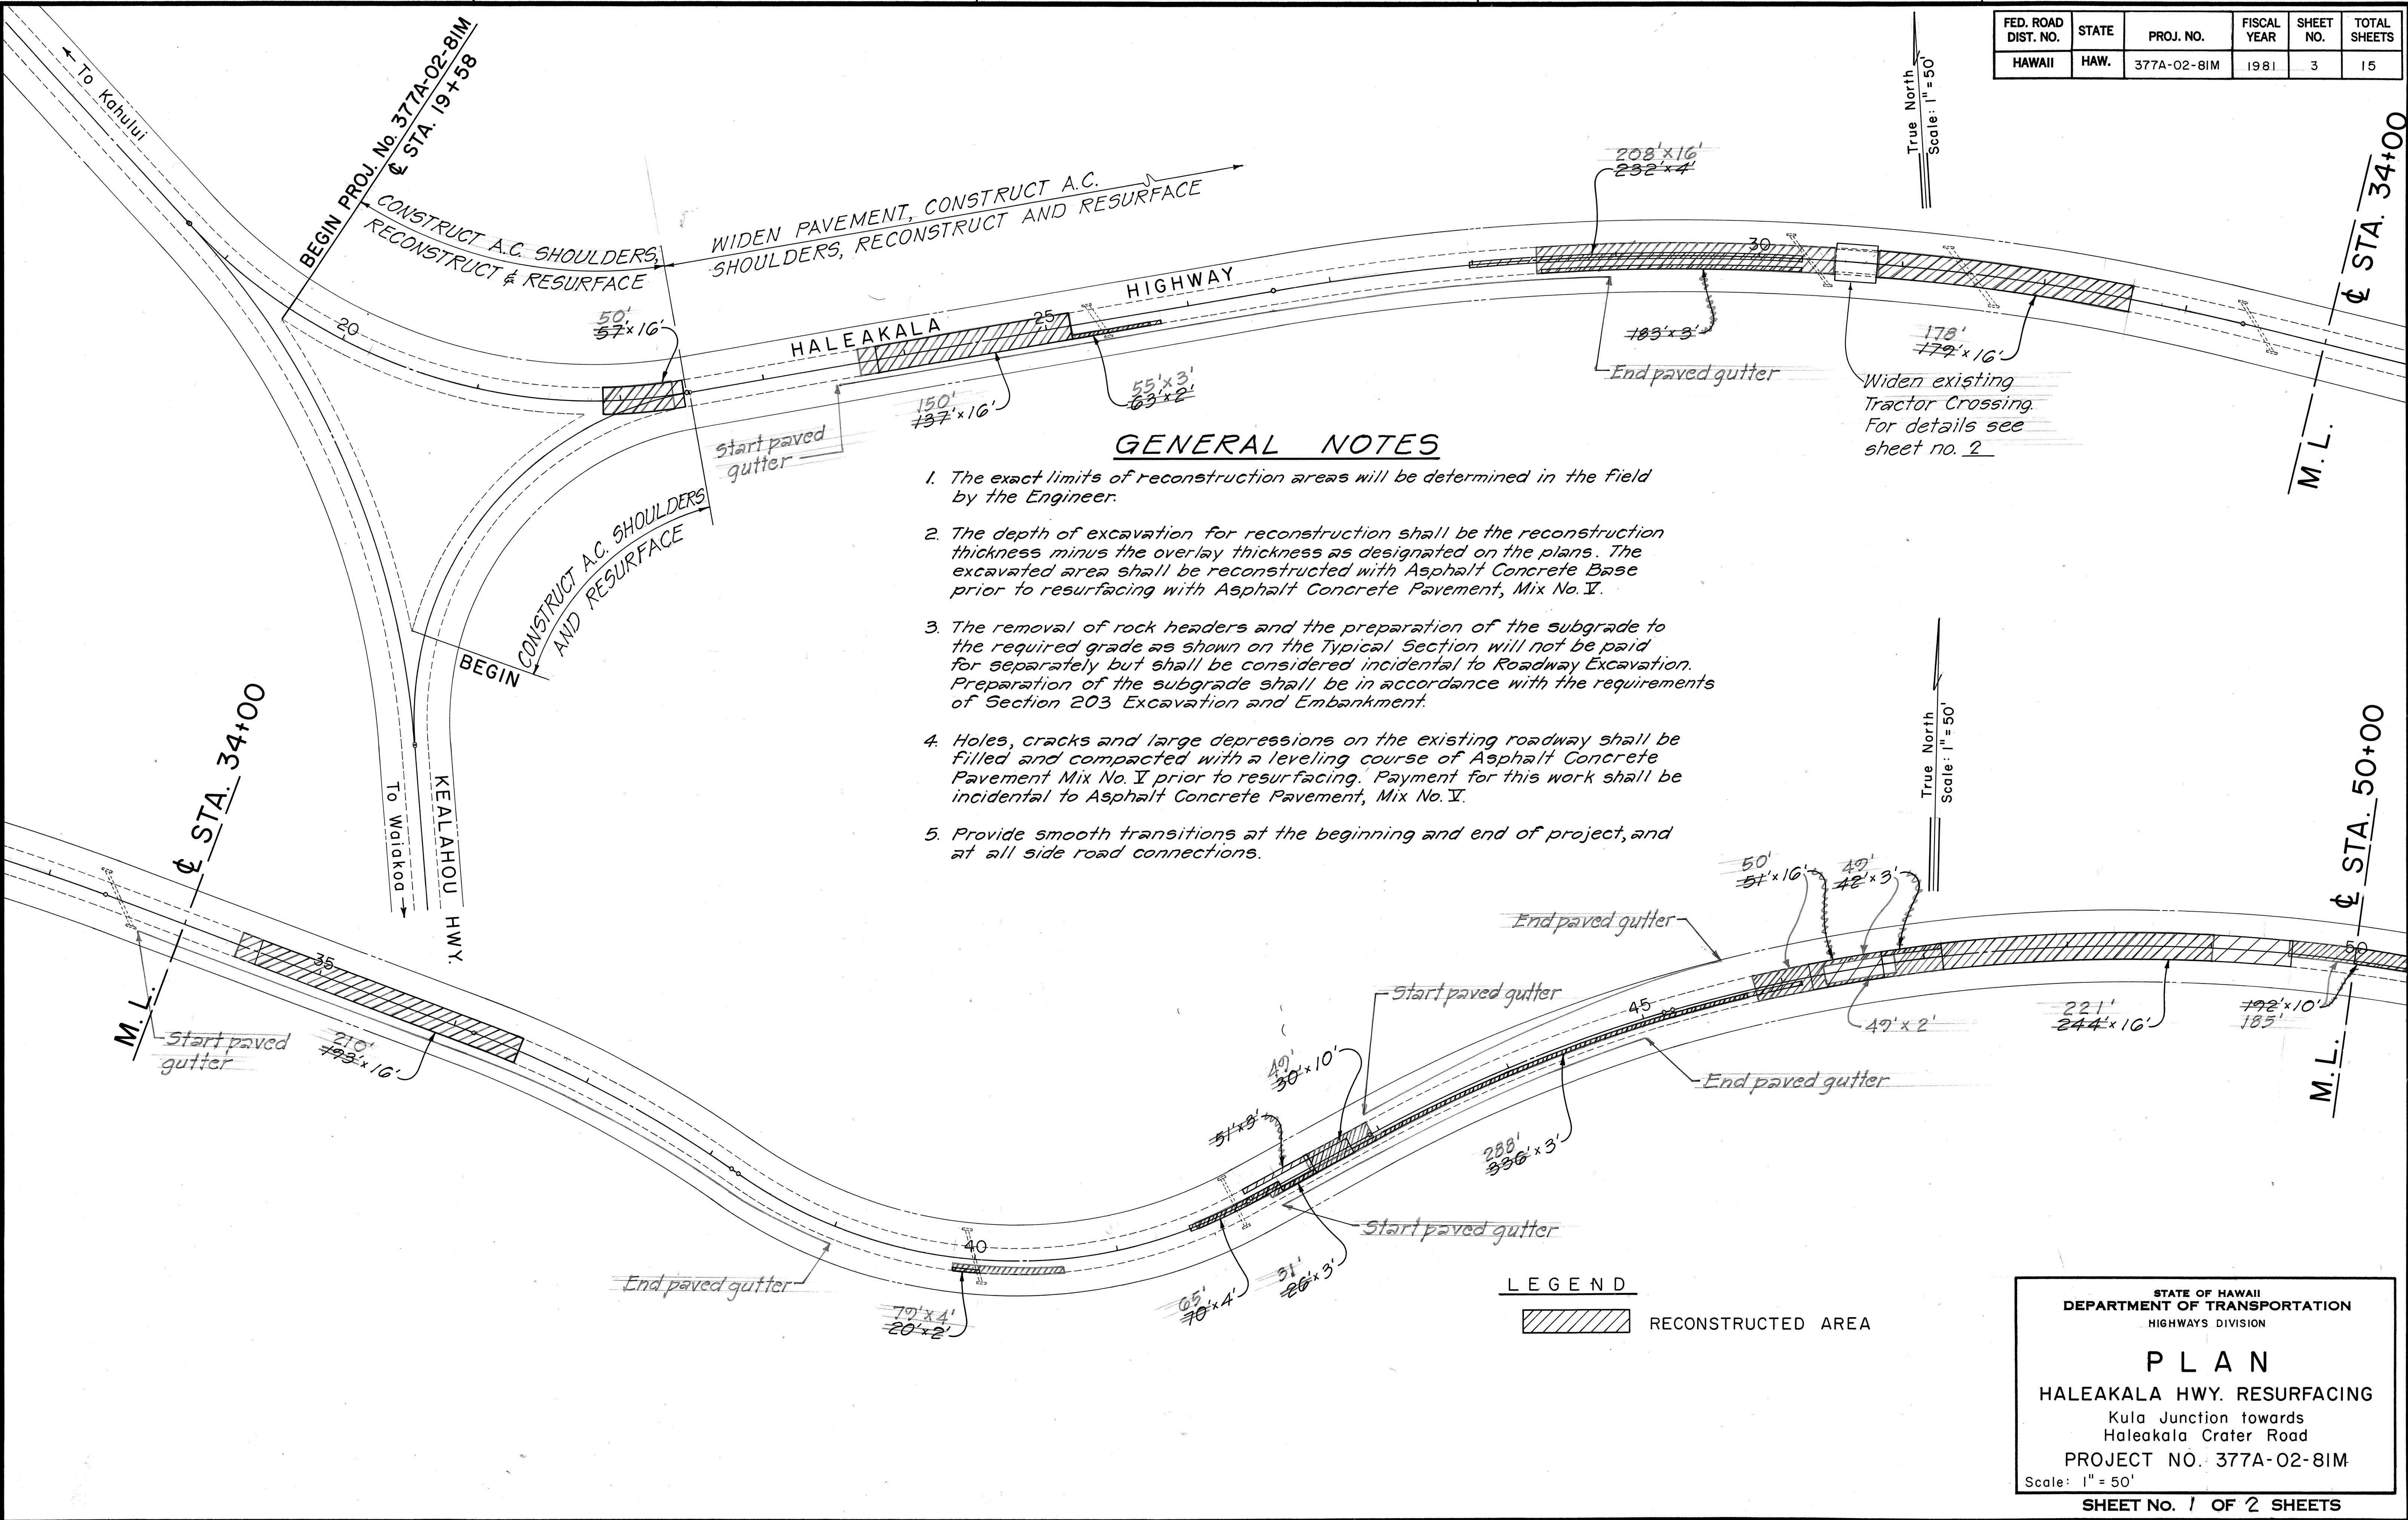

GENERAL NOTES

1. The exact limits of reconstruction areas will be determined in the field by the Engineer.
2. The depth of excavation for reconstruction shall be the reconstruction thickness minus the overlay thickness as designated on the plans. The excavated area shall be reconstructed with Asphalt Concrete Base prior to resurfacing with Asphalt Concrete Pavement, Mix No. V.
3. The removal of rock headers and the preparation of the subgrade to the required grade as shown on the Typical Section will not be paid for separately but shall be considered incidental to Roadway Excavation. Preparation of the subgrade shall be in accordance with the requirements of Section 203 Excavation and Embankment.
4. Holes, cracks and large depressions on the existing roadway shall be filled and compacted with a leveling course of Asphalt Concrete Pavement Mix No. V prior to resurfacing. Payment for this work shall be incidental to Asphalt Concrete Pavement, Mix No. V.
5. Provide smooth transitions at the beginning and end of project, and at all side road connections.

LEGEND

RECONSTRUCTED AREA

STATE OF HAWAII  
DEPARTMENT OF TRANSPORTATION  
HIGHWAYS DIVISION

PLAN

HALEAKALA HWY. RESURFACING  
Kula Junction towards  
Haleakala Crater Road


PROJECT NO. 377A-02-81M

Scale: 1" = 50'

SHEET NO. 1 OF 2 SHEETS



| FED. ROAD DIST. NO. | STATE | PROJ. NO.   | FISCAL YEAR | SHEET NO. | TOTAL SHEETS |
|---------------------|-------|-------------|-------------|-----------|--------------|
| HAWAII              | HAW.  | 377A-02-81M | 1981        | 4         | 15           |

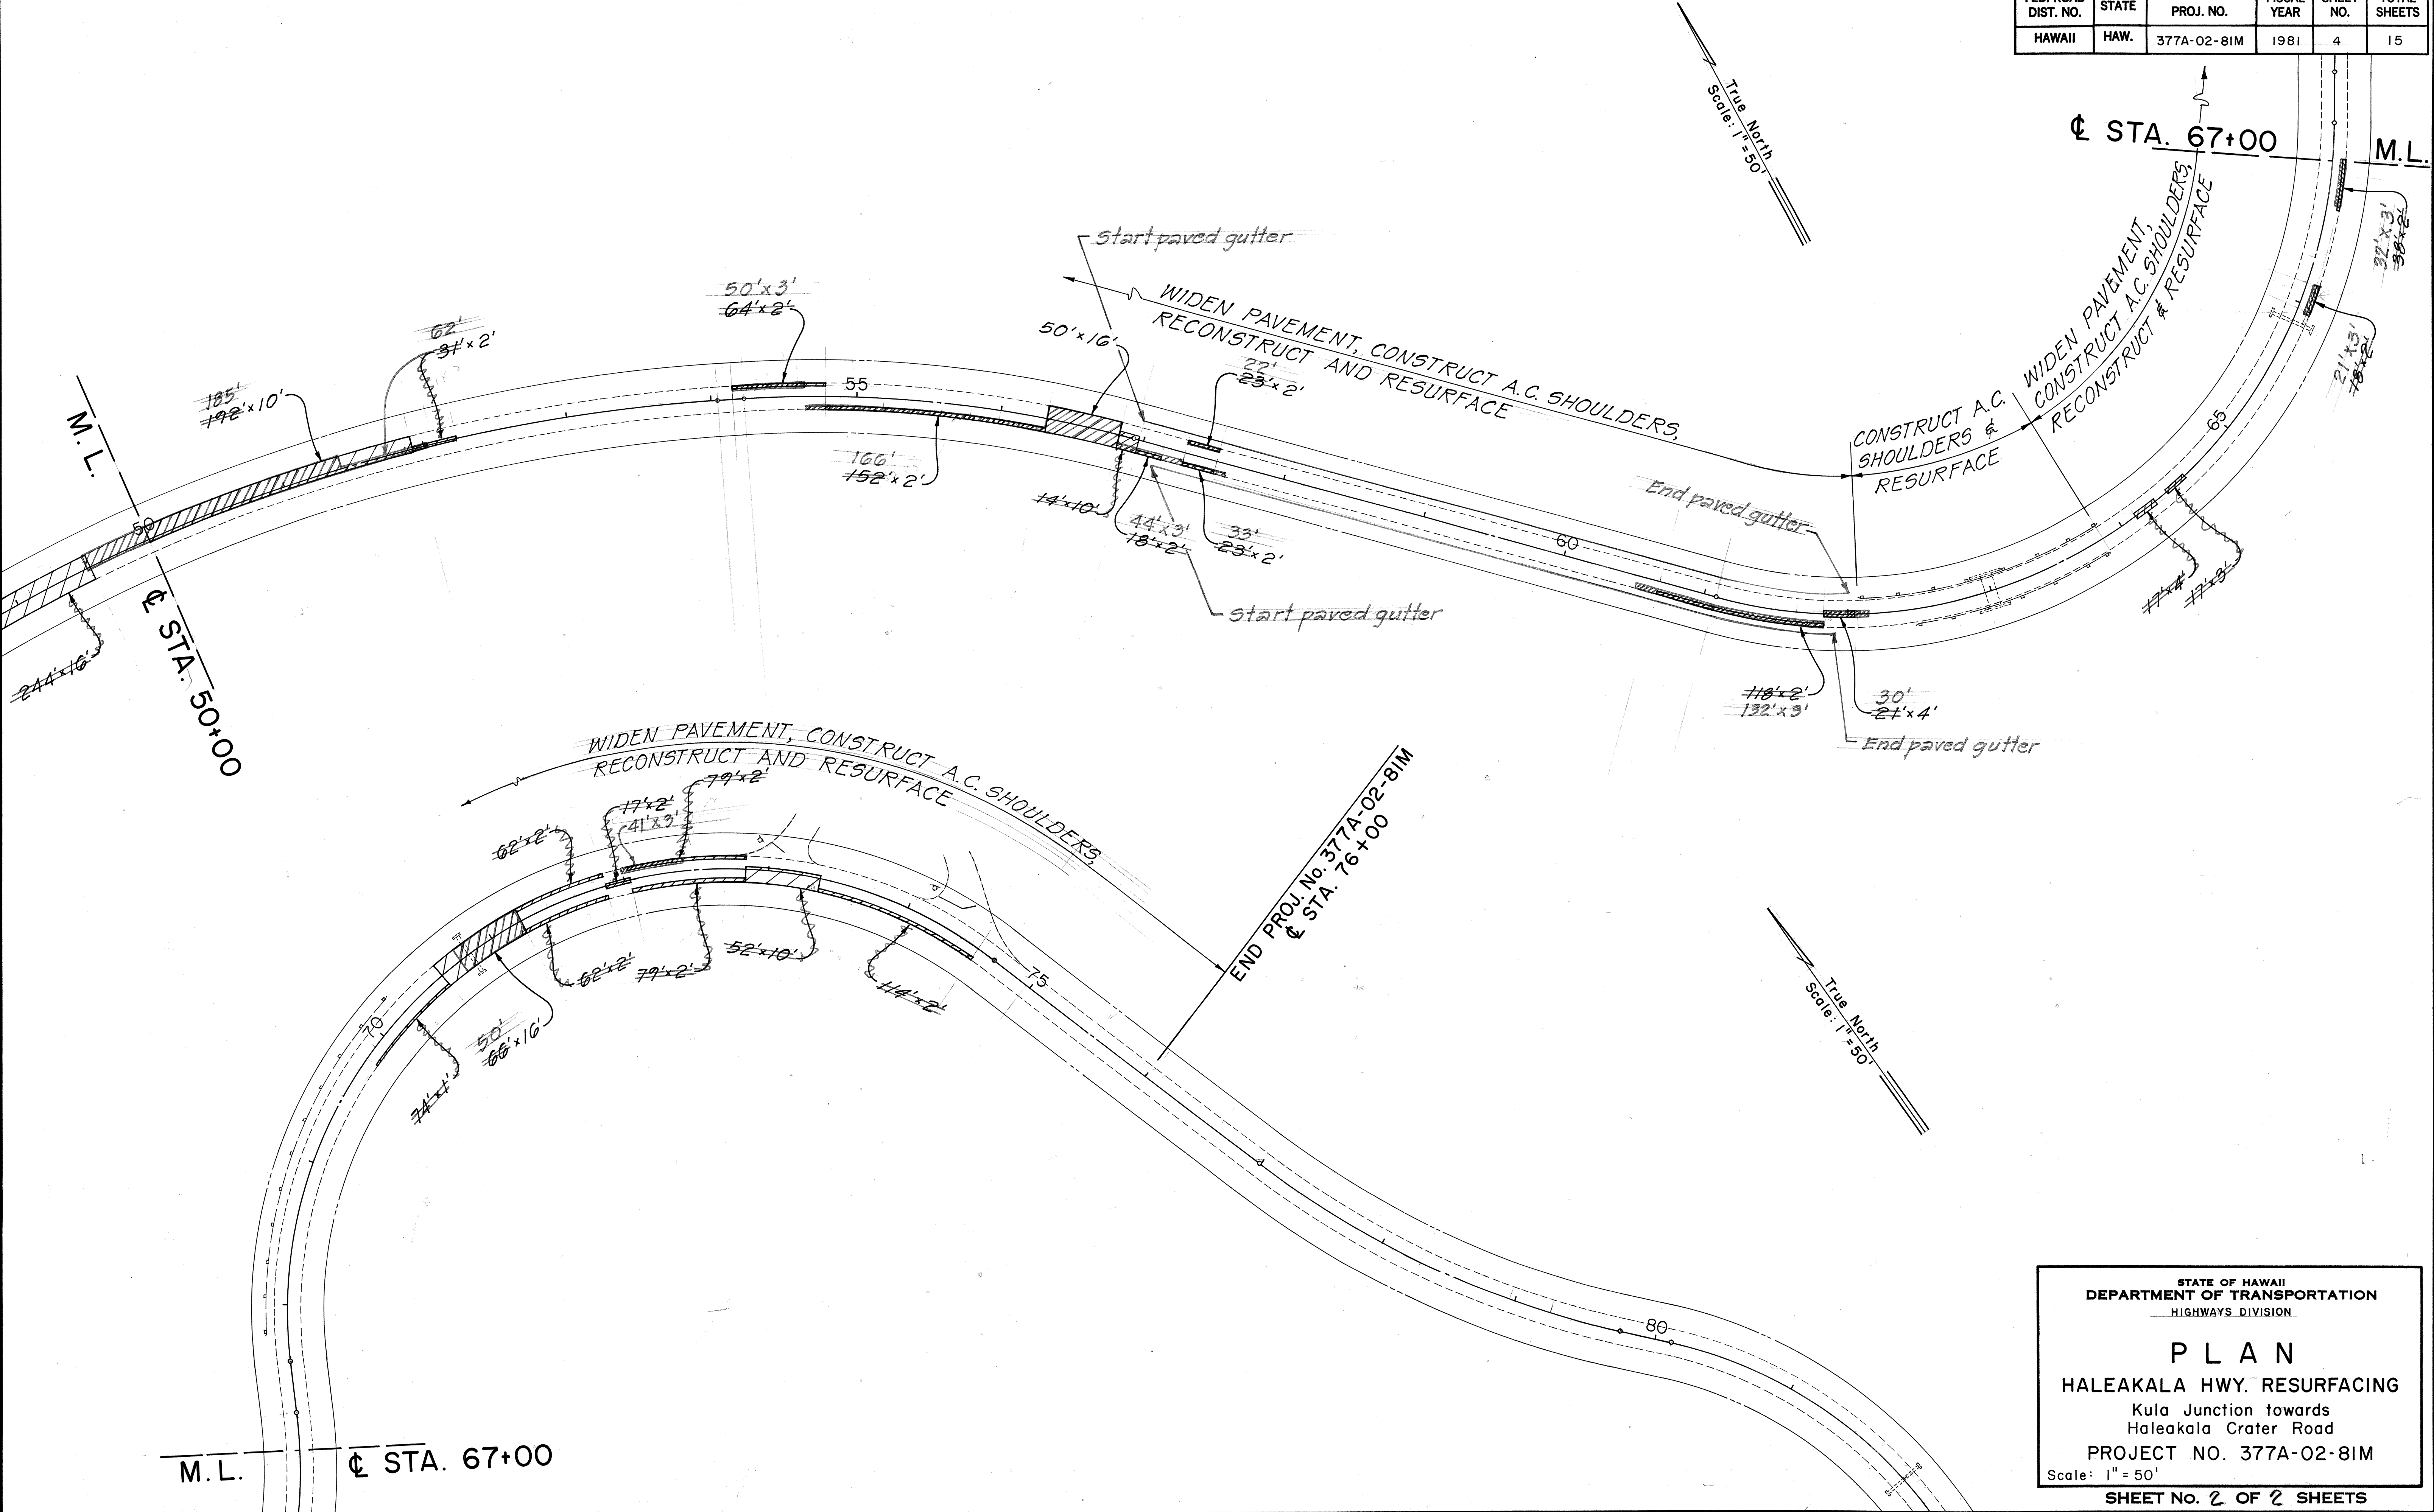

STATE OF HAWAII  
DEPARTMENT OF TRANSPORTATION  
HIGHWAYS DIVISION

**P L A N**

HALEAKALA HWY. RESURFACING  
Kula Junction towards  
Haleakala Crater Road  
PROJECT NO. 377A-02-81M  
Scale: 1" = 50'

SHEET NO. 2 OF 2 SHEETS

|               |                   |      |
|---------------|-------------------|------|
| ORIGINAL PLAN | SURVEY PLOTTED BY | DATE |
| NOTE BOOK     | DRAWN BY          |      |
| No.           | DESIGNED BY       |      |
|               | CHECKED BY        |      |