	INDEX TO DRAWINGS
SHEET NO.	DESCRIPTION
	TITLE SHEET
2	TYPICAL SECTION, GENERAL
	NOTES & PAVEMENT MARKINGS
3-4	PLANS
5-7	STANDARD DETAILS
· ·	
~	
¥°.	
34	



STATE OF HAWAII

DEPARTMENT OF TRANSPORTATION

HIGHWAYS DIVISION


HONOLULU, HAWAII

"AS-BUILT" PLANS FOR


HALEAKALA HIGHWAY RESURFACING


MILE POST 1.3 TO MILE POST 3.7 PROJECT NO. 377A-01-83M

> DISTRICT OF MAKAWAO ISLAND OF MAUI

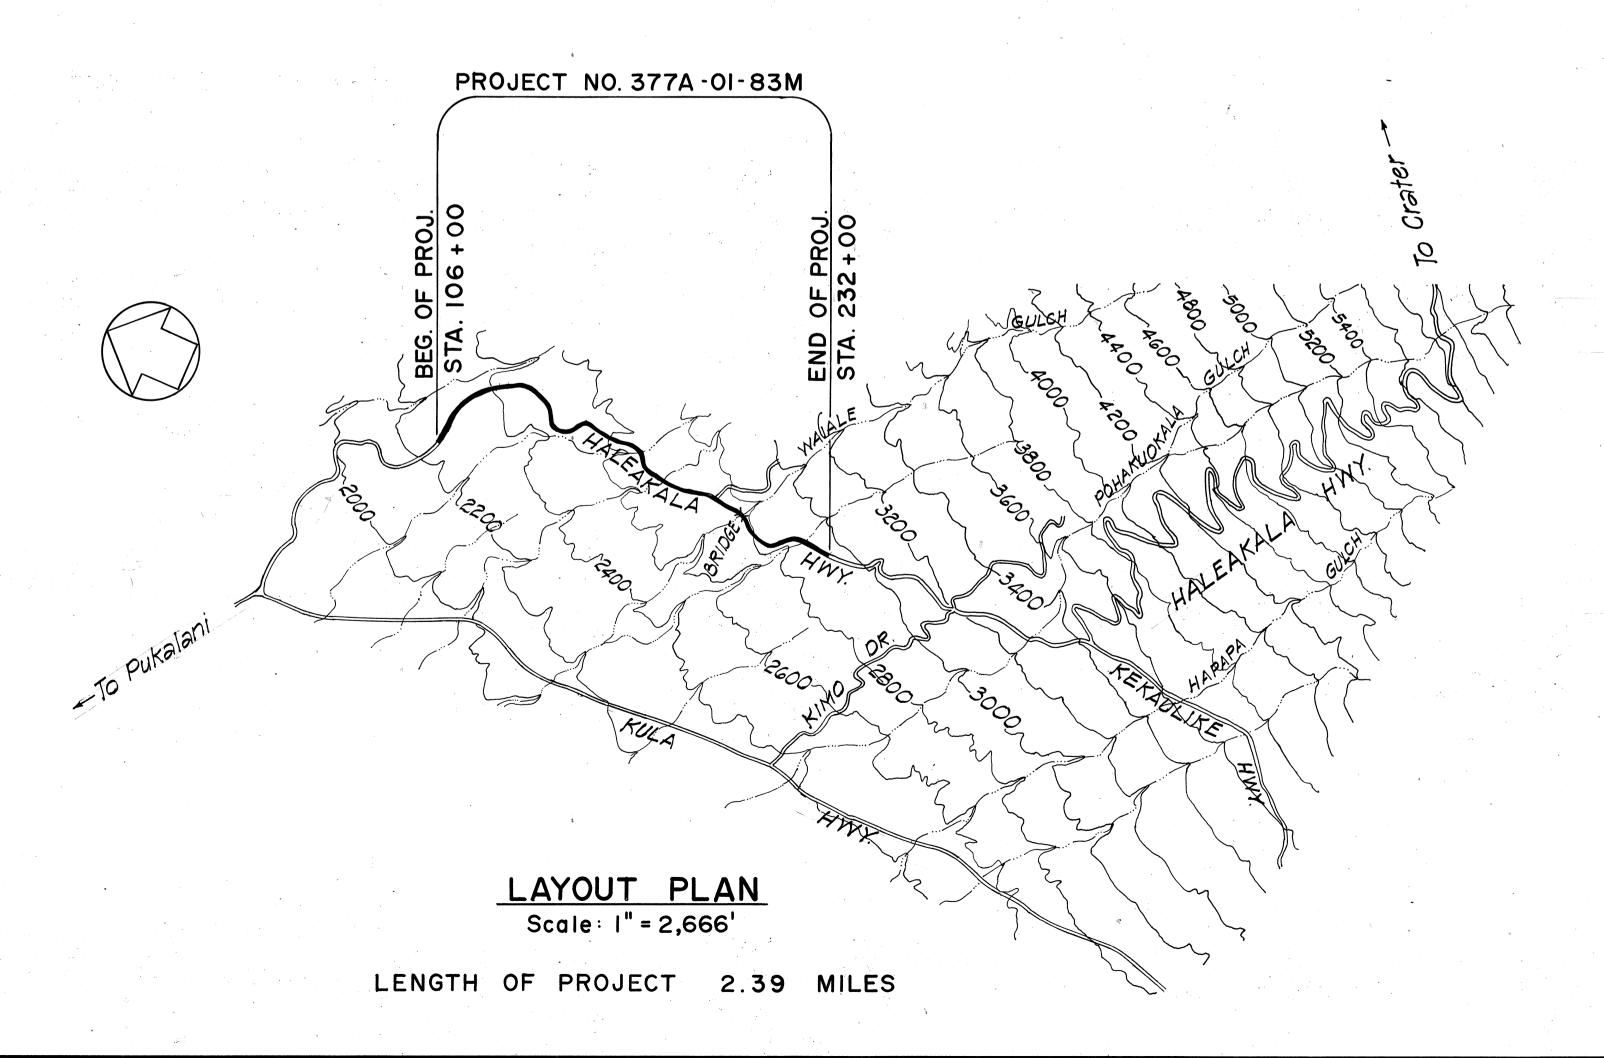

FISCAL SHEET TOTAL YEAR NO. SHEETS FED. ROAD DIST. NO. STATE PROJ. NO. 377A - 01 - 83M

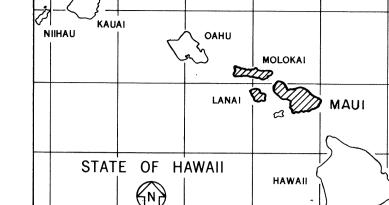

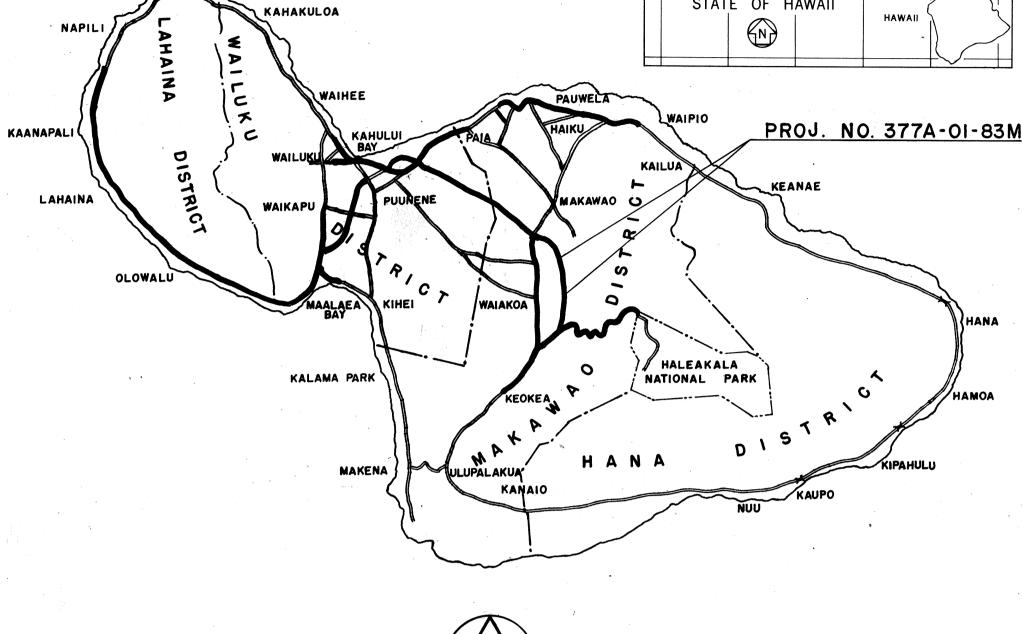

FEDERAL AID PROJECTS PREVIOUSLY CONSTRUCTED OR UNDER CONSTRUCTION

THE SCOPE OF WORK FOR THIS PROJECT CONSIST OF RESURFACING EXISTING PAVEMENT AND INSTALLING PAVE-MENT MARKERS AND PAVEMENT STRIPING.

SCALE IN MILES

ALL CHANGES MADE DURING CONSTRUCTION HAVE BEEN INCORPORATED ON THESE PLANS IN RED EXCEPT CHANGES IN THE ORIGINAL THEORETICAL QUANTITIES. FOR ACTUAL QUANTITIES, REFER TO PROJECT LEDGER AND/OR COMPUTATION BOOK.

Merdinand Cajegal RESIDENT ENGINEER

DEPARTMENT OF TRANSPORTATION STATE OF HAWAII ARPROVED: