SHEET NO.	INDEX TO DRAWINGS DESCRIPTION	TE OF HAVE	ent of Transnor
J. I	TITLE SHEET		
	TYPICAL SECTION, GENERAL		
2	NOTES & PAVEMENT MARKINGS	STATE OF HAWAII	ate of Walan
3-4	PLANS	Taxand .	¥
5-7	STANDARD DETAILS	DEPARTMENT OF TRANSPORT	TATION
	40	HIGHWAYS DIVISION	
		1 10 N 10 1 1 1 1 1 1 1 1 1 1 1 1 1 1 1	
		HONOLULU, HAWAII	
		"AS-BUILT" PLANS FOR	
		HAIFAKAIA HIGHWAY DEGI	IDEACING
V.		HALEAKALA HIGHWAY RESU	MIACING,
		MILEPOST 4 TO CRATER	
		MILEPOST 4 TO CRATER	ROAD
		PROJECT NO. 377A - 01-85	$\mathbf{N} \mathbf{A}$
	v ·	FRUUEUI NU. 311A-UI-83	IAI
	DISTRICT OF MAKAWAO ISLAND OF MAUI		
ý		PROJECT NO. 377A-01-85M	
N. Carlotte			
X			
			\(\)
		33 33	
		2 3 OF	
		m o	
		The second of th	3] / /
i di		S GULL TO SUPPLY	
8 4		THE	
19 ATE			
<u> </u>		The second of th	
(0)		1 3 TO	
45(THE THE PARTY OF T	
%-2 HON		1 3 to 1 har	
748 Pl	in the second of		
	pukale.	Teon ()	
nzn		300	
Tsi		TOTAL STATES OF THE STATES OF	
п. ∞	to the second		
nald P. S.			
Ror L			
			SCOPE OF WORK:
<u>></u>			Work for this project consists of
ED E		LAYOUT PLAN	cold planing existing pavement, resurfacing
I M Y			with A.C. Mix No. V, installing pavement
HWY-M DESIGNED BY	요	SCALE IN MILES	markers and pavement striping.
		LENGTH OF PROJECT 1.967 MILES	

FED. ROAD DIST. NO. STATE PROJ. NO. FISCAL SHEET TOTAL YEAR NO. SHEETS

HAWAII HAW. 3774-01-85M 1985 1 7





NIIHAU OAHU MOLOKAI

LANAI MAUI

STATE OF HAWAII

HAWAII

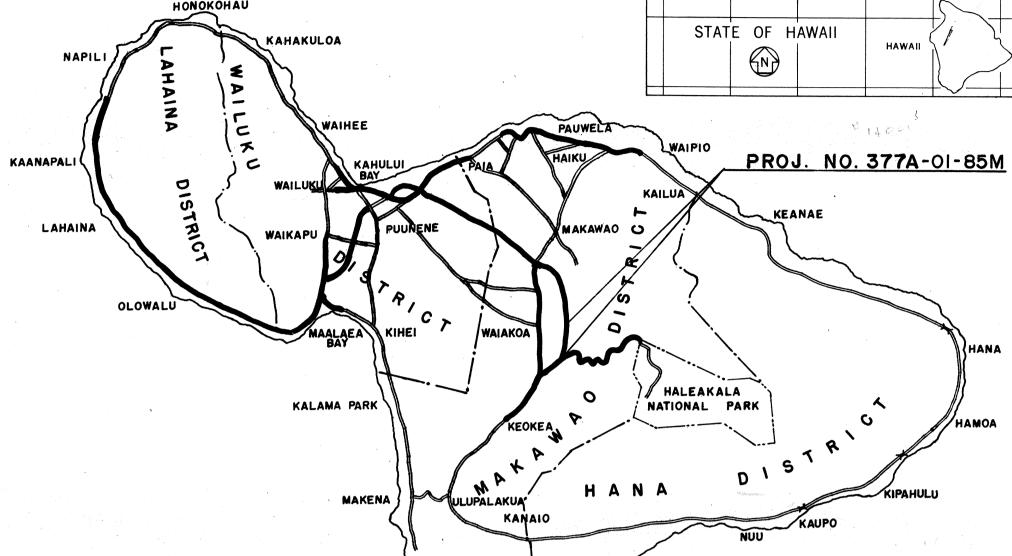

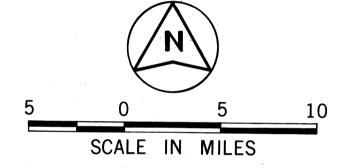

FEDERAL AID PROJECTS PREVIOUSLY CONSTRUCTED OR UNDER CONSTRUCTION

CHANGES MADE DURING CONSTRUCTION HAVE BEEN INCORPORATED ON THESE PLANS EXCEPT CHANGES IN THE ORIGINAL THEORETICAL QUANTITIES, FOR ACTUAL QUANTITIES, REFER TO PROJECT LEDGER AND/OR COMPUTATION BOOK.

Manuel J. Silva RESIDENT ENGINEER

29 Mar. 85 DATE

DEPARTMENT OF TRANSPORTATION STATE OF HAWAII

APPROVED:

mother K Shimada for 9-6-84 DIR. OF TRANSPORTATION DATE

1-3-5