
	INDEX TO DRAWINGS
SHEET NO.	DESCRIPTION
	TITLE SHEET
2	NOTES
3	TYPICAL SECTIONS & DETAILS
4-11	PLANS
12-13	GUARDRAIL & MAILBOX SCHEDULES
14-22	GUARDRAIL SPECIAL, TYPICAL &
	STANDARD DETAILS
23-27	DRAINAGE DETAILS
28-39	PAVEMENT MARKING, STRIPING & DELINEATOR SCHEDULES, SPECIAL TYPICAL & STANDARD DETAILS
E try comment	
Land Carlotte	
Vertical Control Contr	

HAWAII STATE OF

DEPARTMENT OF TRANSPORTATION HIGHWAYS DIVISION HONOLULU, HAWAII "AS - BUILT" PLANS FOR

KEKAULIKE AVENUE IMPROVEMENTS HALEAKALA CRATER ROAD TO KULA HIGHWAY FEDERAL AID PROJECT NO. RS-0377(2)

> DISTRICT OF MAKAWAO ISLAND OF MAUI

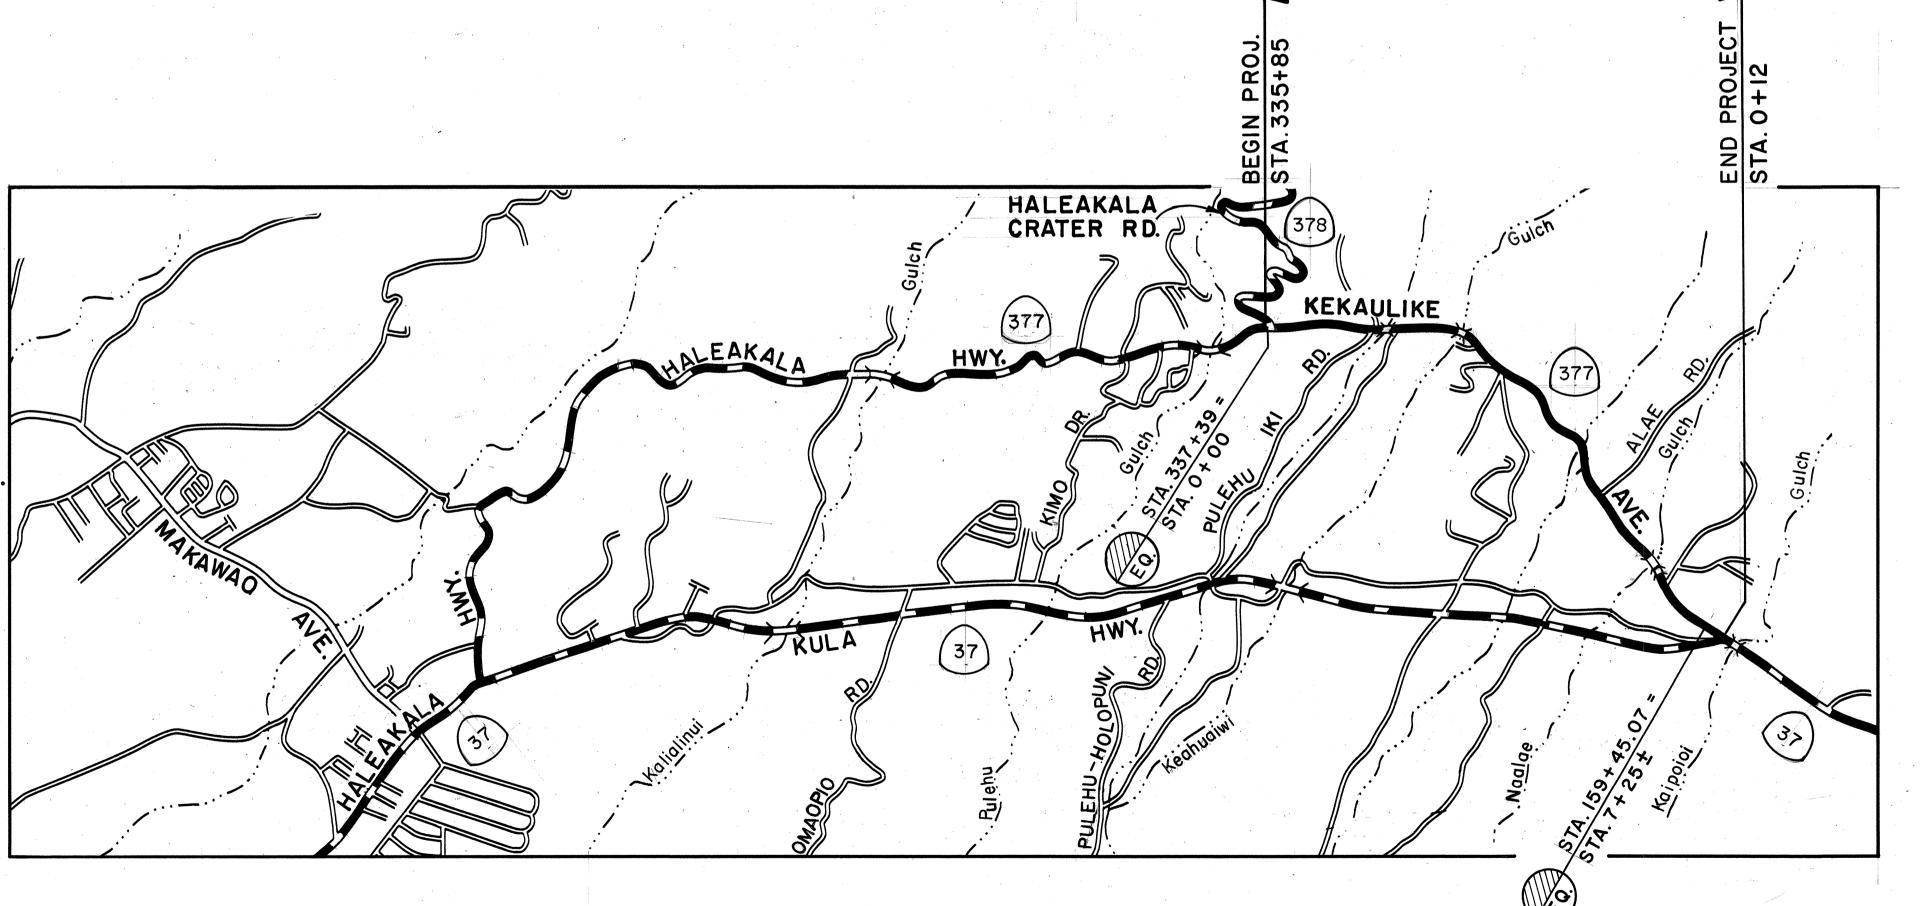


STATE OF HAWAII HALEAKALA NATIONAL PARK LOCATION OF PROJECT

FED. ROAD DIST. NO.

FED. AID PROJ. NO.

RS-0377(2)

FISCAL YEAR

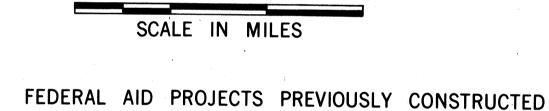

OR UNDER CONSTRUCTION

DESIGN DESIGNATION

CURRENT ADT (1986)....1,000 DHV..... 130 V (POSTED) 30 MPH

CHANGES MADE DURING CONSTRUCTION HAVE BEEN INCORPORATED ON THESE PLANS EXCEPT CHANGES IN THE ORIGINAL THEORETICAL QUANTITIES. FOR ACTUAL QUANTITIES, REFER TO PROJECT LEDGER AND/OR COMPUTATION BOOK.

RESIDENT ENGINEER

5-04-89

LAYOUT PLAN

GROSS LENGTH OF PROJECT 3.184 Miles NET LENGTH OF PROJECT 3.139 Miles

F. A. PROJECT NO. RS - 0377(2)

APPROVED:

DIRECTOR, DEPARTMENT OF WATER SUPPLY,

DEPARTMENT OF TRANSPORTATION STATE OF HAWAII **APPROVED:** 3-19-86 DIR OF TRANSPORTATION DATE

SCALE IN MILES

COUNTY OF MAUL