	The state of the s
INDEX TO DRAWINGS	
SHEET NO.	DESCRIPTION
1	TITLE SHEET
2	STANDARD PLANS SUMMARY
① 3 - 4	TYPICAL SECTIONS, DETAILS, LEGEND
	AND GENERAL NOTES
5 – 18	ROADWAY PLANS
19 – 35	TRAFFIC LEGEND, NOTES, SIGNING AND PAVEMENT
	MARKINGS PLANS AND MISCELLANEOUS SUMMARIES
36	DRAINAGE SUMMARY
37 – 39	END POST CONNECTION PLANS AND DETAILS

① Plan Sht. No. 4S-I is a supplemental sheet to this project. TOTAL SHEET COUNT after "AS-BUILT" posting 40 Sheets.

STATE OF HAWAII

DEPARTMENT OF TRANSPORTATION


HIGHWAYS DIVISION HONOLULU, HAWAII

"AS-BUILT"
PLANS FOR

HALEAKALA HIGHWAY
GUARDRAIL AND SHOULDER IMPROVEMENT

KULA JUNCTION TO CRATER ROAD JUNCTION FEDERAL AID PROJECT NO. STP-0377(3)

DISTRICT OF MAKAWAO
ISLAND OF MAUI

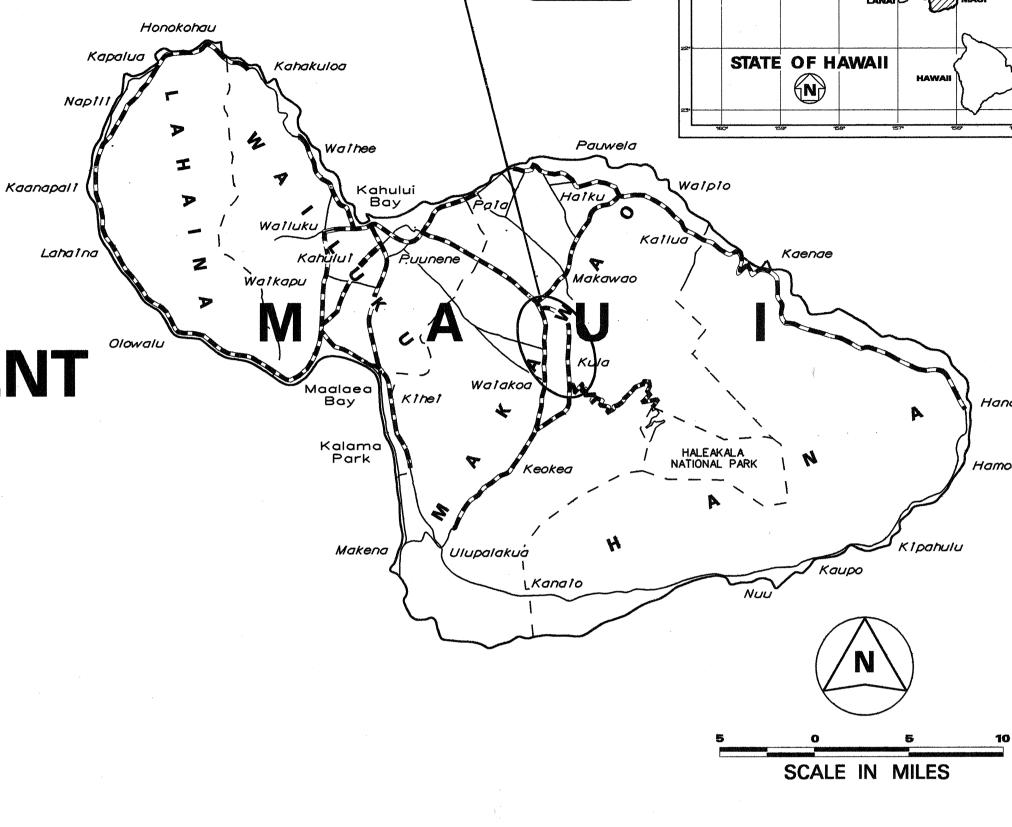

OR UNDER CONSTRUCTION

MILE POST <u>0.05</u> TO MILE POST <u>6.00</u>

FEDERAL AID PROJECTS PREVIOUSLY CONSTRUCTED

FED. AID PROJ. NO.

STP-0377(3)

SCALE IN THOUSAND FEET

DESIGN DESIGNATION

PROJECT LOCATION

PROJECT NO. STP-0377(3)

CHANGES MADE DURING CONSTRUCTION HAVE BEEN INCORPORATED ON THESE PLANS EXCEPT CHANGES IN THE ORIGINAL THEORETICAL QUANTITIES. FOR ACTUAL QUANTITIES, REFER TO PROJECT LEDGER AND/OR COMPUTATION BOOK.

REFER TO PROJECT LEDGER AND/OR COMPOTATION BOOK.

Dwight D. Raw 10-15-98

RESIDENT ENGINEER DATE

DEPARTMENT OF TRANSPORTATION FEDERAL HIGHWAY ADMINISTRATION

APPROVED:

Washam Wong 8/17/93

For DIVISION ADMINISTRATOR DATE

DEPARTMENT OF TRANSPORTATION STATE OF HAWAII		
APPROVED:		
I Harano	8/16/9	
ERDIR. OF TRANSPORTATION	DATE	