

STATE OF HAWAII

## DEPARTMENT OF TRANSPORTATION

HIGHWAYS DIVISION HONOLULU, HAWAII


"AS-BUILT"

## PLANS FOR

## HALEAKALA HIGHWAY RESURFACING


KULA JUNCTION TO CRATER ROAD FEDERAL AID PROJECT NO. STP-0377(4)

> DISTRICT OF MAKAWAO ISLAND OF MAUI

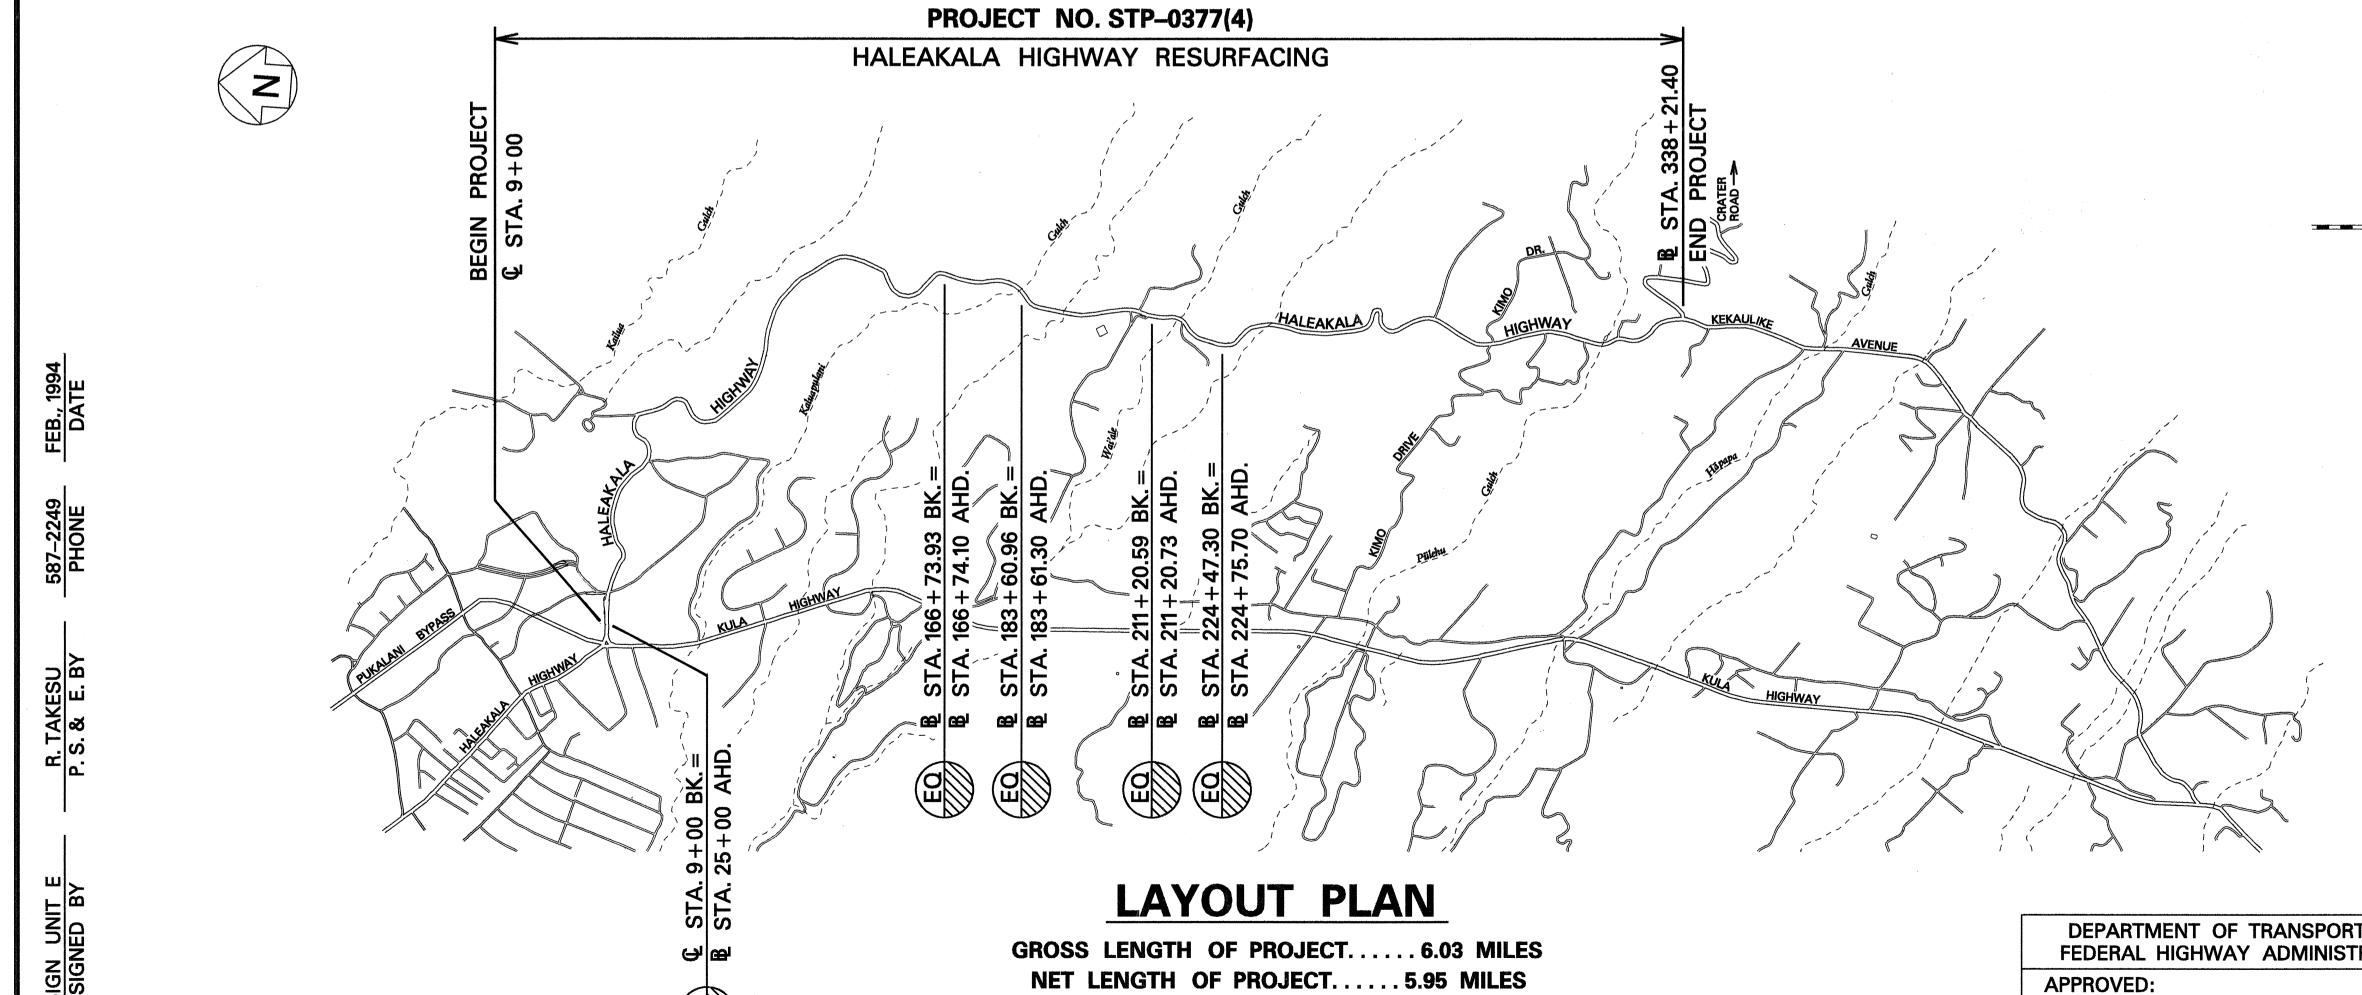

SCALE IN THOUSAND FEET

FED. ROAD DIST. NO. FED. AID PROJ. NO. FISCAL YEAR STP-0377(4)

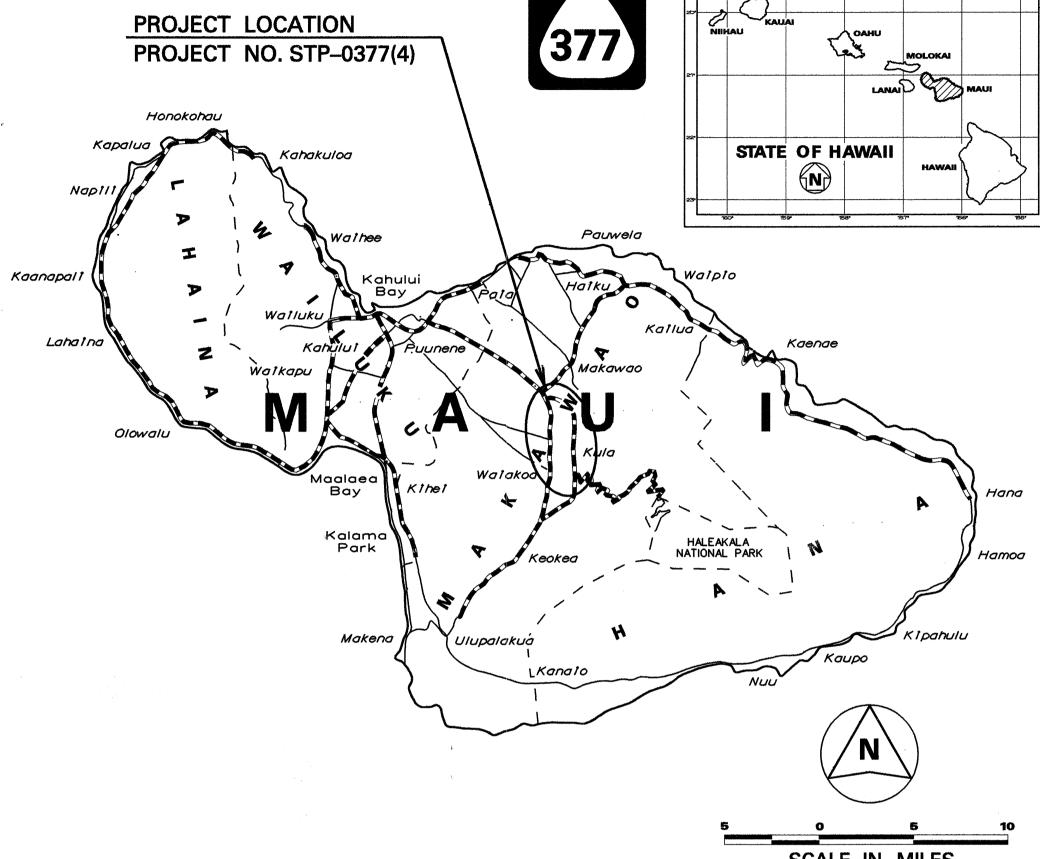

----- FEDERAL AID PROJECTS PREVIOUSLY CONSTRUCTED OR UNDER CONSTRUCTION

MILE POST <u>0.00</u> TO MILE POST <u>6.03</u>

## **DESIGN DESIGNATION**

ADT (1994)	2,840
ADT (2004)	3,880
DHV	350
D	60/40
T <sub>24</sub>	4.5
V	40 mph

CHANGES MADE DURING CONSTRUCTION HAVE BEEN

Clorge Laur

**DEPARTMENT OF TRANSPORTATION** STATE OF HAWAII

**APPROVED:** 5/18/94 pr\_dir. of transportation

DEPARTMENT OF TRANSPORTATION FEDERAL HIGHWAY ADMINISTRATION

DIVISION ADMINISTRATOR DATE