


INDEX TO DRAWINGS	
SHEET NO.	DESCRIPTION
1	TITLE SHEET
2	STANDARD PLANS SUMMARY
3	GENERAL NOTES, TYPICAL INSTALLATION AND SIGN DETAILS
4 - 7	LAYOUT PLANS
8	MISCELLANEOUS DETAILS

FED. ROAD DIST. NO.	STATE	PROJ. NO.	FISCAL YEAR	SHEET NO.	TOTAL SHEETS
HAWAII	HAW.	HWY-M-07-96	1996	1	8

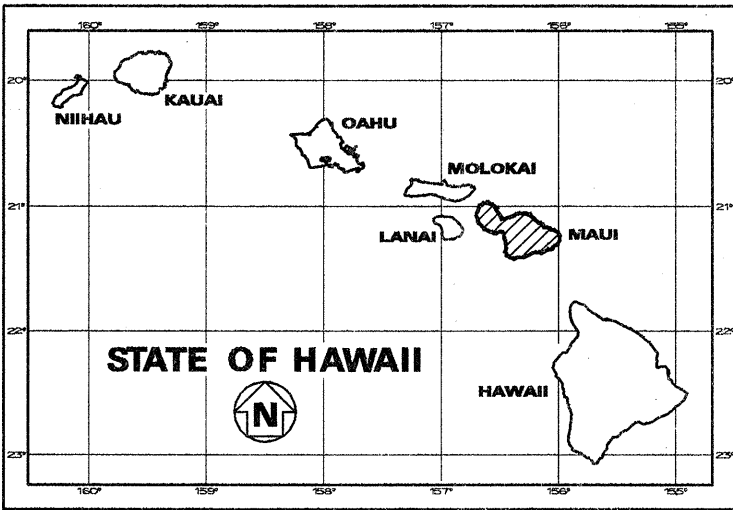

STATE OF HAWAII

DEPARTMENT OF TRANSPORTATION

HIGHWAYS DIVISION

HONOLULU, HAWAII

"AS-BUILT"

PLANS FOR

EMERGENCY TELEPHONES AT VARIOUS LOCATIONS,

MAUI

PROJECT NO. HWY-M-07-96

DISTRICT OF LAHAINA, WAILUKU MAKAWAO AND HANA

ISLAND OF MAUI

ROUTE NOS.

30

31

36

37

340

377

CHANGES MADE DURING CONSTRUCTION HAVE BEEN NOTED IN RED ON THESE TRACINGS AND CHECKED BY:

SEE LAYOUT PLANS FOR MILE POST DATA

*B. Kimura* 7/20/98  
RESIDENT ENGINEER DATE

HWY-TO  
DESIGNED BY

BRYAN KIMURA  
P. S. & E. BY

587-2177  
PHONE

MARCH, 1996  
DATE

DEPARTMENT OF TRANSPORTATION STATE OF HAWAII	
APPROVED:	
<i>Rayn Uyehiro</i>	5/29/96
DIR. OF TRANSPORTATION	DATE