

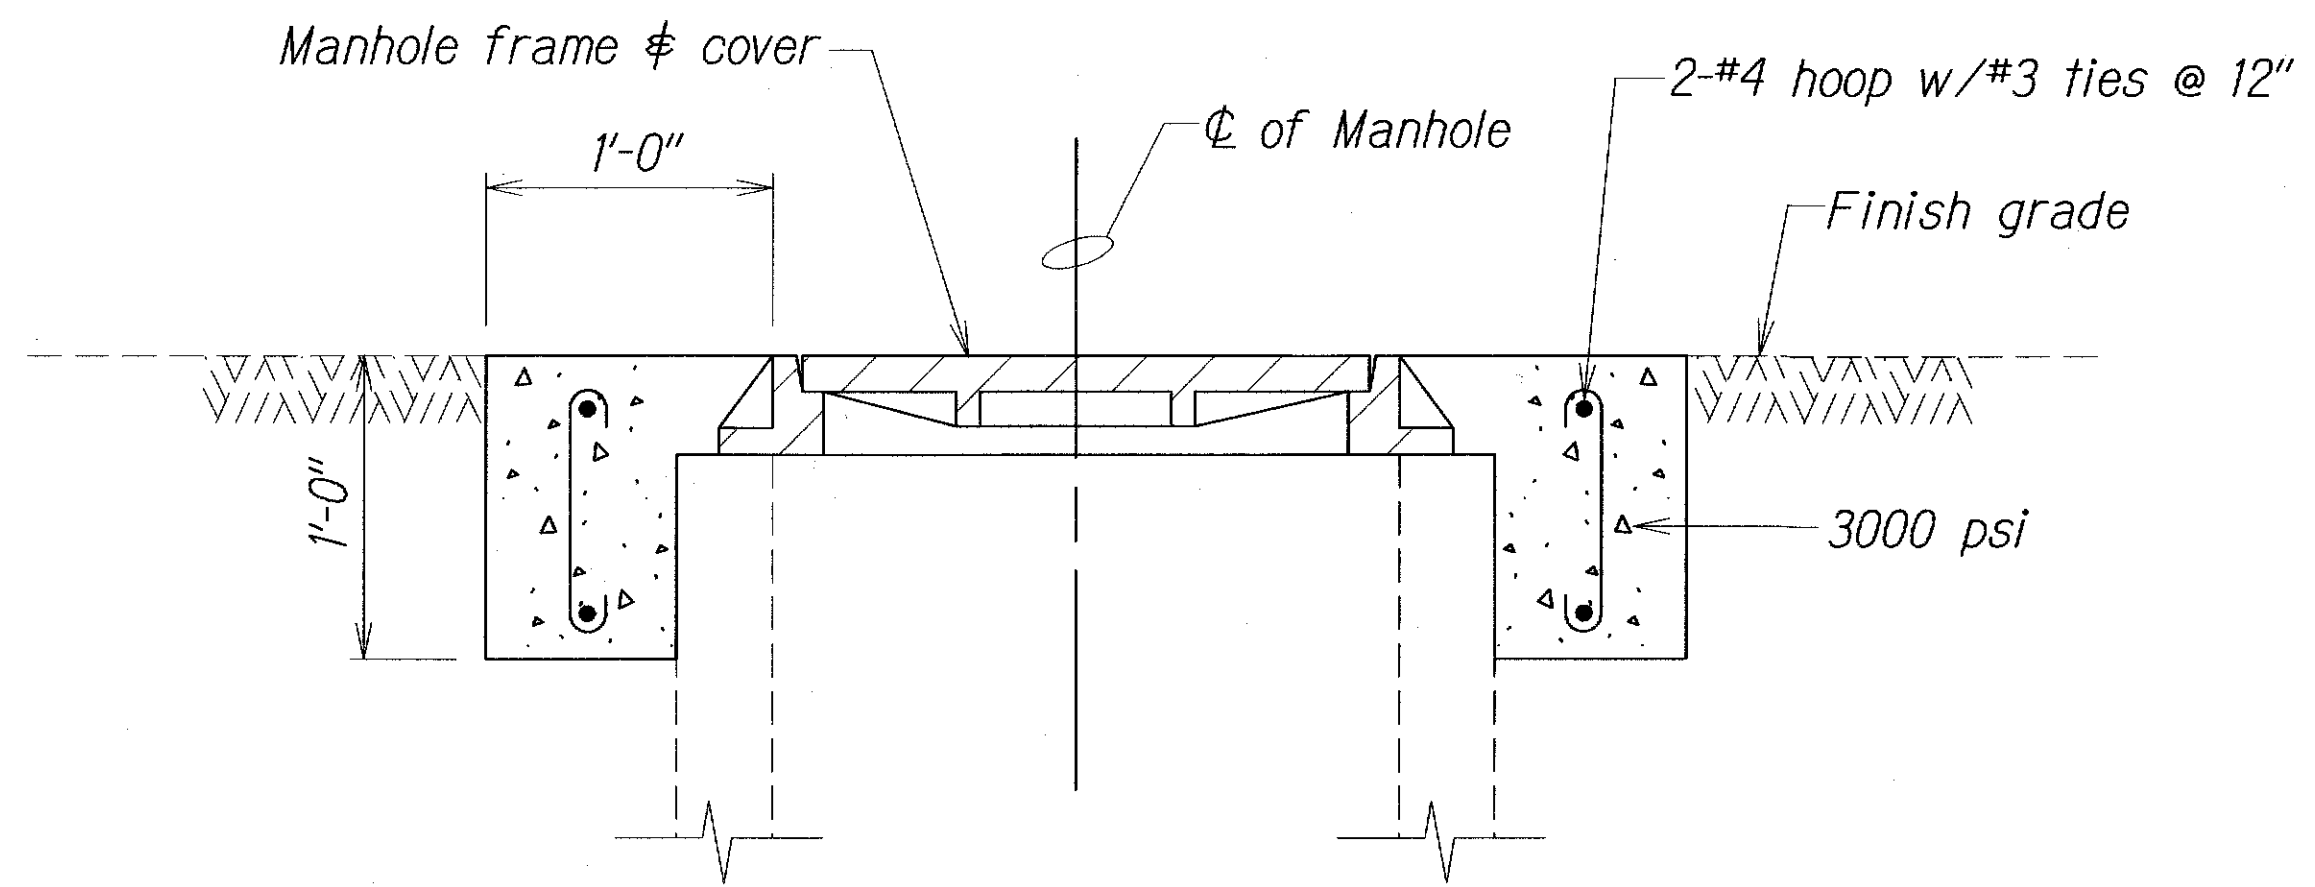



FED. ROAD DIST. NO.	STATE	FED. AID PROJ. NO.	FISCAL YEAR	SHEET NO.	TOTAL SHEETS
HAWAII	HAW.	STP-0377(006)	2014	ADD.6	38

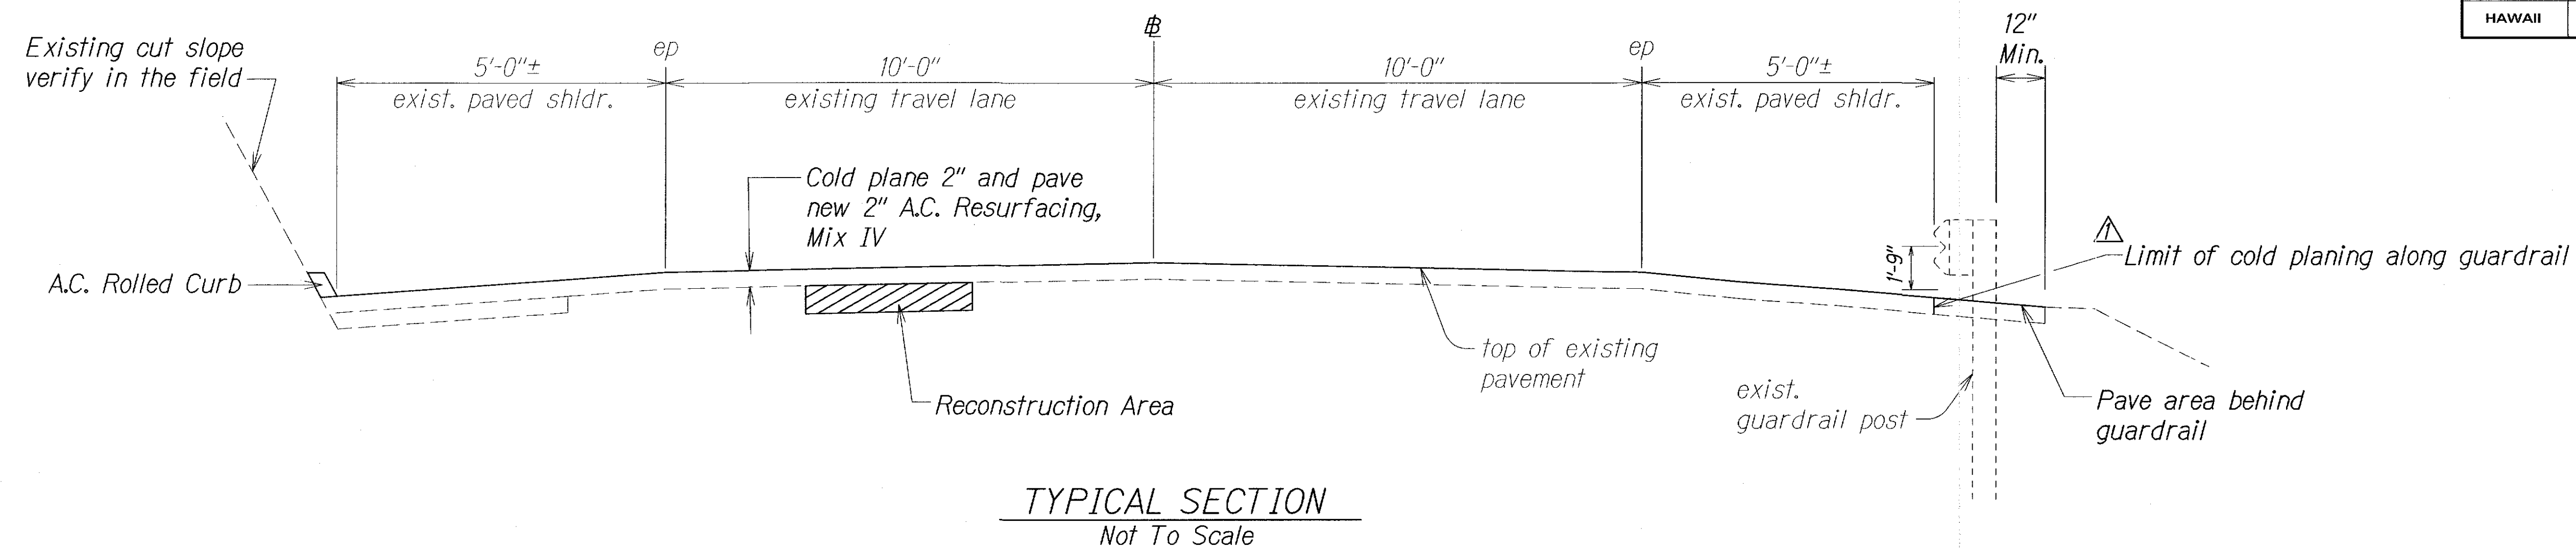


DETAIL - CONCRETE COLLAR FOR ADJUSTMENTS OF MANHOLES AND VALVE BOX
Not To Scale

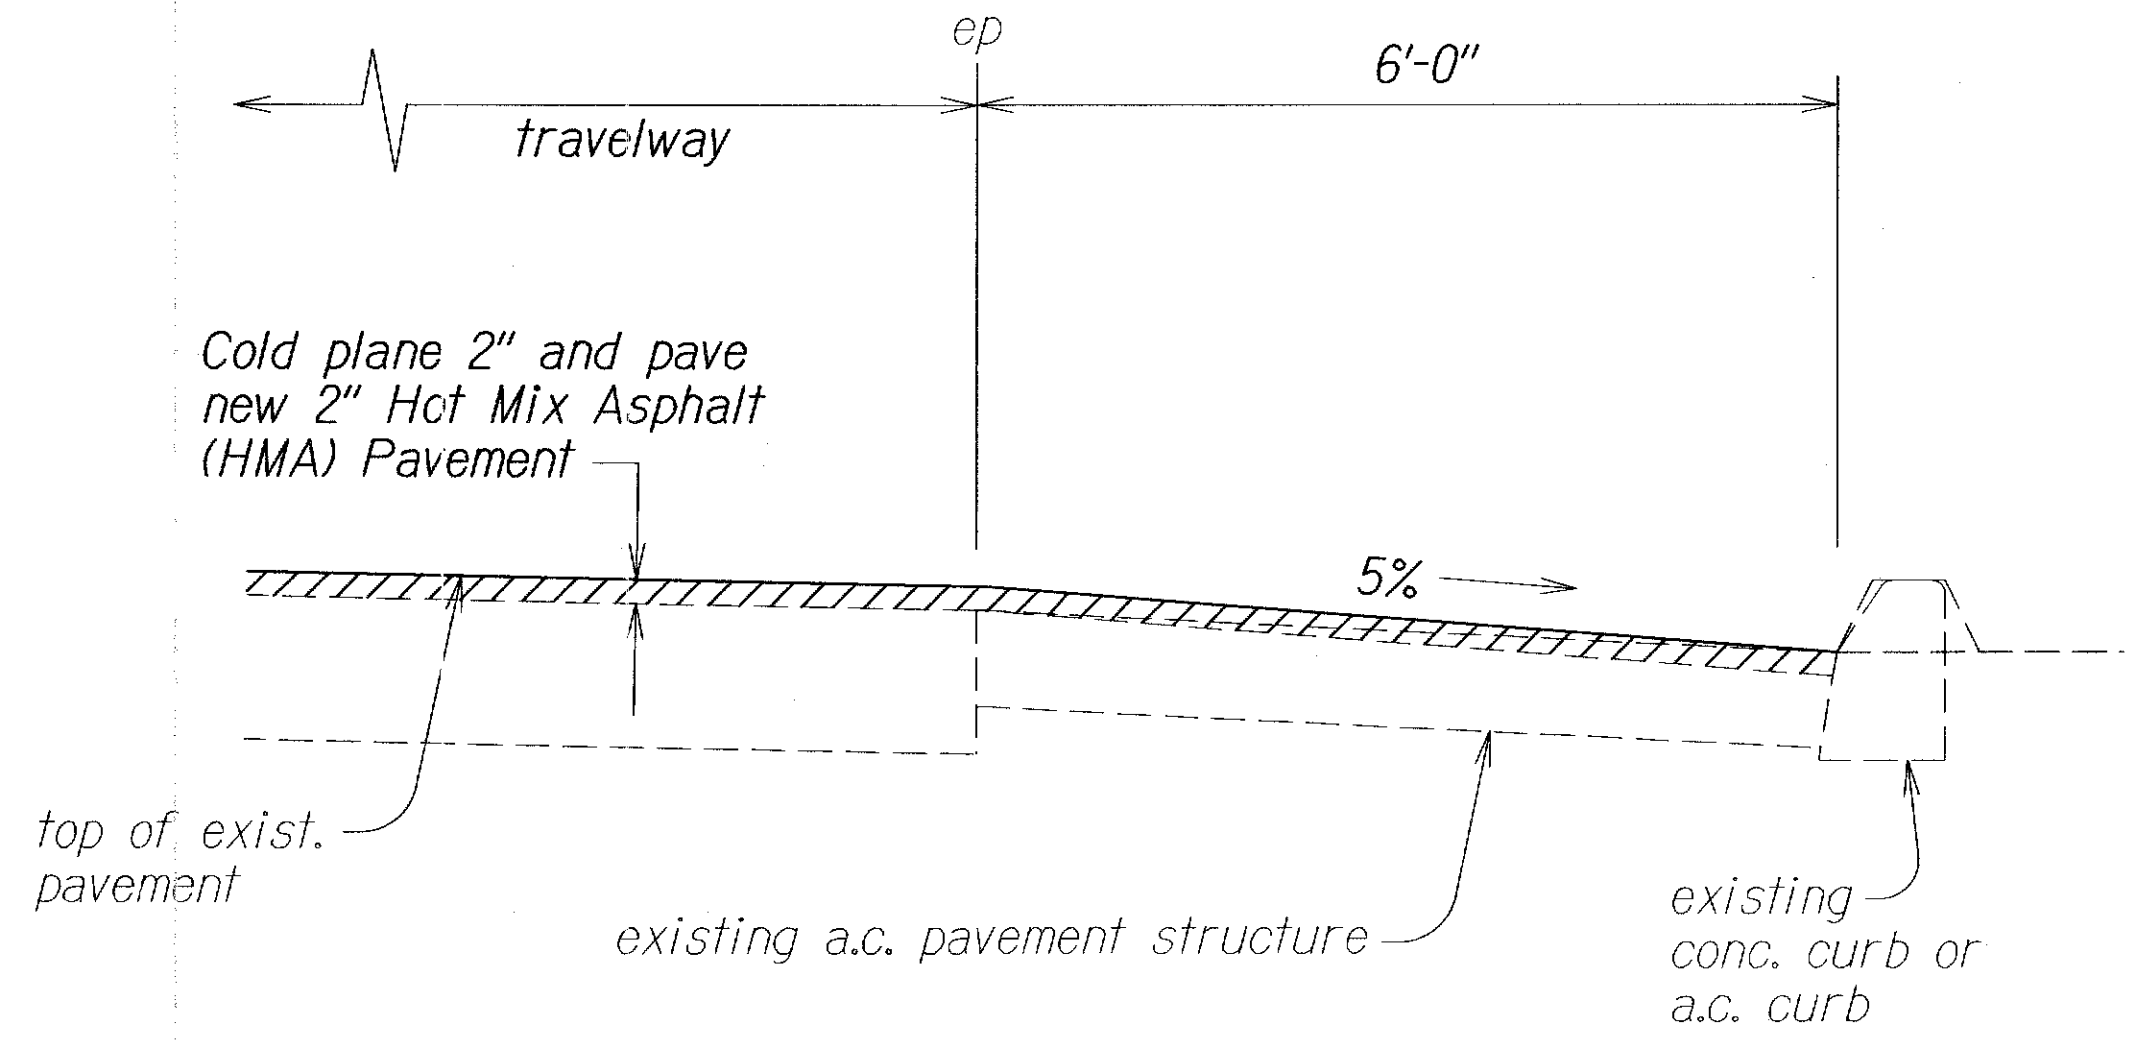

TYPICAL DETAIL COLD PLANING OF EXISTING A.C. PAVEMENT @ CONC. CURB OR A.C. CURB
Scale: $\frac{3}{4}$ " = 1'-0"

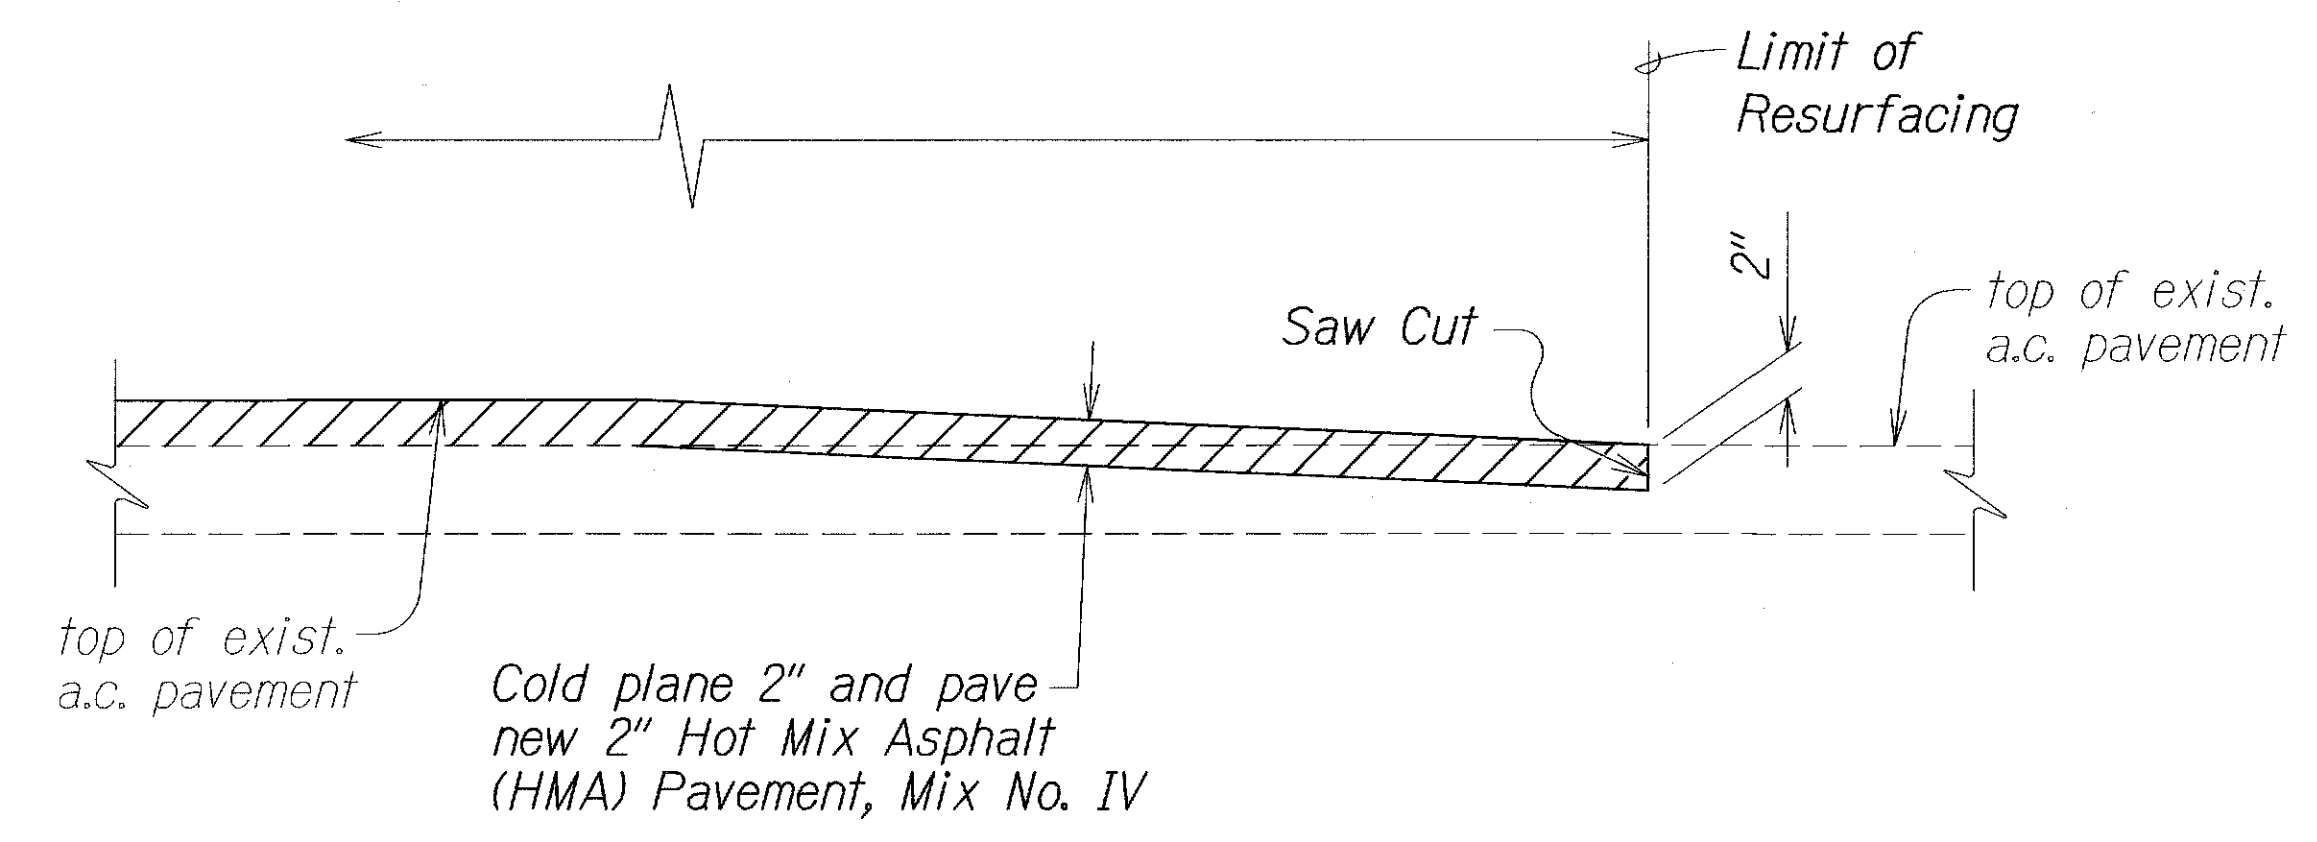

COLD PLANED LONGITUDINAL TRANSITION AT BEGIN AND END OF PROJECT
Not to Scale





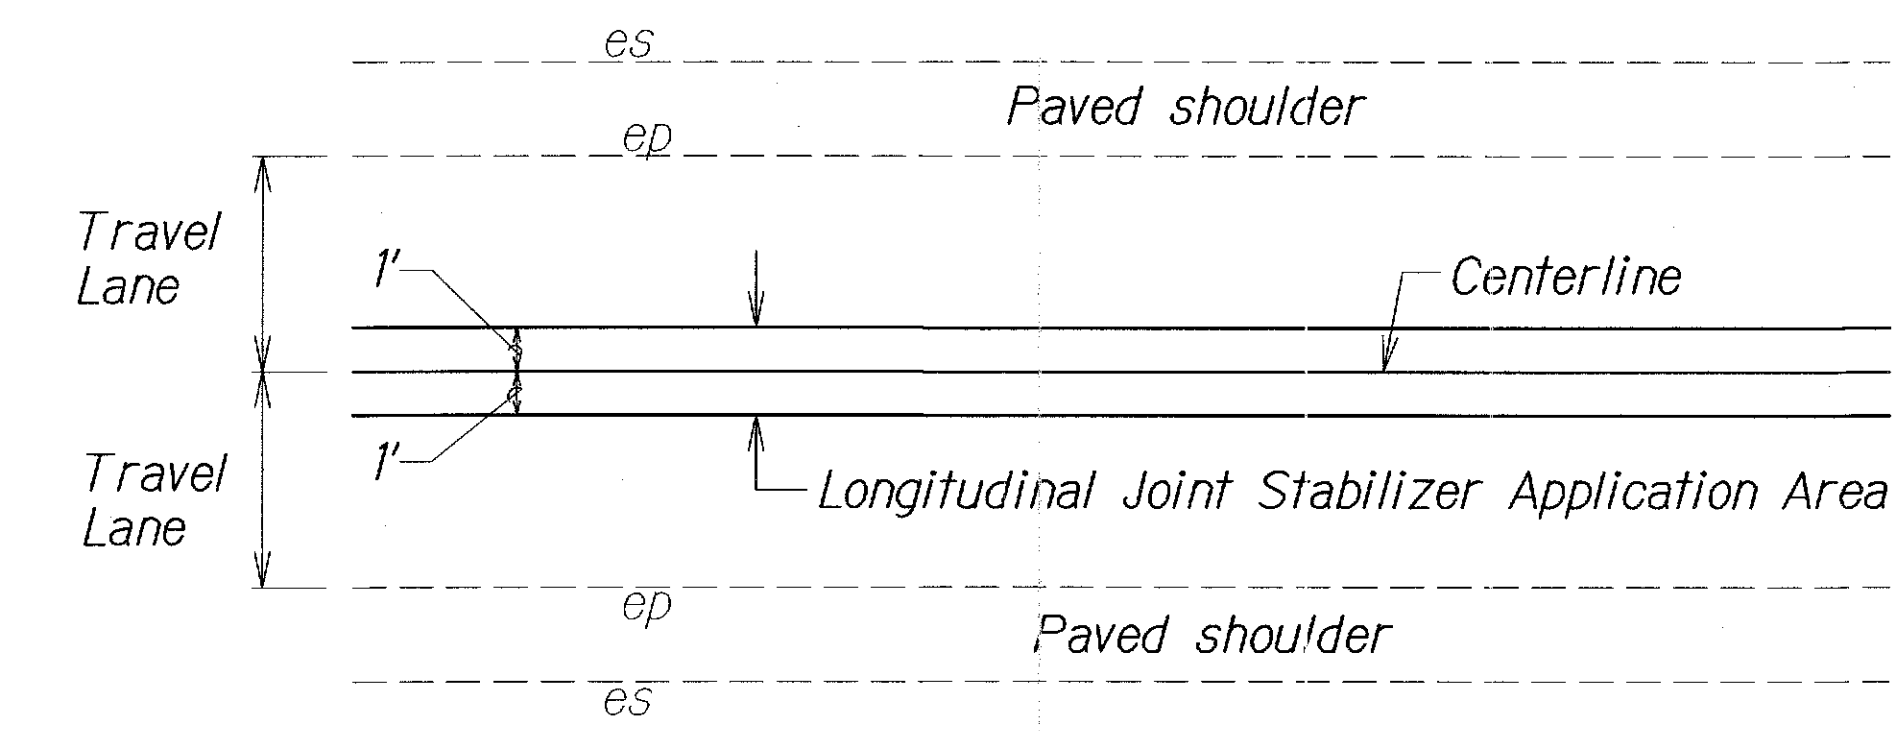


TYPICAL SECTION FOR LONGITUDINAL JOINT STABILIZER
Not To Scale

2-10-14	Limit of cold planing along guardrail.
DATE	REVISION
STATE OF HAWAII DEPARTMENT OF TRANSPORTATION HIGHWAYS DIVISION	
TYPICAL SECTIONS & DETAILS	
KEKAULIKE AVENUE RESURFACING Haleakala Crater Road to Kula Highway Federal-Aid Project No. STP-0377(006)	
Scale: As Shown	Date: August, 2012
SHEET No. 1 OF 2 SHEETS	

DESIGNED BY	DATE
TRACED BY	8/12
NOTED BY	
CHECKED BY	
ORIGINAL PLAN	

FED. ROAD DIST. NO.	STATE	FED. AID PROJ. NO.	FISCAL YEAR	SHEET NO.	TOTAL SHEETS
HAWAII	HAW.	STP-0377(006)	2014	6	38

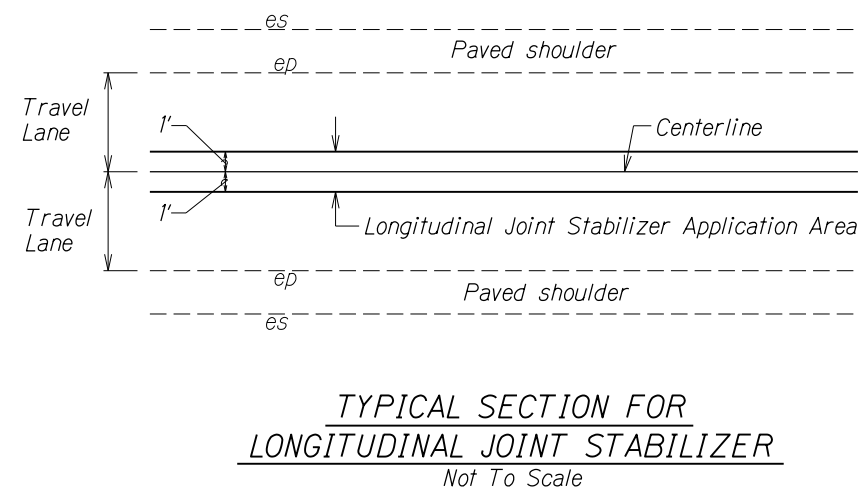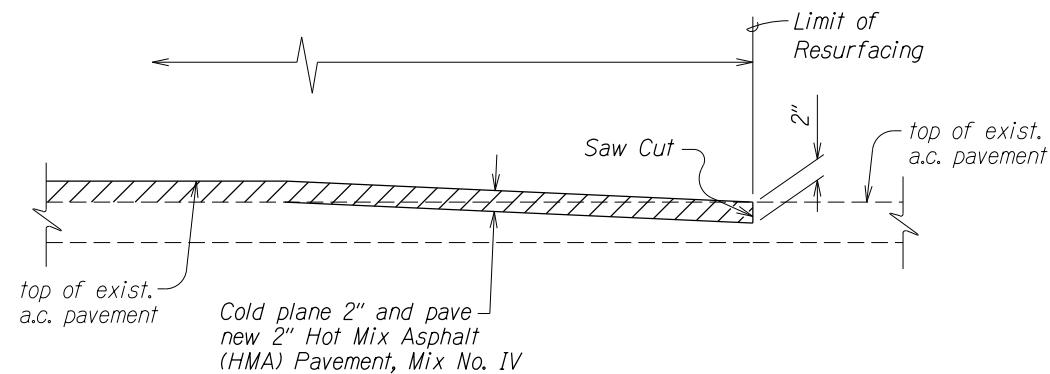
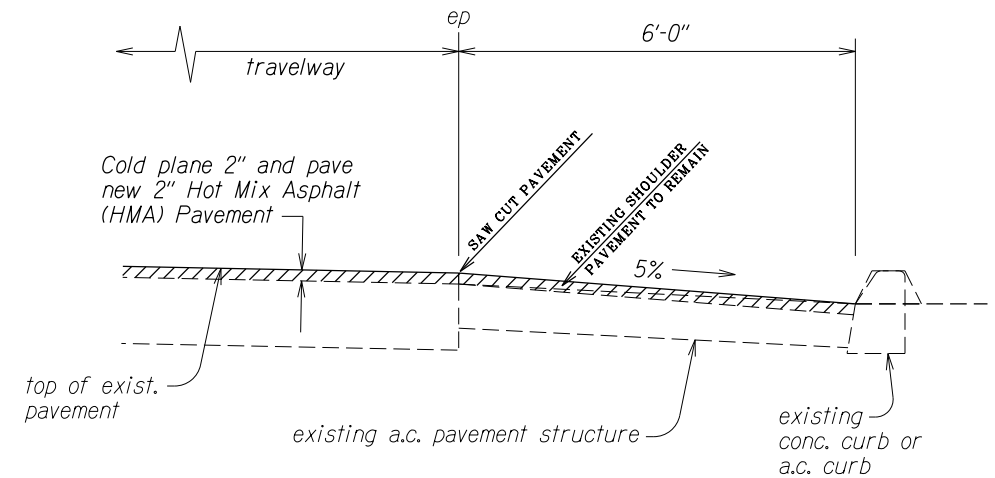
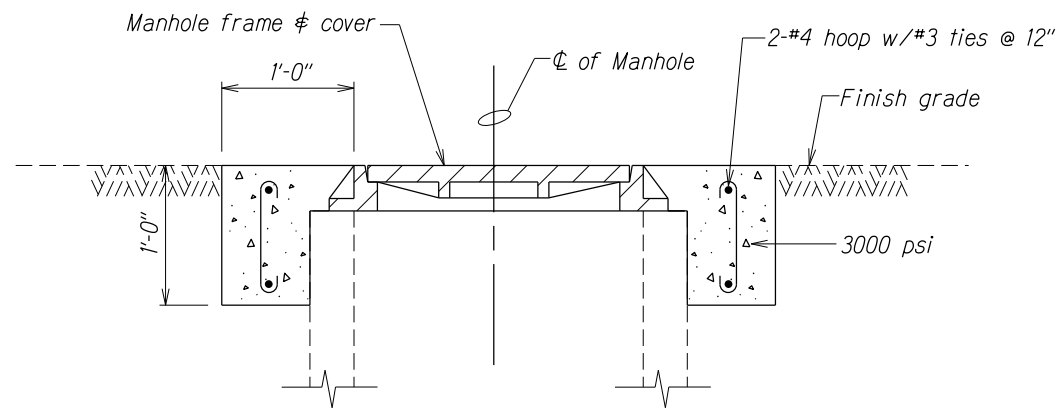
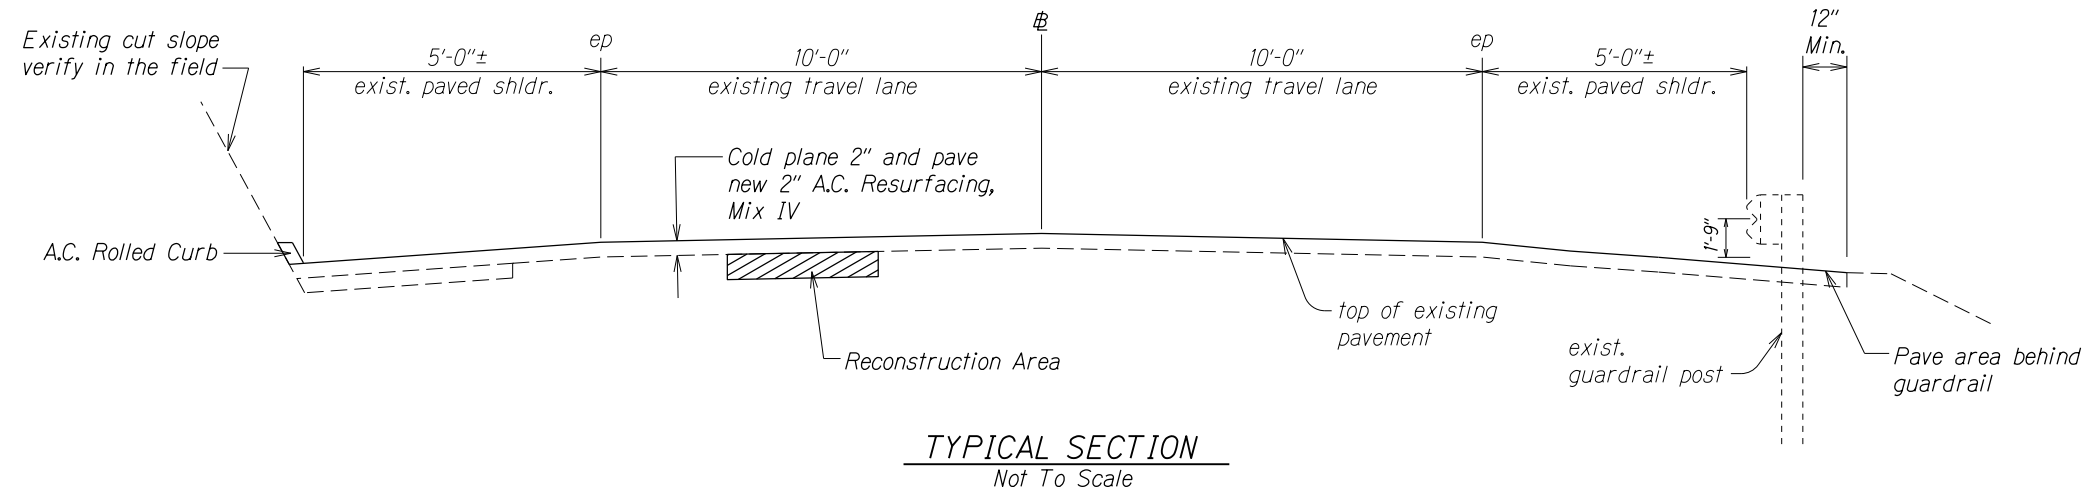


LEGEND FOR AS-BUILT POSTINGS	
	Squiggly line for as-built deletion
	Double line for as-built deletion
Roadway	Text for as-built posting


STATE OF HAWAII DEPARTMENT OF TRANSPORTATION HIGHWAYS DIVISION	
TYPICAL SECTIONS & DETAILS	
KEKAULIKE AVENUE RESURFACING Haleakala Crater Road to Kula Highway Federal-Aid Project No. STP-0377(006)	
Scale: As Shown	Date: August, 2012
SHEET No. 1 OF 2 SHEETS	

"AS-BUILT"

FED. ROAD DIST. NO.	STATE	FED. AID PROJ. NO.	FISCAL YEAR	SHEET NO.	TOTAL SHEETS
HAWAII	HAW.	STP-0377(006)	2014	7	38

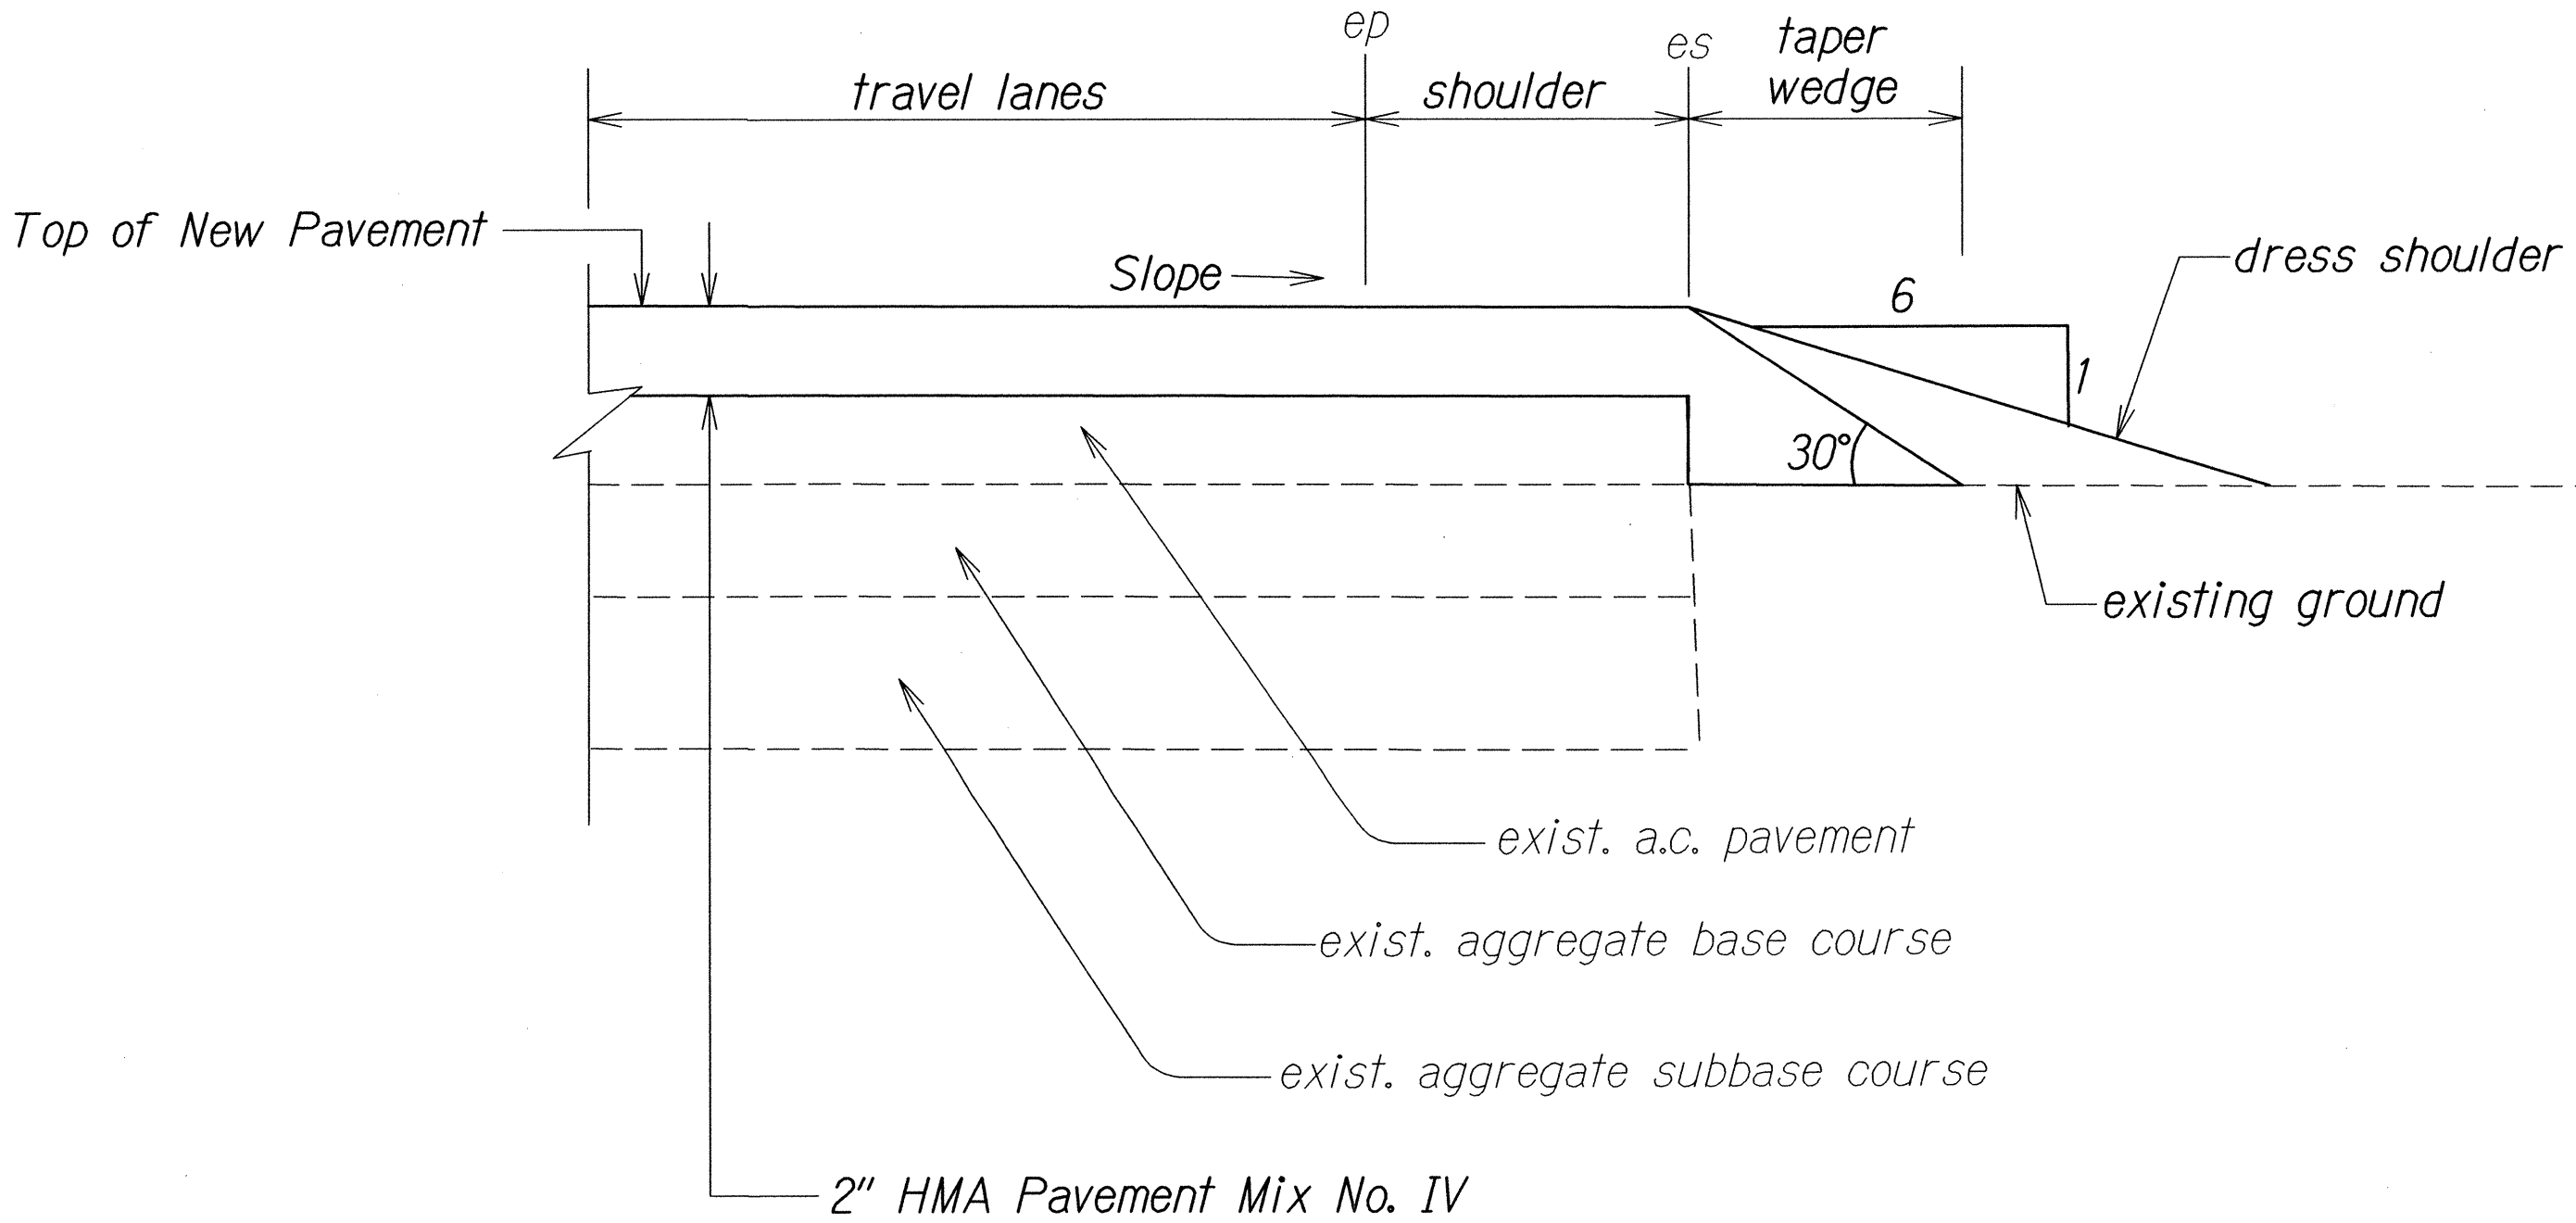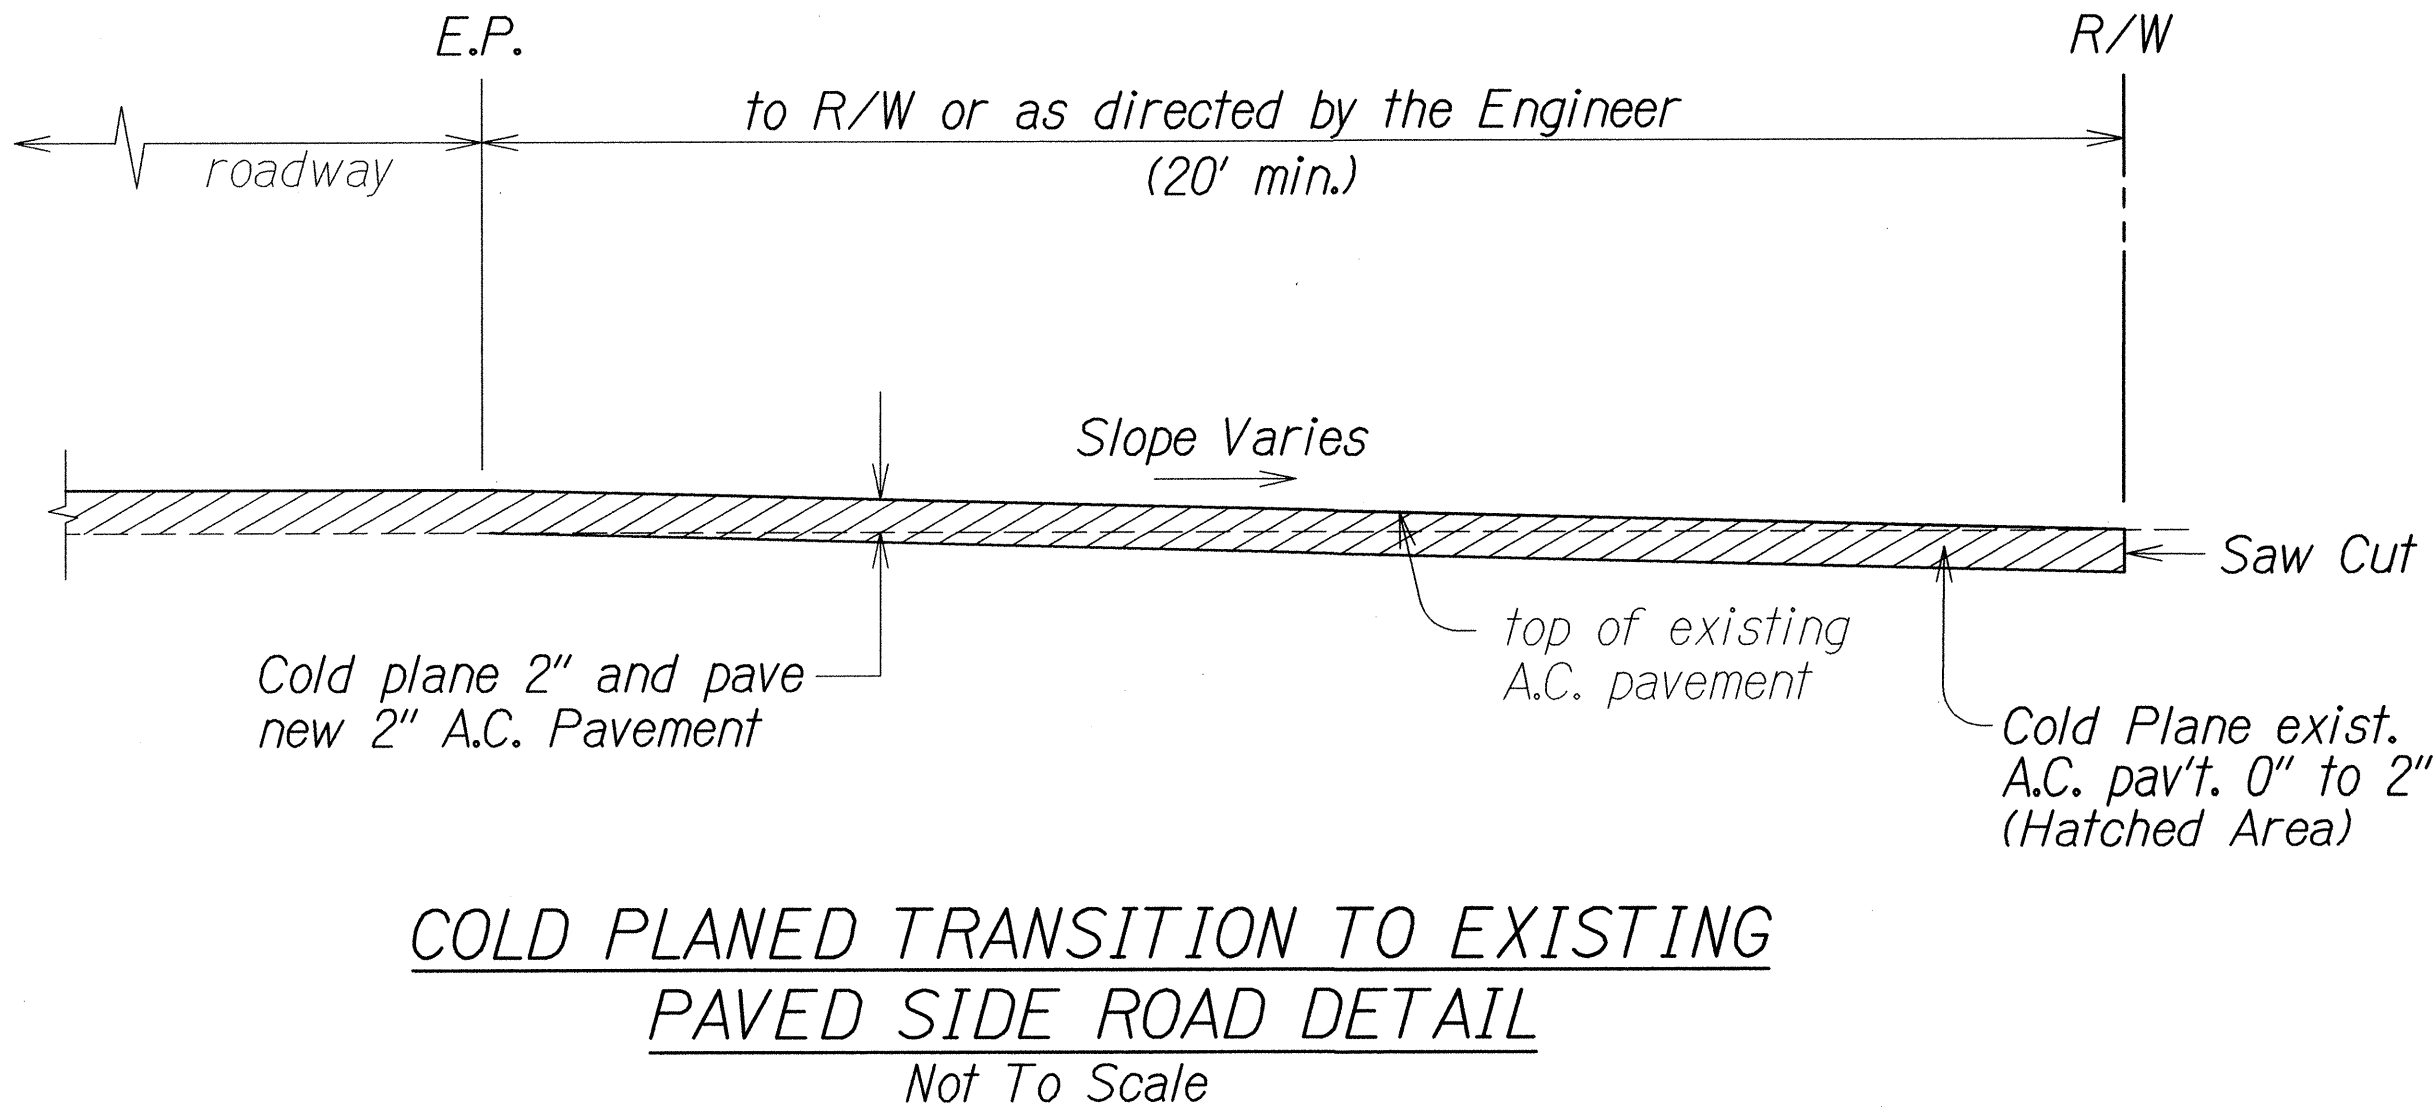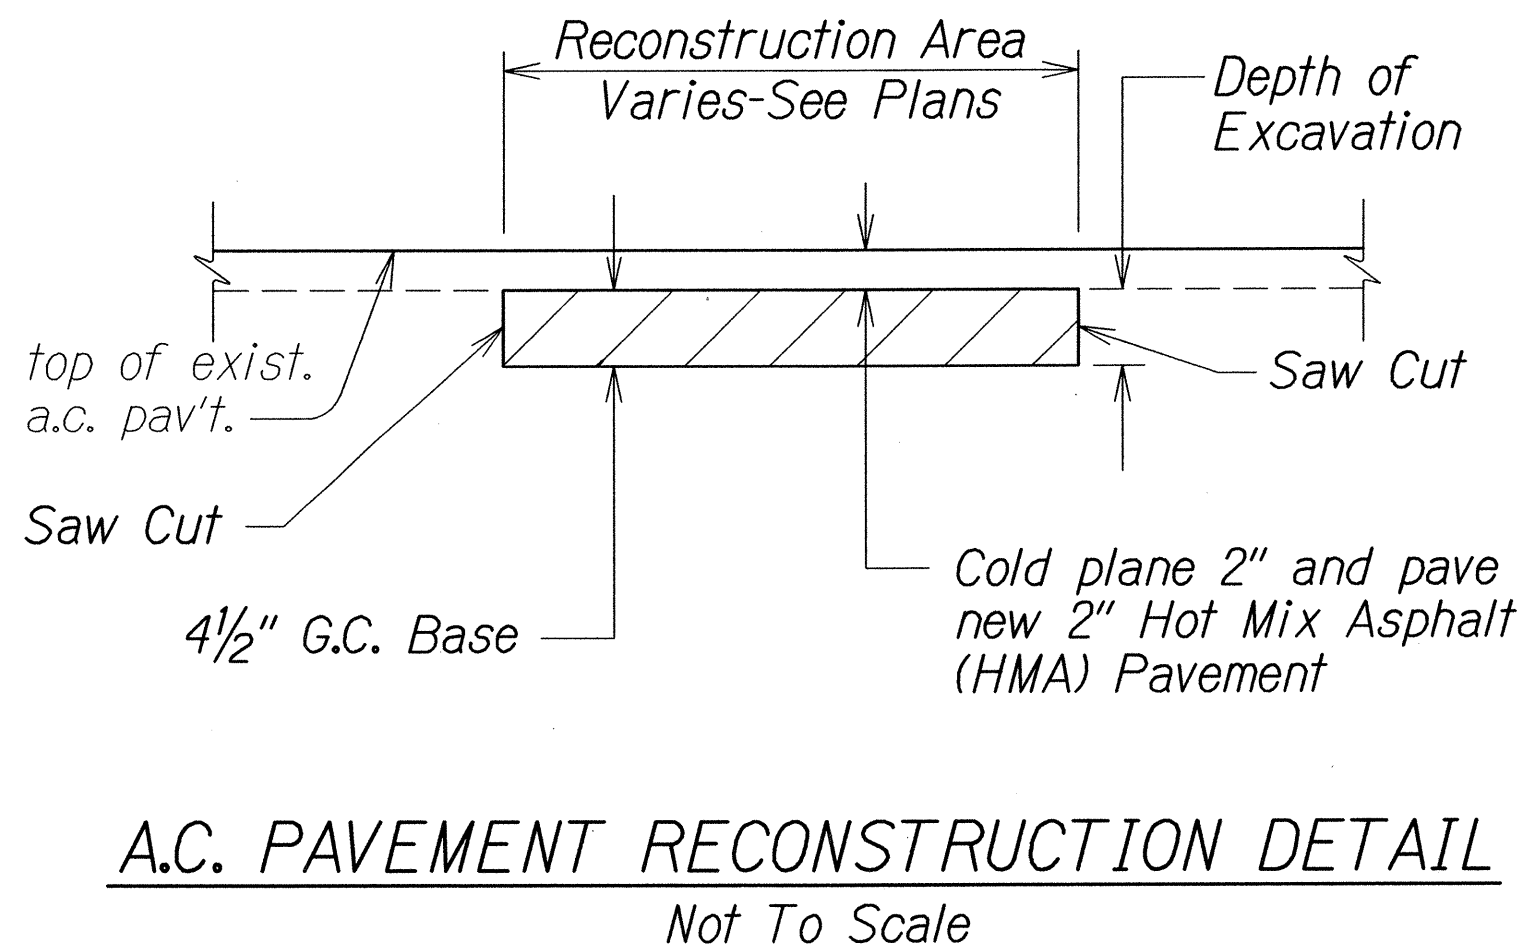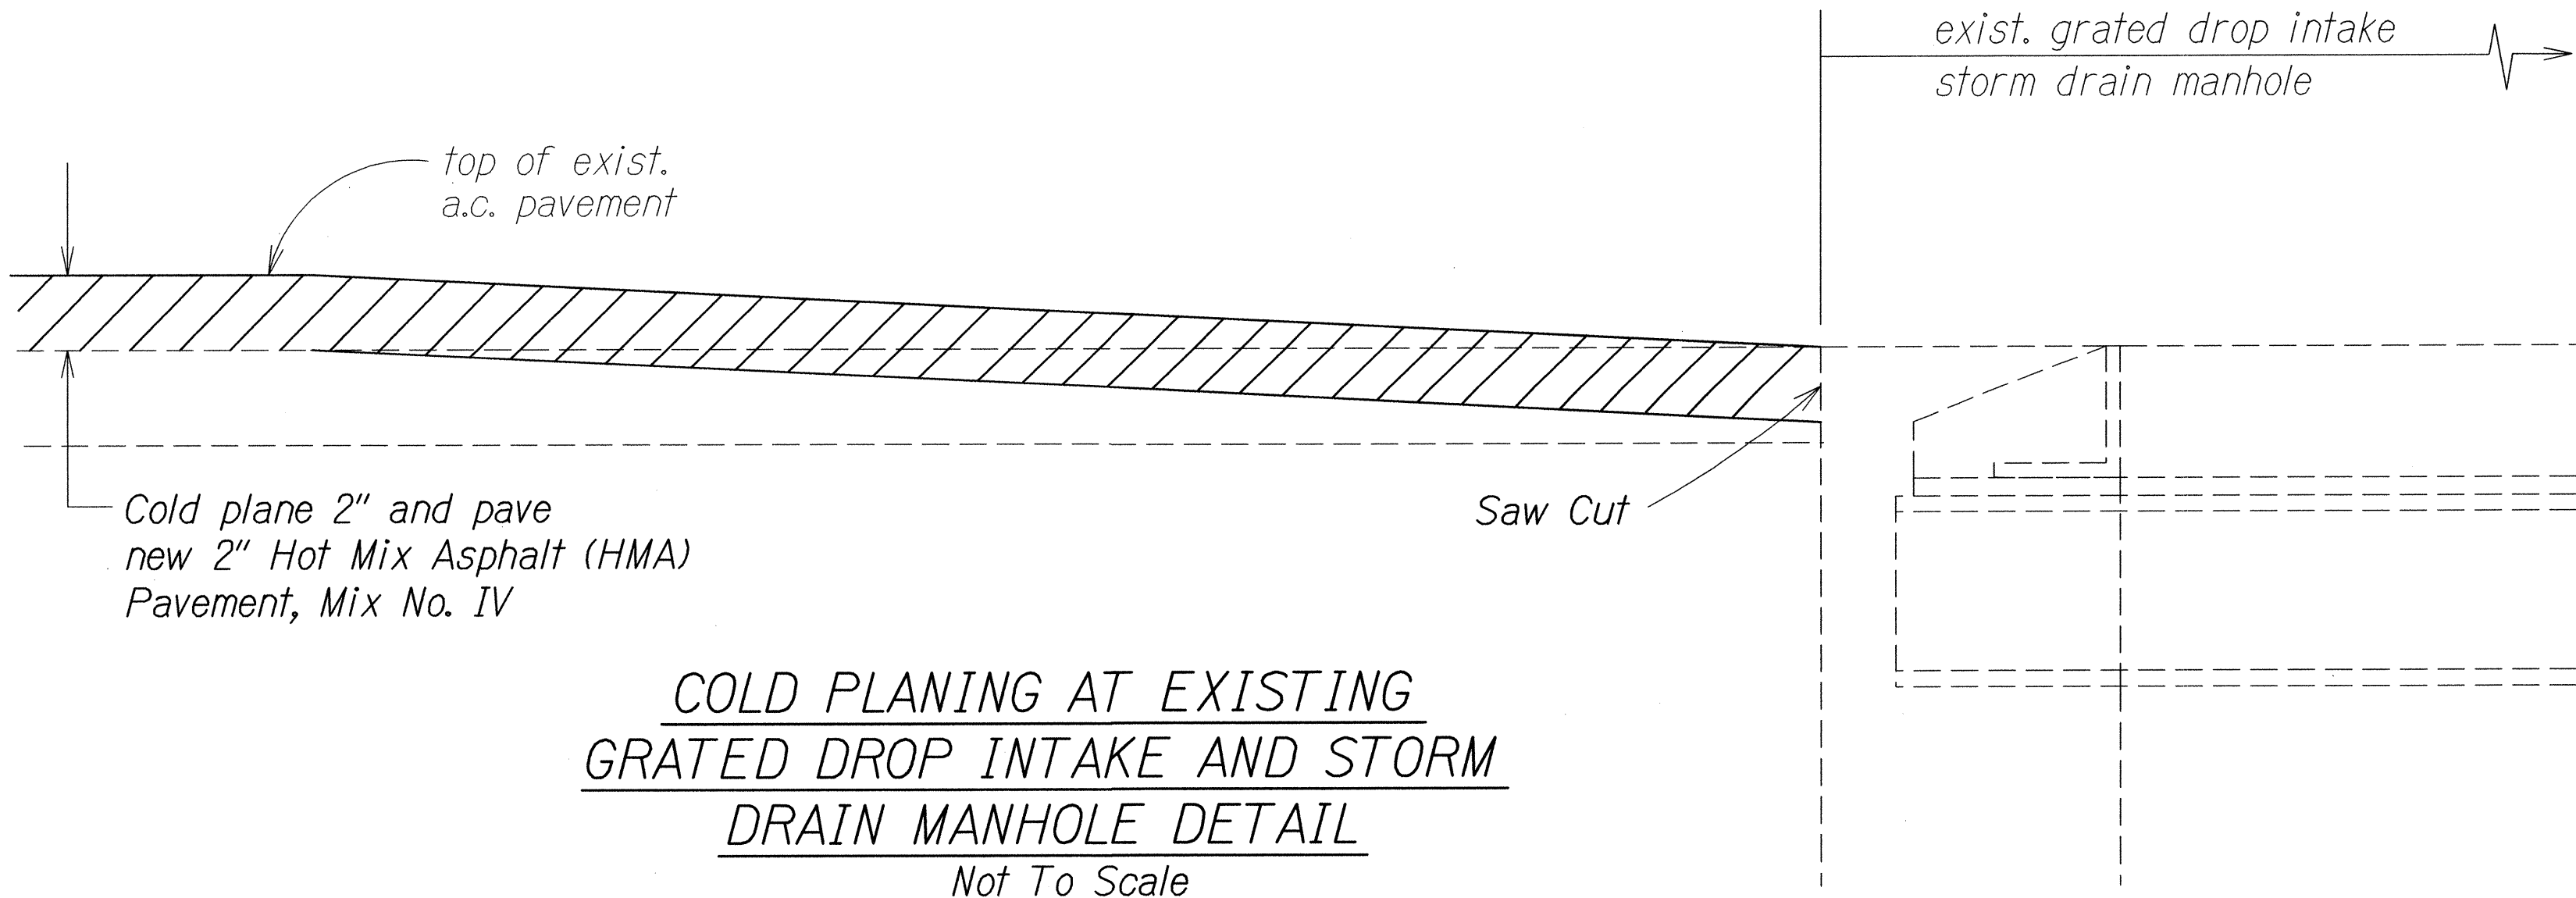

Note: Contractor shall mount a device directly on the paver screed extension to provide a 30° beveled shoulder edge.

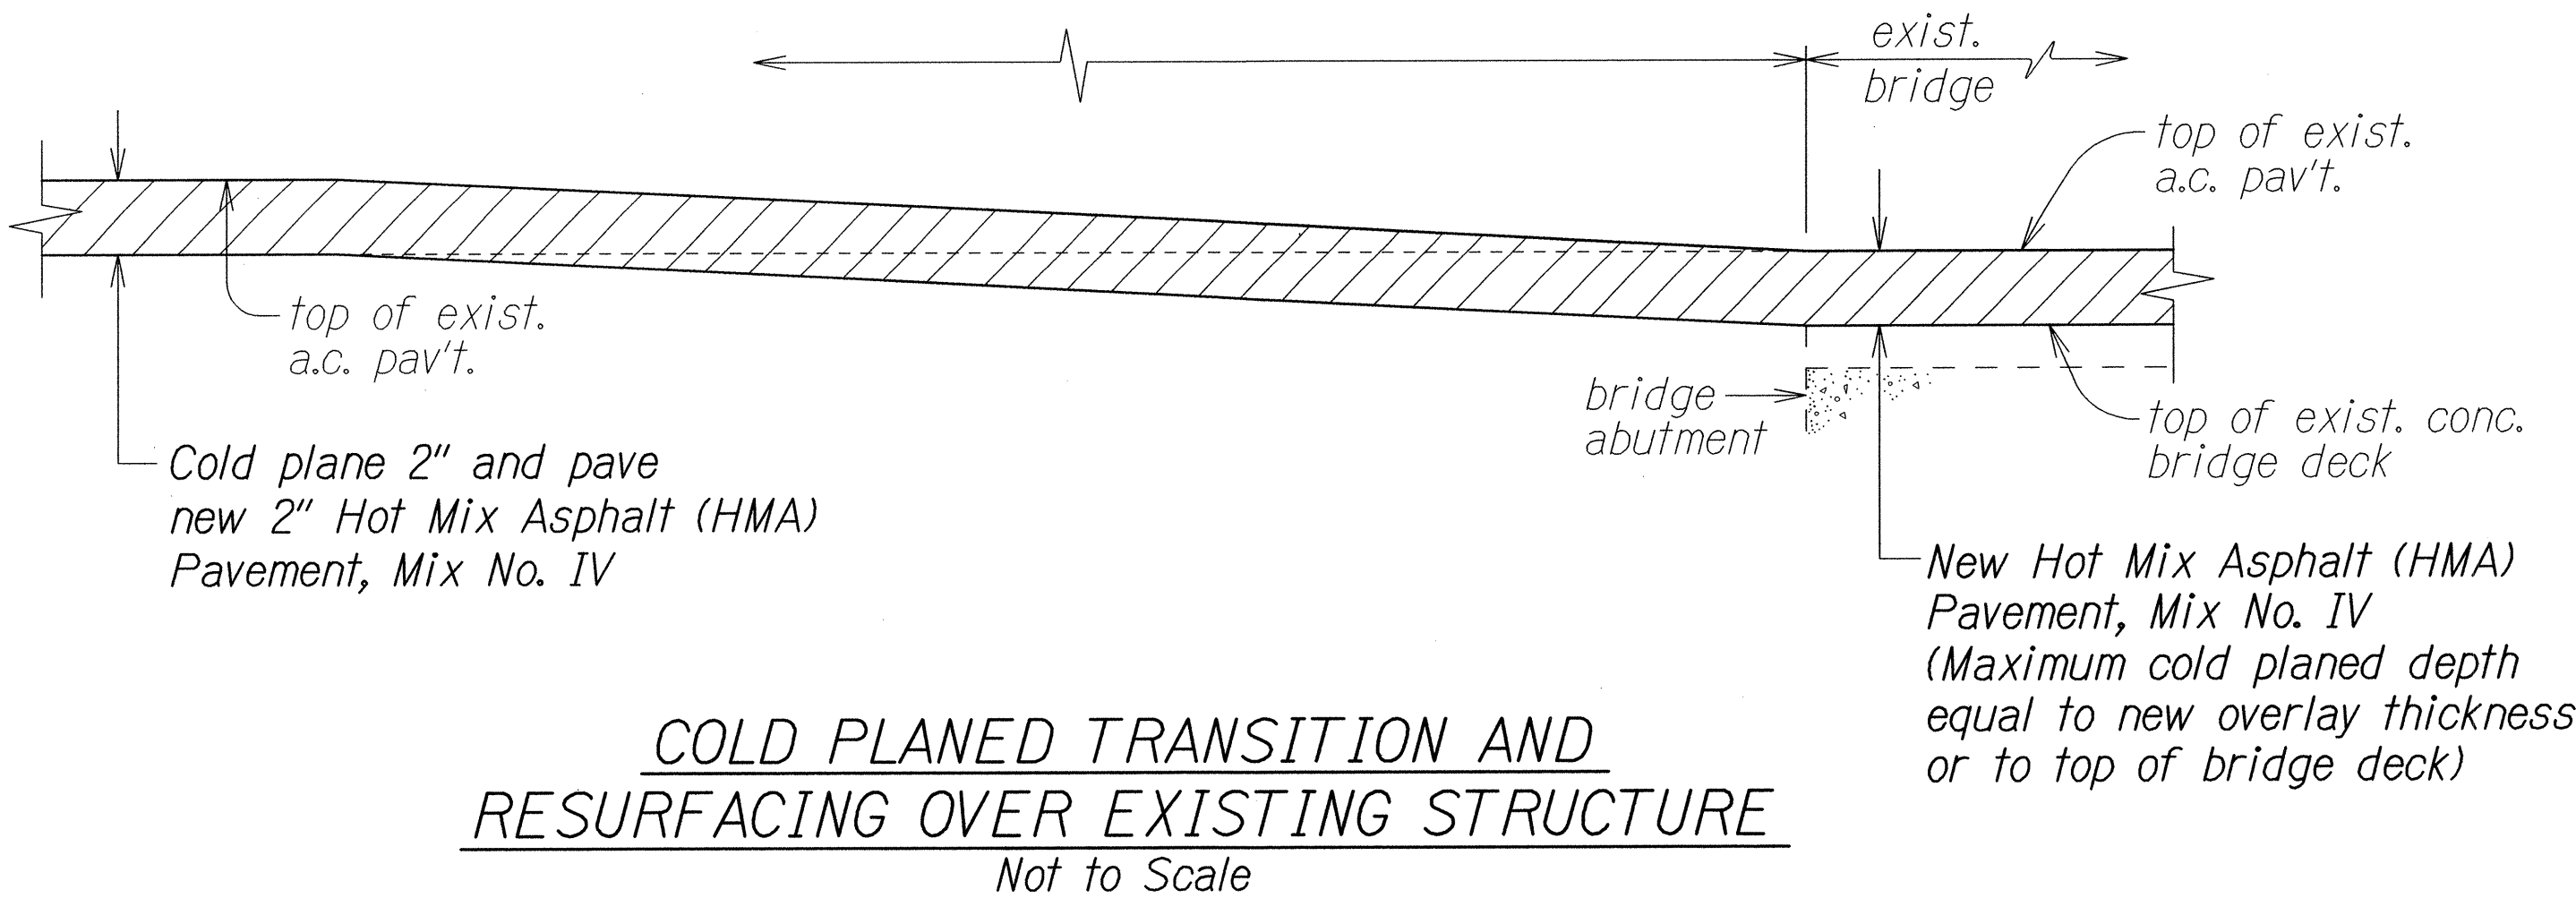

STATE OF HAWAII
DEPARTMENT OF TRANSPORTATION
HIGHWAYS DIVISION

TYPICAL SECTIONS & DETAILS
KEKAULIKE AVENUE RESURFACING
Haleakala Crater Road to Kula Highway
Federal-Aid Project No. STP-0377(006)
Scale: As Shown Date: August, 2012
SHEET No. 2 OF 2 SHEETS

ORIGINAL PLAN	SURVEY PLOTTED BY	DATE
	DESIGNED BY	3/12
NOTE BOOK	TRACED BY	
	DESIGNED BY	ALEX REEDON
No.	QUANTITIES BY	
	CHECKED BY	