





Coping Enclosure Detail

Not To Scale

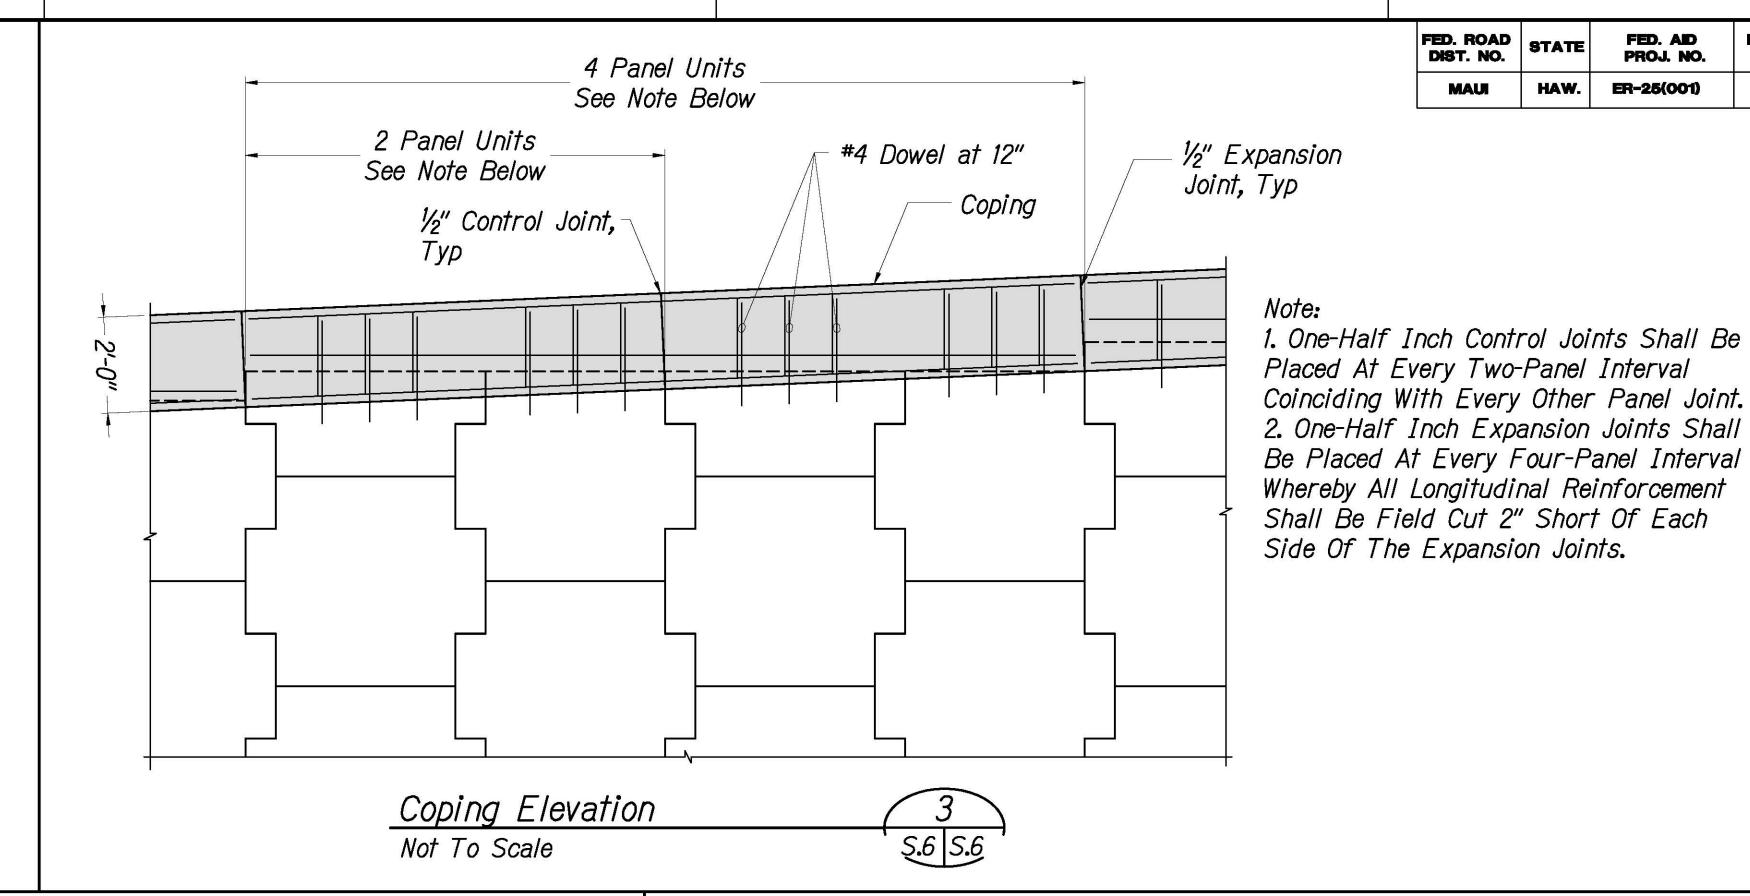

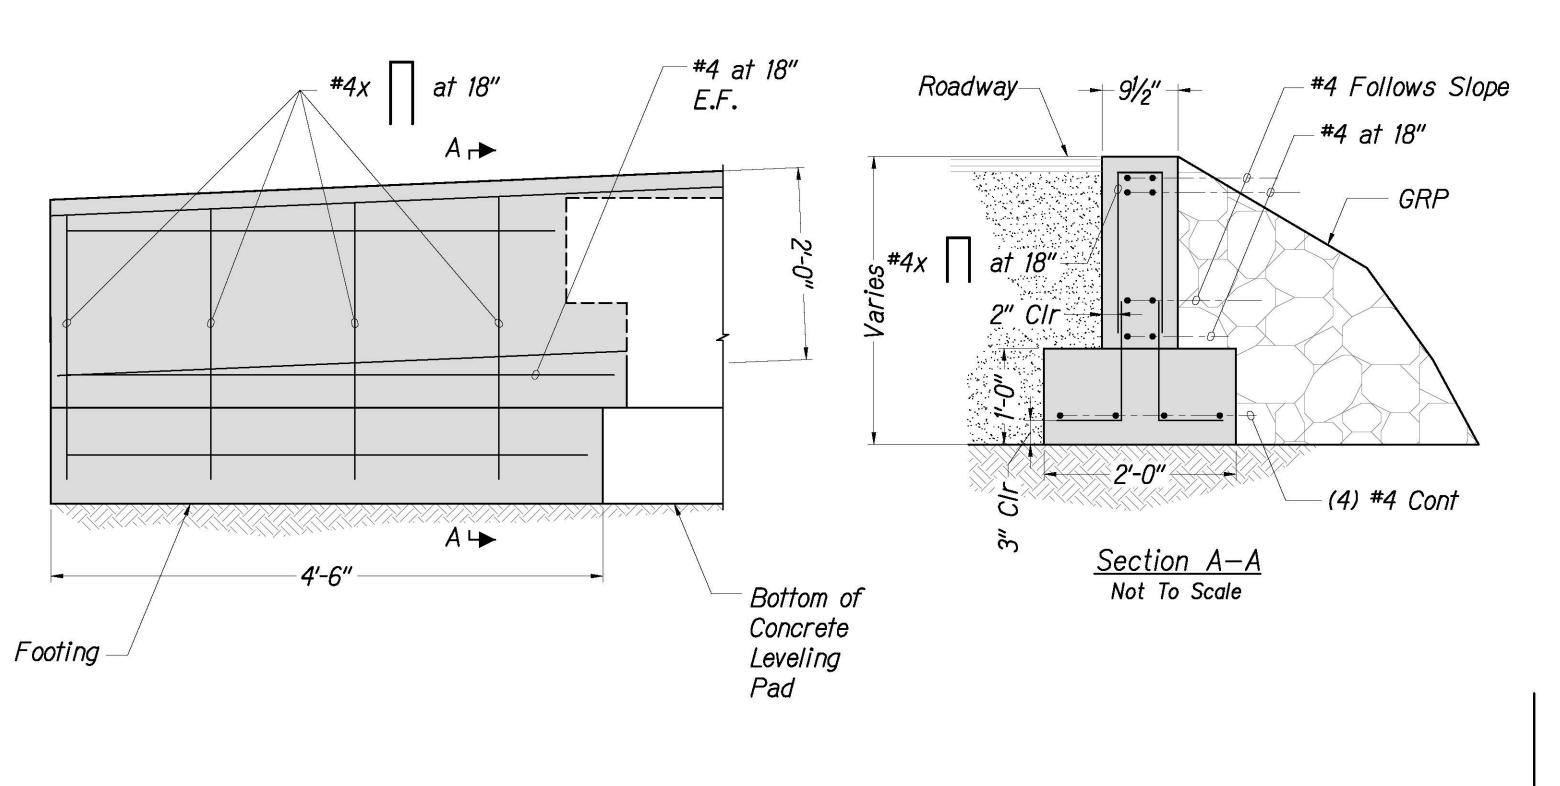

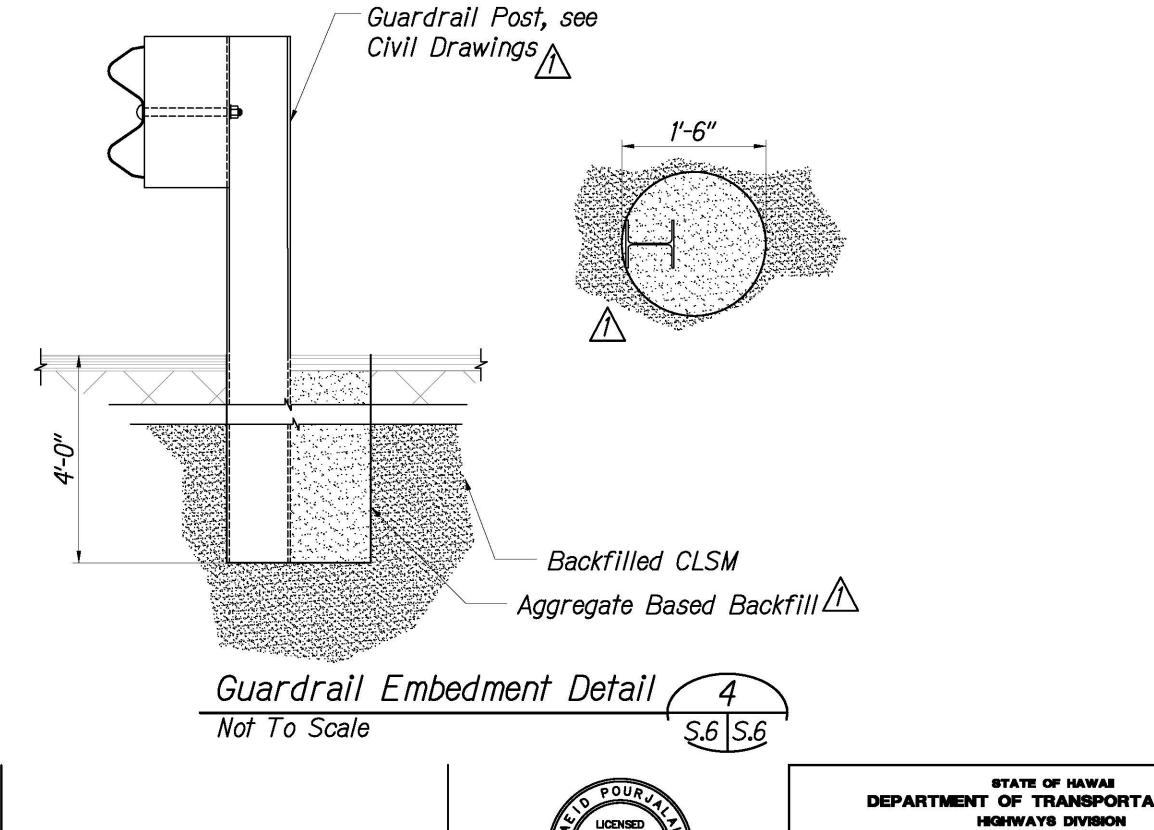

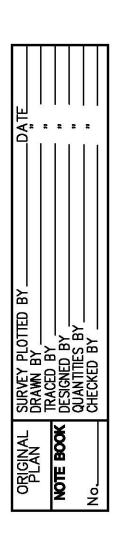

01-19-24

DATE

Revised Guardrail Embedment Position and Fill Material

REVISION

THIS WORK WAS PREPARED BY ME OR UNDER MY SUPERVISION

**PROFESSIONAL** 

LICENSE EXPIRES 4/30/24

DEPARTMENT OF TRANSPORTATION

COPING DETAILS

KEKAULIKE AVENUE, EMERGENCY REPAIRS <u>M.P. 8.2</u>

FEDERAL-AID PROJECT NO. ER-25(001) Date: April 2022 Scale: As Noted

SHEET No. 3 OF 3 SHEETS

ADD.29

FISCAL SHEET TOTAL YEAR NO. SHEETS

2022 ADD.29 30

FED. AID PROJ. NO.

ER-25(001)

STATE

HAW.