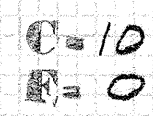


10-6A
10-6A
10-6A
10-6A

$$\sum_{i=1}^n \sum_{j=1}^n$$

$$\begin{aligned} C &= 3 \\ R &= 0 \end{aligned}$$

0 = 5
1 = 0

C = 4
F = 1

C = 6
F = 0

$$\begin{aligned} C &= 4 \\ F &= 1 \end{aligned}$$
$$\begin{aligned} C &= 0 \\ F &= 0 \end{aligned}$$


Exc = 8
Emb = 0

Exc = 7
Embl = 0

Exe = 6
Ench = 0

Exe = 4
Emb = 1

Exe = 6
Enab = 1

C- /
E- /

$$C = 10$$


$$E = C$$

C = 7
F = C

C-9
R-0

$$\begin{aligned} O &= 5 \\ F &= 0 \end{aligned}$$

C = 4
E = 1

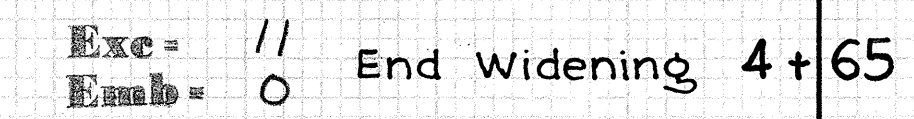
$$\begin{aligned} C &= 0 \\ F &= 0 \end{aligned}$$

Exc = 30
Emmb = 0

$C = 24$
 $E = 0$

```
Exe = 32
Emulb = 0
```

$$C = 40$$
$$E = 0$$

Exc = 32
Emmb = 0

C = 30
E = 0

Exc = 5
Emb = 1

C = 9
E = 0

Exc = 19
Emb = 0

1+70

C=15
F=0

Exc = 26
Emb = 0

1+45

C=25
F=0

Exc = 27
Emb = 2

1+20

C=32
F=0

Exc = 7
Emb = 1

0+75

C=1
F=2

Exc = 8
Emb = 2

0+50

C=14
F=0

Exc = 1
Emb = 2

0+25

C=3
F=4

0+00

C=0
F=0

Exc = 30
Emb = 0

3+45

C=33
F=0

Exc = 28
Emb = 0

3+20

C=32
F=0

Exc = 25
Emb = 0

2+95

C=28
F=0

Exc = 16
Emb = 0

2+70

C=26
F=0

Exc = 11
Emb = 0

2+45

C=9
F=0

Exc = 13
Emb = 0

2+20

C=15
F=0

Exc = 13
Emb = 0

1+95

C=14
F=0

Exc = 1
Emb = 0

End Widening 5+40

C=0
F=0

Exc = 6
Emb = 0

5+15

C=2
F=0

Exc = 23
Emb = 0

4+20

C=12
F=0

Exc = 62
Emb = 0

4+65

C=38
F=0

Exc = 52
Emb = 0

4+20

C=37
F=0

Exc = 69
Emb = 0

3+95

C=76
F=0

Exc = 49
Emb = 0

3+70

C=73
F=0

CURVE #3

SHT. 10

Exc = 10
Emb = 0
D Exc = 15 13

Exc = 12 55
Emb = 2 10
D Exc = 4 4

Exc = 19 47
Emb = 1

D Exc = 5 4
BETWEEN STA. 0+88
AND STA. 1+20

DC = 0

Exc = 11
Emb = 0
D Exc = 13 11

C = 8
F = 0
D.C. = 16 13

Exc = 13 35
Emb = 5
D Exc = 12 4

Exc = 38 48
Emb = 0
C = 14 46
F = 10
D.C. = 11 4

C = 28 50
F = 0

INV. = 04.6
12.02%
INV. = 09.0
Extend Exist'g
18" C.G.M.P.

Exc = 14
Emb = 0
D Exc = 10 8

C = 16
F = 0
D.C. = 12 10

Exc = 14 27
Emb = 0
D Exc = 13 4

Exc = 85
Emb = 0
C = 14 30
F = 0
D.C. = 14 4

C = 54
F = 0

Exc = 11
Emb = 0
D Exc = 8 6

C = 14
F = 0
D.C. = 10 8

Exc = 13 21
Emb = 0
D Exc = 13 4

Exc = 42
Emb = 0
C = 16 29
F = 0
D.C. = 14 4

Exc = 0
Emb = 0

C = 0
F = 0

Exc = 12
Emb = 2

C = 9
F = 0
D.C. = 6 6

Exc = 17
Emb = 0
D Exc = 15 4

Exc = 38 41
Emb = 0
C = 11 17
F = 0
D.C. = 14 4

C = 48
F = 0

Exc = 12
Emb = 0

C = 0
F = 0

Exc = 6
Emb = 1

C = 6
F = 2

Exc = 9 12
Emb = 0
D Exc = 17 7

Exc = 11 12
Emb = 6
C = 12 19
F = 0
D.C. = 19 4

C = 40 46
F = 0

Exc = 37
Emb = 0

C = 25
F = 0

Exc = 4
Emb = 1

C = 6
F = 0

Exc = 10
Emb = 0
D Exc = 16 12

Exc = 18 12
Emb = 7 22
Emb = 10
D Exc = 15 13

C = 14
F = 28
D.C. = 47

Exc = 6 47
Emb = 1

C = 56
F = 0

Exc = 1
Emb = 1

C = 3
F = 0

C = 0
F = 0

C = 13
F = 0
D.C. = 17 14

C = 12 72
F = 10
D.C. = 4

C = 13 51
F = 1

Note:
D.C. = DITCH CUT
D. Exc. = DITCH EXCAVATION

CURVE #5

CULVERT 4+09.20

Extend Exist'g
18" C.G.M.P.

End Widening 5+90

CULVERT 0+88

Exc= 24
Emb= 0

Exc= 14
Emb= 3

Exc= 4
Emb= 6

Exc= 4
Emb= 6

Exc= 1
Emb= 2

1+20

0+75

0+50

0+25

0+00

C= 13
F= 0

C= 4
F= 4

C= 3
F= 3

C= 3
F= 4

C= 0
F= 0

Exc= 59
Emb= 0

Exc= 49
Emb= 0

Exc= 50
Emb= 0

Exc= 55
Emb= 0

Exc= 47
Emb= 0

2+45

2+20

1+95

1+70

1+45

C= 52
F= 0

C= 53
F= 0

C= 56
F= 0

C= 63
F= 0

C= 38
F= 0

Exc= 68
Emb= 0

Exc= 94
Emb= 0

Exc= 116
Emb= 0

Exc= 104
Emb= 0

Exc= 85
Emb= 0

3+70

3+45

3+20

2+95

2+70

C= 70
F= 0

C= 134
F= 0

C= 117
F= 0

C= 107
F= 0

C= 76
F= 0

End Widening

Exc= 4
Emb= 0

Exc= 6
Emb= 0

Exc= 9
Emb= 0

Exc= 75
Emb= 0

5+15

4+90

4+65

4+40

3+95

C= 0
F= 0

C= 8
F= 0

C= 5
F= 0

C= 14
F= 0

C= 76
F= 0

CURVE #6

Exc = 5
Emb = 6

Exc = 25
Emb = 0

Exc = 57
Emb = 0

Exc = 5
Emb = 13

Exc = 19
Emb = 0

Exc = 58
Emb = 0

Exc = 7
Emb = 32

Exc = 11
Emb = 1

Exc = 69
Emb = 0

Exc = 3
Emb = 25

Exc = 8
Emb = 1

Exc = 65
Emb = 0

Exc = 3
Emb = 23

Exc = 7
Emb = 1

Exc = 49
Emb = 0

Exc = 2
Emb = 8

Exc = 4
Emb = 1

Exc = 36
Emb = 0

Exc = 10
Emb = 0

Exc = 24
Emb = 0

Exc = 33
Emb = 0

Exc = 77
Emb = 0

Exc = 56
Emb = 0

End Widening

CURVE # 7

