

INDEX TO DRAWINGS	
SHEET NO	DESCRIPTION
1	TITLE
2	TYPICAL SECTIONS
3-7	PLAN & PROFILE
8-14	CROSS - SECTIONS

STATE OF HAWAII

DEPARTMENT OF TRANSPORTATION

HIGHWAYS DIVISION

HONOLULU, HAWAII

"AS BUILT"


PLANS FOR WIDENING CERTAIN CURVES OF

HALEAKALA ROAD GROUP B

PROJECT NO. A-378-01-65

DISTRICT OF MAKAWAO


ISLAND OF MAUI

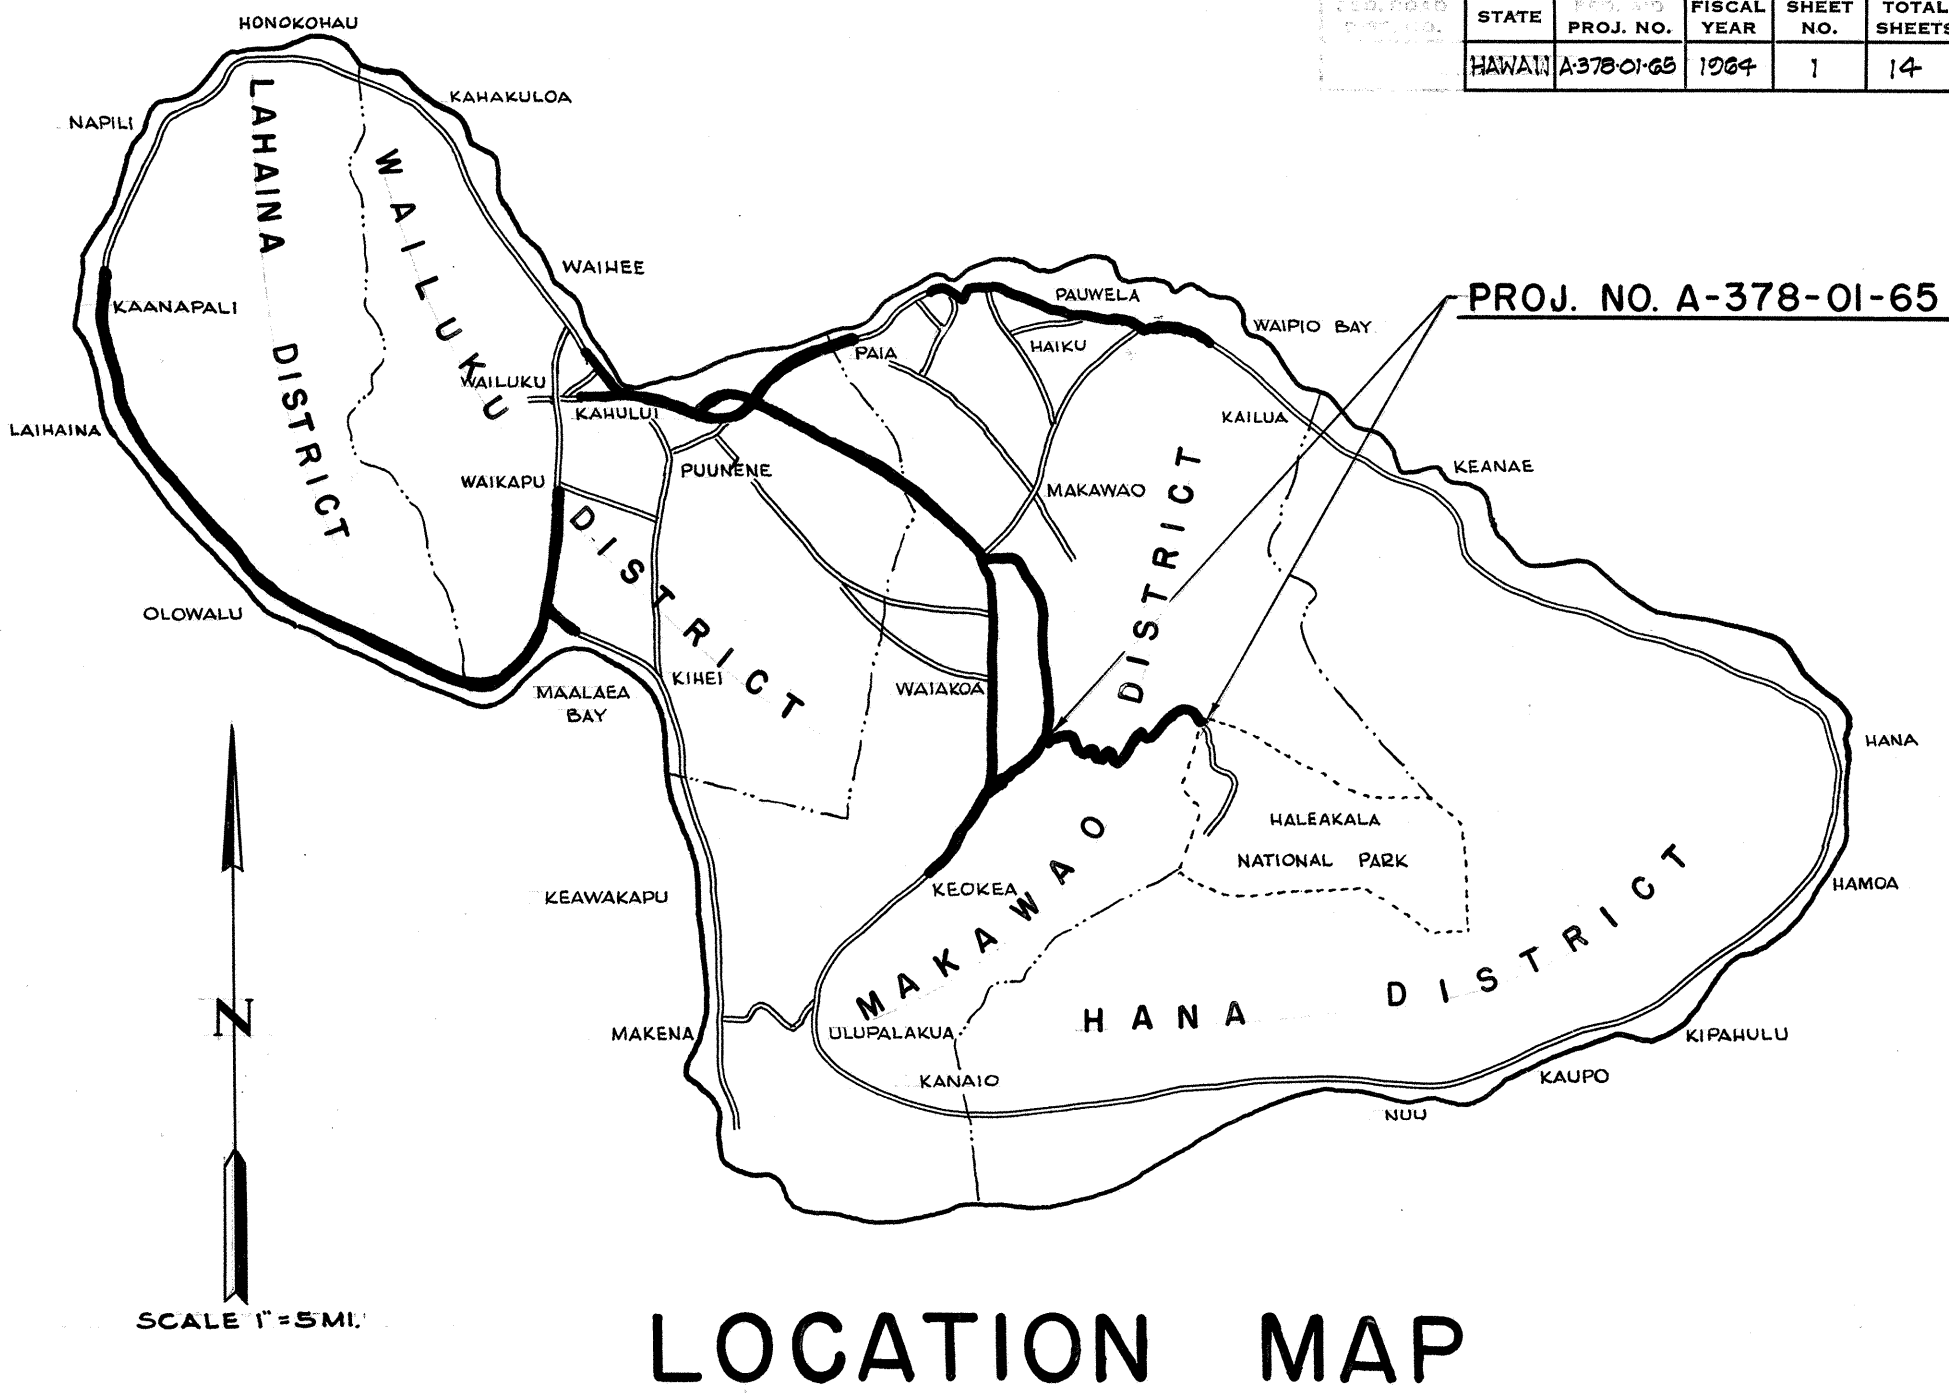

TRUE NORTH
SCALE 1"=2000'

SCALES

PLAN 1 IN. = 100 FT.
 PROFILE HOR. 1 IN. = 100 FT.
 VER. 1 IN. = 10 FT.
 X-SECTIONS HOR. 1 IN. = 10 FT.
 VER. 1 IN. = 10 FT.

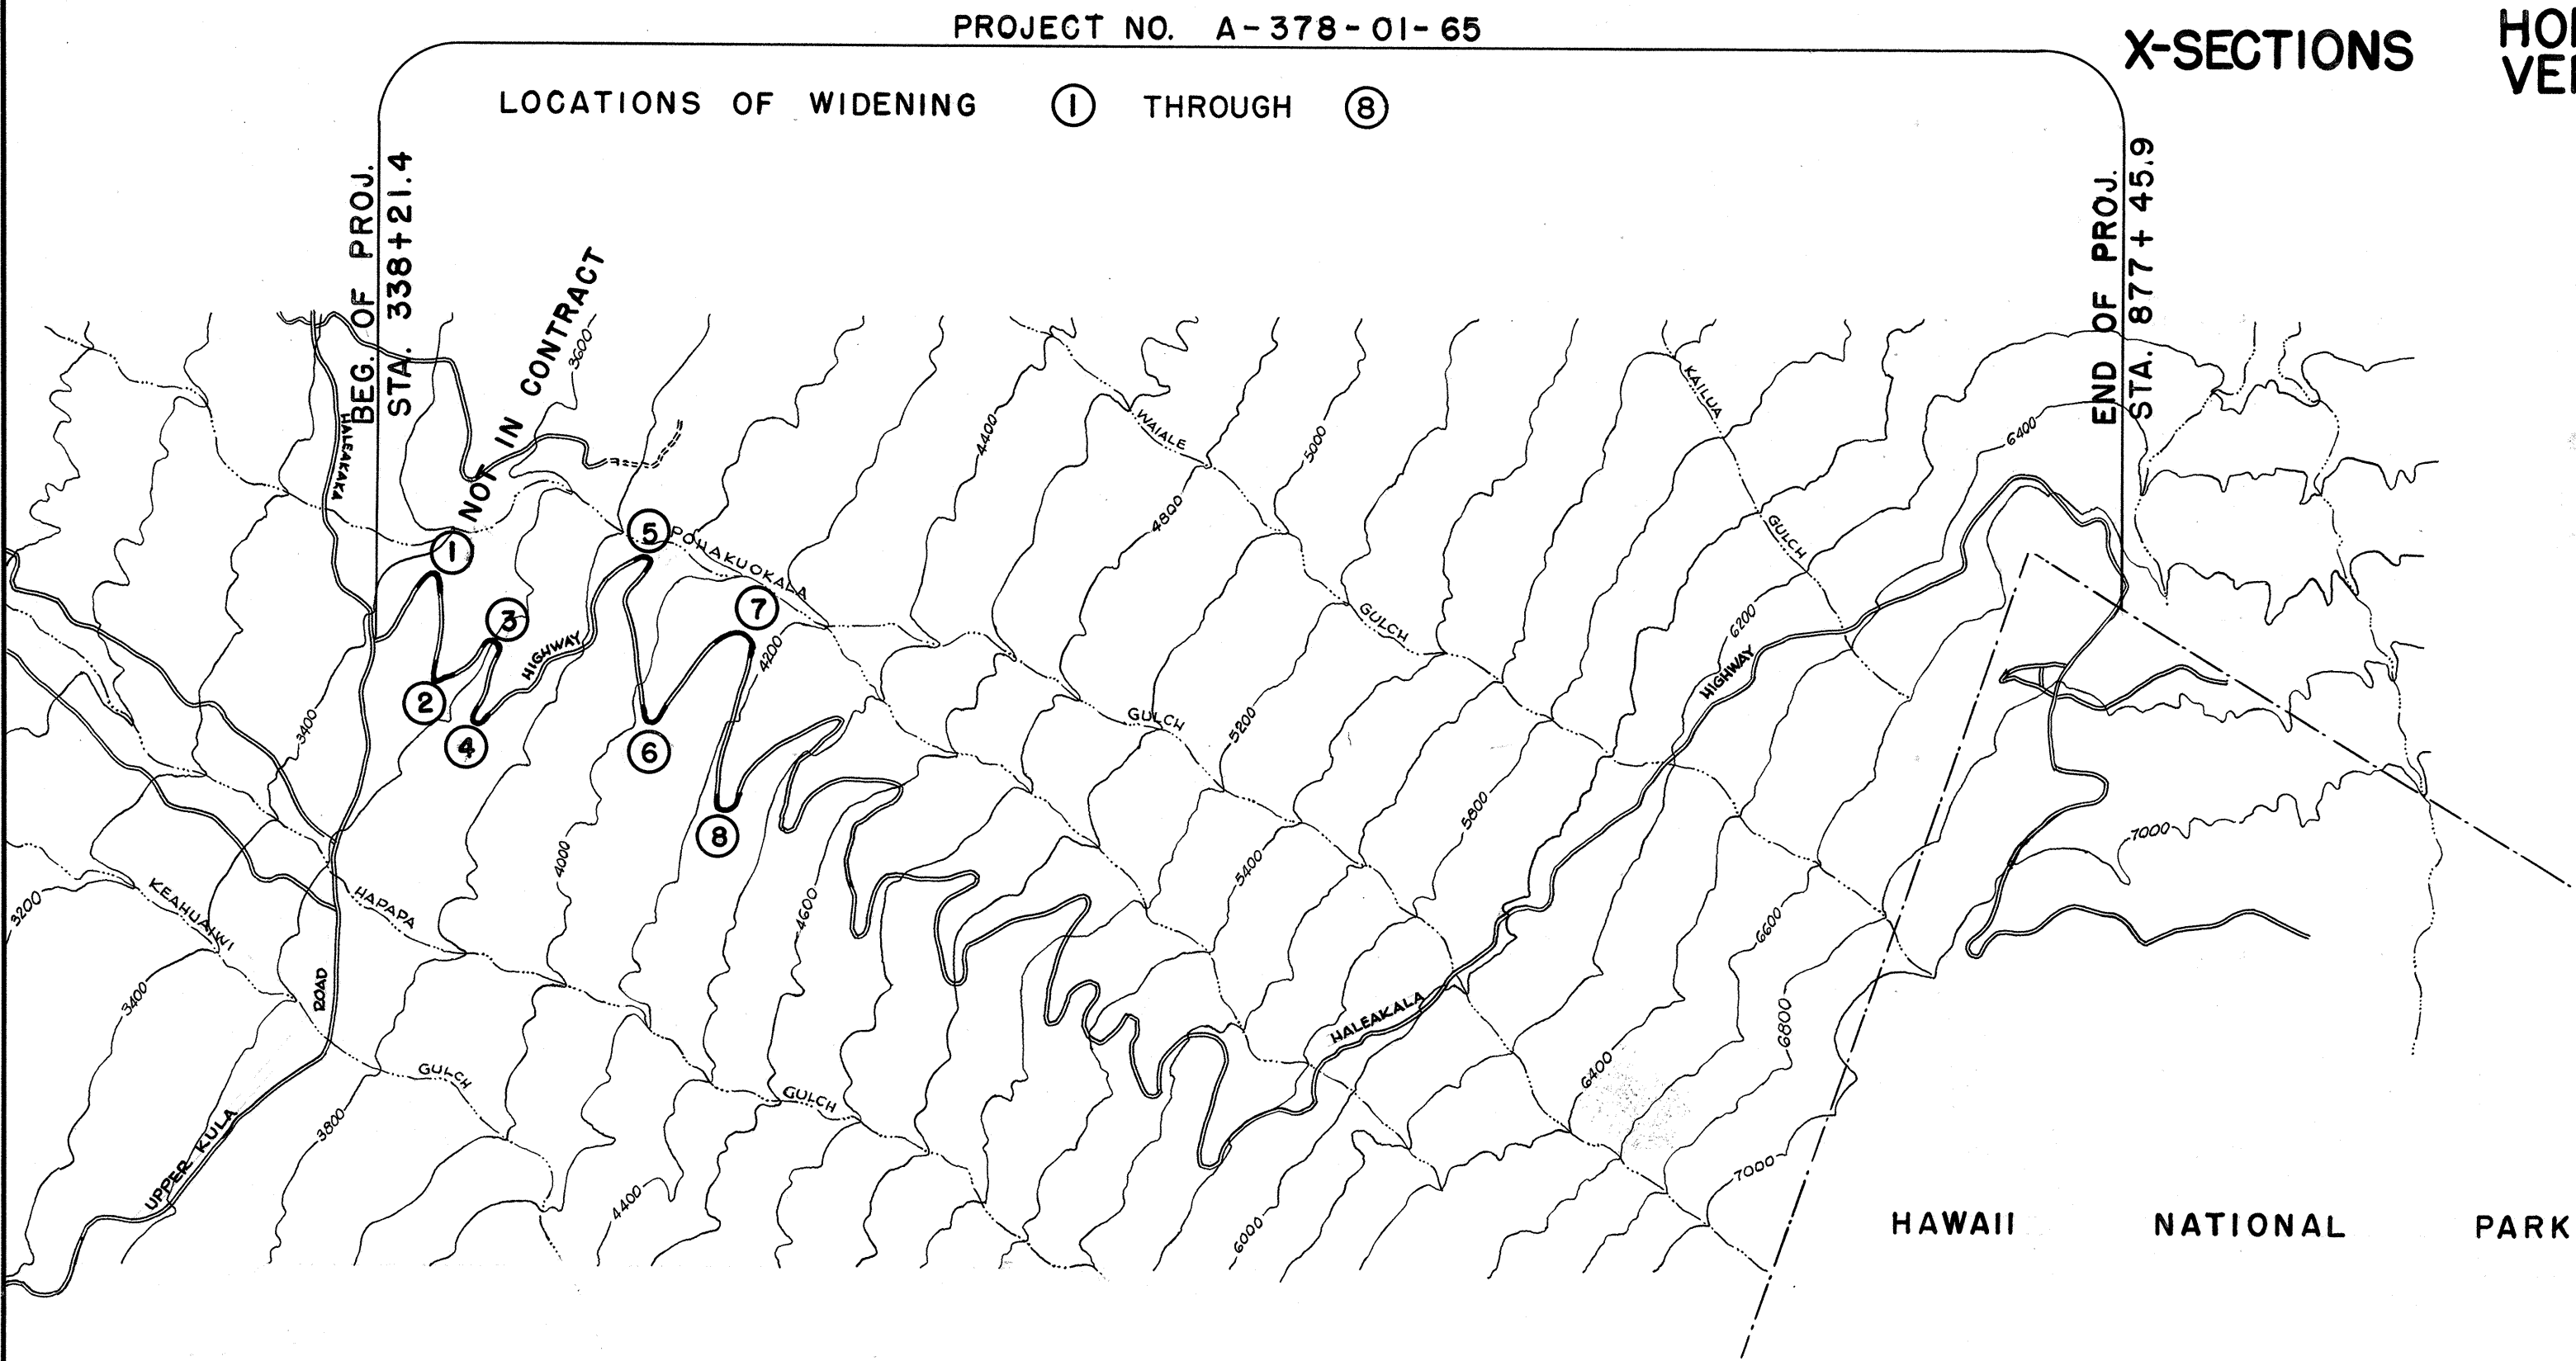

LAYOUT OF PROJECT

LENGTH OF IMPROVEMENTS 0.735 MILE
 LENGTH OF PROJECT 10.213 MILES

NOTE: ALL CHANGES MADE DURING CONSTRUCTION ARE SHOWN IN RED ON THESE TRACINGS AND CHECKED BY:

P. Murakami
 PROJECT ENGINEER
 3/2/67
 DATE

APPROVED: *James A. O'Connell*
 DATE 15 Jan 65
 DIRECTOR OF TRANSPORTATION

ORIGINAL PLAN	DATE
DESIGNED BY	
DRAWN BY	
TRACED BY	
QUANTITIES BY	
CHECKED BY	

REPRODUCTION OF DRAWING
 FOR INFORMATION ONLY

SHEET NO. OF SHEETS

SHT. 1