

INDEX TO DRAWINGS	
SHEET NO	DESCRIPTION
1	TITLE SHEET
2	TYPICAL SECTIONS, DETAILS
3-13	PLAN & PROFILE
14-35	CROSS SECTIONS


CONVENTIONAL SIGNS

"AS BUILT" PLANS FOR WIDENING CERTAIN CURVES OF
HALEAKALA ROAD GROUP B
PROJECT NO. A-378-01-66

DISTRICT OF MAKAWAO
ISLAND OF MAUI

SCALES


PLAN 1 IN. = 100 FT.
PROFILE HOR. 1 IN. = FT.
VER. 1 IN. = FT.
X-SECTIONS HOR. 1 IN. = 10 FT.
VER. 1 IN. = 10 FT.

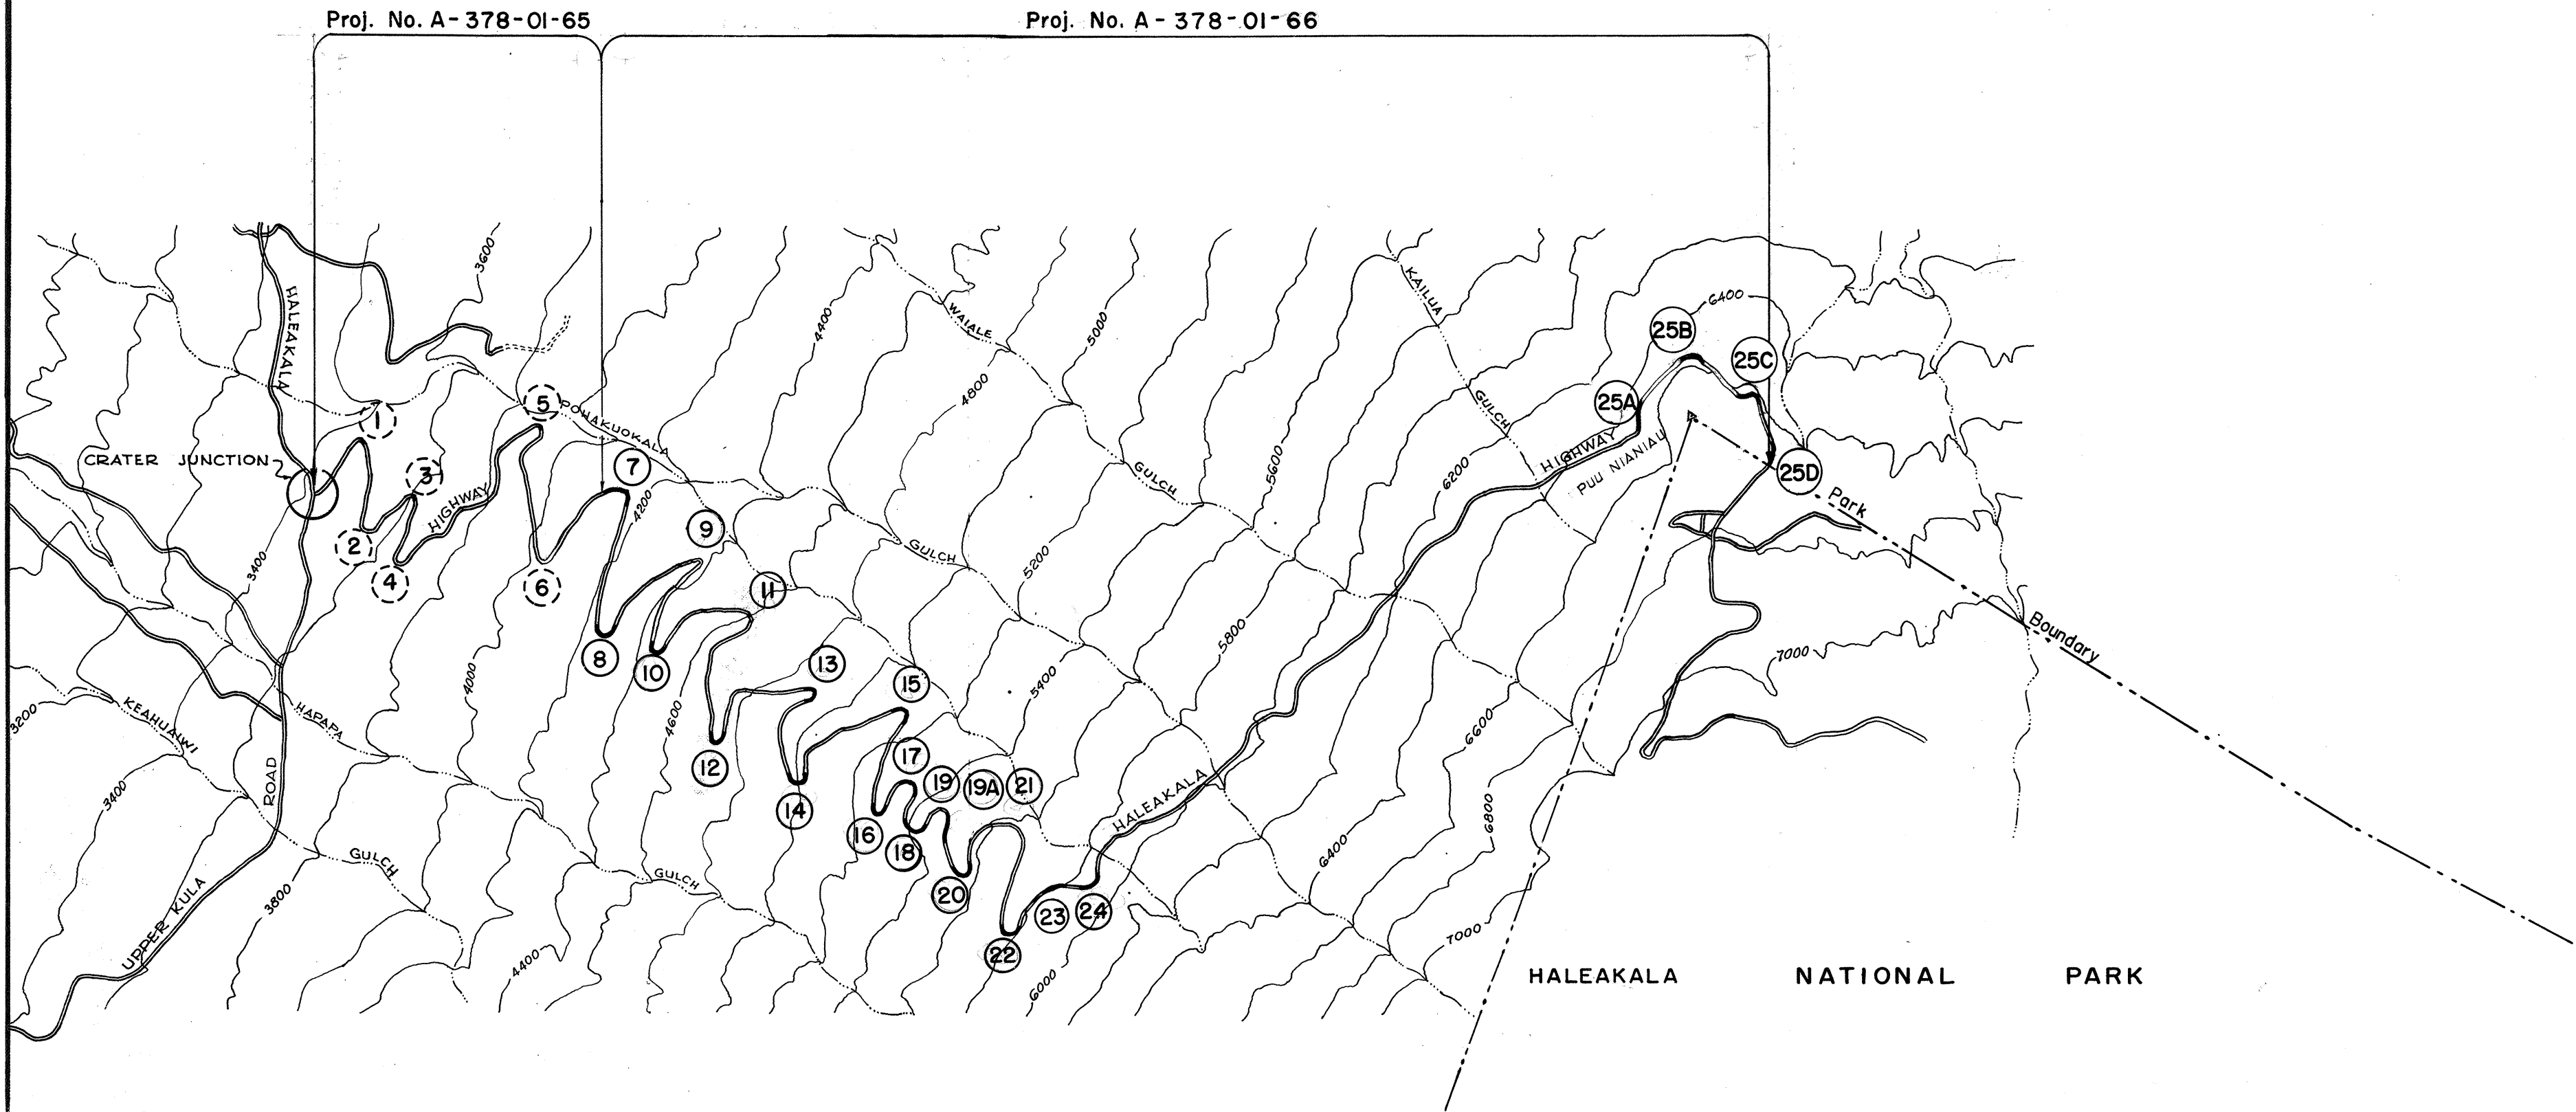

LAYOUT OF PROJECT

LENGTH OF IMPROVEMENTS 2.031 MILES
LENGTH OF PROJECT 7.985 MILES

FED. ROAD DIST. NO.	STATE	PROJ. NO.	FISCAL YEAR	SHEET NO.	TOTAL SHEETS
HAWAII	HAW.	A-378-01-66	1966	1	35

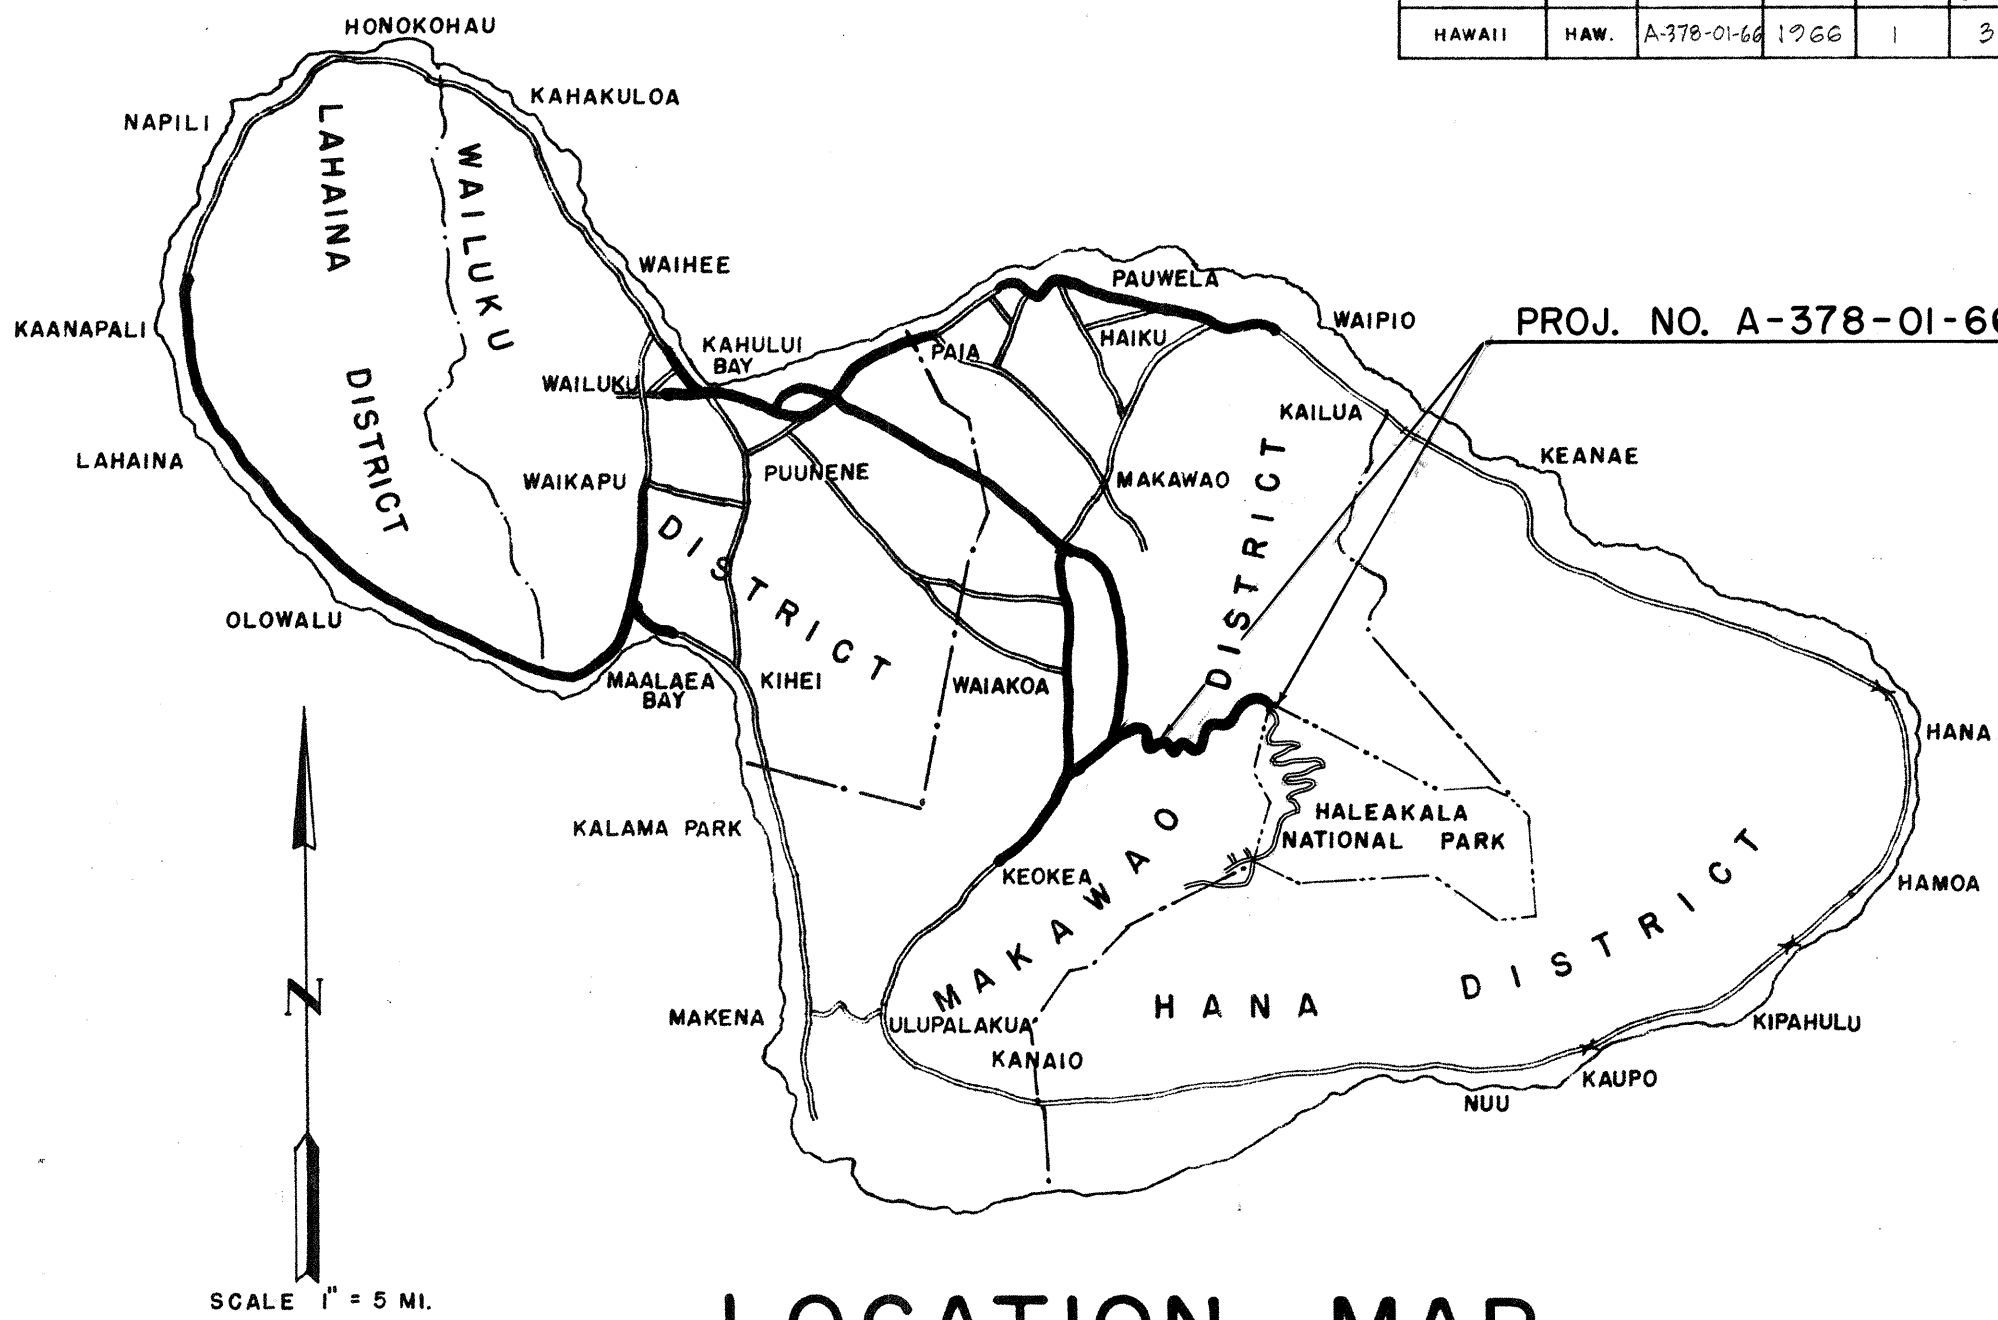

LOCATION MAP

NOTE:

ALL CHANGES MADE DURING CONSTRUCTION
HAVE BEEN NOTED IN RED ON THESE TRACINGS
AND CHECKED BY:

Wataru Kuwada by Stanley S. Hoshi
PROJECT ENGINEER

11-3-67
DATE

APPROVED: DATE 2-11-68
James H. Hester
DIRECTOR OF TRANSPORTATION