


INDEX TO DRAWINGS	
SHEET NO	DESCRIPTION
1	TITLE SHEET
2 - 4	TYPICAL SECTIONS & DETS.
5 & 6+6A	PLANS
7 - 17 19	CROSS SECTIONS


STATE OF HAWAII
DEPARTMENT OF TRANSPORTATION
HIGHWAYS DIVISION
HONOLULU, HAWAII
"AS BUILT"
PLANS OF
HALEAKALA HIGHWAY

KEKAULIKE AVENUE TOWARD HALEAKALA NATIONAL PARK BOUNDARY
PROJECT NO. 378A-02-67
DISTRICT OF MAKAWAO
ISLAND OF MAUI

SCALES	
PLAN	1 IN. = 100 FT.
PROFILE	HOR. 1 IN. = — FT.
	VER. 1 IN. = — FT.
X-SECTIONS	HOR. 1 IN. = 10 FT.
	VER. 1 IN. = 10 FT.

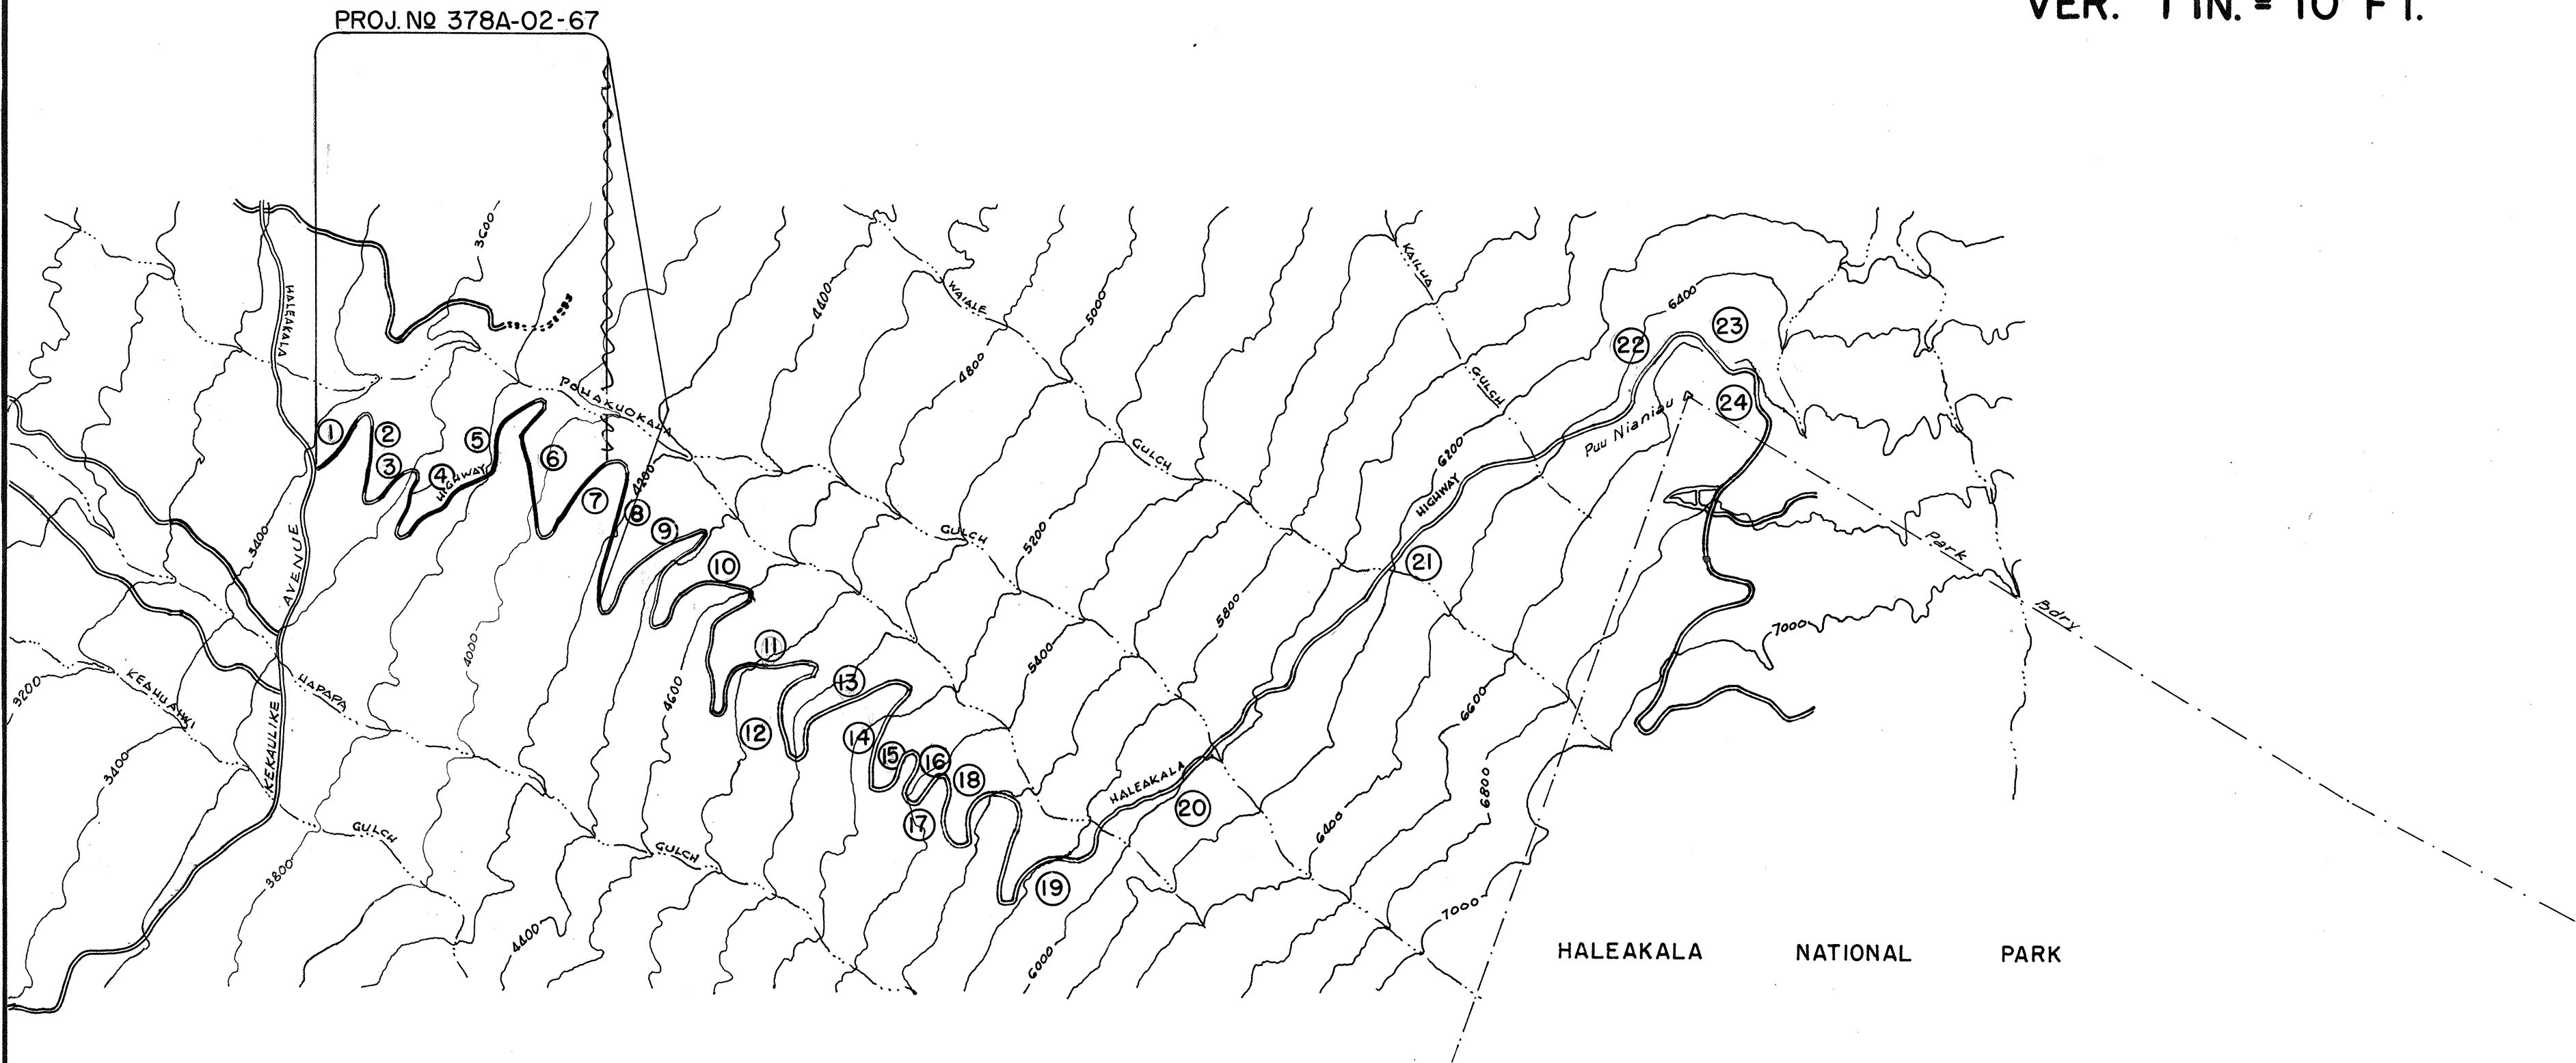

LAYOUT OF PROJECT	
LENGTH OF PROJECT	2.732 MILES
LENGTH OF IMPROVEMENTS	2.322 MILES
	1.902 MILES

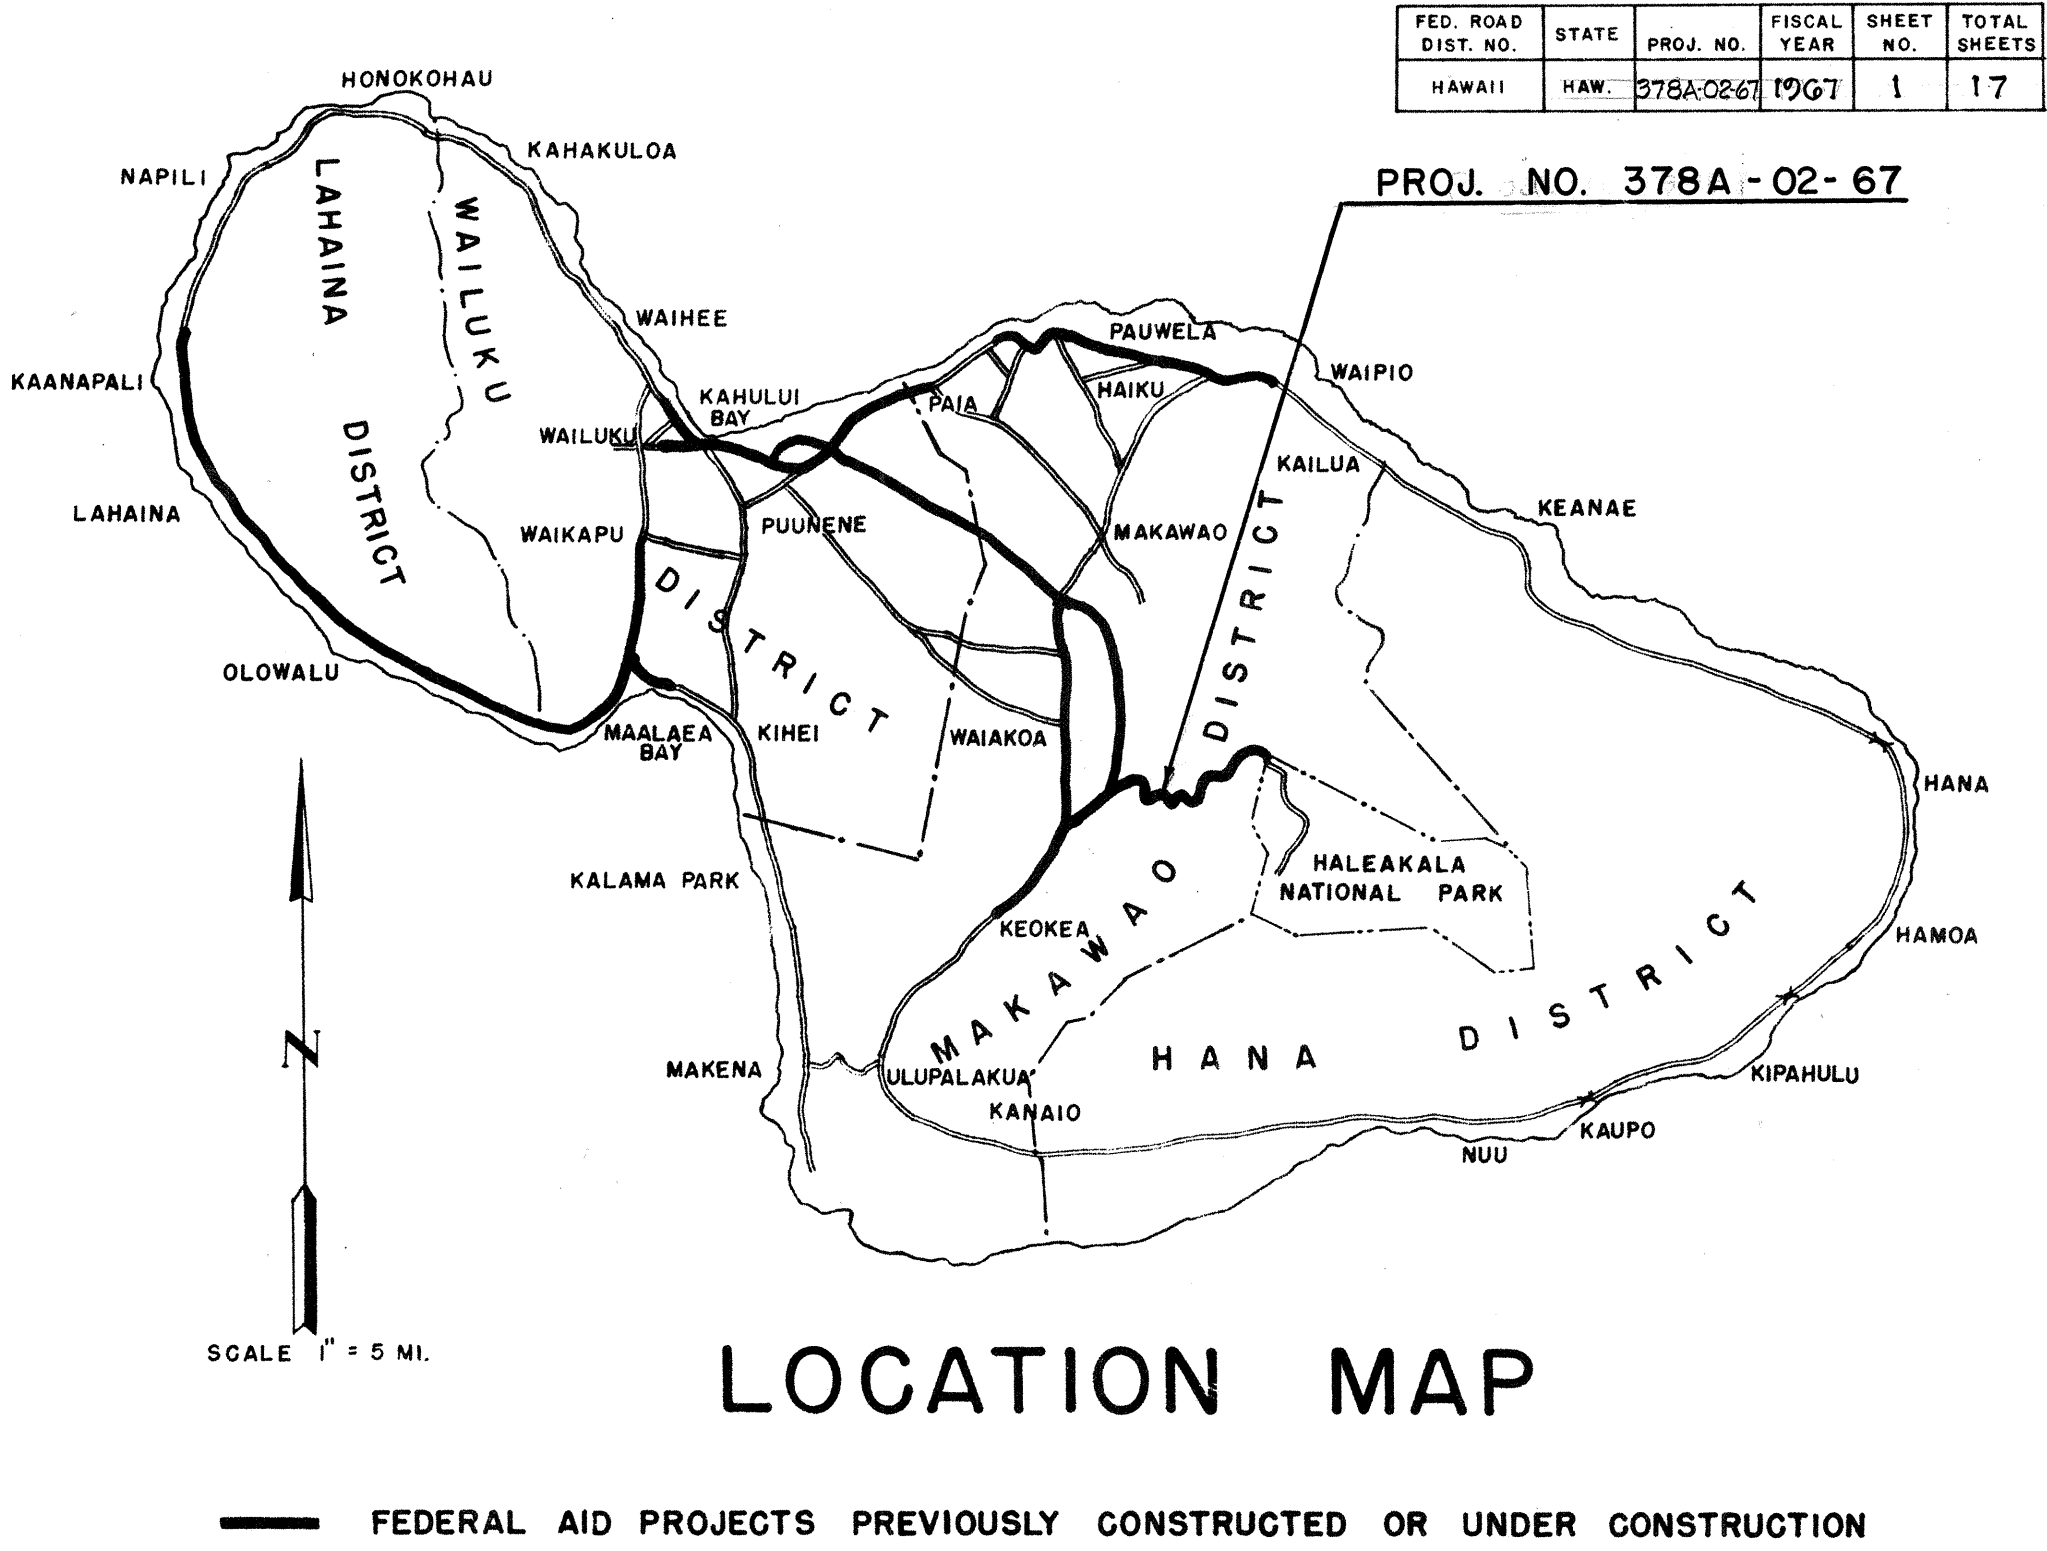

NOTE:
ALL CHANGES MADE DURING CONSTRUCTION HAVE BEEN NOTED IN RED ON THESE TRACINGS AND CHECKED BY:

Harmon Lineberry

PROJECT ENGINEER

7-10-68

DATE

APPROVED:

DATE 3-10-67

John M. Sun

DIRECTOR OF TRANSPORTATION