


INDEX TO DRAWINGS	
SHEET NO	DESCRIPTION
1	TITLE SHEET
2	TYPICAL SECTION & DETAILS
3 - 5	PLANS
6 - 18	CROSS SECTIONS

STATE OF HAWAII
DEPARTMENT OF TRANSPORTATION
HIGHWAYS DIVISION
HONOLULU, HAWAII
"AS BUILT"
PLANS FOR WIDENING CERTAIN PORTIONS OF
HALEAKALA HIGHWAY
KEKAULIKE HIGHWAY TOWARD HALEAKALA NATIONAL PARK BOUNDARY
PROJECT NO. 378A-04-69
DISTRICT OF MAKAWAO
ISLAND OF MAUI

CONVENTIONAL SIGNS

TRUE NORTH
SCALE 1"=2000'

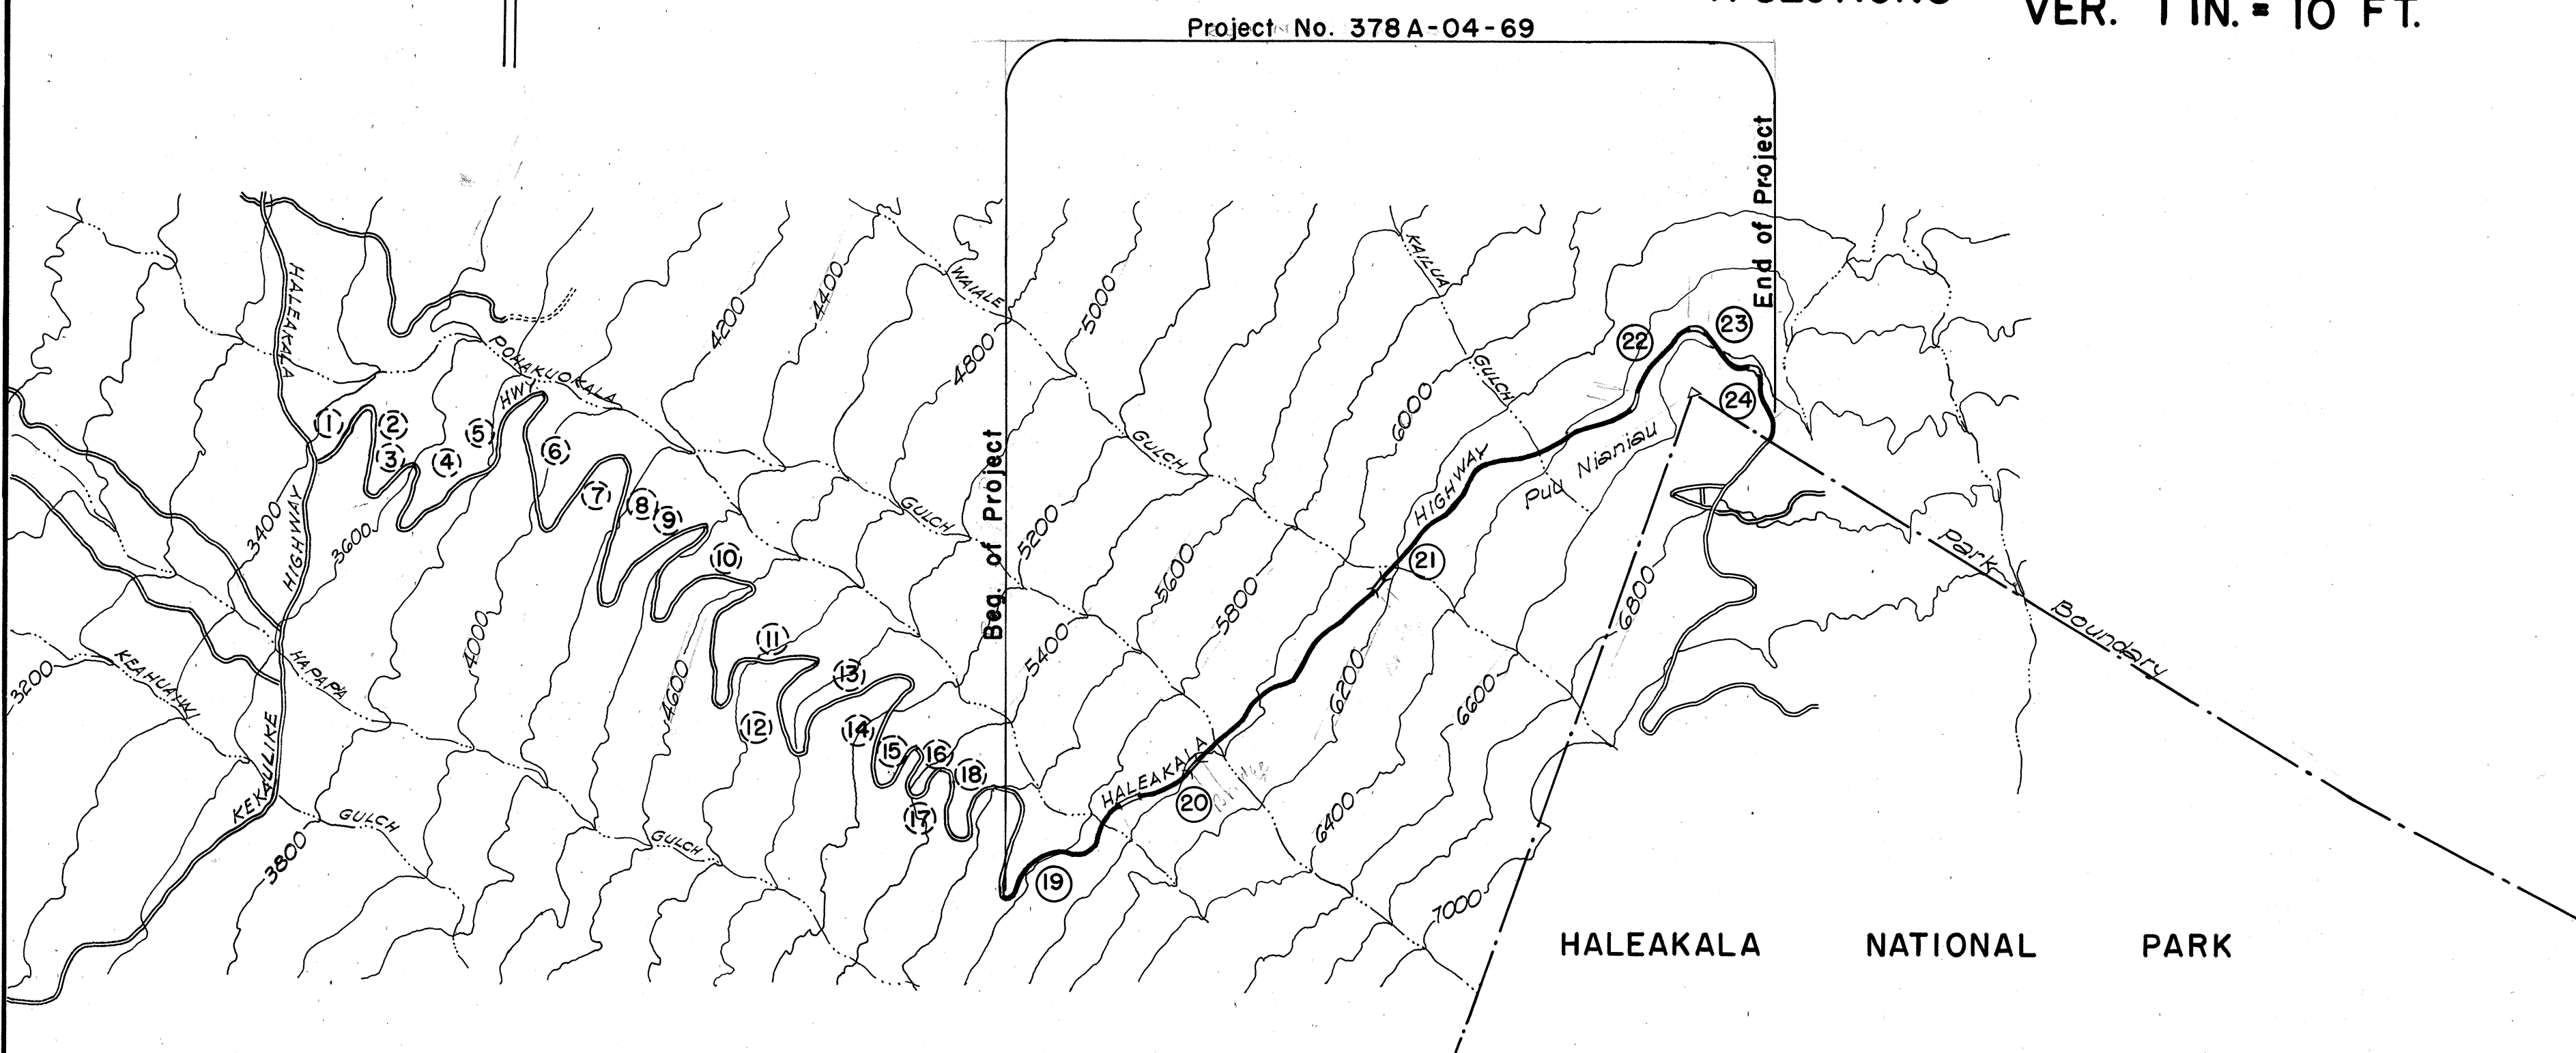


LAYOUT OF PROJECT

GROSS LENGTH OF PROJECT	3.328	MILES
BRIDGES OVER 20 FEET SPAN	0.020	MILES
EXCEPTIONS	0.453	MILES
NET LENGTH OF ROADWAY	2.855	MILES

SCALES

PLAN	1 IN. = 100 FT.
PROFILE	HOR. 1 IN. = — FT.
	VER. 1 IN. = — FT.
X-SECTIONS	HOR. 1 IN. = 10 FT.
	VER. 1 IN. = 10 FT.

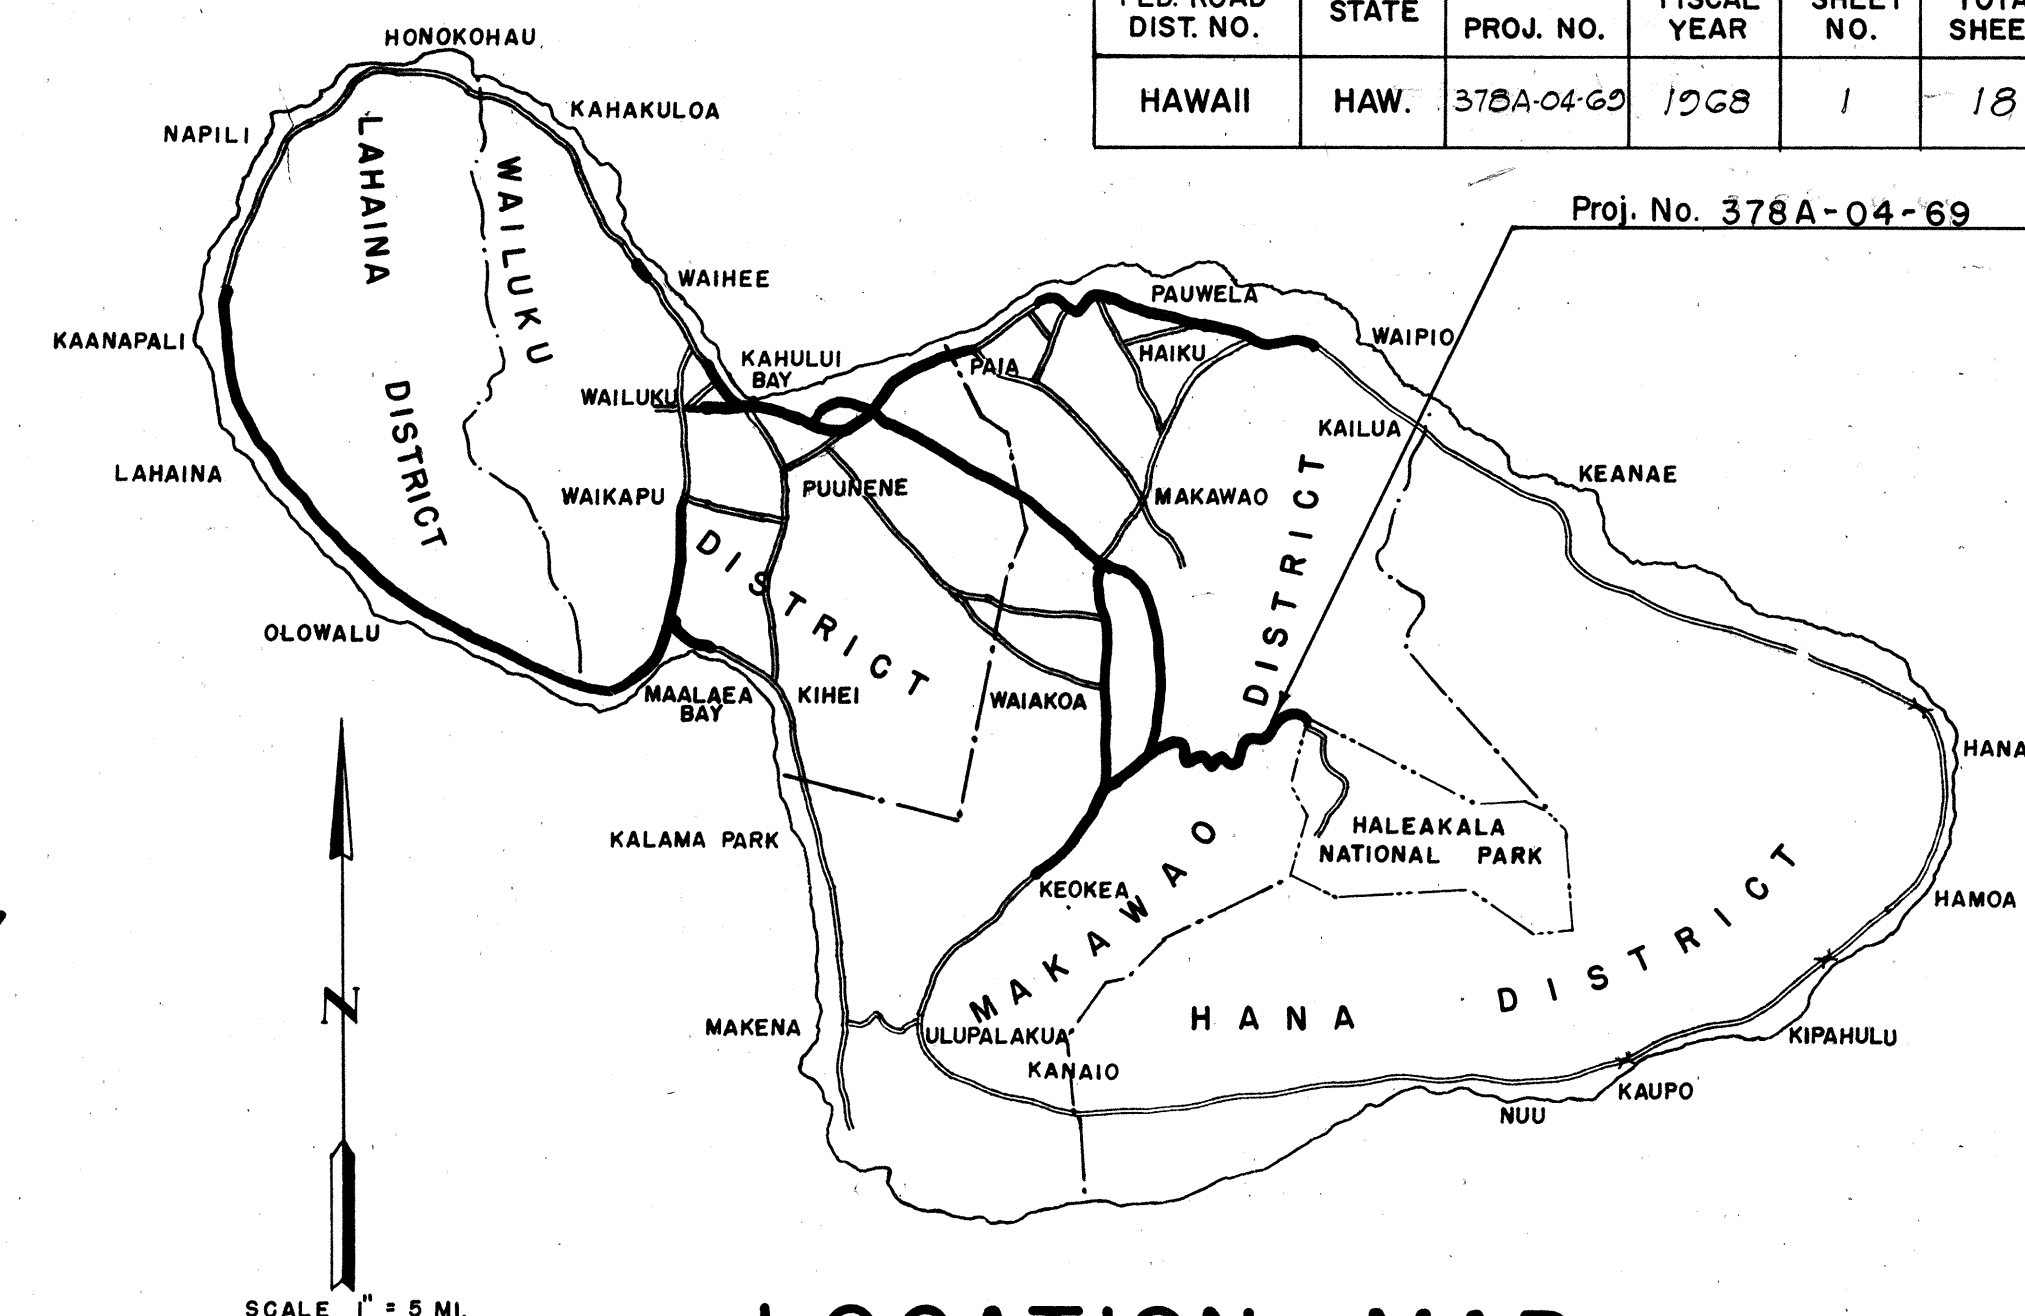

LOCATION MAP

— FEDERAL AID PROJECTS PREVIOUSLY CONSTRUCTED OR UNDER CONSTRUCTION

NOTE:
ALL CHANGES MADE DURING CONSTRUCTION
HAVE BEEN NOTED IN RED ON THESE TRACINGS
AND CHECKED BY:

Manuel J. Lihn
PROJECT ENGINEER
JAN. 5, 1973
DATE

DEPARTMENT OF TRANSPORTATION
STATE OF HAWAII
APPROVED:
E. Alvey Wright 9/2/69
DIRECTOR OF TRANSPORTATION DATE