


FED. ROAD DIST. NO.	STATE	PROJ. NO.	FISCAL YEAR	SHEET NO.	TOTAL SHEETS
HAWAII	HAW.	378A-05-70	1970	3	11

NOTE:
See Summary Sheet
for Scope of Work for
Improvements Shown
on this Sheet

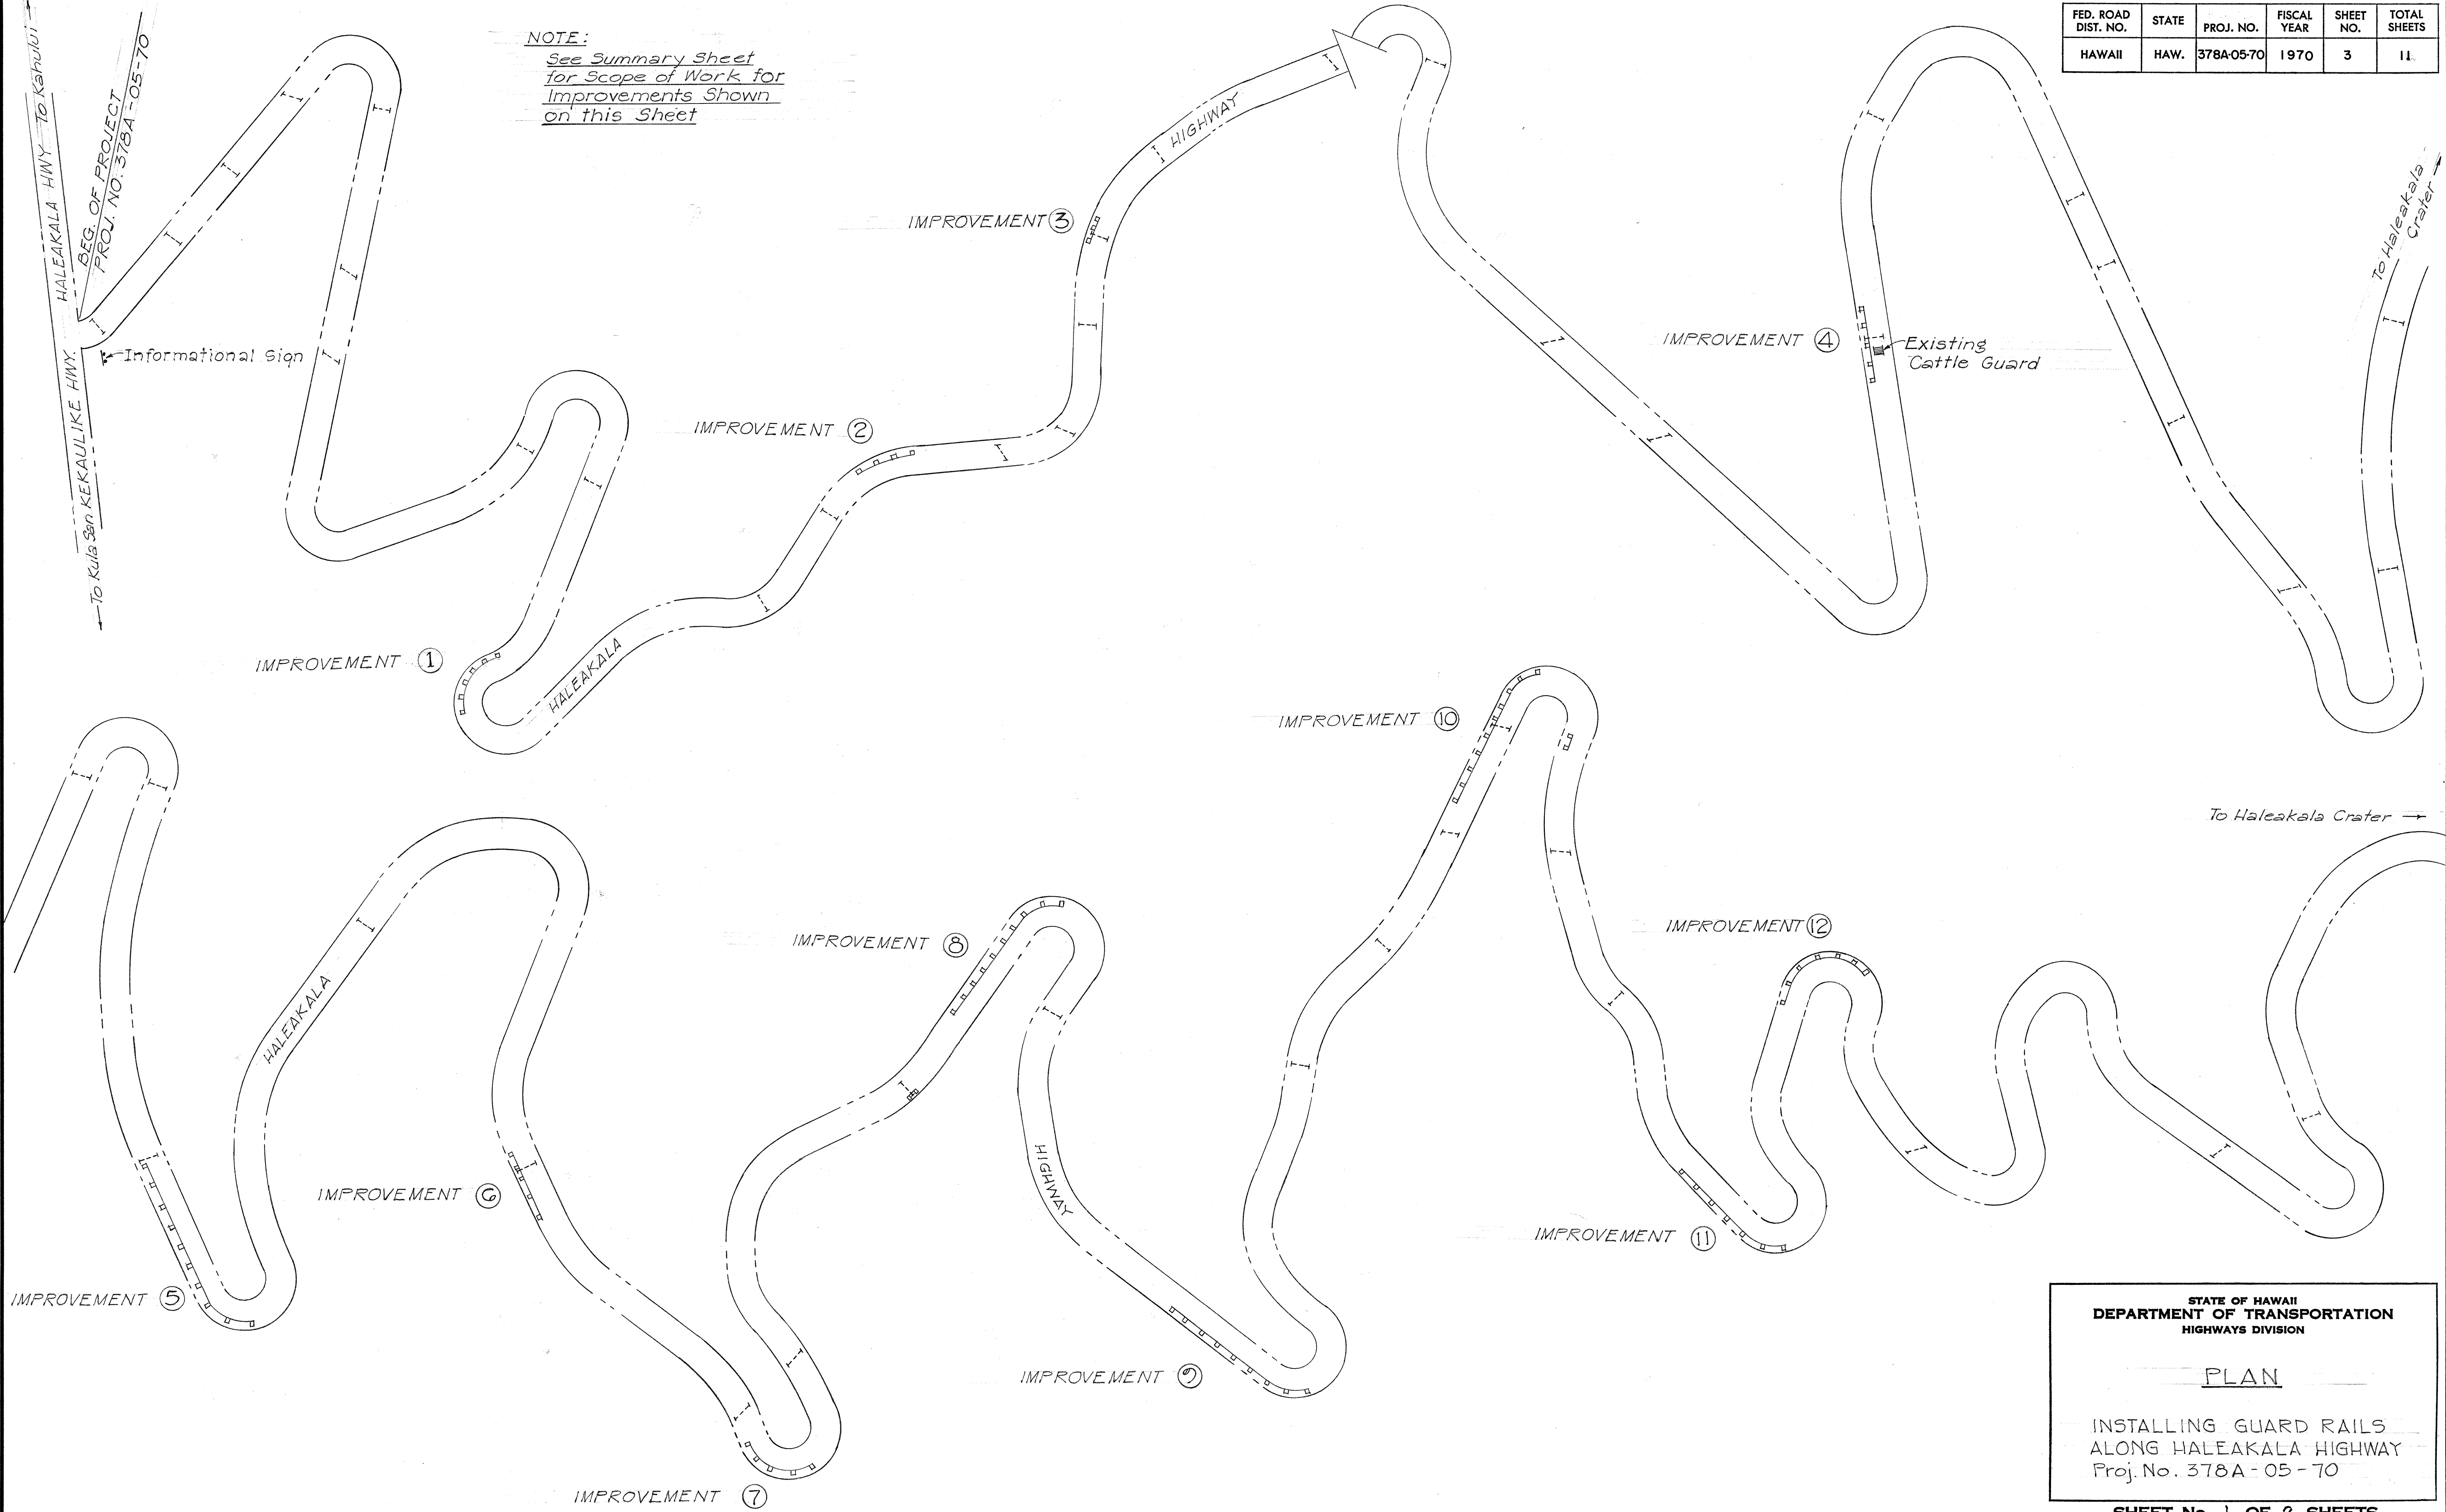

ORIGINAL PLAN	DATE
SURVEY PLOTTED BY	
DRAWN BY	
DESIGNED BY	
CHECKED BY	
NOTE BOOK	
No.	

STATE OF HAWAII
DEPARTMENT OF TRANSPORTATION
HIGHWAYS DIVISION


PLAN

INSTALLING GUARD RAILS
ALONG HALEAKALA HIGHWAY
Proj. No. 378A-05-70

SHEET No. 1 OF 2 SHEETS

FED. ROAD DIST. NO.	STATE	PROJ. NO.	FISCAL YEAR	SHEET NO.	TOTAL SHEETS
HAWAII	HAW.	378A-05-70	1970	4	11

NOTE :
In the event the Scope of Work is increased, existing guard rails shown on this sheet shall be removed and Type 3 Beam Type Guard Rail shall be installed. The increased amount shall be determined in accordance with Section 104 - Scope of Work of the Special Provisions.

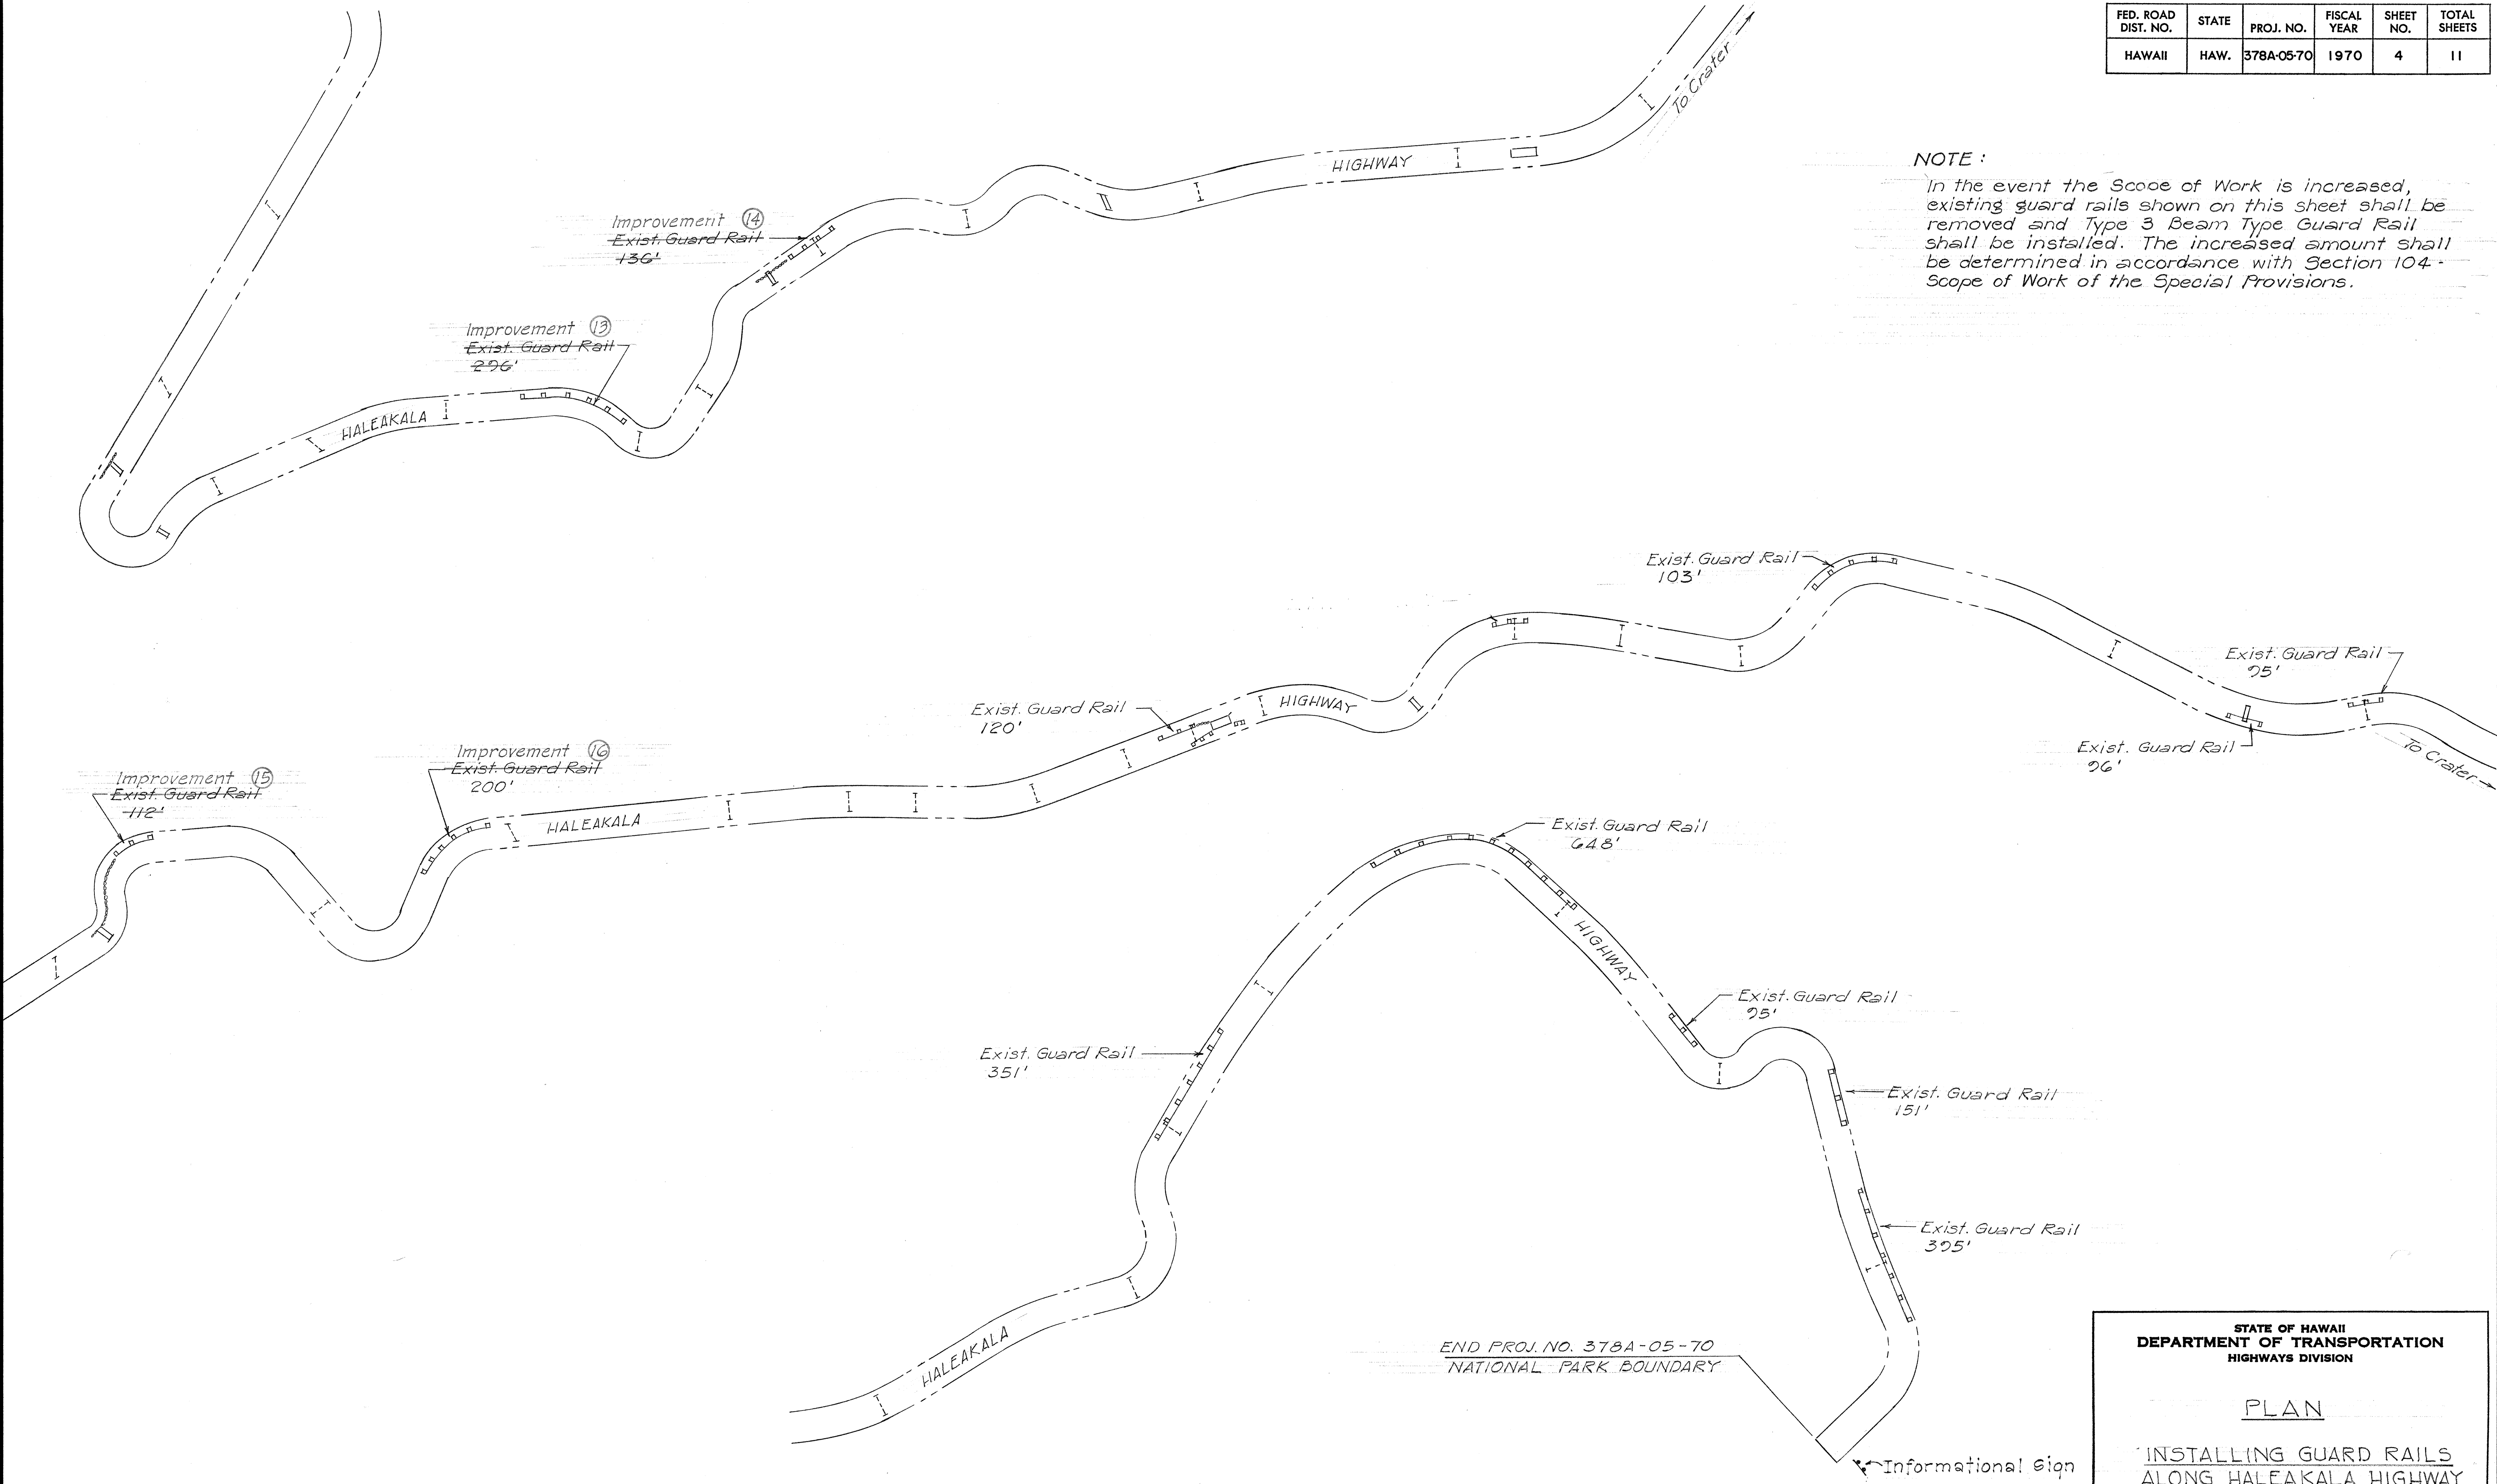

SURVEY PLOTTED BY	DATE
DRAWN BY	
DESIGNED BY	
CHECKED BY	
ORIGINAL PLAN	
NOTE BOOK	No.

STATE OF HAWAII
DEPARTMENT OF TRANSPORTATION
HIGHWAYS DIVISION

PLAN
INSTALLING GUARD RAILS
ALONG HALEAKALA HIGHWAY
Proj. No. 378A-05-70

SHEET No. 2 OF 2 SHEETS