

INDEX TO DRAWINGS	
SHEET NO	DESCRIPTION
1	TITLE SHEET
2	TYPICAL GUARD RAIL DETAIL AND SUMMARY
3-4	PLAN
5-10	METAL GUARD RAIL STANDARD
11	PROJECT INFORMATION SIGN

STATE OF HAWAII

DEPARTMENT OF TRANSPORTATION

HIGHWAYS DIVISION

HONOLULU, HAWAII

AS BUILT

PLANS FOR INSTALLING GUARD RAILS ALONG



HALEAKALA HIGHWAY

KEKAULIKE AVENUE TO HALEAKALA NATIONAL PARK BOUNDARY

PROJECT NO. 378 A -05-70

DISTRICT OF MAKAWAO

ISLAND OF MAUI

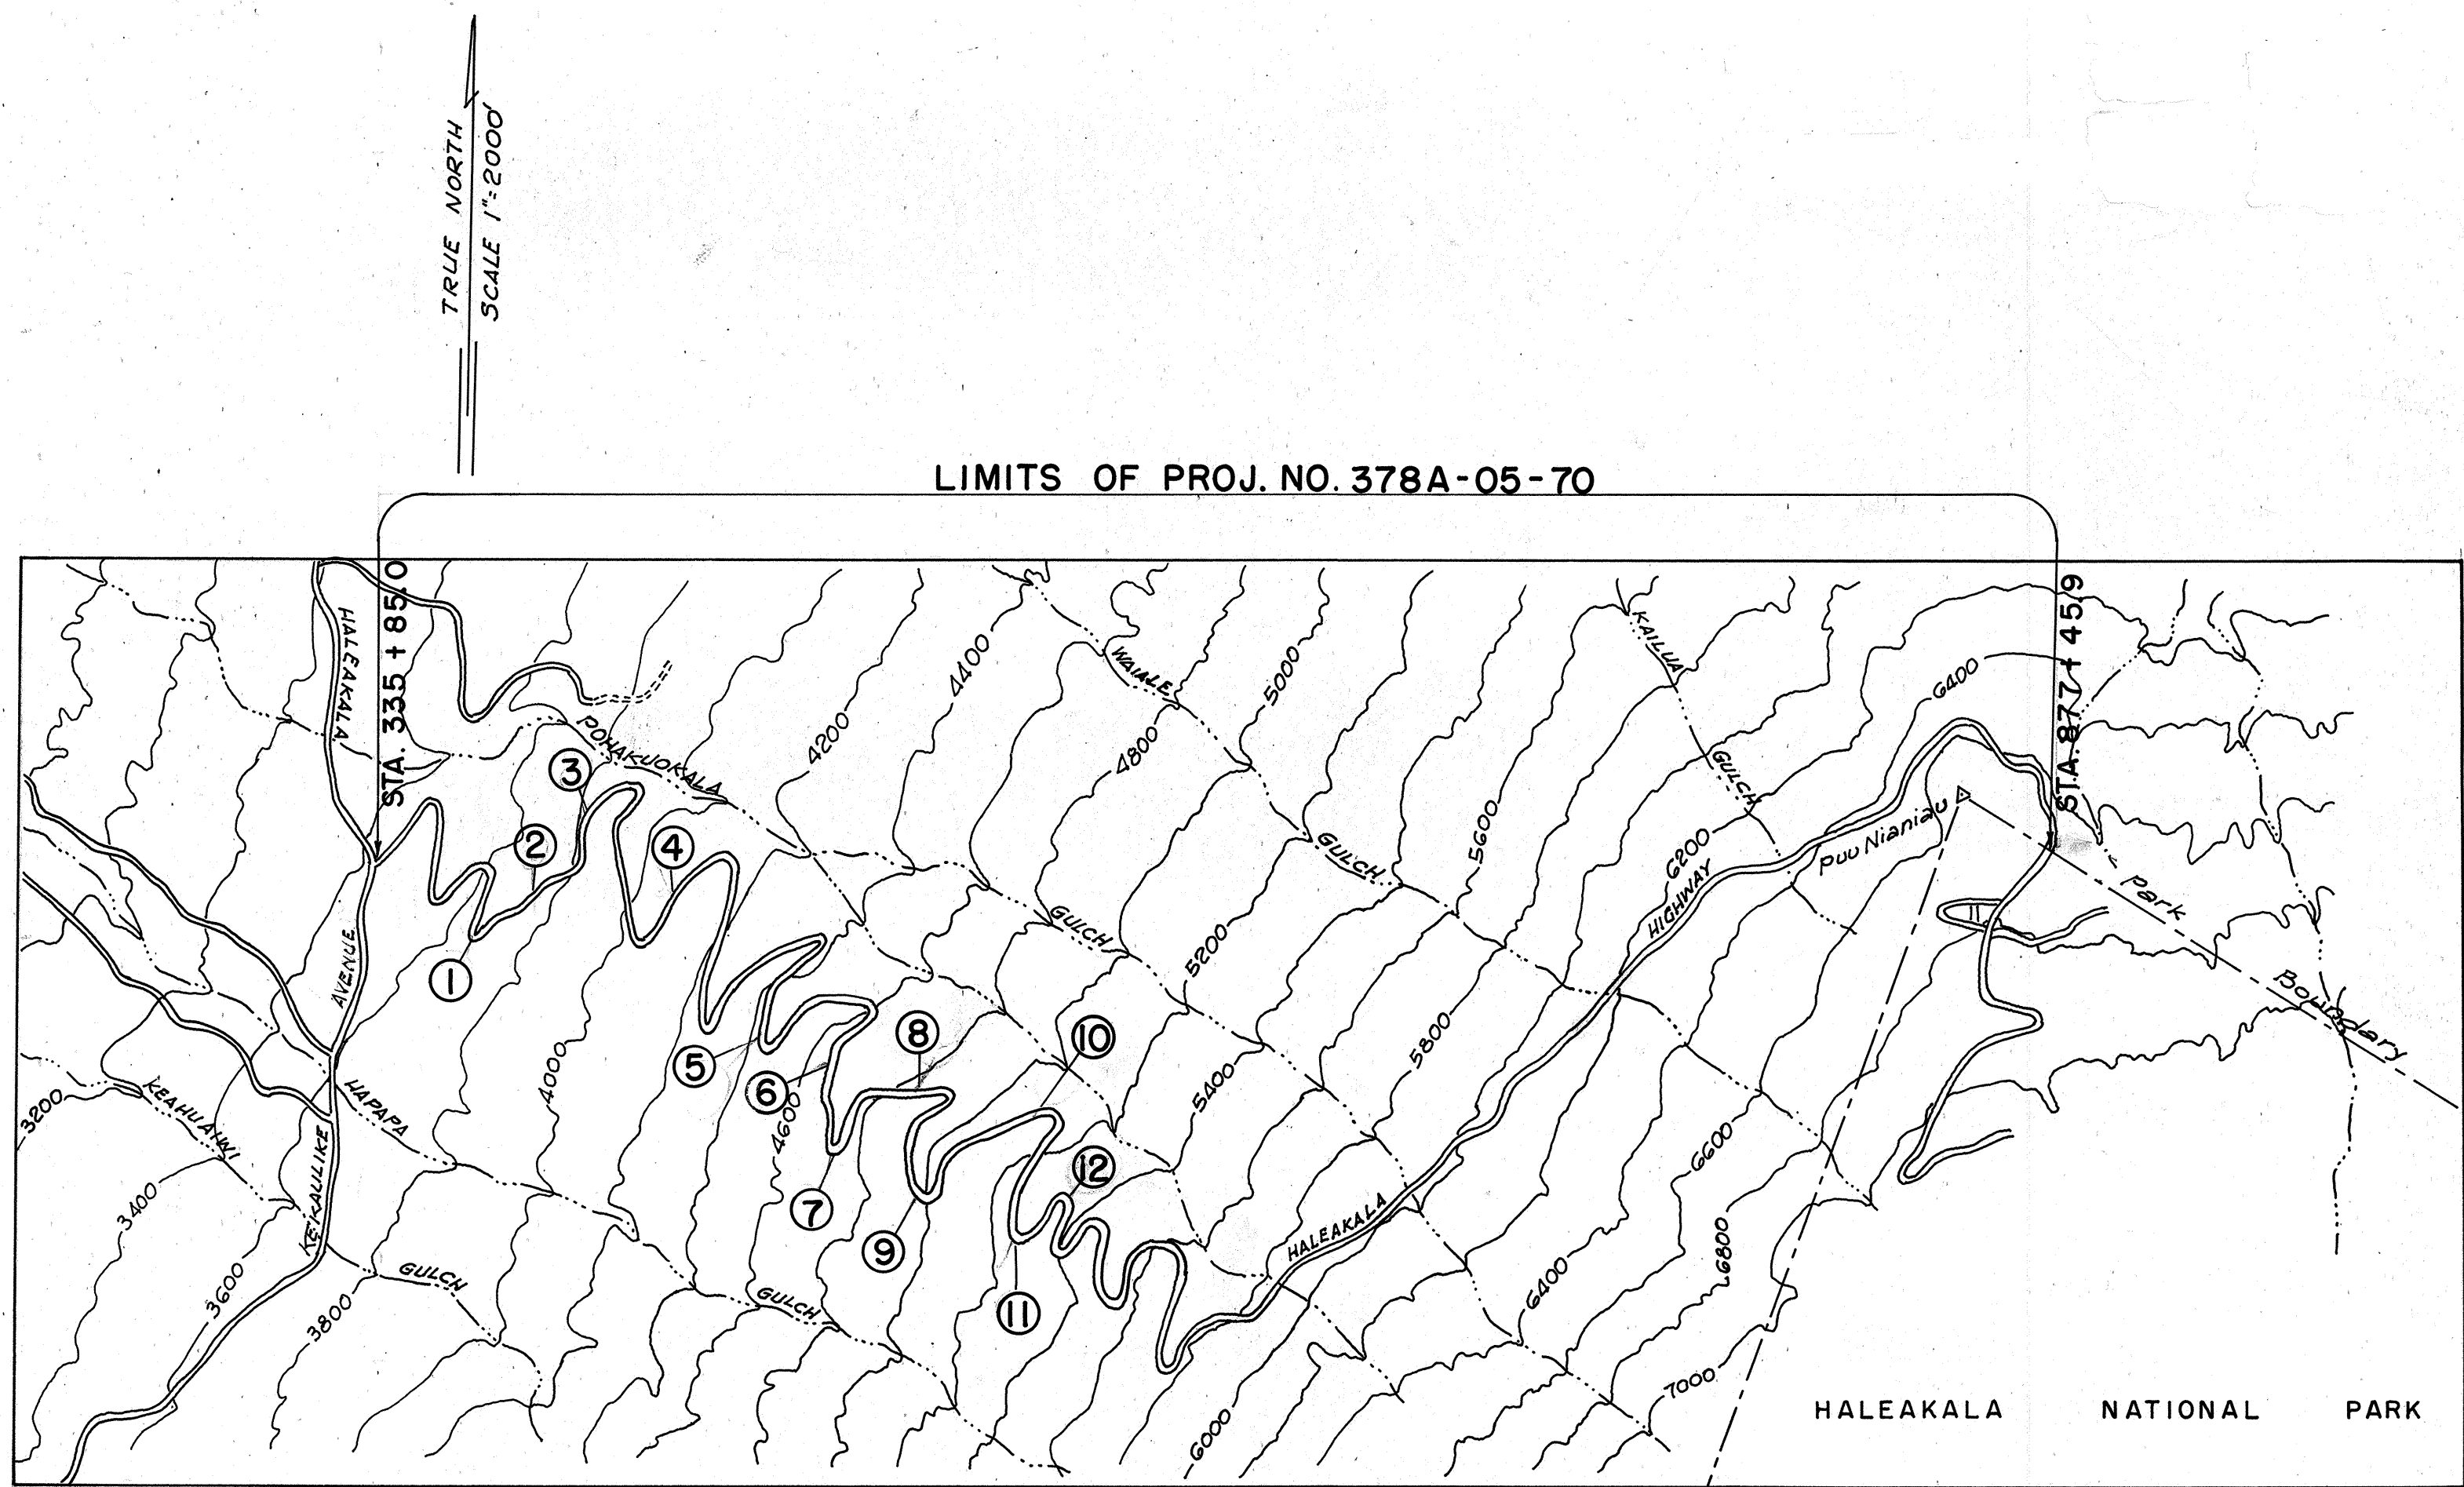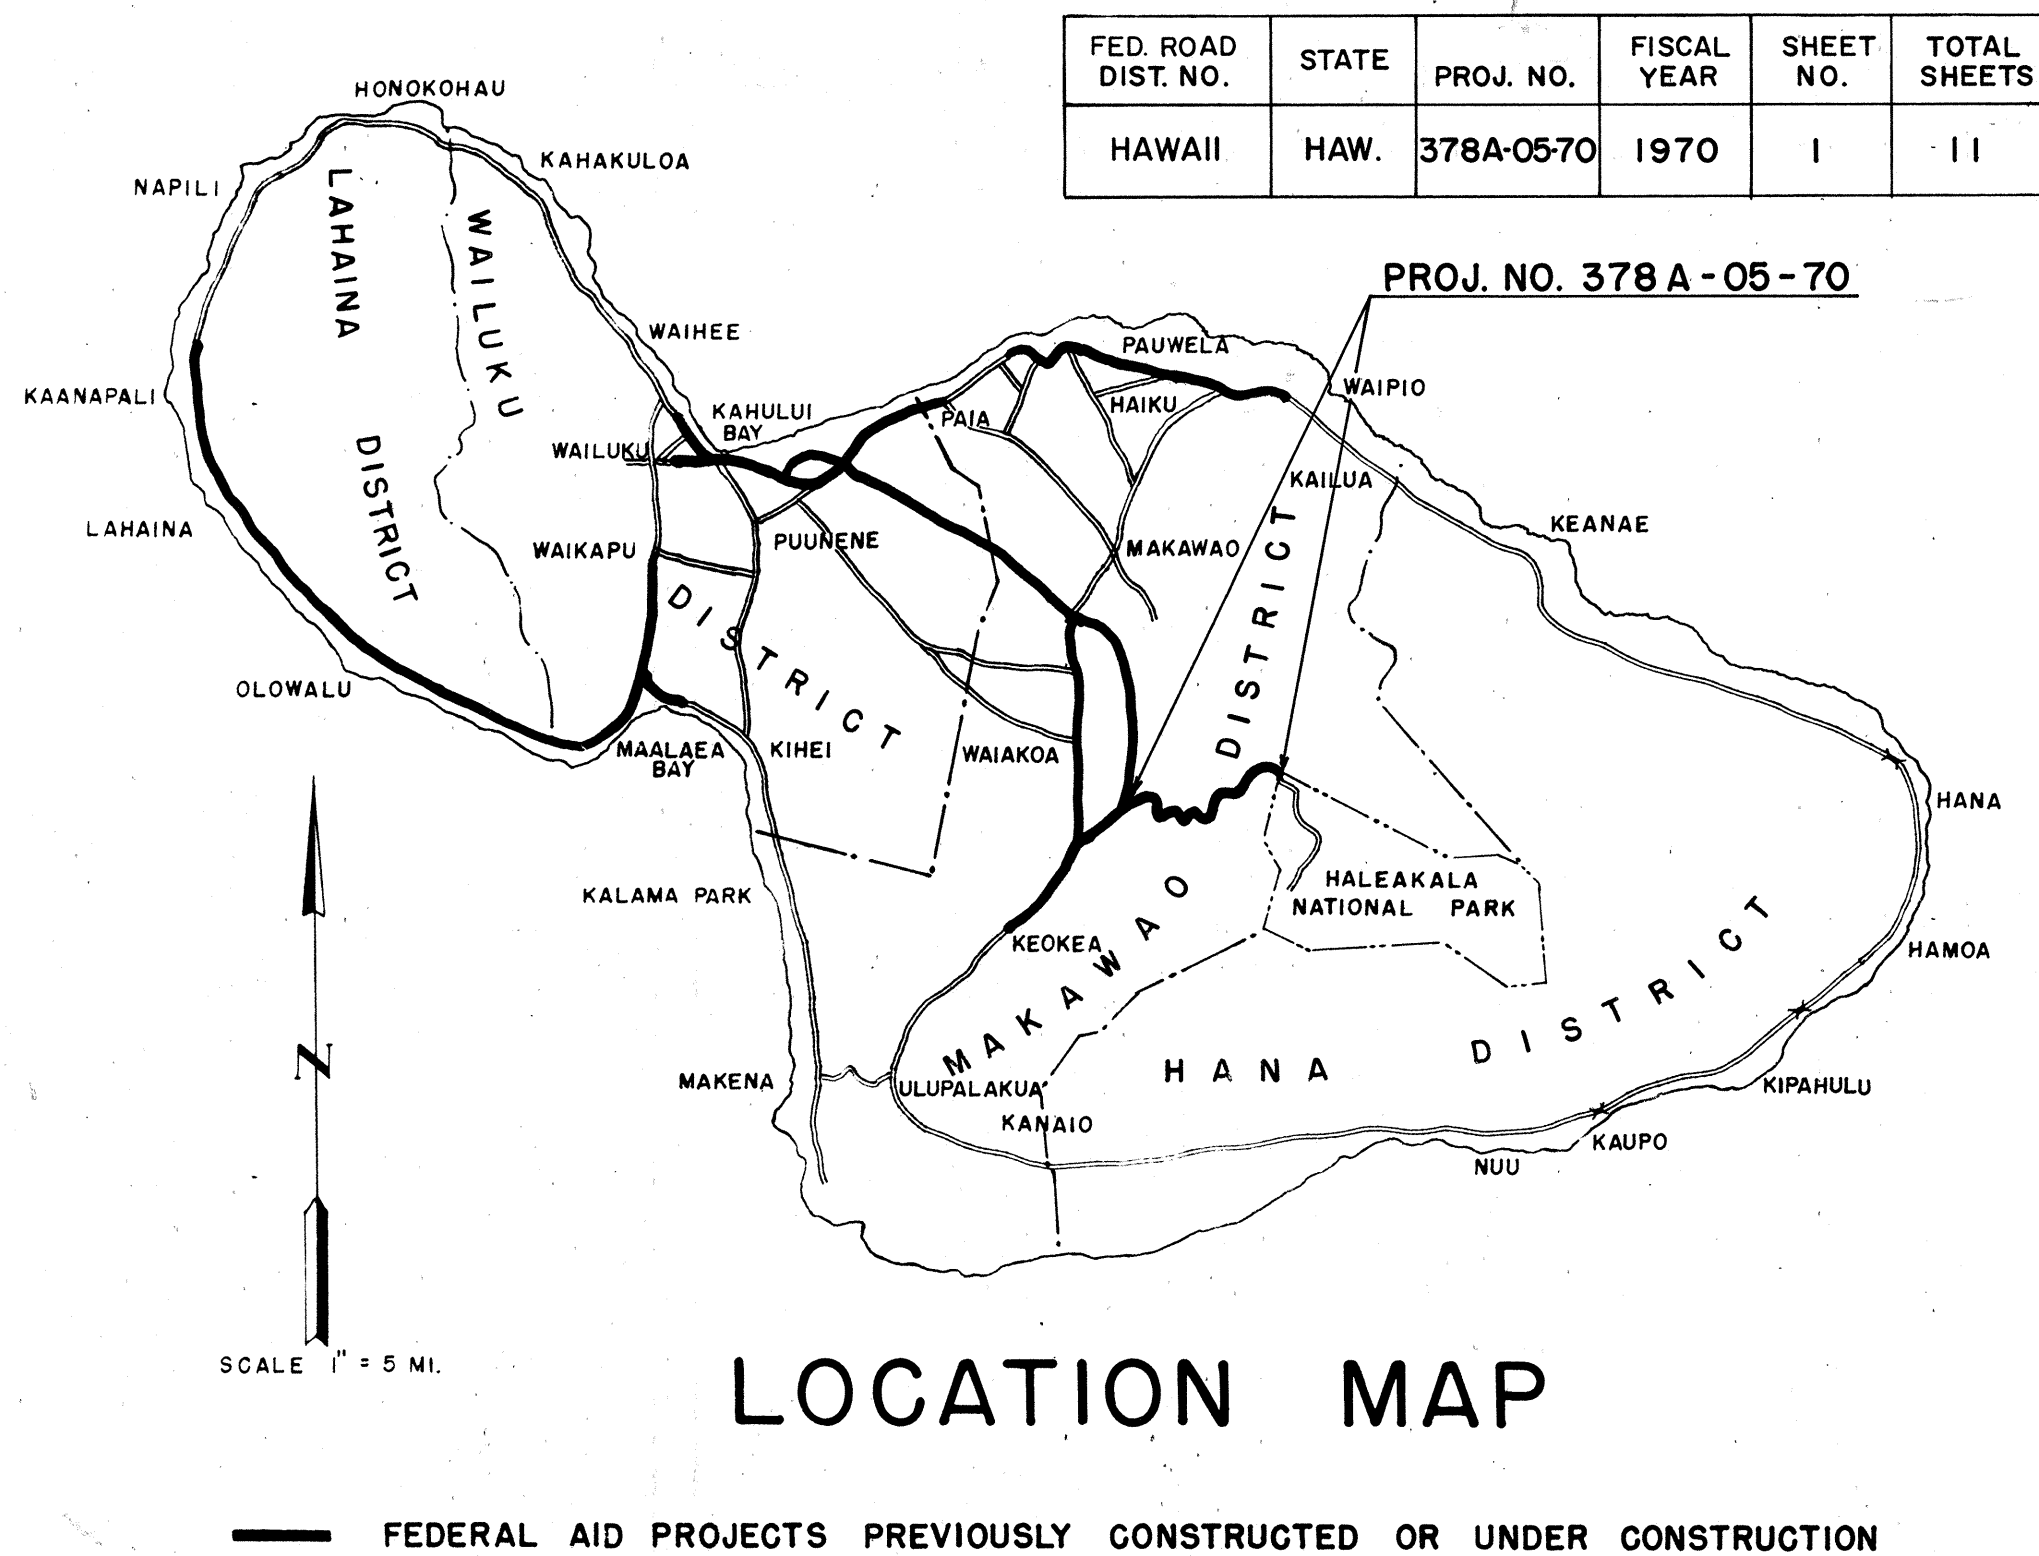

① INDICATES APPROXIMATE LOCATION OF IMPROVEMENTS

LAYOUT OF PROJECT

LENGTH OF IMPROVEMENT = 0.862 Miles

LENGTH OF PROJECT = 10.213 Miles

NOTE:
ALL CHANGES MADE DURING CONSTRUCTION
HAVE BEEN NOTED IN RED ON THESE TRACINGS
AND CHECKED BY:

Stanley J. Sato
PROJECT ENGINEER

11/19/71
DATE

DEPARTMENT OF TRANSPORTATION STATE OF HAWAII	
APPROVED:	
<i>E. Alvey H. H. H.</i>	3/9/70
DIRECTOR OF TRANSPORTATION	DATE

DESIGNED BY: MAUI DISTRICT OFFICE
STATE HIGHWAYS DIVISION
DATE: FEB. 1970

D. BEVIER MAR. 1970