


FED. ROAD DIST. NO.	STATE	PROJ. NO.	FISCAL YEAR	SHEET NO.	TOTAL SHEETS
HAWAII	HAW.	HWY-M-02-72	1972	4	12

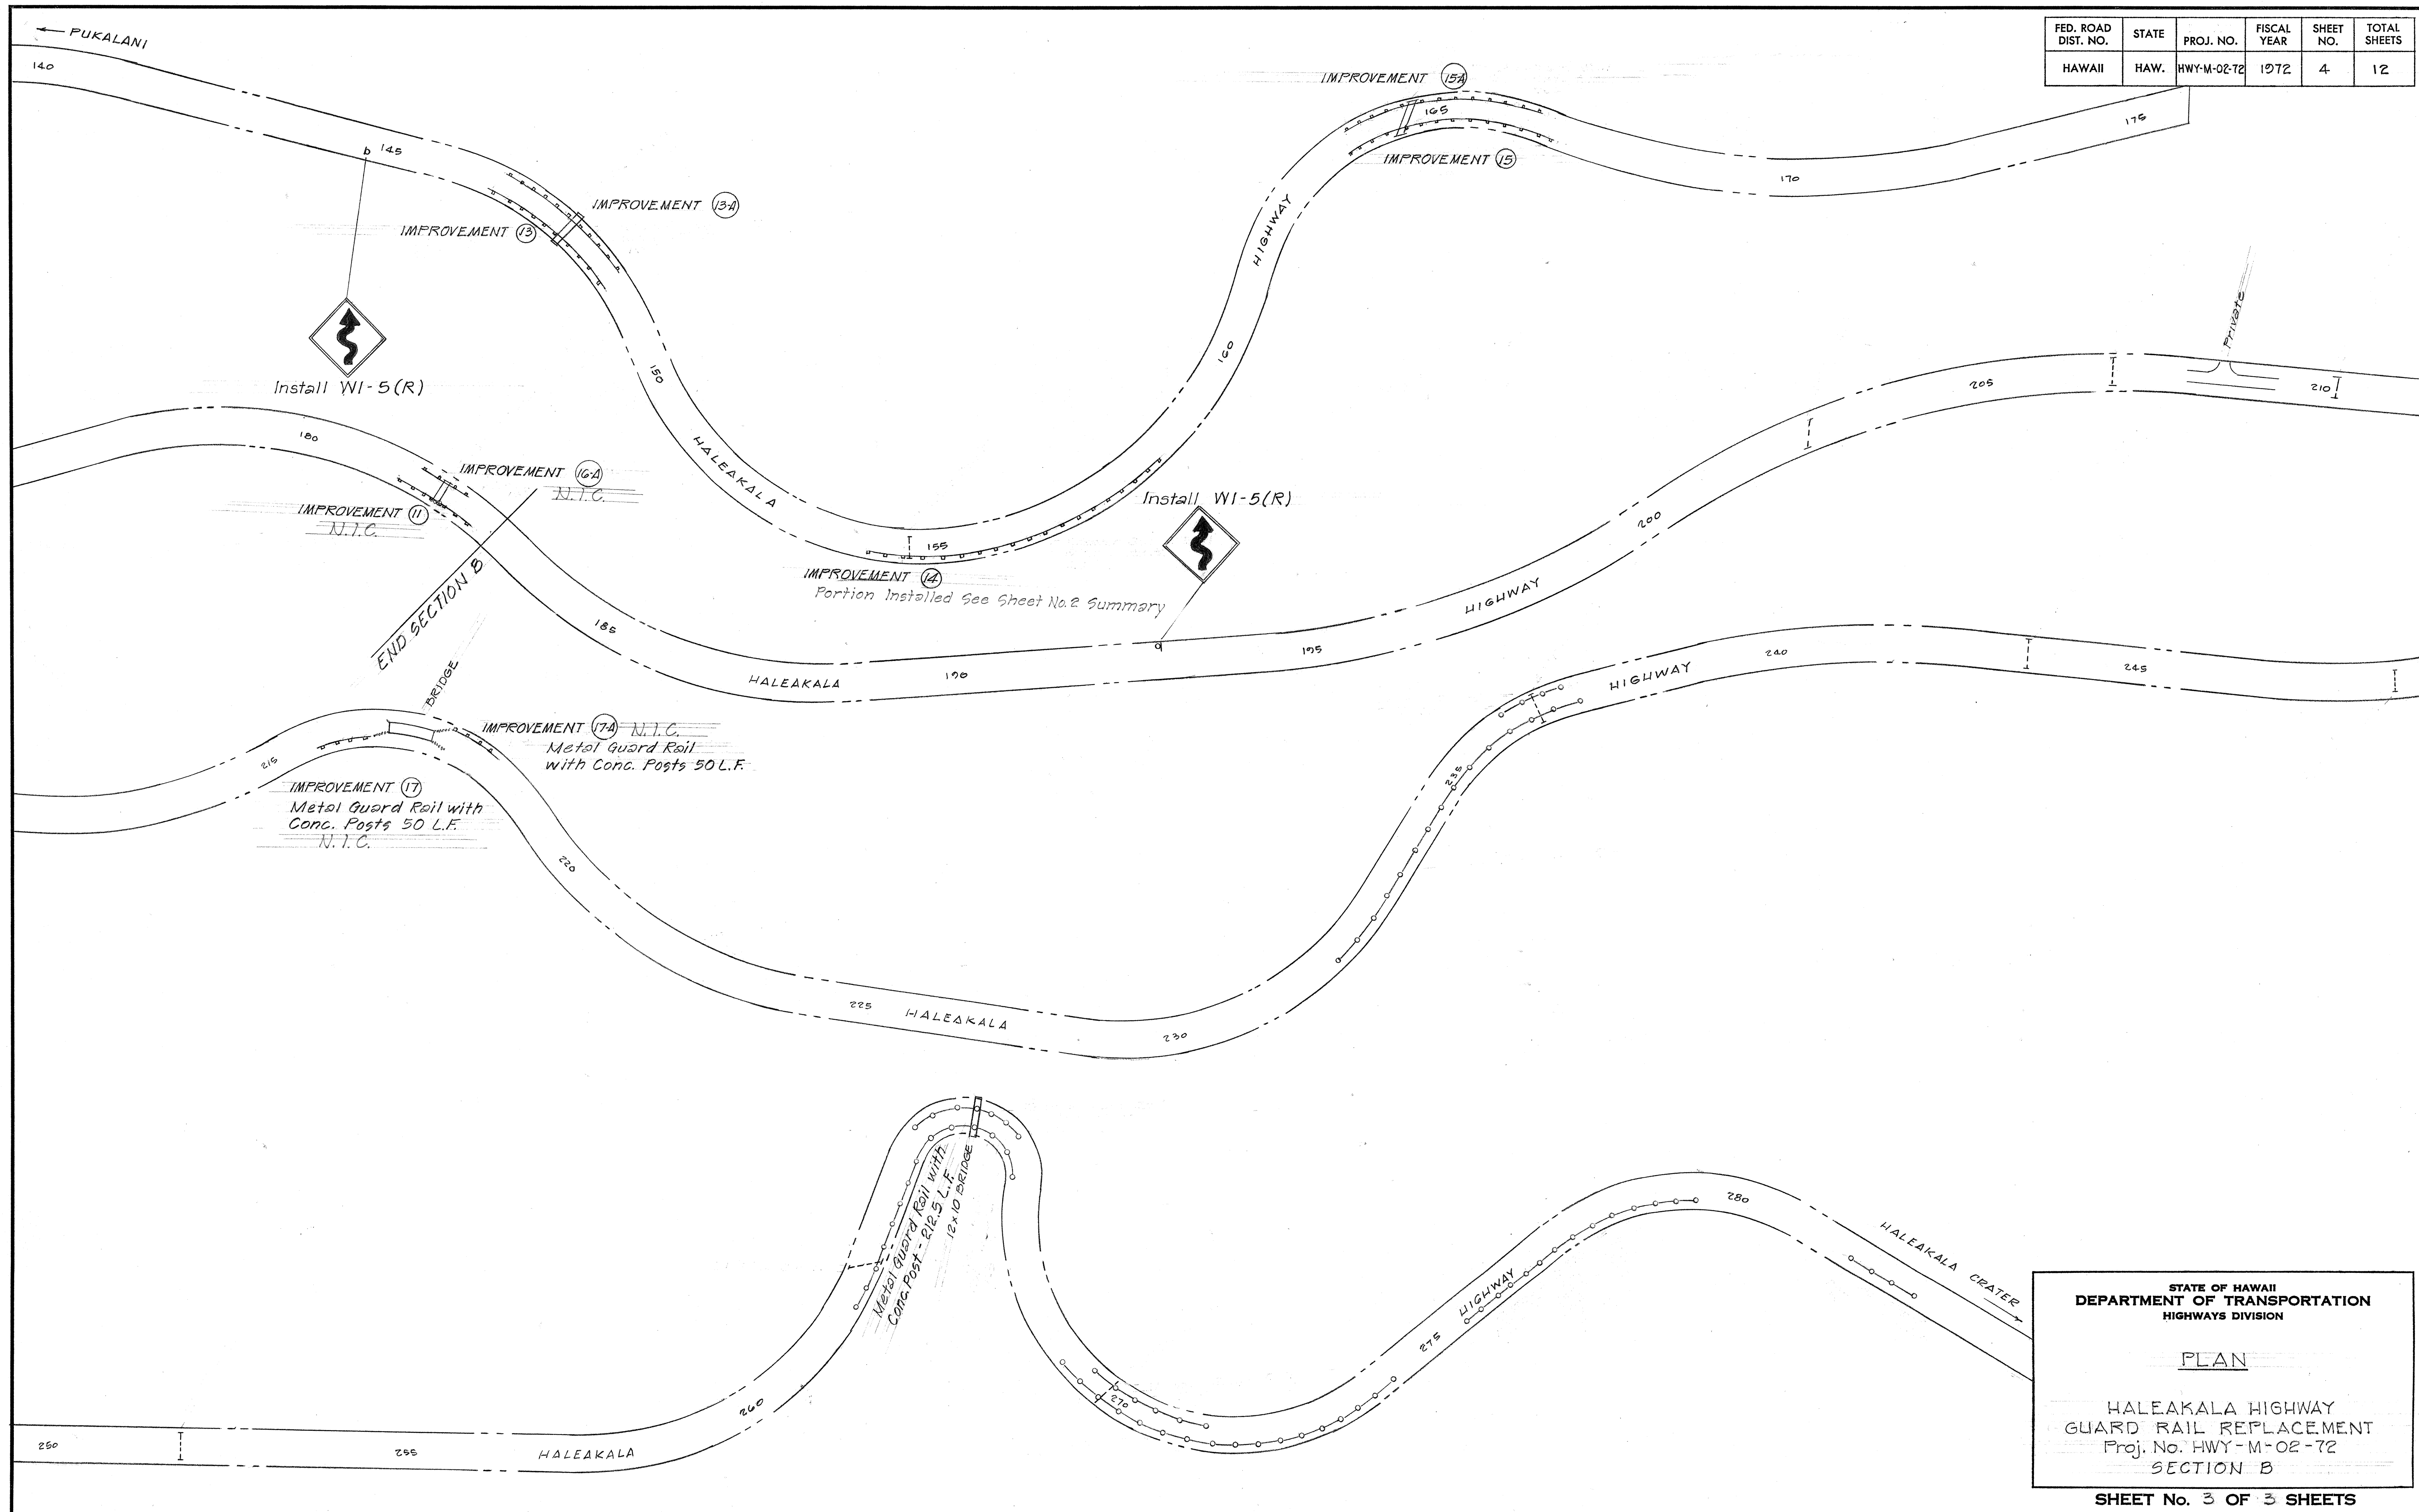

ORIGINAL	SURVEY PLOTTED BY	DATE
PLAN	DRAWN BY	"
	TRACED BY	"
NOTE BOOK	DESIGNED BY	"
	QUANTITIES BY	"
No.	CHECKED BY	"

STATE OF HAWAII
DEPARTMENT OF TRANSPORTATION
HIGHWAYS DIVISION

PLAN

HALEAKALA HIGHWAY
GUARD RAIL REPLACEMENT
Proj. No. HWY-M-02-72
SECTION B

SHEET No. 3 OF 3 SHEETS