

INDEX TO DRAWINGS	
SHEET NO	DESCRIPTION
1	TITLE SHEET
2	PLAN, TYP. SECTION, SUMMARY
3 & 4	PLAN
5-12	STD. DETAILS


STATE OF HAWAII
DEPARTMENT OF TRANSPORTATION
HIGHWAYS DIVISION
HONOLULU, HAWAII

"AS-BUILT" PLANS OF
HALEAKALA HIGHWAY
GUARD RAIL REPLACEMENTS

PROJ. NO. HWY-M-02-72

PLAN

SCALES
1 IN. = 100 FT.

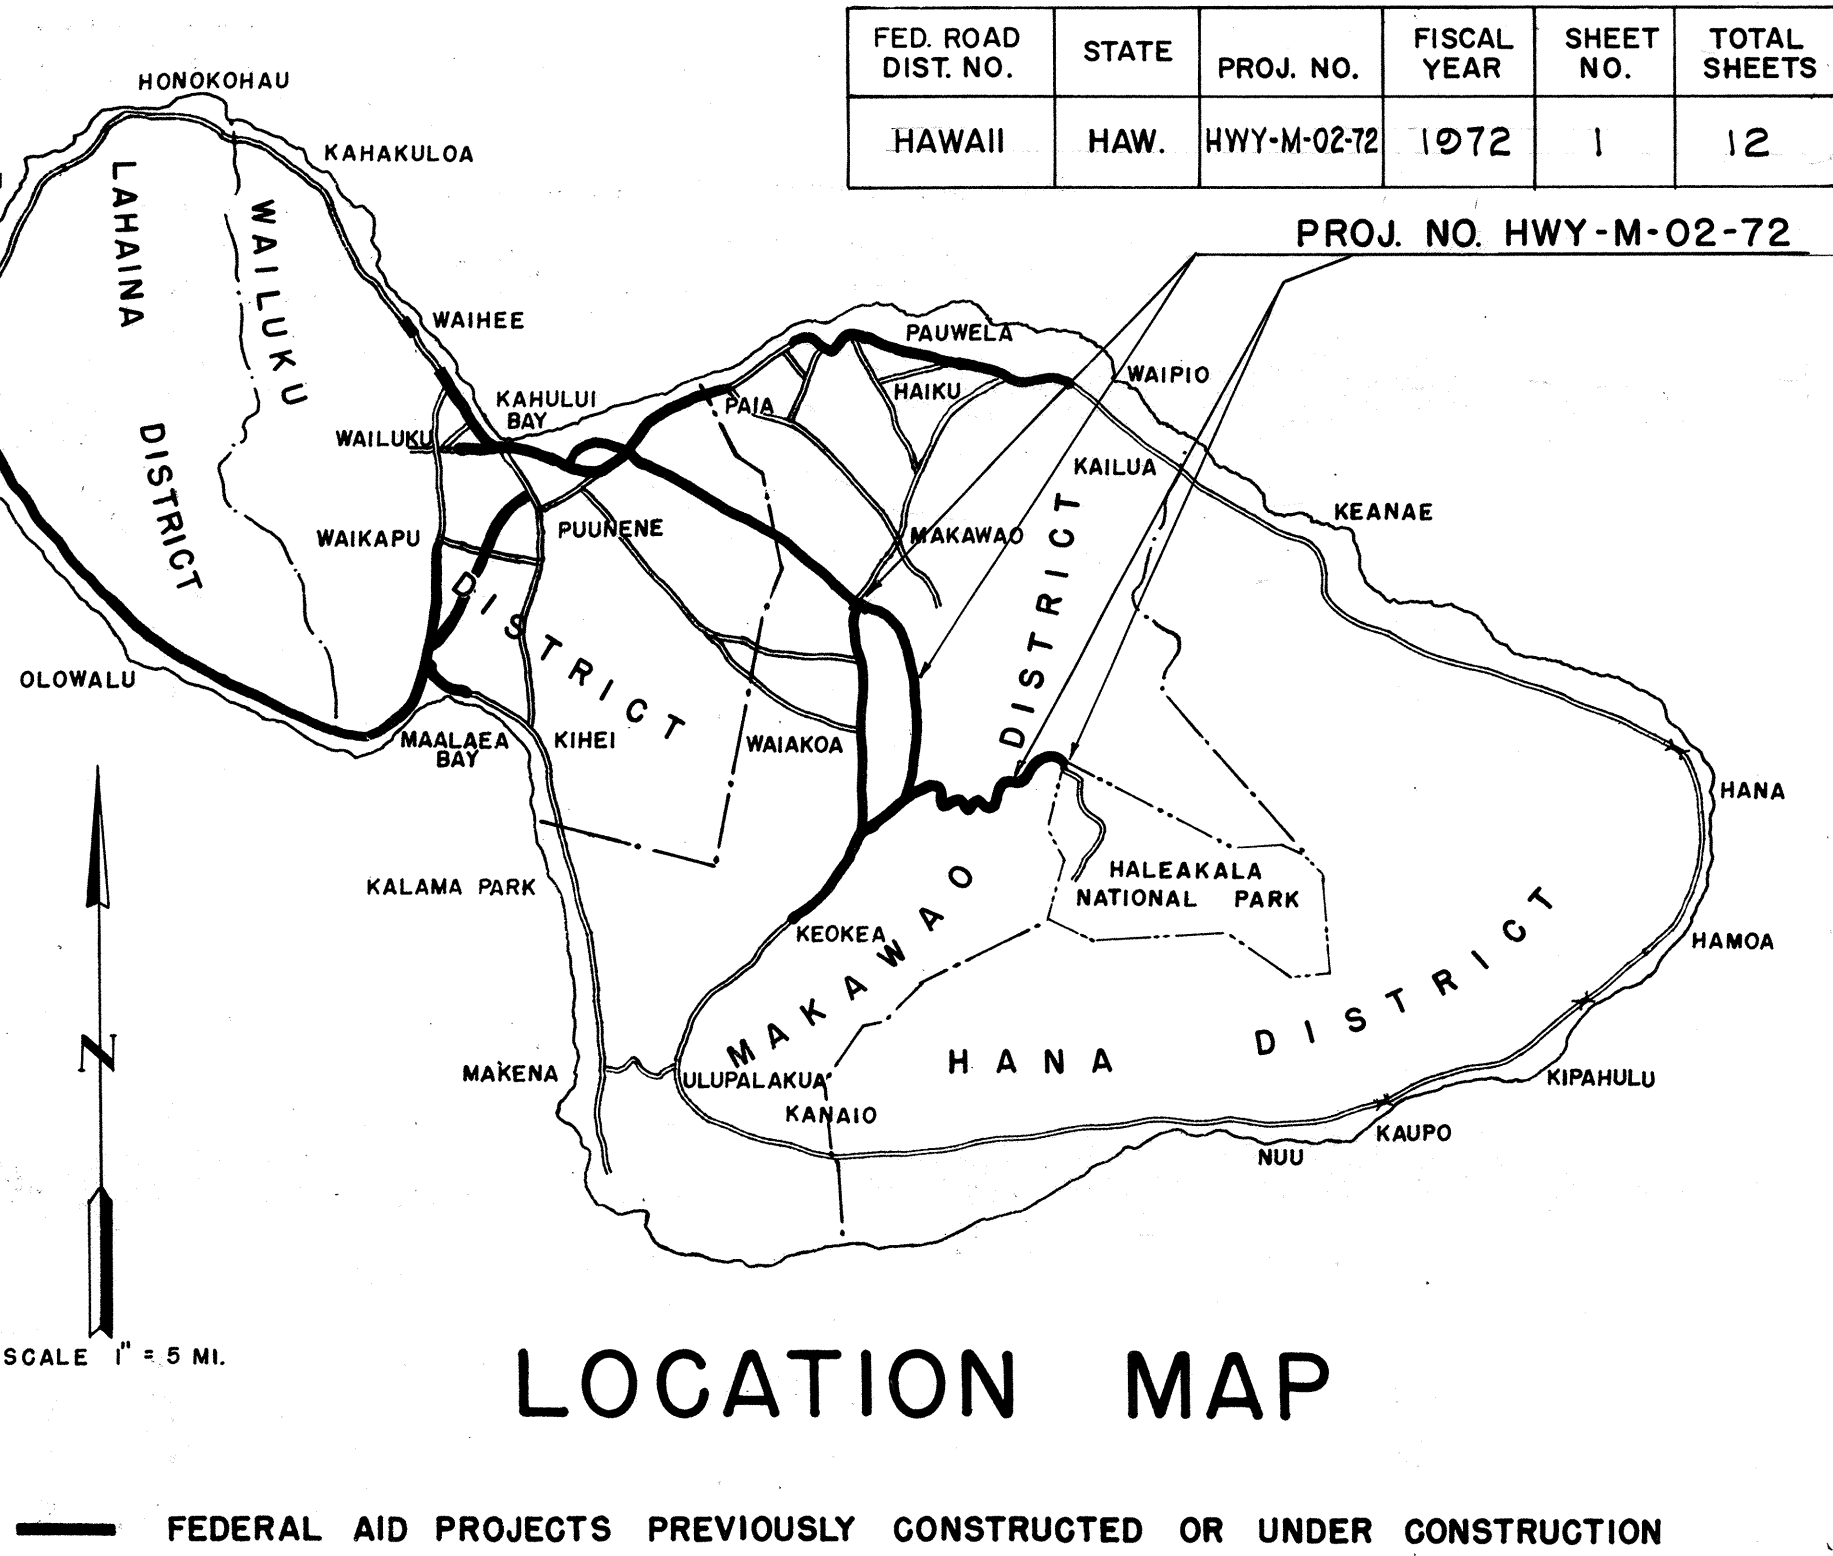

NOTE:
ALL CHANGES MADE DURING CONSTRUCTION
HAVE BEEN NOTED IN RED ON THESE TRACINGS
AND CHECKED BY:


George N. Kaya
PROJECT ENGINEER

9/21/73
DATE

DEPARTMENT OF TRANSPORTATION
STATE OF HAWAII

APPROVED:
Murray Lee
FOR DIR. OF TRANSPORTATION

9/14/73
DATE

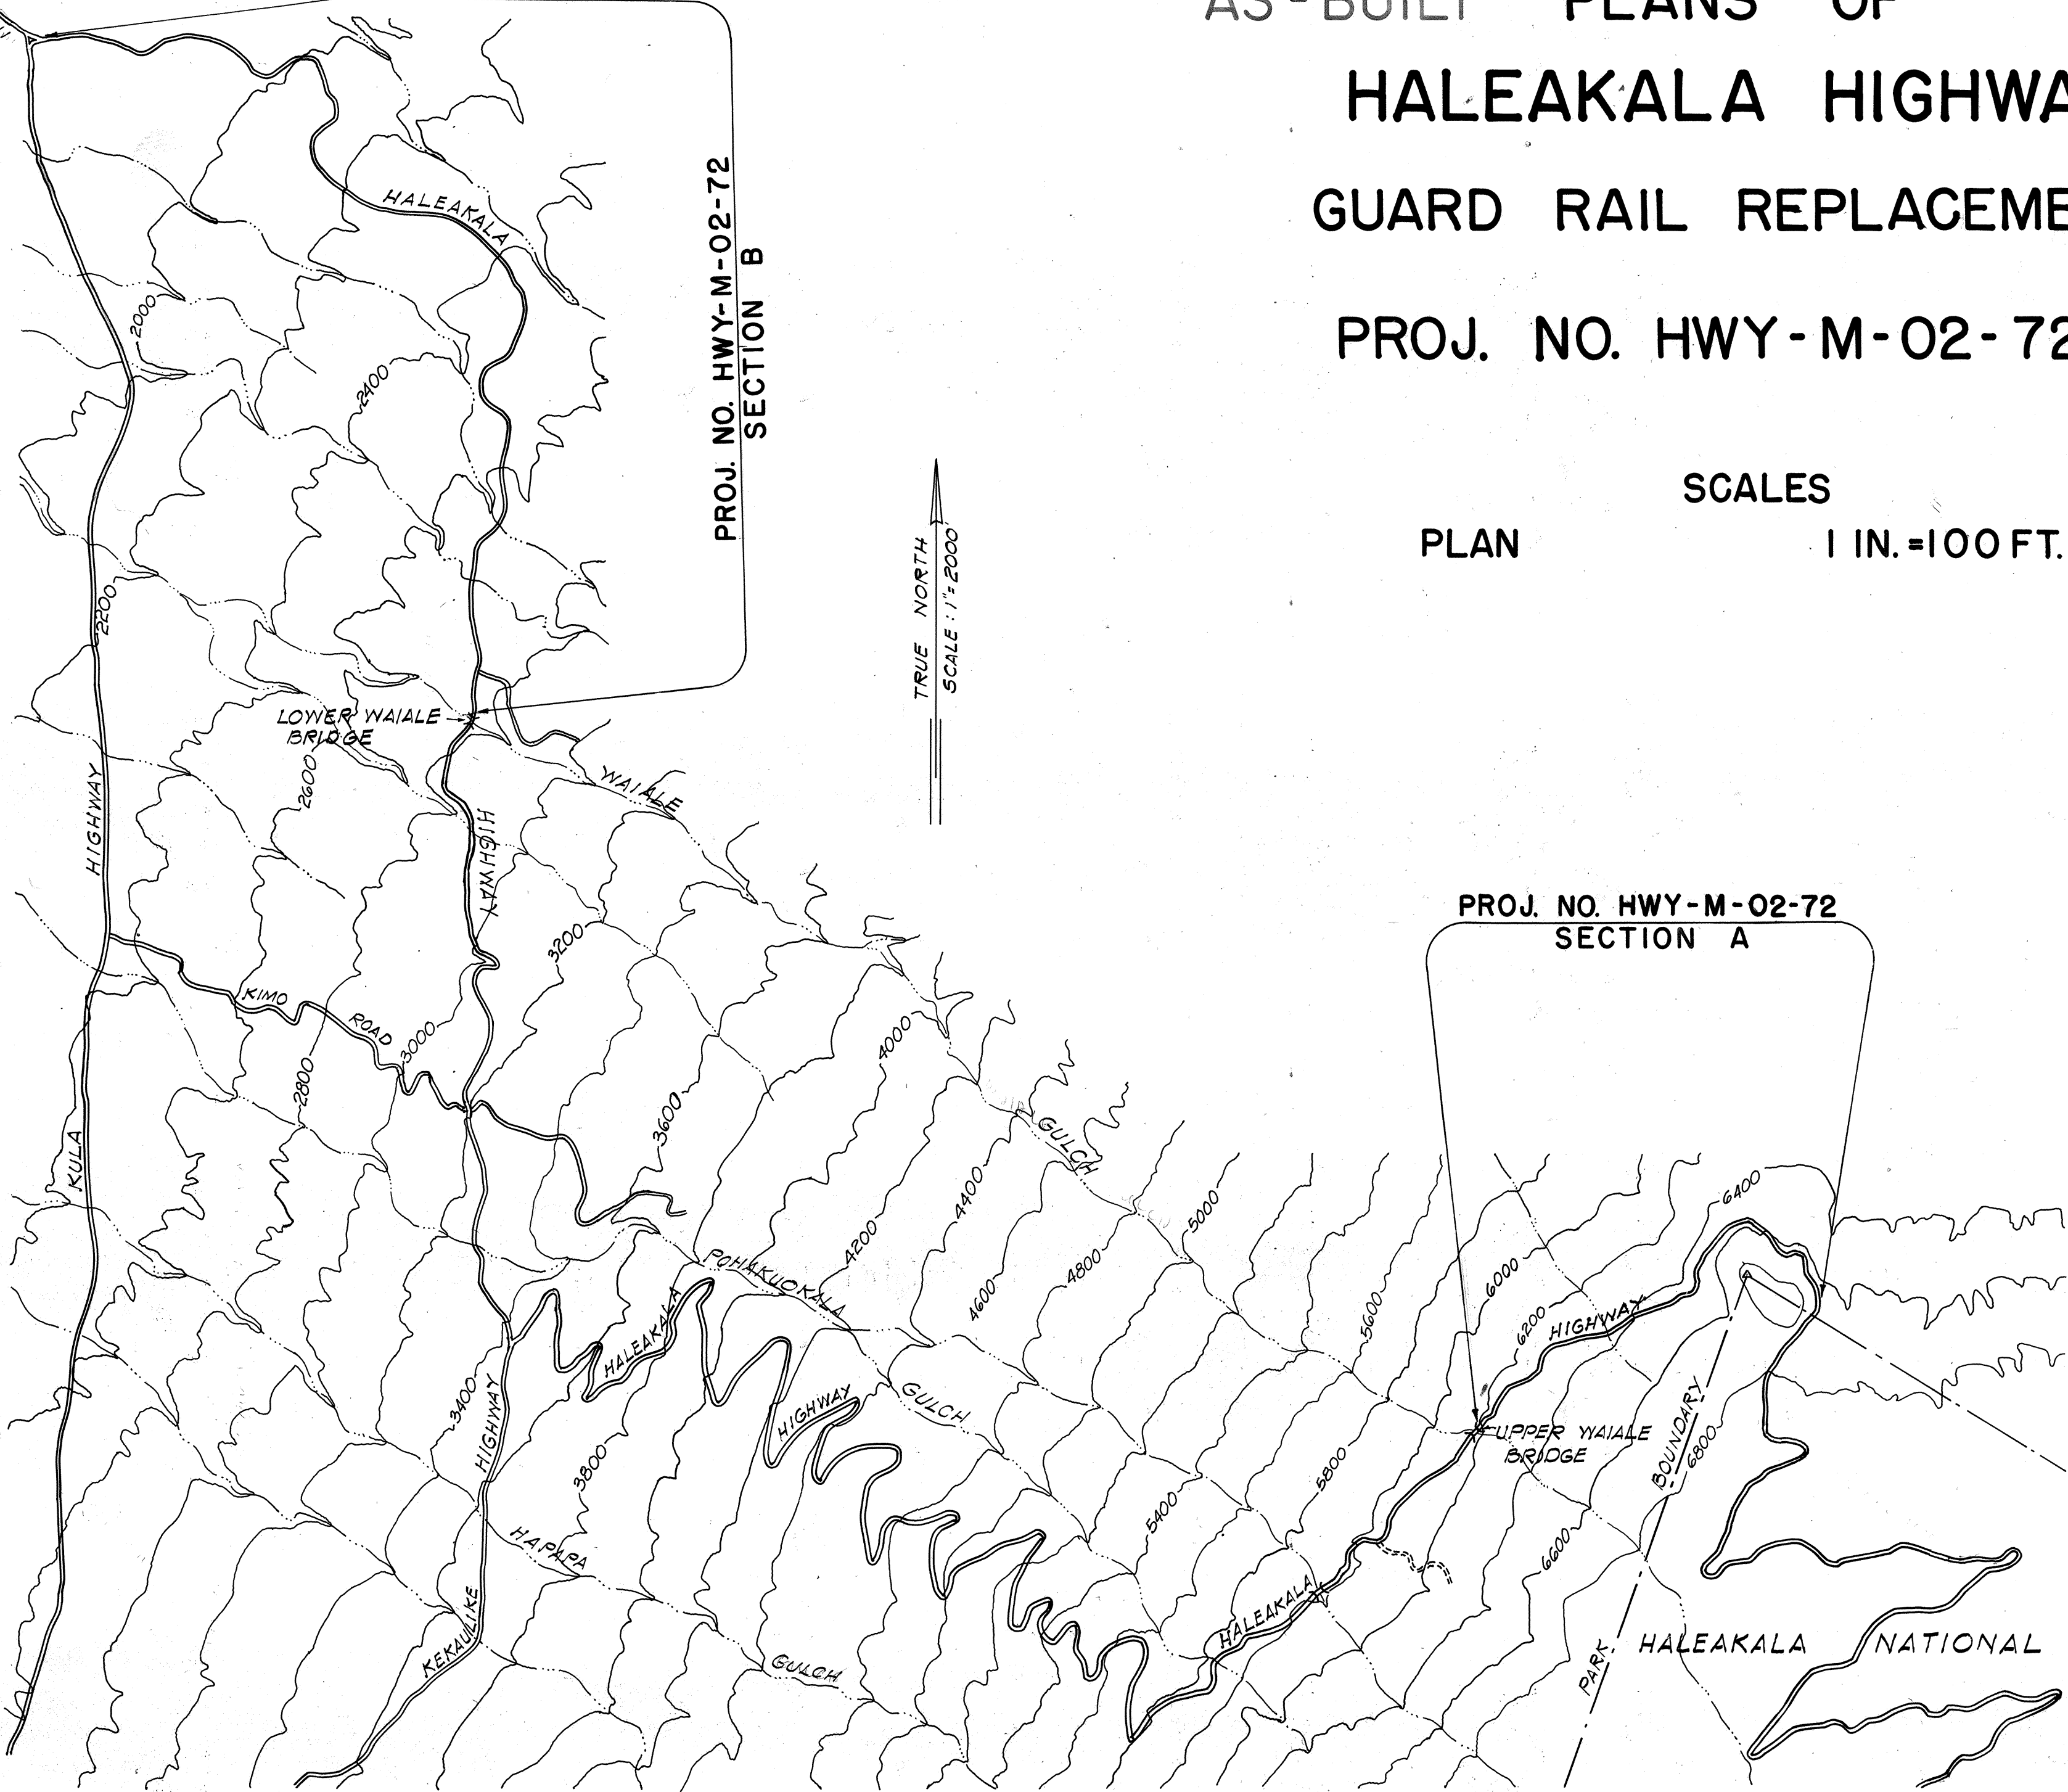

DESIGNED BY: MAUI DISTRICT OFFICE
STATE HIGHWAYS DIVISION
DATE MAY 1972

D. Bevier

LAYOUT OF PROJECT
SCALE: 1" = 2000'