INDEX TO DRAWINGS	
SHEET NO.	DESCRIPTION
1	TITLE SHEET
2	STANDARD PLANS SUMMARY
3 – 4	GENERAL NOTES, TYPICAL SECTION, MISCELLANEOUS
	DETAILS
5 – 21	ROADWAY PLANS
22	SHOULDER WIDTH SCHEDULE
23	GUARDRAIL SCHEDULE
24	PAVEMENT RECONSTRUCTION SCHEDULE
24A	PAVEMENT MARKING, LEGEND, DETAILS & NOTES
25 – 26	TRAFFIC SIGN AND SUMMARY
27 – 36	REFLECTOR MARKERS AND SUMMARY
37	REFLECTOR AND ROUTE MARKERS, CONSTRUCTION
	SIGN SUMMARIES
38 - 39	OBJECT MARKERS AND SUMMARY
40	MISCELLANEOUS TRAFFIC SUMMARIES
41	SIGN DETAILS

STATE OF HAWAII

## DEPARTMENT OF TRANSPORTATION


HIGHWAYS DIVISION HONOLULU, HAWAII


> "AS-BUILT" PLANS FOR

## HALEAKALA CRATER ROAD RESURFACING

HALEAKALA NATIONAL PARK BOUNDARY TOWARDS KEKAULIKE AVENUE PROJECT NO. 378A-01-92M

> DISTRICT OF MAKAWAO ISLAND OF MAUI

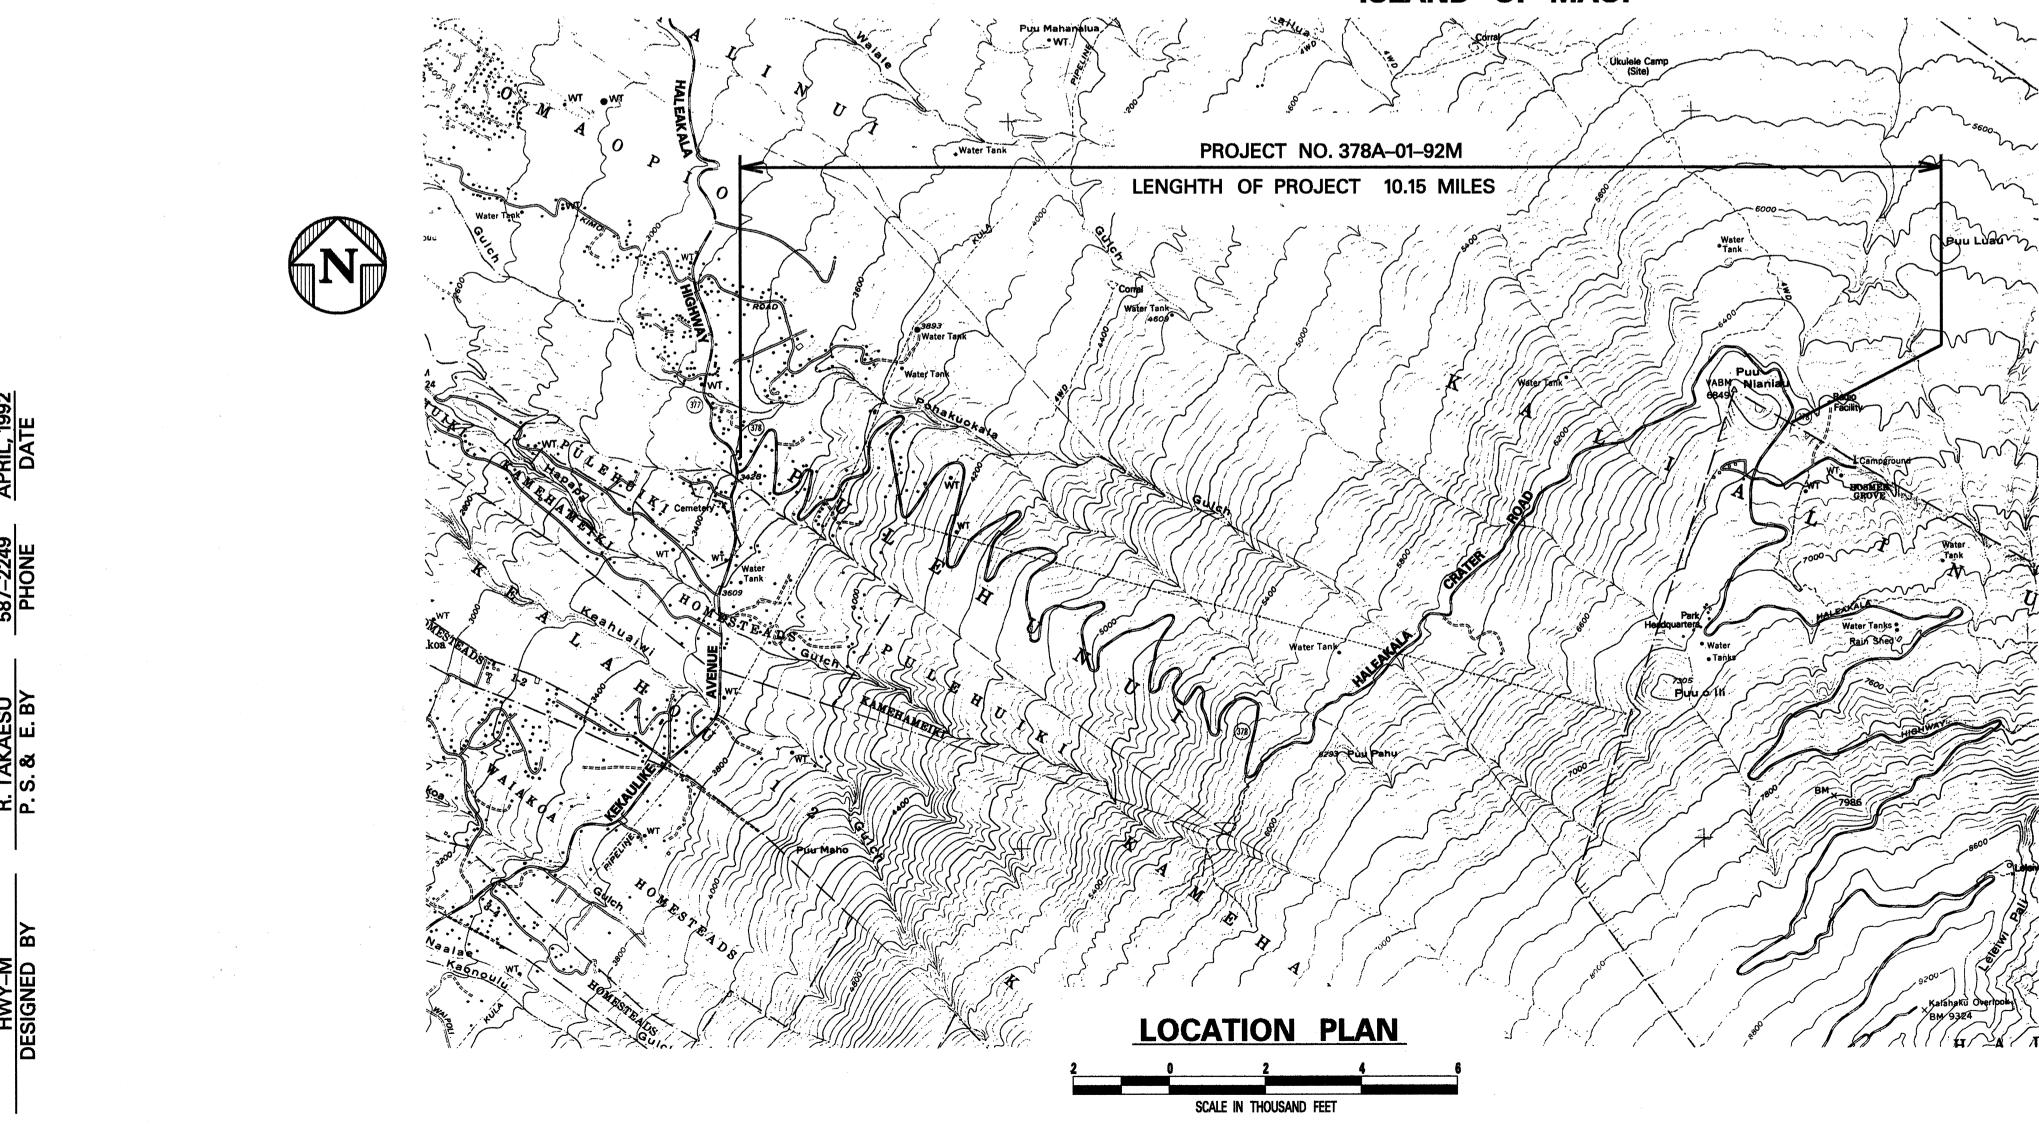

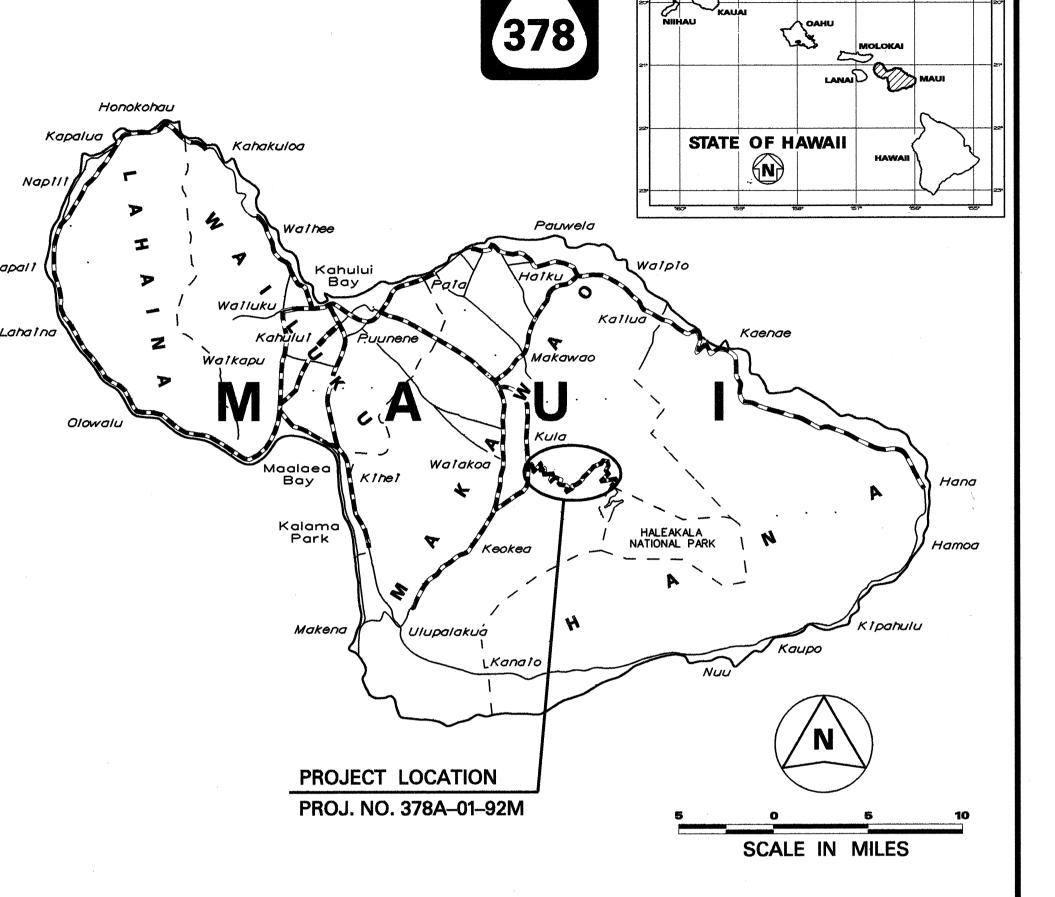

---- FEDERAL AID PROJECTS PREVIOUSLY CONSTRUCTED OR UNDER CONSTRUCTION

378A-01-92M

MILE POST 0.00 TO MILE POST 10.15

CHANGES MADE DURING CONSTRUCTION HAVE BEEN INCORPORATED ON THESE PLANS EXCEPT CHANGES IN THE ORIGINAL THEORETICAL QUANTITIES. FOR ACTUAL QUANTITIES, REFER TO PROJECT LEDGER AND/OR COMPUTATION BOOK.

RESIDENT ENGINEER

10/2/96 DATE

DEPARTMENT OF TRANSPORTATION STATE OF HAWAII **APPROVED:** 

+ Hara no FIR DIR. OF TRANSPORTATION DATE