

HALEAKALA CRATER RD.

CRATER RD.

HALEAKALA

M.L. # STA. 359+00

M.L. # STA. 361+43.74

M.L. # STA. 365+70.7

M.L. # STA. 370+00

M.L. # STA. 374+00

M.L. # STA. 375+30± RT.

M.L. # STA. 379+74.17

M.L. # STA. 381+64.09

M.L. # STA. 387+00

TRUE NORTH SCALE : 1" = 40'

3'-6" SHOULDER

3' SHOULDER

5' SHOULDER

4' -6" SHOULDER

4' SHOULDER

LIMIT of PAVING

R/W

es ep

wire fence

hedge

tree line

a.c. swale

a.c. berm

arm wall

adjust water valve box frame and cover (2 ea.)

Reset existing guardrail post - (54 EACH)

Reset existing guardrail post - (27 EACH)

CURVE DATA

$\Delta = 120^\circ 45'$	$\Delta = 49^\circ 31'$	$\Delta = 180^\circ 00'$
$R = 100.00'$	$R = 383.10'$	$R = 100.00'$
$T = 175.87'$	$T = 176.68'$	$C = 200.00'$
$C = 173.86'$	$C = 320.88'$	$Lc = 314.16'$
$Lc = 210.75'$	$Lc = 331.09'$	

CURVE DATA

$\Delta = 45^\circ 34'$
$R = 238.80'$
$T = 100.29'$
$C = 184.94'$
$Lc = 189.92'$

LEGEND FOR AS-BUILT POSTINGS

- Squiggly line for as-built deletion
- Double line for as-built deletion
- Roadway Text for as-built posting

DEPARTMENT OF TRANSPORTATION


HAWAII

PREVIOUS FEDERAL AID PROJECTS

Scale: 1" = 40'


11

FED. ROAD DIST. NO.	STATE	FED. AID PROJ. NO.	FISCAL YEAR	SHEET NO.	TOTAL SHEETS
HAWAII	HAW.	STP-0378(003)	2011	12	21

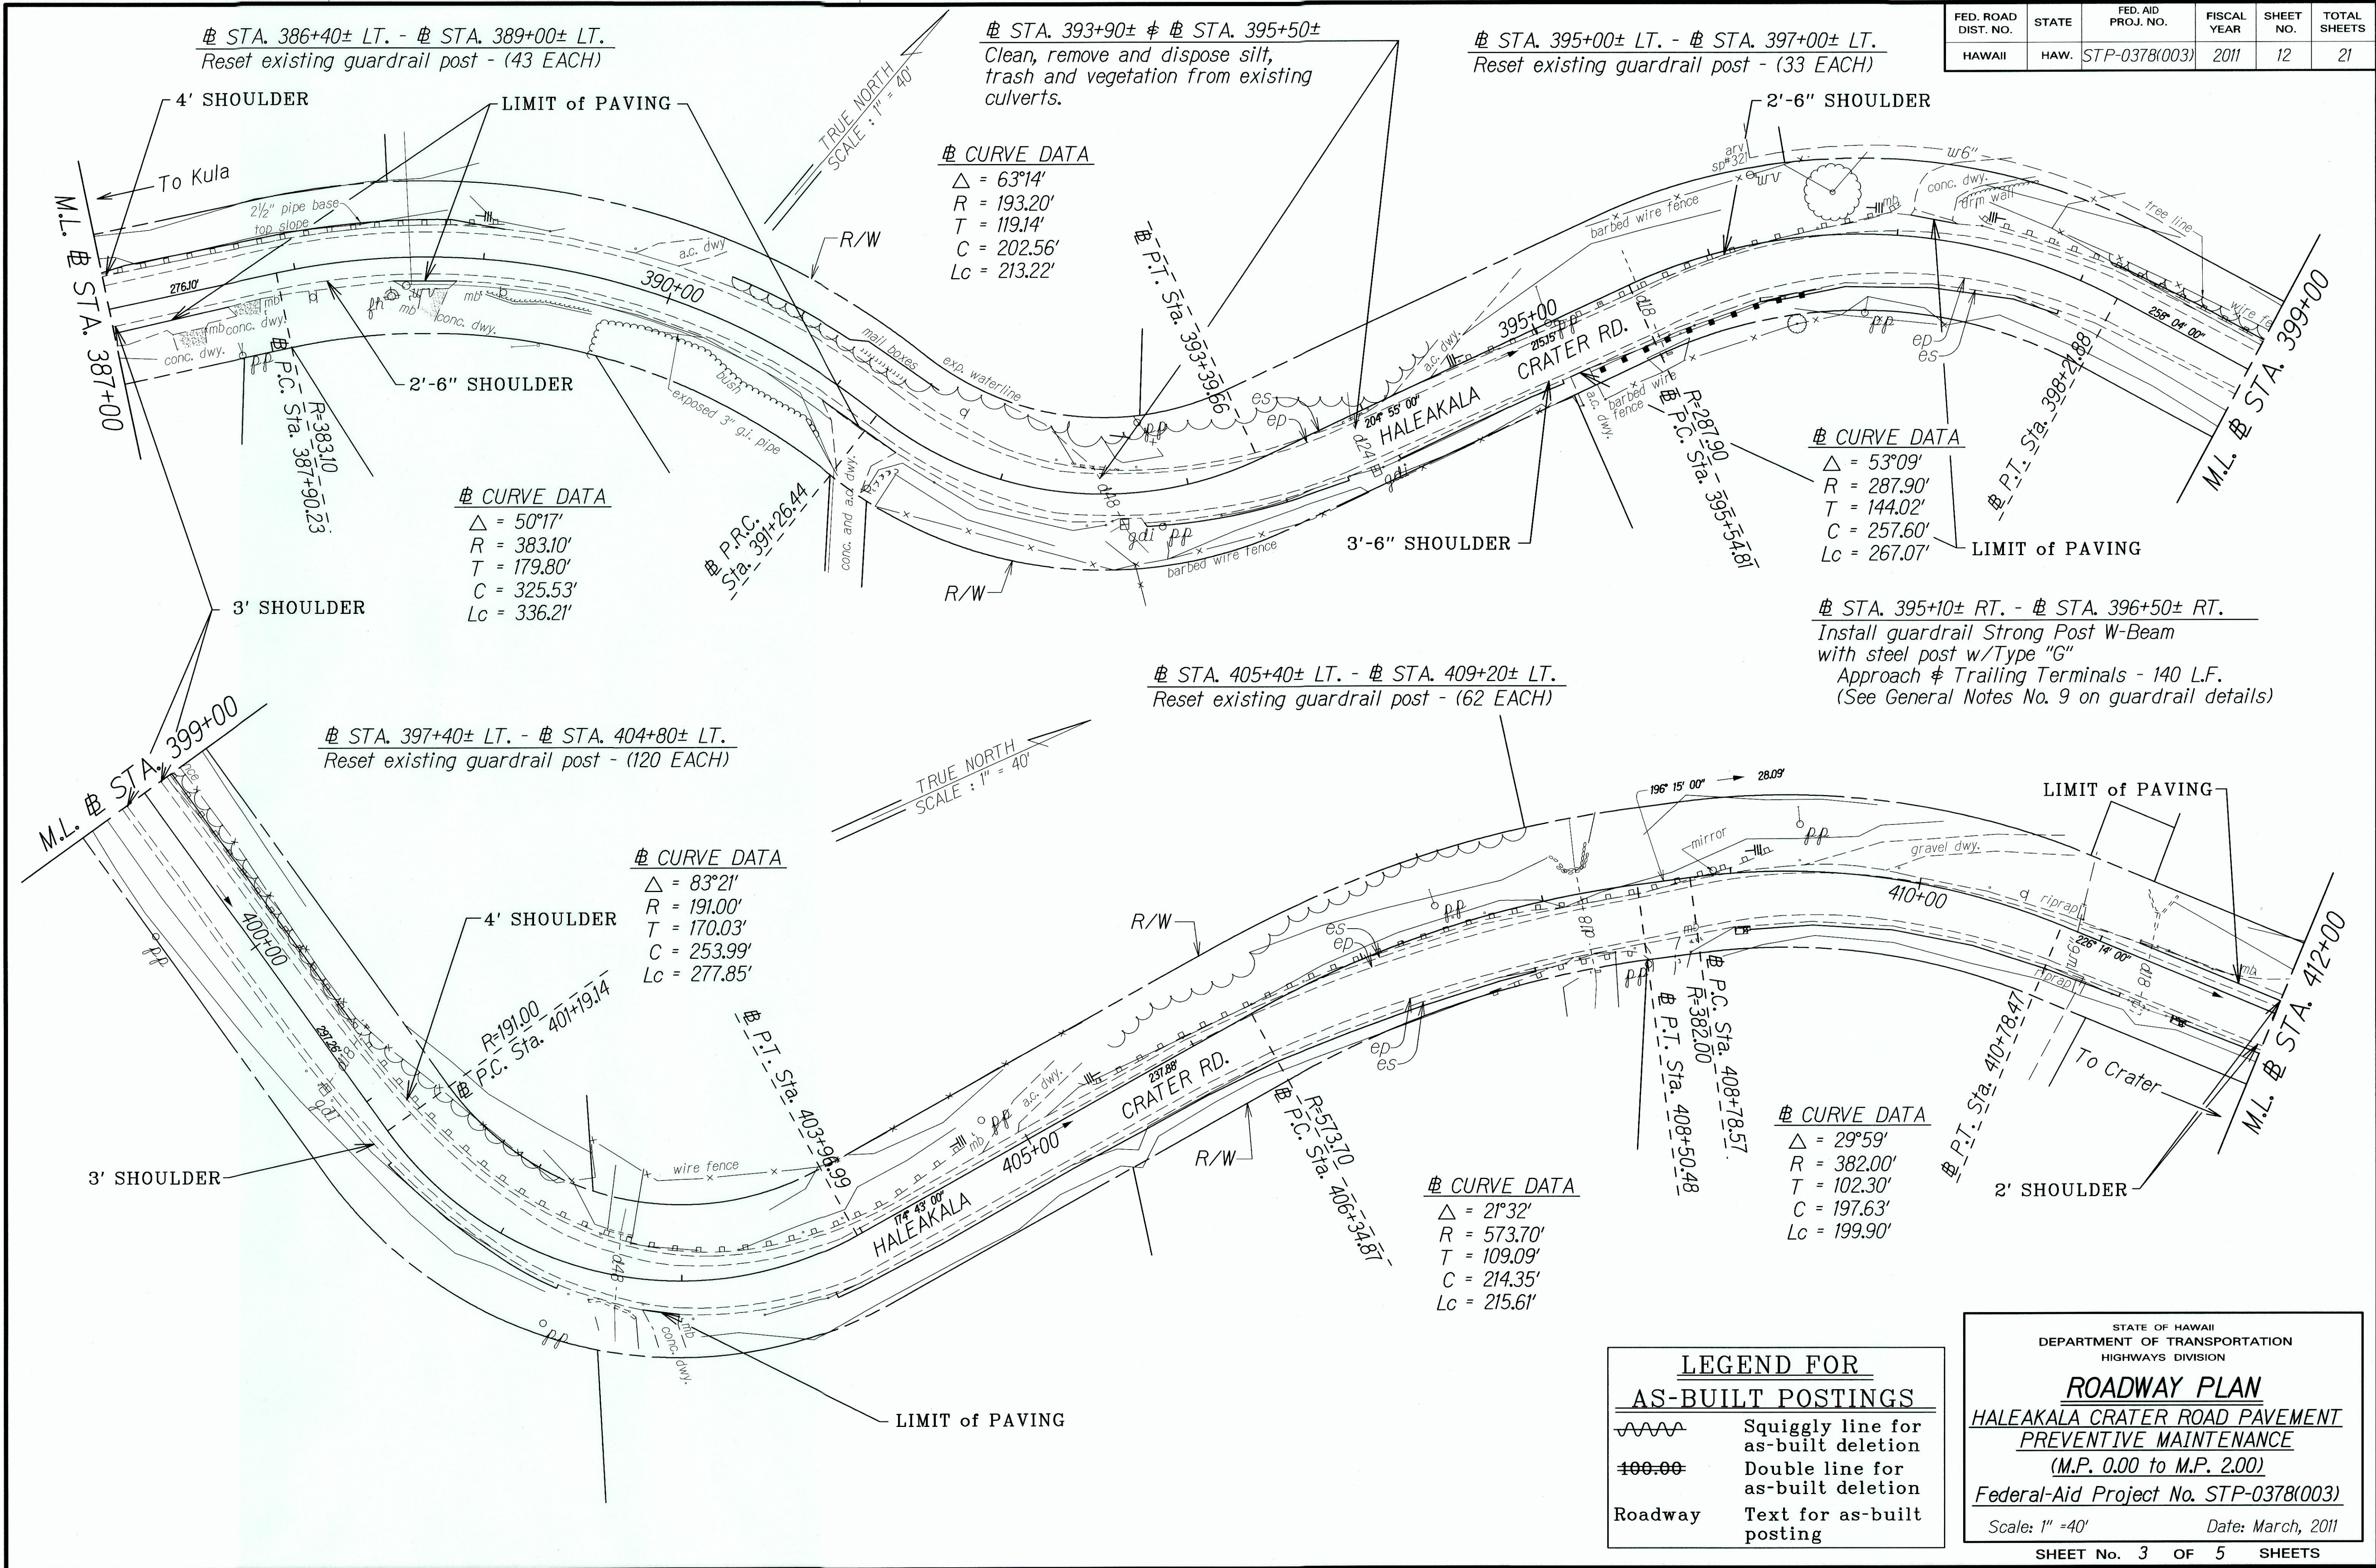

ORIGINAL PLAN	DATE
SURVEY PLOTTED BY	10/03
DRAWN BY	
NOTE BOOK DESIGNED BY	
QUANTITIES BY	
CHECKED BY	

FED. ROAD DIST. NO.	STATE	FED. AID PROJ. NO.	FISCAL YEAR	SHEET NO.	TOTAL SHEETS
HAWAII	HAW.	STP-0378(003)	2011	13	21

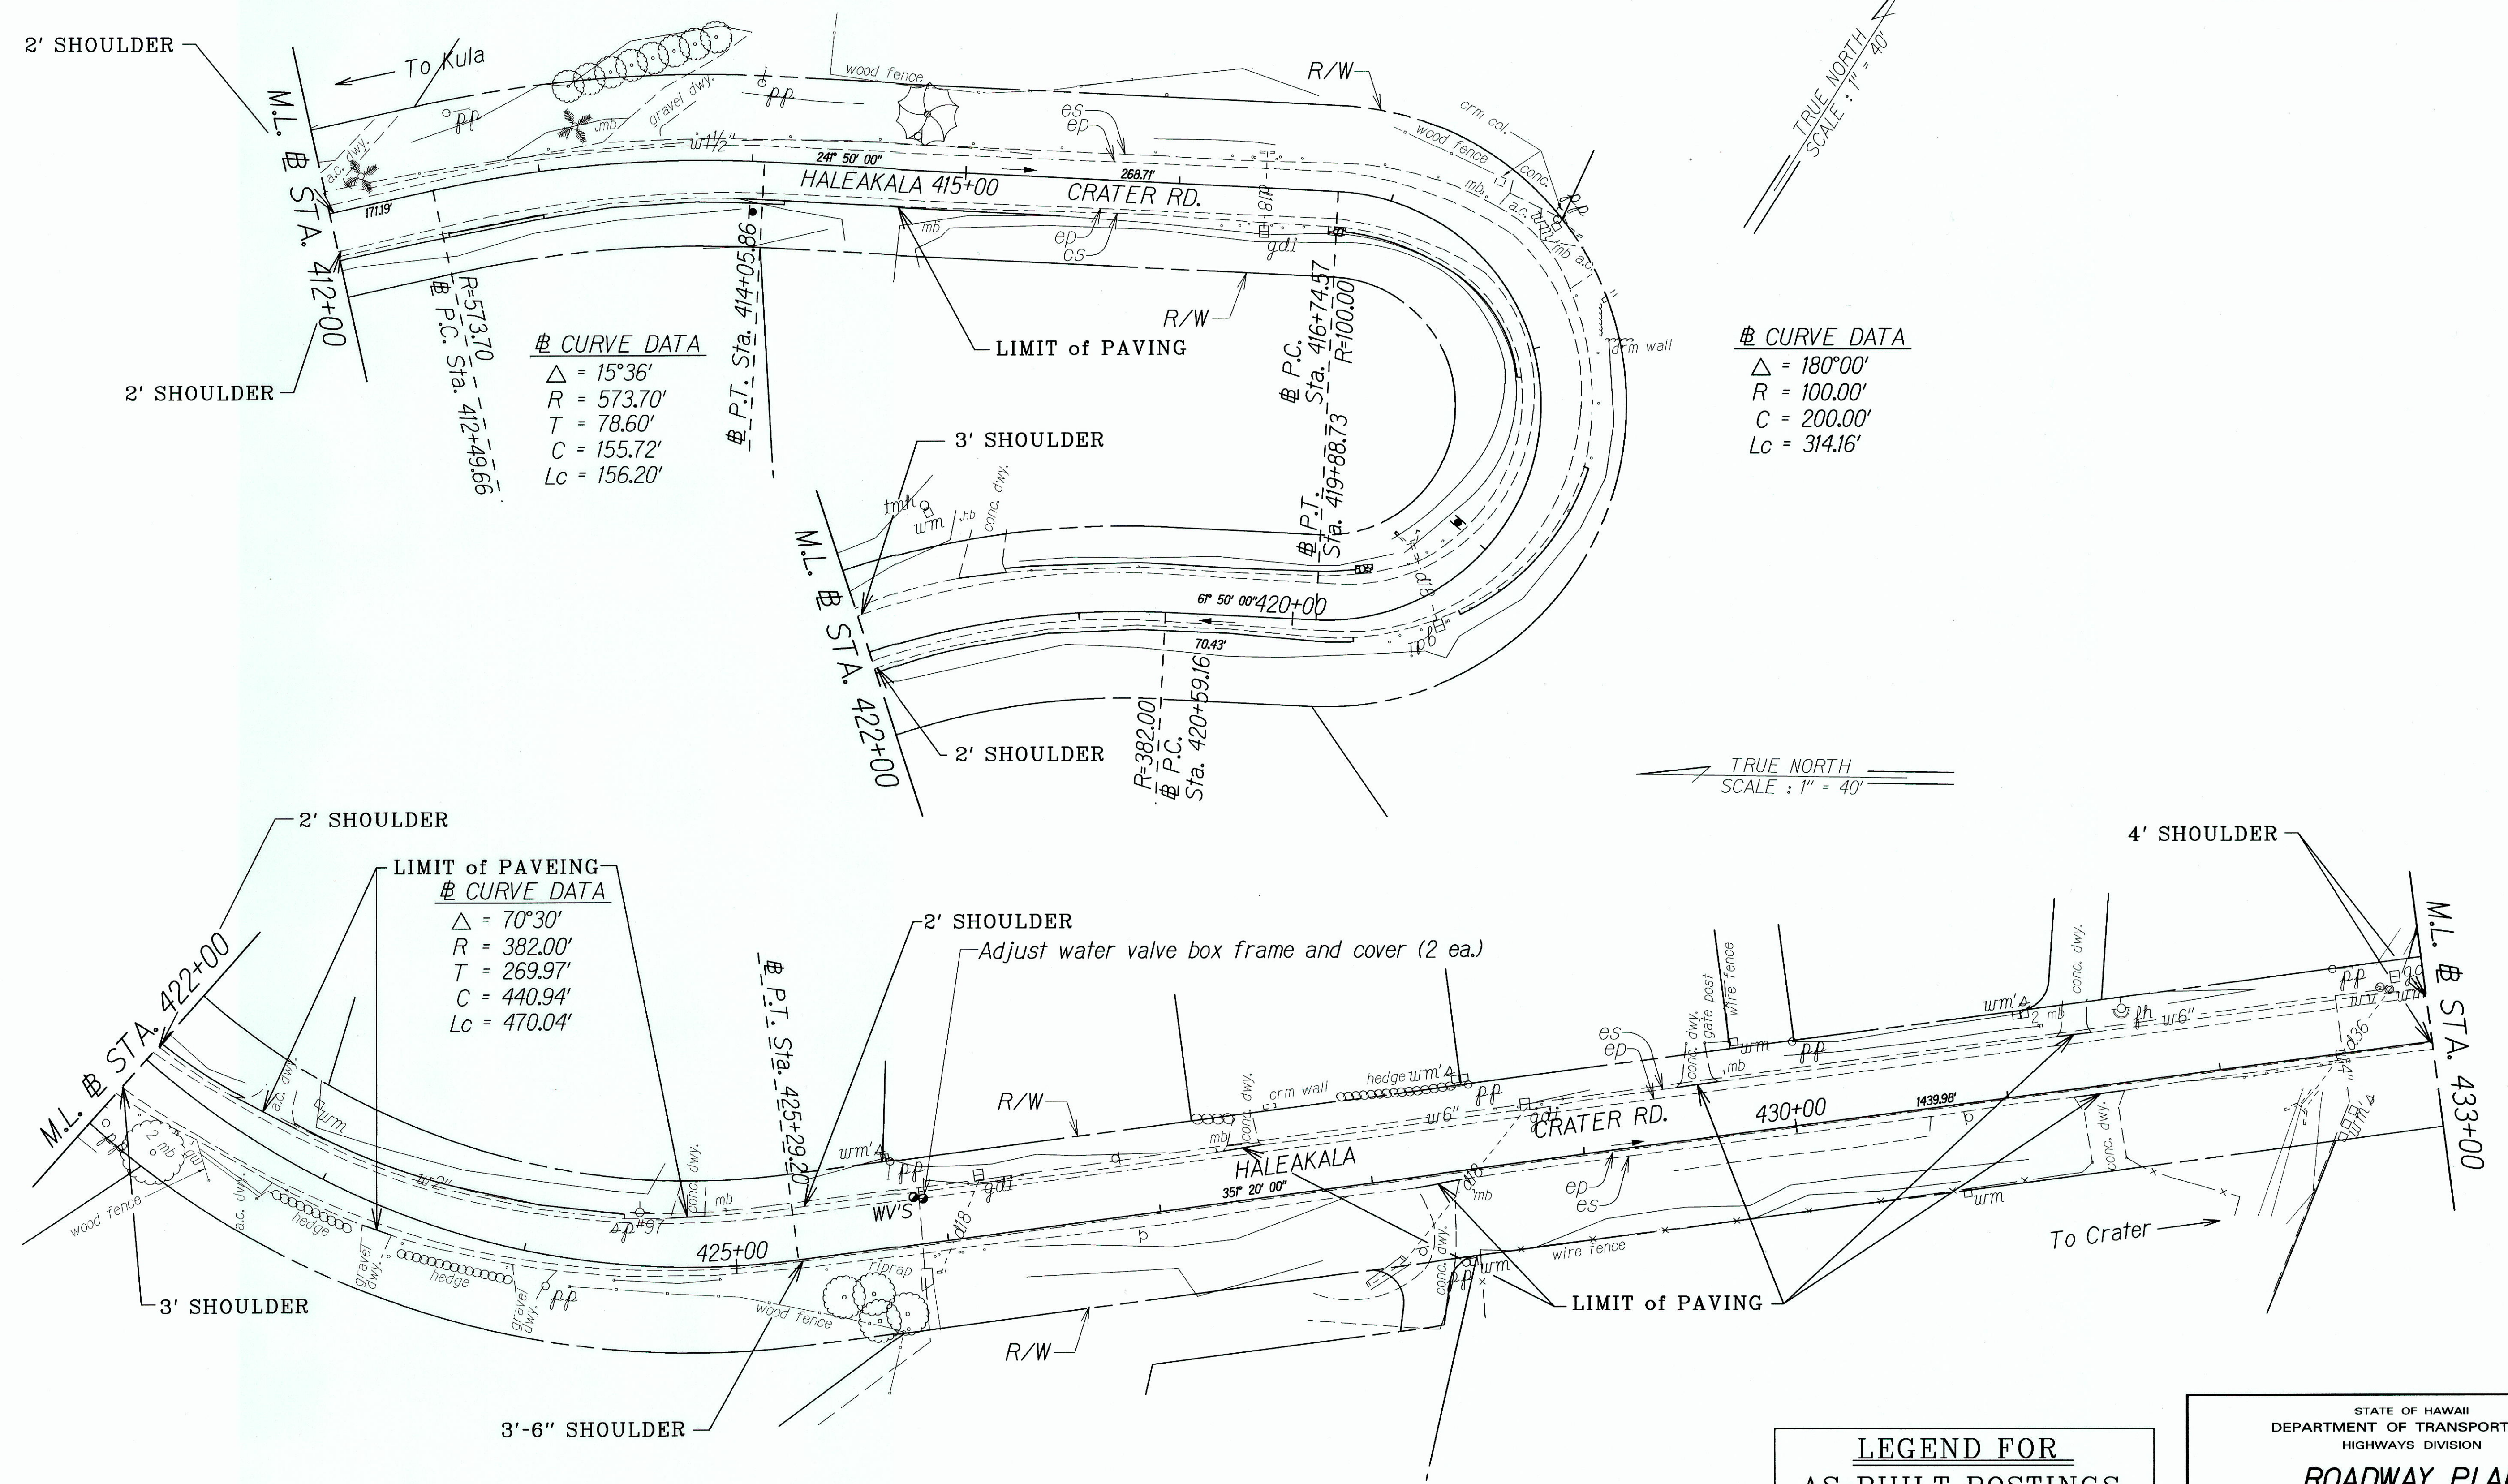


ORIGINAL PLAN	DATE
SURVEY PLOTTED BY	10/03
DRAWN BY	
TRACED BY	
CHECKED BY	
NOTES	
QUANTITIES BY	
CHECKED BY	

STATE OF HAWAII
DEPARTMENT OF TRANSPORTATION
HIGHWAYS DIVISION


ROADWAY PLAN
HALEAKALA CRATER ROAD PAVEMENT PREVENTIVE MAINTENANCE
(M.P. 0.00 to M.P. 2.00)
Federal-Aid Project No. STP-0378(003)
Scale: 1" = 40' Date: March, 2011

FED. ROAD DIST. NO.	STATE	FED. AID PROJ. NO.	FISCAL YEAR	SHEET NO.	TOTAL SHEETS
HAWAII	HAW.	STP-0378(003)	2011	14	21

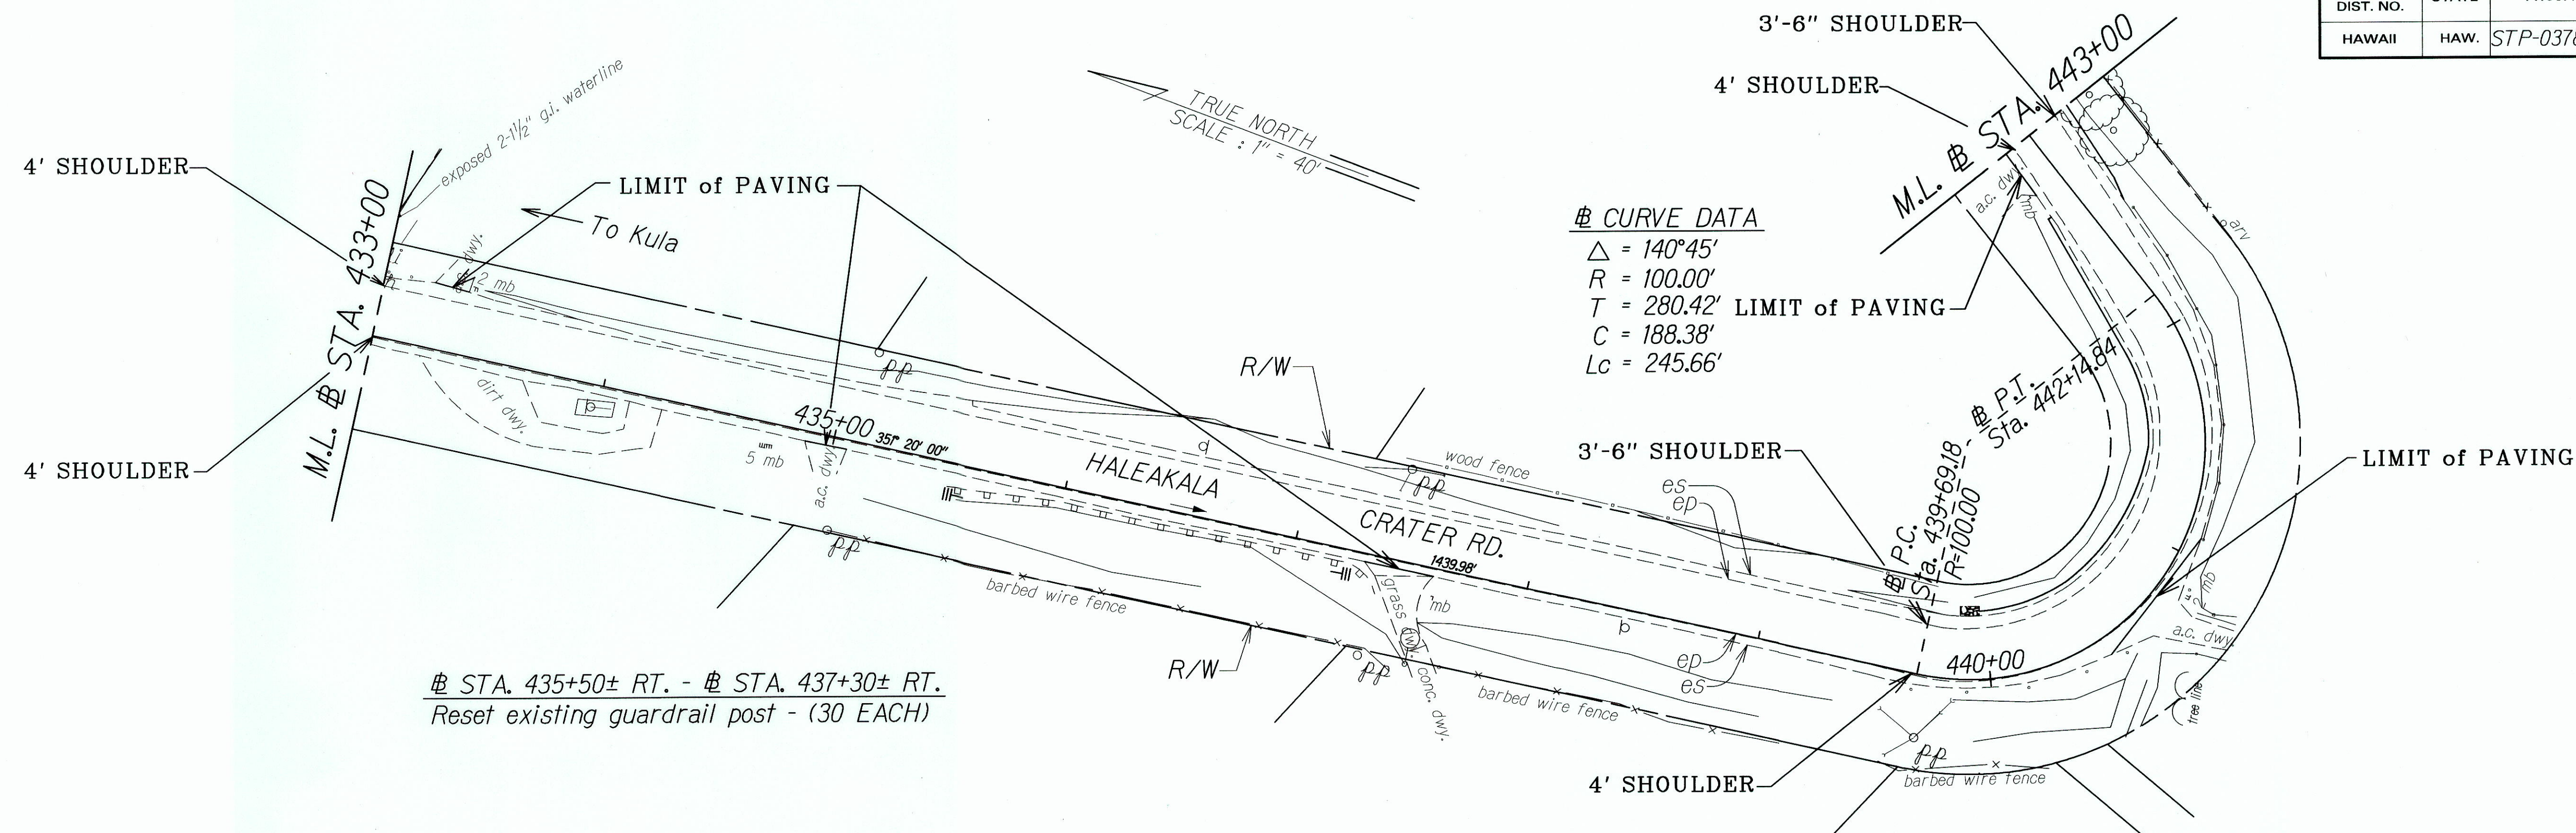

Sta. 435+50± RT. - Sta. 437+30± RT.
Reset existing guardrail post - (30 EACH)

END PROJECT
Fed. Aid Proj. No. STP-0378(003)
Sta. 448+00

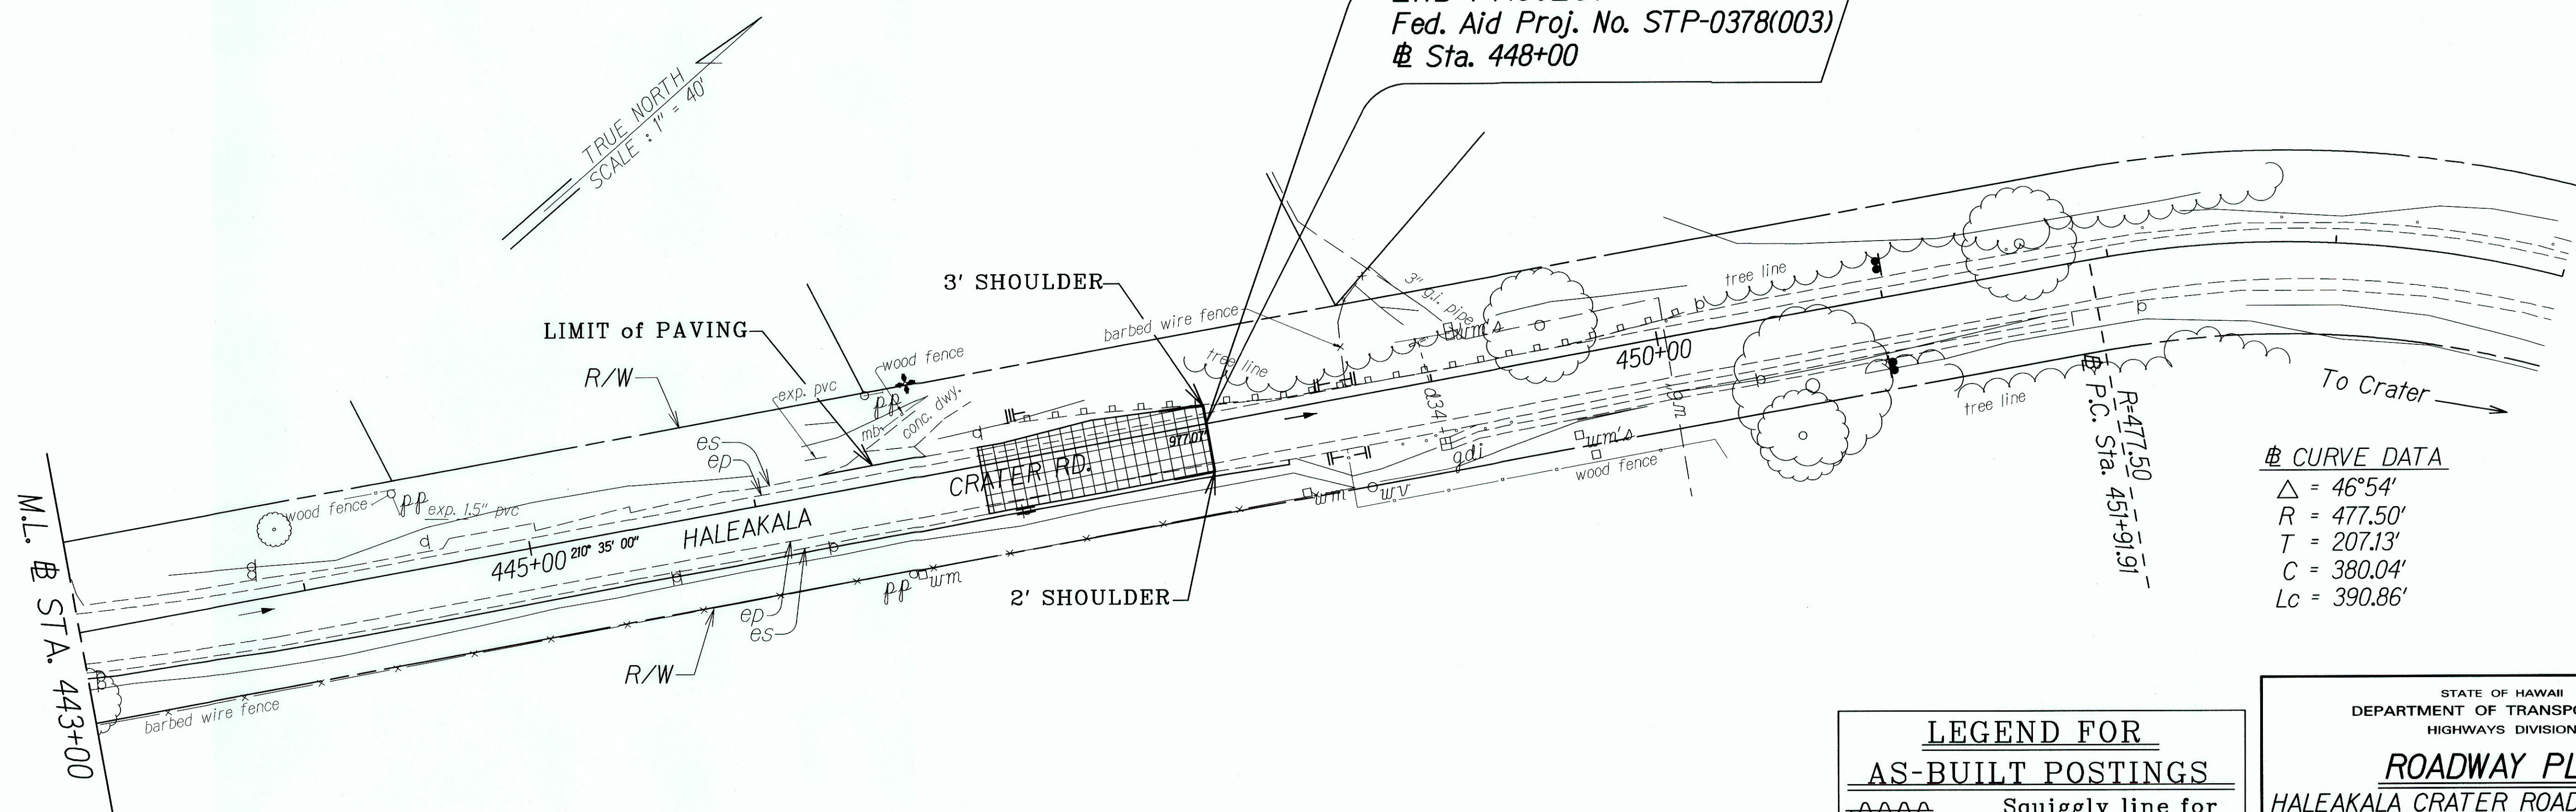

Δ = 46°54'
R = 477.50'
T = 207.13'
C = 380.04'
Lc = 390.86'

SURVEY PLOTTED BY	DATE
DESIGNED BY	10/03
QUANTITIES BY	
CHECKED BY	
ORIGINAL PLAN	
NOTE BOOK	
DESIGNED BY	
QUANTITIES BY	
CHECKED BY	

LEGEND FOR AS-BUILT POSTINGS	
	Squiggly line for as-built deletion
	Double line for as-built deletion
Roadway	Text for as-built posting

STATE OF HAWAII
DEPARTMENT OF TRANSPORTATION
HIGHWAYS DIVISION

ROADWAY PLAN
HALEAKALA CRATER ROAD PAVEMENT PREVENTIVE MAINTENANCE
(M.P. 0.00 to M.P. 2.00)
Federal-Aid Project No. STP-0378(003)
Scale: 1" = 40' Date: March, 2011

"AS-BUILT"