

INDEX TO DRAWINGS	
SHEET NO.	DESCRIPTION
1	TITLE SHEET
2	STANDARD PLANS SUMMARY
3	GENERAL NOTES AND LEGEND
4 - 5	WATER POLLUTION & EROSION CONTROL NOTES
6 - 7	TYPICAL SECTIONS & DETAILS
8 - 9	GUARDRAIL DETAILS & NOTES
10 - 14	ROADWAY PLANS
15	PAVEMENT MARKING LEGEND, DETAILS & NOTES
16	WORK ZONE SIGNING PLAN, NOTES & DETAILS
17 - 21	SIGNING & PAVEMENT MARKING PLANS

STATE OF HAWAII

DEPARTMENT OF TRANSPORTATION

HIGHWAYS DIVISION

HONOLULU, HAWAII

"AS-BUILT"

PLANS FOR



HALEAKALA CRATER ROAD PAVEMENT PREVENTIVE MAINTENANCE

(M.P. 0.00 TO M.P. 2.00)

FEDERAL-AID PROJECT NO. STP-0378(003)

DISTRICT OF MAKAWAO

ISLAND OF MAUI

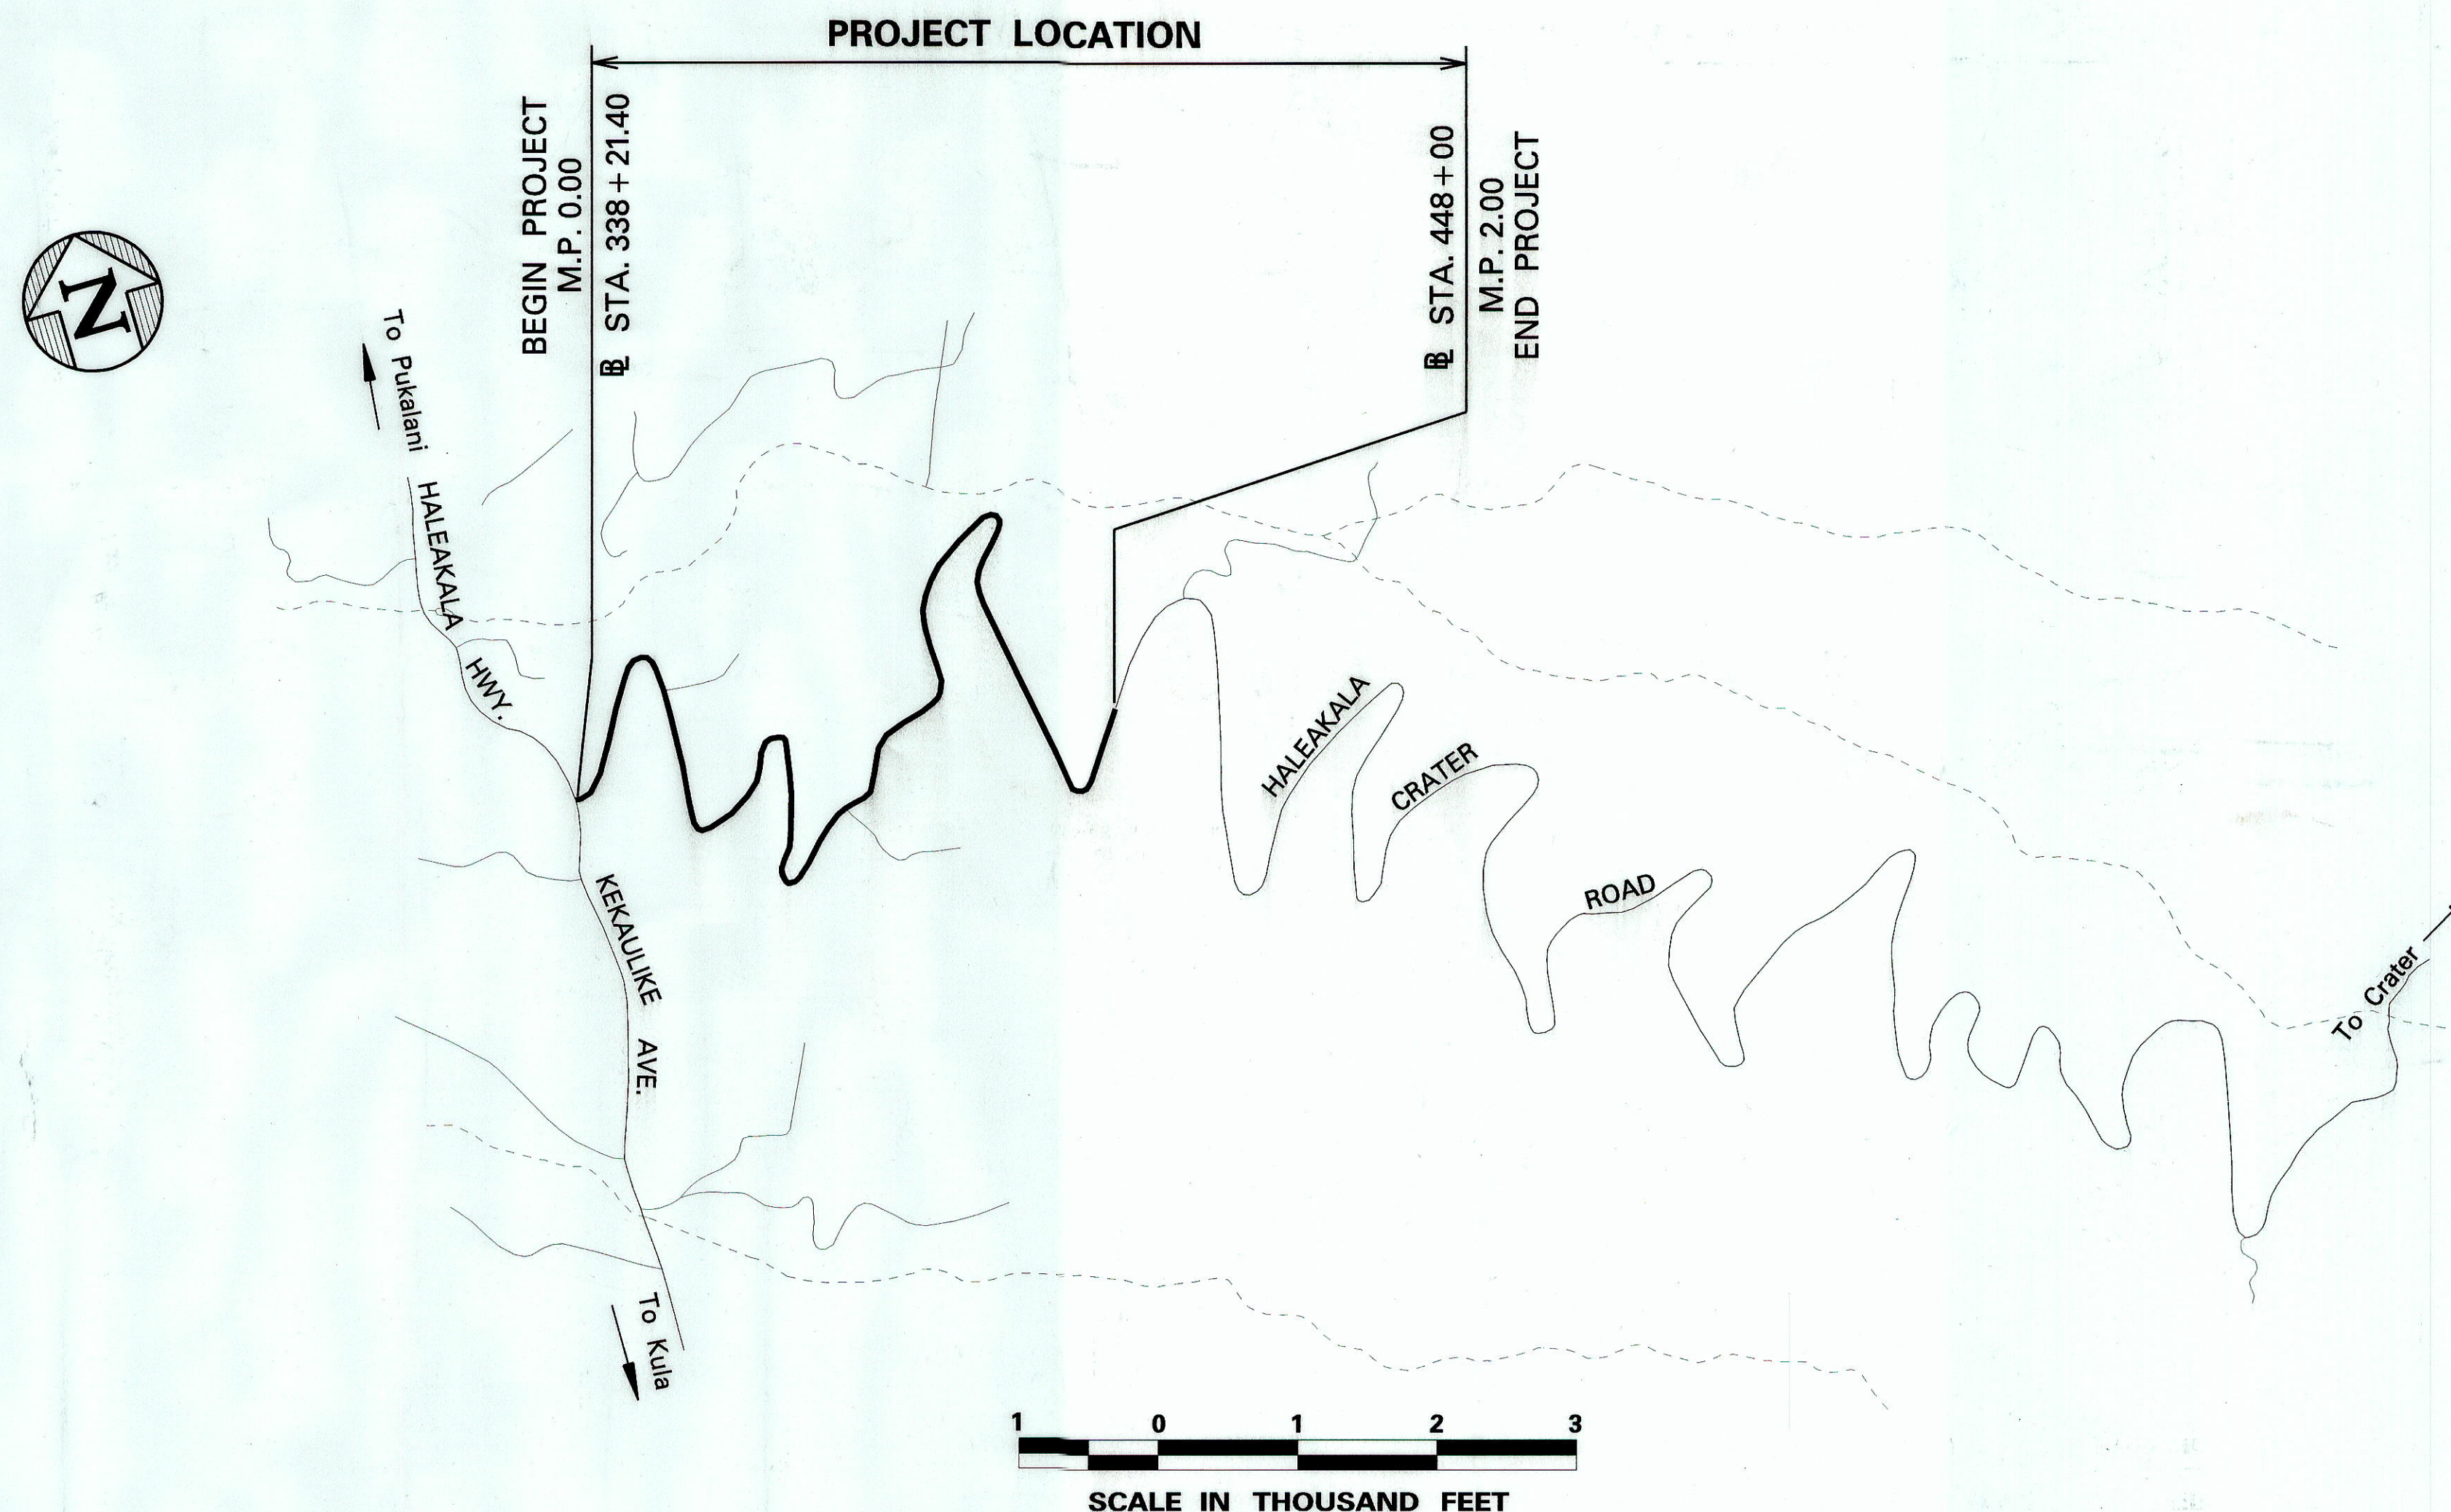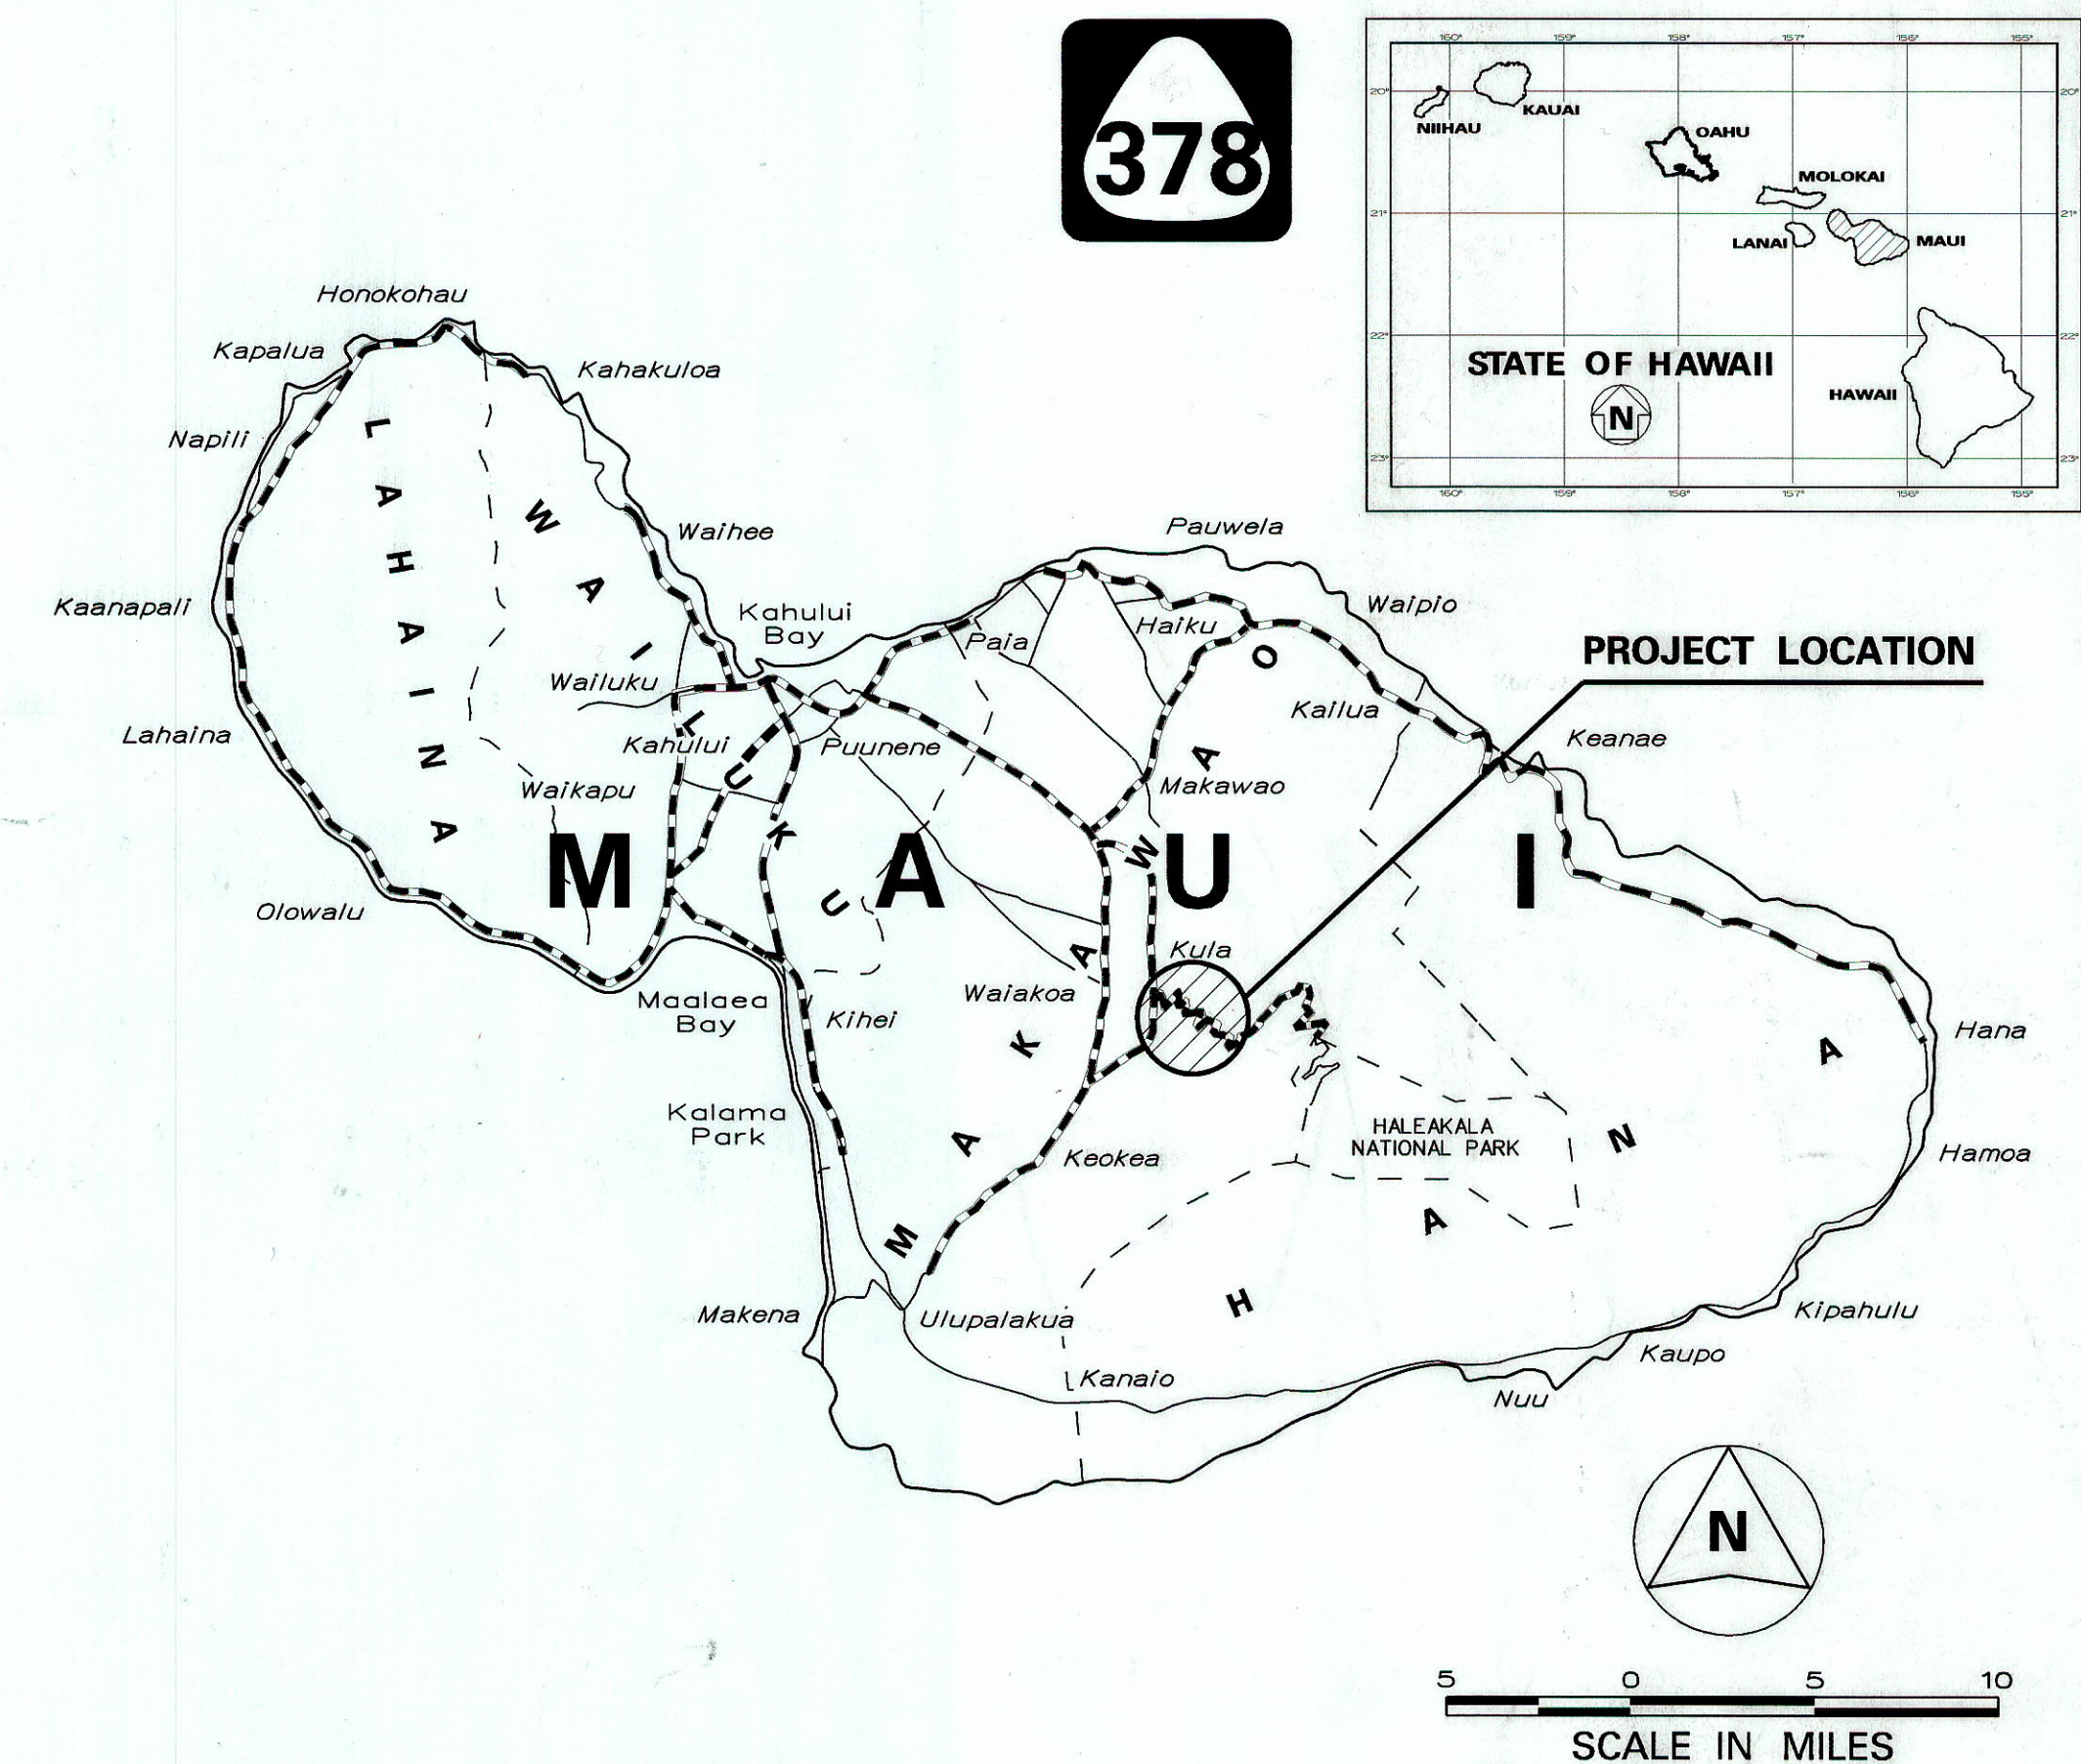

----- FEDERAL AID PROJECTS PREVIOUSLY CONSTRUCTED OR UNDER CONSTRUCTION

MILE POST 0.00 TO MILE POST 2.00

DESIGN DESIGNATION

ADT (2011)	1,700
ADT (2021)	1,900
DHV	180
DESIGN K	9.5
DESIGN D	65/35
DESIGN T	6.5
T ₂₄	5.5

CHANGES MADE DURING CONSTRUCTION HAVE BEEN INCORPORATED ON THESE PLANS EXCEPT CHANGES IN THE ORIGINAL THEORETICAL QUANTITIES. FOR ACTUAL QUANTITIES, REFER TO PROJECT LEDGER AND/OR COMPUTATION BOOK.

for RESIDENT ENGINEER

6/9/14 DATE

DEPARTMENT OF TRANSPORTATION STATE OF HAWAII	
APPROVED:	5/3/11
DIR. OF TRANSPORTATION	DATE

DESIGNED BY
HWY-M

MANAGED BY
HWY-ME

PHONE 873-3535

DATE MARCH, 2011