




FED. ROAD DIST. NO.	STATE	FED. AID PROJ. NO.	FISCAL YEAR	SHEET NO.	TOTAL SHEETS
HAWAII	HAW.	STP-0378(003)	2011	ADD.6	21

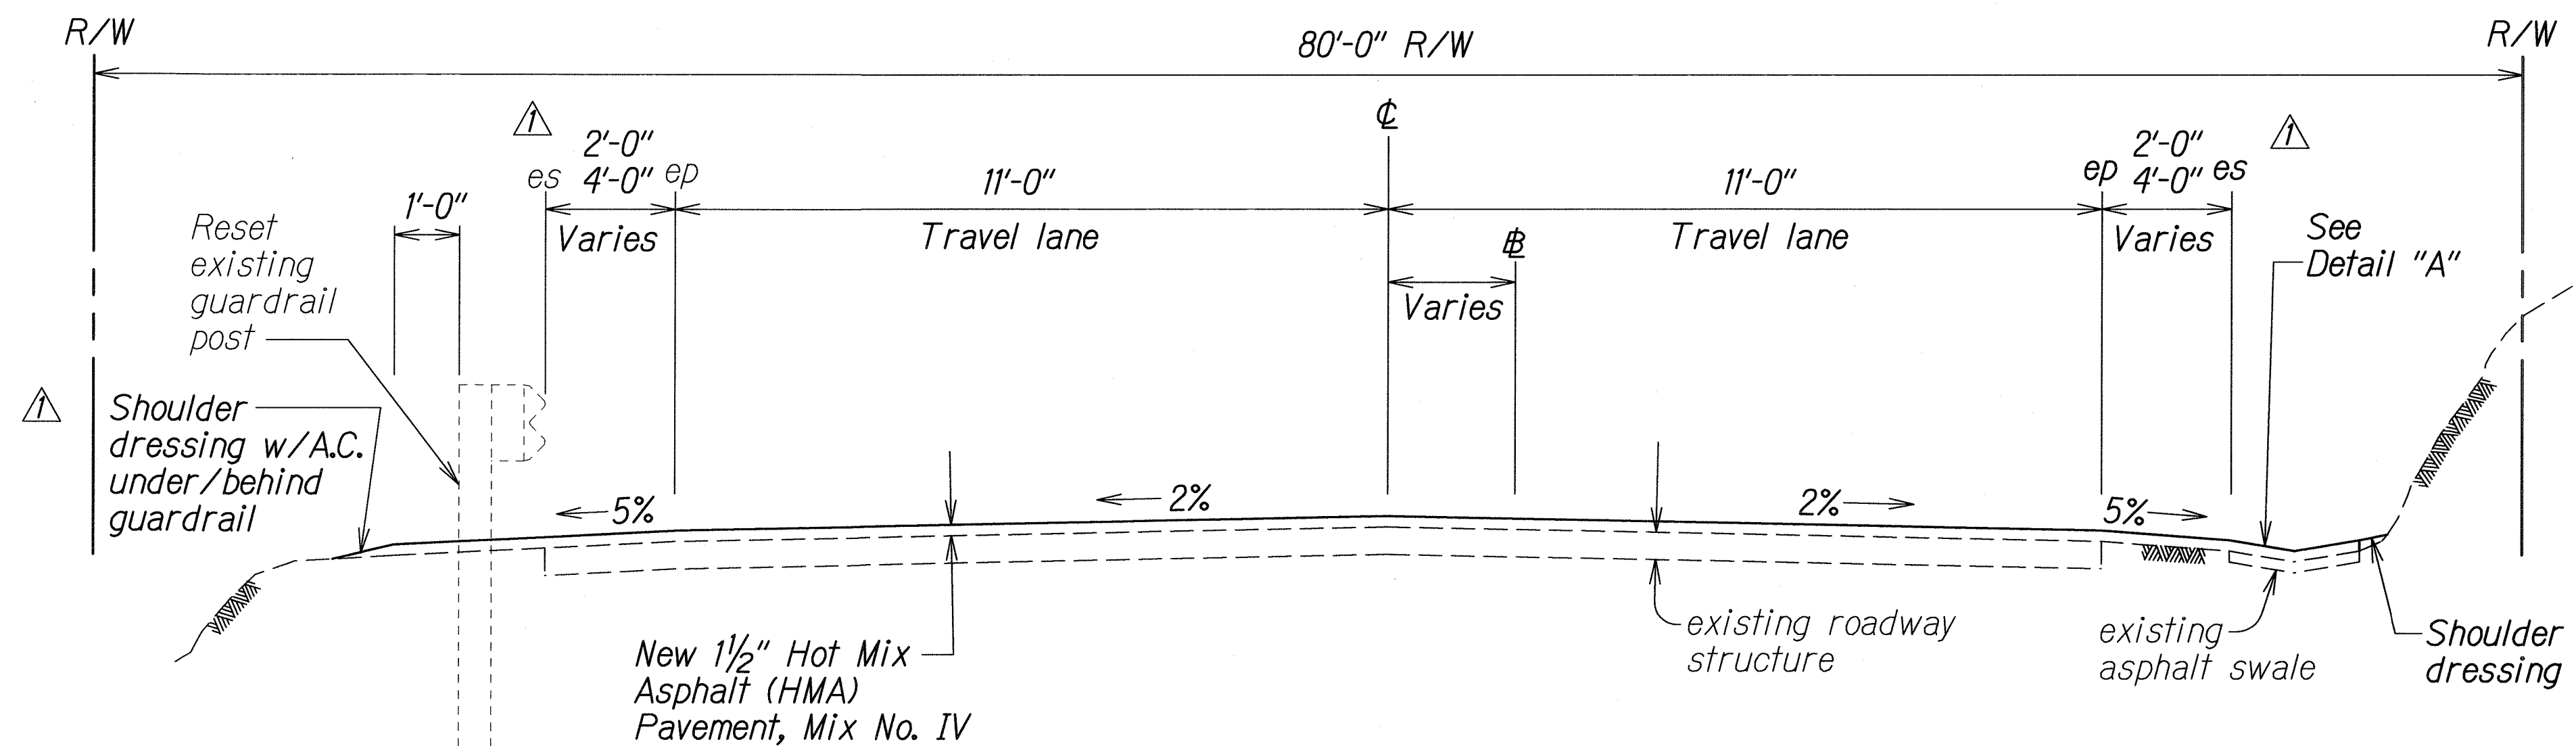

TYPICAL TANGENT SECTION
Scale: 1/2" = 1'-0"

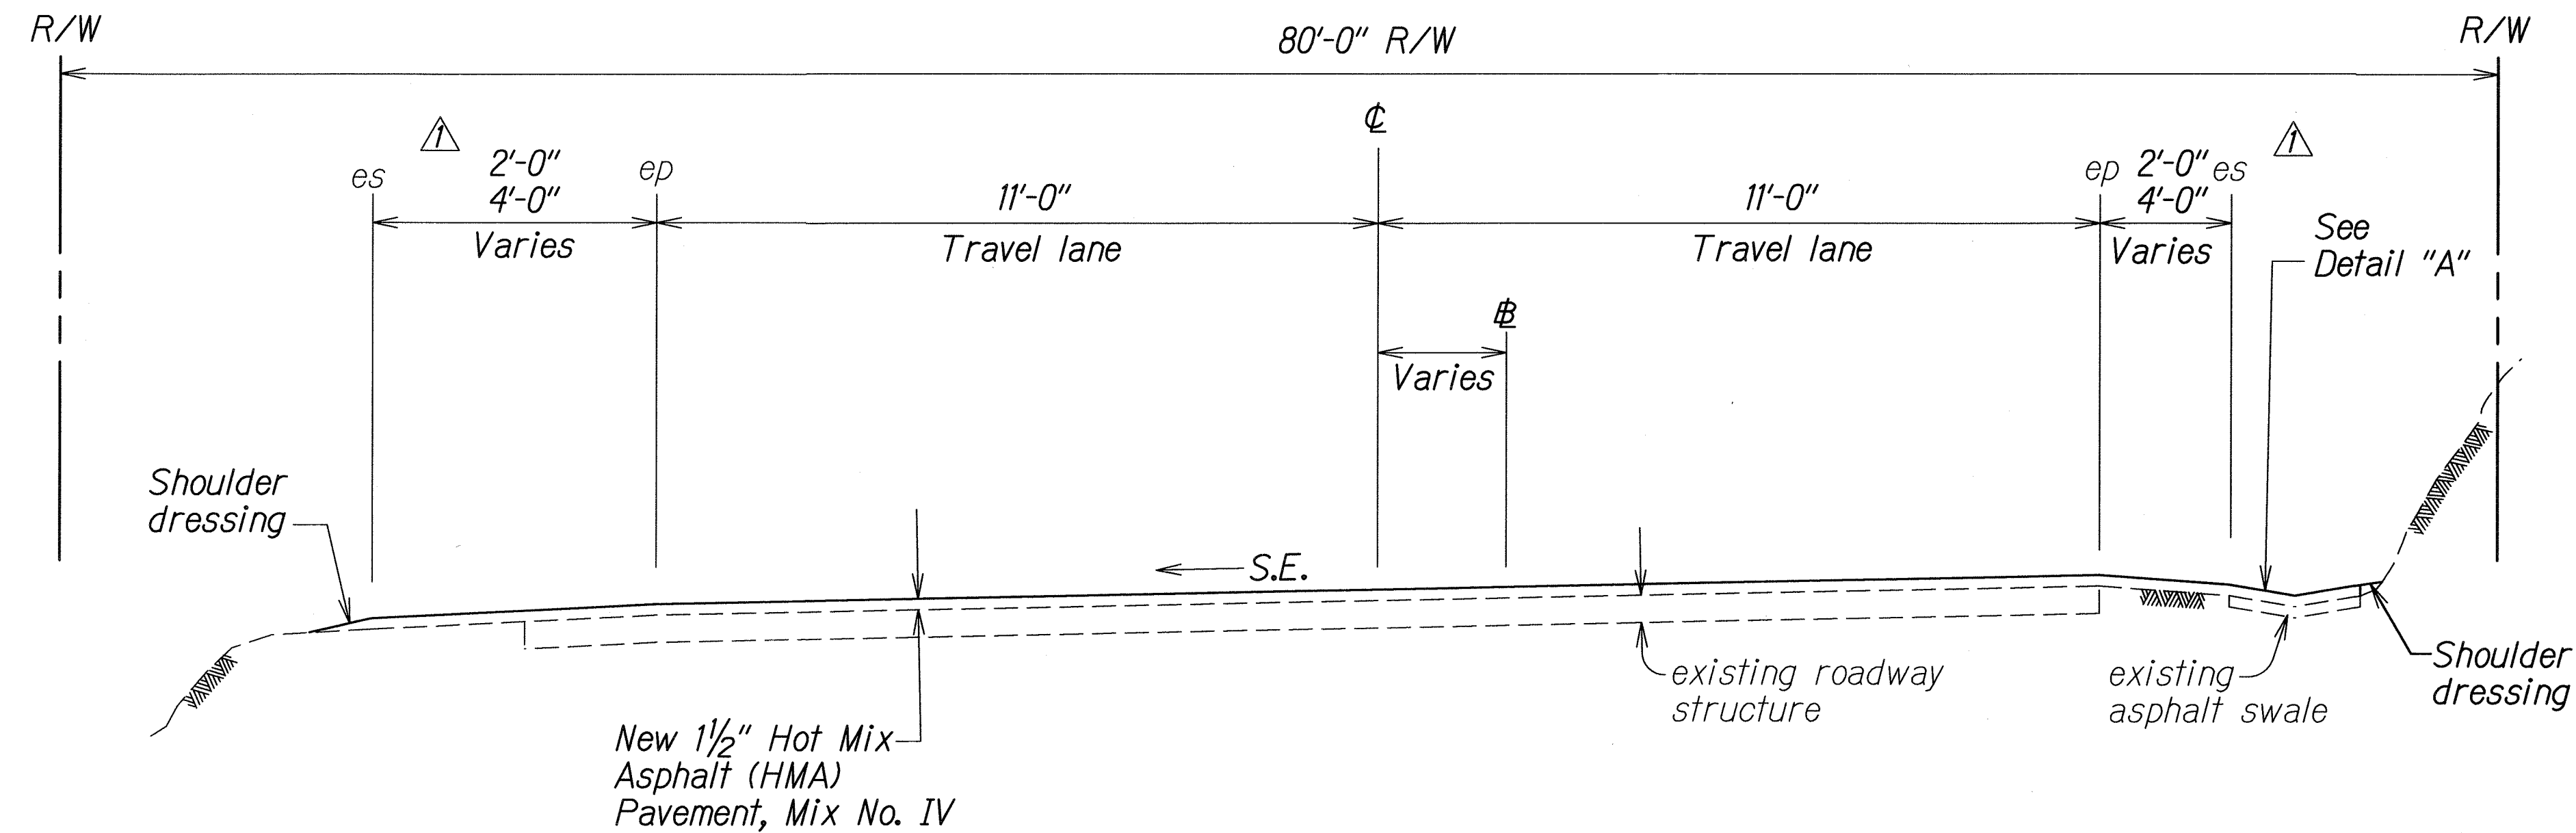


TYPICAL SUPERELEVATED SECTION
Scale: 1/2" = 1'-0"

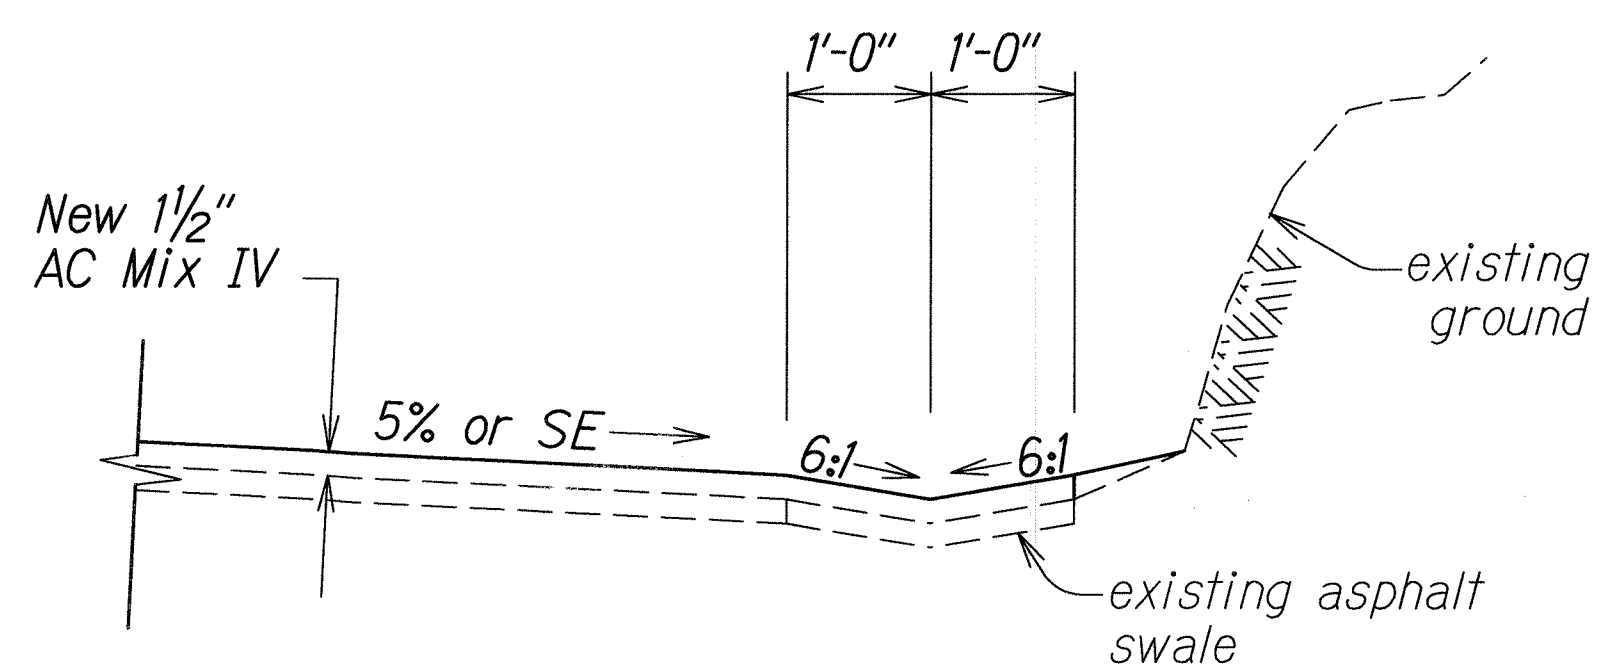

DETAIL "A"
Scale: 3/4" = 1'-0"


NOTE:
A.C. Mix for existing swale overlay shall be paid under A.C. Mix IV

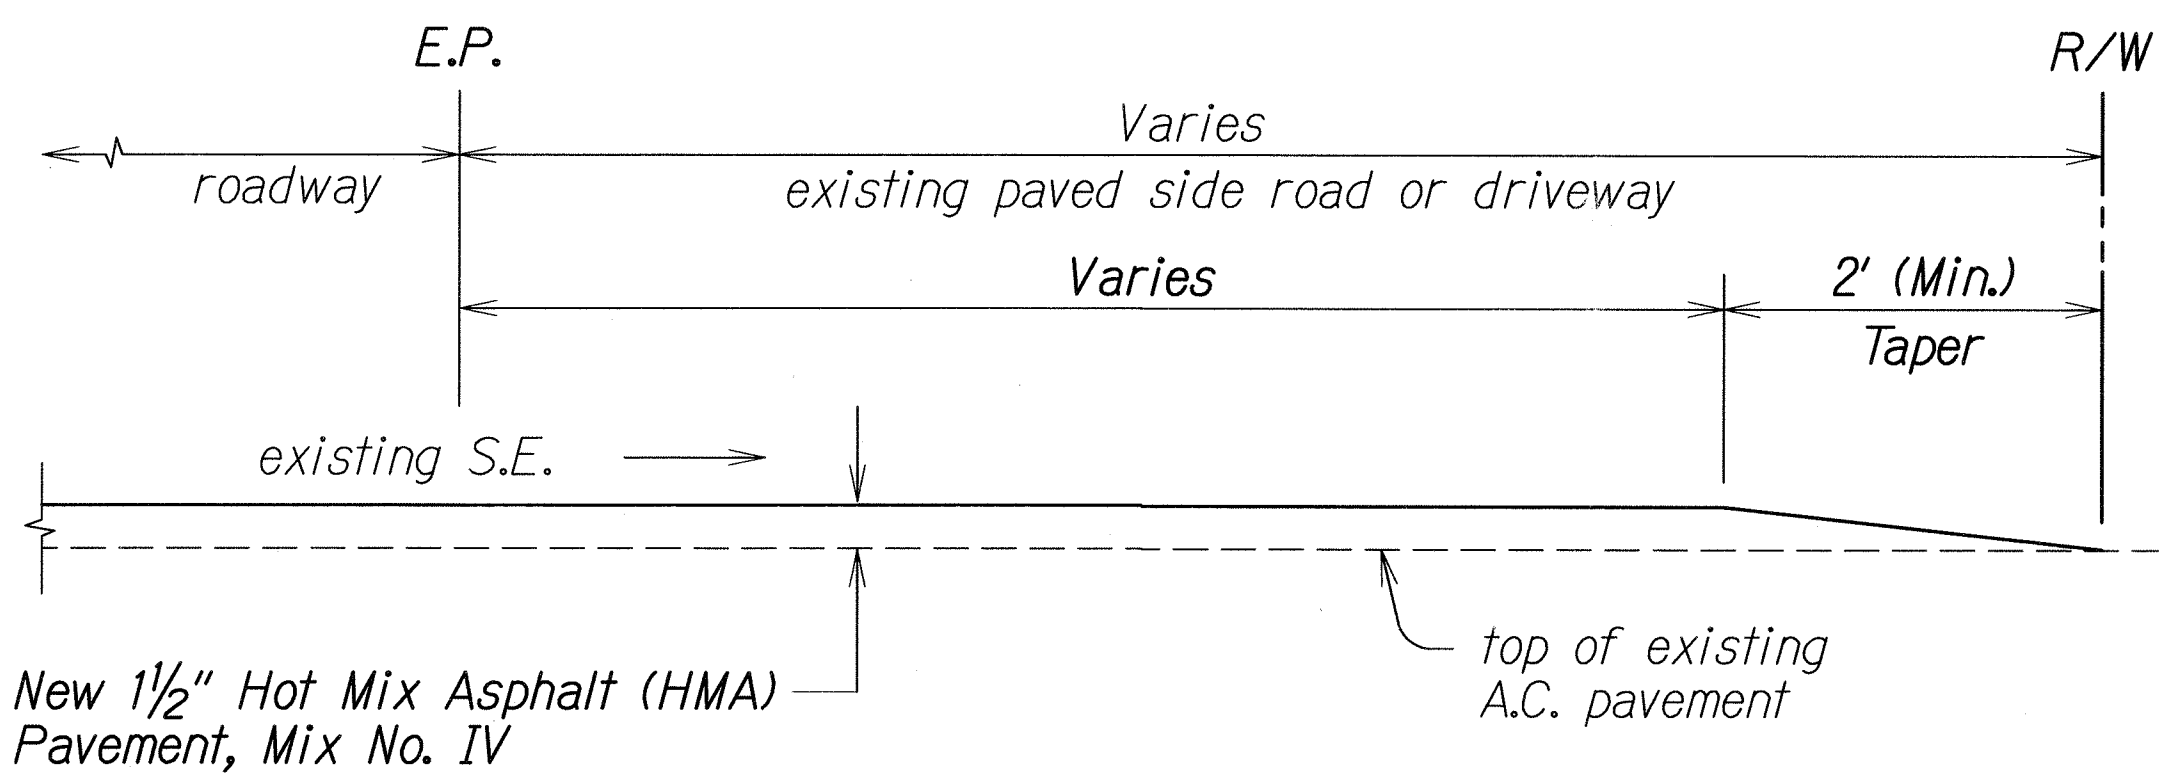

A. C. RESURFACING AT PAVED SIDEROAD OR PAVED DRIVEWAY DETAIL
Not To Scale


6-14-11	Revised Typical Tangent and Superelevated Sections.
DATE	REVISION
STATE OF HAWAII DEPARTMENT OF TRANSPORTATION HIGHWAYS DIVISION	
TYPICAL SECTIONS & DETAILS	
HALEAKALA CRATER ROAD PAVEMENT PREVENTIVE MAINTENANCE	
M.P. 0.00 to M.P. 2.00	
Federal-Aid Project No. STP-0378(003)	
Scale: As Shown	Date: March, 2011
SHEET No. 1 OF 2 SHEETS	

FED. ROAD DIST. NO.	STATE	FED. AID PROJ. NO.	FISCAL YEAR	SHEET NO.	TOTAL SHEETS
HAWAII	HAW.	STP-0378(003)	2011	7	21

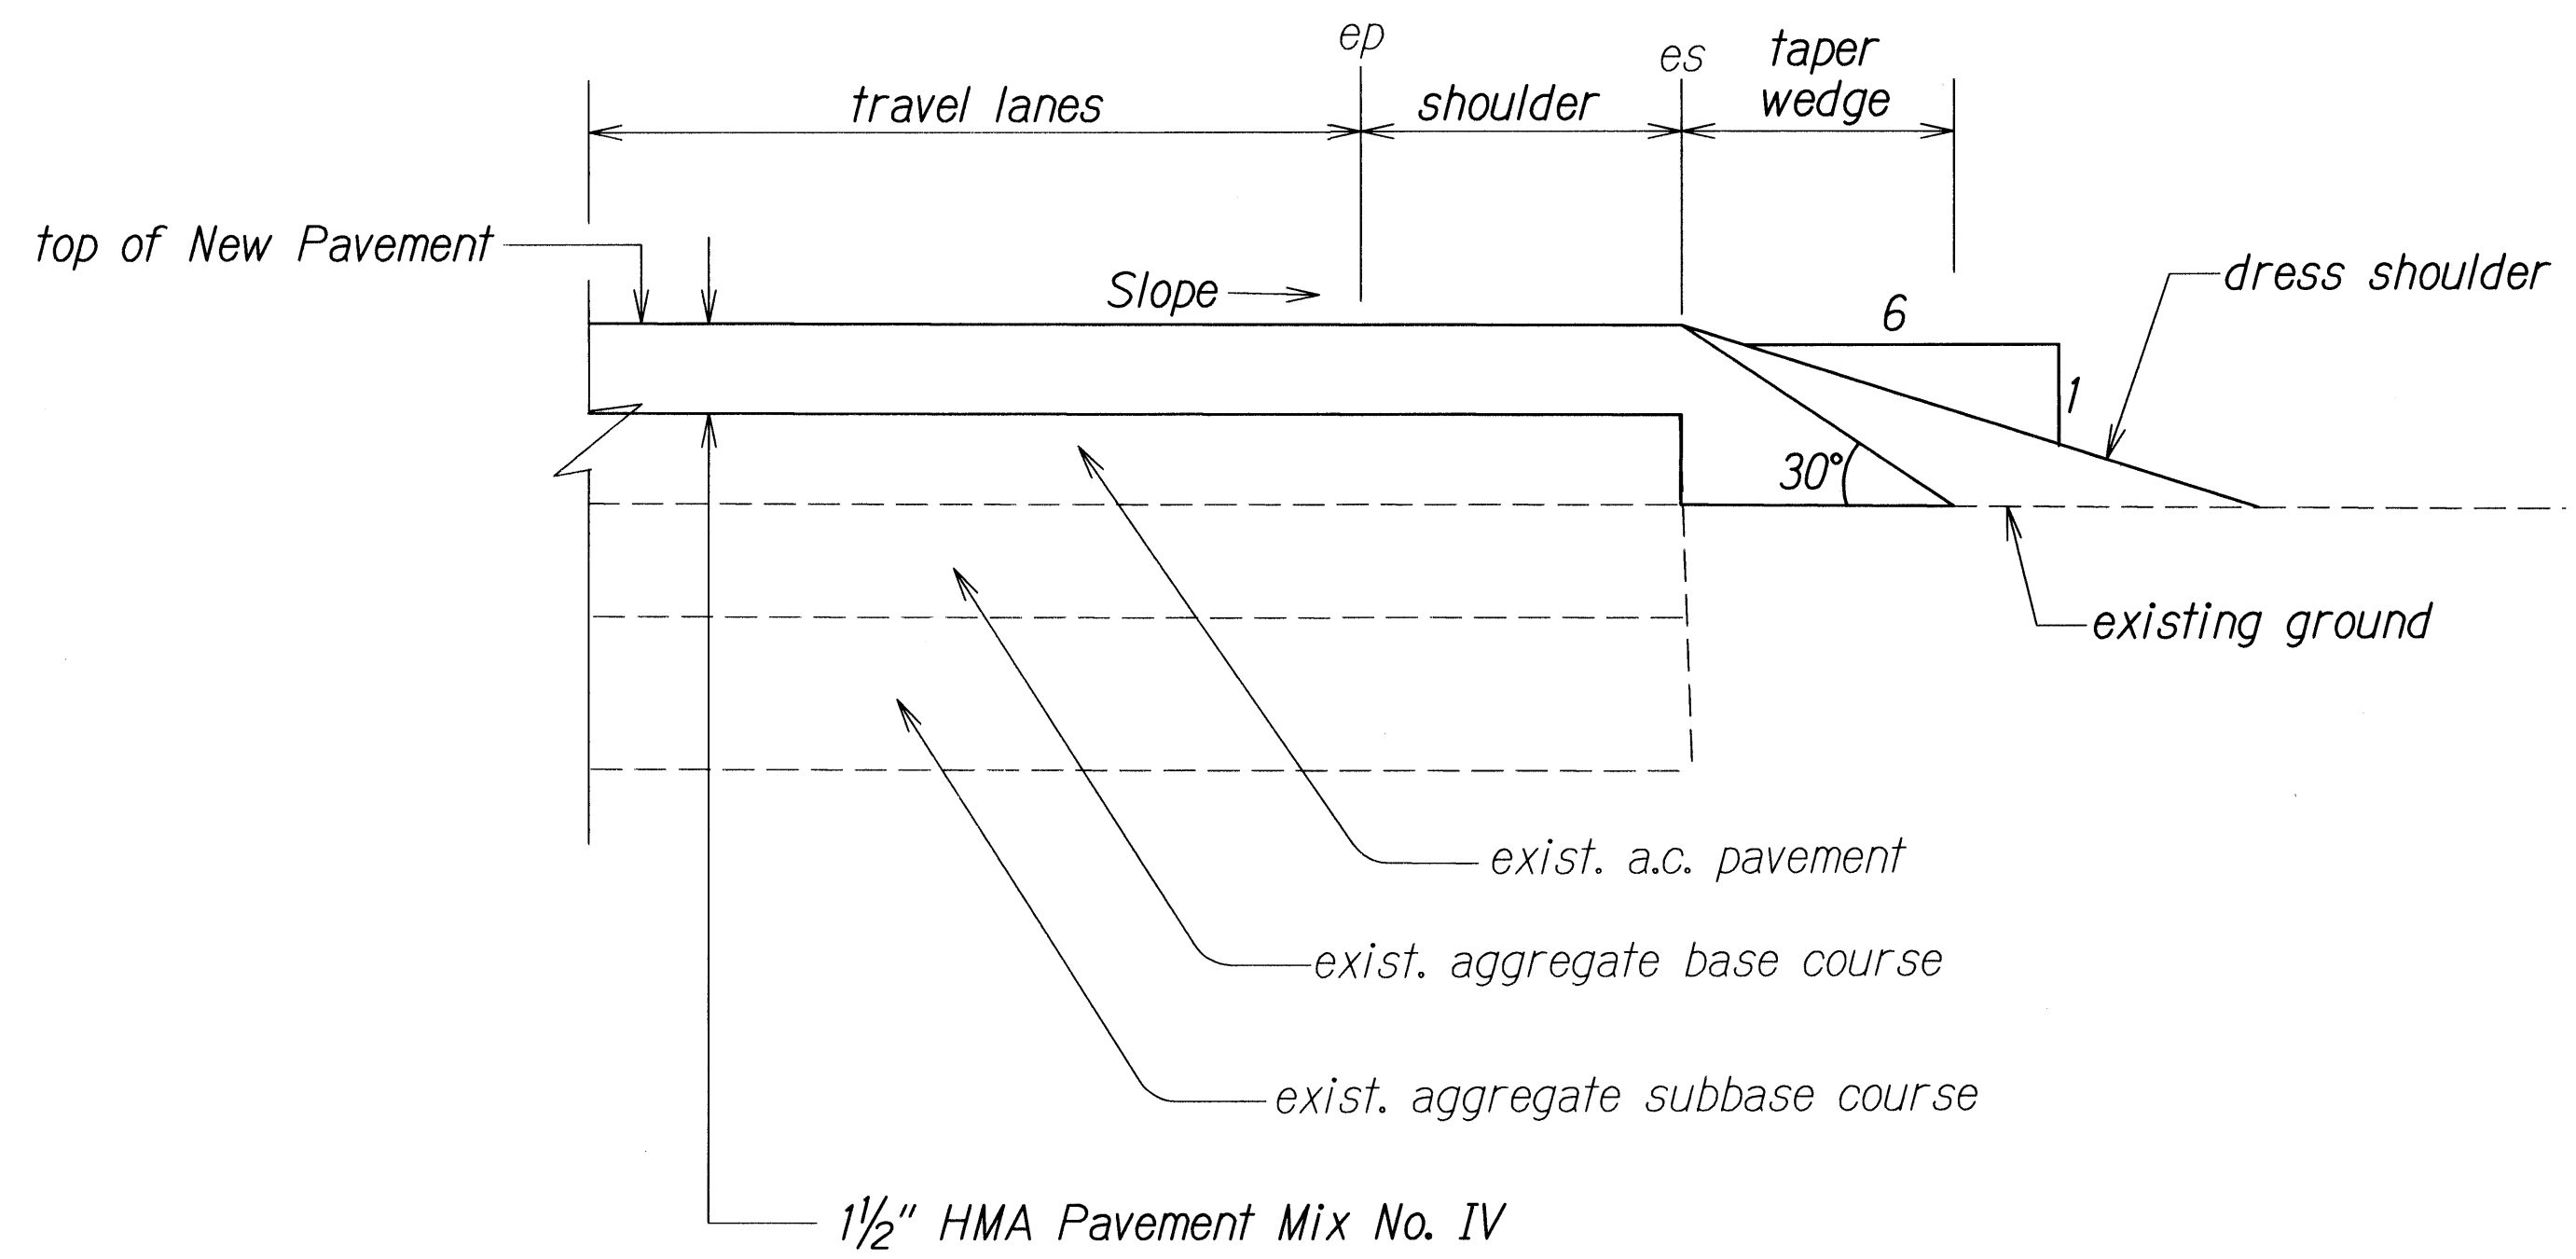


Note: Contractor shall mount a device directly on the paver screed extension to provide a 30° beveled shoulder edge.

TYPICAL PAVEMENT EDGE DETAIL
(FOR OVERLAYING PROJECT)
Not To Scale

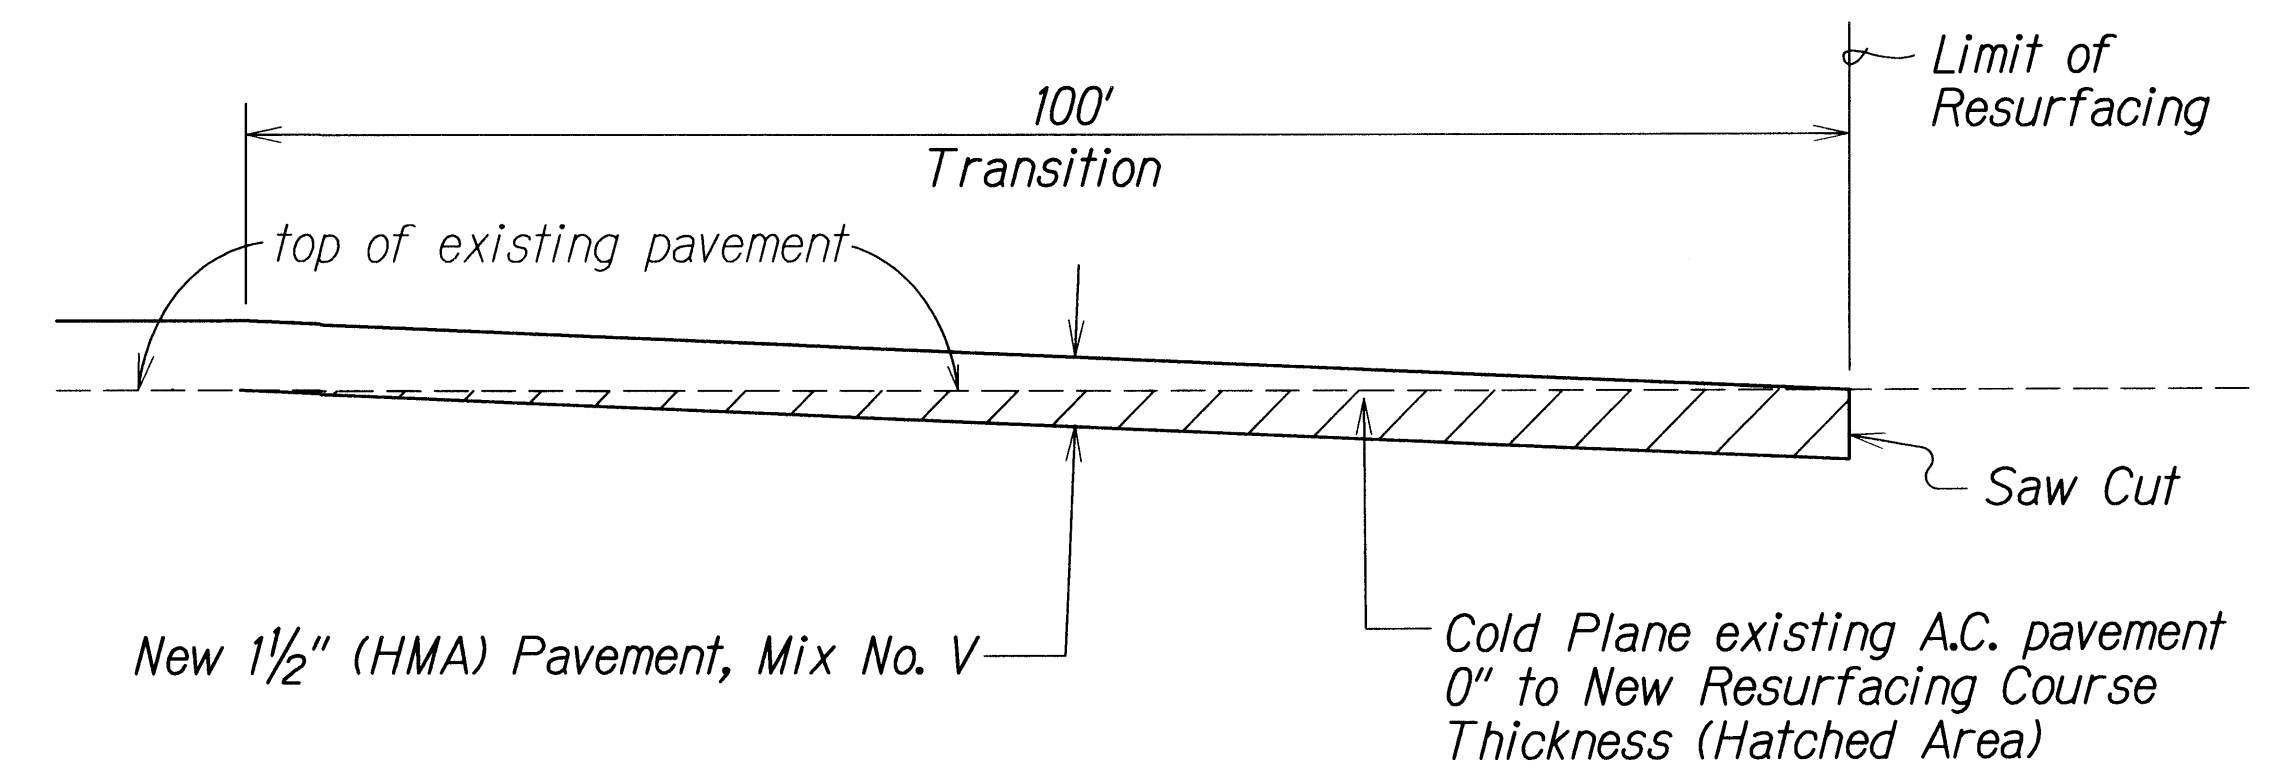

COLD PLANED TRANSITION
TO EXISTING A.C. PAVEMENT
AT BEGINNING AND END OF PROJECT
Not To Scale

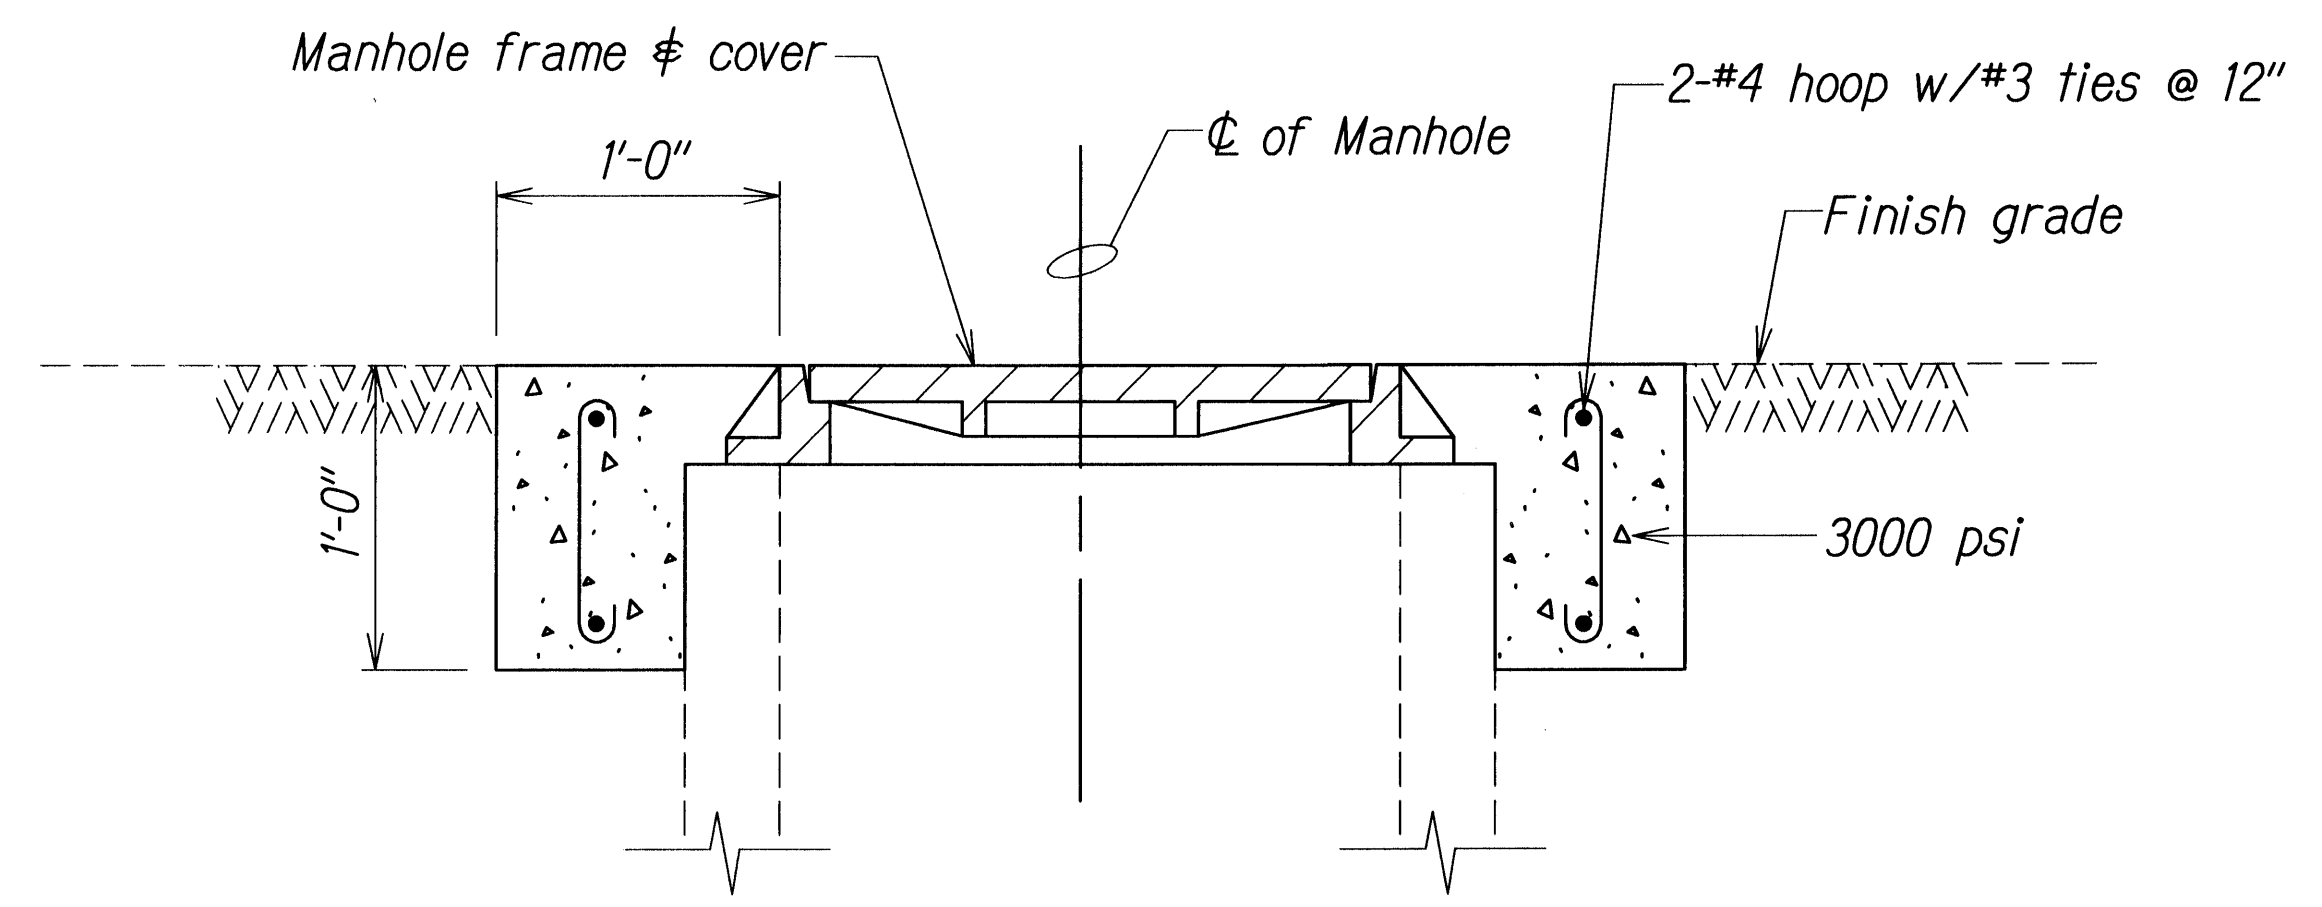

DETAIL - CONCRETE COLLAR FOR
ADJUSTMENTS OF MANHOLES AND VALVE BOX
Not To Scale

ORIGINAL PLAN	SURVEY PLOTTED BY	DATE
NOTE BOOK	DRAWN BY	
DESIGNED BY	QUANTITIES BY	
CHECKED BY		

STATE OF HAWAII
DEPARTMENT OF TRANSPORTATION
HIGHWAYS DIVISION

TYPICAL SECTIONS & DETAILS
HALEAKALA CRATER ROAD PAVEMENT
PREVENTIVE MAINTENANCE
M.P. 0.00 to M.P. 2.00
Federal-Aid Project No. STP-0378(003)
Scale: As Shown Date: March, 2011

SHEET No. 2 OF 2 SHEETS