	INDEX TO DRAWINGS	
SHEET NO.	DESCRIPTION	
1	TITLE SHEET	
2	STANDARD PLANS SUMMARY	
3	GENERAL NOTES AND LEGEND	
4 – 5	WATER POLLUTION & EROSION CONTROL NOTES	
6	TYPICAL SECTIONS & DETAILS	
7 – 10	ROADWAY PLANS	

#### STATE OF HAWAII

## DEPARTMENT OF TRANSPORTATION

HIGHWAYS DIVISION HONOLULU, HAWAII


## "AS-BUILT"


PLANS FOR

# HALEAKALA CRATER ROAD

BICYCLE PULLOUT AREAS
FEDERAL-AID PROJECT NO. STP-0378(2)

DISTRICT OF MAKAWAO
ISLAND OF MAUI

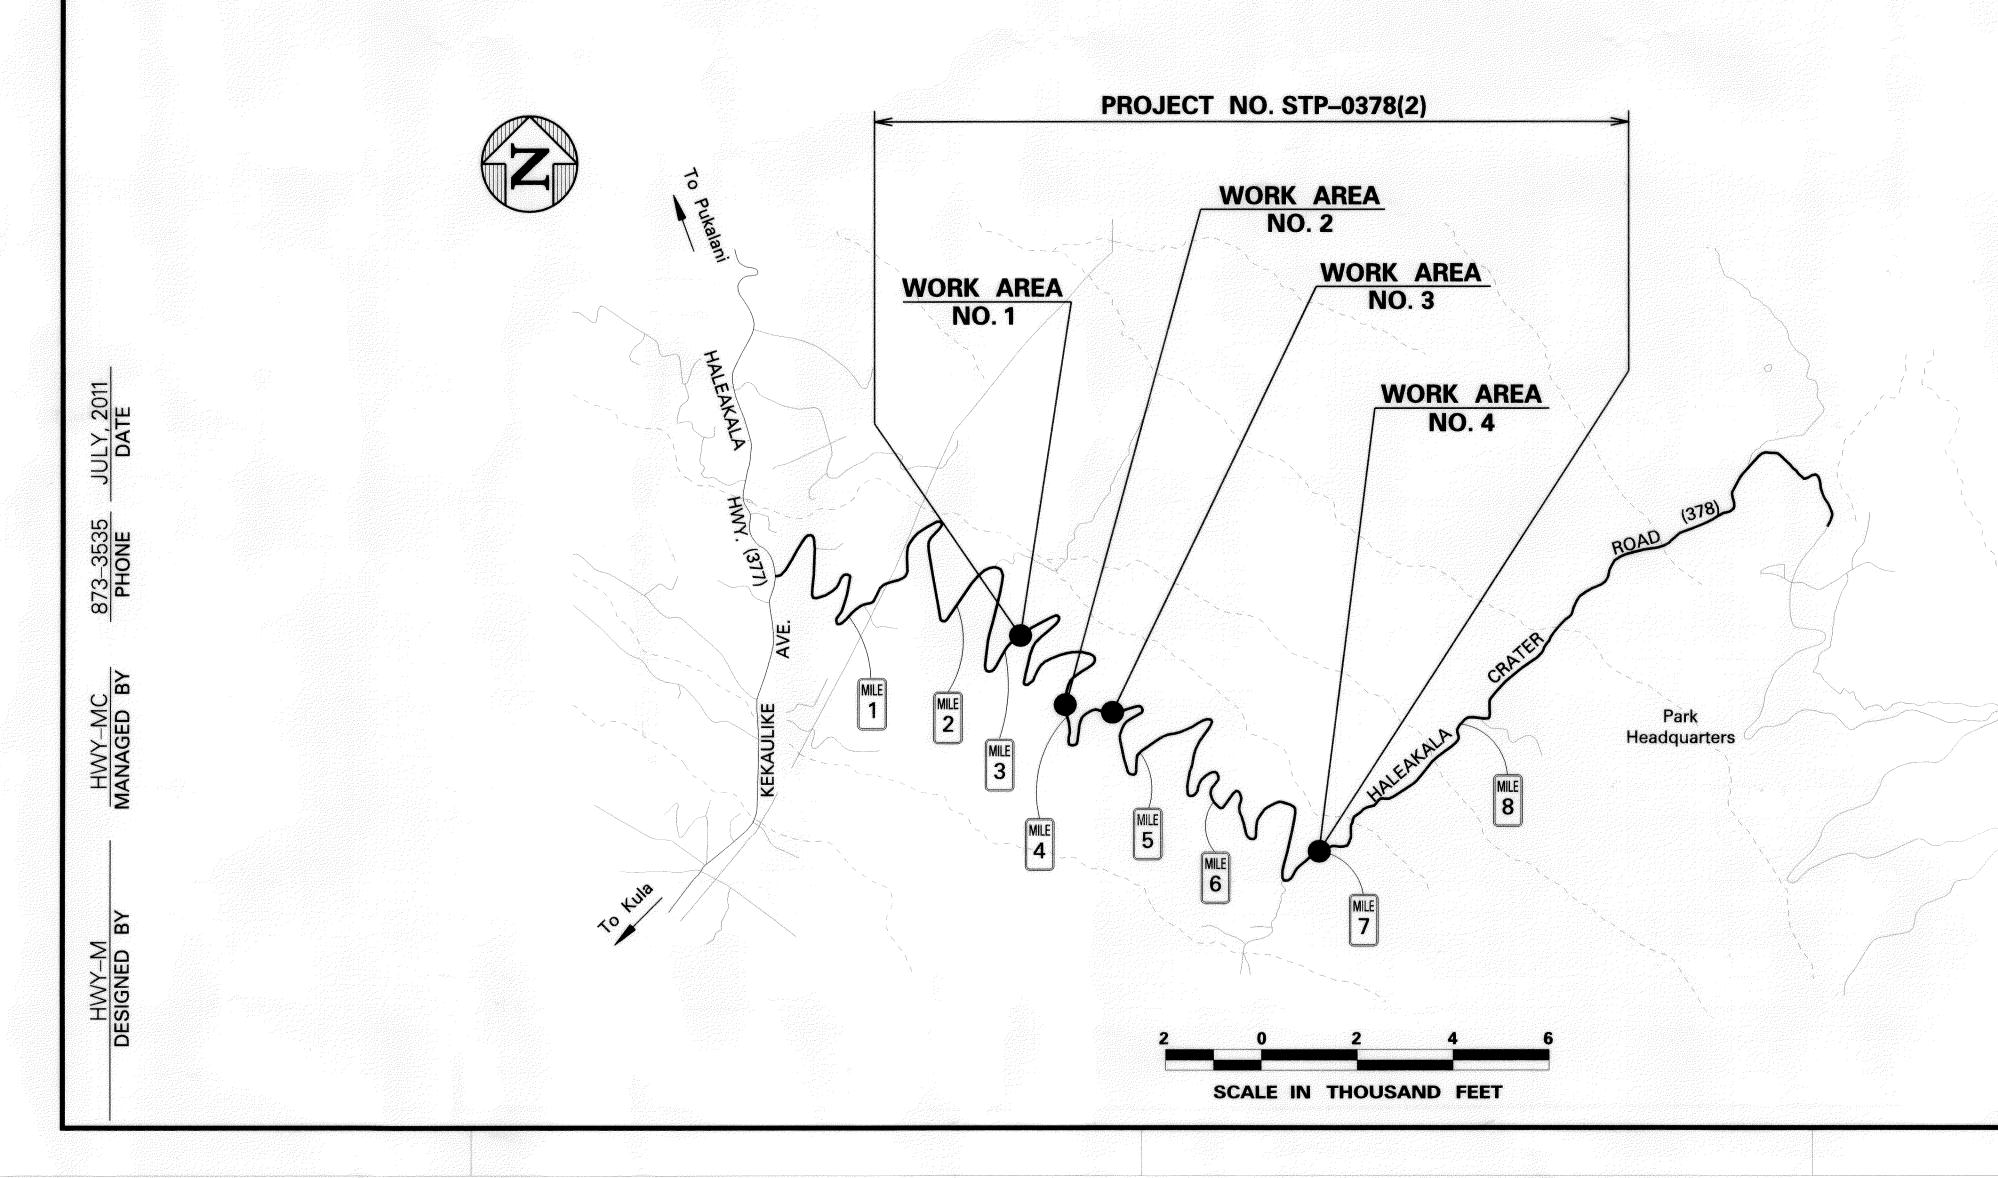

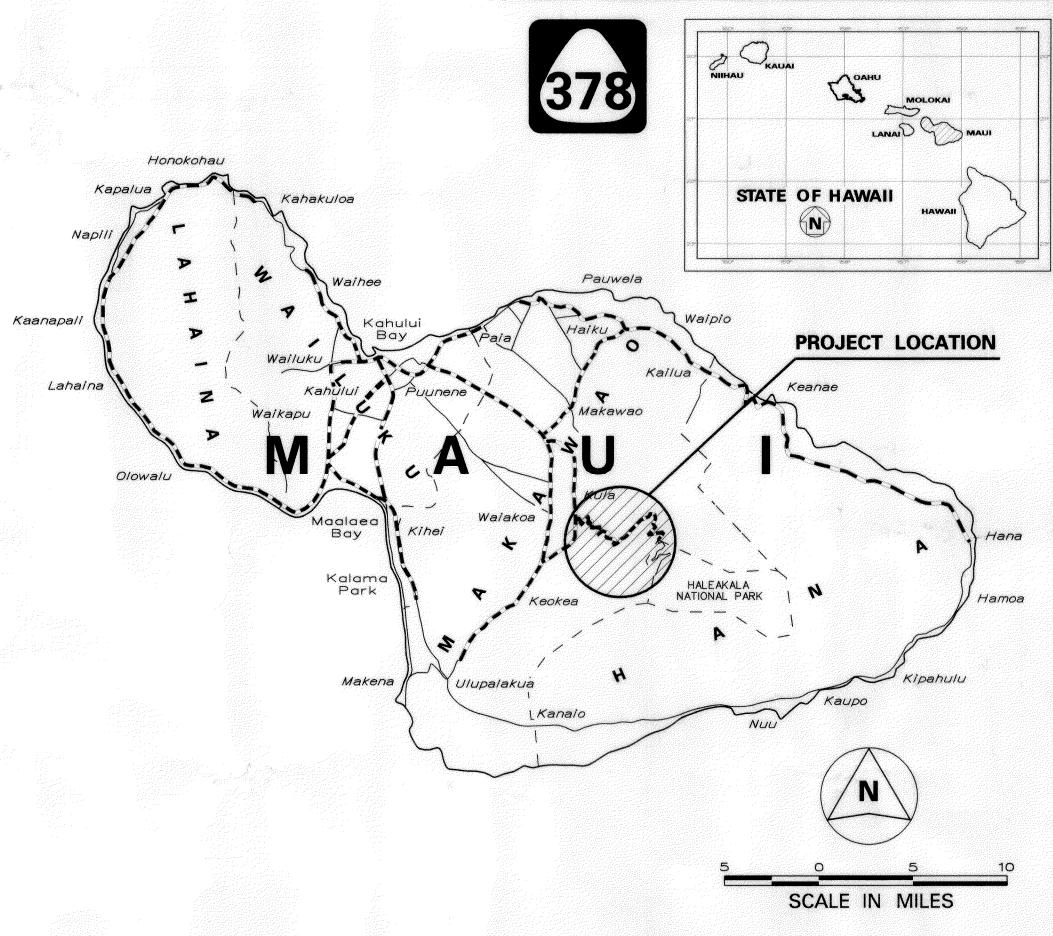

---- FEDERAL AID PROJECTS PREVIOUSLY CONSTRUCTED OR UNDER CONSTRUCTION

FED. AID PROJ. NO.

WORK AREA NO. 1 MILE POST 3.00
WORK AREA NO. 2 MILE POST 4.00
WORK AREA NO. 3 MILE POST 4.37
WORK AREA NO. 4 MILE POST 7.00

#### DESIGN DESIGNATION

ADT (2011).	1,700
ADT (2021).	1,900
DHV	
	9.5
DESIGN D.	65/38
T <sub>24</sub>	5.5

CHANGES MADE DURING CONSTRUCTION HAVE BEEN INCORPORATED ON THESE PLANS EXCEPT CHANGES IN THE ORIGINAL THEORETICAL QUANTITIES. FOR ACTUAL QUANTITIES, REFER TO PROJECT LEDGER AND/OR COMPUTATION BOOK.

RESIDENT ENGINEER DATE

DEPARTMENT OF TRANSPORTATION STATE OF HAWAII APPROVED:

JOHN A DALLY TO DIR. OF TRANSPORTATION

TATION DATE