




FED. ROAD DIST. NO.	STATE	FEDERAL AID PROJ. NO.	FISCAL YEAR	SHEET NO.	TOTAL SHEETS
HAWAII	HAW.	STP-0378(004)	2022	2	24

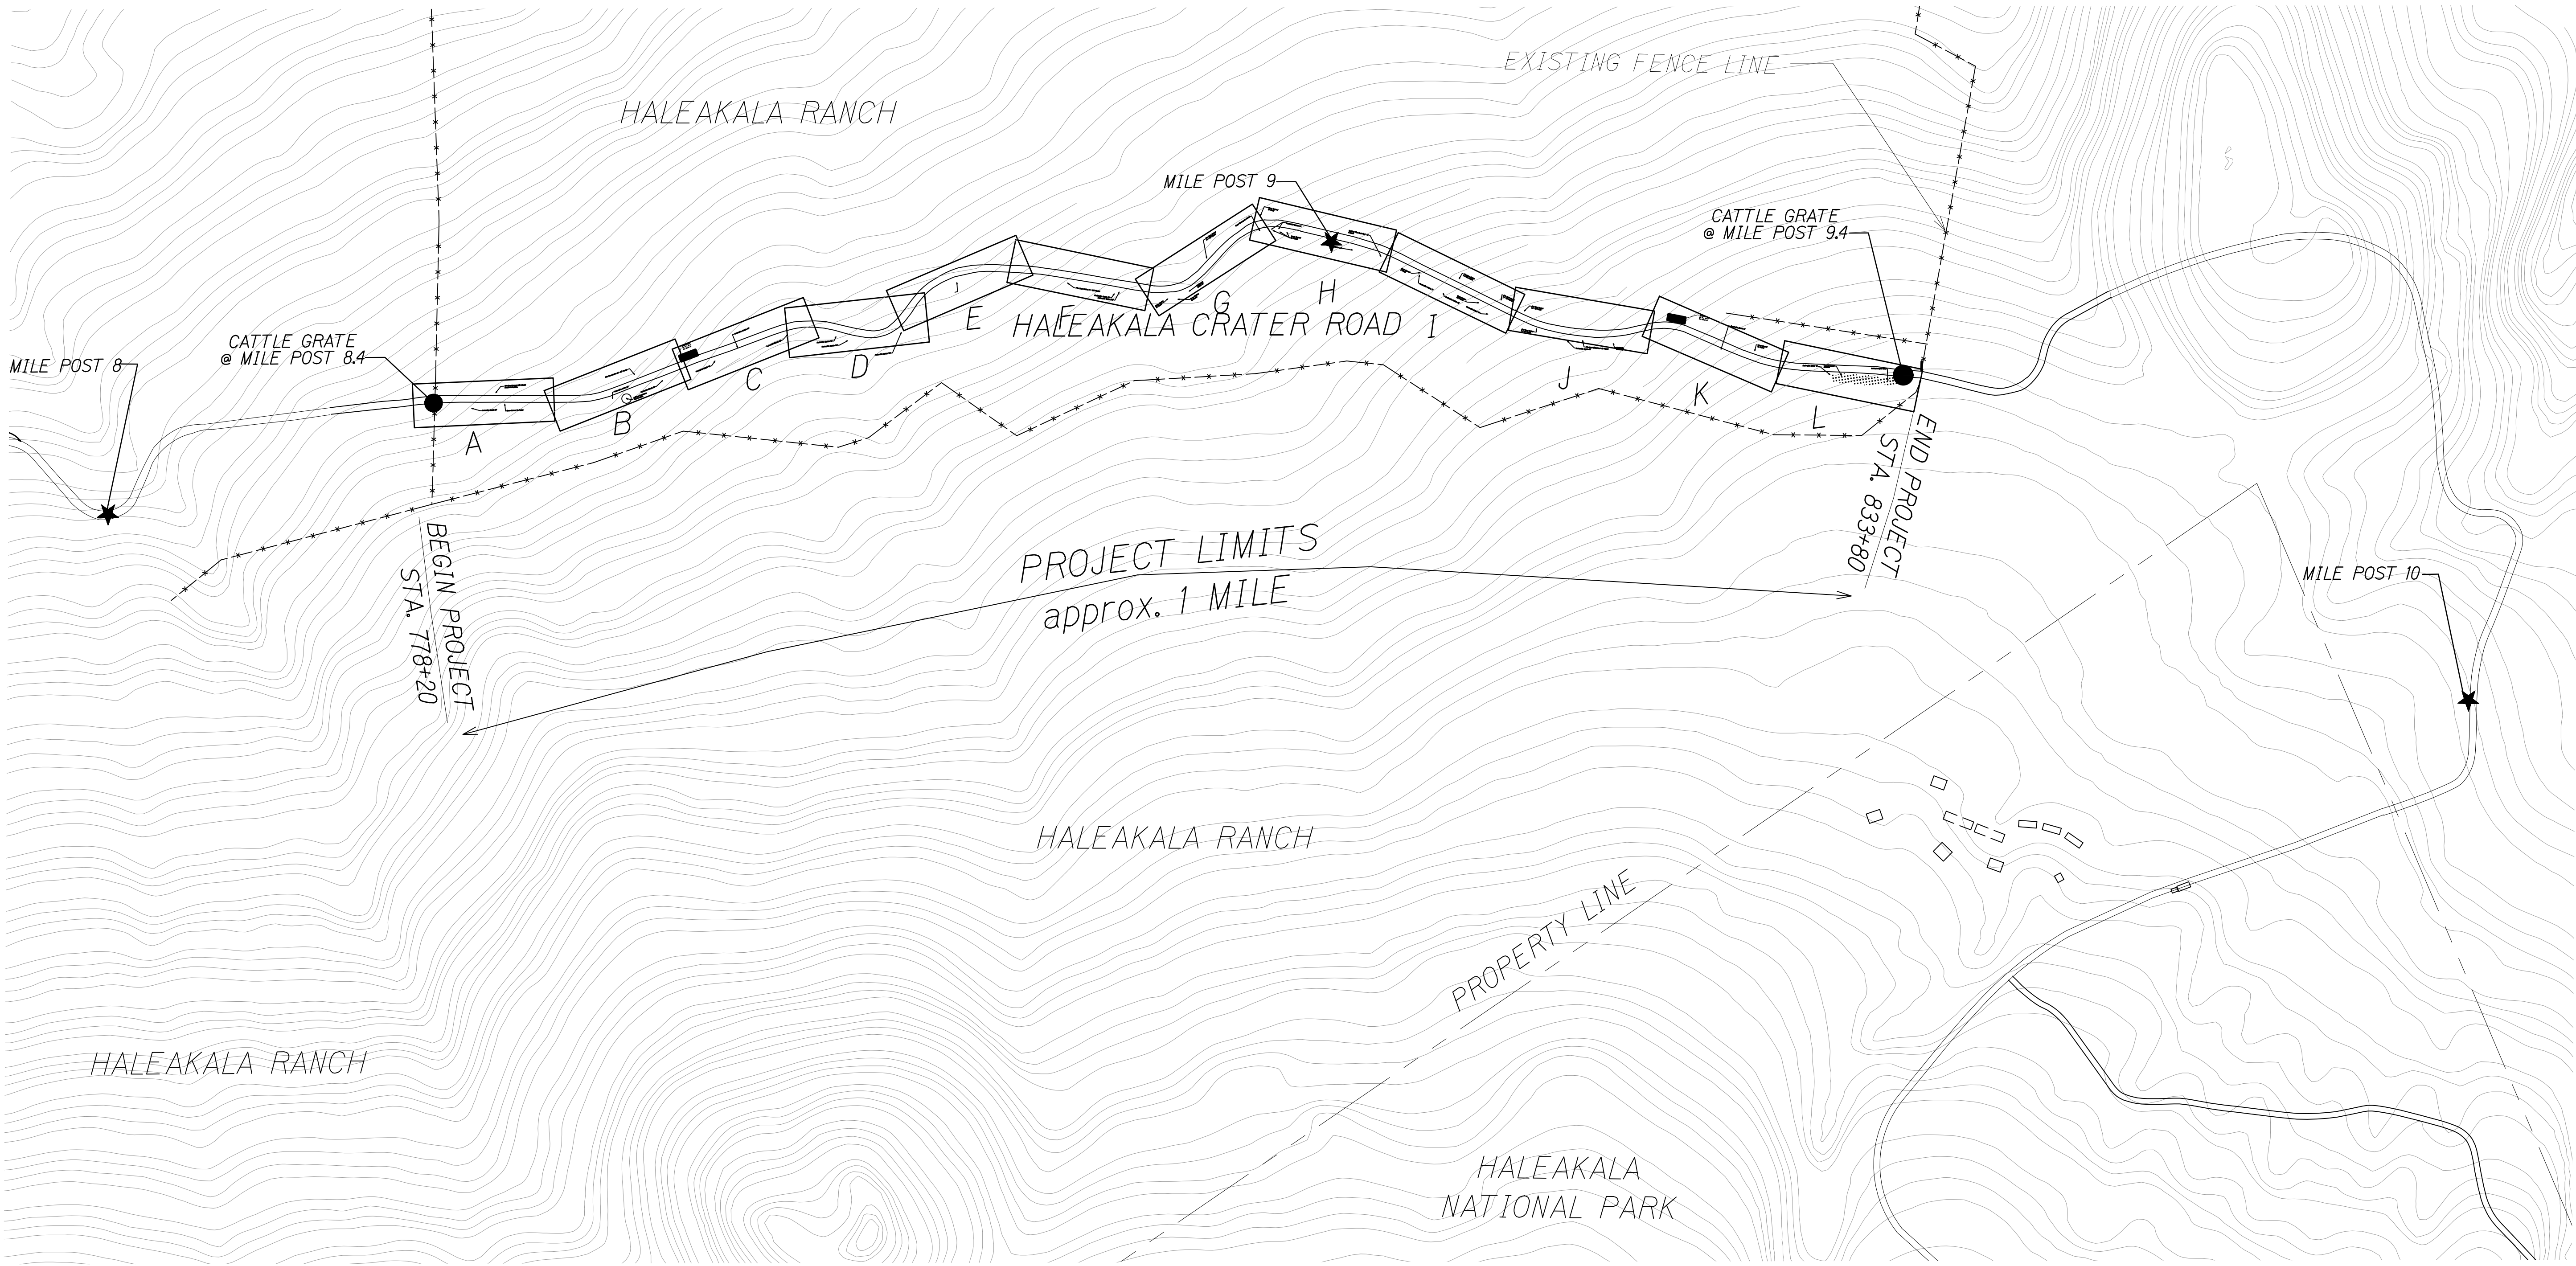

ORIGINAL SURVEY PLOTTED BY _____	DATE _____
PLAN DRAWN BY _____	DESIGNED BY _____
NOTE BOOK TRACED BY _____	QUANTITIES BY _____
No. _____	CHECKED BY _____

GENERAL SITE LAYOUT PLAN

Scale: 1"=300'

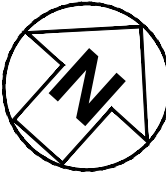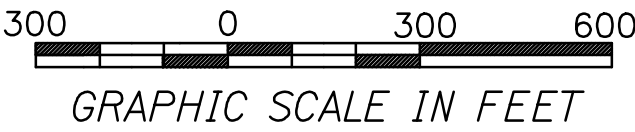



RICHARD L. QUINN
LICENSED PROFESSIONAL
LANDSCAPE ARCHITECT
No. 6028
HAWAII U.S.A.

[Signature]
EXPIRATION OF LICENSE: 04/30/2024

THIS WORK WAS PREPARED BY ME OR UNDER MY SUPERVISION AND CONSTRUCTION OF THIS PROJECT WILL BE UNDER MY OBSERVATION. (SEC. 10-115.9 DEPARTMENT OF COMMERCE AND CONSUMER AFFAIRS)

STATE OF HAWAII
DEPARTMENT OF TRANSPORTATION
HIGHWAYS DIVISION

GENERAL SITE LAYOUT PLAN

HALEAKALA CRATER ROAD LANDSCAPE RESTORATION

Federal-Aid Project No. STP-0378(004)

Scale: As Noted Date: Aug. 2021