
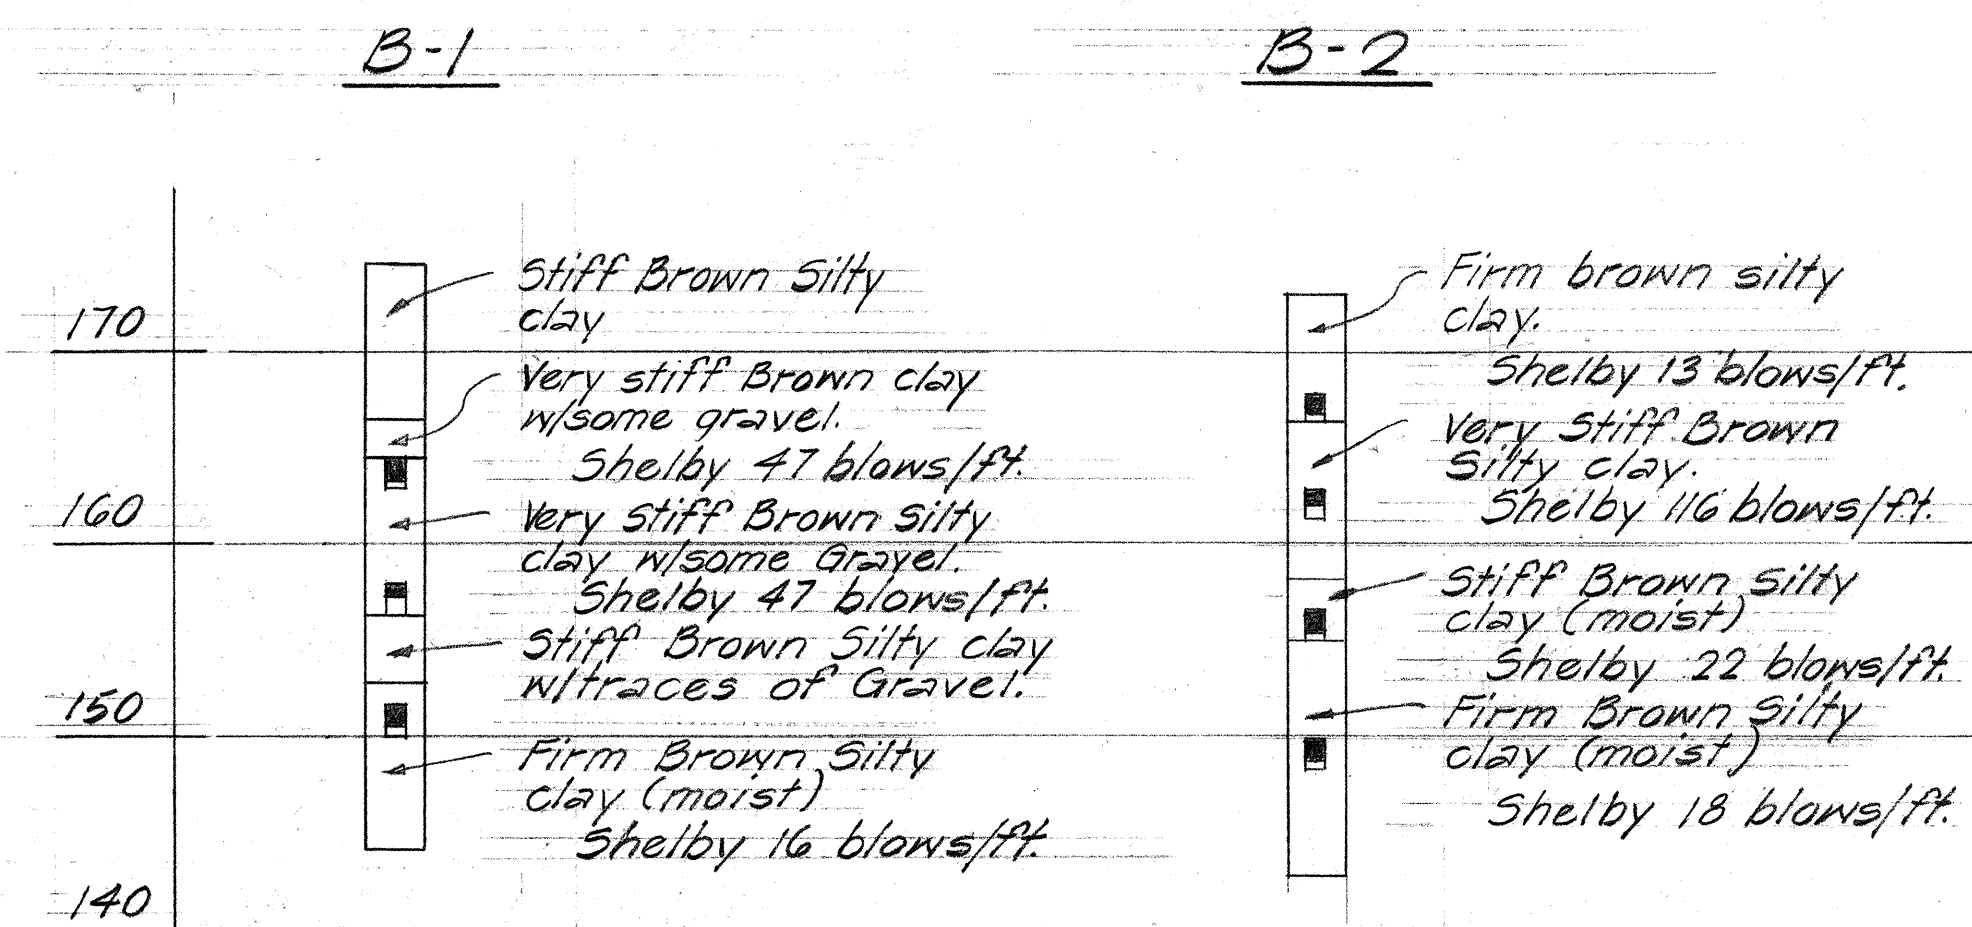





FED. ROAD DIST. NO.	STATE	FED. AID PROJ. NO.	FISCAL YEAR	SHEET NO.	TOTAL SHEETS
HAWAII	HAW.	S-0380(6)	1967	47	87

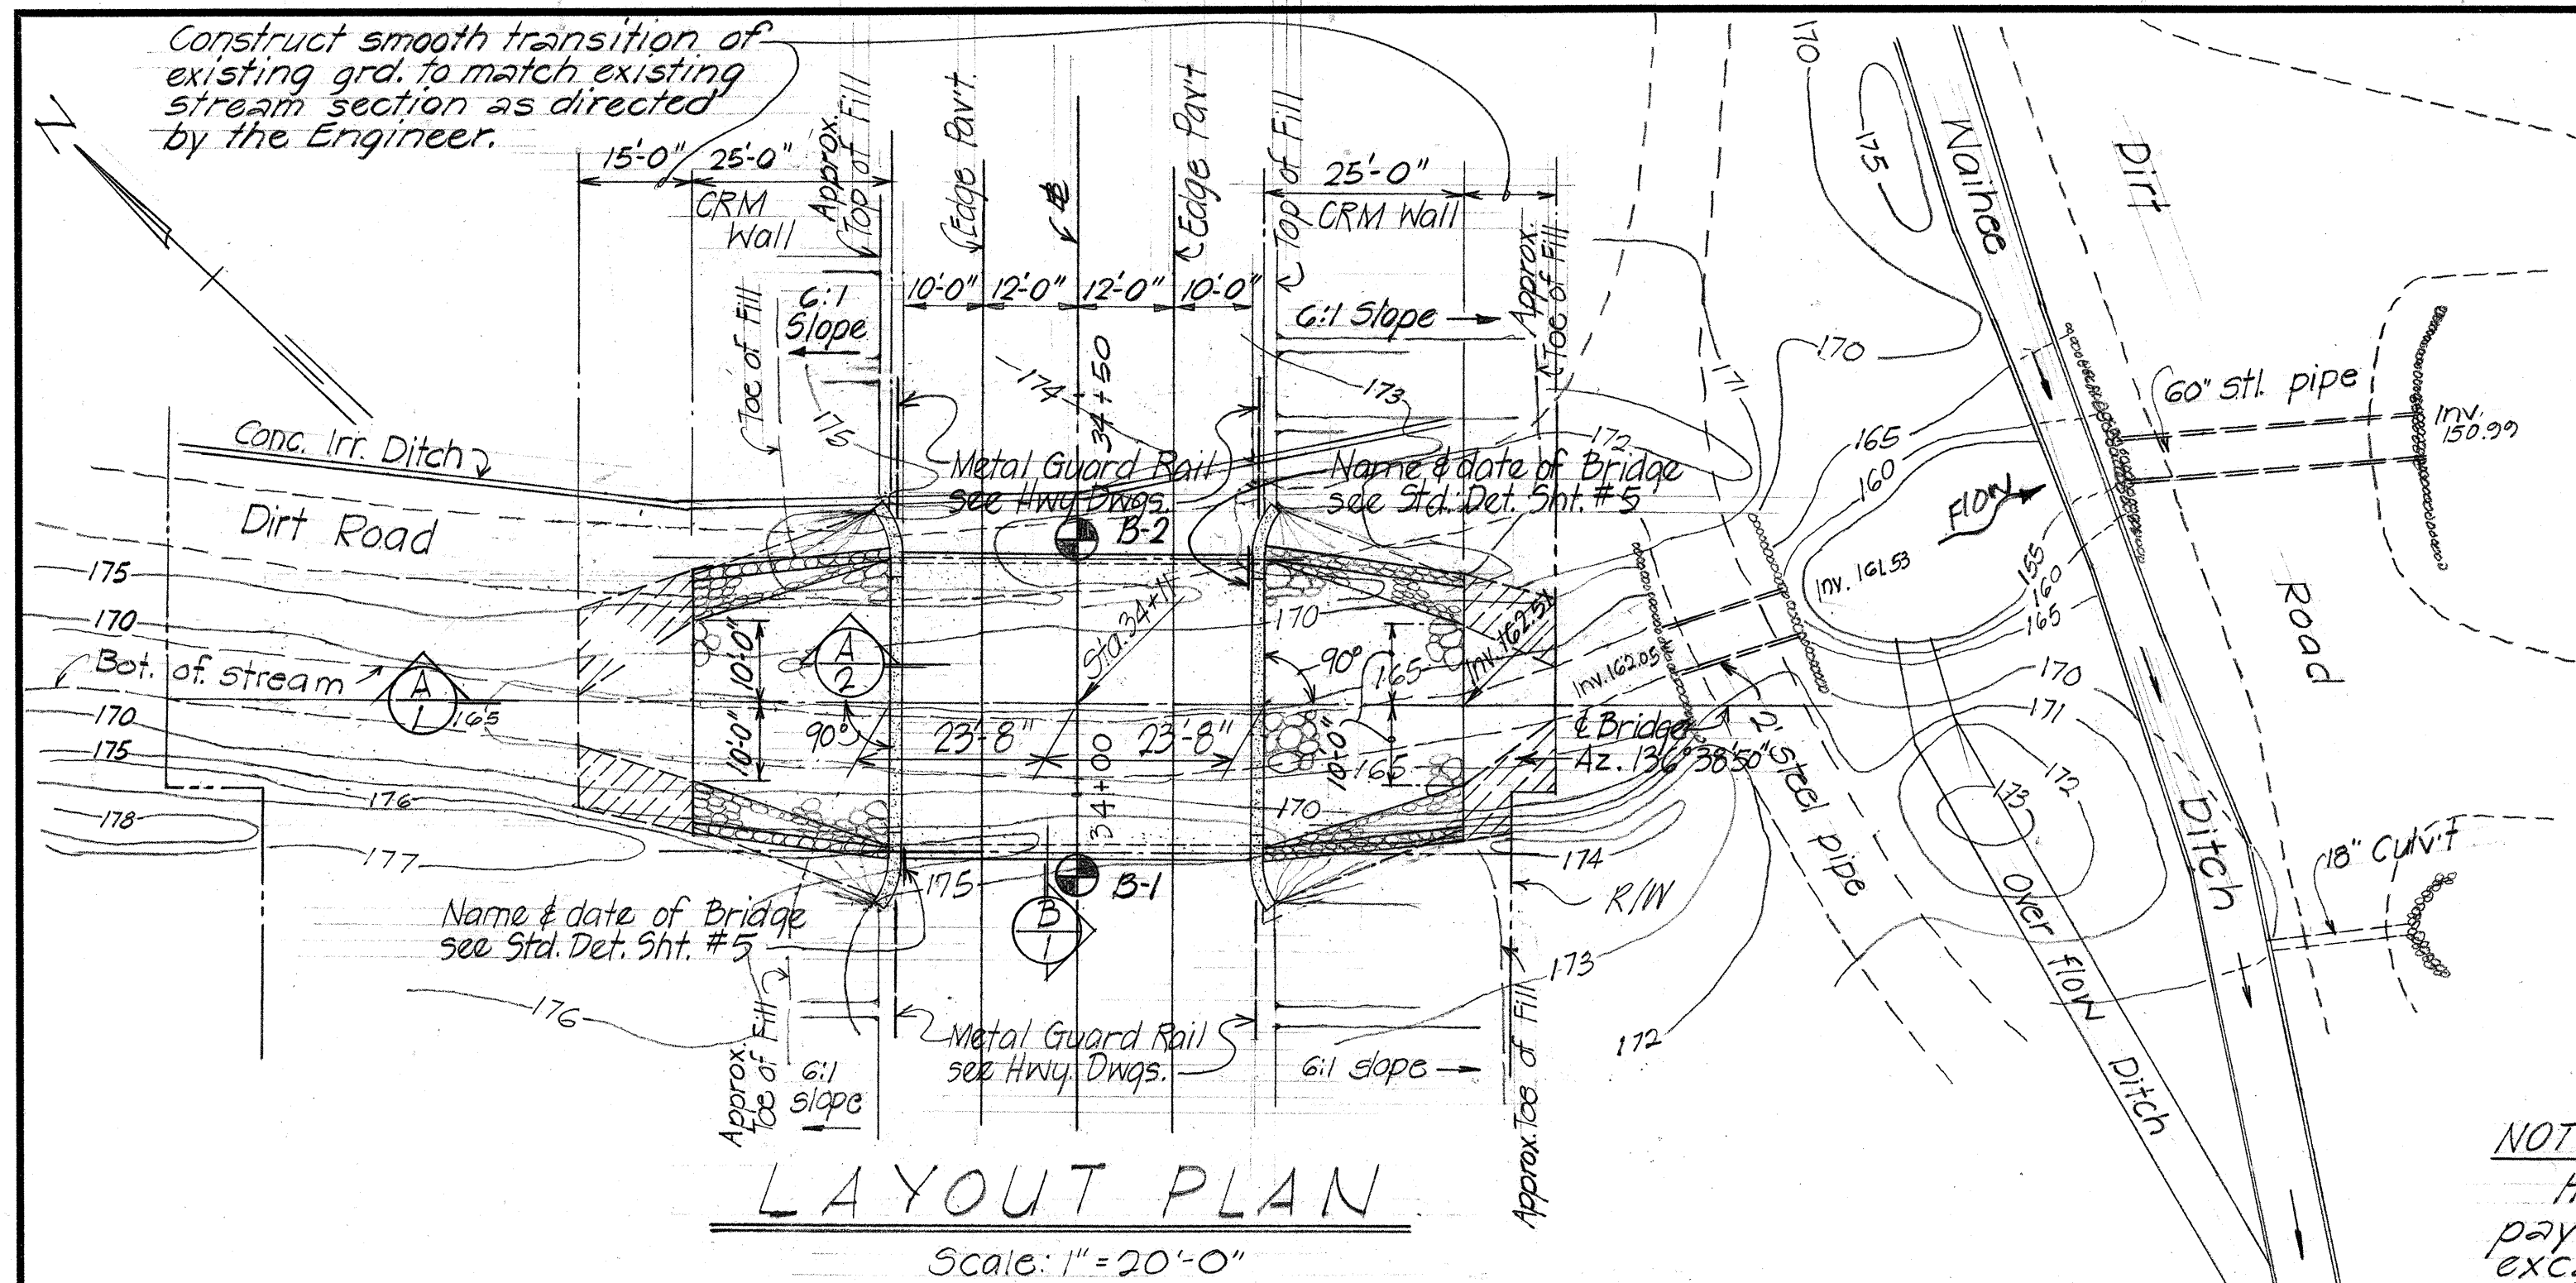

LOG OF BORINGS

NOTE:
Hatched area denotes pay limits of structural excavation.
Hatched area denotes pay limits of channel excavation.

NOTE:
Refer to Waihee Stream Bridge - Sht. # 1 for applicable General Notes.
Hand finish will be permitted for deck surface finish.

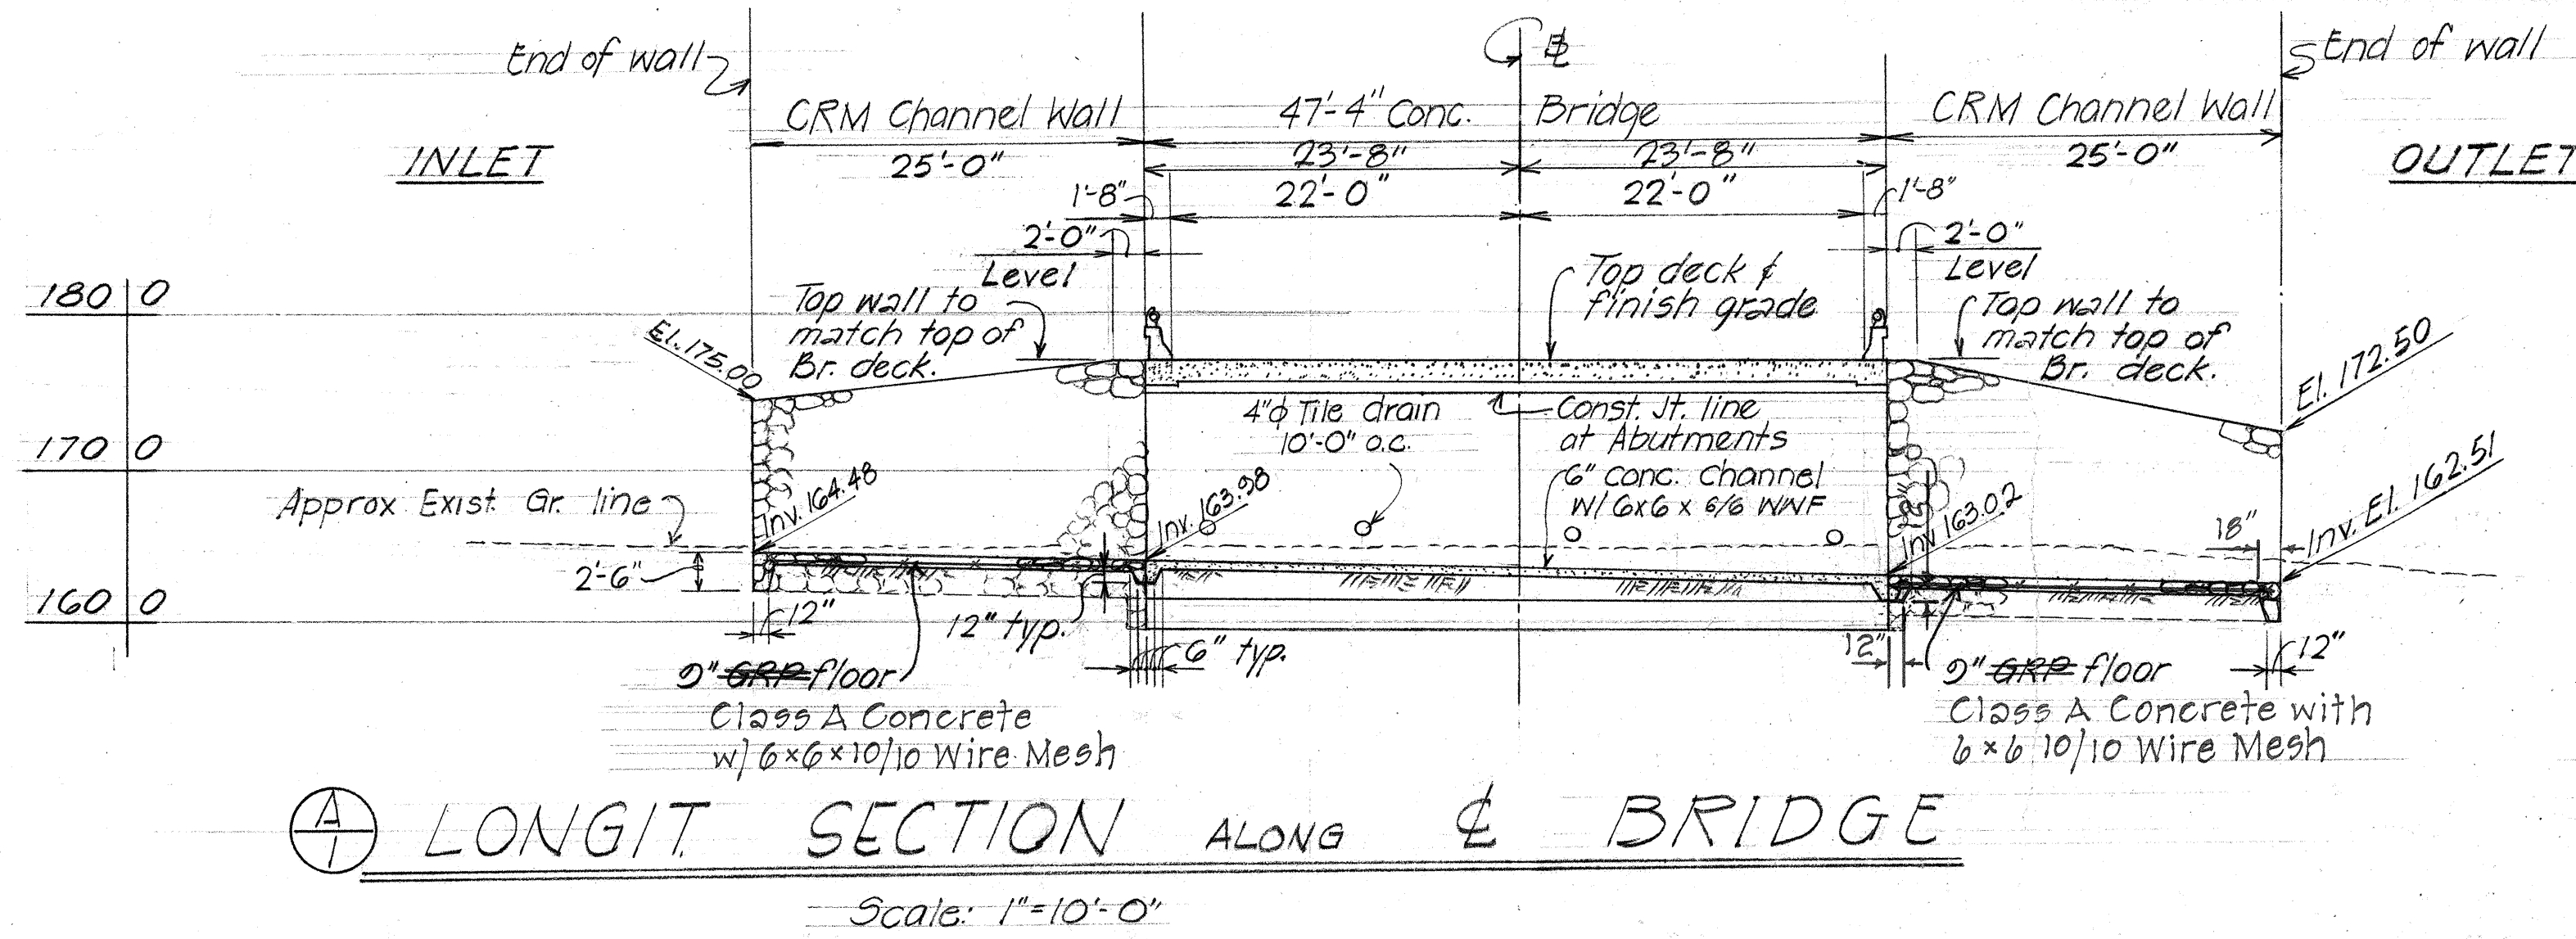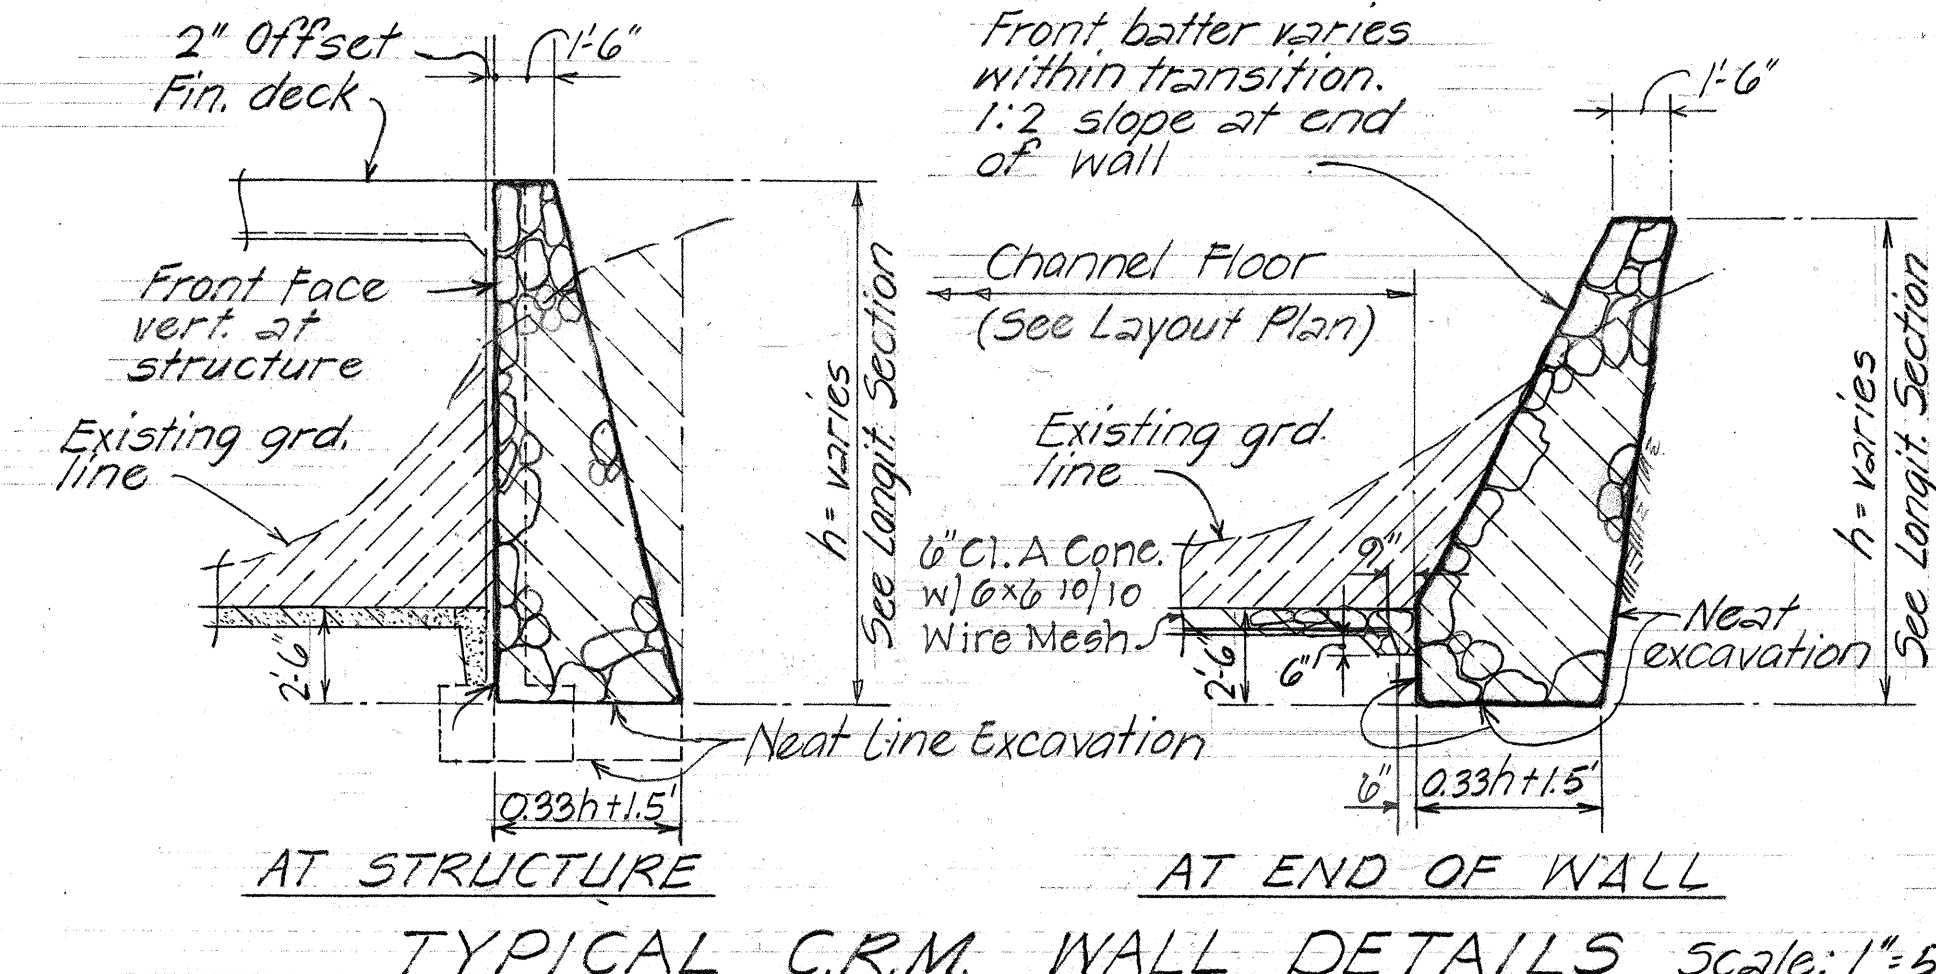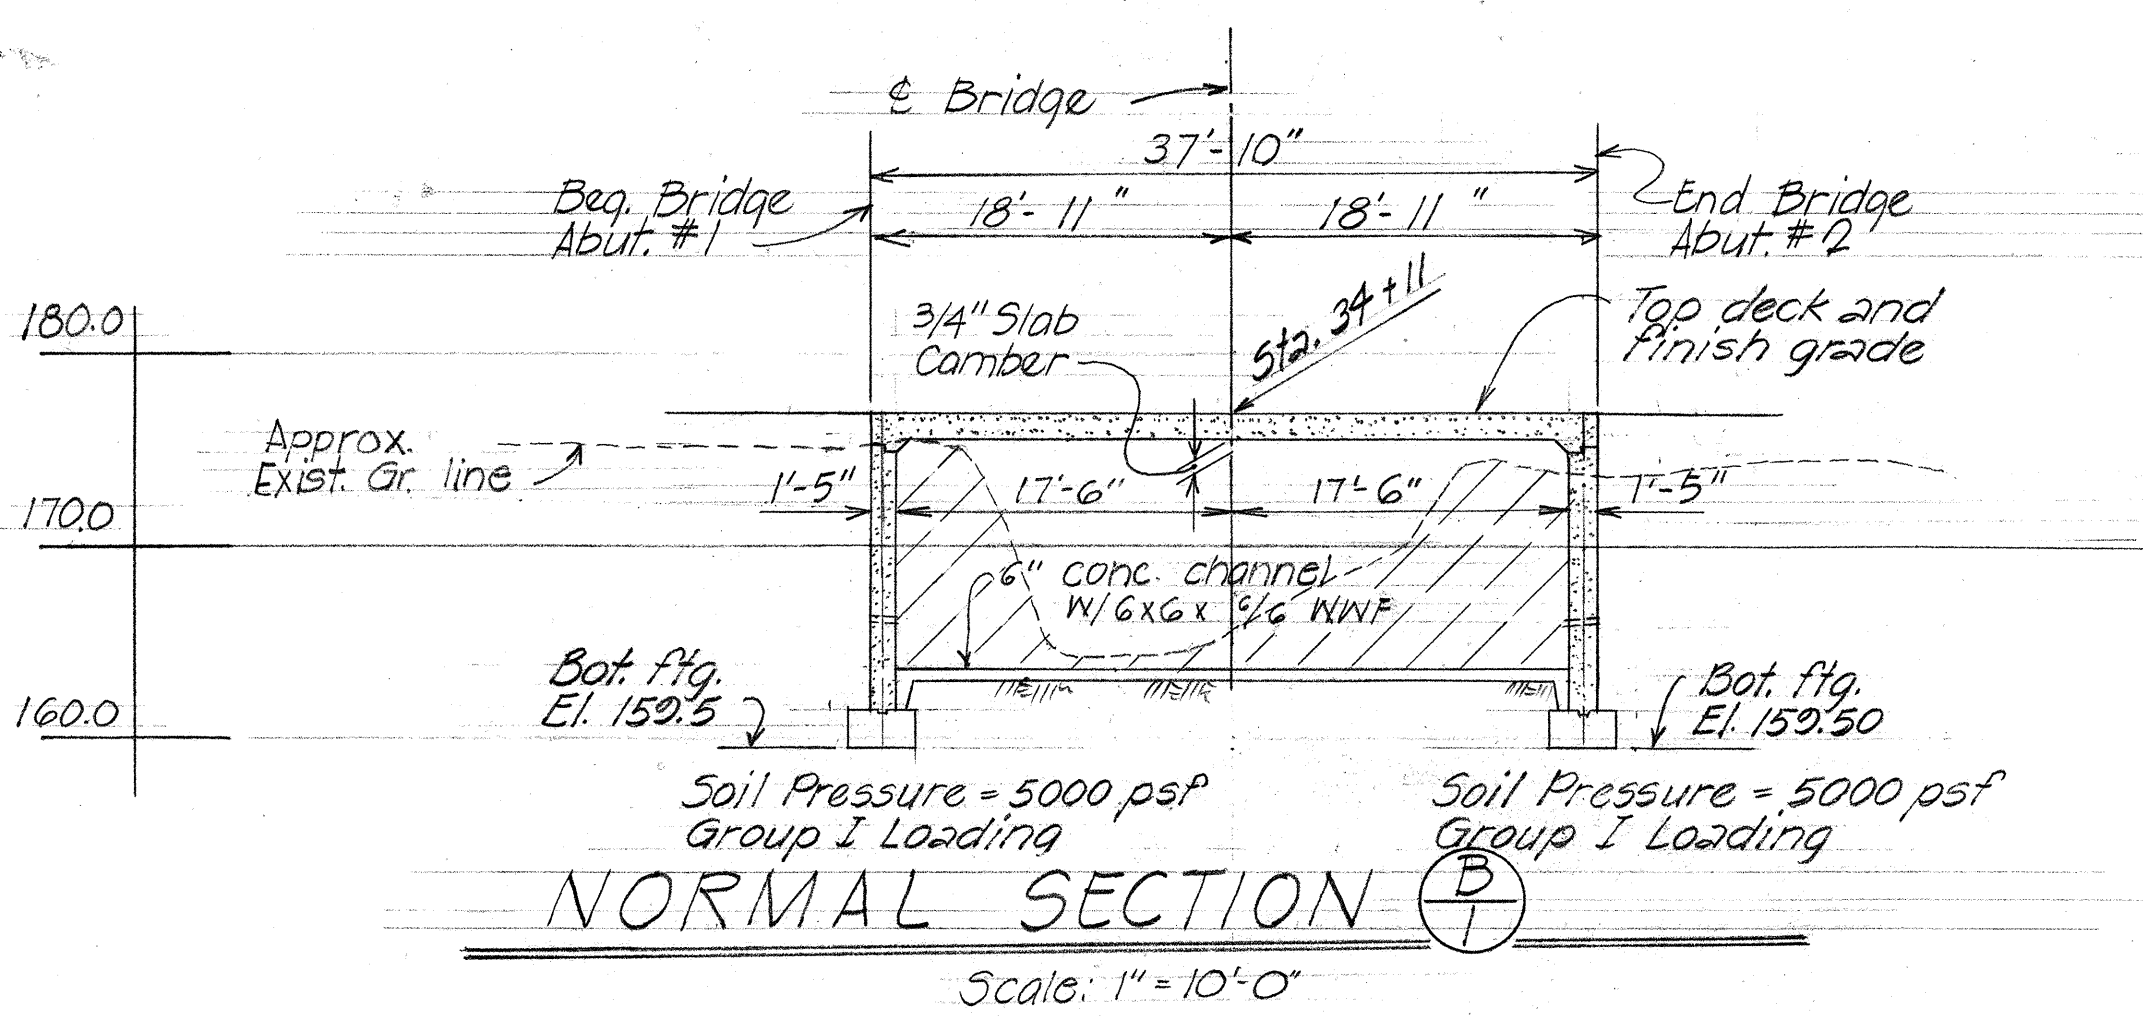

ESTIMATED QUANTITIES		
Concrete - Footing	(25 c.y.)	Lump Sum
Concrete - All Others	(214 c.y.)	Lump Sum
Reinforcing Steel	(34,750 lbs)	Lump Sum
Structural Excavation	585	c.y.
Channel Excavation	850	c.y.
C.R.M.	206	c.y.
G.R.P.	45	c.y.
Filter Material	39	c.y.
Concrete Bridge Railing & End Post	104	Lin. Ft.
Metal Bridge Railing (Single Rail)	64	Lin. Ft.

STATE OF HAWAII
DEPARTMENT OF TRANSPORTATION
HIGHWAYS DIVISION





PALEAAHU STREAM BRIDGE
STA. 34+11.00

KAHULUI AIRPORT - MAALAEA HWY.
Proj. No S-0380(6) Nov. 1967

SHEET No. 1 OF 2 SHEETS

DATE	BY
DESIGNED BY	TRACED BY
QUANTITIES BY	CHECKED BY
ORIGINAL PLAN	NO. 1

FED. ROAD DIST. NO.	STATE	FED. AID PROJ. NO.	FISCAL YEAR	SHEET NO.	TOTAL SHEETS
HAWAII	HAW.	5-0380(6)	1969	48	89

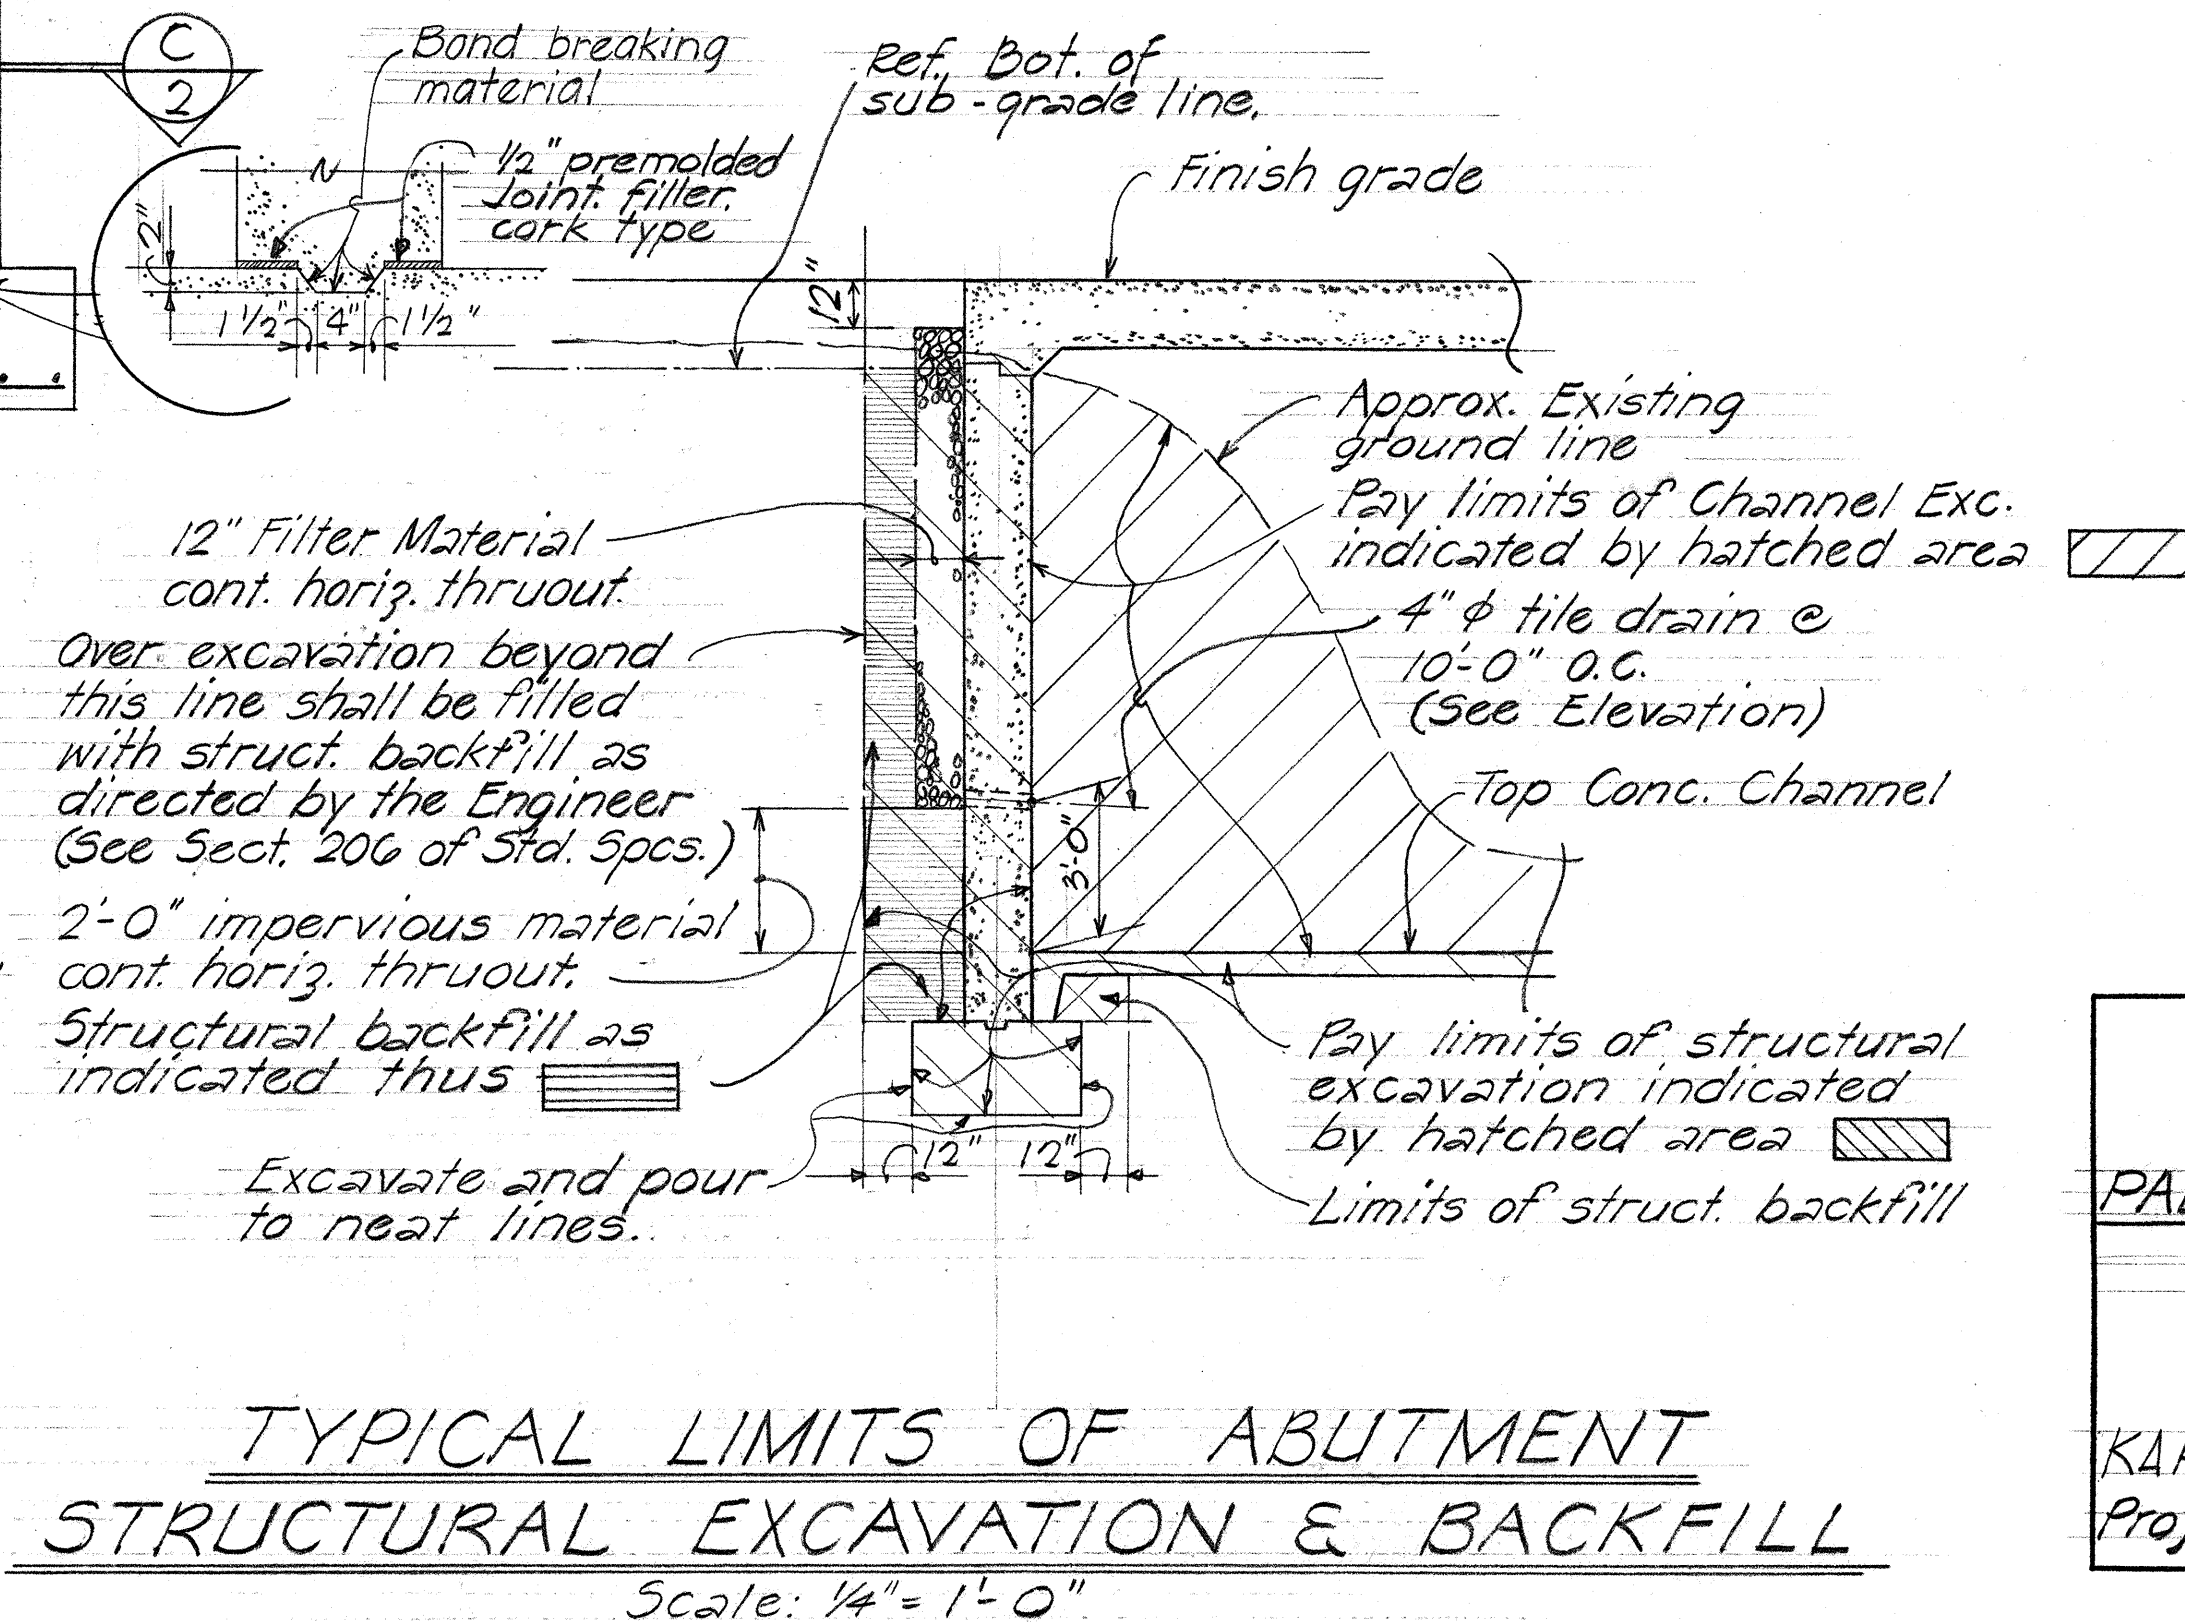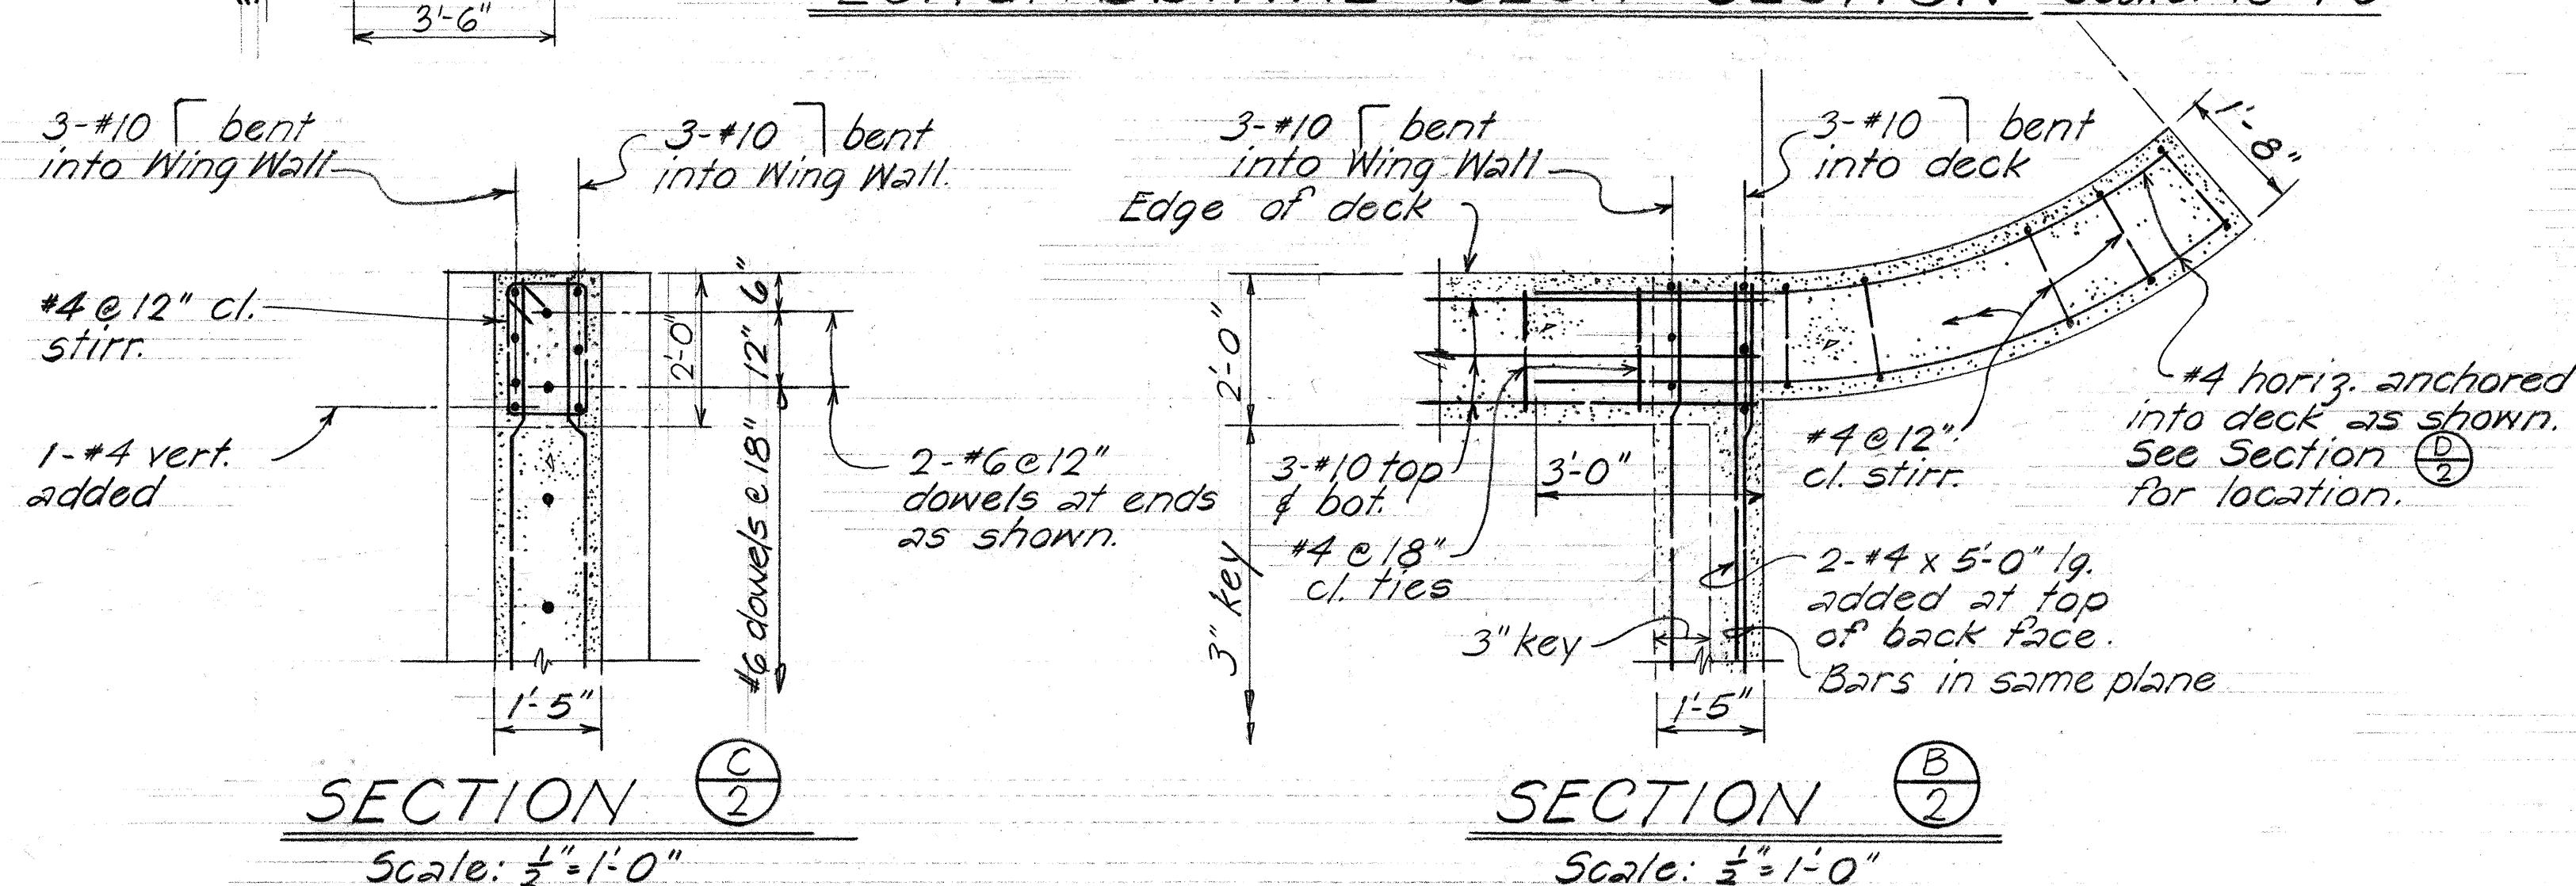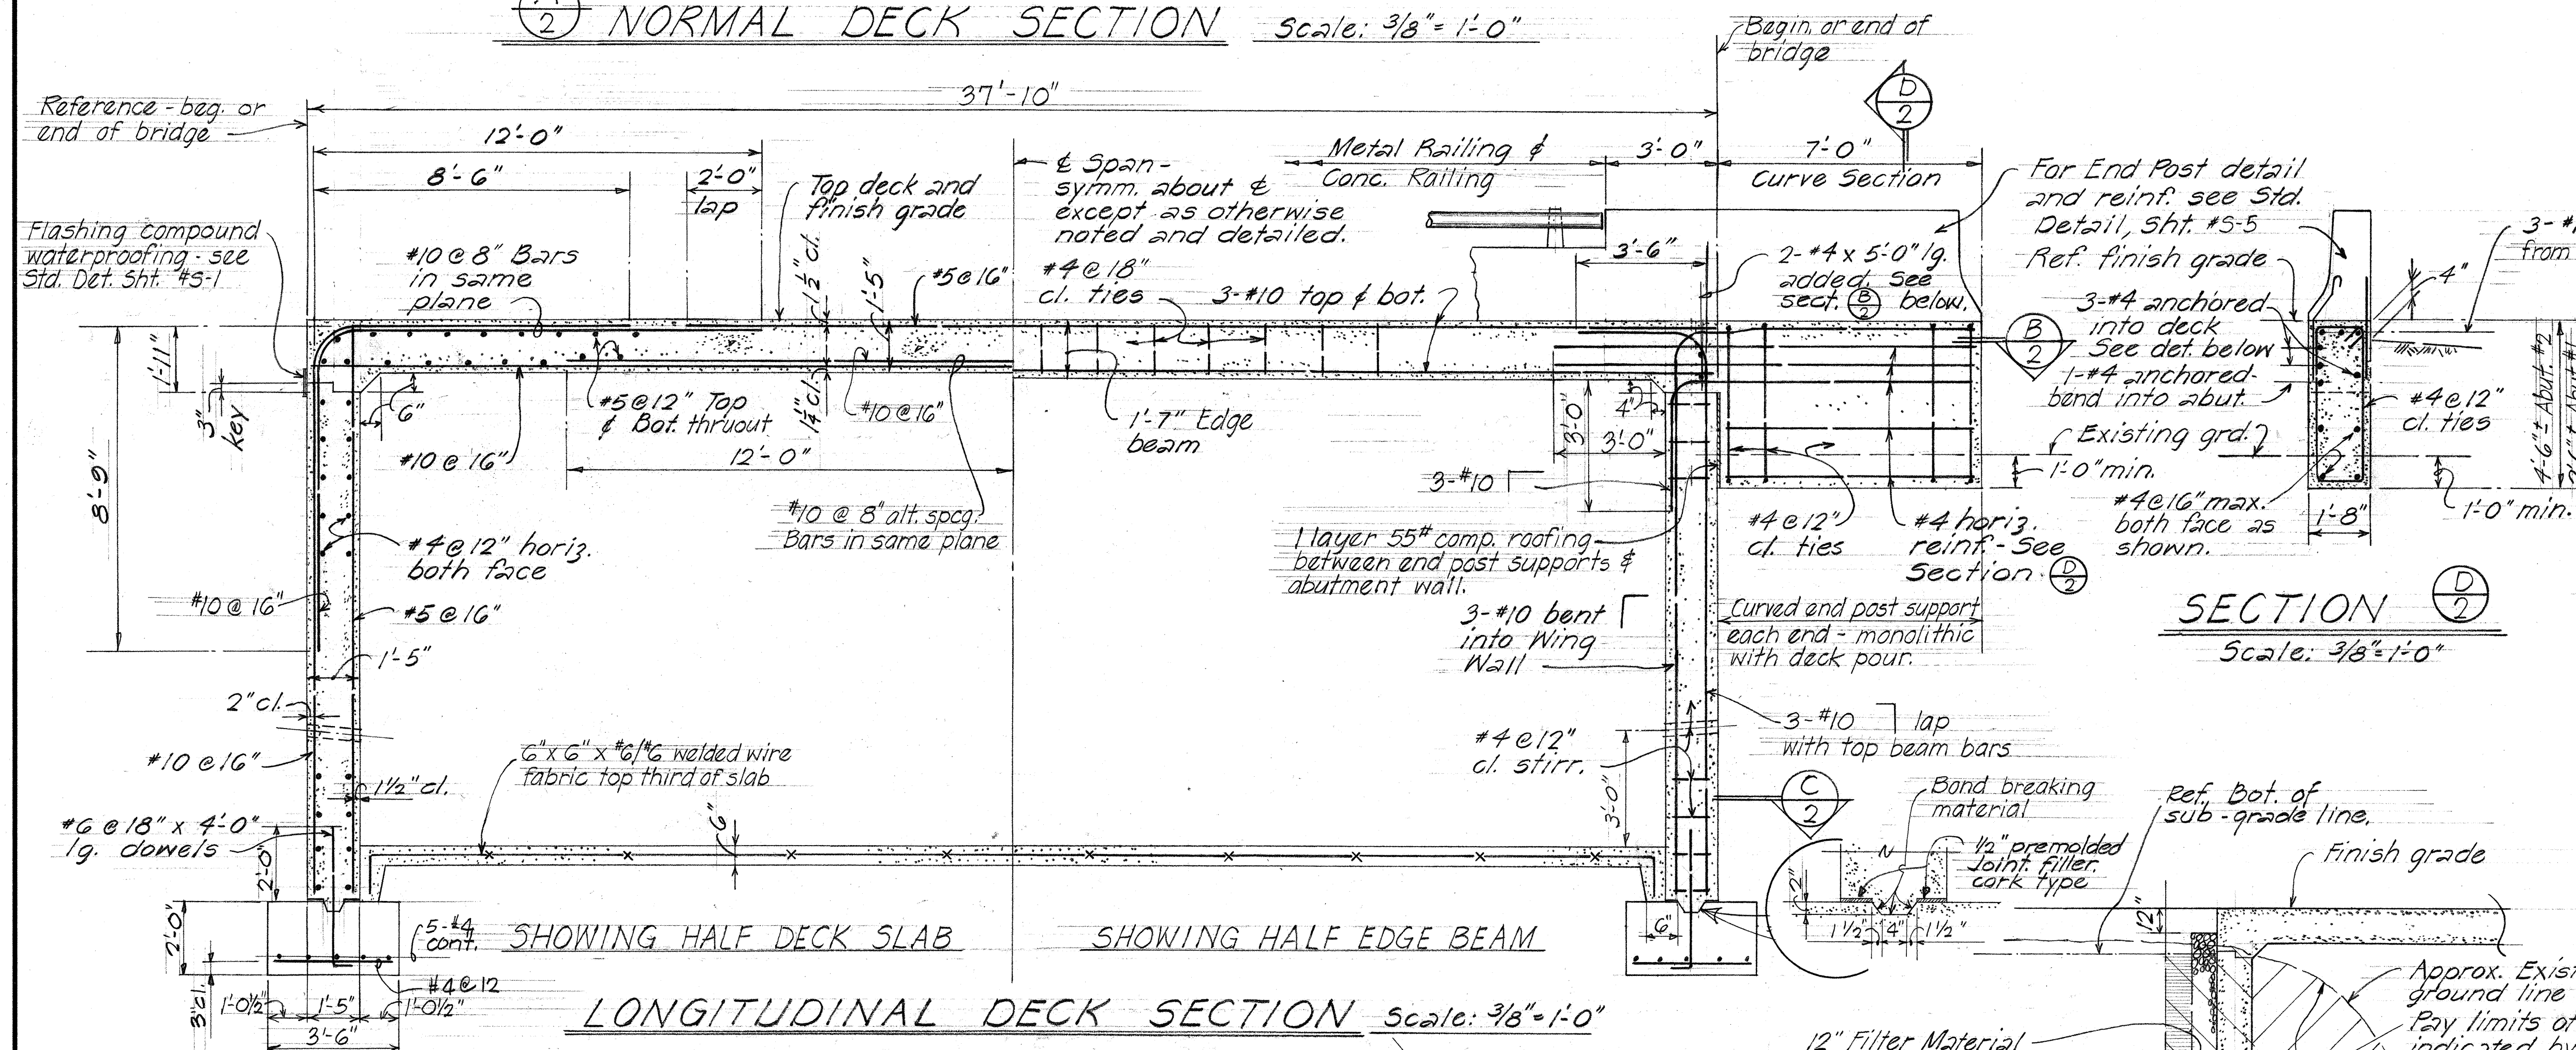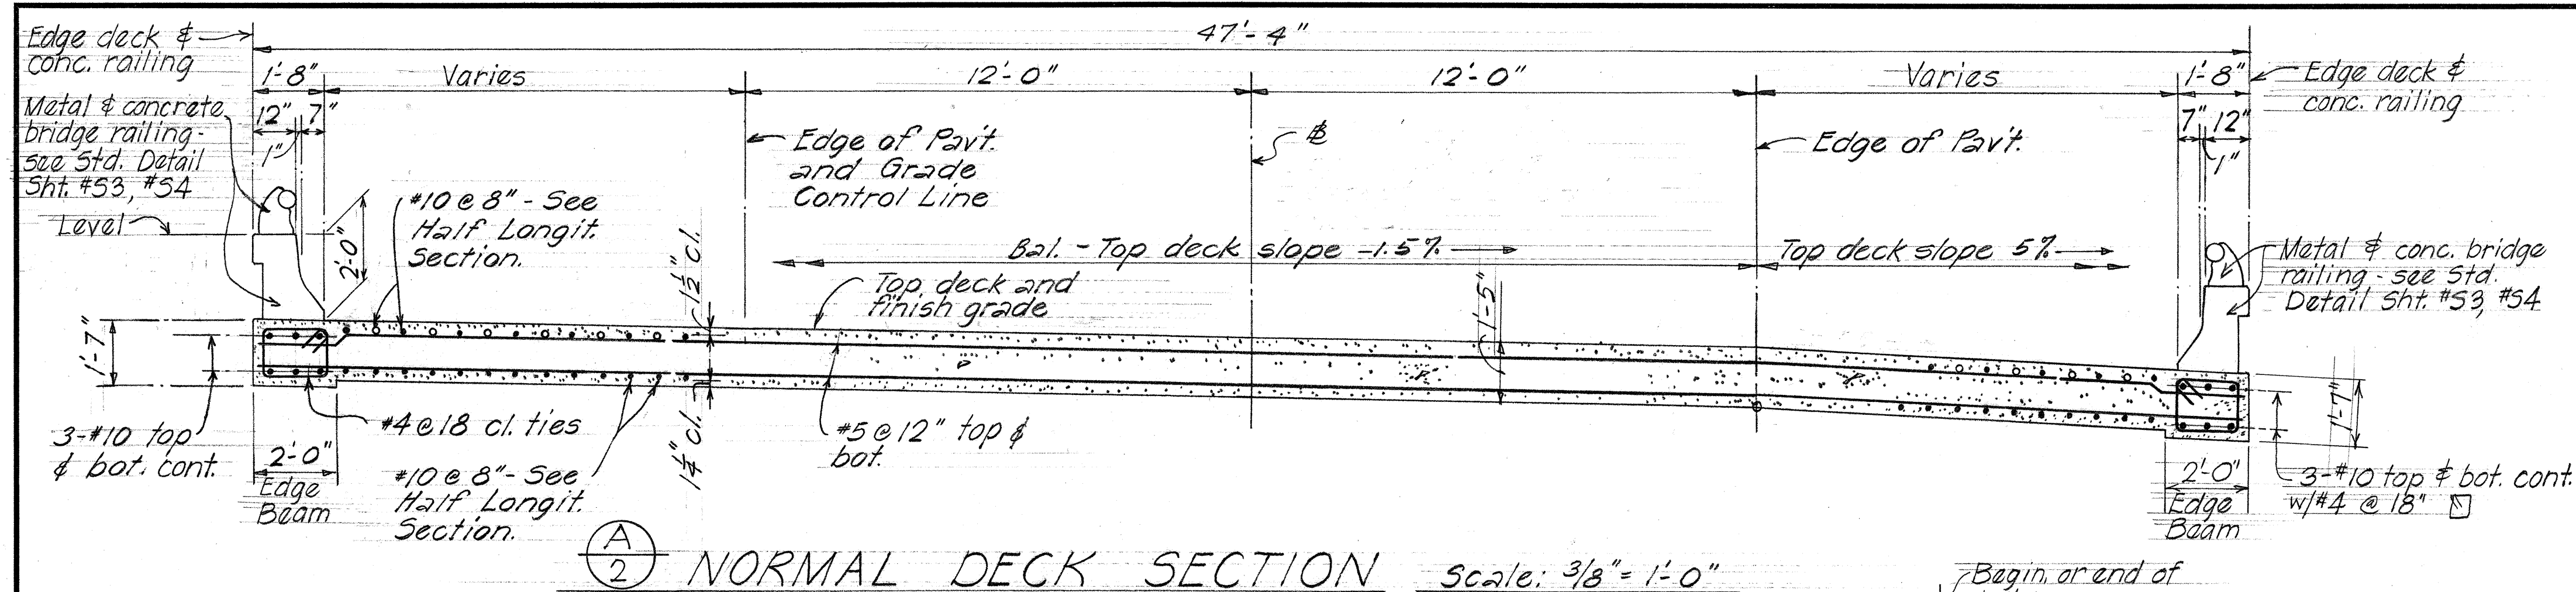

ORIGINAL PLAN	SURVEY PLOTTED BY.....	DATE.....
	DRAWN BY.....	".....
	TRACED BY.....	".....
NOTE BOOK	DESIGNED BY.....	".....
	QUANTITIES BY.....	".....
	CHECKED BY.....	".....
No.		

K-E CRYSTALEND® LA 292C
TRACING BASES