



FED. ROAD DIST. NO.	STATE	FED. AID PROJ. NO.	FISCAL YEAR	SHEET NO.	TOTAL SHEETS
HAWAII	HAW.	5-0380(6)	1969	7	89

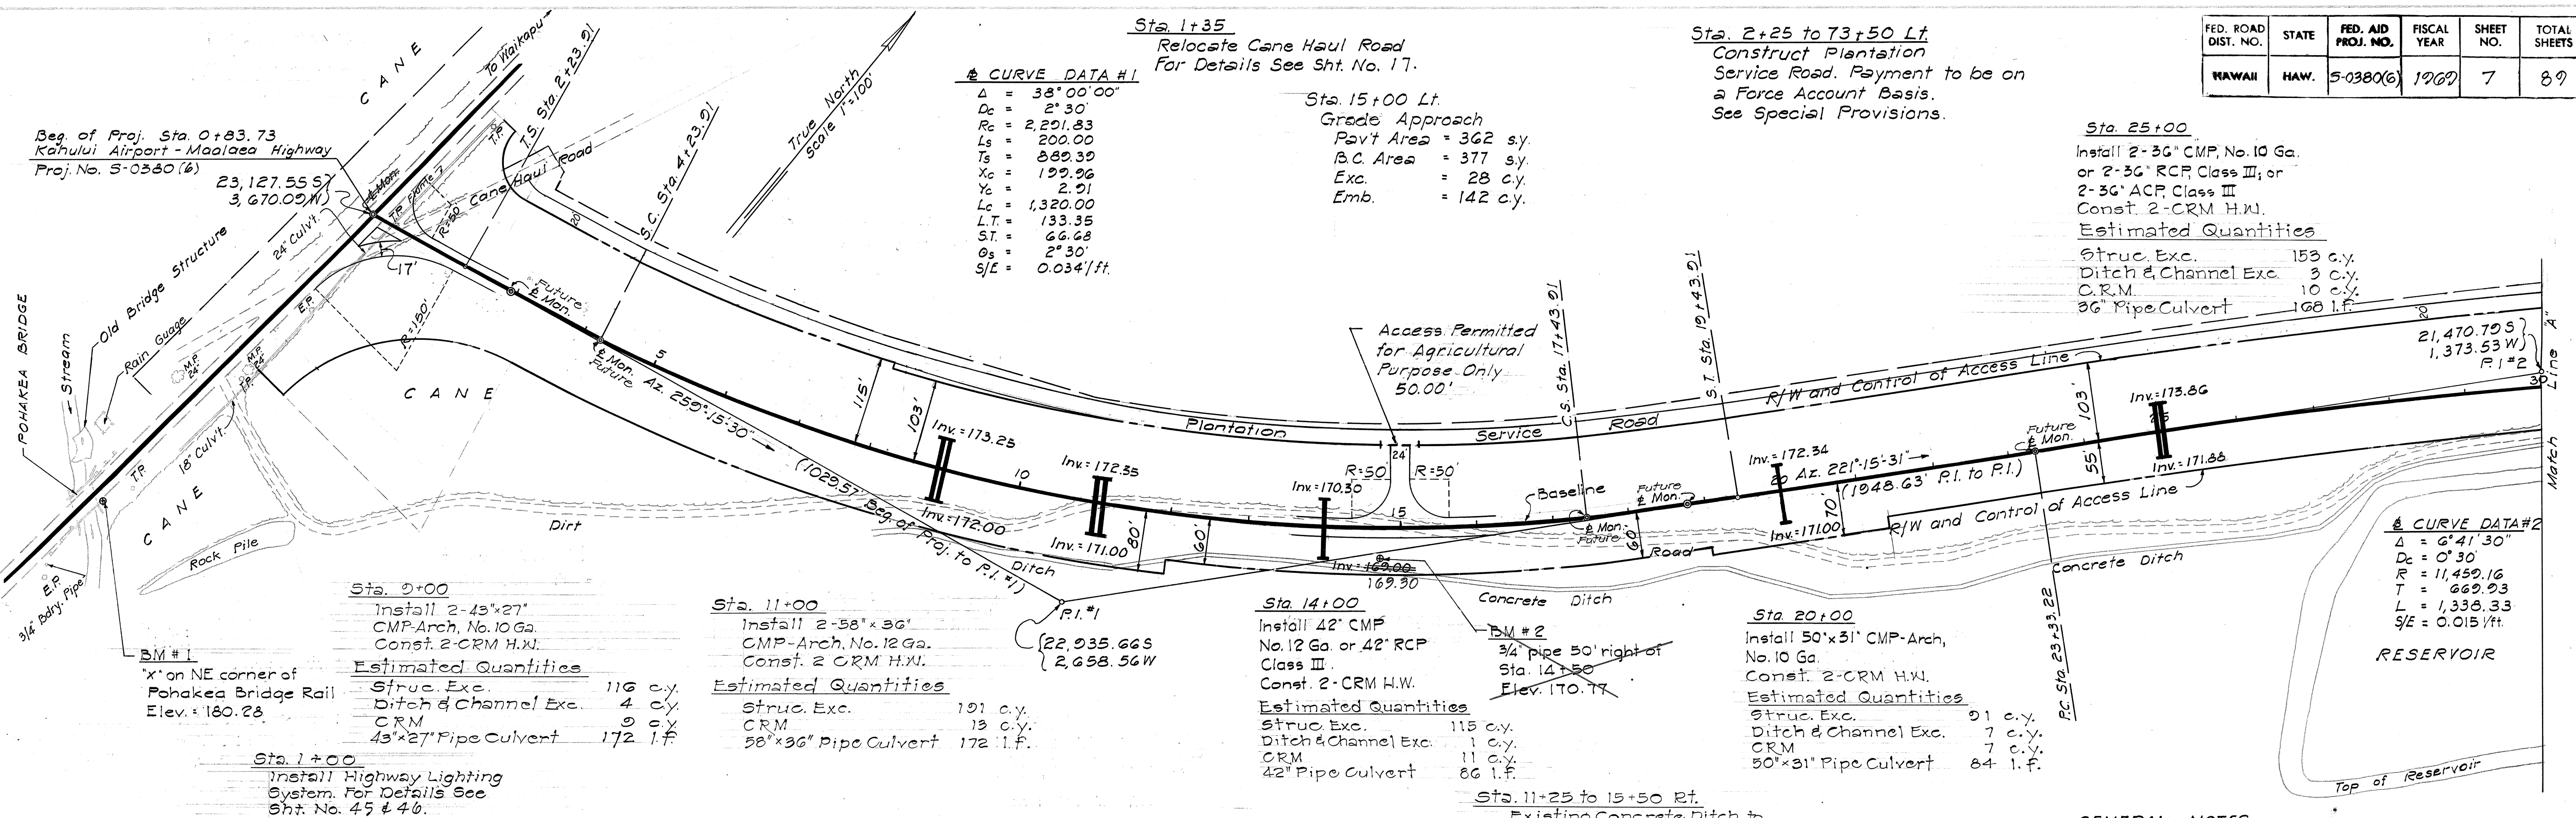

GENERAL NOTES

- Roadway azimuths referred to "Luke".
- All elevations referred to Mean Sea Level.
- Electrical and telephone utilities will be relocated by Maui Electric Co. and Hawaiian Telephone Co. respectively.
- Scarify and remove all existing Pavement within the R/W. Payment for the work shall be incidental to Roadway Excavation.


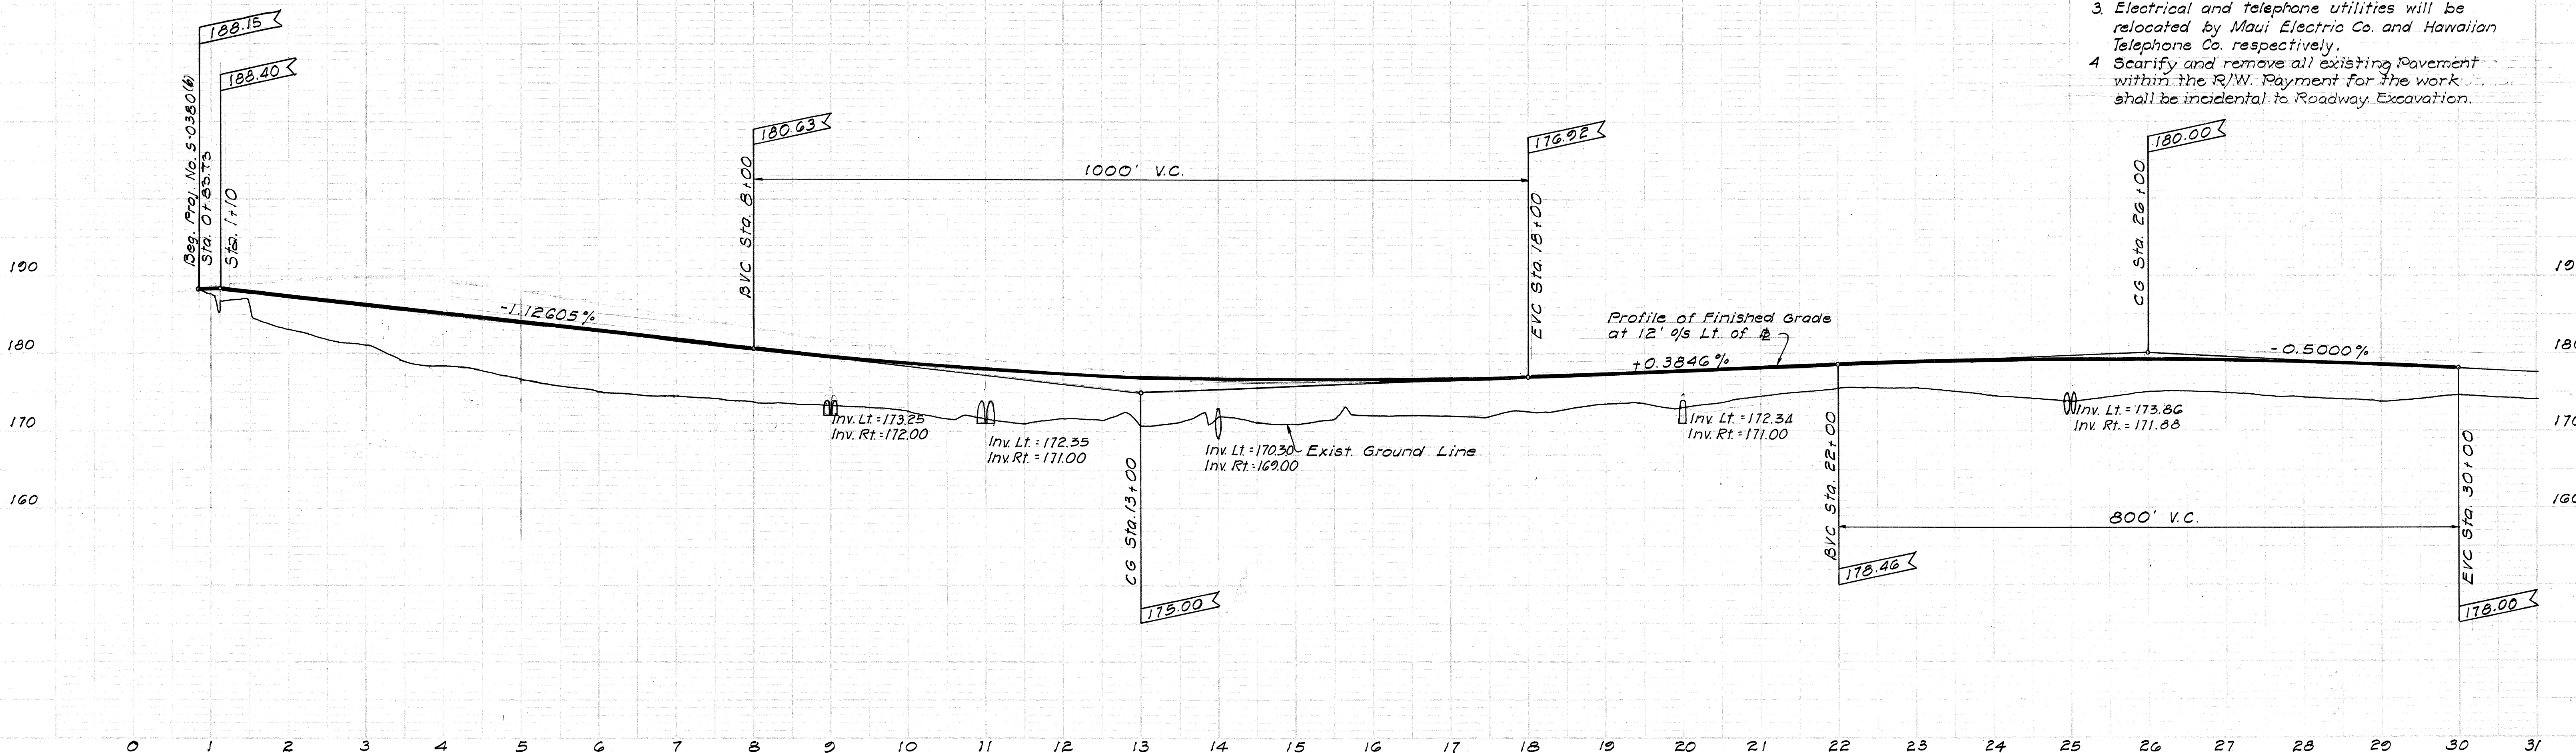


Sta. 91+00 to 123+00 Lt. & Rt.
Const. Barbed Wire Fence
6400 Lin. Ft.

Sta. 99+00 Lt. & Rt.
Grade Approaches
Pav't Area = 734 s.y.
B.C. Area = 766 s.y.
Exc. = 663 c.y.
Emb. = 0 c.y.
Lay 8-inches of Aggregate
Subbase for Temporary Crossing
Sta. 99+00 Lt. & Rt.
Const. Std. Cattle Gate
2 Ea.
For Detail See Sht. No. 22.

Sta. 110+00 to 122+50 Lt.
Grade to Drain as ordered
by the Engineer. Payment
to be made under Roadway
Excavation.


FED. ROAD DIST. NO.	STATE	FED. AID PROJ. NO.	FISCAL YEAR	SHEET NO.	TOTAL SHEETS
HAWAII	HAW.	5-0380(6)	1969	10	89

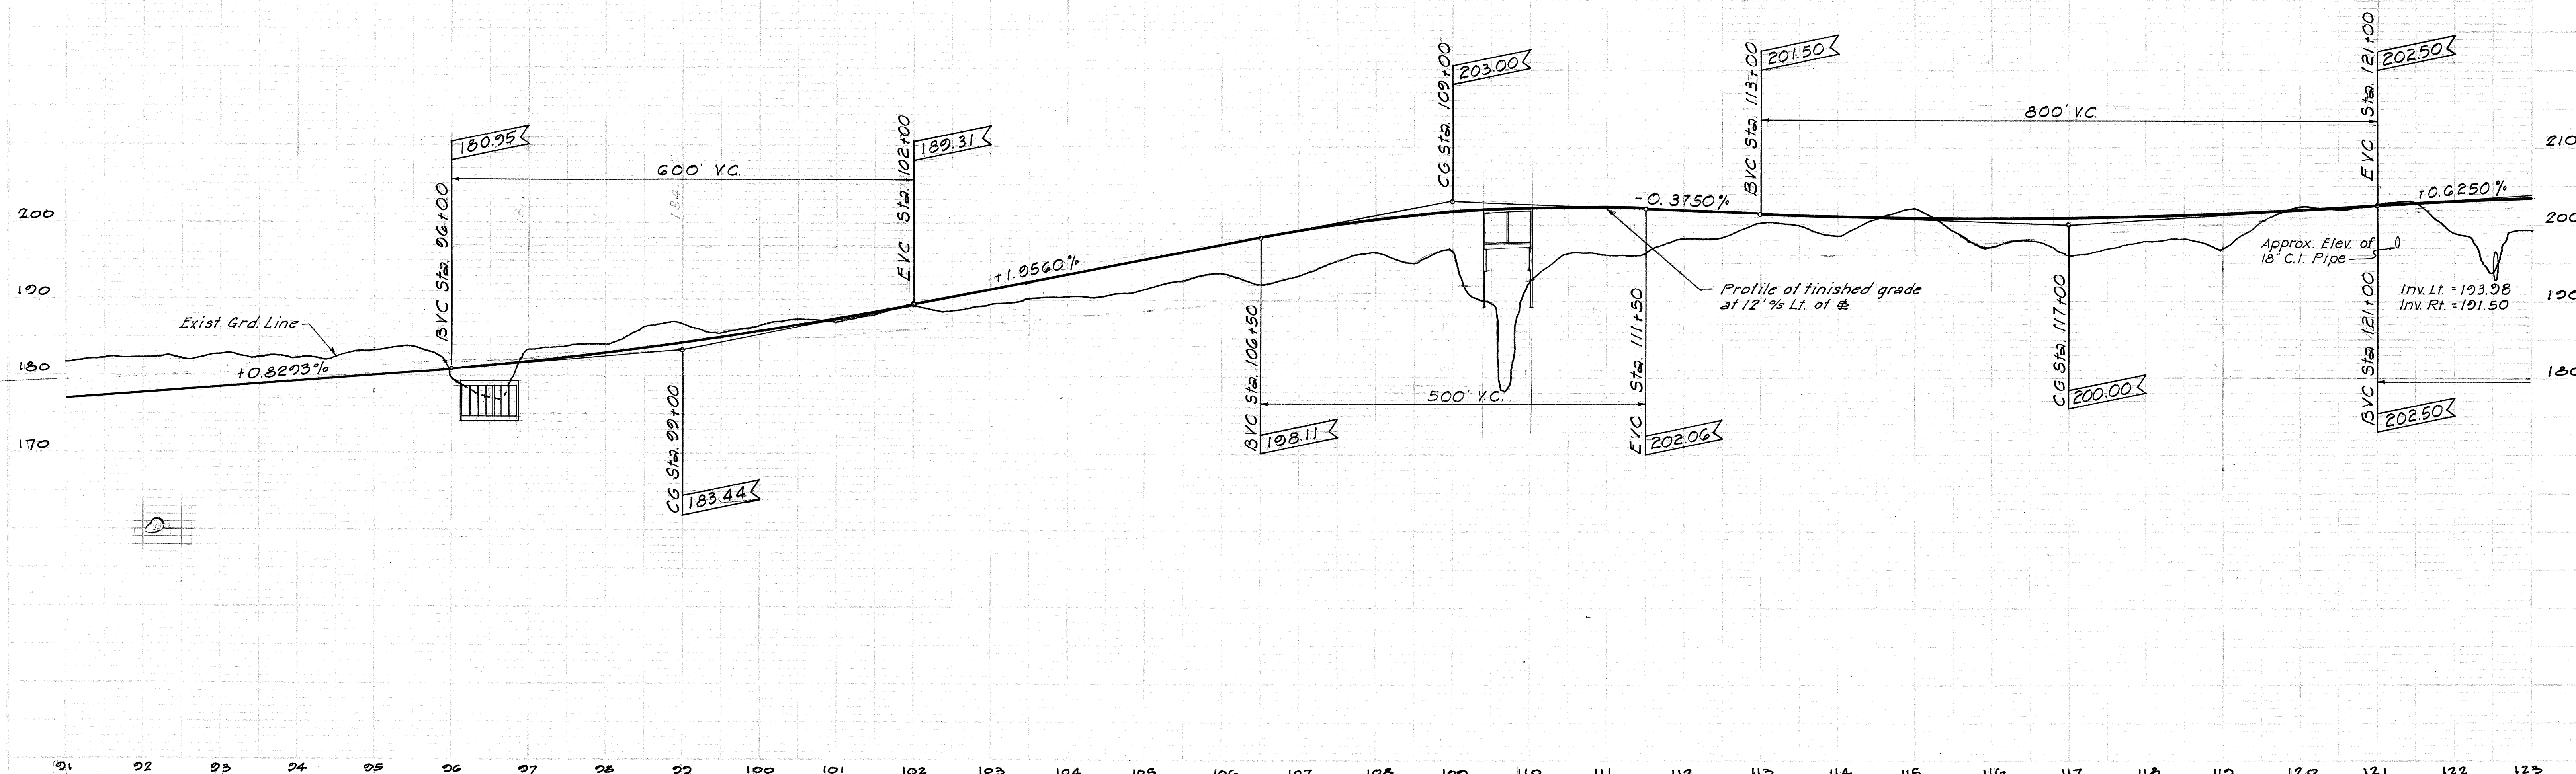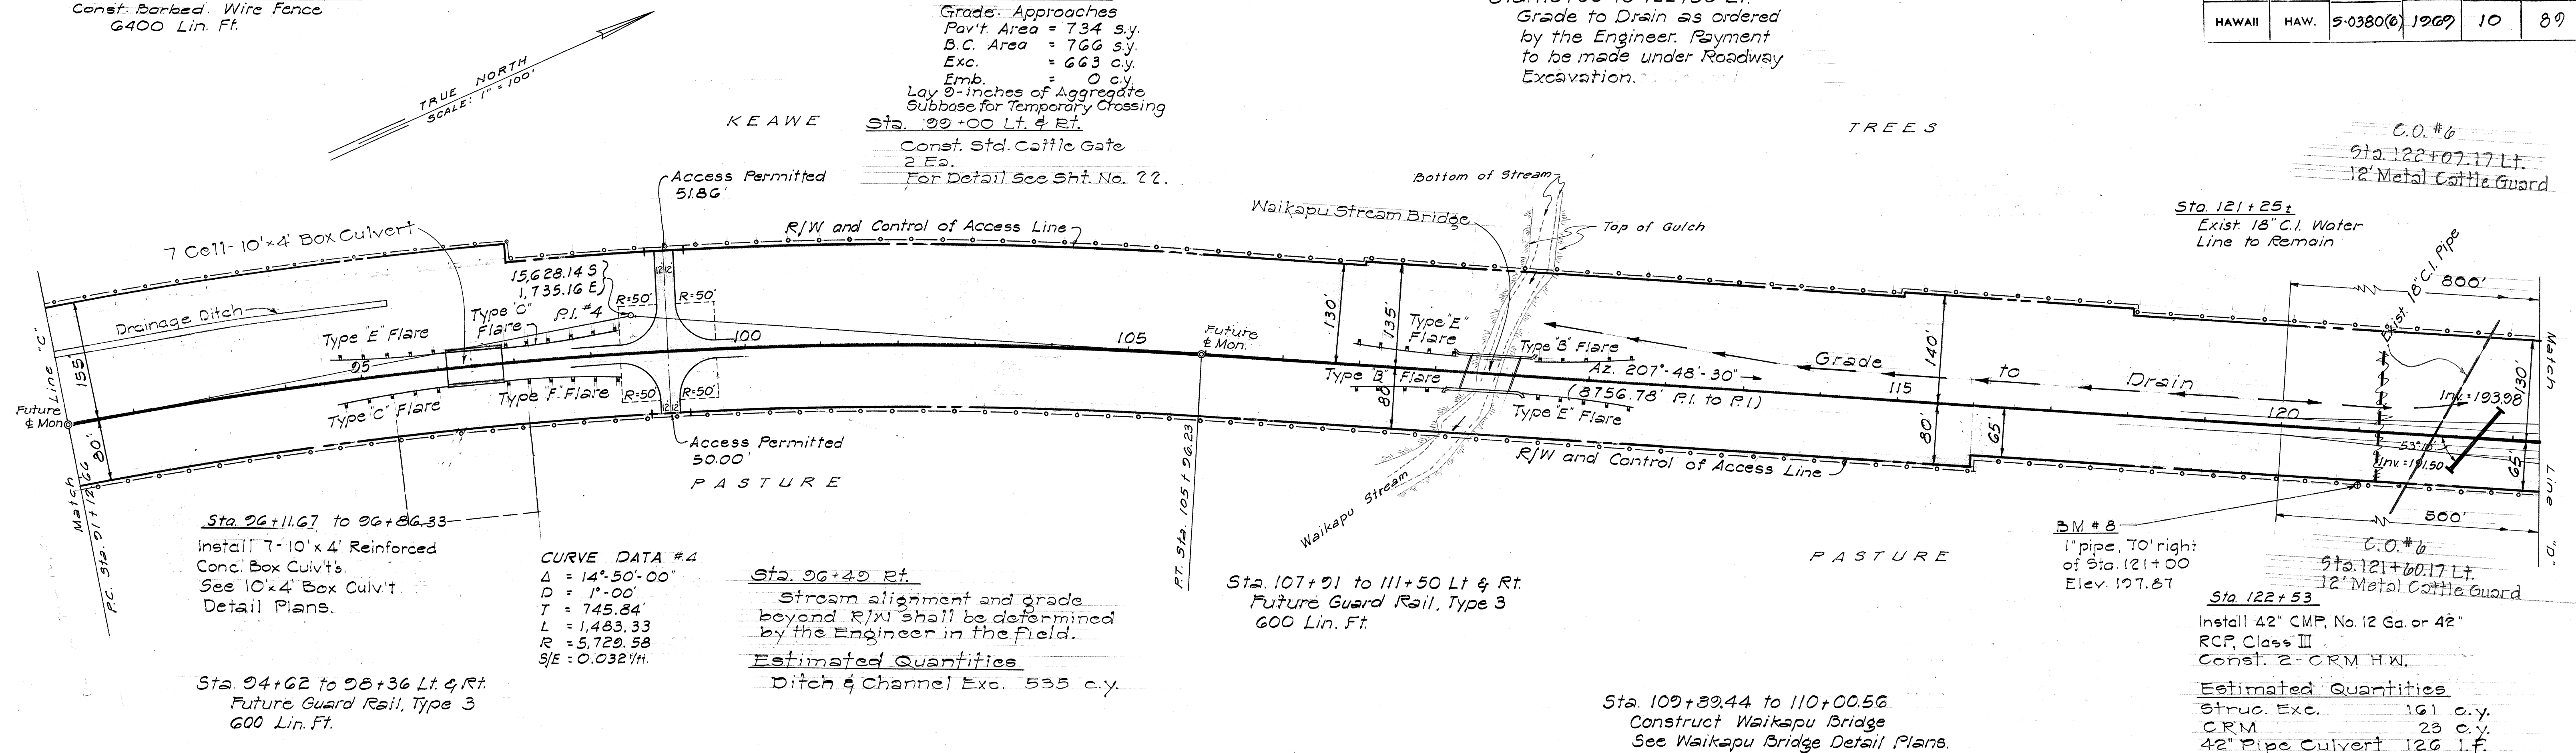

May 19, 1970

(C) (D) 1 (D)

FED. ROAD DIST. NO.	STATE	FED. AID PROJ. NO.	FISCAL YEAR	SHEET NO.	TOTAL SHEETS
HAWAII	HAW.	5-0380(6)	1969	11	89

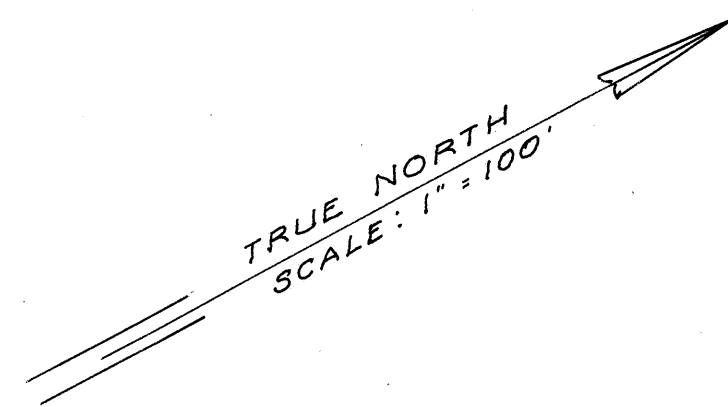

~~Deleted by C.O. #7~~

~~Sta. 122+00 to 137+00 Lt.~~

~~Construct GIGI4 Reinforced Conc. Gutter.~~

~~For Details See Sheet No. 33~~

~~Estimated Quantities~~

~~Class B Conc. or Shotcrete 78 c.y.
Reinf. Steel 1,344 lbs.~~

Sta. 138+50 and 154+00 Rt.

Stream alignment and grade beyond culvert outlet shall be determined by the Engineer in the field.

Estimated Quantities


Ditch & Channel Exc. 20 c.y. (Sta. 138+50)

Ditch & Channel Exc. 20 c.y. (Sta. 154+00)

Sta. 123+00 to 144+50 and 146+10 to 155+00 Lt.

Sta. 123+00 to 145+00 and 146+60 to 155+00 Rt.

Const. Barbed Wire Fence
6080 Lin. Ft.

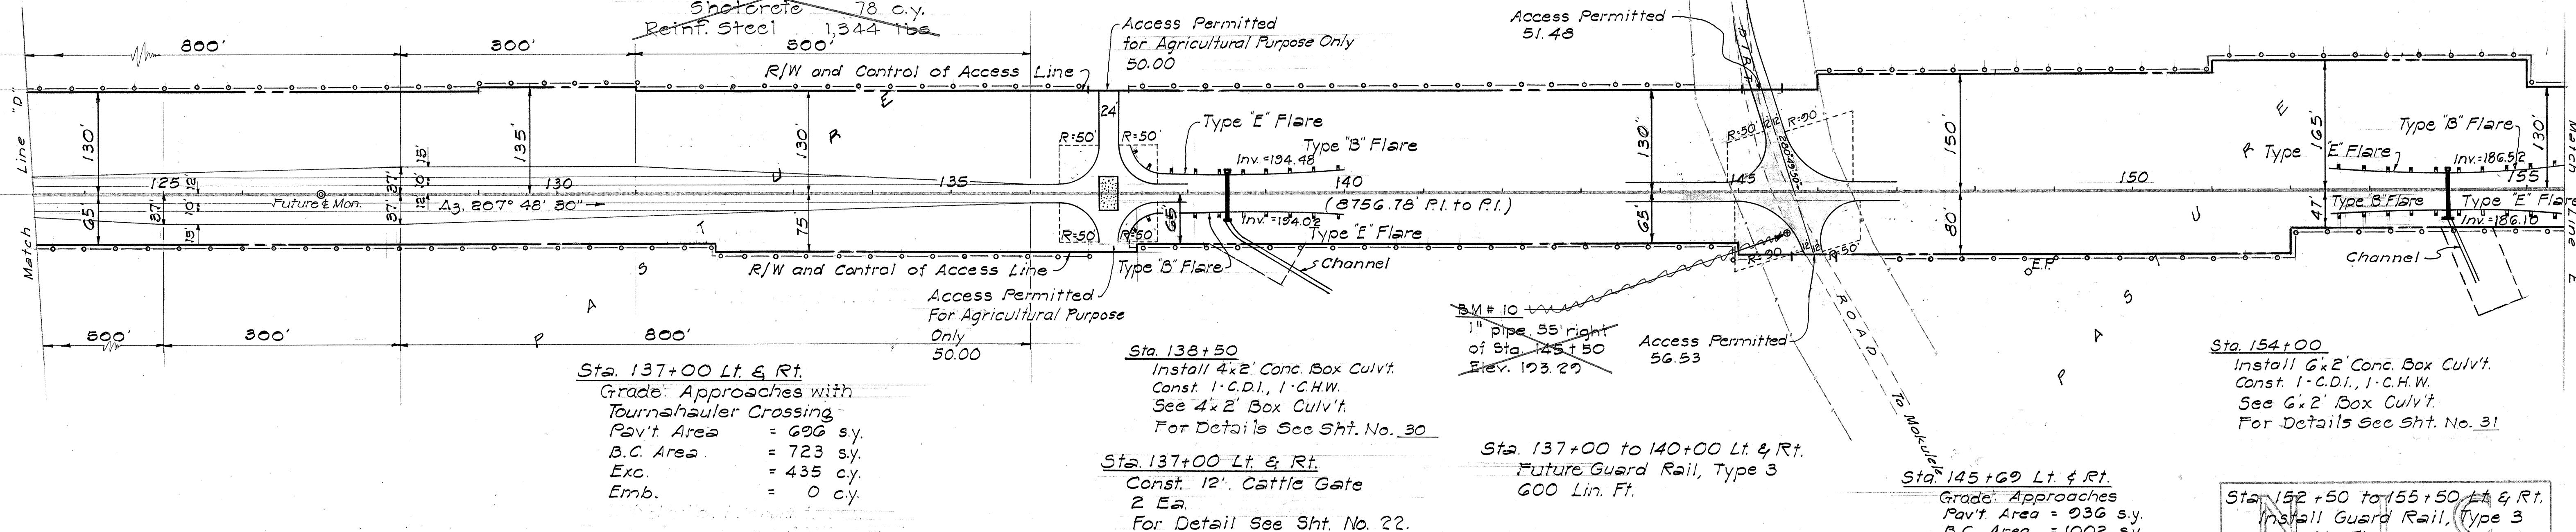

Sta. 137+00 Lt. & Rt.

Grade Approaches with

Tournahauler Crossing

Pav't Area = 606 s.y.

B.C. Area = 723 s.y.

Exc. = 435 c.y.

Emb. = 0 c.y.

Detail of Tournahauler Crossing
See Sht. No. 5.

Sta. 138+50

Install 4x2' Conc. Box Culvt.

Const. 1-C.D.I., 1-C.H.W.

See 4x2' Box Culvt.

For Details See Sht. No. 30

Sta. 137+00 Lt. & Rt.

Const. 12' Cattle Gate

2 Ea.

For Detail See Sht. No. 22.

Sta. 137+00 to 140+00 Lt. & Rt.

Future Guard Rail, Type 3

600 Lin. Ft.

Sta. 154+00

Install 6x2' Conc. Box Culvt.

Const. 1-C.D.I., 1-C.H.W.

See 6x2' Box Culvt.

For Details See Sht. No. 31

Sta. 145+69 Lt. & Rt.

Grade Approaches

Pav't Area = 936 s.y.

B.C. Area = 1002 s.y.


Exc. = 623 c.y.

Emb. = 0 c.y.

Lay 4-inches of Aggregate

Subbase for Temporary Crossing

Sta. 152+50 to 155+50 Lt. & Rt.
Install Guard Rail, Type 3
600 Lin. Ft.

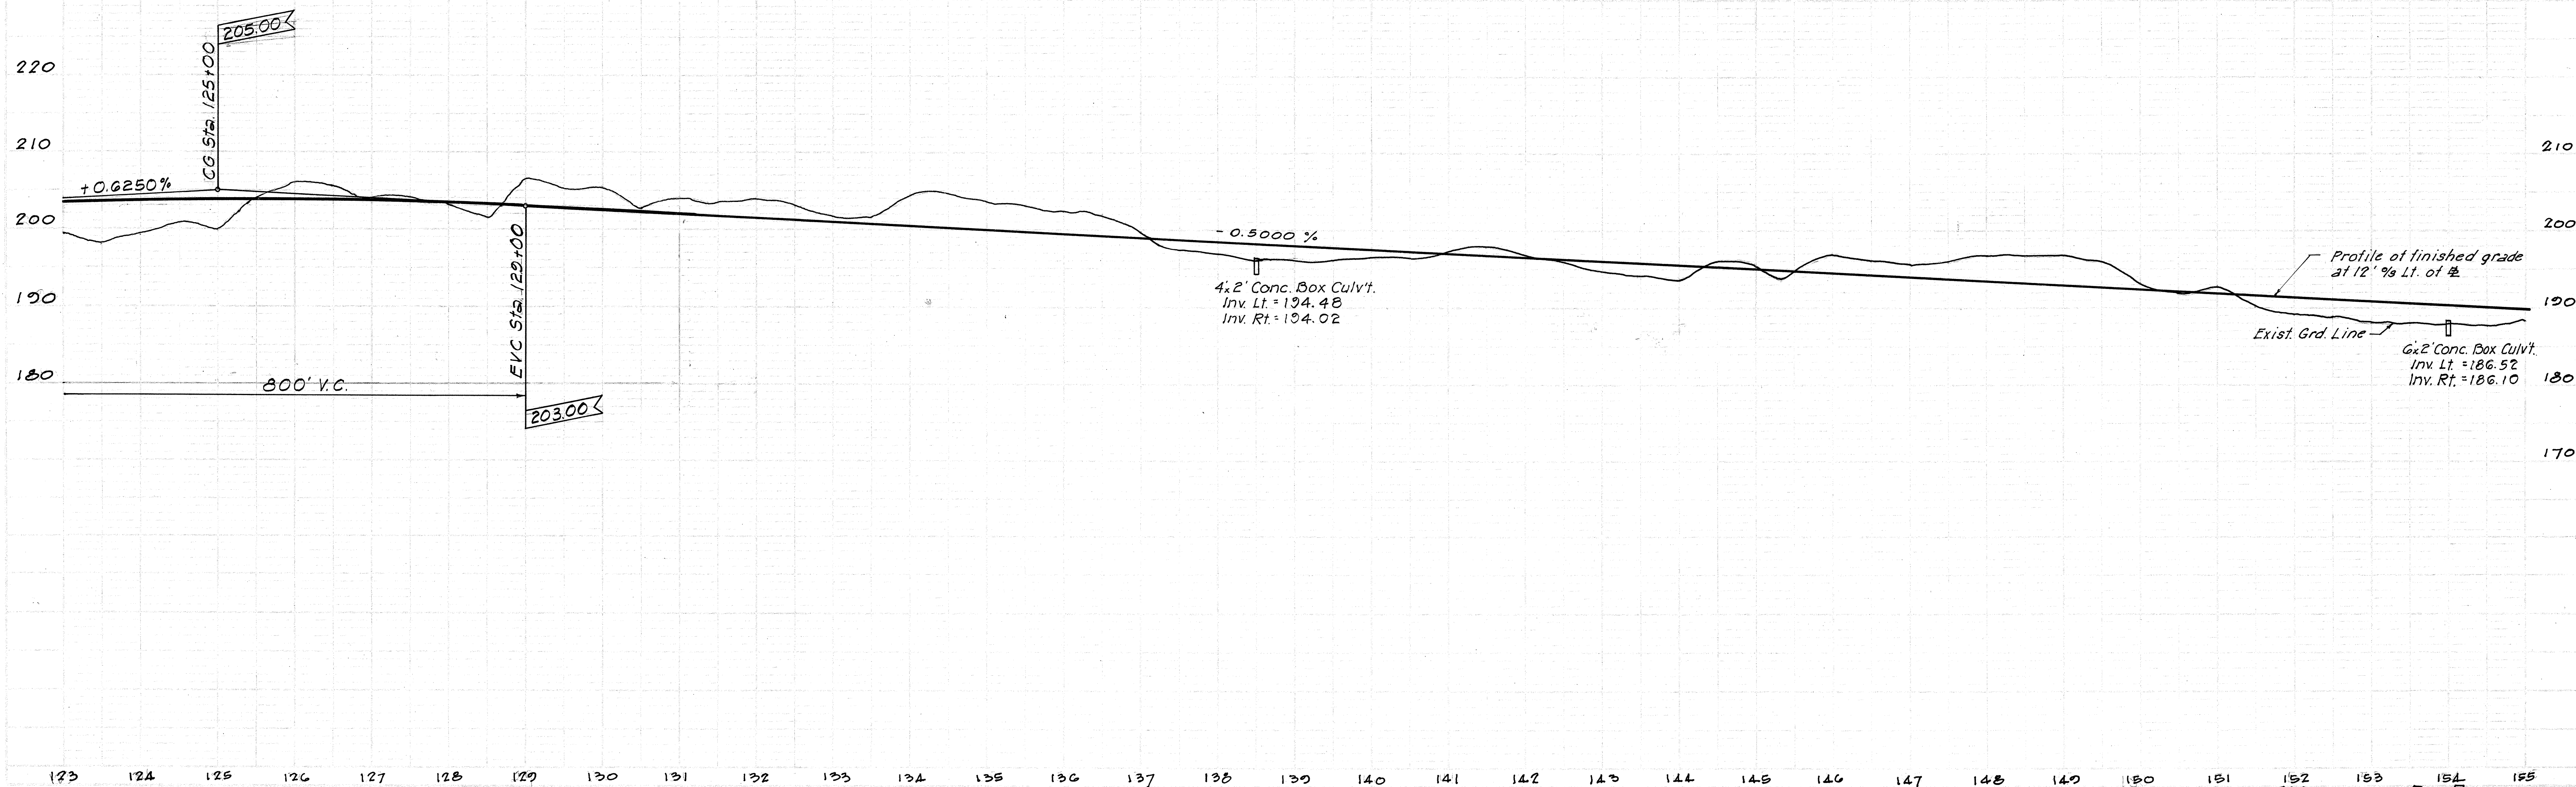


May 19, 1970

11

FED. ROAD DIST. NO.	STATE	FED. AID PROJ. NO.	FISCAL YEAR	SHEET NO.	TOTAL SHEETS
HAWAII	HAW.	5-0380(6)	1969	12	89

Sta. 155+00 to 163+30 Lt.
Sta. 155+00 to 162+10 Rt.
Const. Barbed Wire Fence
1540 Lin. Ft.

Sta. 167+00 to 187+00
Remove Bagasse from within
R/W to Left Side of Roadway.
Payment Incidental to Roadway
Excavation.

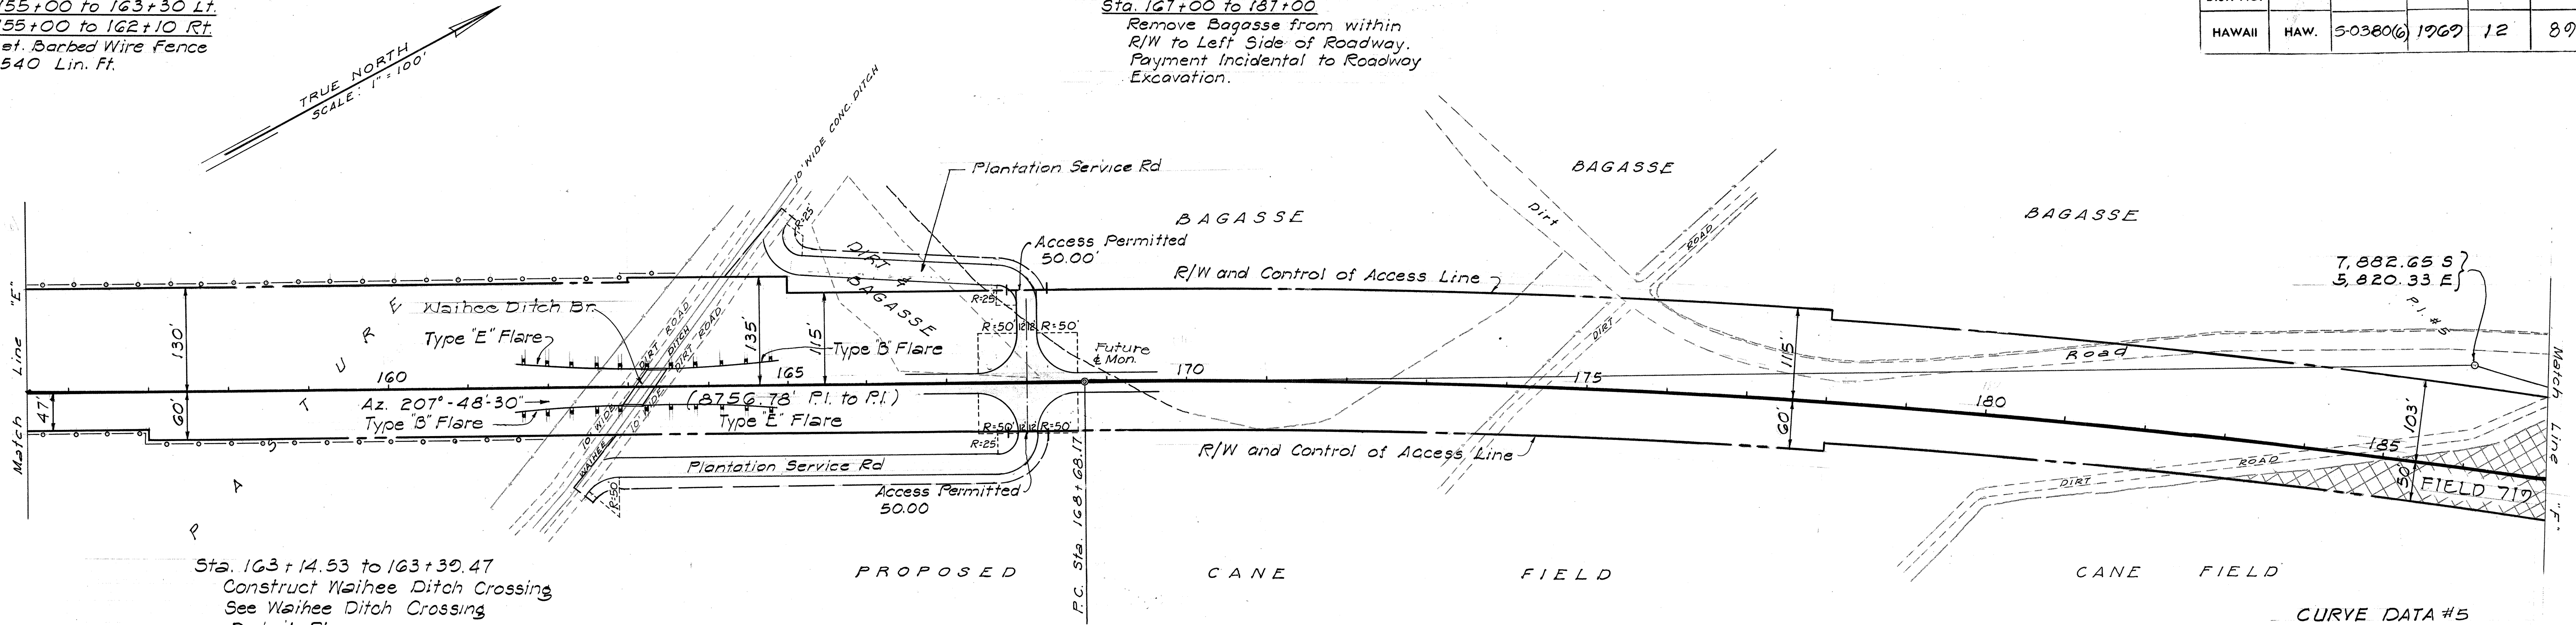


Sta. 163+14.53 to 163+30.47
Construct Waihee Ditch Crossing
See Waihee Ditch Crossing
Detail Plans

Sta. 161+53 to 164+90 Lt. & Rt.
Future Guard Rail, Type 3
600 Lin. Ft.


Sta. 168+00 Lt. & Rt.
Grade Approaches
Pav't. Area = 641 s.y.
B.C. Area = 665 s.y.
Exc. = 164 c.y.
Emb. = 142 c.y.
For Detail of Graded & Drained
Roads See Sht. No. 4.
Lay 6-inches of Aggregate Base
for Temporary Crossing.

CURVE DATA #5
 $\Delta = 17^\circ 15' 30''$
 $D = 0' 30''$
 $R = 11,459.16$
 $T = 1,739.00$
 $L = 3,451.67$
 $S/E = 0.0151/ft.$

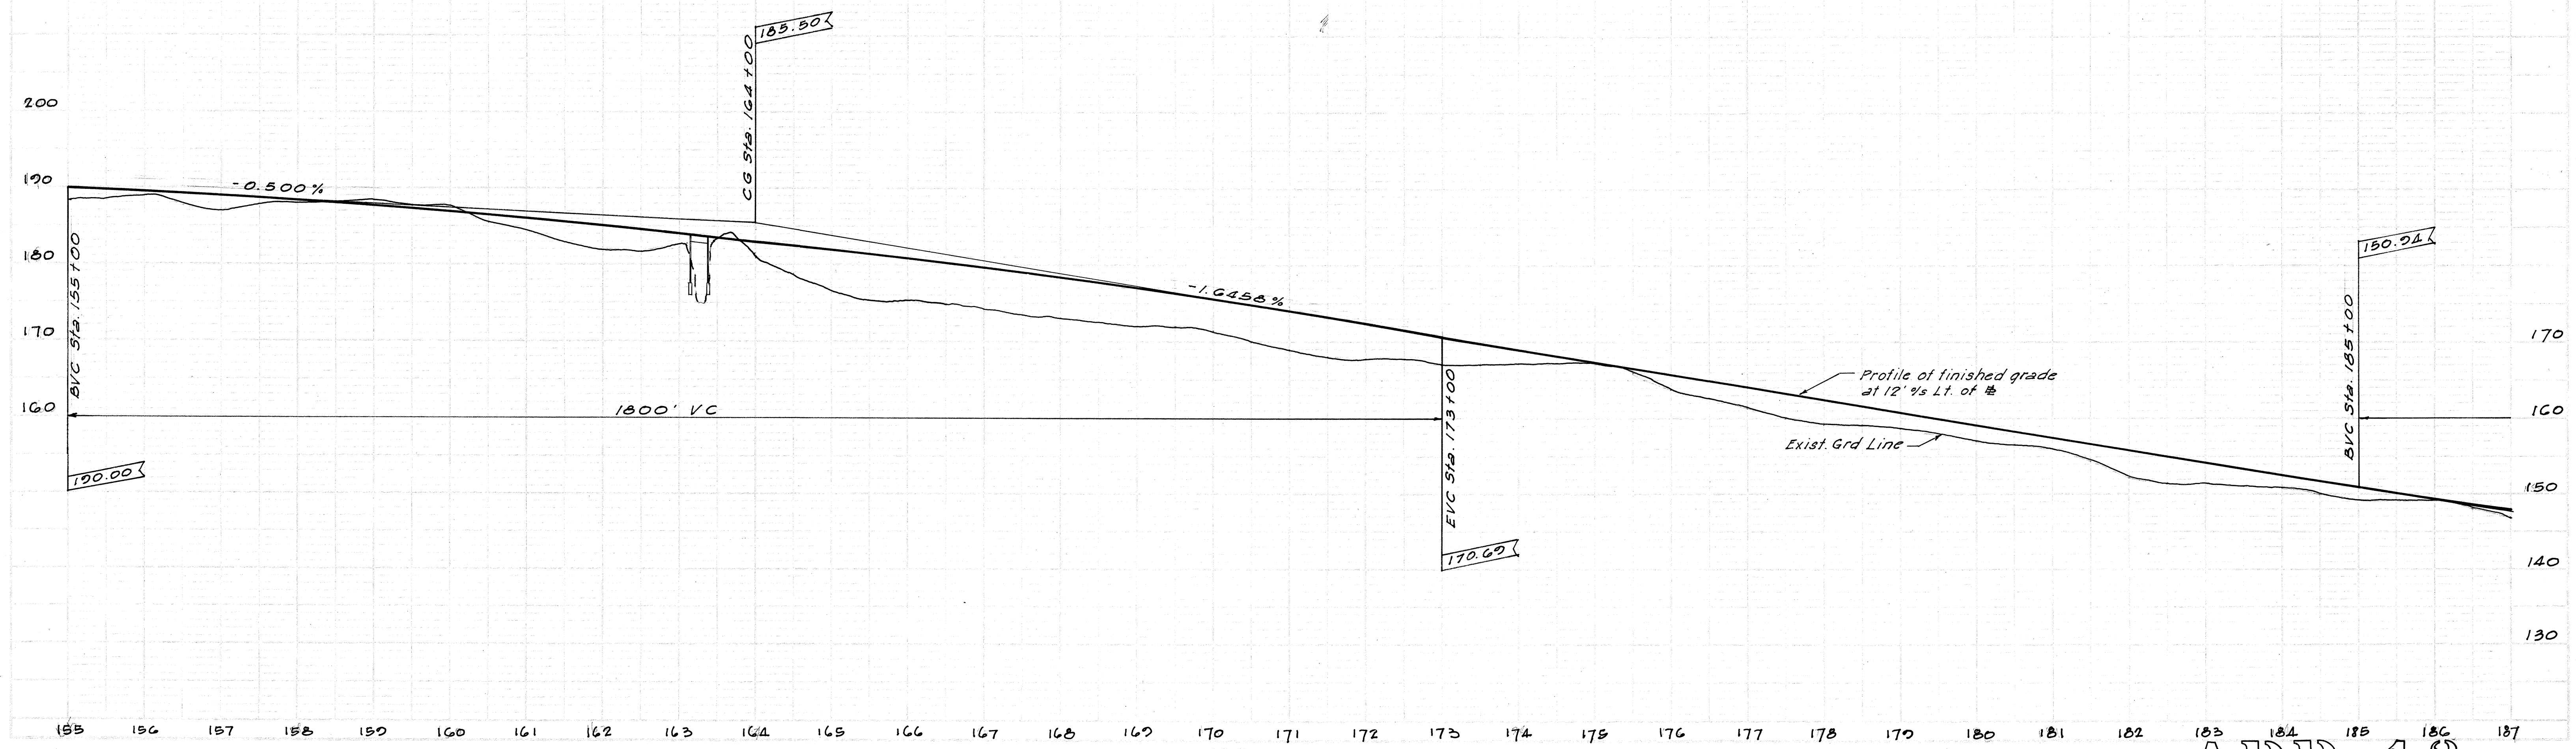

210+48
Sta. 191+00 to 209+00 Lt.
Construct Reinforced G1013.5
Conc. Gutter
For Detail See Sht. No. 33

Estimated Quantities
Class B Conc.
or Shotcrete 105 c.y.
Reinf. Steel 2,835 lbs.

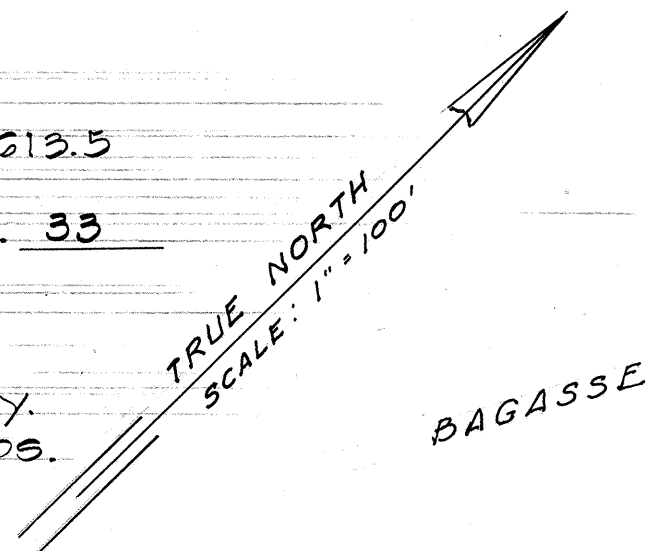


Sta. 200+90 Lt.
Electric Switch Box and
Valve Box to be Relocated
by Owner.

Sta. 201+00 to 215+00 Lt. & Rt.
Water Sprinklers to be
Relocated by Owner

Sta. 207+80 Lt. & Rt.
Power Pole to be
Relocated by Owner.

FED. ROAD DIST. NO.	STATE	FED. AID PROJ. NO.	FISCAL YEAR	SHEET NO.	TOTAL SHEETS
HAWAII	HAW.	5-0380(6)	1969	13	89

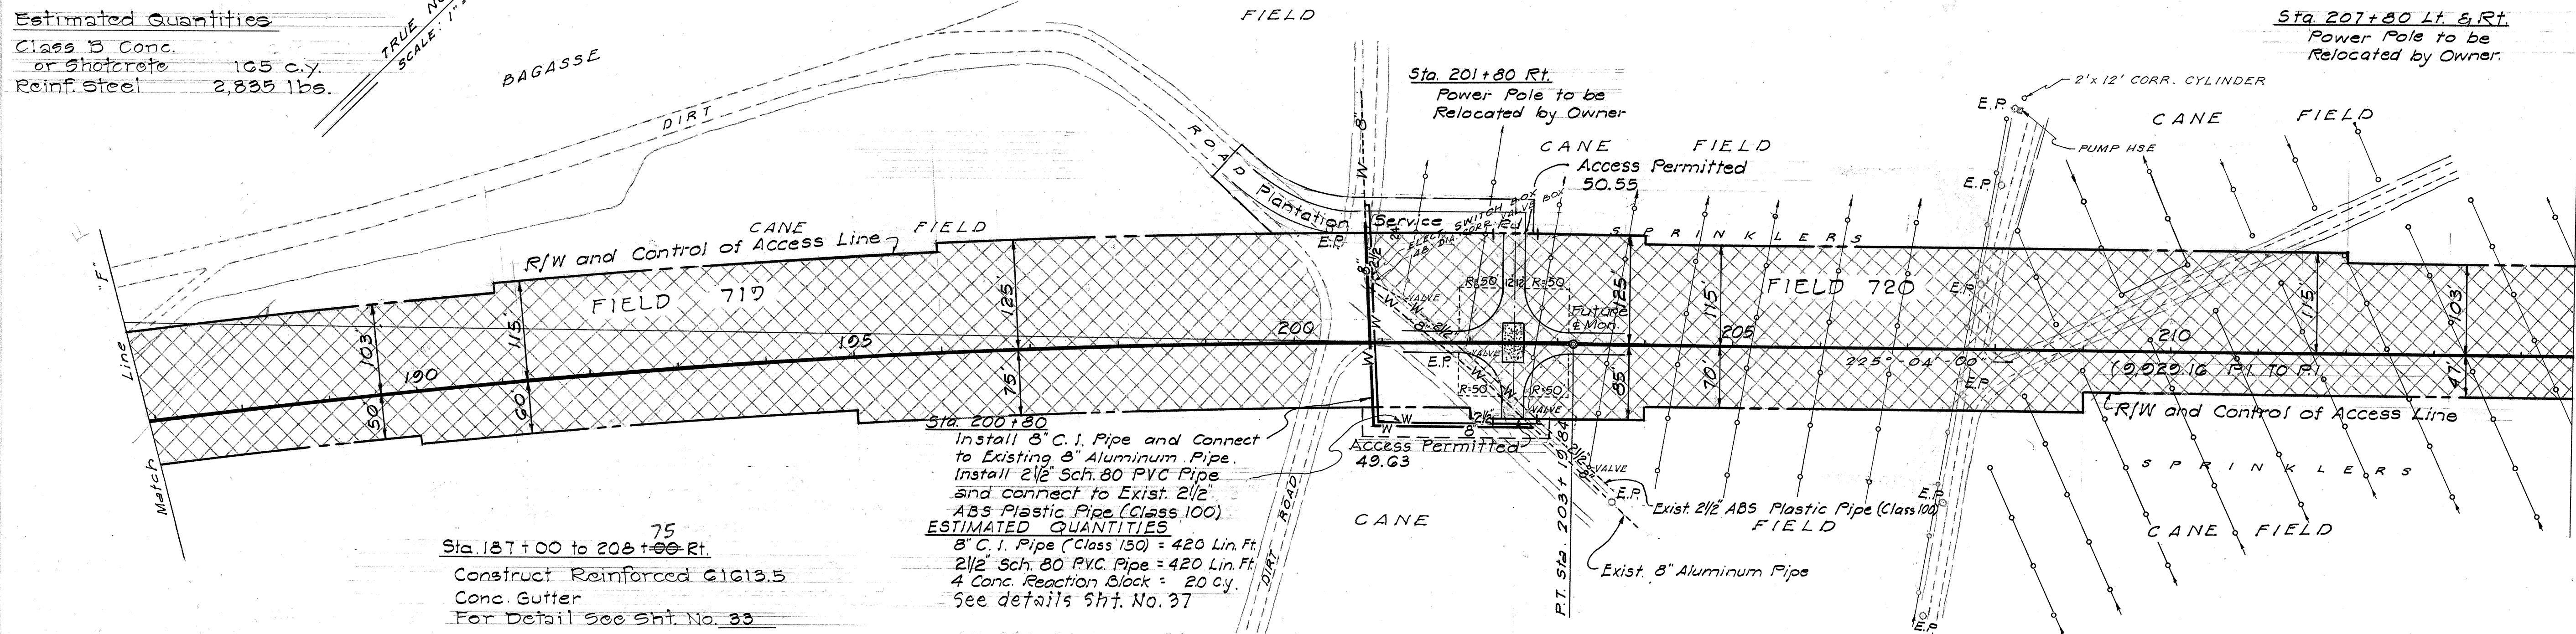

Sta. 187+00 to 206+00 Rt.
Construct Reinforced G1013.5
Conc. Gutter
For Detail See Sht. No. 33

Estimated Quantities
Class B Conc.
or Shotcrete 193 c.y.
Reinf. Steel 3,308 lbs.


Sta. 200+30
Install 8" C.I. Pipe and Connect
to Existing 8" Aluminum Pipe.
Install 2 1/2" Sch. 80 PVC Pipe
and connect to Exist. 2 1/2"
ABS Plastic Pipe (Class 100).
ESTIMATED QUANTITIES
8" C.I. Pipe (Class 150) = 420 Lin. Ft.
2 1/2" Sch. 80 PVC Pipe = 420 Lin. Ft.
4 Conc. Reaction Block = 20 cy.
See details Sht. No. 37

RI-1

Sta. 202+50 Lt. & Rt.
Grade Approaches with Tournahauler Crossing
Pav't Area = 853 sq. yd. 12 1/2" Portland Cement
B.C. Area = 802 sq. yd. Conc. Pavement = 40.74 c.y.
Exc. = 753 c.y.
Emb. = 0 c.y.
Detail of Tournahauler Crossing See Sht. No. 5.
Detail of Graded & Drained Road See Sht. No. 4.
Lay 4 inches of Aggregate Subbase for
Temporary Crossing.




FED. ROAD DIST. NO.	STATE	FED. AID PROJ. NO.	FISCAL YEAR	SHEET NO.	TOTAL SHEETS
HAWAII	HAW.	5-0380(6)	1969	14	89

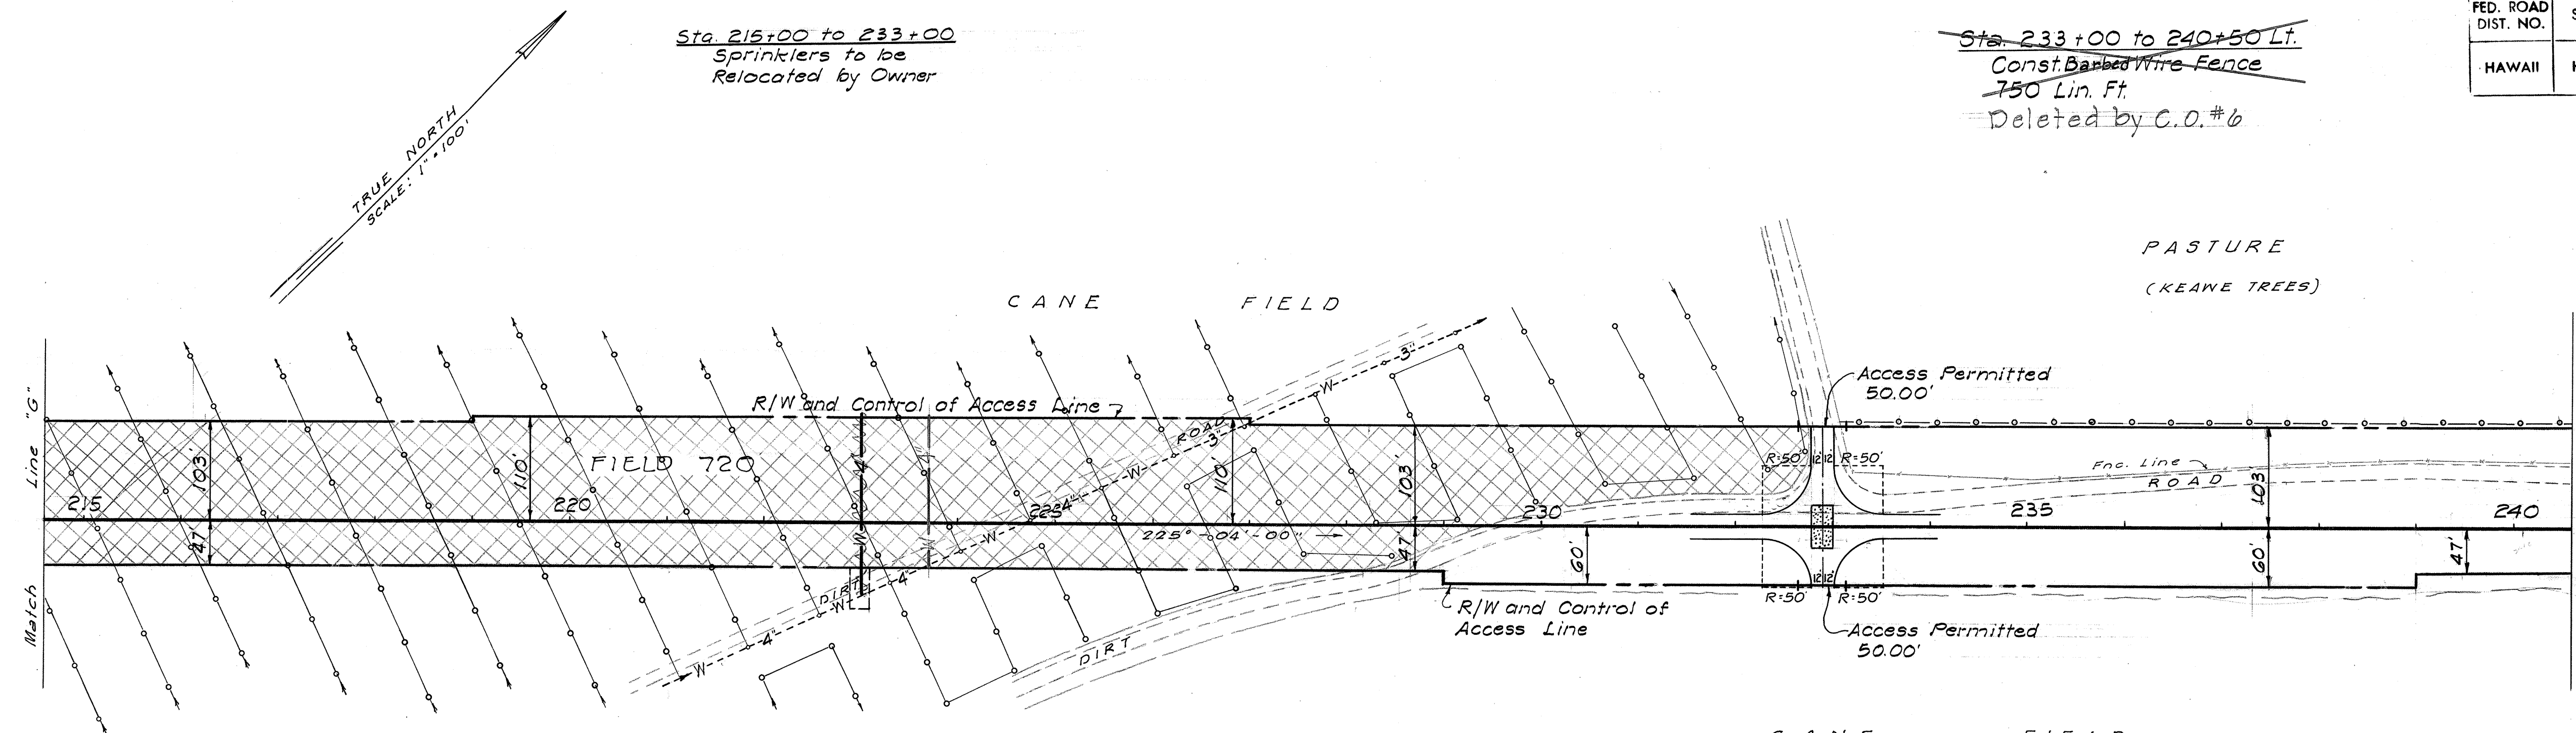


67.41
 Sta. 223+00
 Inst. 4" Sch. 80 P.V.C. Pipe
 Connect to Existing
 4" ABS Plastic Pipe
 For Detail See Sht. No. 37
 ESTIMATED QUANTITIES
 4" Sch. 80 P.V.C. Pipe = 100 Lin. Ft.
 2 Reaction Blocks = 1 c.y.

Sta. 232+90 Lt. & Rt.
 Grade Approaches with Tournahauler Crossing
 Pav't. Area = 609 s.y. 12 1/2" Portland Cement
 B.C. Area = 630 s.y. Conc. Pavement = 40.74 c.y.
 Exc. = 76 c.y.
 Emb. = 239 c.y.
 For Detail of Tournahauler Crossing See Sht. No. 5.
 Lay 8 inches of Aggregate Subbase for Temporary Crossing.

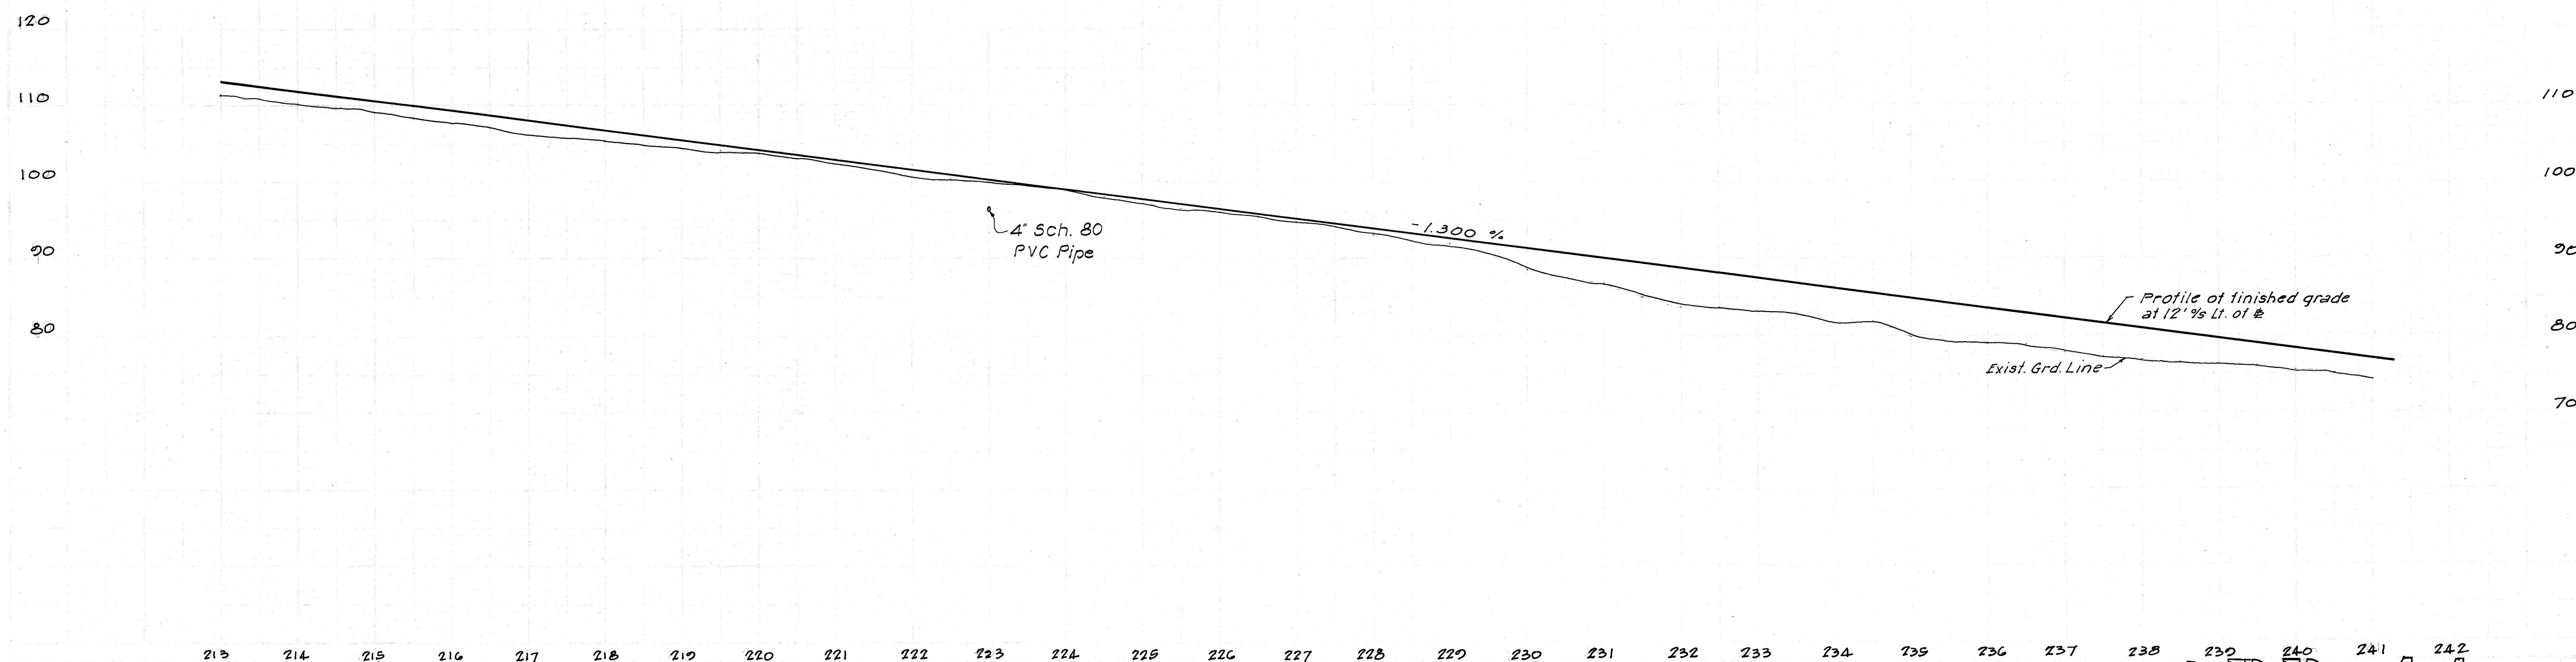

FED. ROAD DIST. NO.	STATE	FED. AID PROJ. NO.	FISCAL YEAR	SHEET NO.	TOTAL SHEETS
HAWAII	HAW.	50380(6)	1969	15	89

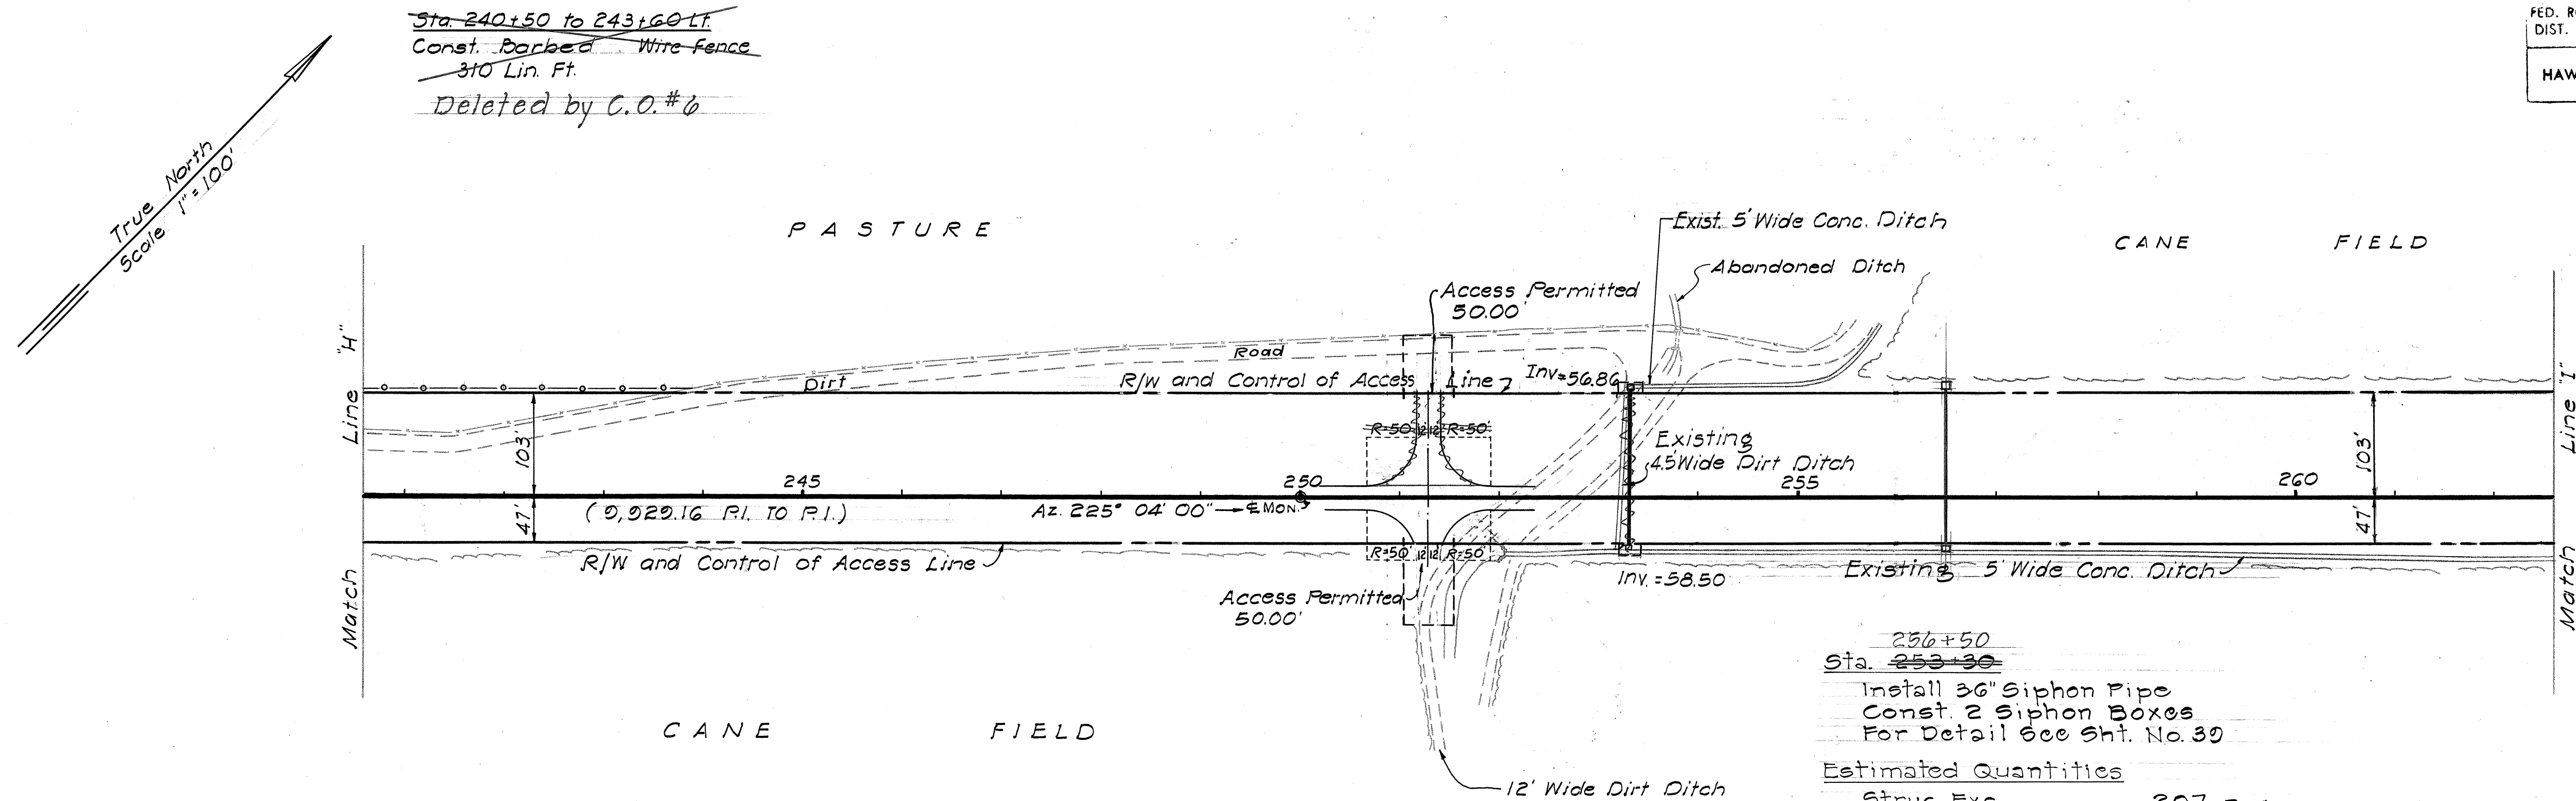


Sta. 251+~~25~~ Lt. & Rt.
 Grade Approaches
 Pav't. Area = 571 s.y.
 B.C. Area = 590 s.y.
 Exc. = 97 c.y.
 Emb. = 18 c.y.
 Lay 9 inches of Aggregate Subbase
 for Temporary Crossing.



256+50
 Sta. 253+30
 Install 36" Siphon Pipe
 Const. 2 Siphon Boxes
 For Detail See Sht. No. 30

Estimated Quantities

Struc. Exc.	207 c.y.
Ditch & Channel Exc.	19 c.y.
Class B Conc.	9 c.y.
Class B Conc. or Shotcrete	5 c.y.
Reinf. Steel	558 lbs.
36" Siphon Pipe	153 l.f.
Wooden Gate	2 ea.

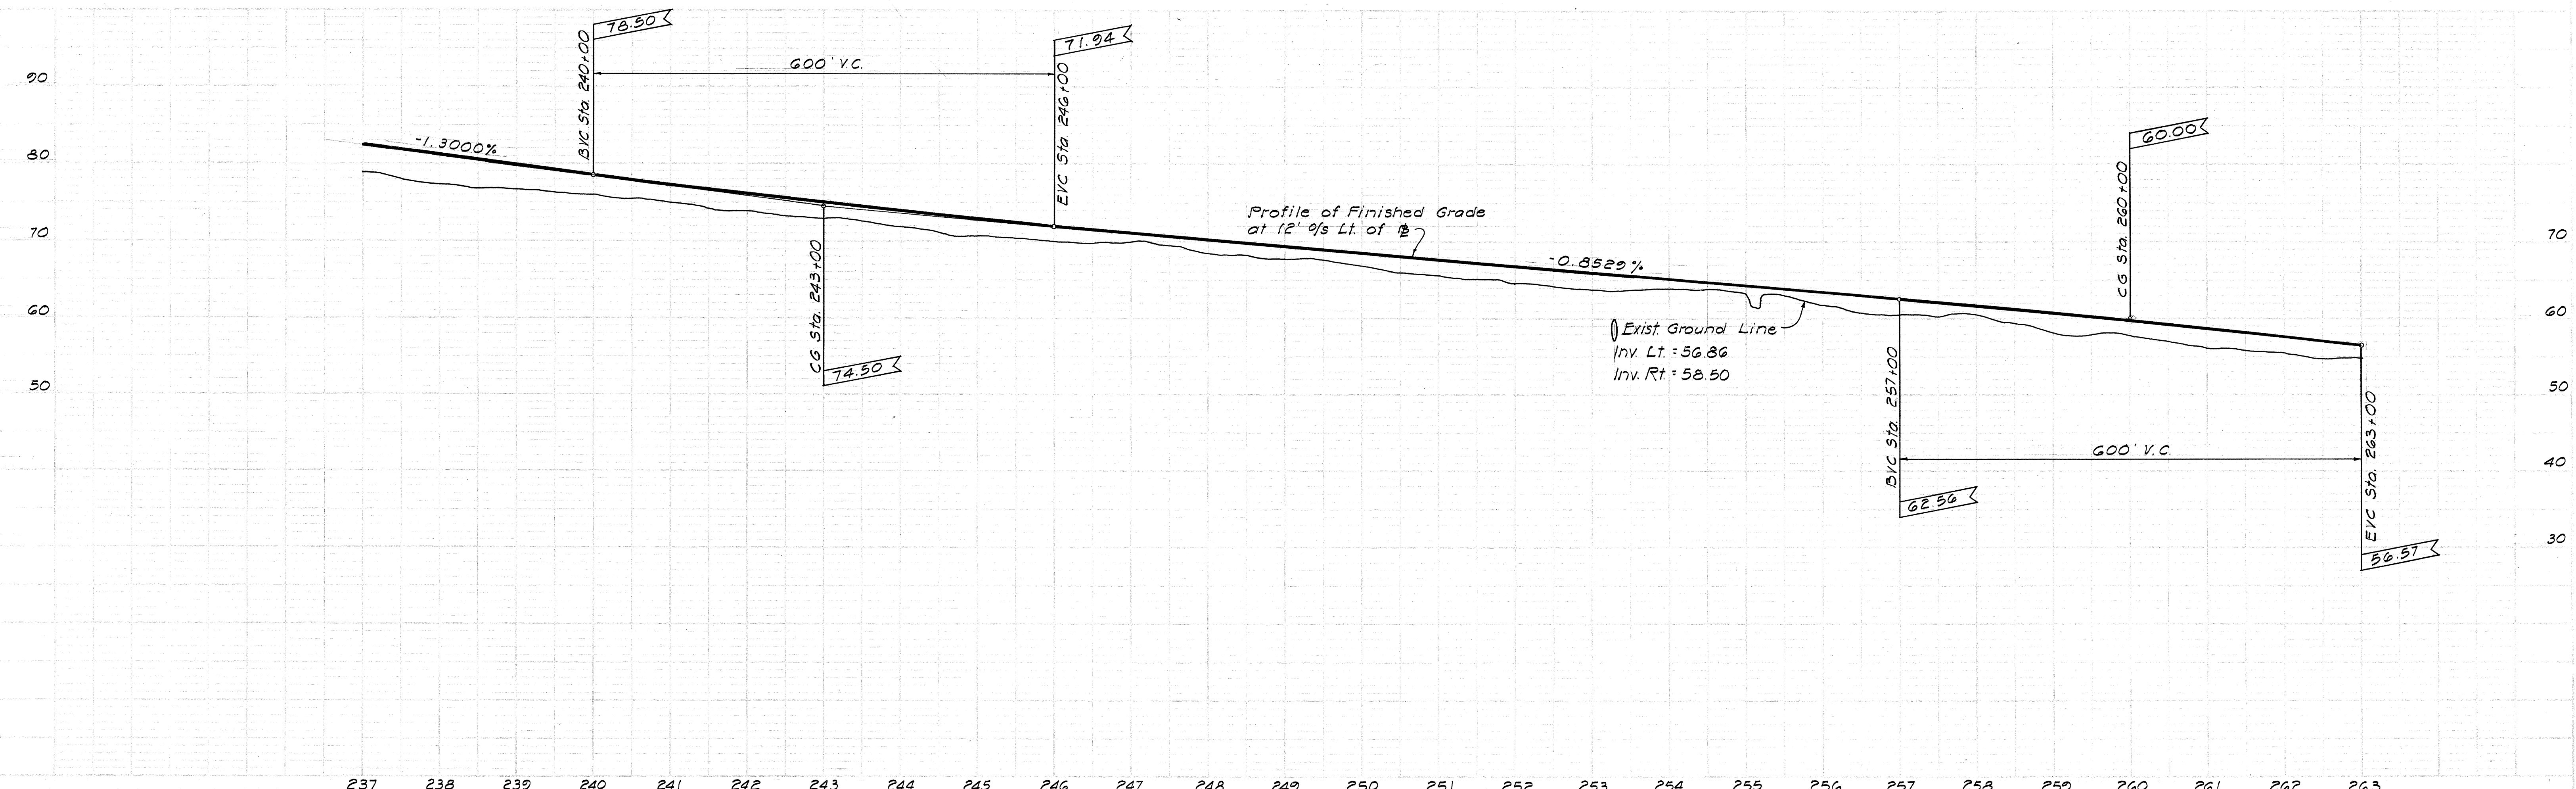

FED. ROAD DIST. NO.	STATE	FED. AID PROJ. NO.	FISCAL YEAR	SHEET NO.	TOTAL SHEETS
HAWAII	HAW.	5-0380(6)	1969	16	89

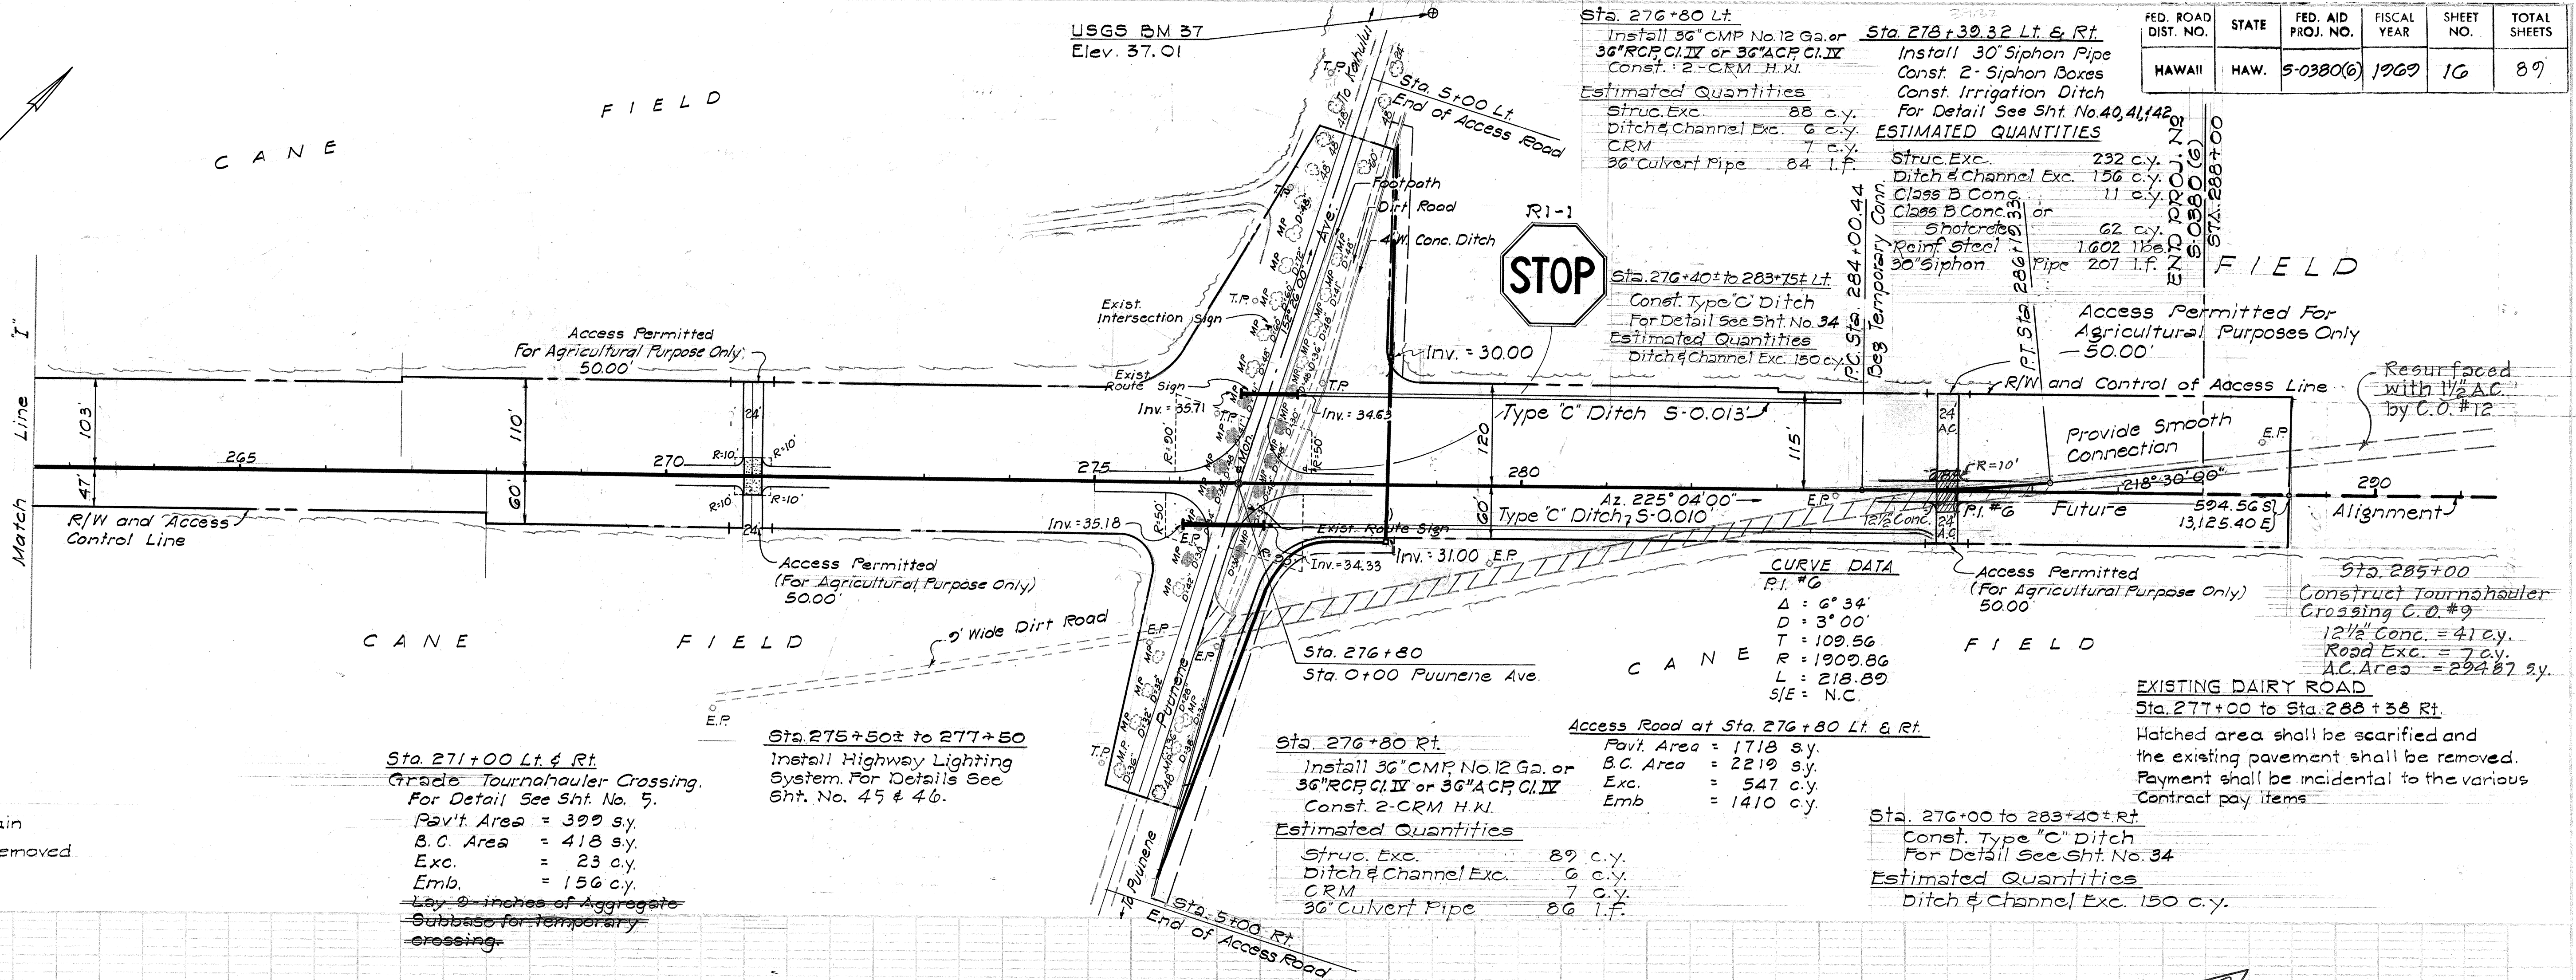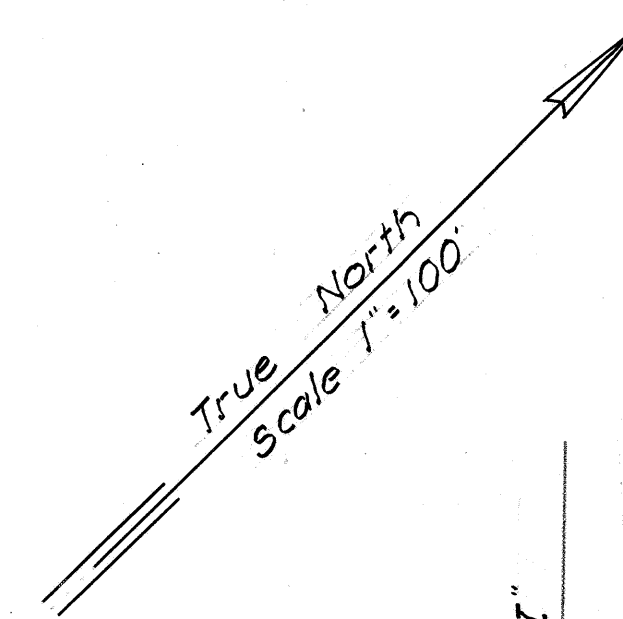

LEGEND FOR TREES
 ☉ Existing trees to remain
 ● Existing trees to be removed

Sta. 271+00 Lt. & Rt.
 Grade Tournahauler Crossing.
 For Detail See Sht. No. 5.
 Pav't Area = 399 s.y.
 B.C. Area = 418 s.y.
 Exc. = 23 c.y.
 Emb. = 156 c.y.
 Lay 6 inches of Aggregate
 Subbase for temporary crossing.

Sta. 275+50± to 277+50
 Install Highway Lighting
 System. For Details See
 Sht. No. 45 & 46.

Sta. 276+80 Rt.
 Install 36" CMP No. 12 Ga. or
 36" RCP C.I. IV or 36" ACP C.I. IV
 Const. 2-CRM H.W.
Estimated Quantities
 Struc. Exc. 89 c.y.
 Ditch & Channel Exc. 6 c.y.
 CRM 7 c.y.
 36" Culvert Pipe 86 l.f.

Access Road at Sta. 276+80 Lt. & Rt.
 Pav't Area = 1718 s.y.
 B.C. Area = 2219 s.y.
 Exc. = 547 c.y.
 Emb. = 1410 c.y.

Sta. 276+00 to 283+40± Rt.
 Const. Type "C" Ditch
 For Detail See Sht. No. 34
Estimated Quantities
 Ditch & Channel Exc. 150 c.y.

EXISTING DAIRY ROAD
 Sta. 277+00 to Sta. 283+38 Rt.
 Hatched area shall be scarified and
 the existing pavement shall be removed.
 Payment shall be incidental to the various
 Contract pay items.



NOTE

- Existing Stop Sign and Chain and Pipe Gate for Cane Haul Road to be Relocated to New Location as shown or Ordered by the Engineer. The work must conform to the requirements of Section 022, except payment incidental to the various items.
- The Contractor shall provide for a continuous flow when work is being done on the Siphons. The work shall be coordinated with Wailuku Sugar Co.

True North
Scale 1" = 100'

CANE HAUL ROAD

CURVE No. 1
Δ = 2°-04'-41"
D = 0°-10'-00"
L = 1246.88'
T = 623.48'

CURVE No. 2
Δ = 45°00'
Δ/2 = 22°30'
R = 96.33
T = 39.90
L = 75.66

CURVE No. 3
Δ = 134°50'
Δ/2 = 67°25'
R = 50.00'
T = 120.22
L = 117.66

Sta. 14+40.20

Install 24" siphon pipe
Construct 2 siphon boxes
For Details See Sht. No. 43.

Estimated Quantities

Struc. Exc. 05 c.y.
Ditch & Channel Exc. 4 c.y.
Class B Conc. 10 c.y.
Class B Conc. on Shotcrete 2 c.y.
Reinf. Steel 595 lbs.
24" Siphon Pipe 32 l.f.
Type 'A' Trash Rack 2 ea.



30" x 30"

* R1-1

PT. Sta. 14+40.20 EQ = PLUS 75.96

PT. Sta. 13+64.24

TP Conc. EP Ditch 7

TP Conc. EP Ditch 7

FED. ROAD DIST. NO.	STATE	FED. AID PROJ. NO.	FISCAL YEAR	SHEET NO.	TOTAL SHEETS
HAWAII	HAW.	5-0380(6)	1969	17	89

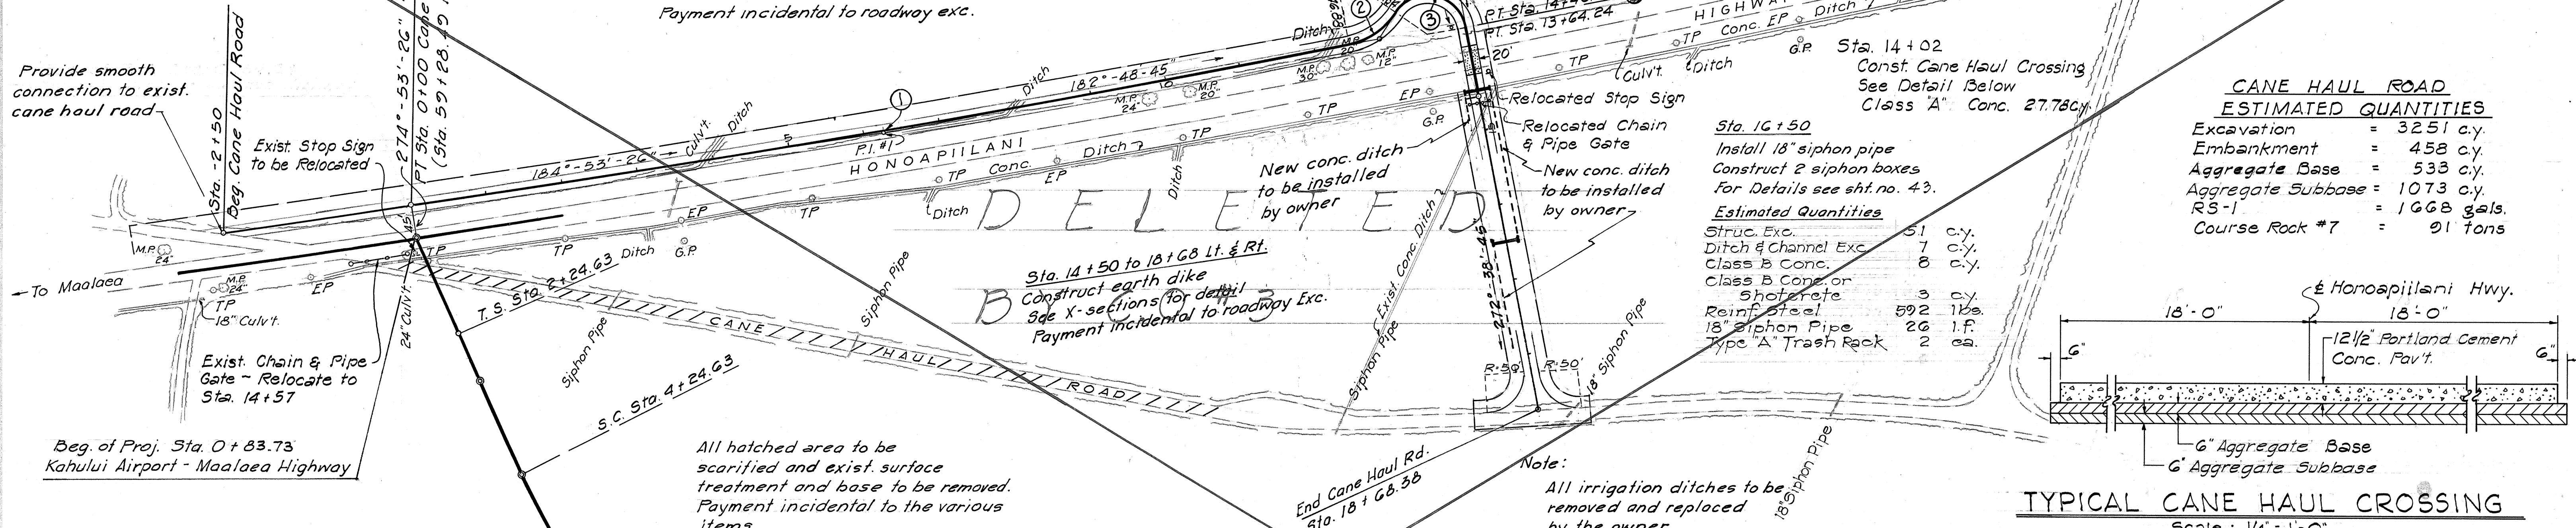


- *NOTE
- The shape, color, dimensions, symbols, wording, lettering and reflectorization of all signs shall be in accordance with the Manual on Uniform Traffic Control Devices for Streets and Highways, dated June 1961 and the BPR manual "Standard Highway Signs," dated September 1961 unless otherwise specified.
 - The regulatory signs shall be reflectorized unless otherwise specified.
 - The regulatory signs shall have 3/8" bolt holes drilled at appropriate locations unless otherwise noted.

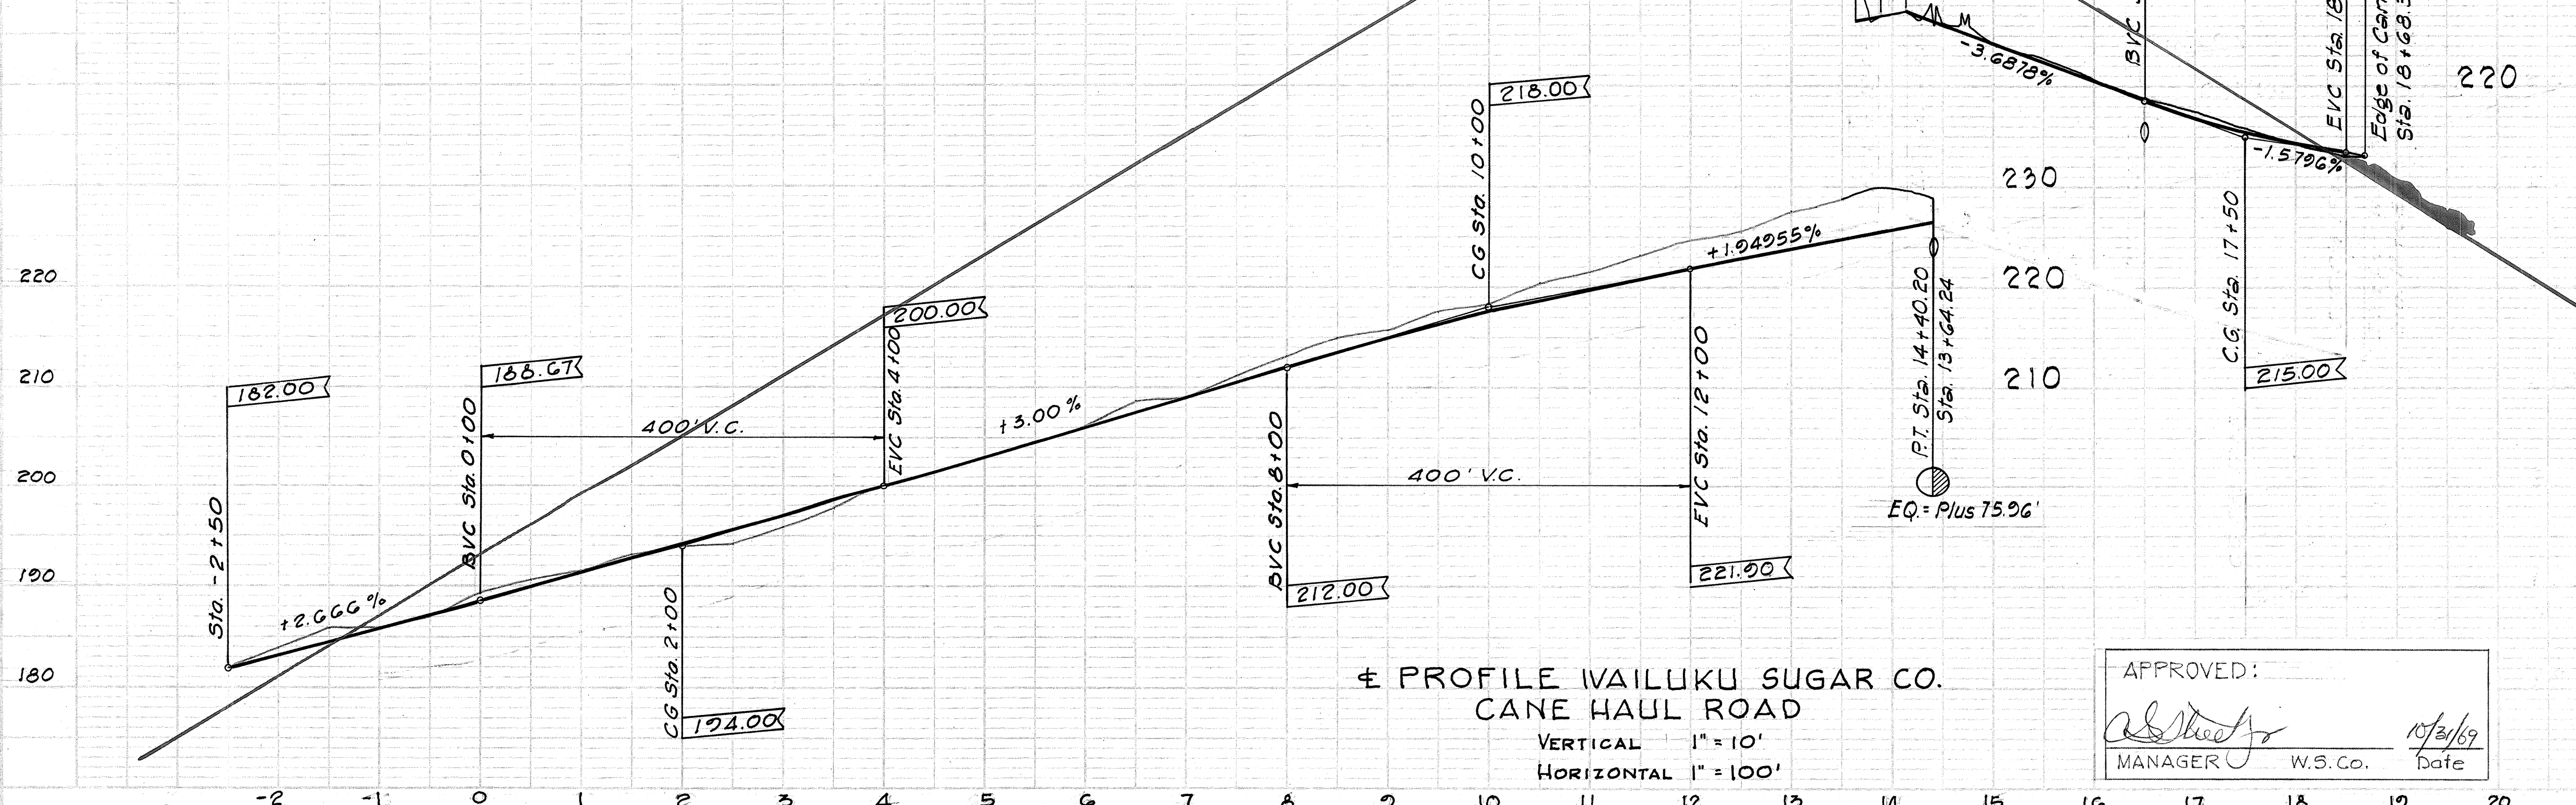

APPROVED: *[Signature]*
MANAGER W.S. Co. 10/31/69
Date


TYPICAL CANE HAUL CROSSING

Scale: 1/4" = 1'-0"

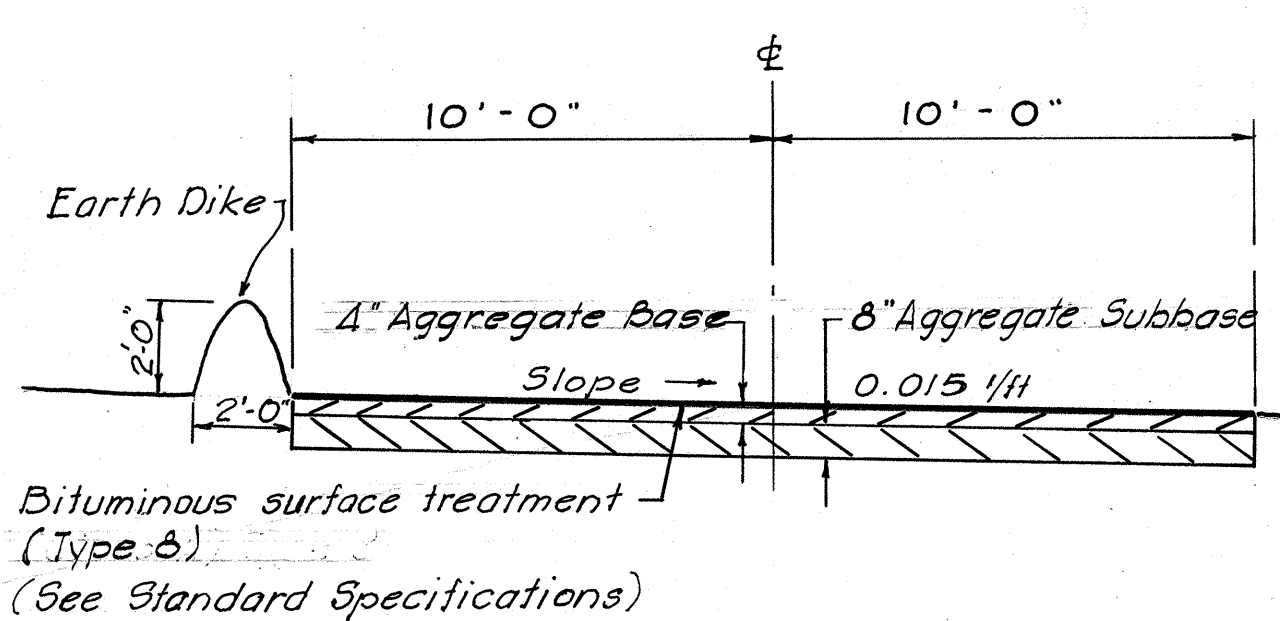

TYPICAL SECTION

STA. -2+50 TO STA. 13+50
Scale: 1/4" = 1'-0"

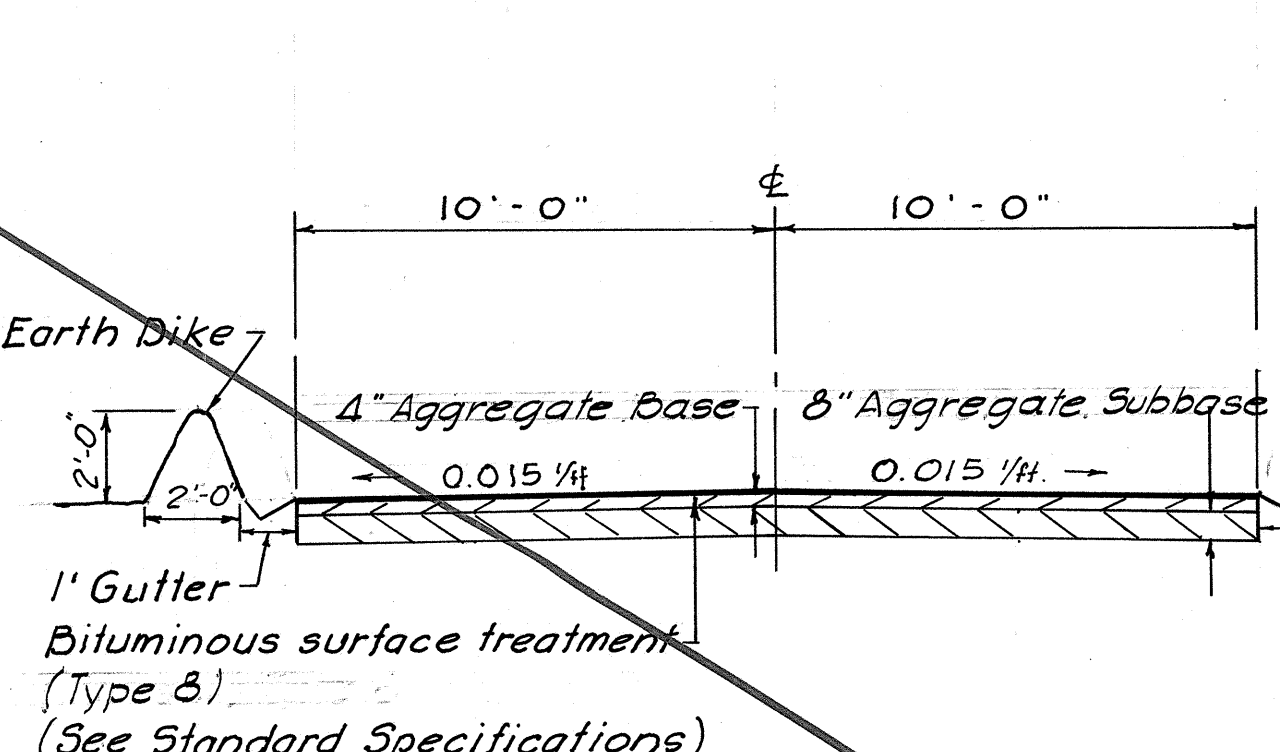

TYPICAL SECTION

STA. 14+00 TO STA. 18+68
Scale: 1/4" = 1'-0"

