
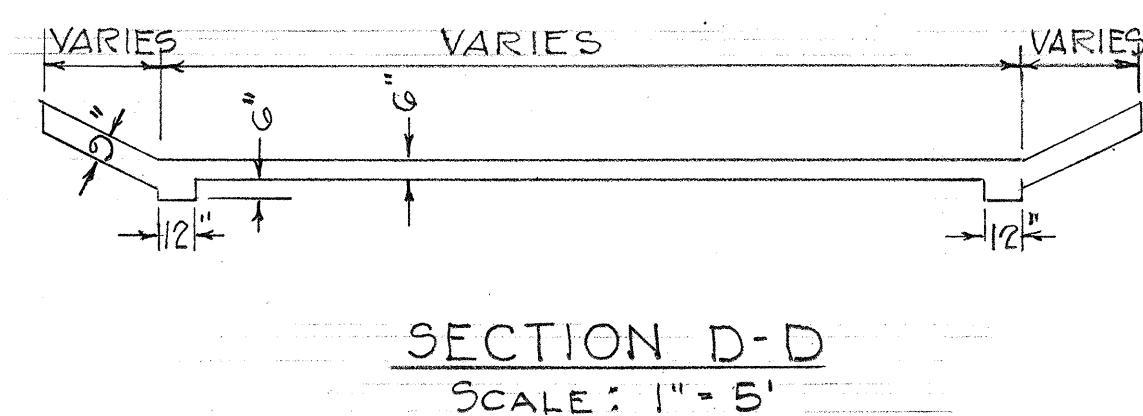
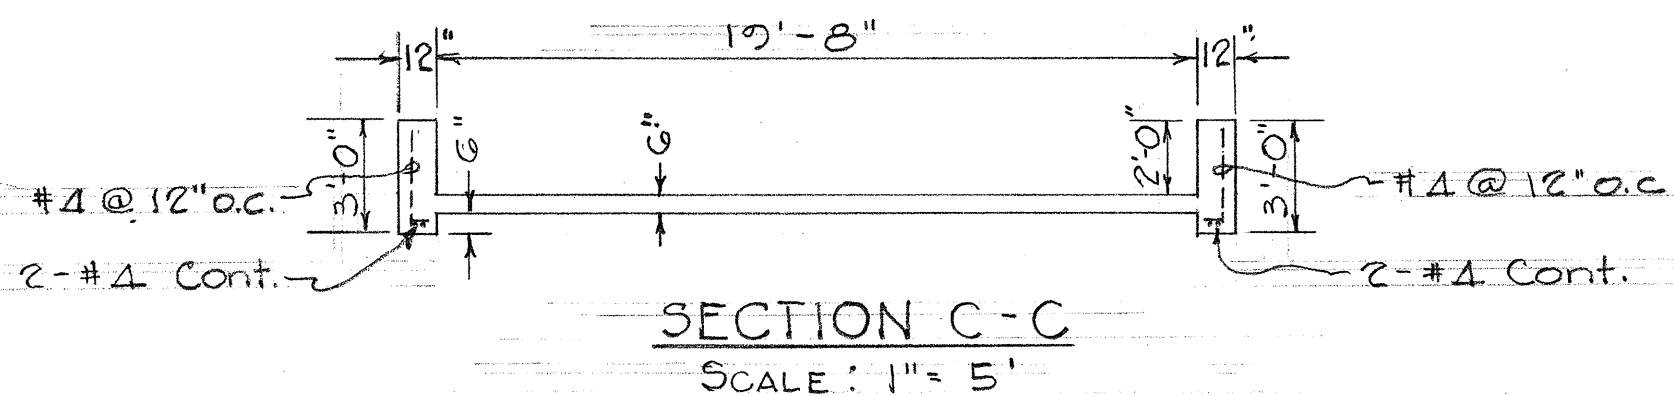
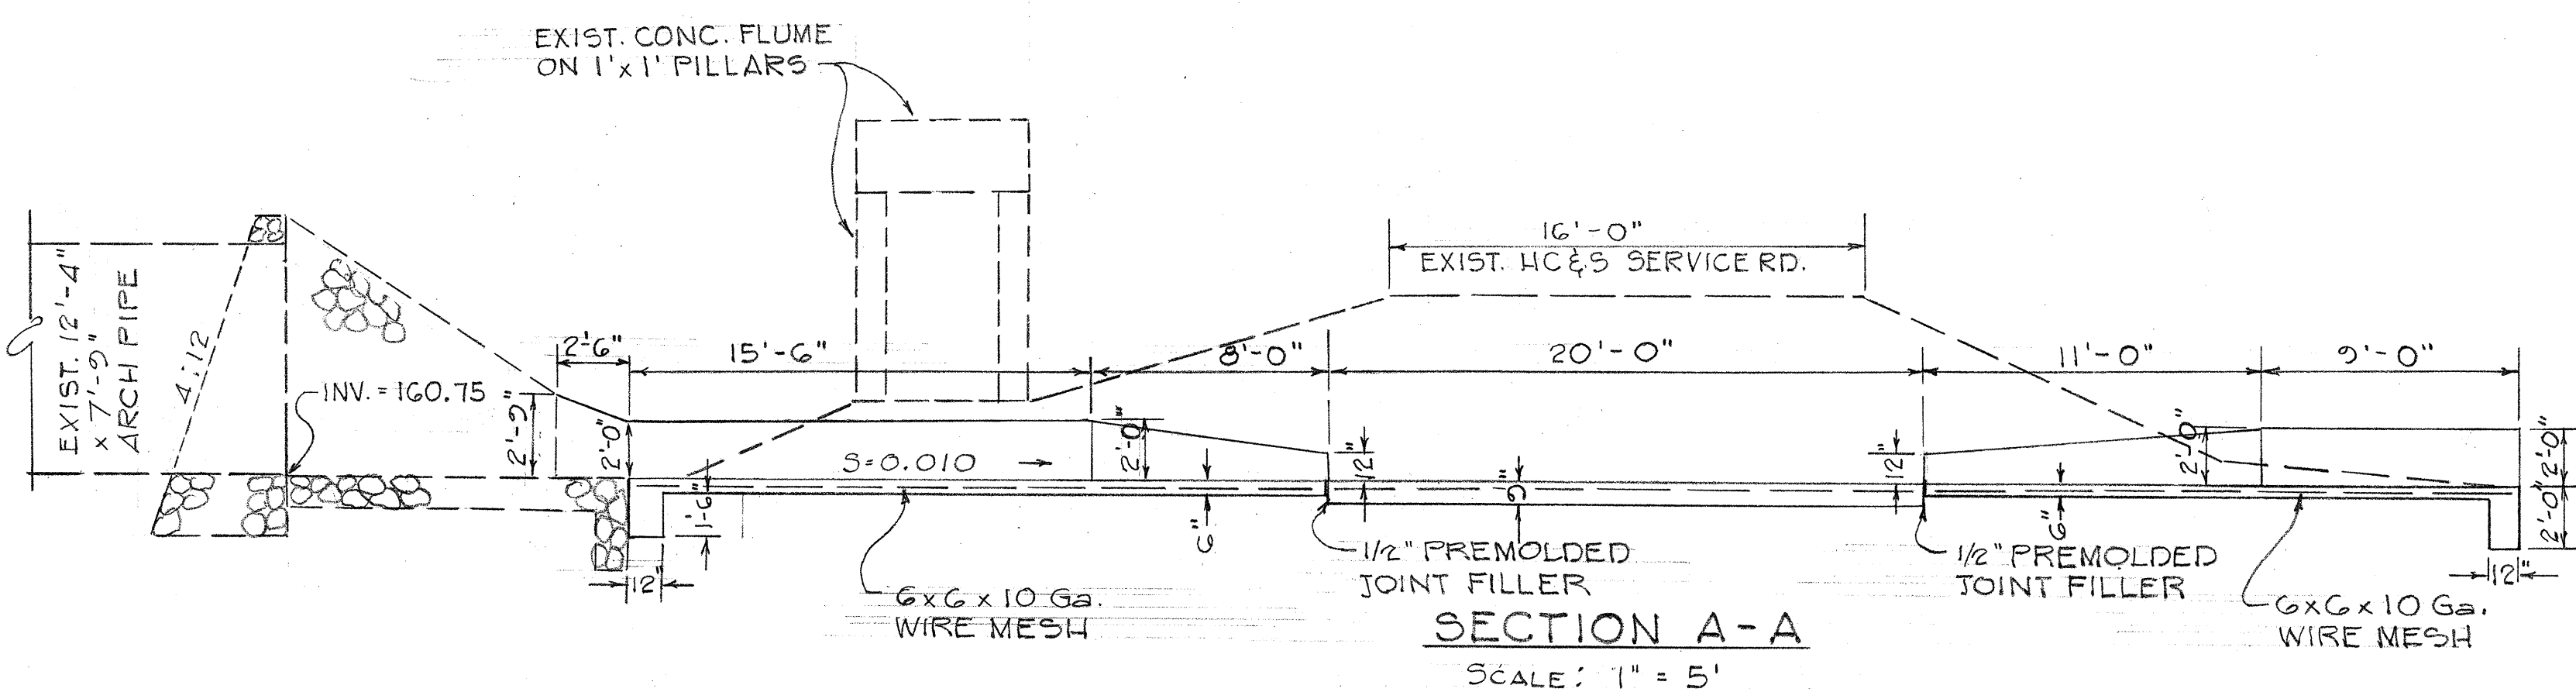
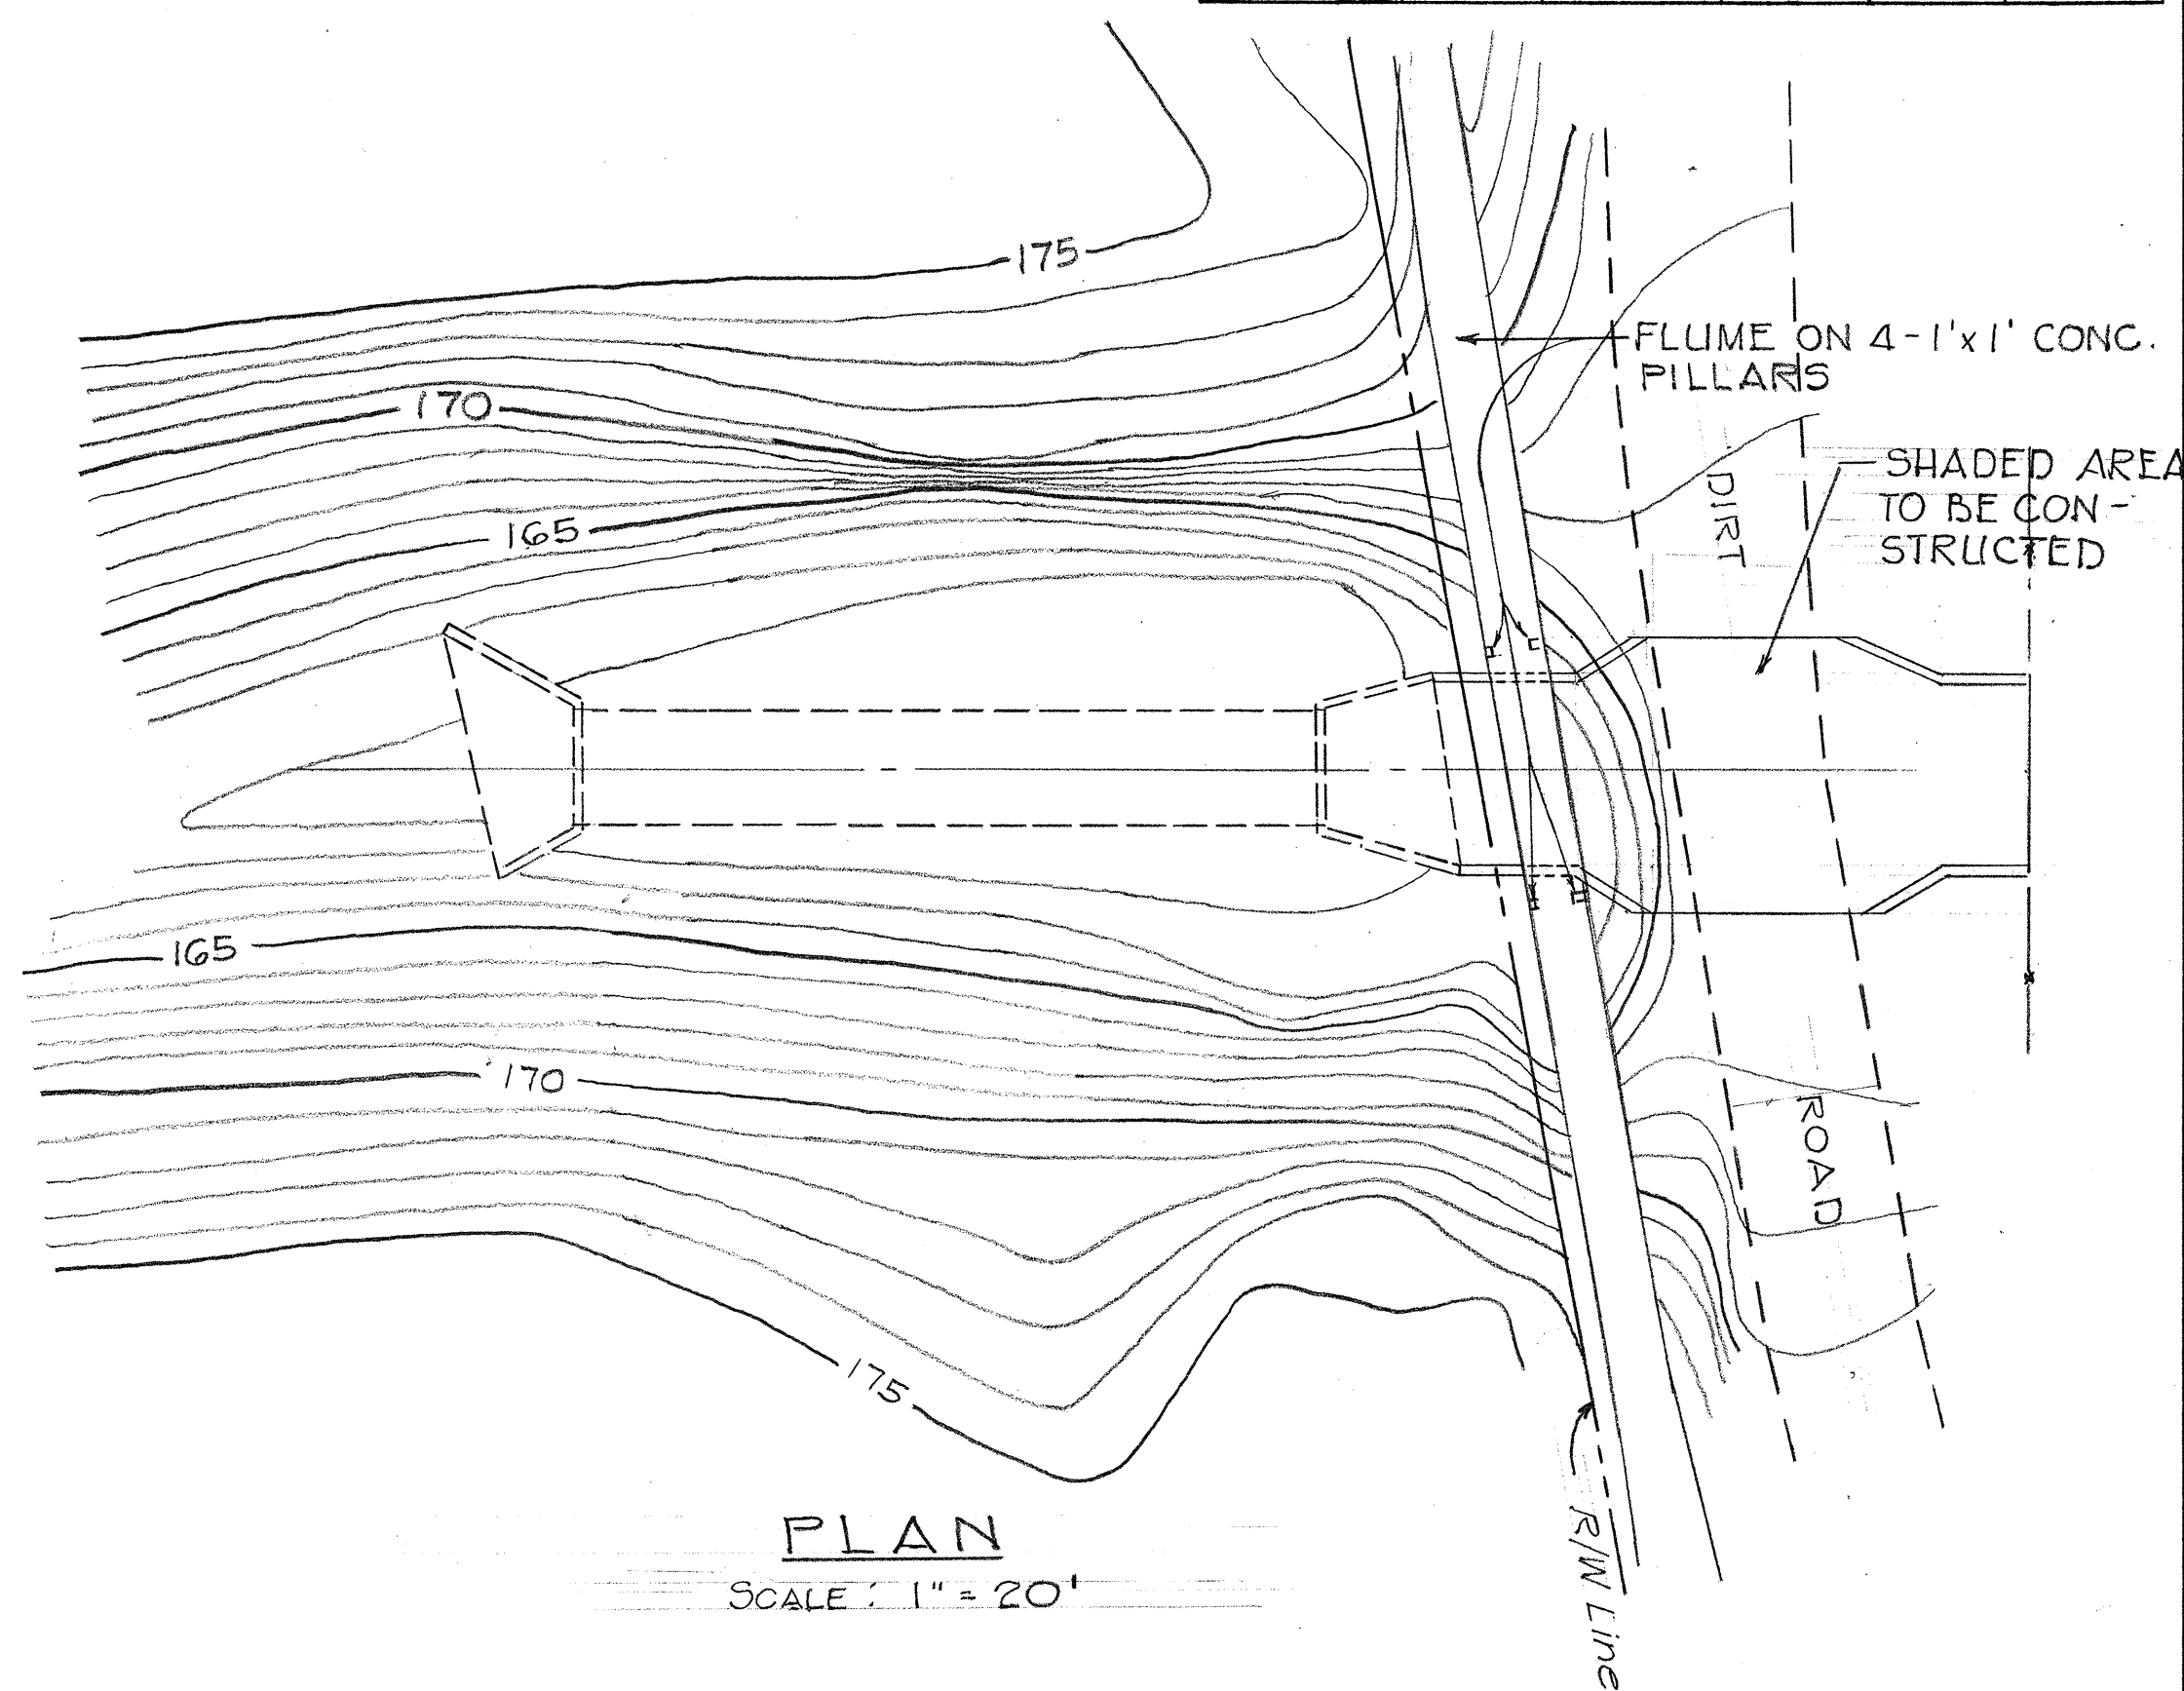


FED. ROAD DIST. NO.	STATE	FED. AID PROJ. NO.	FISCAL YEAR	SHEET NO.	TOTAL SHEETS
HAWAII	HAW.				

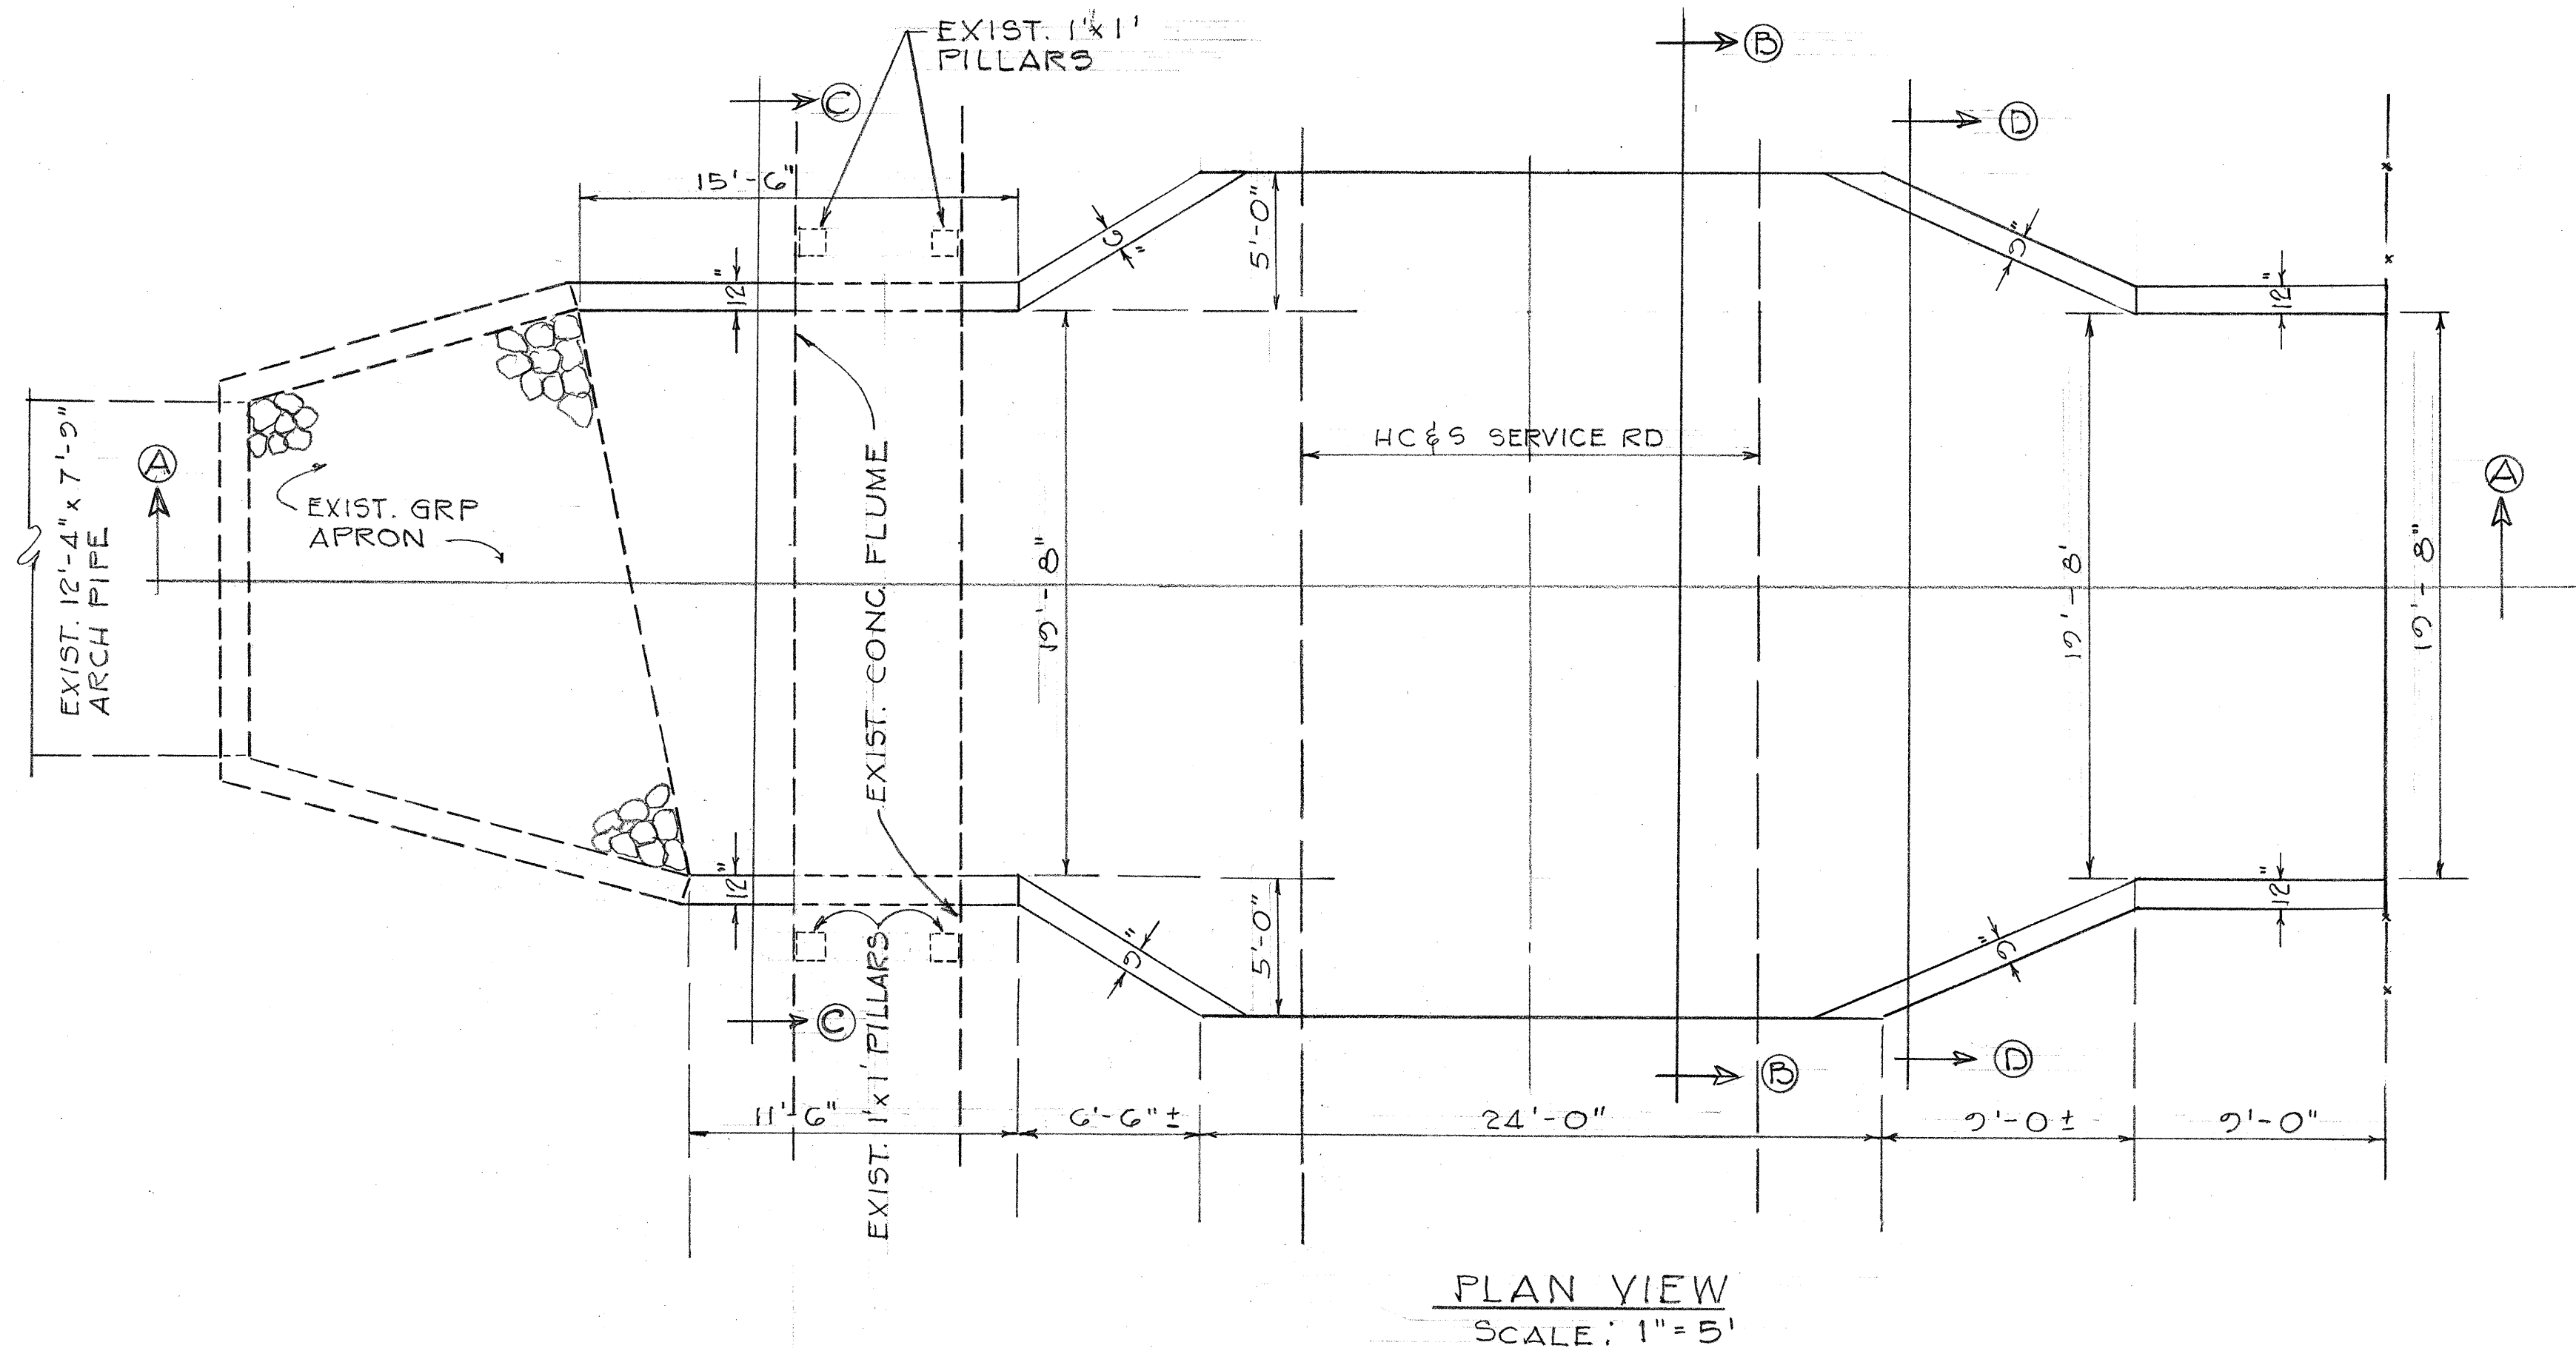

ESTIMATED QUANTITIES

Special Exc.	=	577 cy.
Class "B" Conc.	=	56 cy.
Reinf. Steel	=	411 lb.
Aggregate Base	=	20 cy.

STATE OF HAWAII DEPARTMENT OF TRANSPORTATION HIGHWAYS DIVISION	
CHANGE ORDER NO. 2	
KAHULUI AIRPORT-MAALAEA HWY. (KAHULUI AIRPORT-PUUNENE AVE.)	
Proj. No. S-0380(5)	Jul. 1971
Scale as noted	
SHEET No.	OF SHEETS

DATE	
SURVEY PLOTTED BY	
DRAWN BY	
DESIGNED BY	
CHECKED BY	
NOTE BOOK	
No.	