
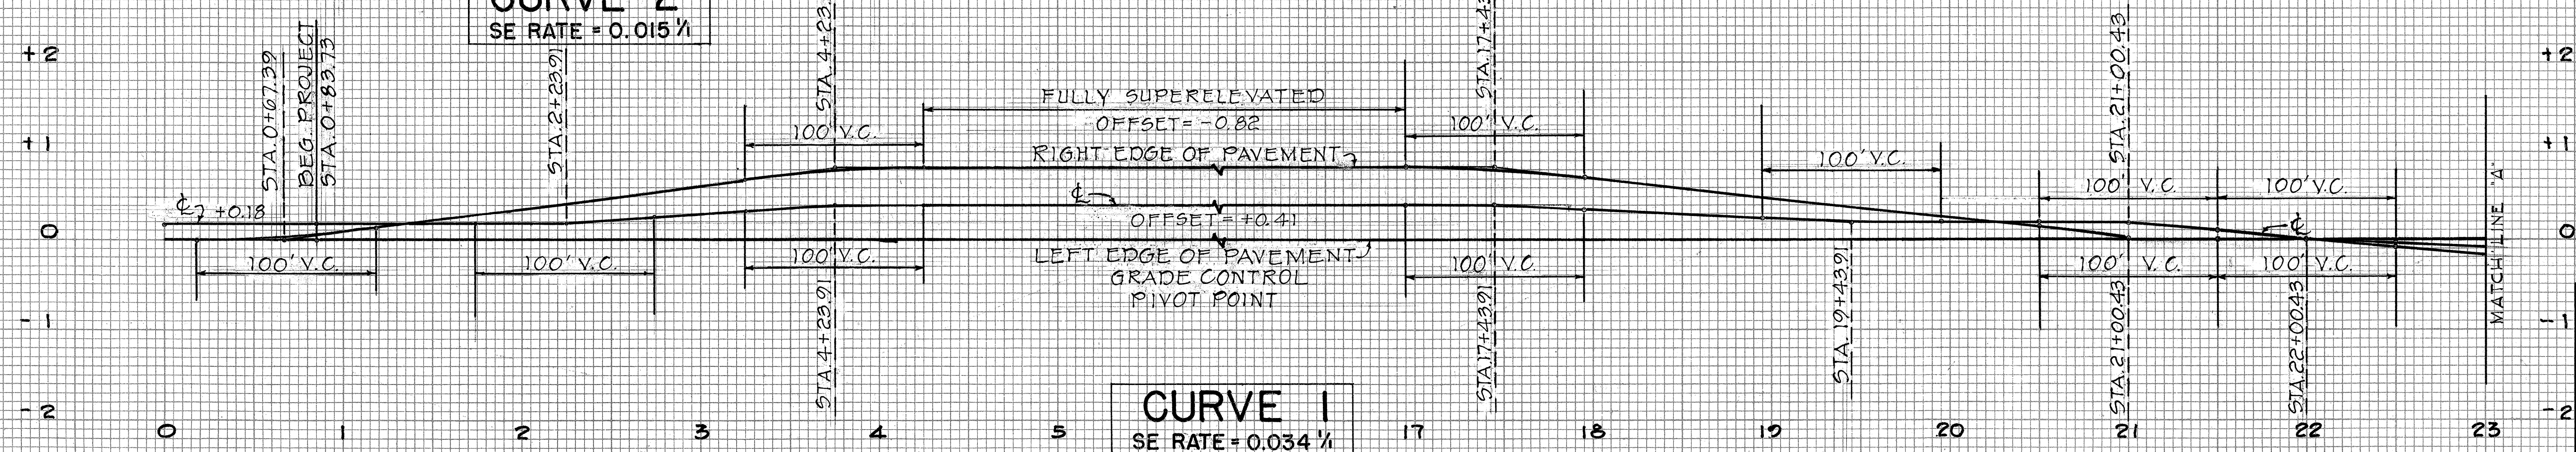
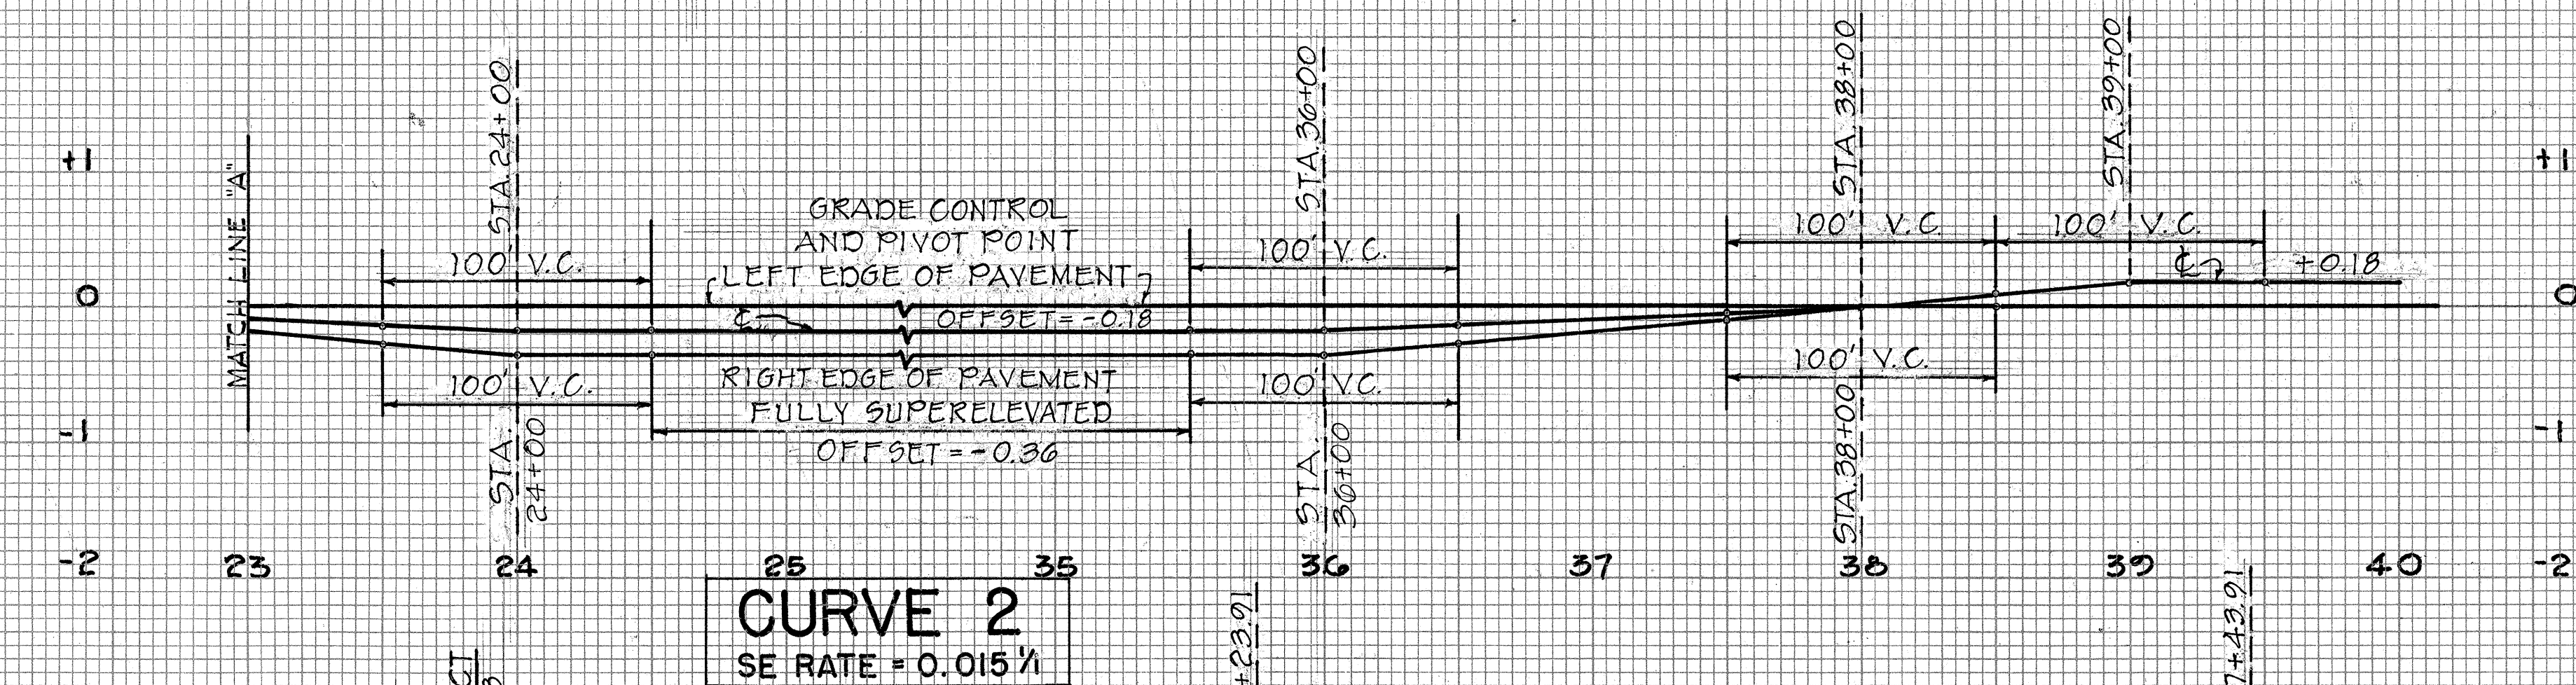


FED. ROAD DIST. NO.	STATE	FED. AID PROJ. NO.	FISCAL YEAR	SHEET NO.	TOTAL SHEETS
HAWAII	HAW.	5-0380 (5)	1970	15	44

FINAL SURVEY	SURVEYED _____	BY _____	DATE _____
	PLOTTED _____ TEMPLATE _____ AREAS _____ AREAS CHECKED _____		
NOTE BOOK			
NO. _____			

ORIGINAL	BY _____	DATE _____
SURVEY		
PLOTTED		
TEMPLATE		
AREAS CHECKED		
NOTE BOOK		
NO. _____		

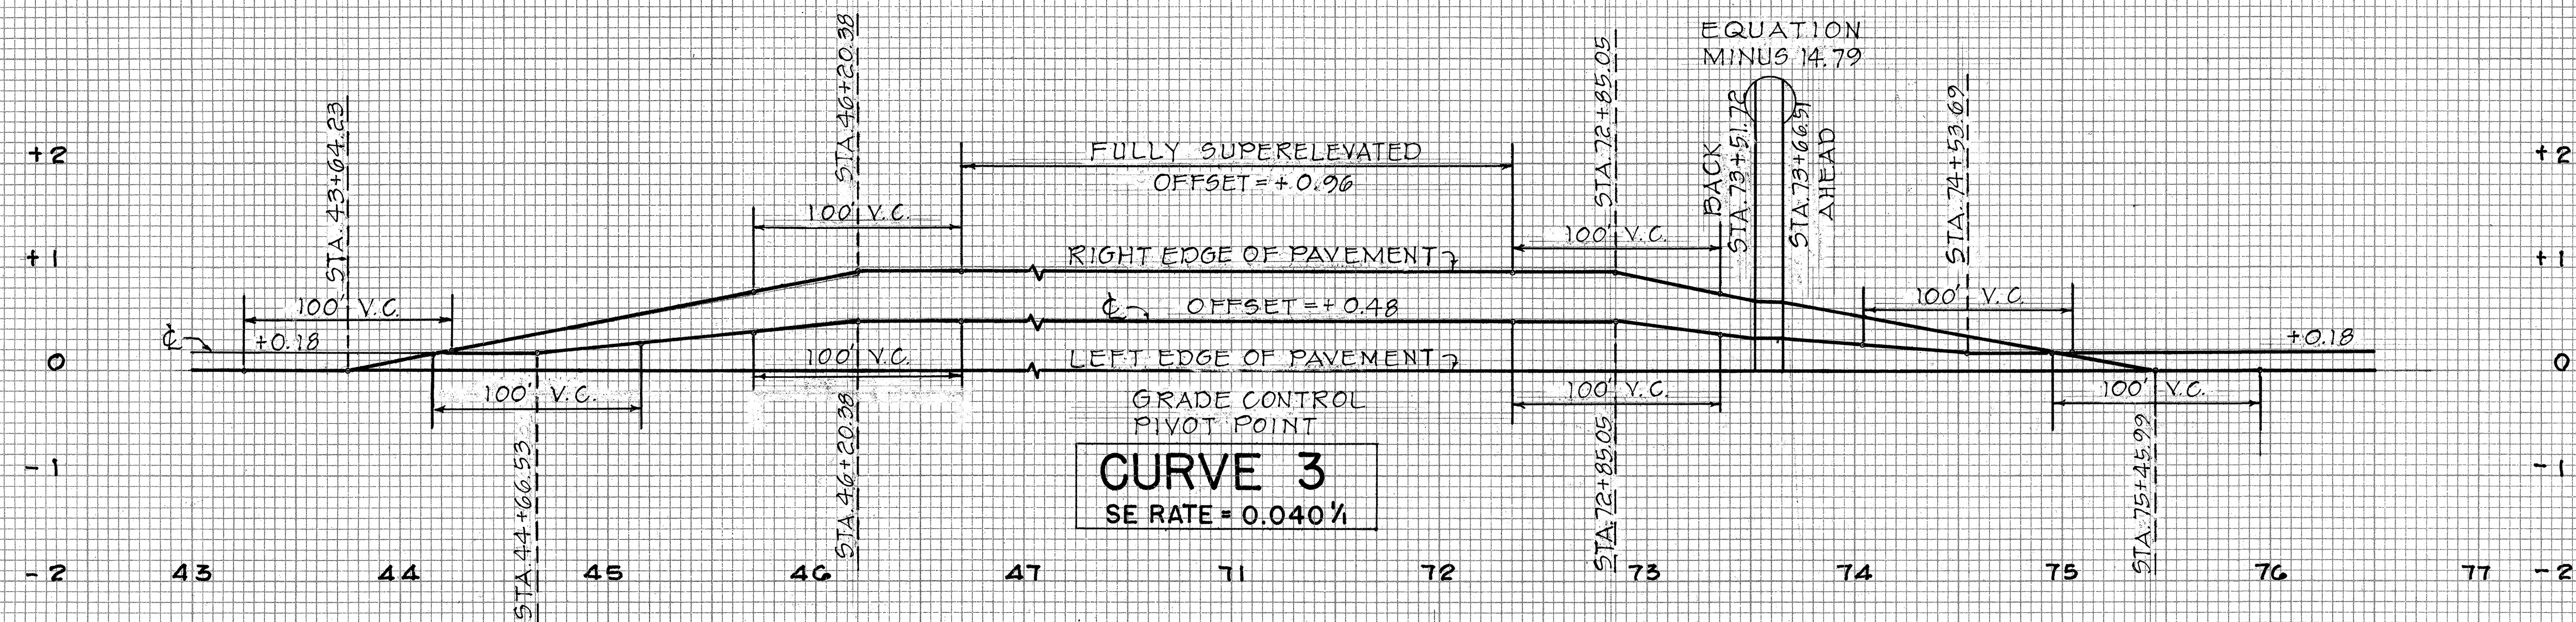

STATE OF HAWAII
DEPARTMENT OF TRANSPORTATION
HIGHWAYS DIVISION

SUPERELEVATION DIAGRAMS


KAHULUI AIRPORT - MAALAEA HIGHWAY
Proj. No. S-0380 (5)

OCT. 1967


FED. ROAD DIST. NO.	STATE	FED. AID PROJ. NO.	FISCAL YEAR	SHEET NO.	TOTAL SHEETS
HAWAII	HAW.	5-0380(5)	1970	16	44

FINAL SURVEY NO.	SURVEYED PLOTTED TEMPLATE AREAS CHECKED	BY	DATE

ORIGINAL SURVEY NO.	SURVEYED PLOTTED TEMPLATE AREAS CHECKED	BY	DATE

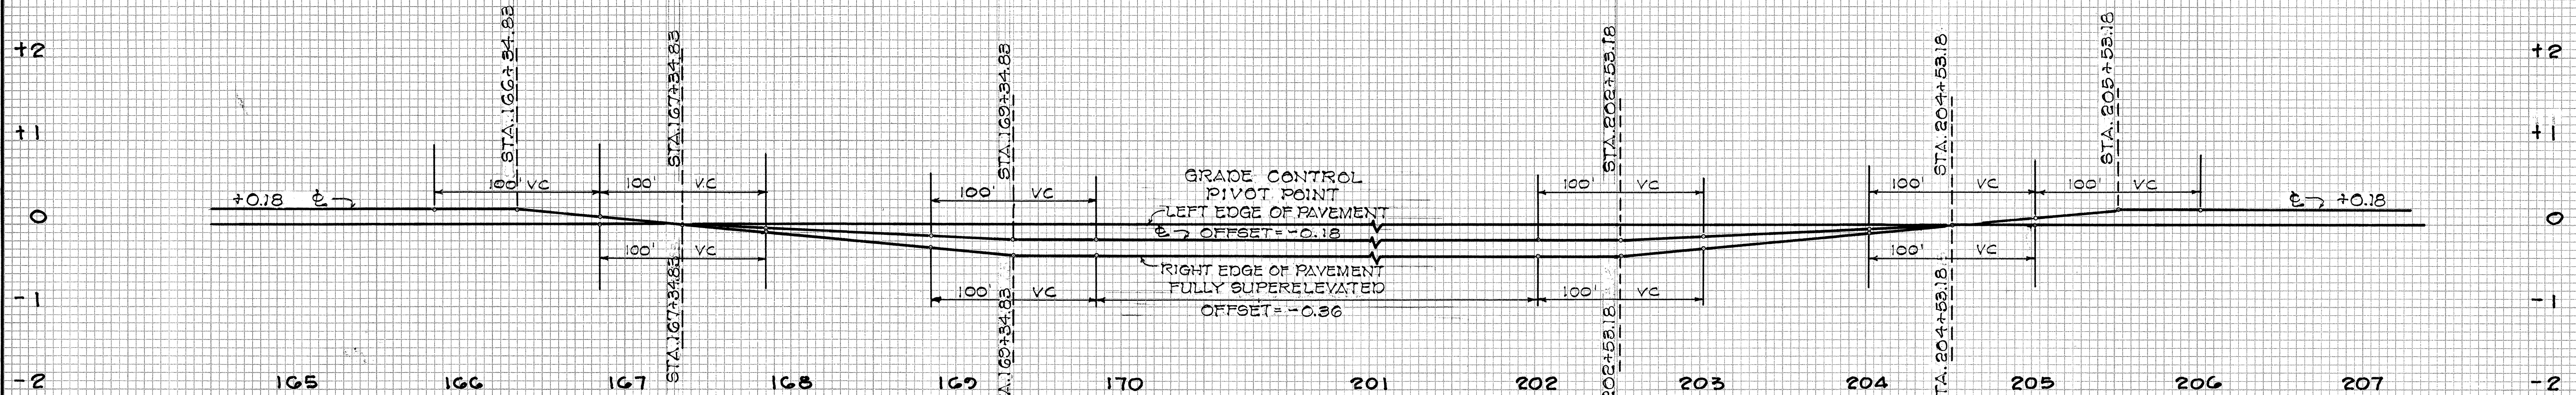

CURVE 5
SE RATE = 0.015%

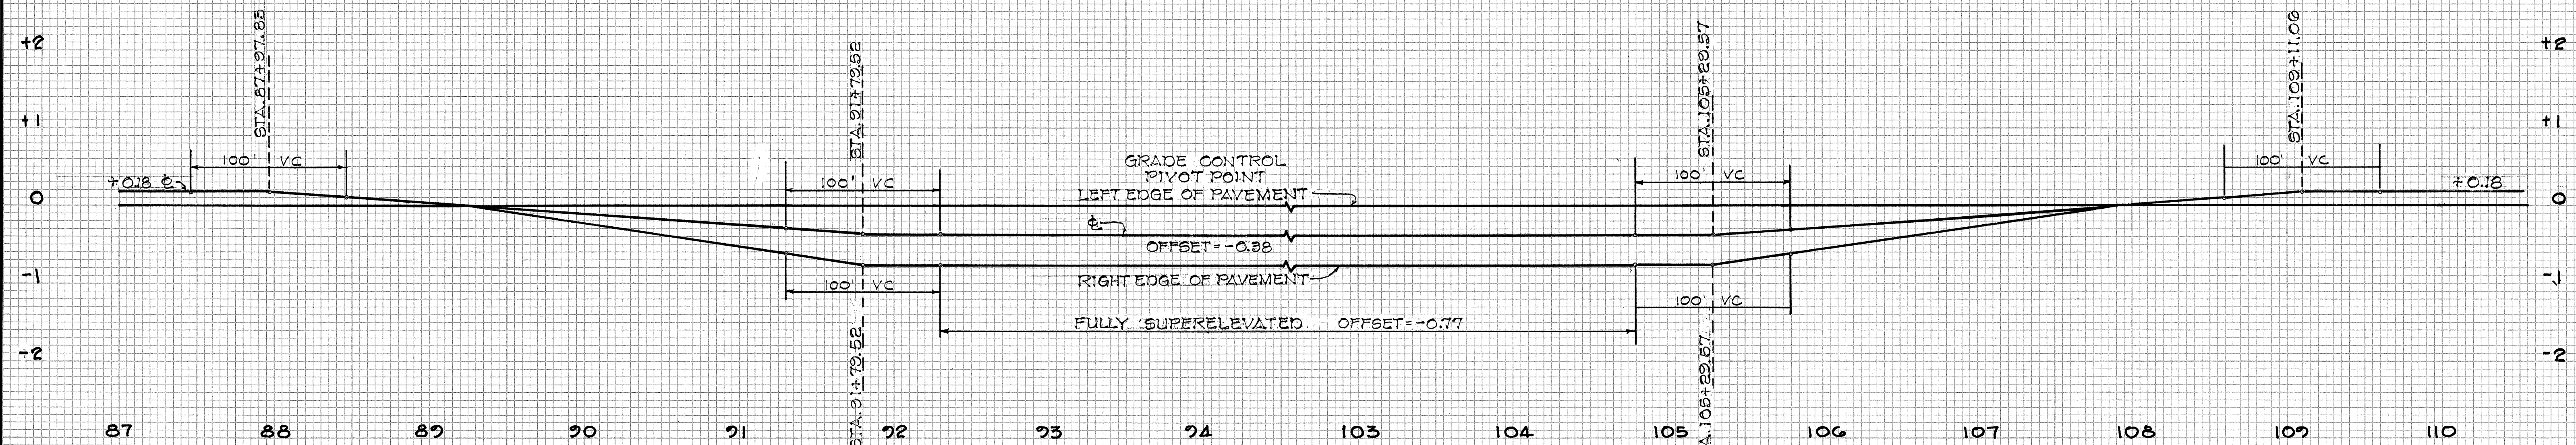

CURVE 4
SE RATE = 0.032%

STATE OF HAWAII
DEPARTMENT OF TRANSPORTATION
HIGHWAYS DIVISION

SUPERELEVATION DIAGRAMS

KAHULUI AIRPORT-MAALAEA HIGHWAY
Proj. No. 5-0380(5) Oct. 1969