


FED. ROAD DIST. NO.	STATE	FED. AID PROJ. NO.	FISCAL YEAR	SHEET NO.	TOTAL SHEETS
HAWAII	HAW.	S-0380(5)	1970	19	44

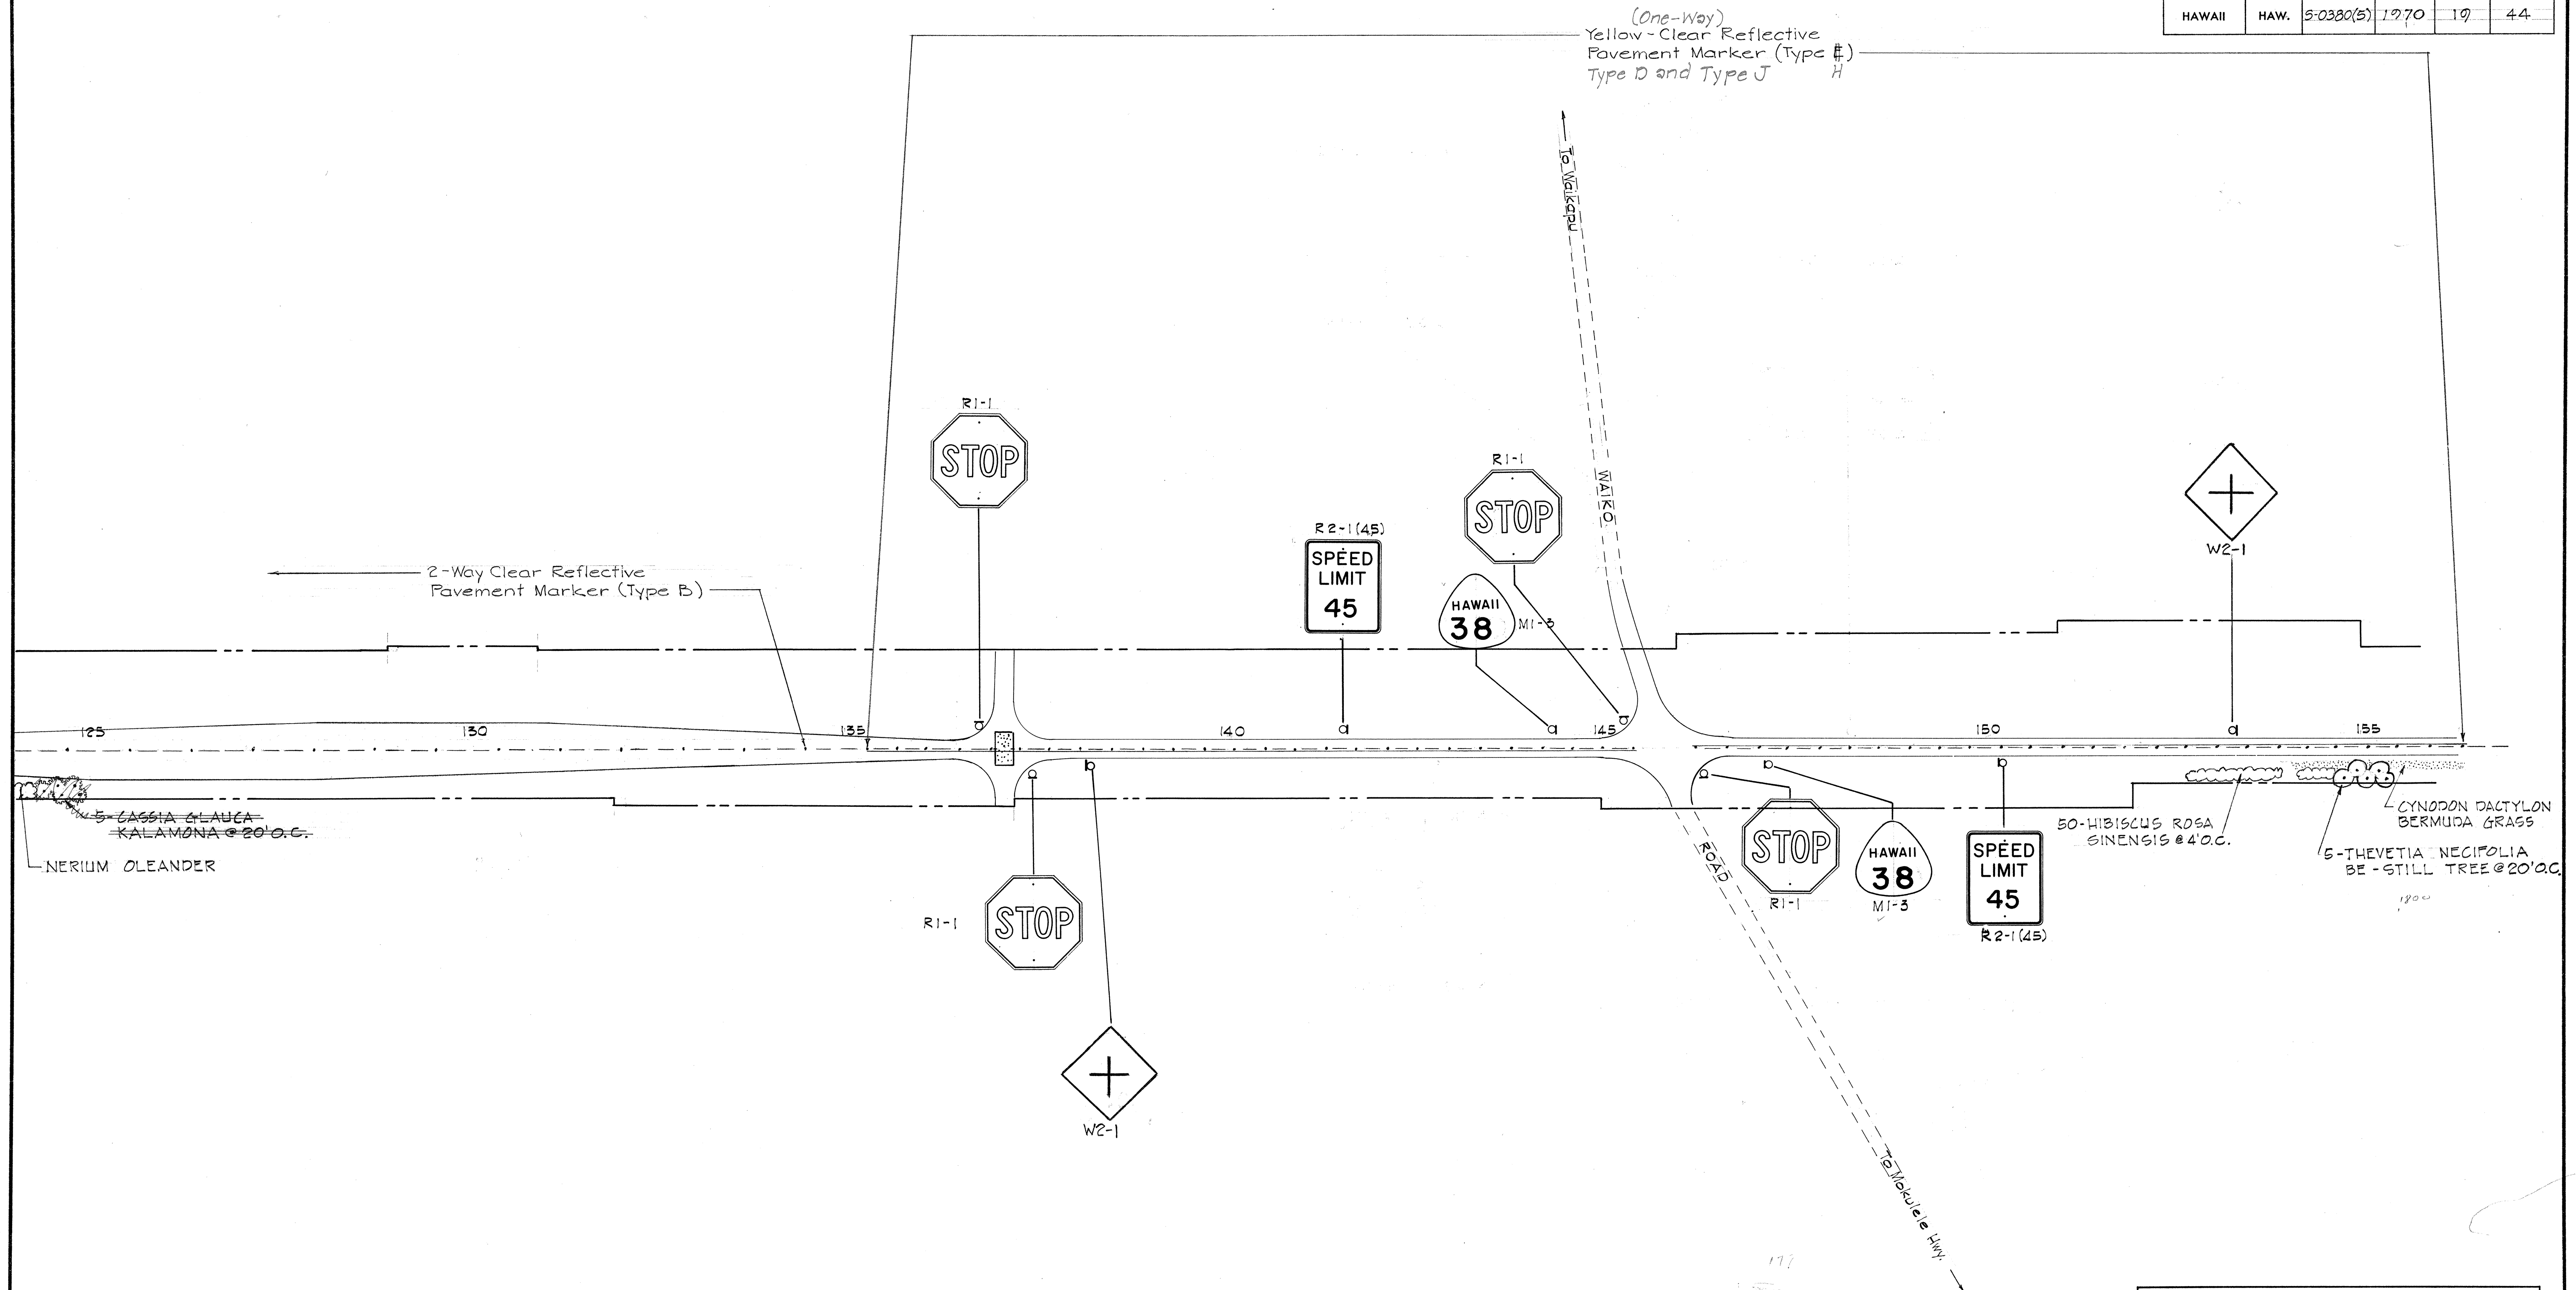


STATE OF HAWAII
DEPARTMENT OF TRANSPORTATION
HIGHWAYS DIVISION
TRAFFIC SIGNS, LANDSCAPING
& PAVEMENT MARKERS
STA. 124+00± to STA. 156+00±
KAHULUI AIRPORT - MAALAEA HIGHWAY
(Puunene Avenue to Maalaea)
FASP No. S-0380(5)

SHEET No. 3 OF 6 SHEETS

ORIGINAL PLAN	DATE
SURVEY PLOTTED BY	
DRAWN BY	
DESIGNED BY	
CHECKED BY	
NOTE BOOK	
No.	

FED. ROAD DIST. NO.	STATE	FED. AID PROJ. NO.	FISCAL YEAR	SHEET NO.	TOTAL SHEETS
HAWAII	HAW.	5-0380(5)	1970	21	44

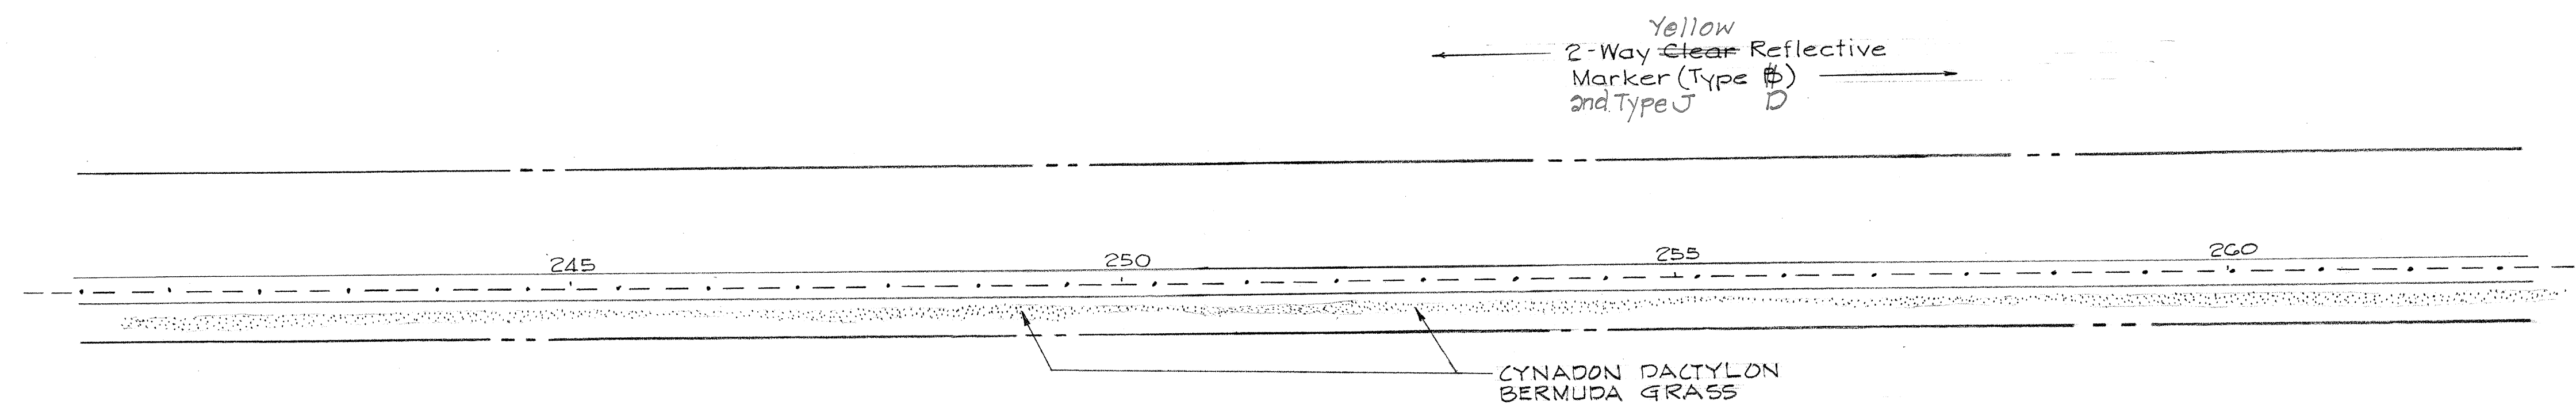

STATE OF HAWAII
DEPARTMENT OF TRANSPORTATION
HIGHWAYS DIVISION
TRAFFIC SIGNS, LANDSCAPING
& PAVEMENT MARKERS
STA. 241+00± to STA. 263+00±
KAHULUI AIRPORT - MAALAE A HIGHWAY
(Puunene Avenue to Maalaea)
FASP No. 5-0380(5)

SHEET No. 5 OF 6 SHEETS

21

ORIGINAL PLAN	DATE
SURVEY PLOTTED BY	
DRAWN BY	
DESIGNED BY	
CHECKED BY	
NOTE BOOK No.	

SUMMARY OF REGULATORY & WARNING SIGNS

TYPE	DESCRIPTION	QUANTITY
R1-1	STOP	20
R1-2	YIELD	1
R2-1	SPEED LIMIT (45)	4
R2-1	SPEED LIMIT (35)	2
R2-5	SPEED ZONE AHEAD	2
R4-1	DO NOT PASS	4
R4-2	PASS WITH CARE	1
W3-1	STOP AHEAD	5
W5-1	ROAD NARROWS	1
W13-1	35 MPH	2
W2-1	CROSS ROAD +	2
TOTAL		42

SUMMARY OF ROUTE MARKERS, AUXILIARY MARKERS, AND ROUTE MARKER ASSEMBLIES

TYPE	DESCRIPTION	QUANTITY	ROUTE MARKER ASSEMBLY
M1-3	HAWAII 30	2	TYPE "A" TYPE "B"
M1-3	HAWAII 35	2	
M1-3	HAWAII 38	5	
M1-4	HAWAII 30	4	
M1-4	HAWAII 35	6	
M1-4	HAWAII 38	10	
M2-1	JCT	7	
M4-1	↑	2	
M4-3	↑	6	
M4-4	↔	9	
TOTAL		49	17 6

REFLECTIVE PAVEMENT MARKERS

TYPE	QUANTITY
B	267
D	30,432
E	150
H	223
J	4,044

C.C.O. No. 7

Yellow 2-Way Clear Reflective Pavement Marker (Type D) and Type J

Construction Identification Sign and Project Informational Sign

(One-Way) Yellow Clear Reflective Pavement Marker (Type D and Type J)

Note: Do not install reflective pavement markers on temporary connector.

STATE OF HAWAII
DEPARTMENT OF TRANSPORTATION
HIGHWAYS DIVISION
TRAFFIC SIGNS, LANDSCAPING & PAVEMENT MARKERS
STA. 263+00 to STA. 288+00
KAHULUI AIRPORT - MAALAE HIGHWAY
(Puunene Avenue to Maalaea)
FA SP No. S-0380(5)

FED. ROAD DIST. NO.	STATE	FED. AID PROJ. NO.	FISCAL YEAR	SHEET NO.	TOTAL SHEETS
HAWAII	HAW.	S-0380(5)	1970	22	44

DATE	_____
DESIGNED BY	_____
CHECKED BY	_____
NOTED BY	_____
ORIGINAL PLAN	_____
NOTE BOOK	_____