
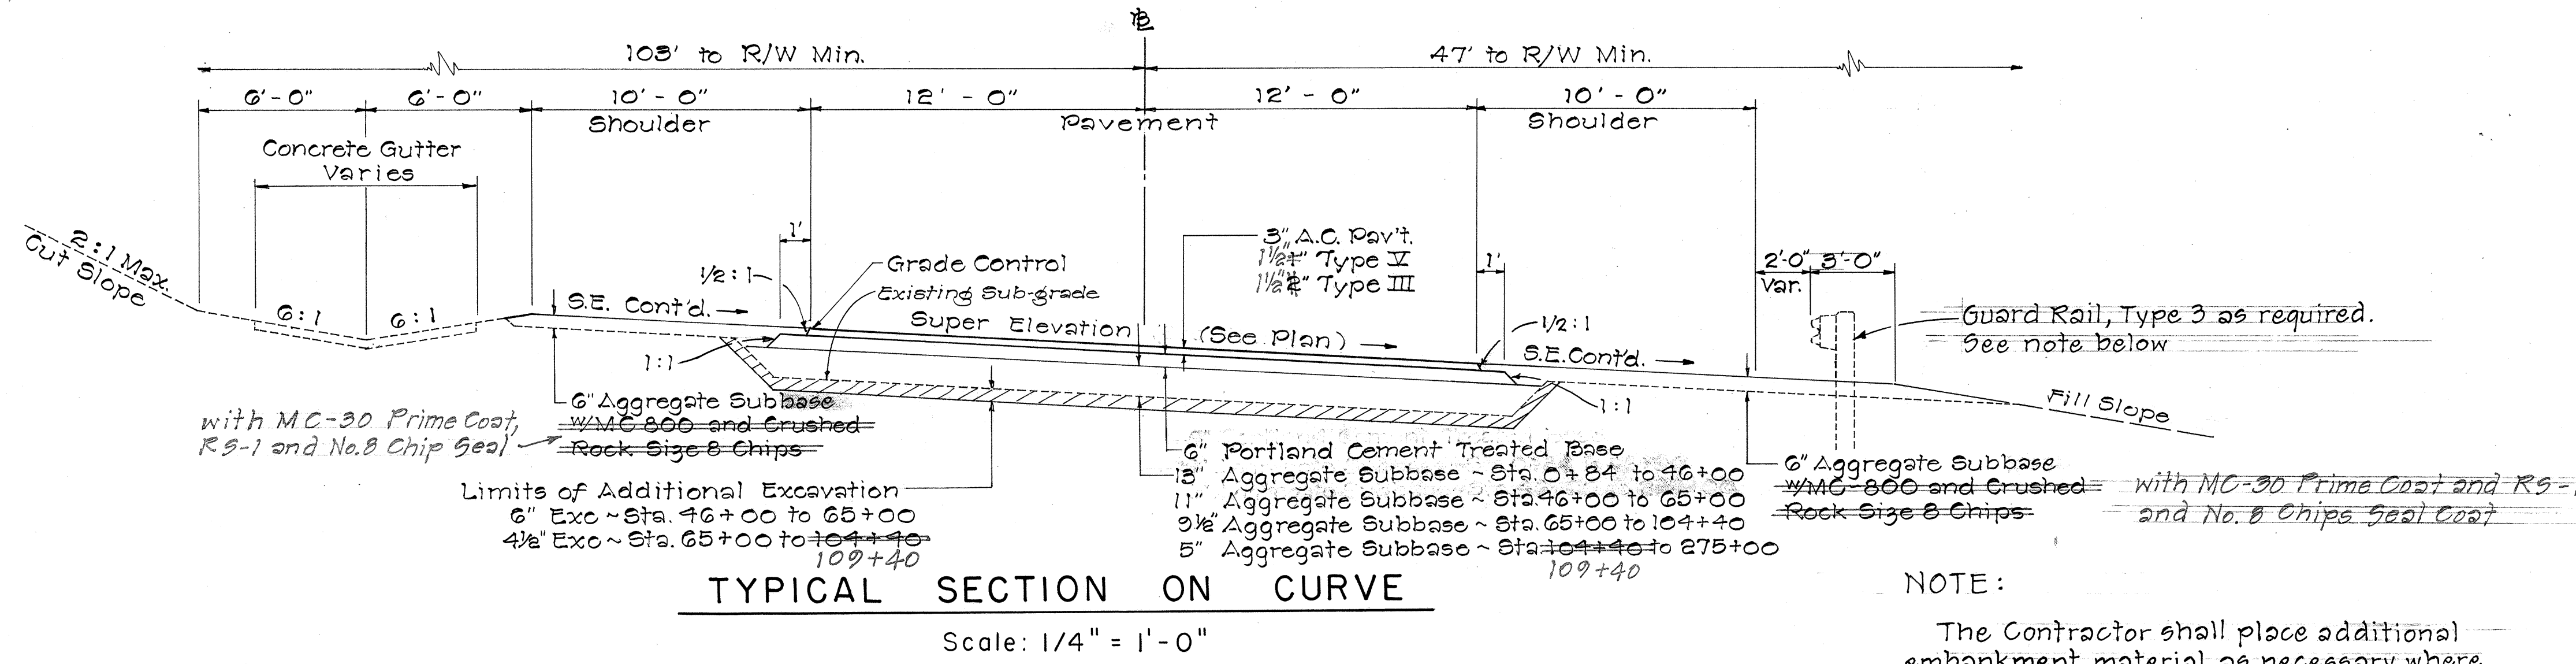


FED. ROAD DIST. NO.	STATE	FED. AID PROJ. NO.	FISCAL YEAR	SHEET NO.	TOTAL SHEETS
HAWAII	HAW.	5-0380(5)	1970	2	44

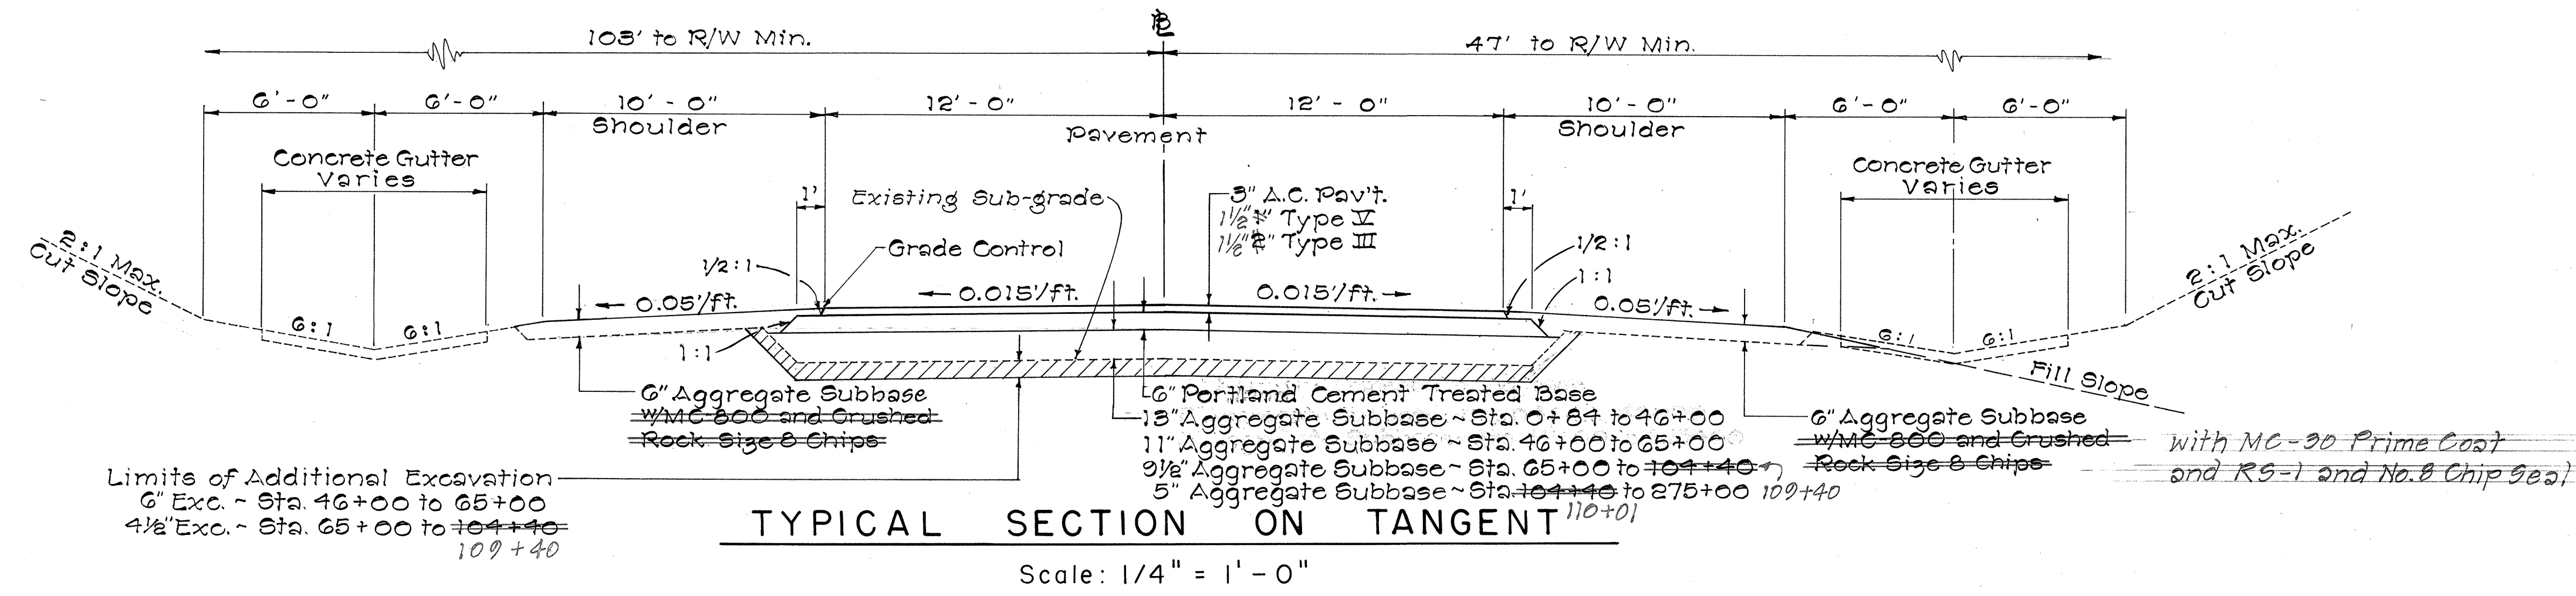

NOTE:

The Contractor shall place additional embankment material as necessary where guard rails are required.

ORIGINAL PLAN	SURVEY PLOTTED BY	DATE
DRAWN BY	_____	_____
CHECKED BY	_____	_____
NOTED BY	_____	_____
QUANTITIES BY	_____	_____
CHECKED BY	_____	_____
No.	_____	_____


STATE OF HAWAII
DEPARTMENT OF TRANSPORTATION
HIGHWAYS DIVISION

TYPICAL SECTIONS


PROJECT NO. S-0380(5)

Scale: As Noted
SHEET No. 1 OF 2 SHEETS


FED. ROAD DIST. NO.	STATE	FED. AID PROJ. NO.	FISCAL YEAR	SHEET NO.	TOTAL SHEETS
HAWAII	HAW.	S-0380(5)	1970	2	44

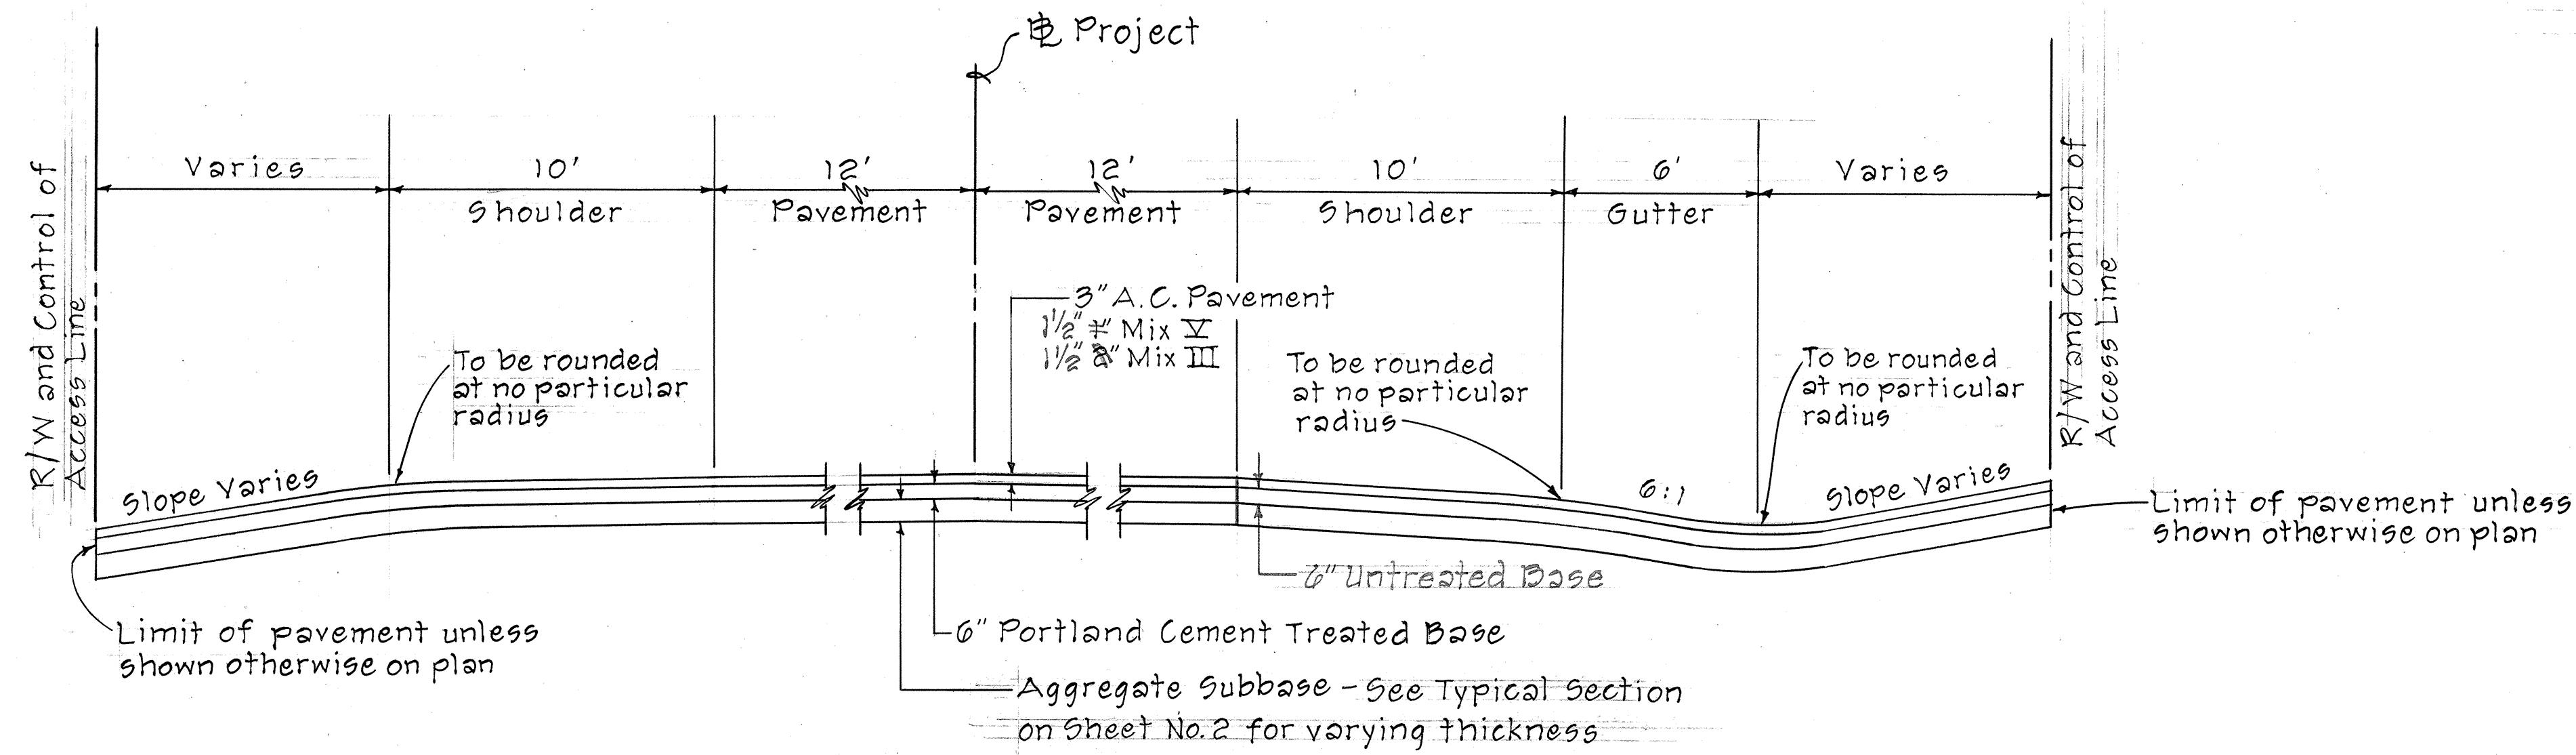


TYPICAL SECTION AT ACCESS ROAD APPROACHES
Scale: 1/4" = 1' - 0"

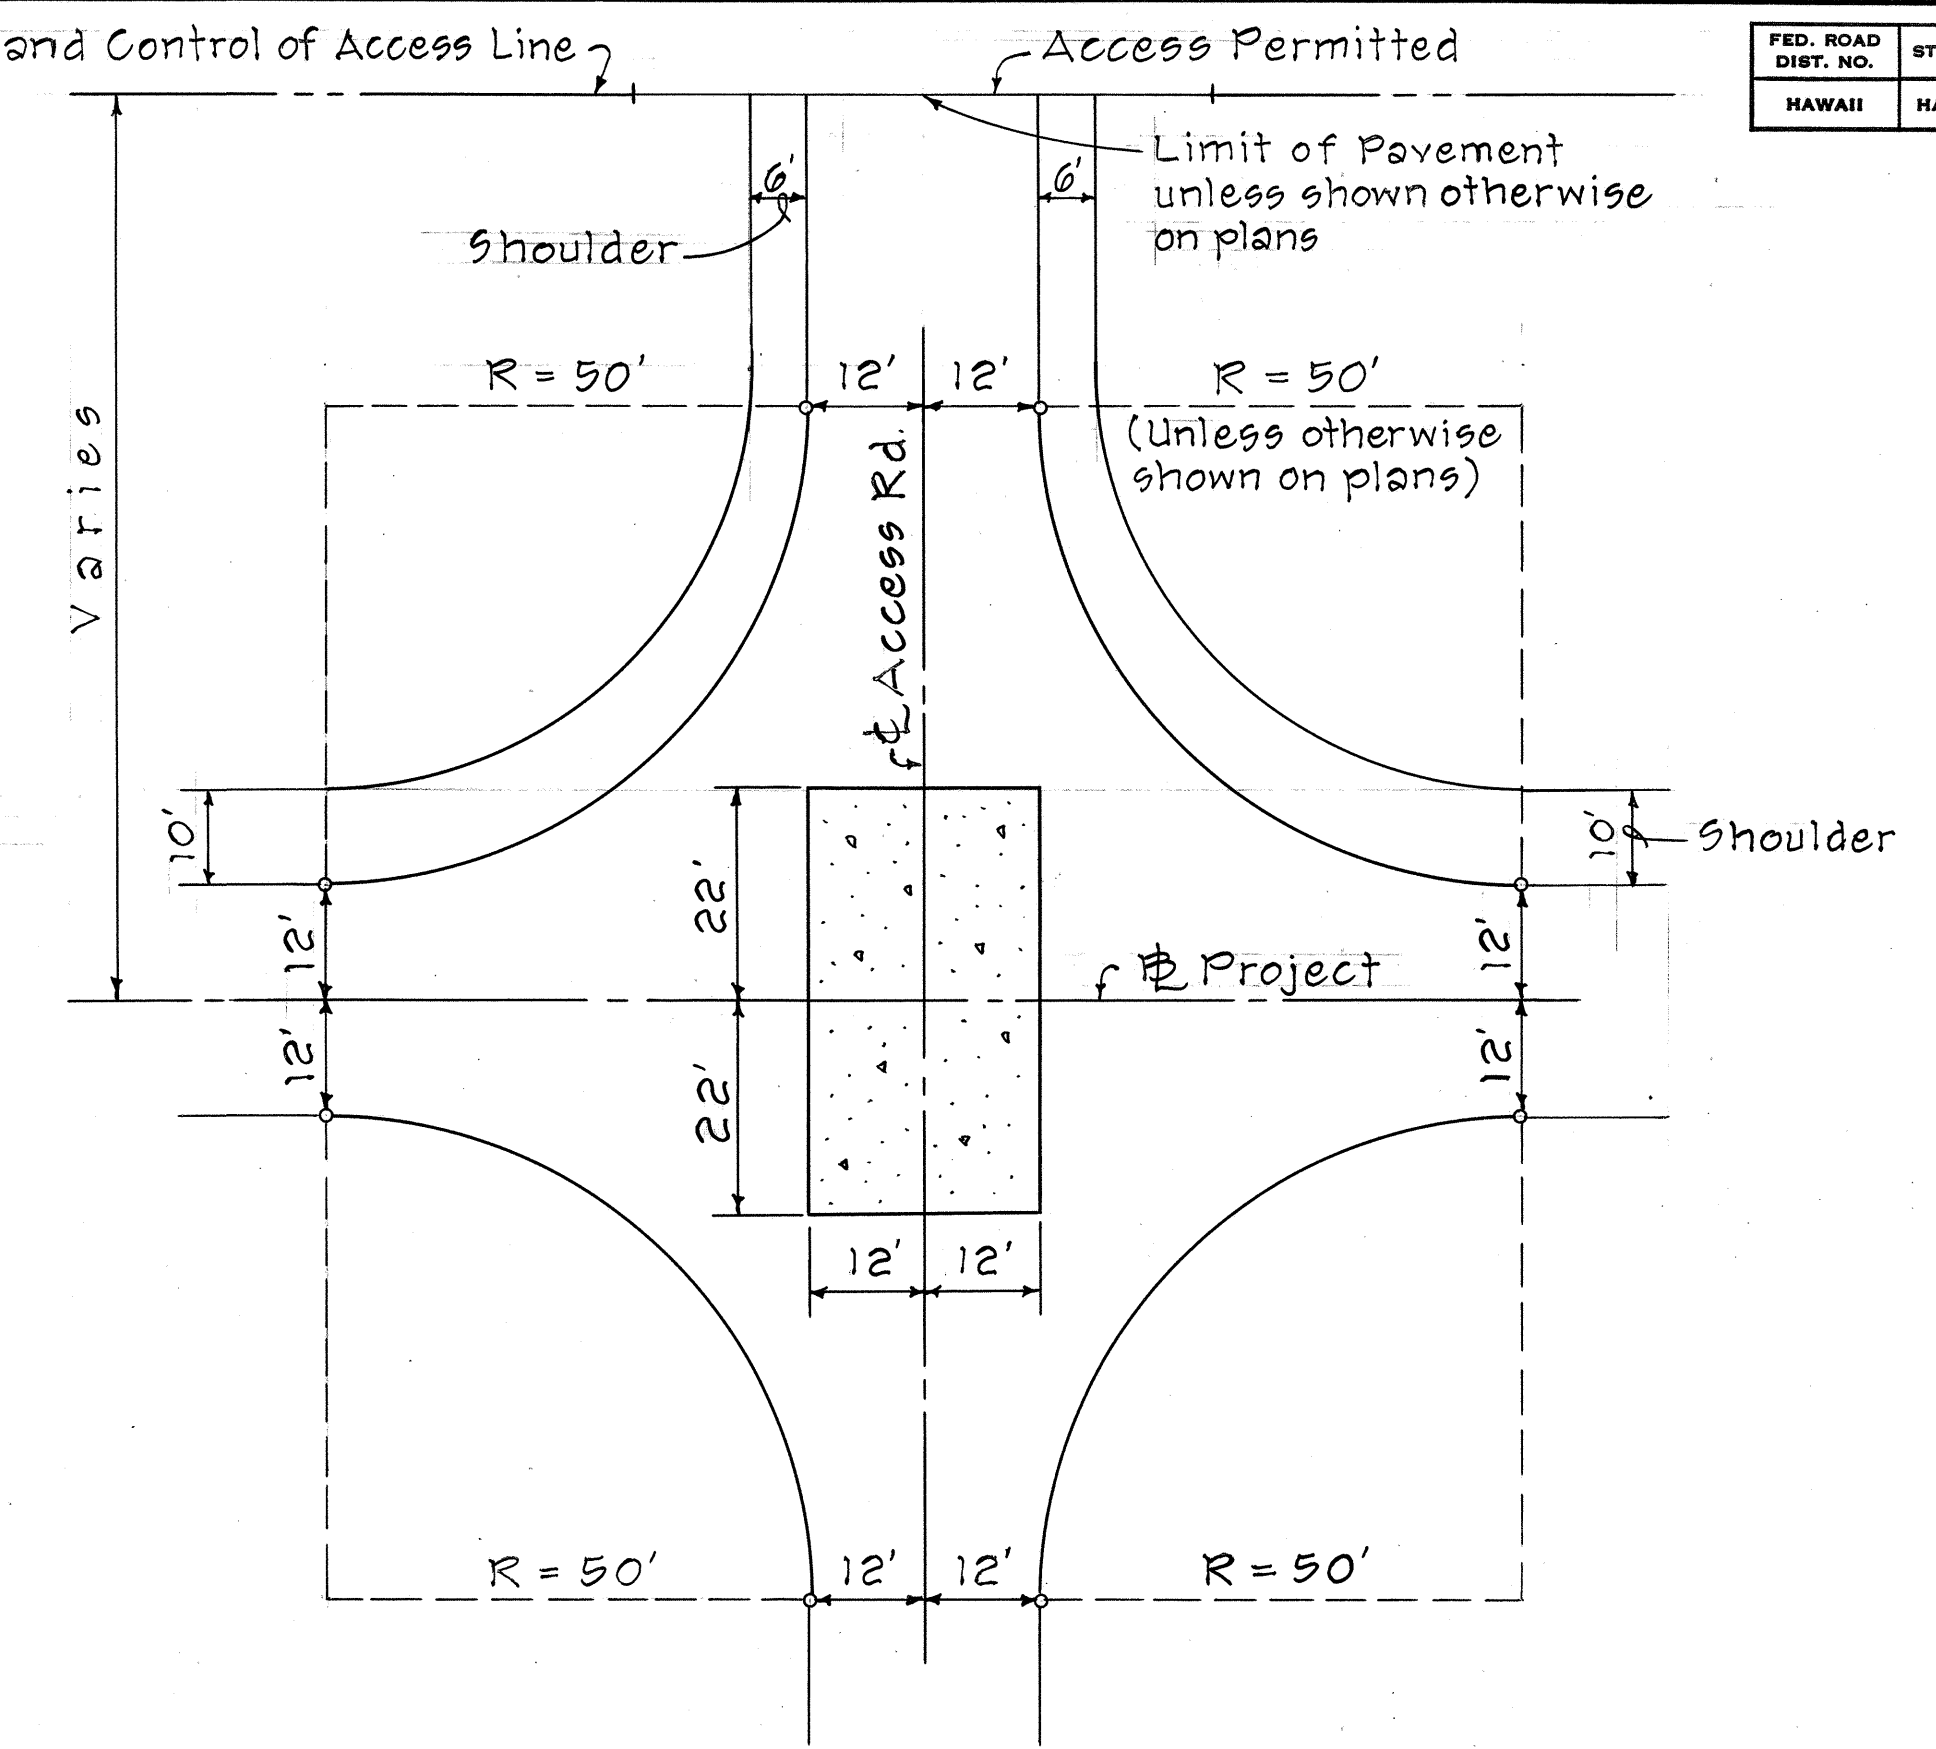


TYPICAL PLAN OF ACCESS ROAD AND TOURNAHAULER CROSSING
Scale: 1" = 20' - 0"

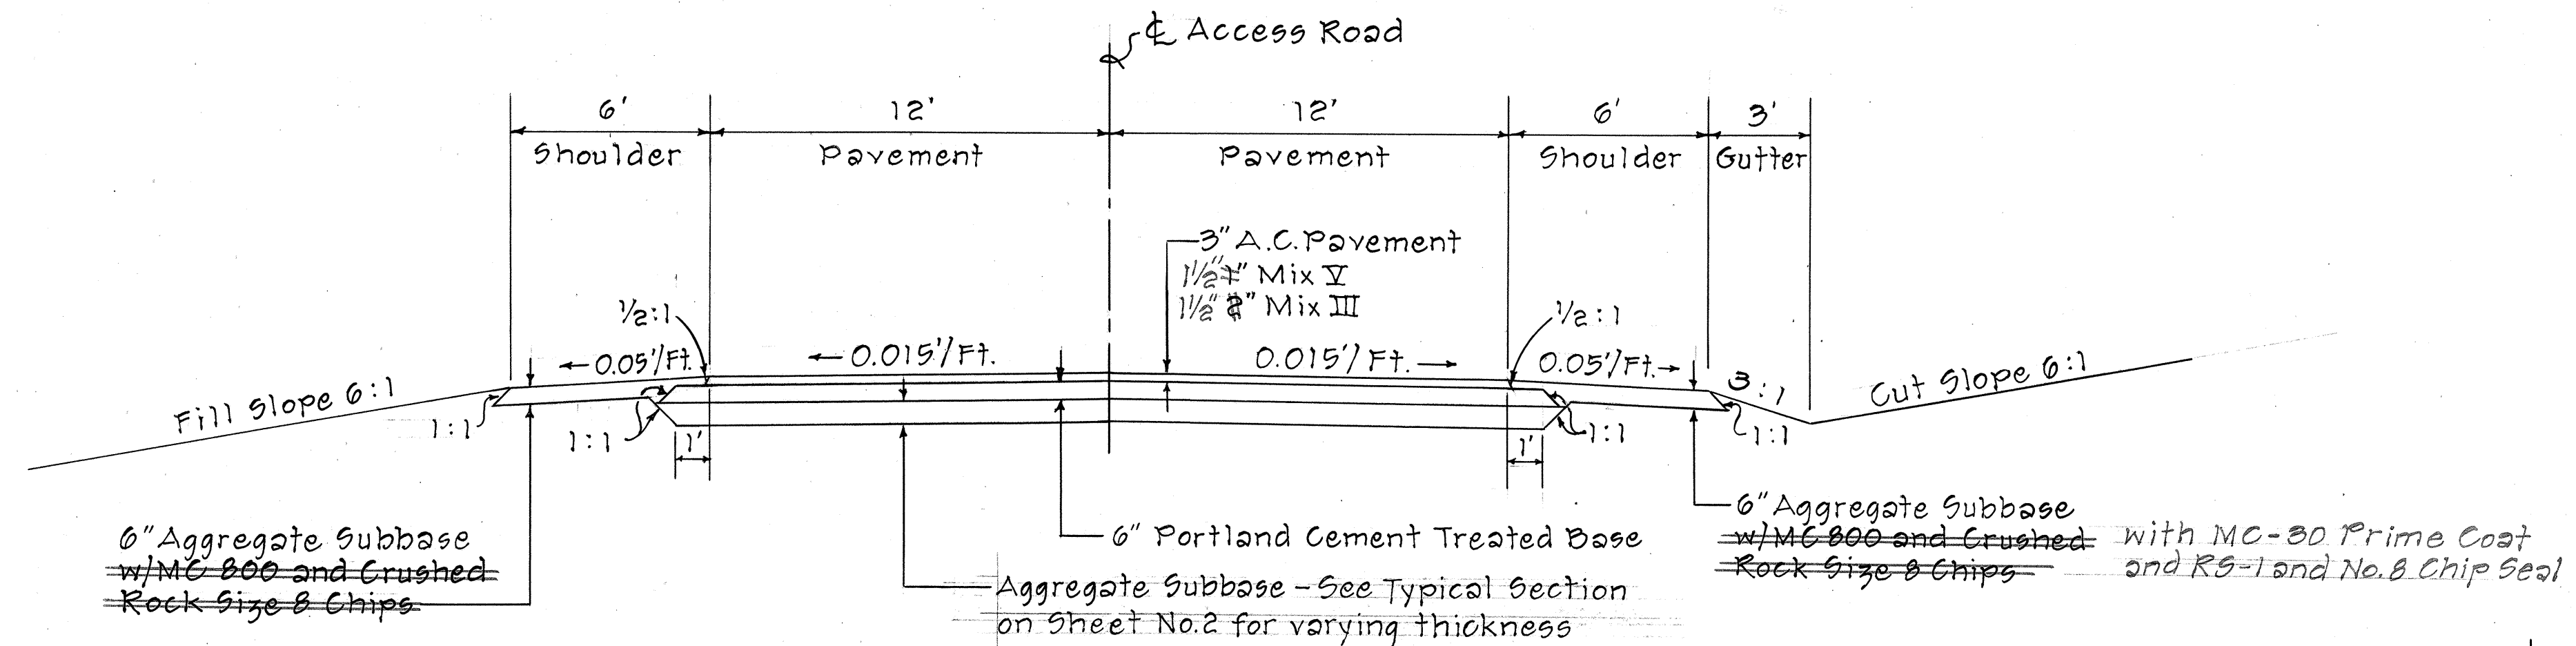

TYPICAL SECTION - ACCESS ROAD
Scale: 1/4" = 1' - 0"

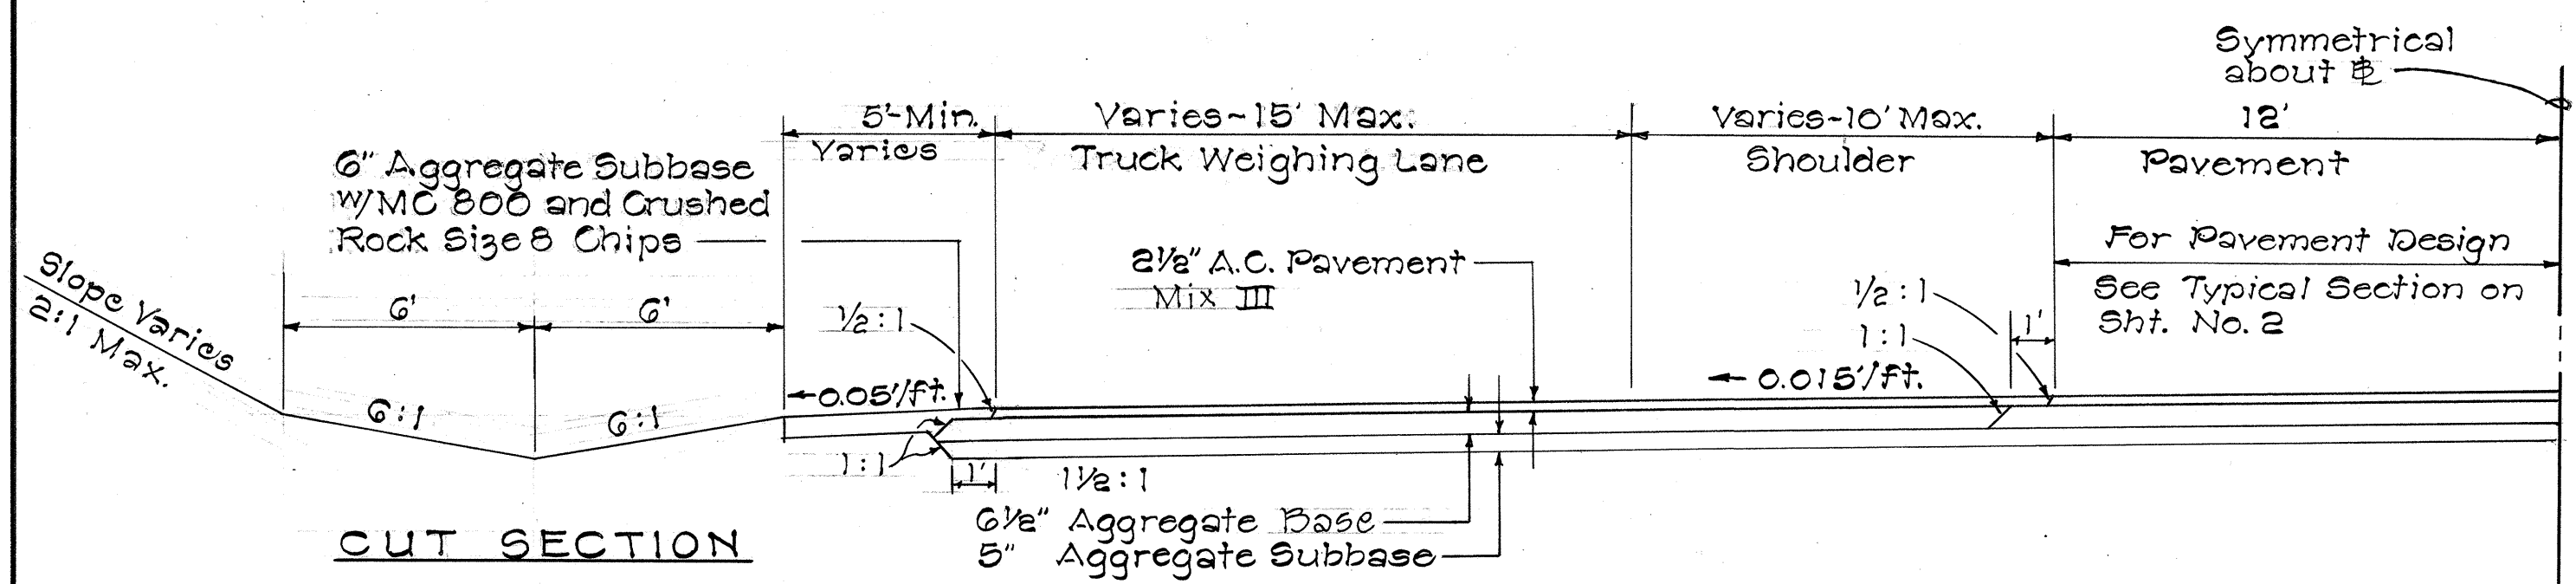


CUT SECTION

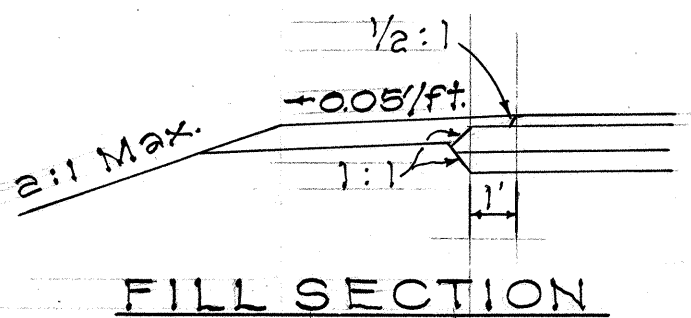

FILL SECTION

TYPICAL SECTION TRUCK WEIGHING STATION
Sta. 120+00 TO 136+00
Scale: 1/4" = 1' - 0"

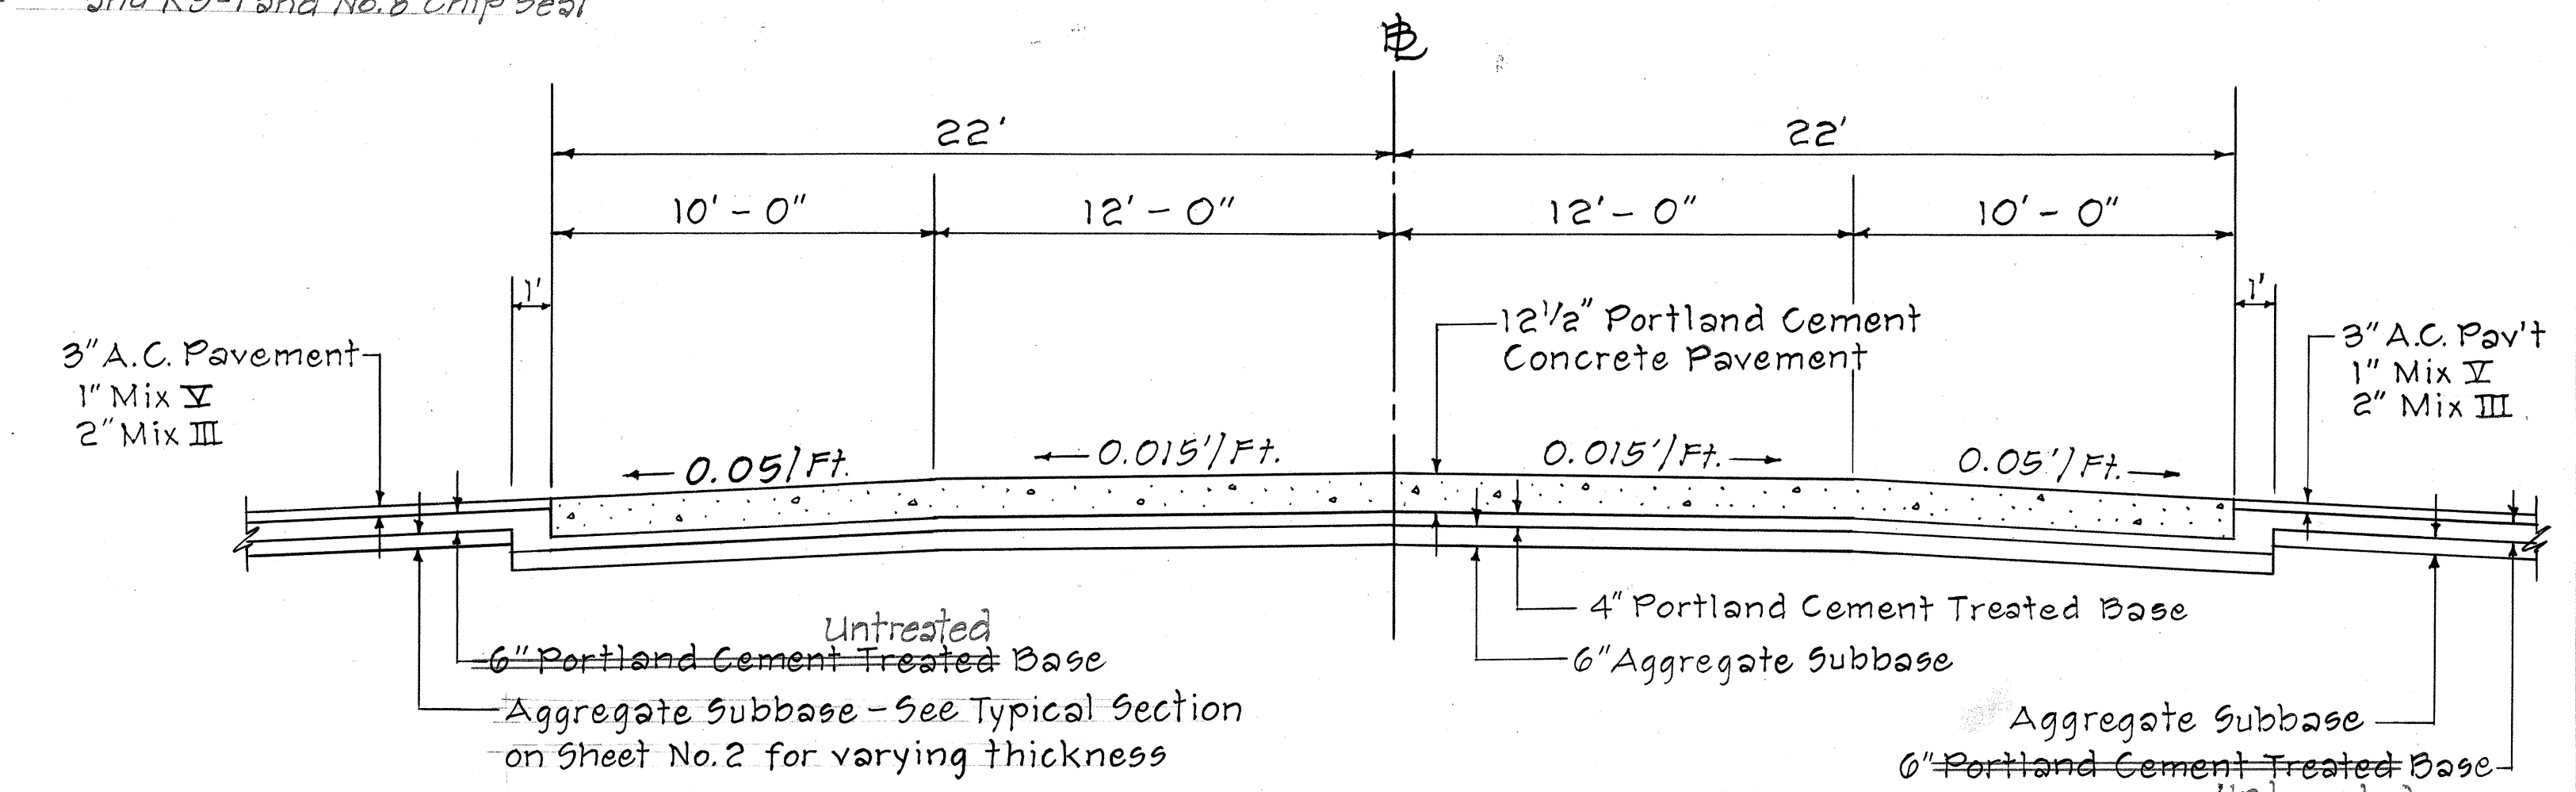

TYPICAL SECTION AT TOURNAHAULER CROSSING
Scale: 1/4" = 1' - 0"

STATE OF HAWAII
DEPARTMENT OF TRANSPORTATION
HIGHWAYS DIVISION

TYPICAL SECTIONS

PROJECT NO. S-0380(5)

Scale: As Noted

SHEET No. 2 OF 2 SHEETS