4	
	INDEX TO DRAWINGS
SHEET NO.	DESCRIPTION
l	TITLE SHEET
2	PLAN, GENERAL NOTES & TYPICAL SECTION
3	STANDARD DETAILS
,	
	·
·	



STATE OF

HAWAII

OF TRANSPORTATION DEPARTMENT HIGHWAYS DIVISION


"AS-BUILT"

PLANS FOR

KUIHELANI HIGHWAY RESURFACING DAIRY ROAD SECTION

Project No. 3800A-01-81M

DISTRICT OF WAILUKU ISLAND OF MAUI

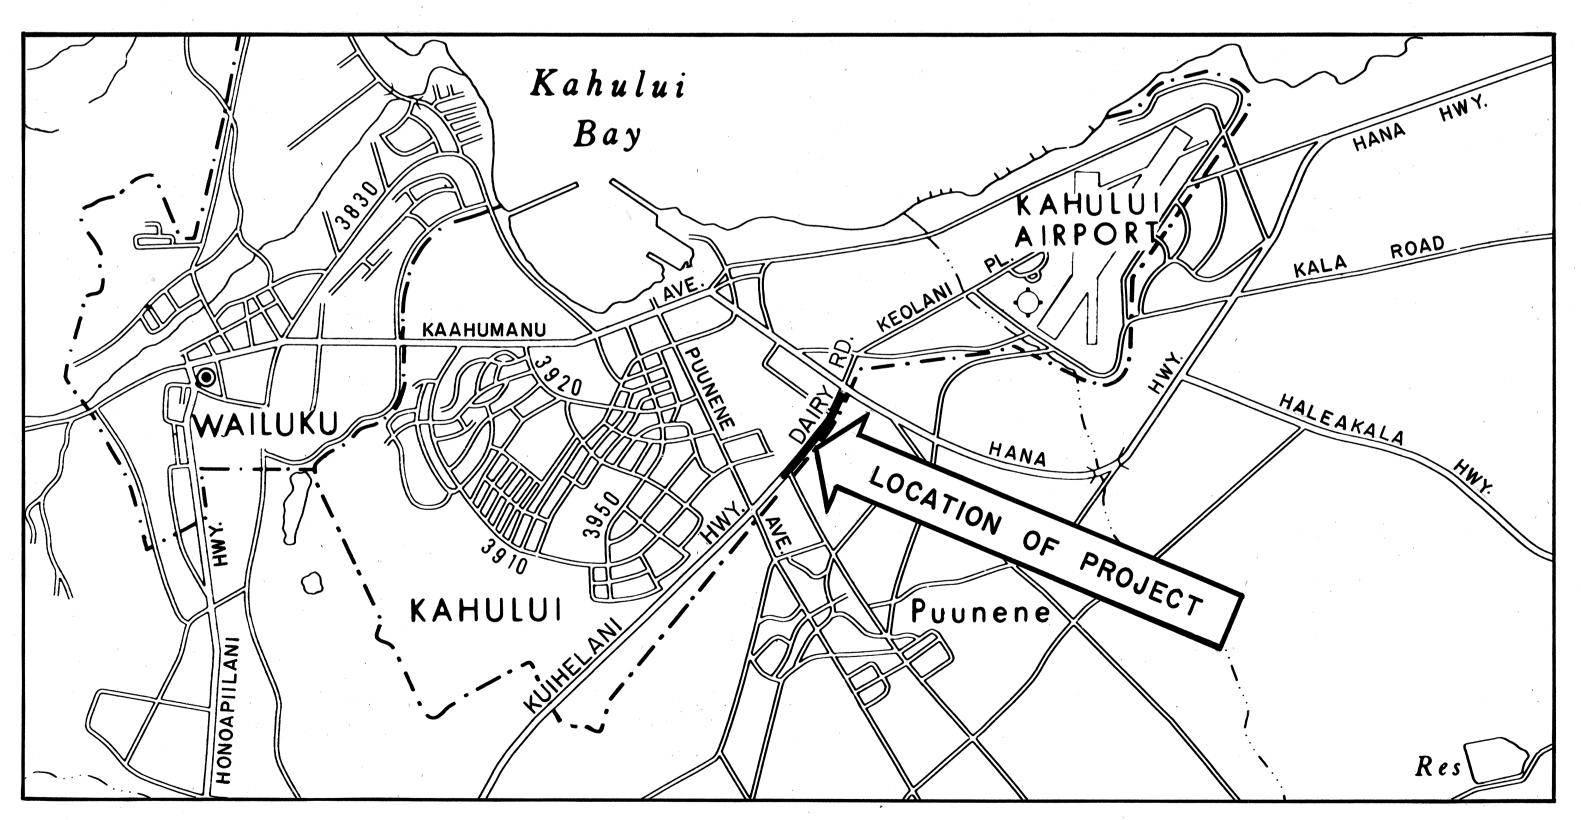


LAYOUT PLAN





GROSS LENGTH OF PROJECT . . . 0.568 Mile NET LENGTH OF PROJECT 0 568 Mile FED. ROAD DIST. NO. PROJ. NO. HAW. 3800A-01-81M 1981

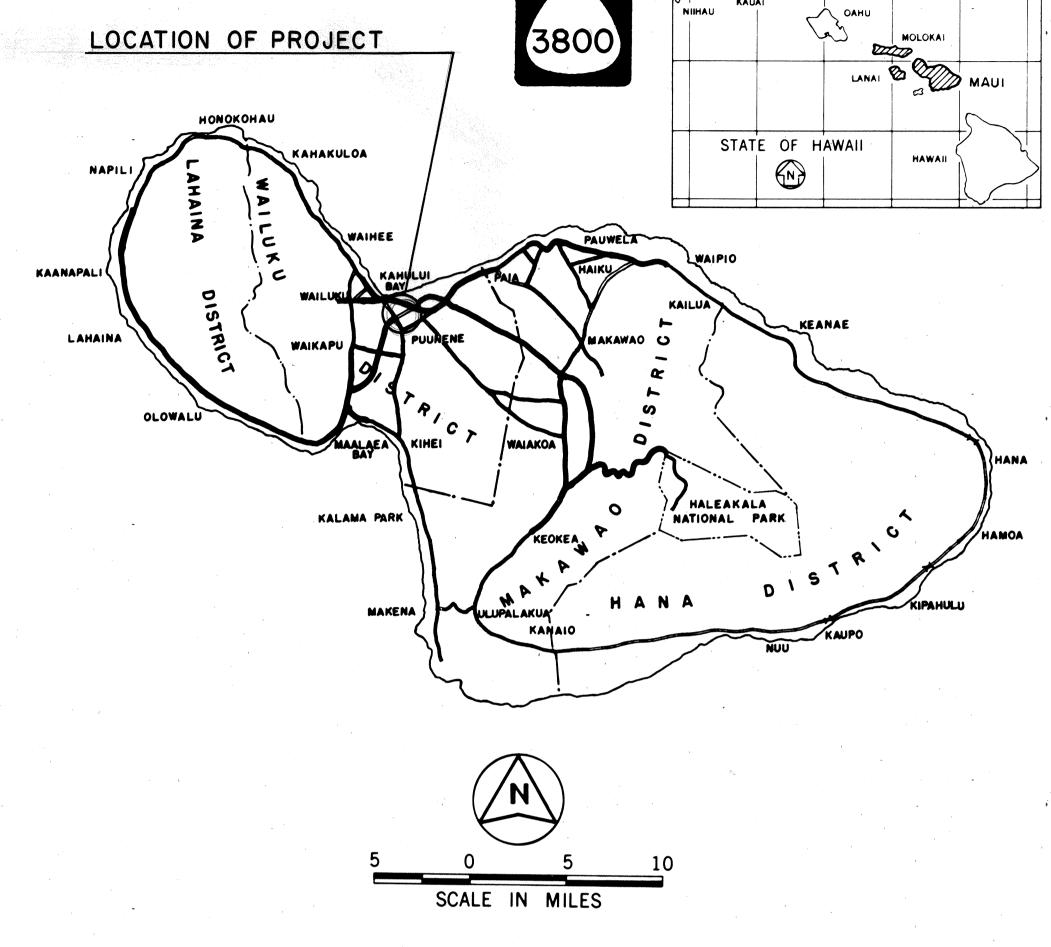

FEDERAL AID PROJECTS PREVIOUSLY CONSTRUCTED OR UNDER CONSTRUCTION

ALL CHANGES MADE DURING CONSTRUCTION HAVE BEEN INCORPORATED ON THESE PLANS IN RED EXCEPT CHANGES IN THE ORIGINAL THEORETICAL QUANTITIES. FOR ACTUAL QUANTITIES, REFER TO PROJECT LEDGER AND/OR COMPUTATION BOOK.

RESIDENT ENGINEER

2 July 81 DATE

DEPARTMENT OF TRANSPORTATION STATE OF HAWAII APPROVED: POIR. OF TRANSPORTATION