	INDEX TO DRAWINGS
SHEET NO.	DESCRIPTION
l ,	TITLE SHEET
2	STANDARD PLANS SUMMARY SHEET
3	NOTES, LEGEND & DETAILS
4	TRAFFIC SIGNAL PLAN
5	PAVEMENT WIDENING, STRIPING,
	MARKING & SIGNING PLAN
6	LOOP DETECTOR DETAILS
-	
	•
	· -
MA	

STATE OF HAWAII

DEPARTMENT OF TRANSPORTATION

HIGHWAYS DIVISION HONOLULU, HAWAII


"AS-BUILT"

PLANS FOR

KUIHELANI HIGHWAY TRAFFIC SIGNALS
AT HONOAPIILANI HIGHWAY
PROJECT NO. RSG-0380(8)

DISTRICT OF WAILUKU
ISLAND OF MAUI

TO WAIKAPU -

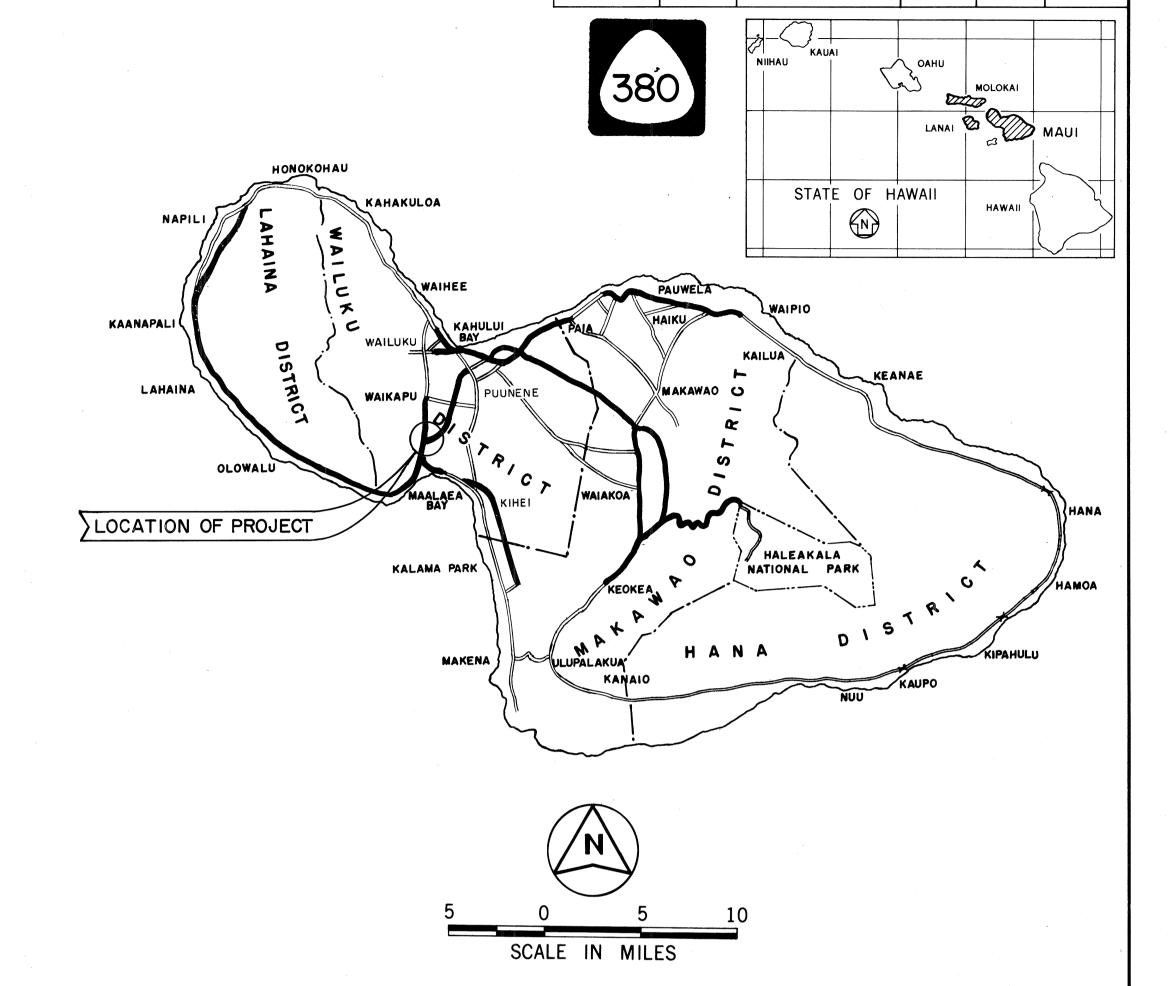

FED. ROAD DIST. NO.

FEDERAL AID PROJECTS PREVIOUSLY CONSTRUCTED OR UNDER CONSTRUCTION

CHANGES MADE DURING CONSTRUCTION HAVE
BEEN INCORPORATED ON THESE PLANS EXCEPT
CHANGES IN THE ORIGINAL THEORETICAL
QUANTITIES. FOR ACTUAL QUANTITIES, REFER TO
PROJECT LEDGER AND/OR COMPUTATION BOOK.

RESIDENT ENGINEER

11/4/99 DATE

NORTH NORTH SCALE IN FEET

LAYOUT PLAN

HONOAPIILANI

PROJECT LOCATION

DEPARTMENT OF TRANSPORTATION STATE OF HAWAII

APPROVED:

DIR. OF TRANSPORTATION

72/22/88 DATE

FISCAL SHEET YEAR NO.

1989

FED. AID PROJ. NO.

RSG-0380(8)

DATE

FRED ABESHIMA 548-4042
P. S. & E. BY PHONE

RO, ENDO & YOSHIZAKI, INC.

AVE. HONOLULU, HI.

SIGNED RY

P. & &