
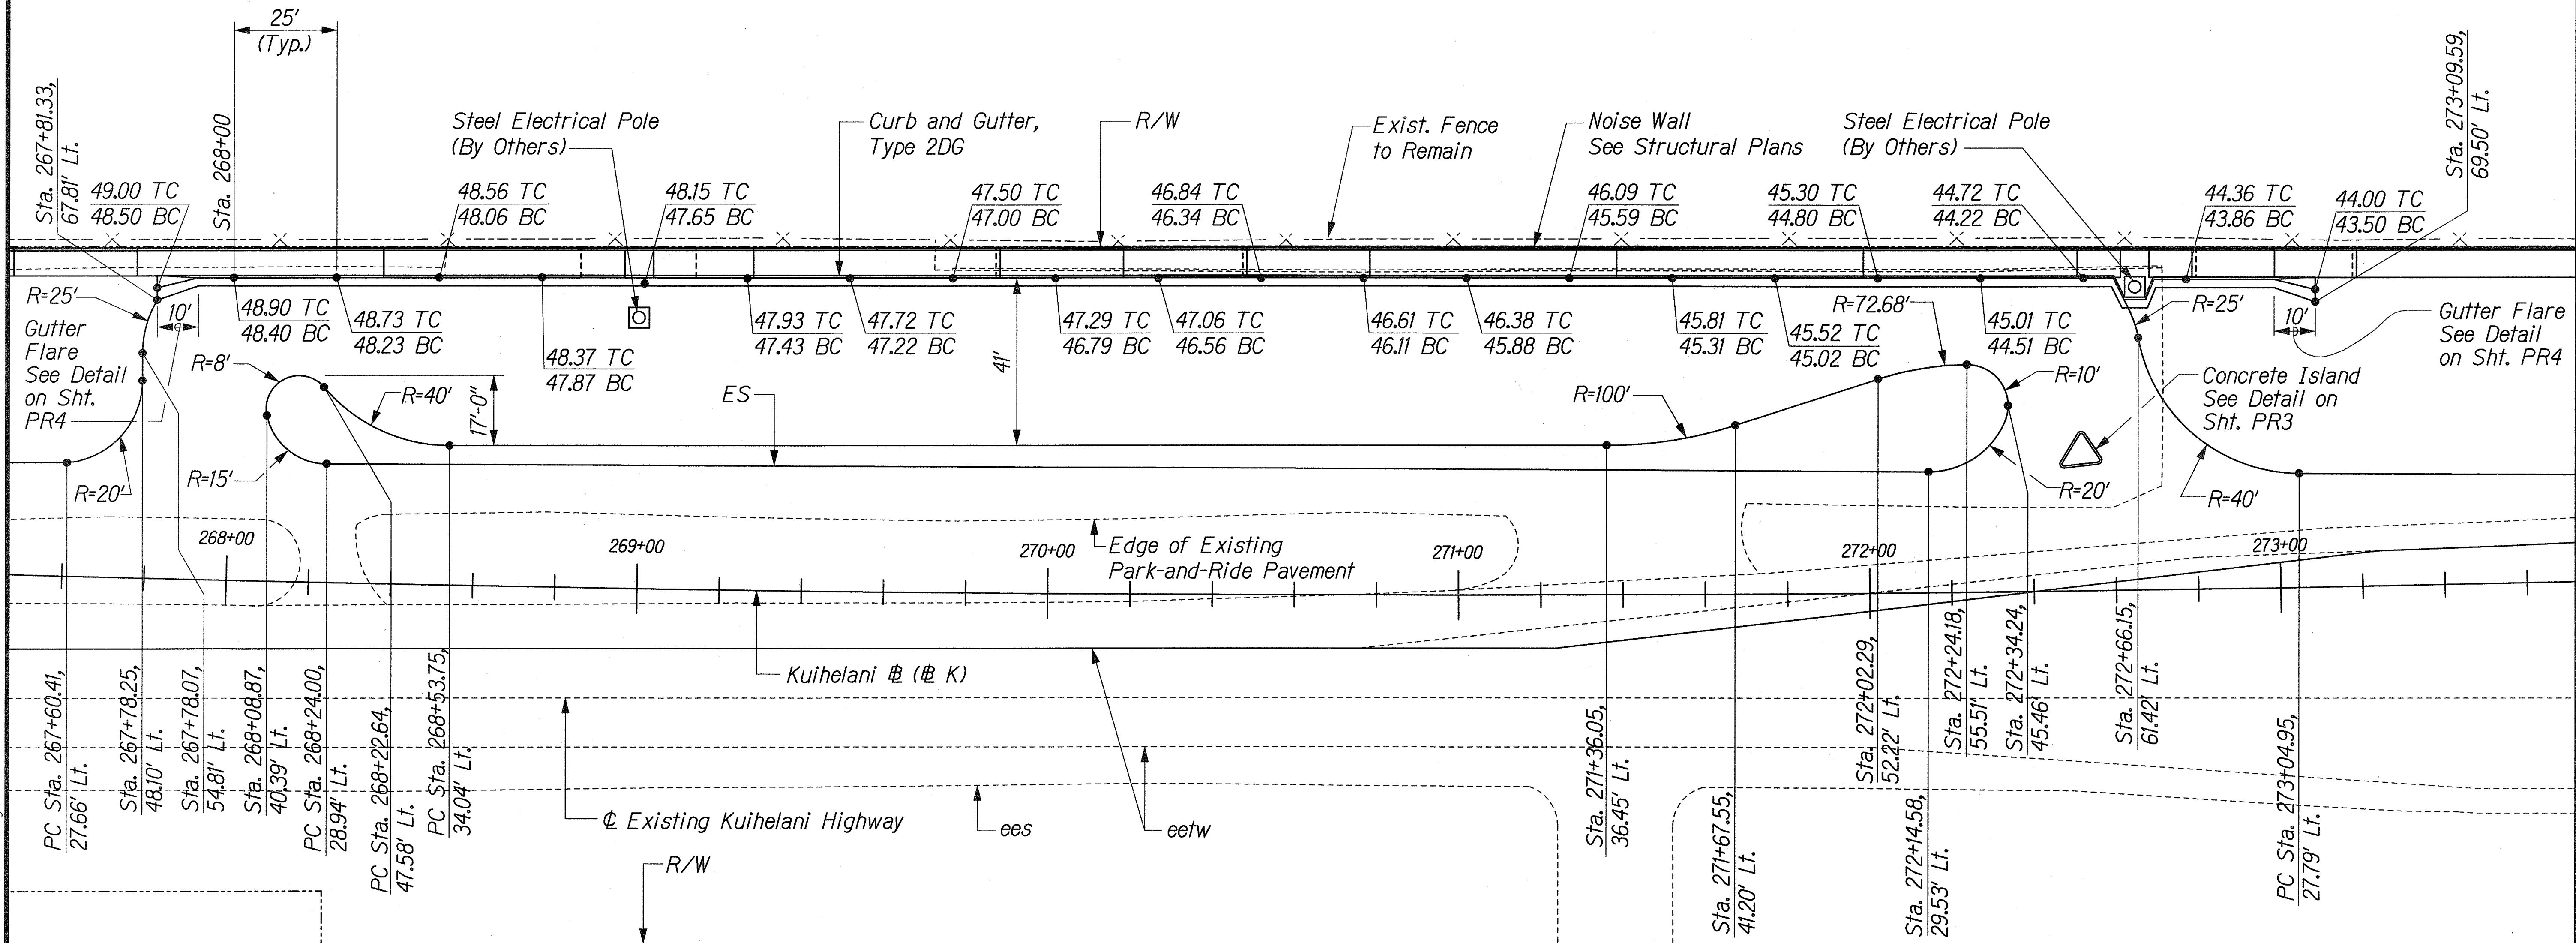


FED. ROAD DIST. NO.	STATE	FED. AID PROJ. NO.	FISCAL YEAR	SHEET NO.	TOTAL SHEETS
HAWAII	HAW.	NH-0380(9)	2000	159	380


NOTE:
1. See Typical Section on Sht. PR3.

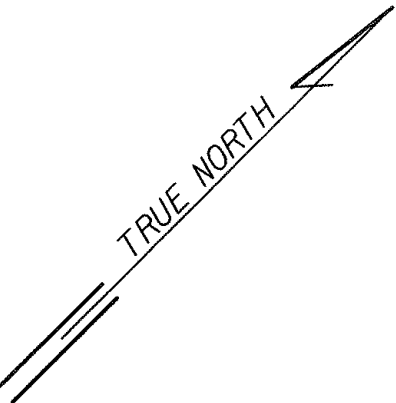

ORIGINAL PLAN	SURVEY PLOTTED BY	DATE
NOTE BOOK	DRAWN BY	
	DESIGNED BY	
	QUANTITIES BY	
	CHECKED BY	

\\KUIHELANI\CHANGE ORDER\PAK-AND-RIDE\JUN02 REV\PMR-ROAD.dgn


LEGEND
TC Top Curb
BC Bottom Curb

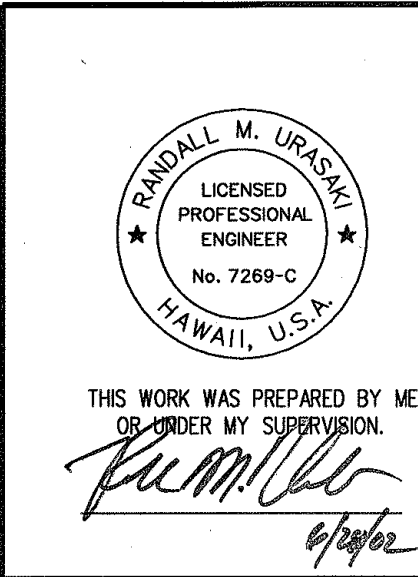

6/26/02	Revised Sheet
2/8/02	Revised Sheet
Date	Revision


STATE OF HAWAII
DEPARTMENT OF TRANSPORTATION
HIGHWAYS DIVISION
PARK AND RIDE
ROADWAY CONSTRUCTION
KUIHELANI HIGHWAY WIDENING
HONOLULU HIGHWAY TO PUUNENE AVENUE
FEDERAL-AID PROJECT NO. NH-0380(9)
Scale: 1"=20' Date: June 26, 2002

FED. ROAD DIST. NO.	STATE	FED. AID PROJ. NO.	FISCAL YEAR	SHEET NO.	TOTAL SHEETS
HAWAII	HAW.	NH-0380(9)	2000	161	380

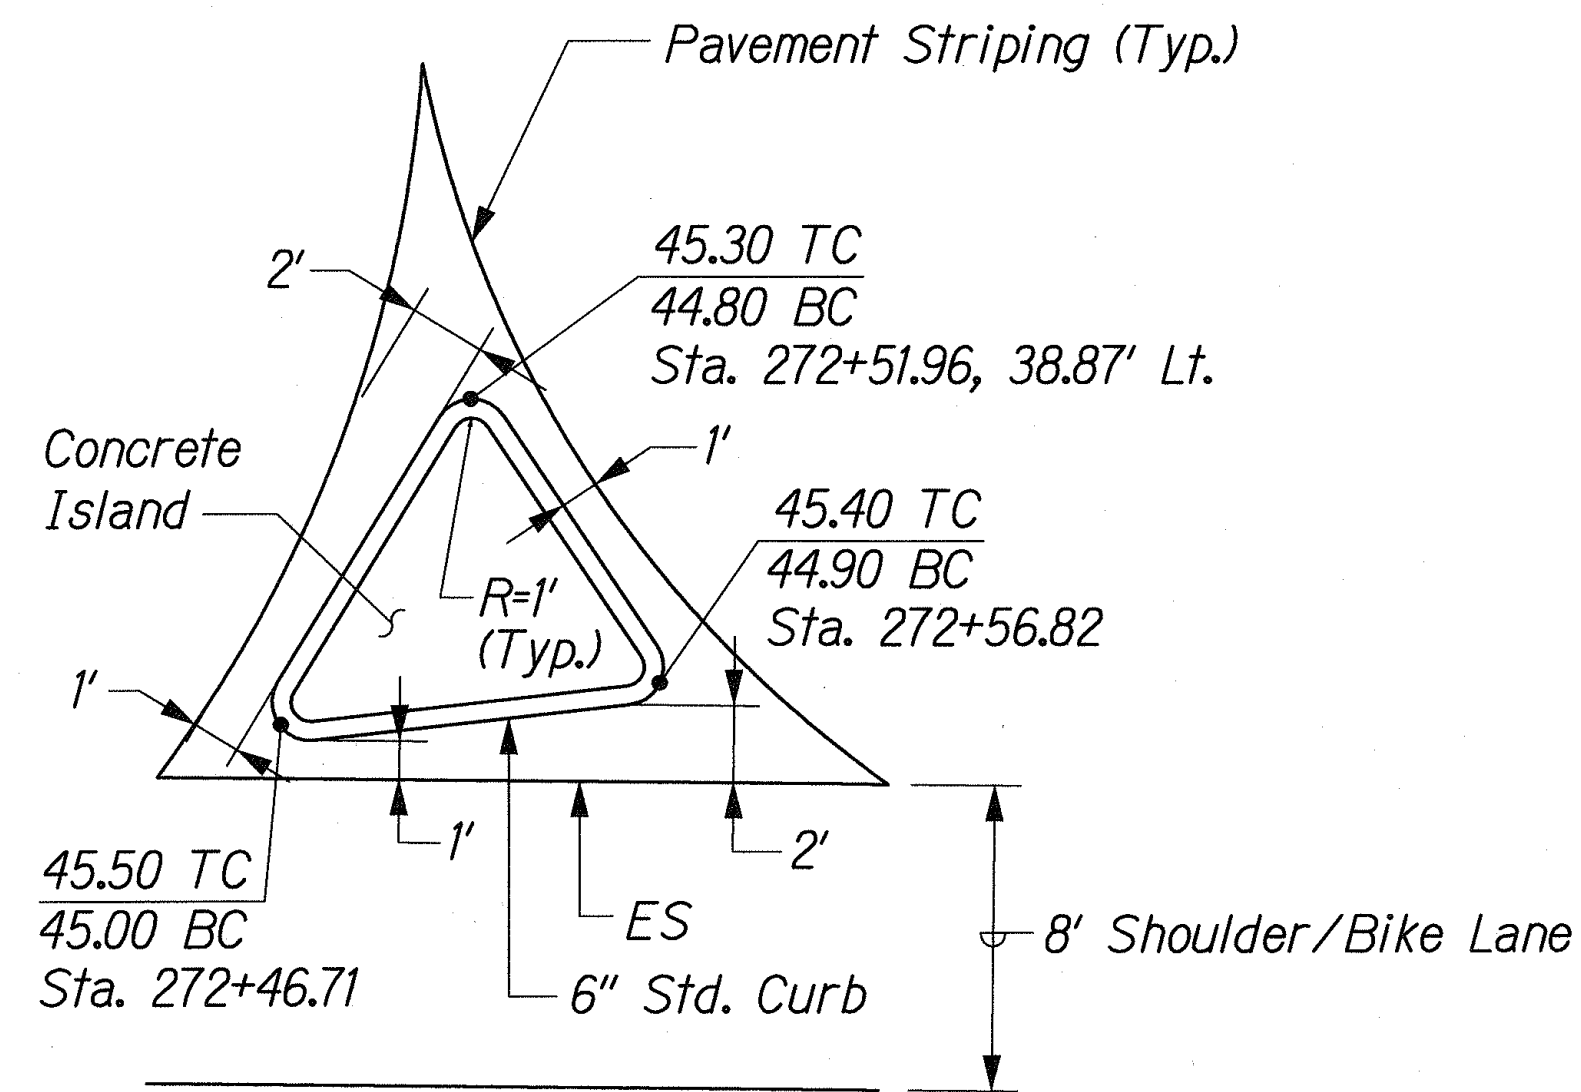


CONCRETE ISLAND DETAIL

Scale: 1" = 5'

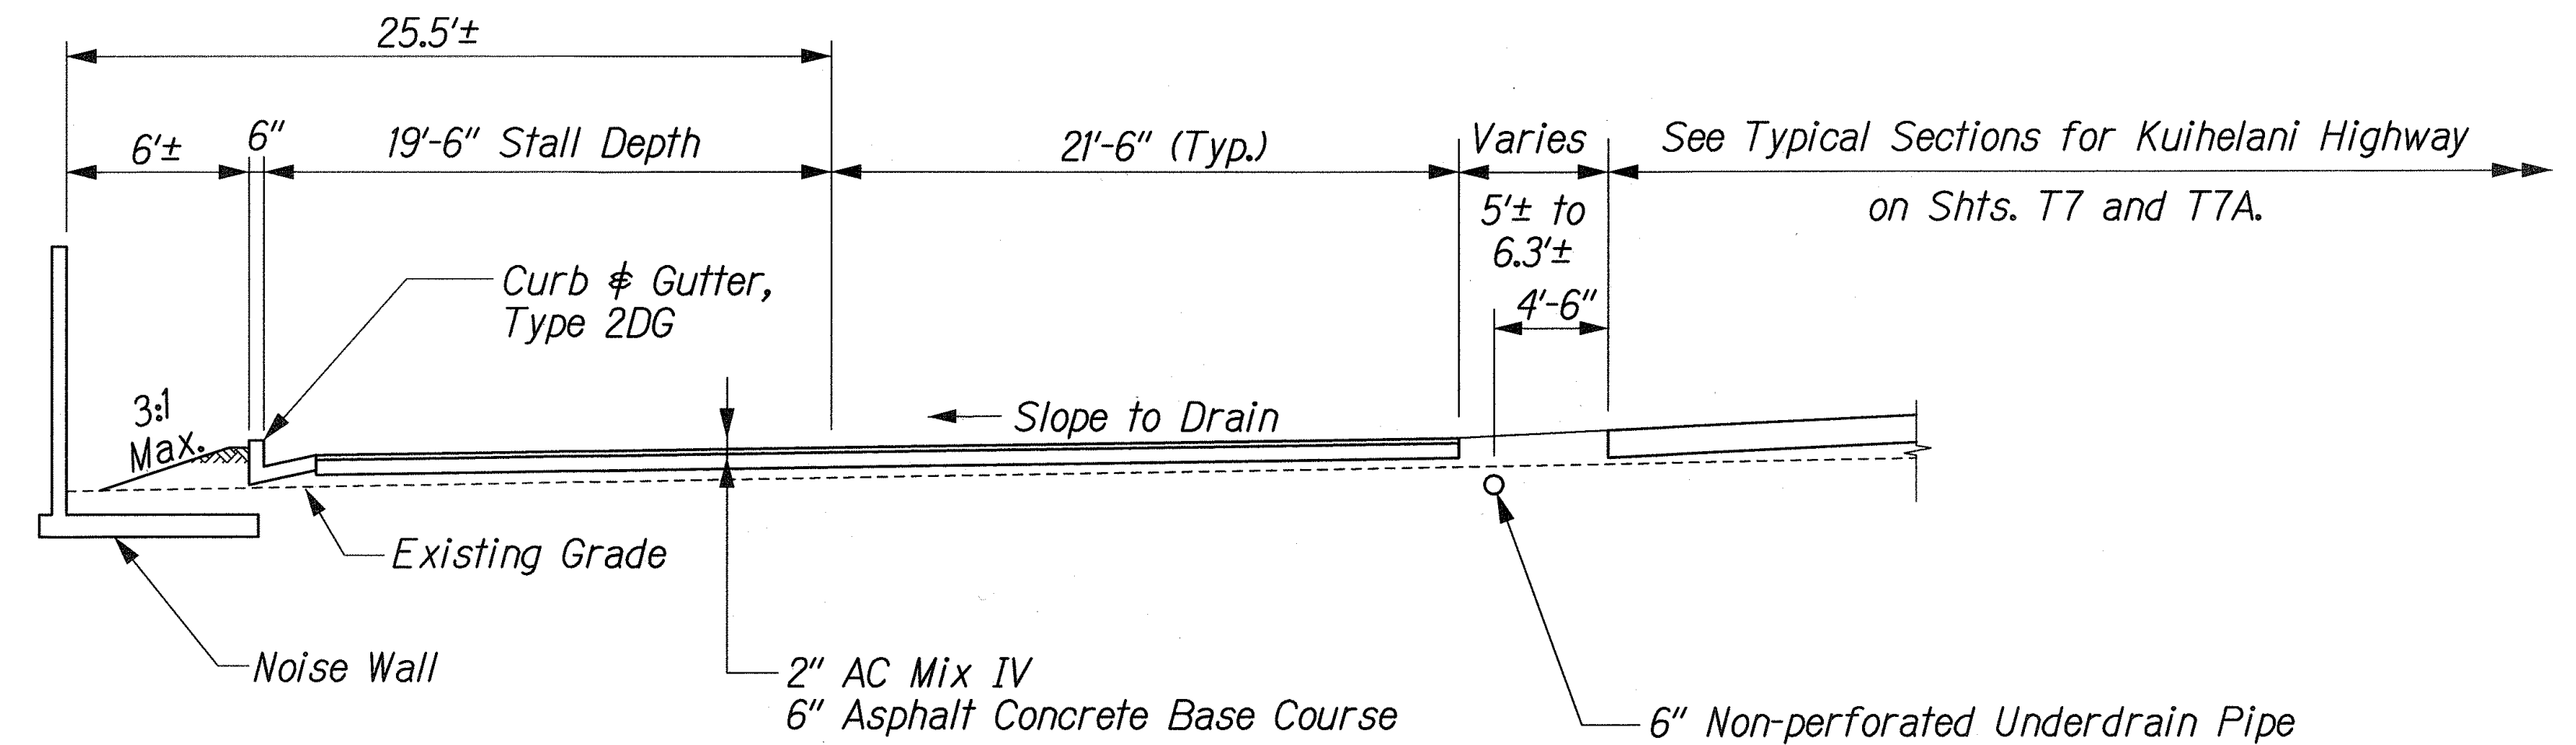

TYPICAL SECTION
Sta. 268+27.32 to 271+38.17

Not to Scale

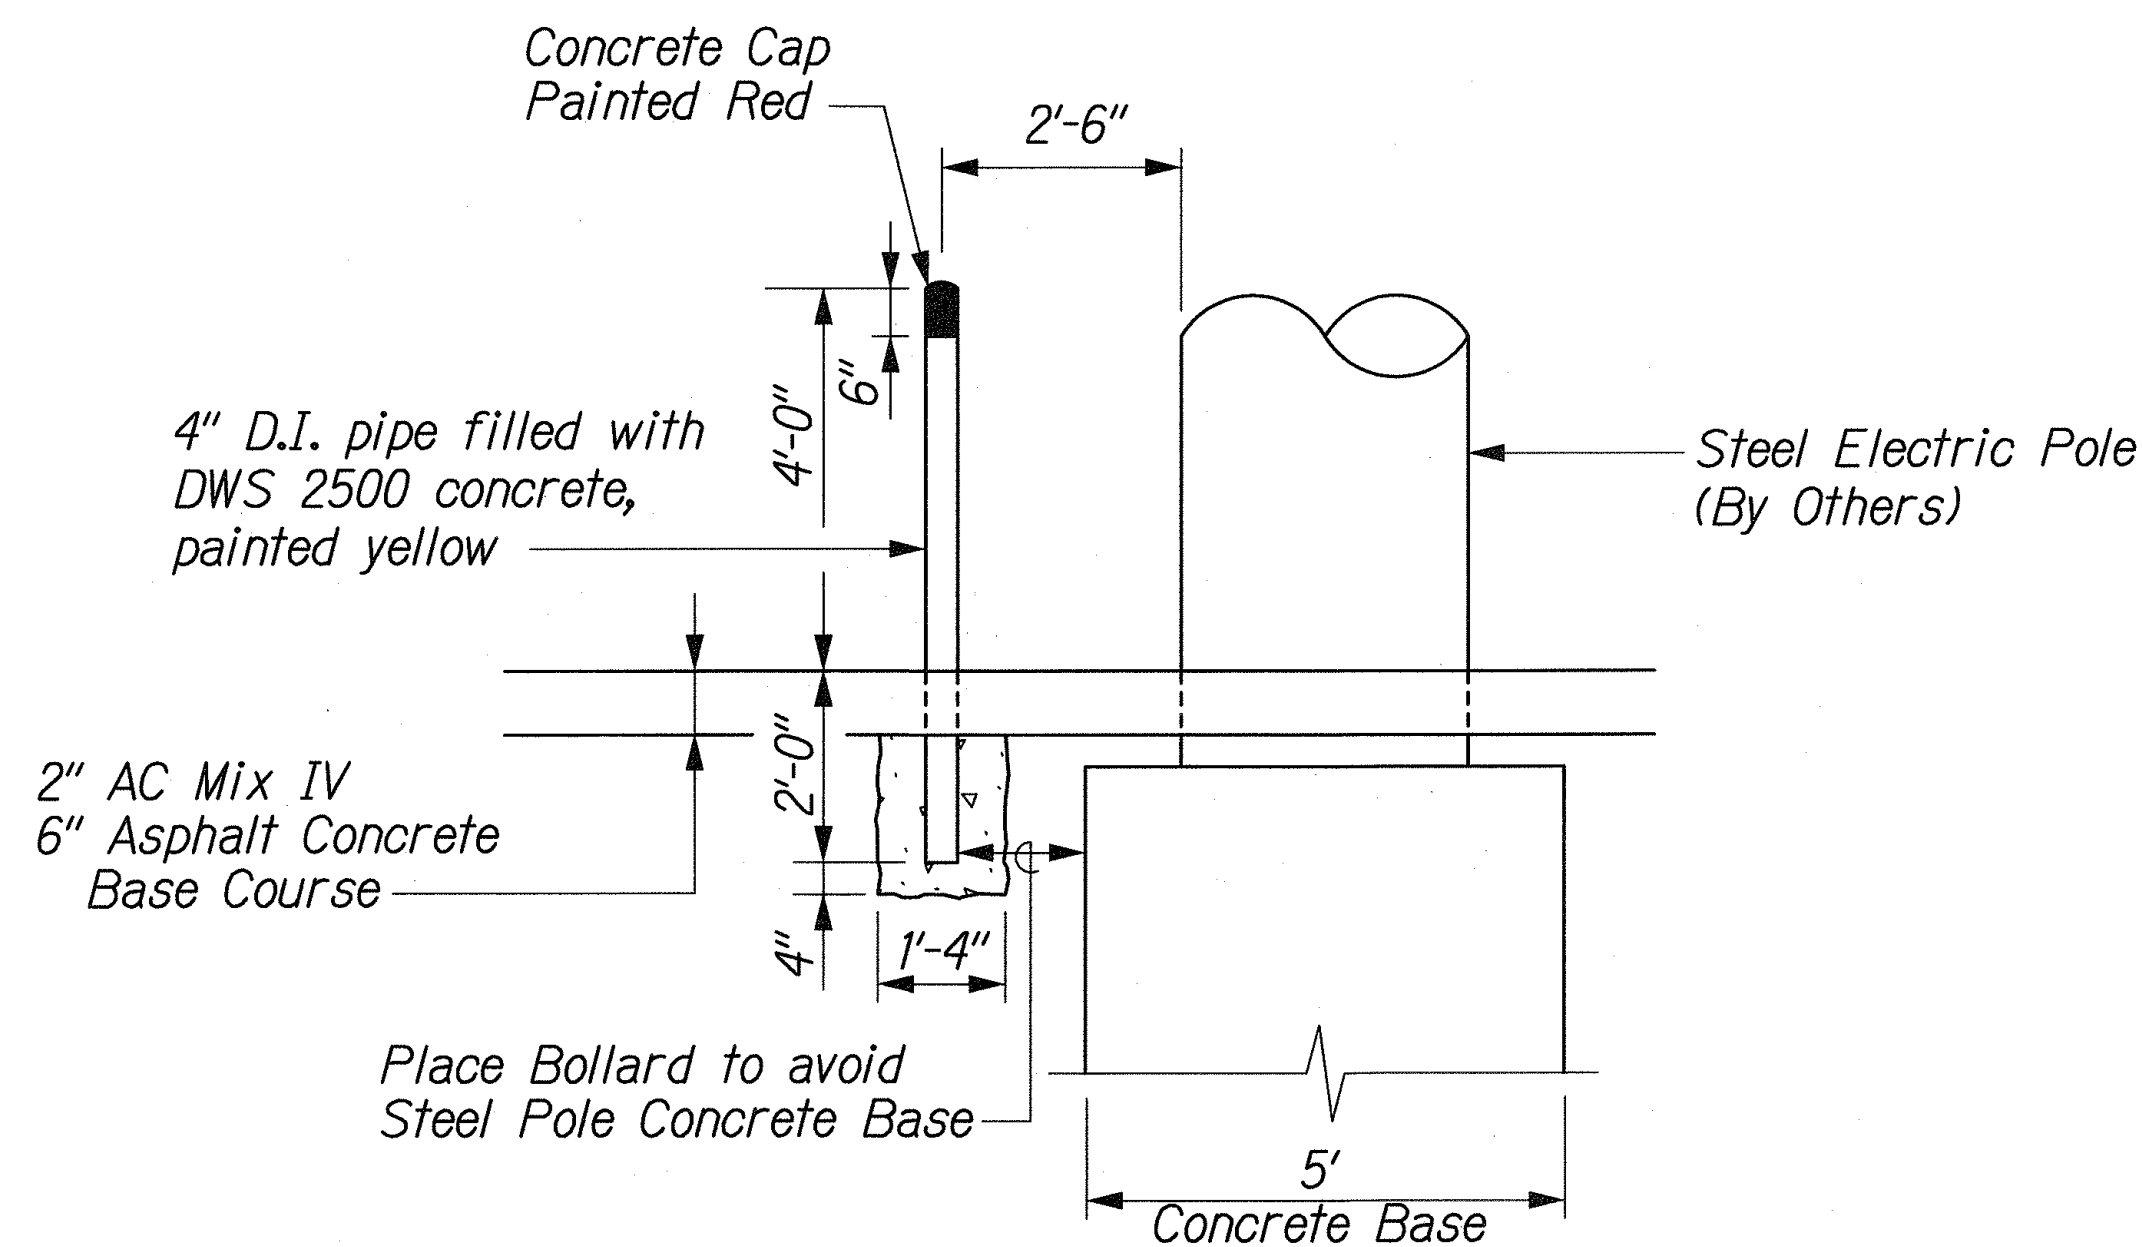

CONCRETE BOLLARD DETAIL

Scale: 1" = 2'

6/26/02	Revised Details; Deleted Pvm. Marking & Wheelstop Details
2/8/02	Revised Sheet
Date	Revision

THIS WORK WAS PREPARED BY ME OR UNDER MY SUPERVISION.

Rumalt

6/26/02

STATE OF HAWAII

DEPARTMENT OF TRANSPORTATION

HIGHWAYS DIVISION

PARK AND RIDE

DETAILS

KUIHELANI HIGHWAY WIDENING

HONOAPIILANI HIGHWAY TO PUUNENE AVENUE

FEDERAL-AID PROJECT NO. NH-0380(9)

Scale: AS SHOWN Date: June 26, 2002



SHEET No. PR3 OF 4 SHEETS

C.O. 161

ORIGINAL PLAN	DATE
NOTE BOOK	DESIGNED BY
QUANTITIES BY	CHECKED BY
N.	

36 KUIHELANI/CHANGE ORDER/PARK-AND-RIDE/JUN02 REV/PNRDET-01.dgn

FED. ROAD DIST. NO.	STATE	FED. AID PROJ. NO.	FISCAL YEAR	SHEET NO.	TOTAL SHEETS
HAWAII	HAW.	NH-0380(9)	2000	162	380

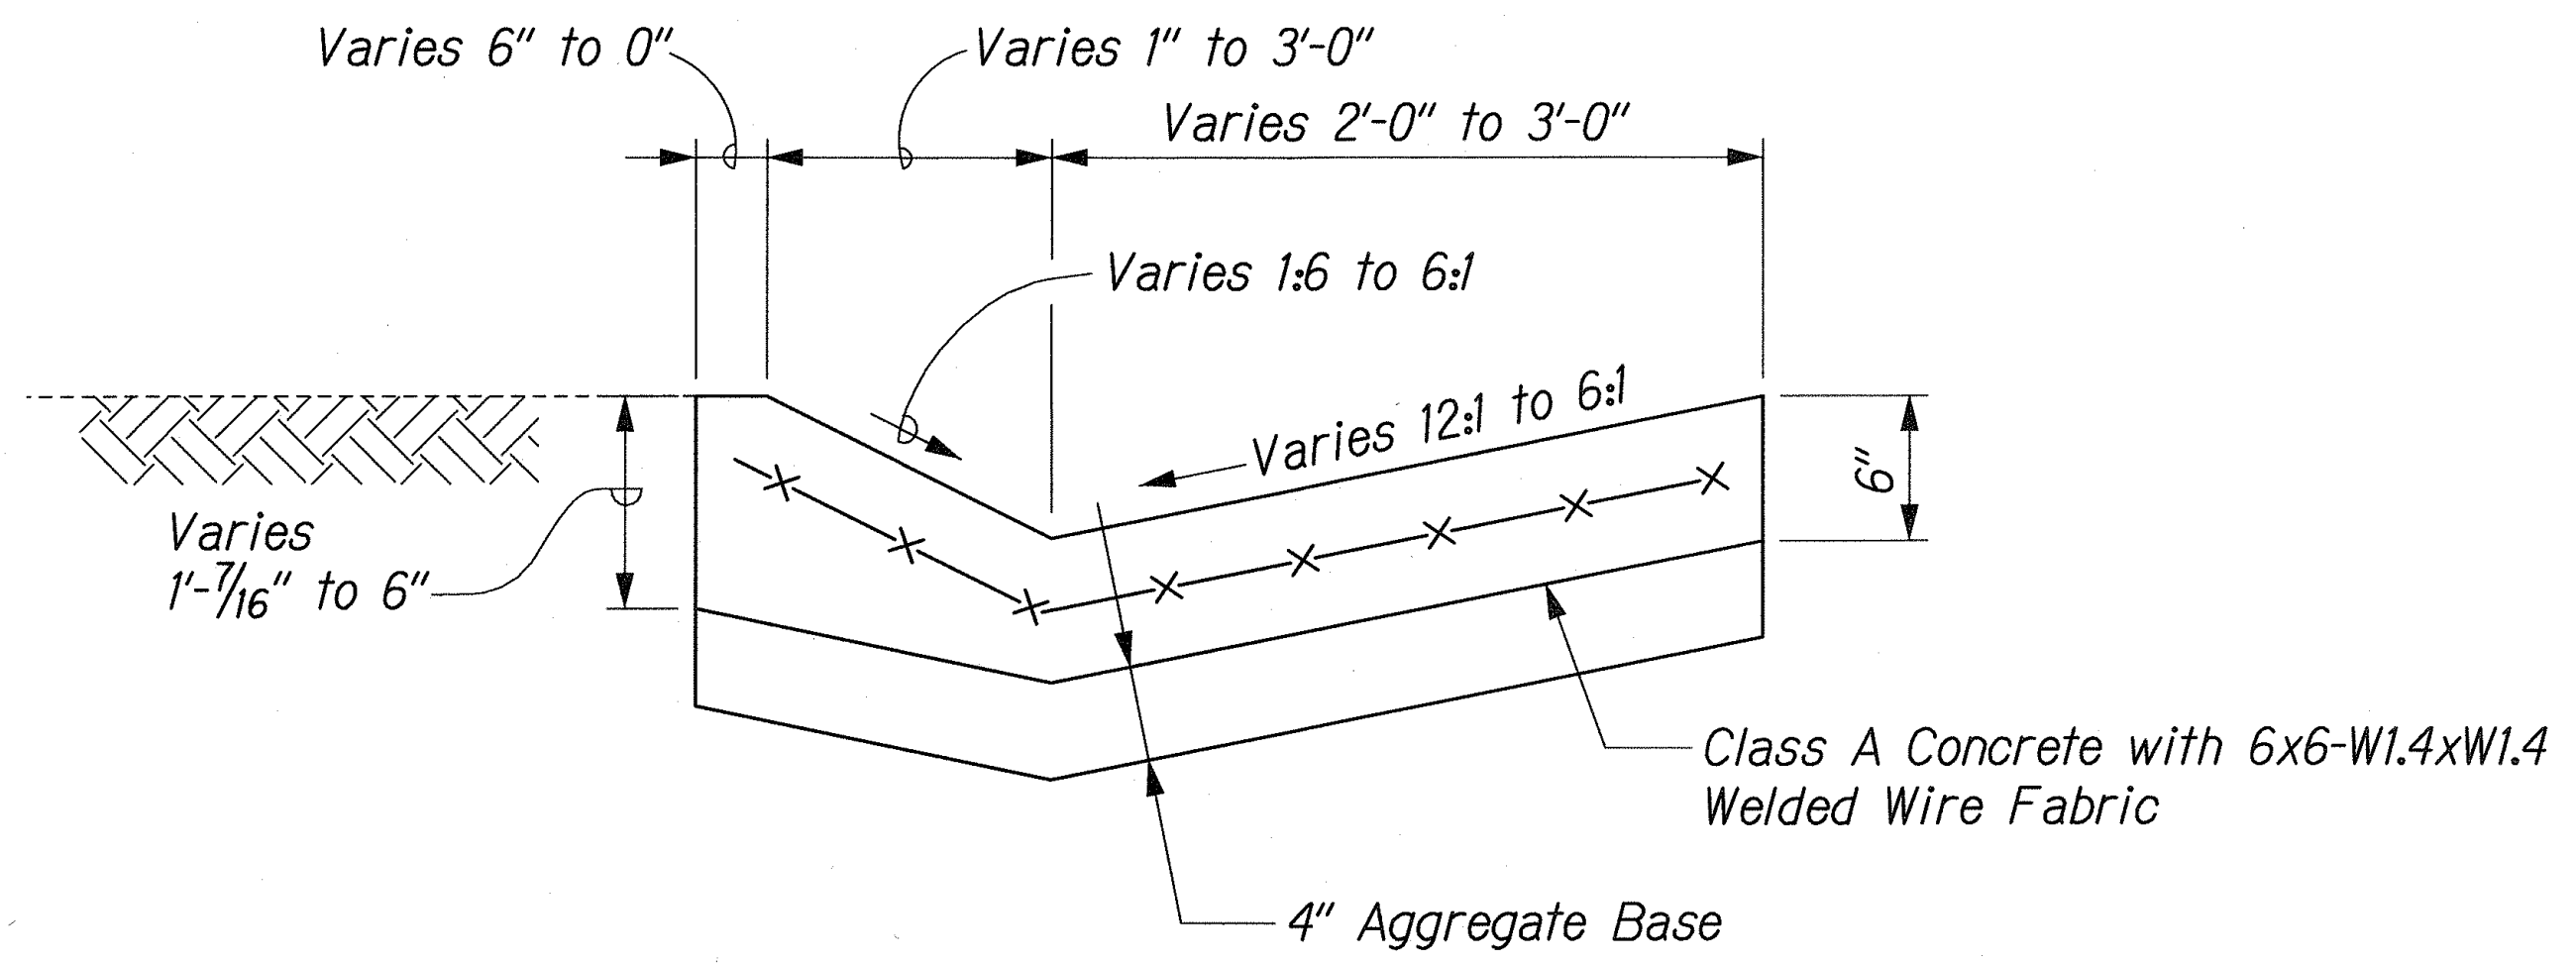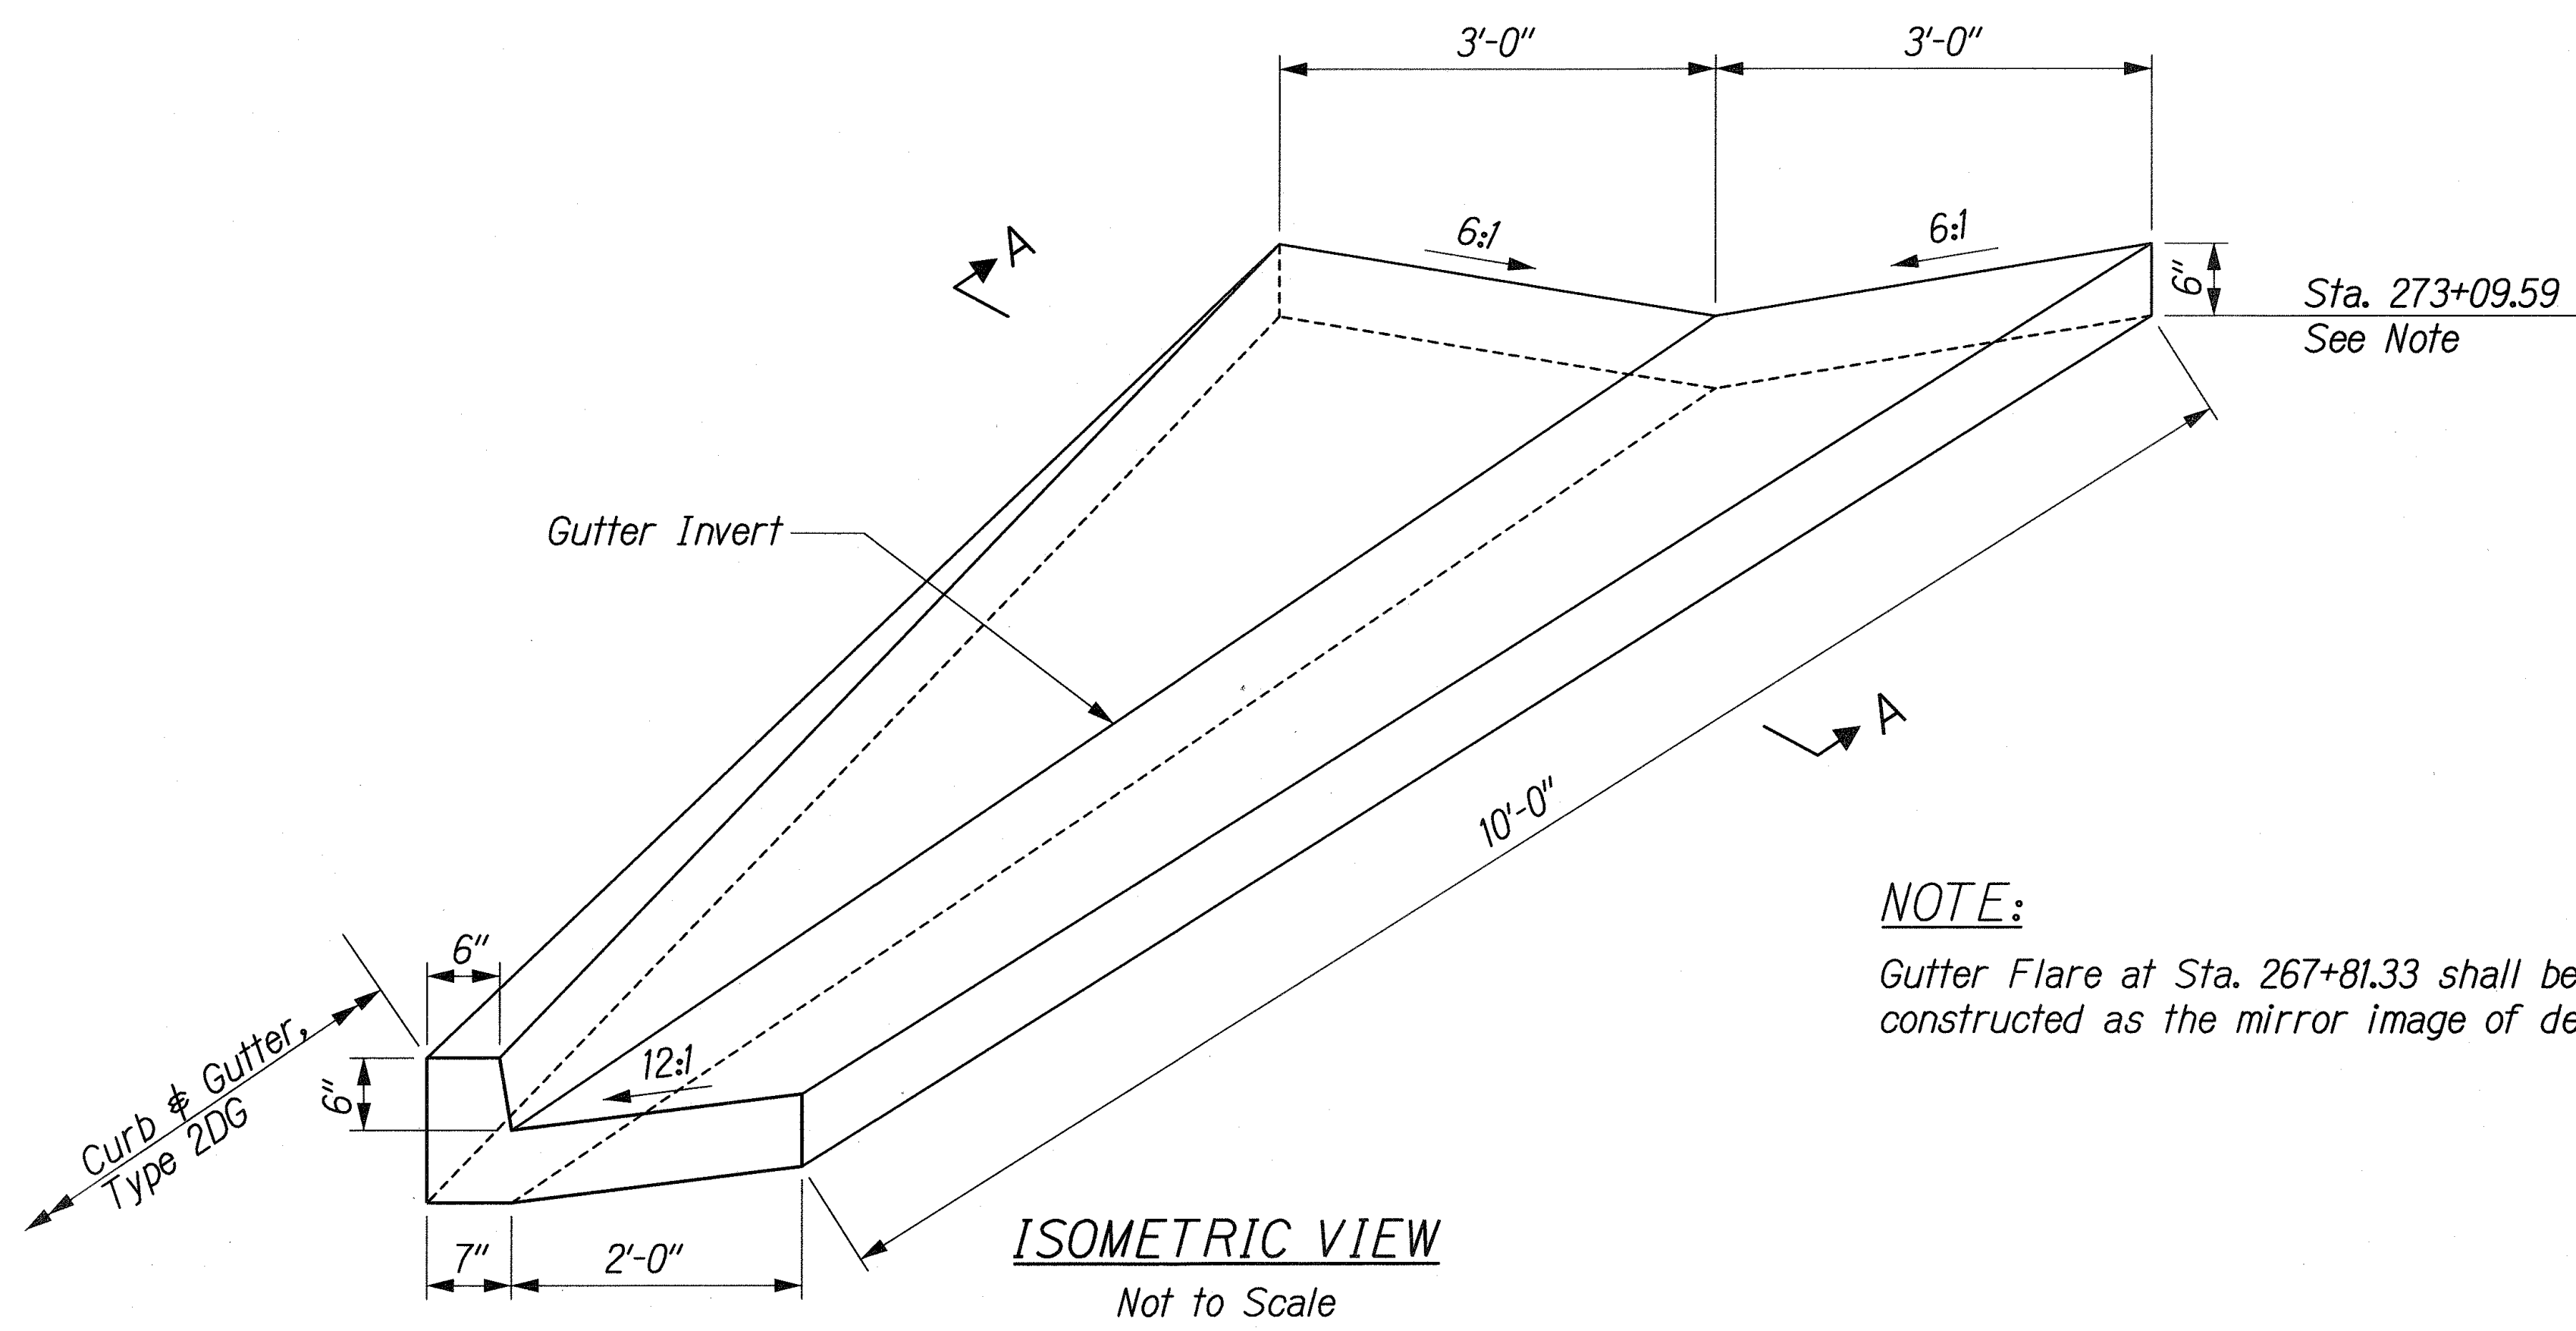

SECTION A-A
Scale: 1 1/2"=1'-0"

DESIGNED BY	DATE
DRAWN BY	
CHECKED BY	
NOTED BY	
QUANTITIES BY	
NO.	

162 KUIHELANI/CHANGE ORDER/PARK-AND-RIDE/PARK/PNRDET-02.dgn

2/8/02	Revised Sheet
Date	Revision

THIS WORK WAS PREPARED BY ME
OR UNDER MY SUPERVISION.
R. Urasaka
2/8/02

STATE OF HAWAII
DEPARTMENT OF TRANSPORTATION
HIGHWAYS DIVISION
PARK AND RIDE
ROADWAY CONSTRUCTION DETAILS
KUIHELANI HIGHWAY WIDENING
HONOAPIILANI HIGHWAY TO PUUNENE AVENUE
FEDERAL-AID PROJECT NO. NH-0380(9)
Scale: As Shown Date: Feb. 8, 2002

SHEET No. PR4 OF 4 SHEETS