


FED. ROAD DIST. NO.	STATE	FED. AID PROJ. NO.	FISCAL YEAR	SHEET NO.	TOTAL SHEETS
HAWAII	HAW.	NH-0380(9)	2000	163	380

INDEX TO BRIDGE DRAWINGS

SHEET NO.	DESCRIPTION	SHEET NO.	DESCRIPTION
S-1	Index To Bridge Drawings and Abbreviations	S-31	Drilled Shaft Details
S-2	Structural General Notes	S-32	Concrete Railing Details
S-3	Paleaahu Stream Bridge Plan, Elevation and Section	S-33	Existing Concrete Railing Upgrade
S-4	Paleaahu Stream Bridge Foundation Plan and Spot Elevations	S-34	Metal Bikeway Railing Details
S-5	Paleaahu Stream Bridge Abutment Sheet 1 of 4	S-35	Deck Joint and Approach Slab Details
S-6	Paleaahu Stream Bridge Abutment Sheet 2 of 4	S-36	Miscellaneous Details - 1
S-7	Paleaahu Stream Bridge Abutment Sheet 3 of 4	S-37	Miscellaneous Details - 2
S-8	Paleaahu Stream Bridge Abutment Sheet 4 of 4	S-38	CMU Noise Wall Plan & Elevation 1
S-9	Paleaahu Stream Bridge Prestressed Beam Details	S-39	CMU Noise Wall Plan & Elevation 2
S-10	Paleaahu Stream Bridge Deck Reinforcement and Framing Plan	S-40	CMU Noise Wall Plan & Elevation 3
S-11	Waikapu Stream Bridge Plan, Elevation and Section	S-41	CMU Noise Wall Plan & Elevation 4
S-12	Waikapu Stream Bridge Foundation Plan and Spot Elevations	S-42	CMU Noise Wall Plan & Elevation 5
S-13	Waikapu Stream Bridge Abutment Sheet 1 of 4	S-43	CMU Noise Wall Plan & Elevation 6
S-14	Waikapu Stream Bridge Abutment Sheet 2 of 4	S-44	CMU Noise Wall Plan & Elevation 7
S-15	Waikapu Stream Bridge Abutment Sheet 3 of 4	S-45	CMU Noise Wall Plan & Elevation 8
S-16	Waikapu Stream Bridge Abutment Sheet 4 of 4	S-46	CMU Noise Wall Plan & Elevation 9
S-17	Waikapu Stream Bridge Prestressed Beam Details - 1	S-47	CMU Noise Wall Plan & Elevation 10
S-18	Waikapu Stream Bridge Prestressed Beam Details - 2	S-48	CMU Noise Wall Plan & Elevation 11
S-19	Waikapu Stream Bridge Deck Reinforecement and Framing Plan	S-49	CMU Noise Wall Plan & Elevation 12
S-20	Waihee Ditch Bridge Plan and Longitudinal Section	S-50	CMU Noise Wall Plan & Elevation 13
S-21	Waihee Ditch Bridge Foundation Plan and Spot Elevations	S-51	CMU Noise Wall Plan & Elevation 14
S-22	Waihee Ditch Bridge Abutment Sheet 1 of 3	S-52	CMU Noise Wall Plan & Elevation 15
S-23	Waihee Ditch Bridge Abutment Sheet 2 of 3	S-53	CMU Noise Wall Plan & Elevation 16
S-24	Waihee Ditch Bridge Abutment Sheet 3 of 3	S-54	CMU Noise Wall Details
S-25	Waihee Ditch Bridge Precast R.C. Plank Details		
S-26	Waihee Ditch Bridge Deck Reinforcement and Framing Plan		
S-27	Kuihelani Three Span Culvert Plan, Elevation and Section		
S-28	Kuihelani Three Span Culvert Foundation Plan and Spot Elevations		
S-29	Kuihelani Three Span Culvert Wingwall Details		
S-30	Excavation and Backfill Payment Limits		

SYMBOLS AND ABBREVIATIONS

A.C.	Asphalt Concrete	Horiz.	Horizontal
Add.	Additional	H.S.	High Strength
ASTM	American Society For Testing & Materials	JT.	Joint
AZ.	Azimuth	Lc.	Length of Curve
(B), B., or BOT	Bottom	lg.	Long
		Max.	Maximum
B.C.	Bottom of Curve	Min.	Minimum
℄	Baseline	No. or #	Number
BRG.	Bearing	N.T.S.	Not To Scale
(C)	Contraction or Control Joint	O.C.	On Centers
C.C.	Center of Curve or Center to Center	o/s	Offset
℄	Centerline	℄	Plate
CL, Clr.	Clear	R	Radius
CRM	Cement Rubble Masonry	R.C.	Reinforce Concrete
Conc.	Concrete	ref.	Reference
Cont.	Continuous	reinf.	Reinforcement
Const.	Construction	Sht. No.	Sheet Number
CMU	Concrete Masonry Unit	Std.	Standard
dwgs.	Drawings	(T) or T.	Top
(E)	Expansion Joints or Expansion Bearing	TYP.	Typical
e.a.	Each	Var.	Varies
El, Elev.	Elevation	Vert.	Vertical
FIN. GR.	Finished Grade	w/	With
ft.	Foot	∅ or Dia.	Diameter
ga.	Gage	¢	And
galv.	Galvanized	±	Plus or Minus
(H)	Hinge Bearing		

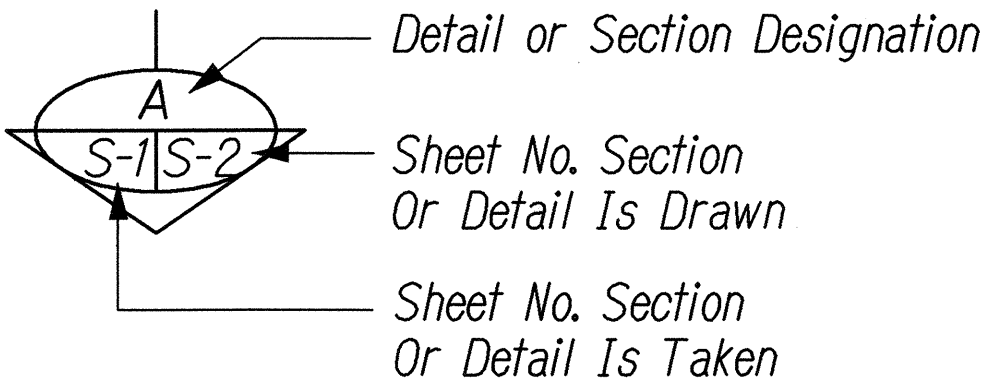

ORIGINAL PLAN	SURVEY PLOTTED BY	DATE
NOTE BOOK	DRAWN BY	
	TRACED BY	
	QUANTITIES BY	
	CHECKED BY	

J:\KUIHELANI\MISC\GP-INDEX.dgn

THIS WORK WAS PREPARED BY ME
OR UNDER MY SUPERVISION.

Hui Pang Chen

STATE OF HAWAII
DEPARTMENT OF TRANSPORTATION
HIGHWAYS DIVISION

INDEX TO DRAWINGS & ABBREVIATIONS

KUIHELANI HIGHWAY WIDENING
HONOAPIILANI HIGHWAY TO PUUNENE AVENUE
FEDERAL-AID PROJECT NO. NH-0380(9)
Scale: None Date: Sept. 14, 2001

SHEET No. S-1 OF 54 SHEETS

FED. ROAD DIST. NO.	STATE	FED. AID PROJ. NO.	FISCAL YEAR	SHEET NO.	TOTAL SHEETS
HAWAII	HAW.	NH-0380(9)	2000	164	380


1. GENERAL SPECIFICATIONS: Hawaii Standard Specifications for Road, Bridge, and Public Works construction, 1994. Together with Special Provisions prepared for this contract.
2. DESIGN SPECIFICATIONS: "AASHTO LRFD Bridge Design Specifications," Second Edition, 1998, with 1999 Interim.
3. LOADS:
- A. Dead Load: An allowance of 2 inches for future wearing surface of asphalt concrete has been provided for in the design.
- B. Live Load: HL-93.
- C. Seismic Load: Acceleration Coefficient = 0.26.
Seismic Performance Zone = 3.
Importance Category = Essential Bridge Soil Profile Type I.
- D. Railing Test Level = TL-4.
4. MATERIALS:
- A. Minimum concrete compressive strength (at 28 days) shall be as follows unless otherwise noted:
- 1) Deck Slab = 3750 psi (Class BD)
- 2) All other concrete = 4000 psi unless otherwise noted
- B. All reinforcing steel shall conform to ASTM A615, Grade 60, unless otherwise noted.
- C. All drilled shaft spiral reinforcing shall be deformed reinforcing bars conforming to ASTM A615, Grade 60.
- D. All miscellaneous steel shall conform to ASTM A36 and be hot dip galvanized after fabrication, unless otherwise noted.
- E. All pipe sections shall conform to ASTM A53 (Type E), Grade B, and be hot dip galvanized after fabrication.
- F. All structural tube sections shall conform to ASTM A500, Grade B, and be hot dip galvanized after fabrication.
- G. All anchor bolts, washers and nuts shall conform to ASTM A307 and be hot dip galvanized after fabrication, unless otherwise specified.
- H. For materials of prestressed concrete girders, see applicable prestressed concrete notes.
- I. Elastomeric bearing pads shall be 60 hardness. Steel laminations shall be 1/8 inches thick ASTM A36 Steel Plates.
5. REINFORCEMENT:
- A. Unless otherwise noted, the covering measured from the surface of the concrete to the face of any reinforcing bars shall be as follows:
- 1) Deck Slabs
- A) Top Bars = 2"
- B) Bottom Bars = 1 1/4"
- 2) Railings and Parapets = 2"
- 3) For Prestressed Concrete Girders, see Prestressed Concrete Girder Details.
- 4) Abutment Walls and Wing Walls = 2"
- 5) Concrete Cast against and permanently exposed earth = 3"
- 6) Drilled Shafts = 3" (to spirals)
- B. Reinforcing bars shall be detailed in accordance with ACI Detailing manual for reinforced concrete highway structures unless otherwise noted.
- C. Minimum clear spacing between parallel bars shall be 1 1/2 times the diameter of bars (For non bundled bars) or 1 1/2 times the diameter derived from the equivalent total area of the bars (for bundled bars), but in no case shall the clear distance between the parallel bars be less than 1 1/2 times the maximum size of the coarse aggregate or 1 1/2 inches.
- D. All dimensions relating to reinforcing bars (e.g. spacing of bars, etc.) are to centers of bars unless otherwise noted.
- E. Reinforcing bars shall be securely tied at all intersections and lap splices except where the spacing of intersections is less than one foot in each direction, in which case alternate intersections shall be tied.
- F. All bars shown with bends shall conform to standard ACI Hooks unless otherwise noted.
- G. Vertical drilled shaft bars shall be arranged in such a manner as to avoid interference with footing bars. Top bends of vertical bars shall be arranged to fit within limits of the footing. Minimum embedment shown shall be provided. No bars shall be cut.

6. GIRDER BEARINGS:
- A. Bearing surface shall be smooth and level. Girders shall be set on a fresh layer of mortar to insure full bearing.
- B. Girder seat elevations shall be verified by the Contractor. Seat elevations shall take into consideration the vertical roadway curve differential, deck slab thickness, minimum haunch required, girder depth, and the calculated or, if available, the actual camber of the girders.
- C. The concrete seat and elastomeric bearing pad shall be placed as shown.
7. CONSTRUCTION NOTES:
- A. See Standard Specifications and Special Provisions.
- B. Top of concrete deck slab shall be constructed to follow the roadway finish grades. The Contractor shall set deck slab forms to account for anticipated deflection of girders during placement of concrete for deck slab and diaphragms. Also, see prestressed girder notes.
- C. Unless otherwise noted, all vertical dimensions are measured plumb.
- D. The Contractor shall verify all site conditions before commencing with work.
- E. The Contractor shall verify the location of all utility lines and notify the respective owners before commencing the work of excavation or drilled shafts.
- F. For concrete finish, see Standard Specifications.
- G. Construction joints may be relocated or additional ones added subject to the approval of the Engineer.
- H. Unless otherwise noted, all exposed concrete edges shall be chamfered 3/4"x3/4".
- I. Elastomeric bearing pads shall be secured to the concrete bearing surface with adhesives or other means necessary as approved by the Engineer.
- J. The Contractor shall restrain the girders in the longitudinal direction during placement.
- K. Shoring shall be provided for the existing bridge footings during construction of the new abutment footings as required.
- L. All slopes and exposed areas of slope steeper than 3H: 1V shall be Hydro-Mulch seeded and covered with erosion control matting as soon as final grades have been established in accordance with the Specifications and Grading plan. Planting shall not be delayed until all grading work has been completed. Grading to final grade shall be continuous, and any area within which work has been interrupted or delayed shall be planted.
8. GENERAL:
- A. All items noted incidental will not be paid for separately.
- B. Standard detail drawings refer to all structures in general, except for modifications as may be required for special conditions. For such modifications, refer to the corresponding detailed drawings.
- C. The Contractor shall comply with all construction permits for this project. In addition, the Contractor shall be responsible for obtaining and complying with any NPDES permits and licenses that may be required for the work.
- D. The Contractor shall utilize appropriate erosion control measures during construction and shall perform construction activities affecting or affected by the stream only during periods of low stream flow. The Contractor shall prevent debris and construction materials, including cement or concrete, petroleum products, and other pollutants from entering the stream. Wash and dust control water shall be properly disposed.
- E. In the event that subsurface cultural remains such as artifacts, burials or deposits of shells or charcoal are encountered during excavation work, the Contractor shall stop work in the area of the find and contact the Engineer immediately. Work may recommence only with Engineer's approval.
9. FOUNDATION:
- These foundation notes were based on recommendations contained in a foundation investigation report by Geolabs Hawaii, Inc. dated September 18, 2000. The report shall be considered as part of the construction documents and its recommendations shall be implemented unless otherwise ordered by the Engineer.
- A. Abutments and Wing Walls:
- 1) Design Equivalent Fluid Pressure:
- Level Backfill:
- Active = 40 PCF
- At Rest = 60 PCF
- 2) Backfill Material:
- a. The onsite clayey silt and highly to completely weathered basalt may be reused as backfill provided all rock fragments larger than 6 inches in maximum dimension are removed prior to compaction.




- b. Imported structural backfill shall be in accordance with the requirements for structure backfill material A as indicated in Section 703.20 of the Hawaii Standard Specifications for Road, Bridge, and Public Works Construction, 1994.
- c. Placement of the backfill material shall be in accordance with the Standard Specifications and the Special Provisions.
- B. Drilled Shafts
- 1) The vertical load capacity for the 60 inch diameter drilled shafts are from friction between the shafts and the surrounding soils. The following net vertical load parameters were used for design:
- a) Abutment No. 1 and No. 2: Paleaahu Stream Bridge
- Strength Limit State = 510 kips
- Extreme Event Limit State = 780 kips
- b) Abutment No. 1 and No. 2: Waikapu Stream Bridge
- Strength Limit State = 520 kips
- Extreme Event Limit State = 800 kips
- 2) The following lateral load capacities for 60 inch drilled shafts (Fixed-Head Condition) were used for design.
- Abutment No. 1 and No. 2 = 172 kips
- 3) The drilled shafts estimated tip elevation shown on the plans are based on the boring data. The actual tip elevation could change due to varying subsurface conditons. Soils Engineer of record shall be present during the drilling operation to determine that the actual subsurface conditions are consistent with the conditions assumed for design. Based on the recommendations, the tip elevations could change. The Contractor shall make provisions to account for variations in the final tip elevations.
- 4) The Contractor shall exercise care in drilling the shaft holes and in placing concrete into the holes. Rock drilling/coring equipment will be required for drilled shafts extending through hard basalt layers. Temporary casing may be needed to reduce the potential for caving in of the holes. The use of permanent casing will not be allowed.
- 5) Drilling shall not be conducted by methods utilizing drilling fluids.
- 6) Concrete for drilled shafts shall be placed within 24 hours after drilling to reduce the potential for caving in.
- 7) Since groundwater will likely be encountered in the drilled holes, placement of concrete shall be by tremie methods. A minimum of 10 feet of concrete head shall be maintained above the bottom of the tremie pipe during placement of concrete.
- C. Spread Footings:
- 1) Bearing Pressure:
- Extreme Event Limit State = 9000 psf
- Strength Limit State = 4000 psf
- Service Limit State = 3000 psf
- 2) Coefficient of Sliding Friction:
- Extreme Event Limit State = 0.35
- Strength Limit State = 0.28
- 3) Passive Earth Pressure:
- Extreme Event Limit State = 300 pcf
- Strength Limit State = 150 pcf
- D. Noise Wall
- 1) Design Equivalent Fluid Pressure, see Note 9A(1).
- 2) Design Wind Pressure = 80 MPH Wind Velocity with 30% gust.
- 3) Spread Footing, see Note 9C.

ORIGINAL PLAN	SURVEY PLOTTED BY	DATE
DRAWN BY		
CHECKED BY		
NOTE BOOK		
QUANTITIES BY		
CHECKED BY		
N ^o .		

\\KUIHELANI\STRUCT\ST-GN01.dgn

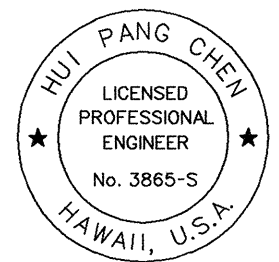 THIS WORK WAS PREPARED BY ME OR UNDER MY SUPERVISION. <i>Hui Pang Chen</i>	STATE OF HAWAII DEPARTMENT OF TRANSPORTATION HIGHWAYS DIVISION
	STRUCTURAL GENERAL NOTES
	KUIHELANI HIGHWAY WIDENING
	HONOAPIILANI HIGHWAY TO PUUNENE AVENUE
	FEDERAL-AID PROJECT NO. NH-0380(9)
Scale: None	Date: Sept. 14, 2001

FED. ROAD DIST. NO.	STATE	FED. AID PROJ. NO.	FISCAL YEAR	SHEET NO.	TOTAL SHEETS
HAWAII	HAW.	NH-0380(9)	2000	165	380

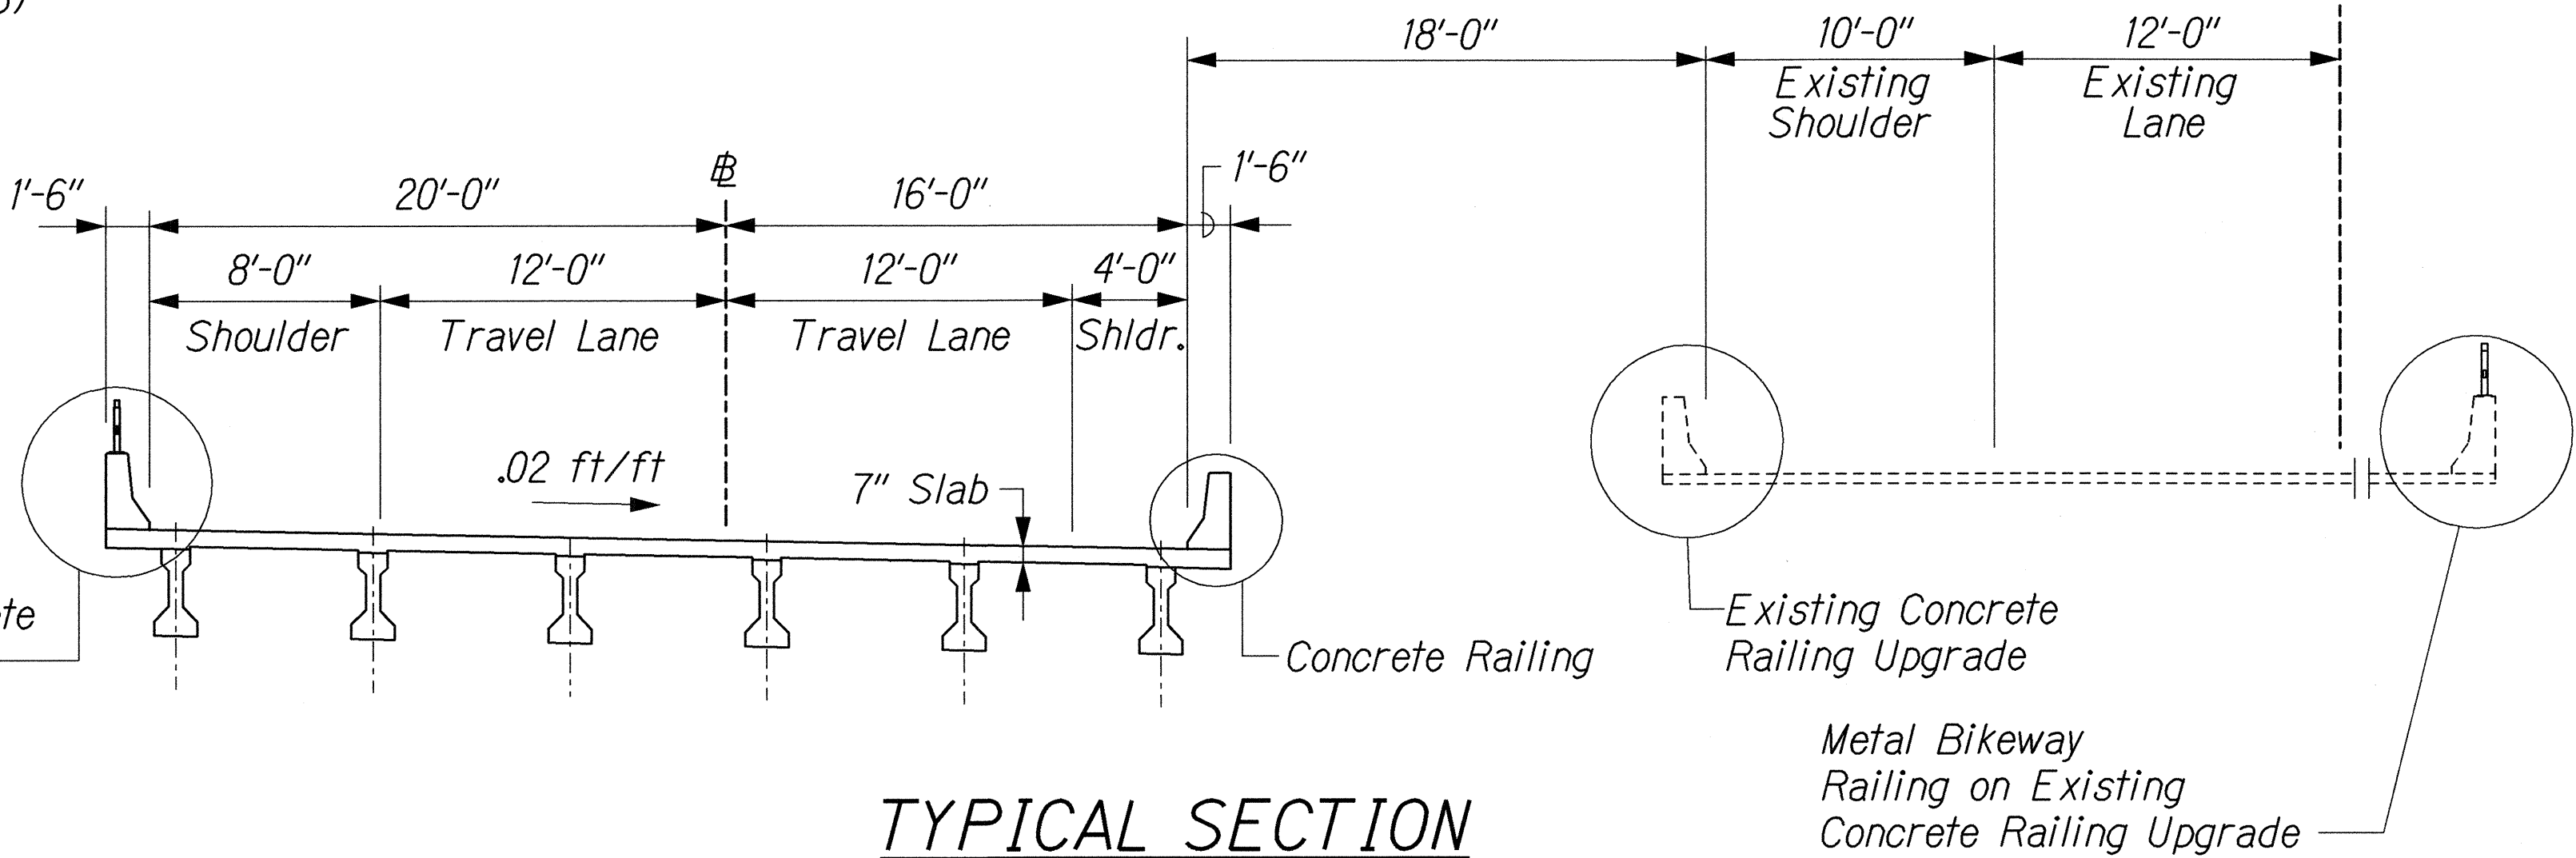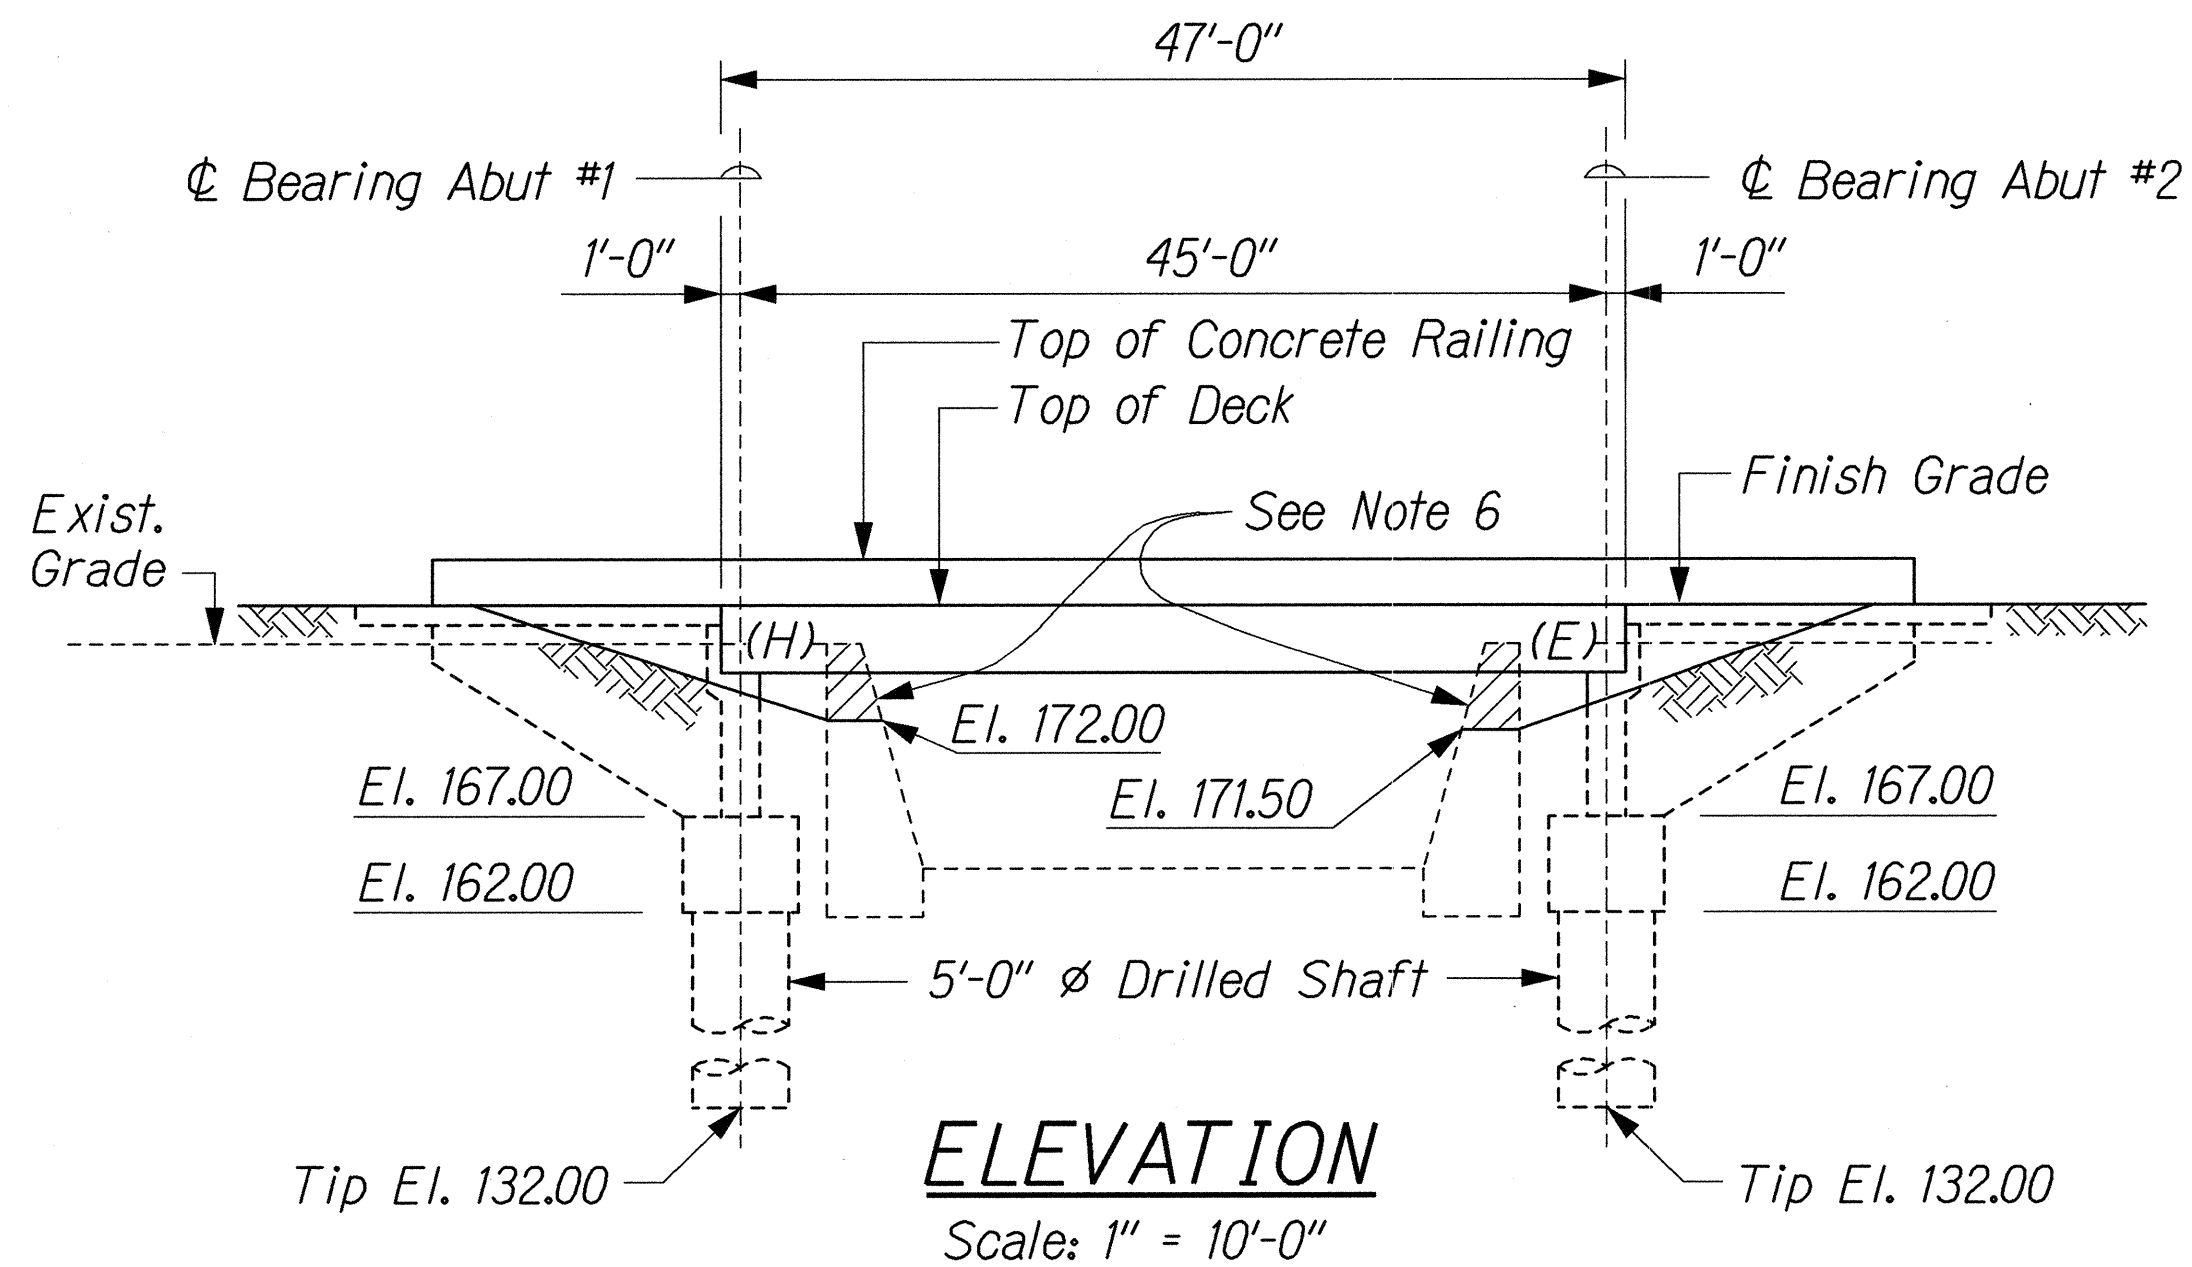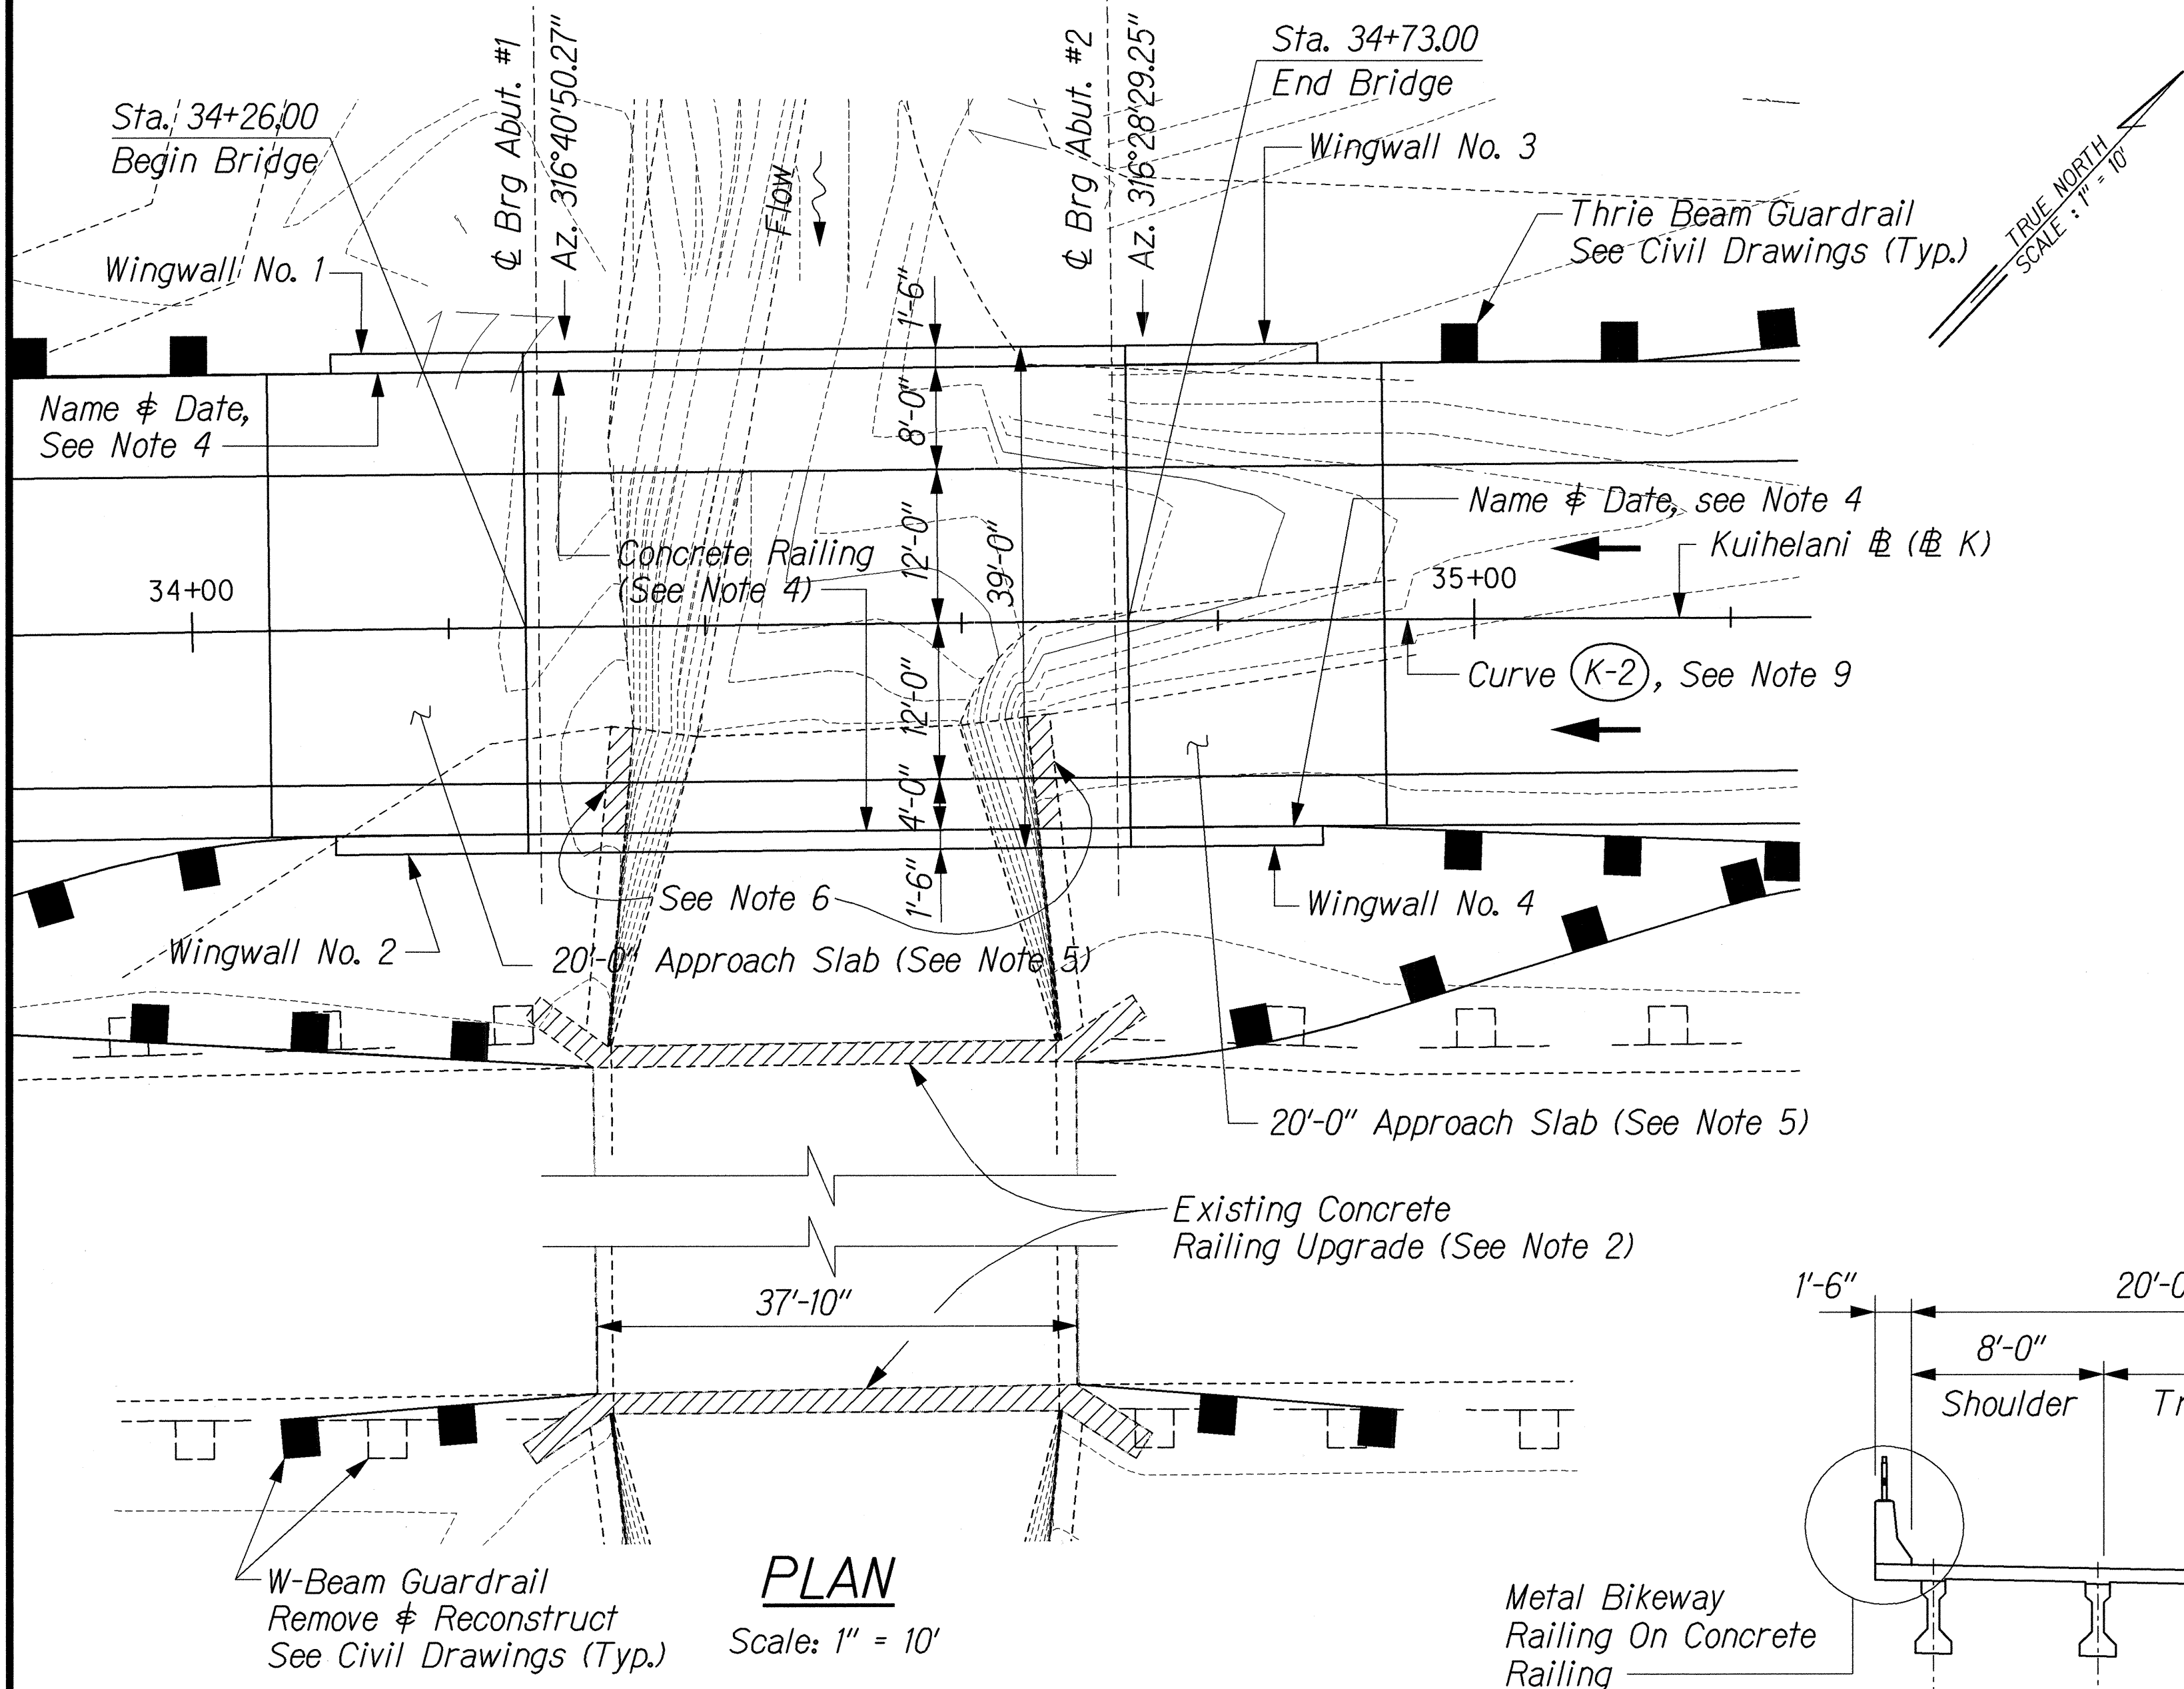

NOTES:

- For General Notes, see Sht. No. S-2.
- For Existing Concrete Railing Upgrade Details, See Sht. No. S-33.
- For Drilled Shaft details and Cutoff Elevation, See Sht. No. S-31.
- For Bridge Name & Date location, Concrete railing Details, See Sht. No. S-32.
- For Approach Slab Details, See Sheet No. S-35.
- Portion of existing CRM wall shall be removed to the elevations as shown. The removal of existing CRM wall shall be incidental to structural excavation.
- For Metal Bikeway Railing Details, See Sheet No. S-34.
- For Payment Limit, See Sheet No. S-30.
- For curve data for Curve (K-2), See Alignment Plan Sheet No. A4.
- For grading around abutments & wingwalls, See Civil Plans.

ESTIMATED QUANTITIES

ITEM NO.	ITEM	UNIT	QUANTITIES
206.	Structure Excavation For Abutments & Walls	CY	407
206.	Structure Backfill For Abutments & Walls	CY	128
646.	Geocomposite Drain For Abutments & Walls	SY	62
503.	Concrete In Bridge (Except Footing)	LS	(116 CY)
503.	Concrete In Bridge Footing	LS	(96 CY)
503.	Concrete in Approach Slab	LS	(54 CY)
504.	AASHTO Type II Prestressed Concrete Beam	LF	281
507.	Concrete Railing (Include End Post)	LF	154
507.	Metal Bikeway Railing	LF	115
507.	Upgrade of Existing Concrete Railing	LF	76
511.	Drilled Shafts	LF	248
511.	Load Test For Drilled Shafts	EA	1
602.	Reinforcing Steel For Bridge	LS	(48,340 Lbs)

DATE	_____
SURVEY PLOTTED BY	_____
DRAWN BY	_____
DESIGNED BY	_____
CHECKED BY	_____
NOTE BOOK	_____
NO.	_____

36/KUIHELANI/STRUCT/BR-01dgn

THIS WORK WAS PREPARED BY ME OR UNDER MY SUPERVISION.


Hui Pang Chen

STATE OF HAWAII
DEPARTMENT OF TRANSPORTATION
HIGHWAYS DIVISION


PALEAAHU STREAM BRIDGE
PLAN, ELEVATION AND SECTION
KUIHELANI HIGHWAY WIDENING
HONOAPIILANI HIGHWAY TO PUUNENE AVENUE
FEDERAL-AID PROJECT NO. NH-0380(9)
Scale: As Shown Date: Sept. 14, 2001

SHEET No. S-3 OF 54 SHEETS

FED. ROAD DIST. NO.	STATE	FED. AID PROJ. NO.	FISCAL YEAR	SHEET NO.	TOTAL SHEETS
HAWAII	HAW.	NH-0380(9)	2000	166	380

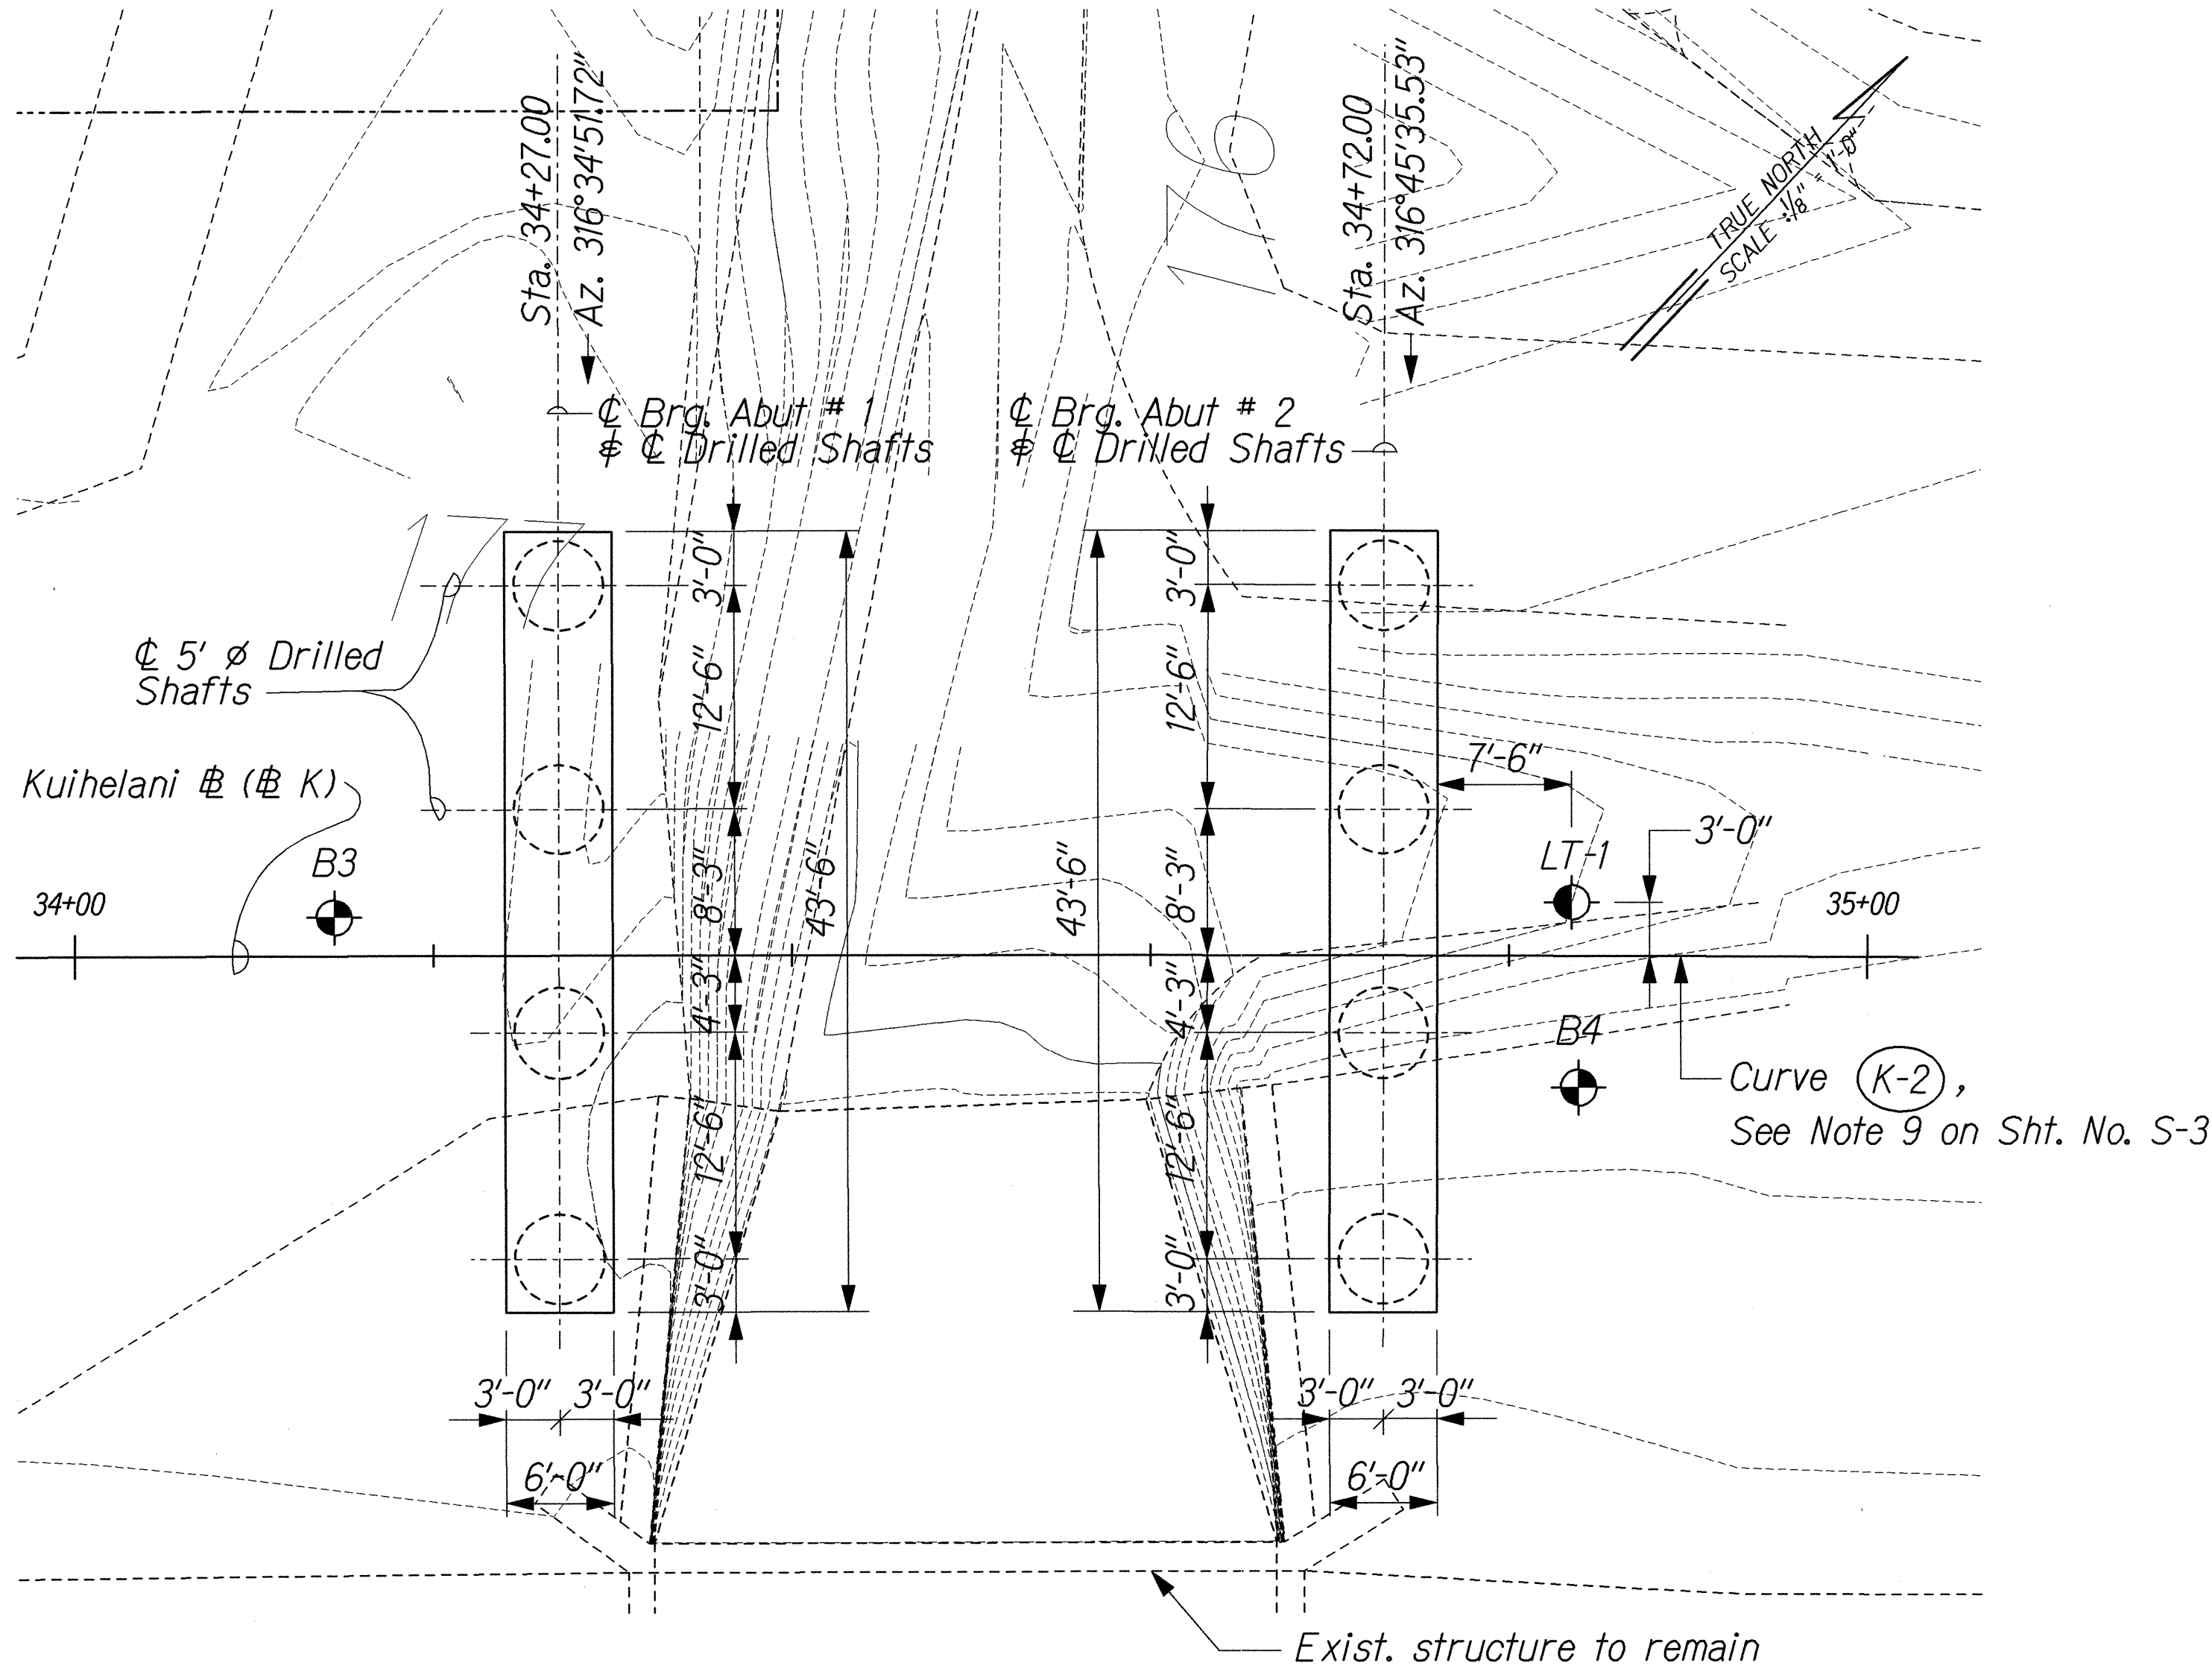

FOUNDATION PLAN
Scale: 1/8" = 1'-0"

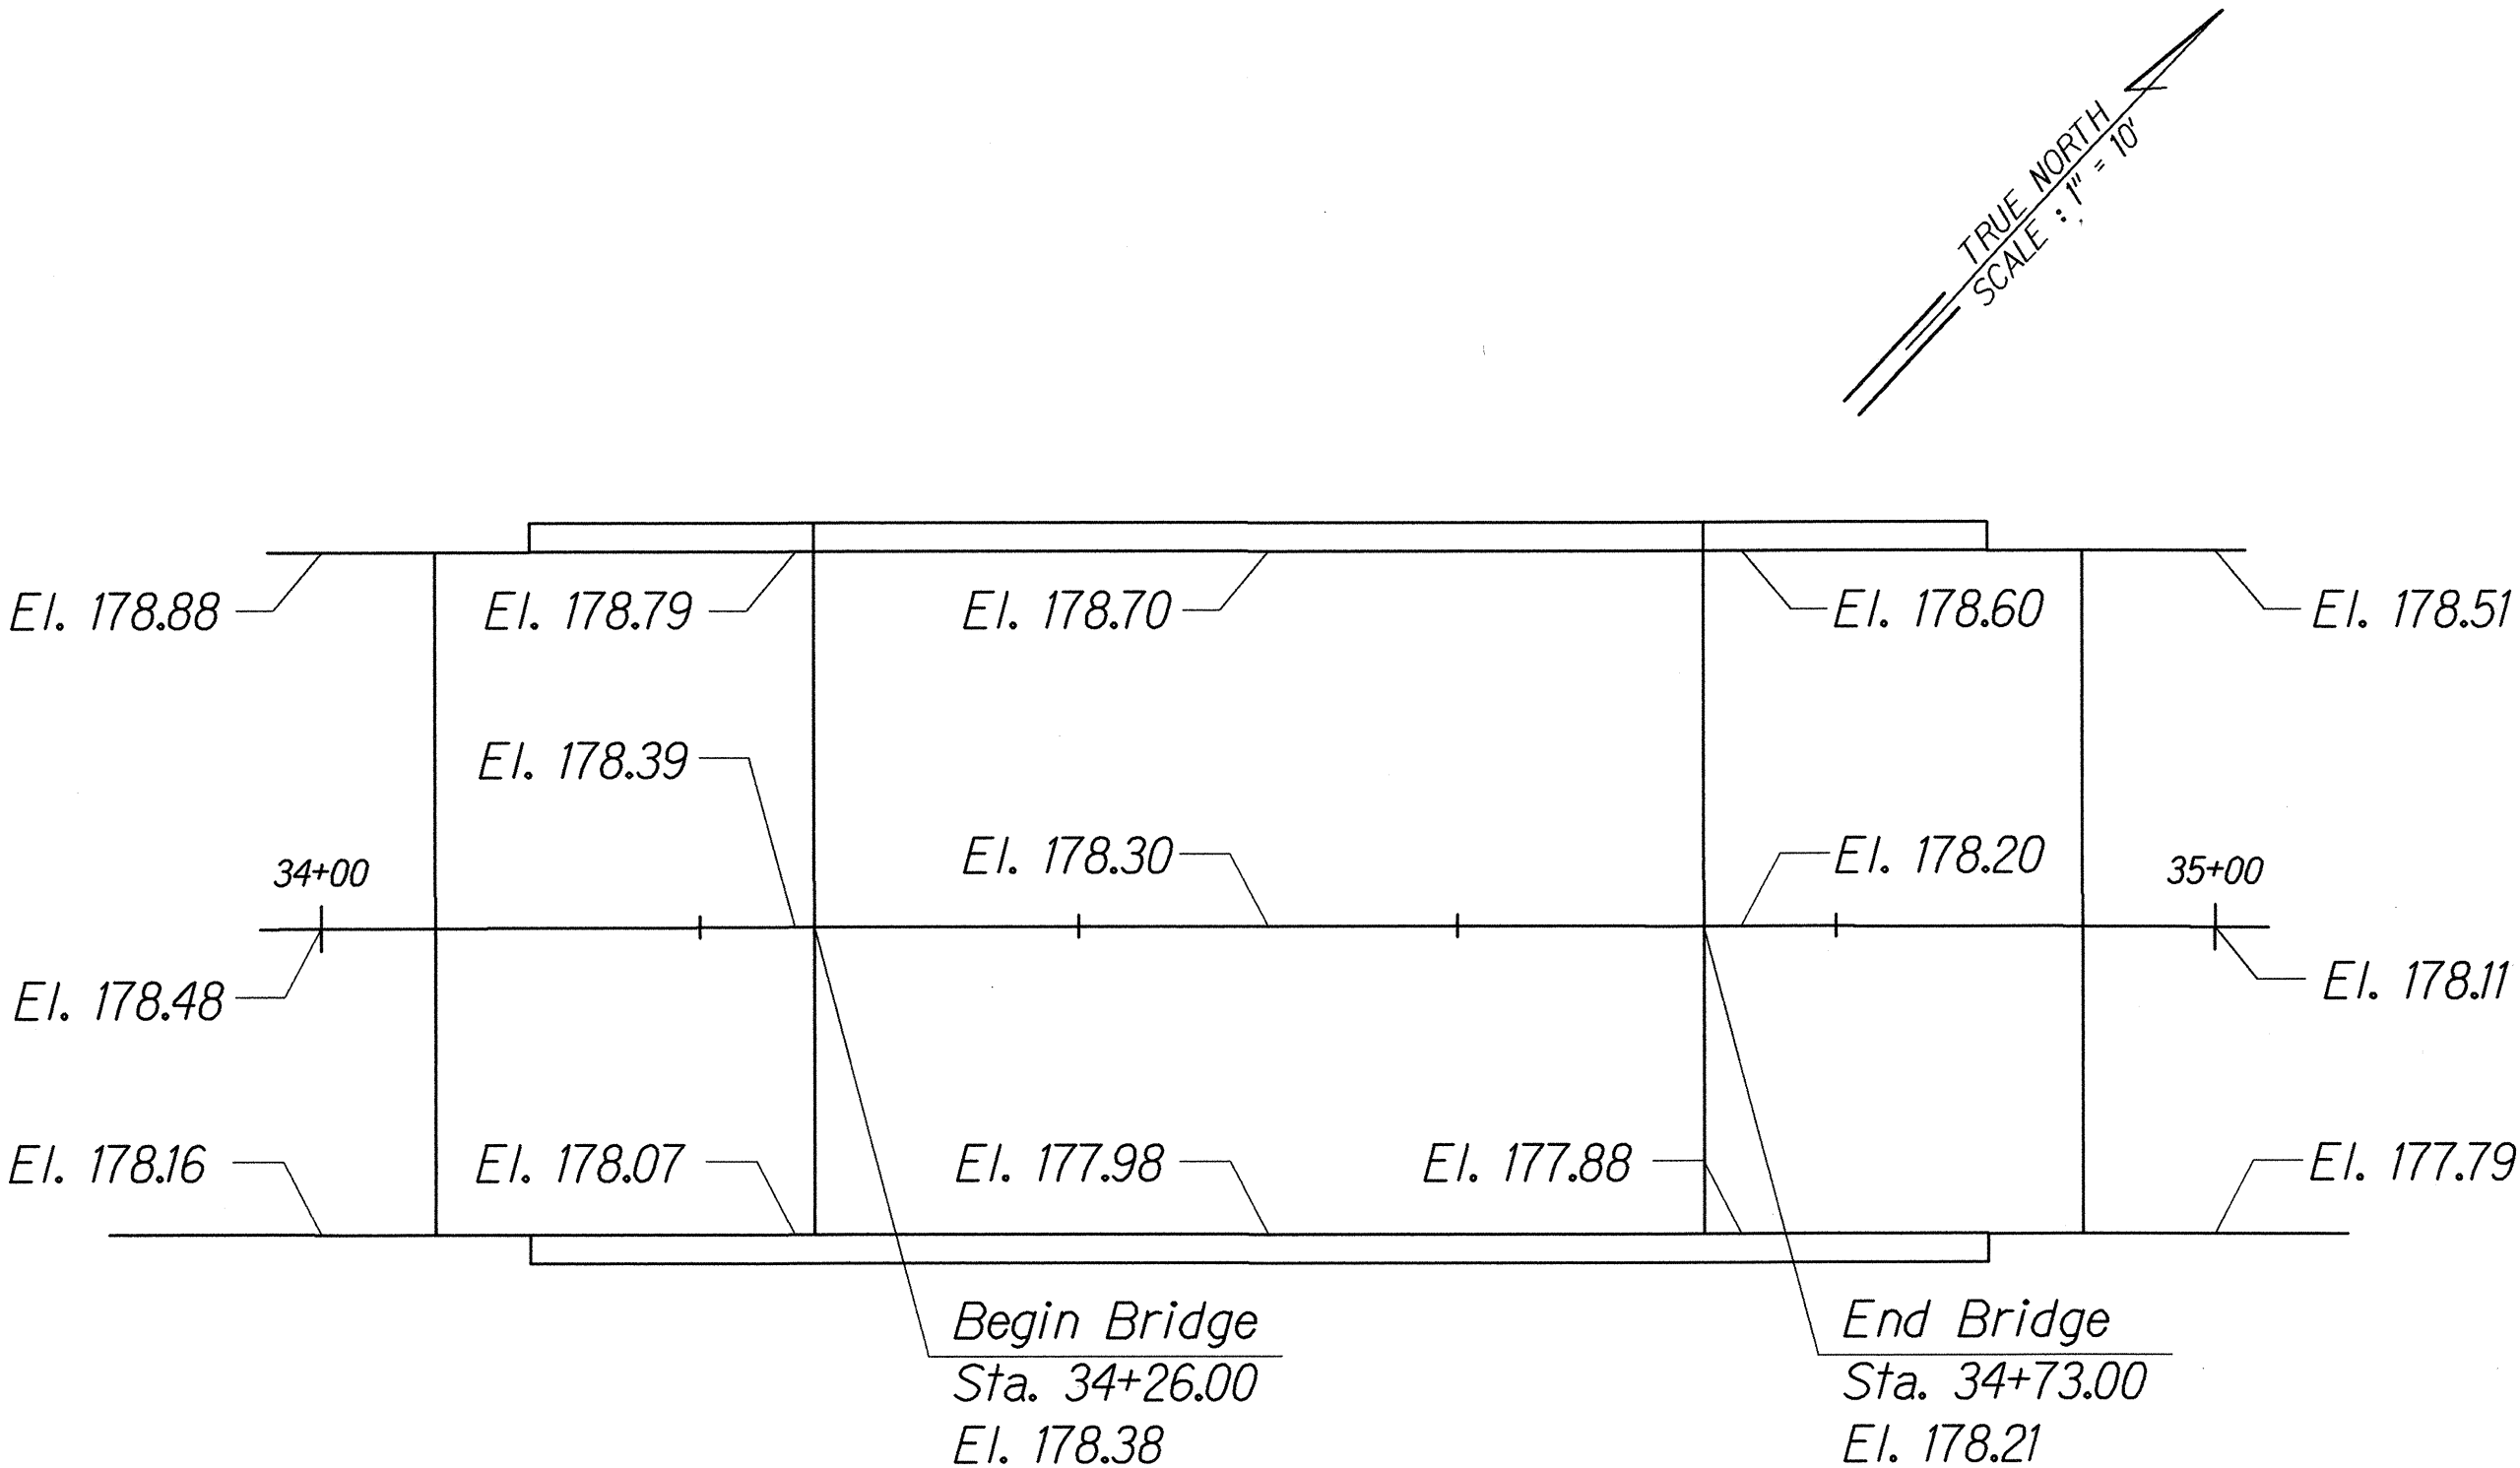

FINISH SPOT ELEVATIONS (@ 25'-0" INTERVALS)
Scale: 1" = 10'-0"

LEGEND:

- B4 Denotes Locations of Borings
- LT-1 Denotes Location of Trial and Load Test Shaft

NOTES:

- For Boring Logs, See Sht. Nos. B1 to B12.
- For Drilled Shaft Tip Elevations, See Sht. No. S-3.
- For Drilled Shaft Details and Drilled Shaft Cutoff Elevations, See Sht. No. S-31.

ORIGINAL PLAN	SURVEY PLOTTED BY	DATE
NOTE BOOK	DRAWN BY	
	DESIGNED BY	
	CHECKED BY	

U:\KUIHELANI\STRUCT\ST-DET4dgn


THIS WORK WAS PREPARED BY ME OR UNDER MY SUPERVISION.

Hui Pang Chen


STATE OF HAWAII
DEPARTMENT OF TRANSPORTATION
HIGHWAYS DIVISION

PALEAAHU STREAM BRIDGE
FOUNDATION PLAN & SPOT ELEVS.
KUIHELANI HIGHWAY WIDENING
HONOAPIILANI HIGHWAY TO PUUNENE AVENUE
FEDERAL-AID PROJECT NO. NH-0380(9)
Scale: 1/8" = 1'-0" Date: Sept. 14, 2001

FED. ROAD DIST. NO.	STATE	FED. AID PROJ. NO.	FISCAL YEAR	SHEET NO.	TOTAL SHEETS
HAWAII	HAW.	NH-0380(9)	2000	167	380

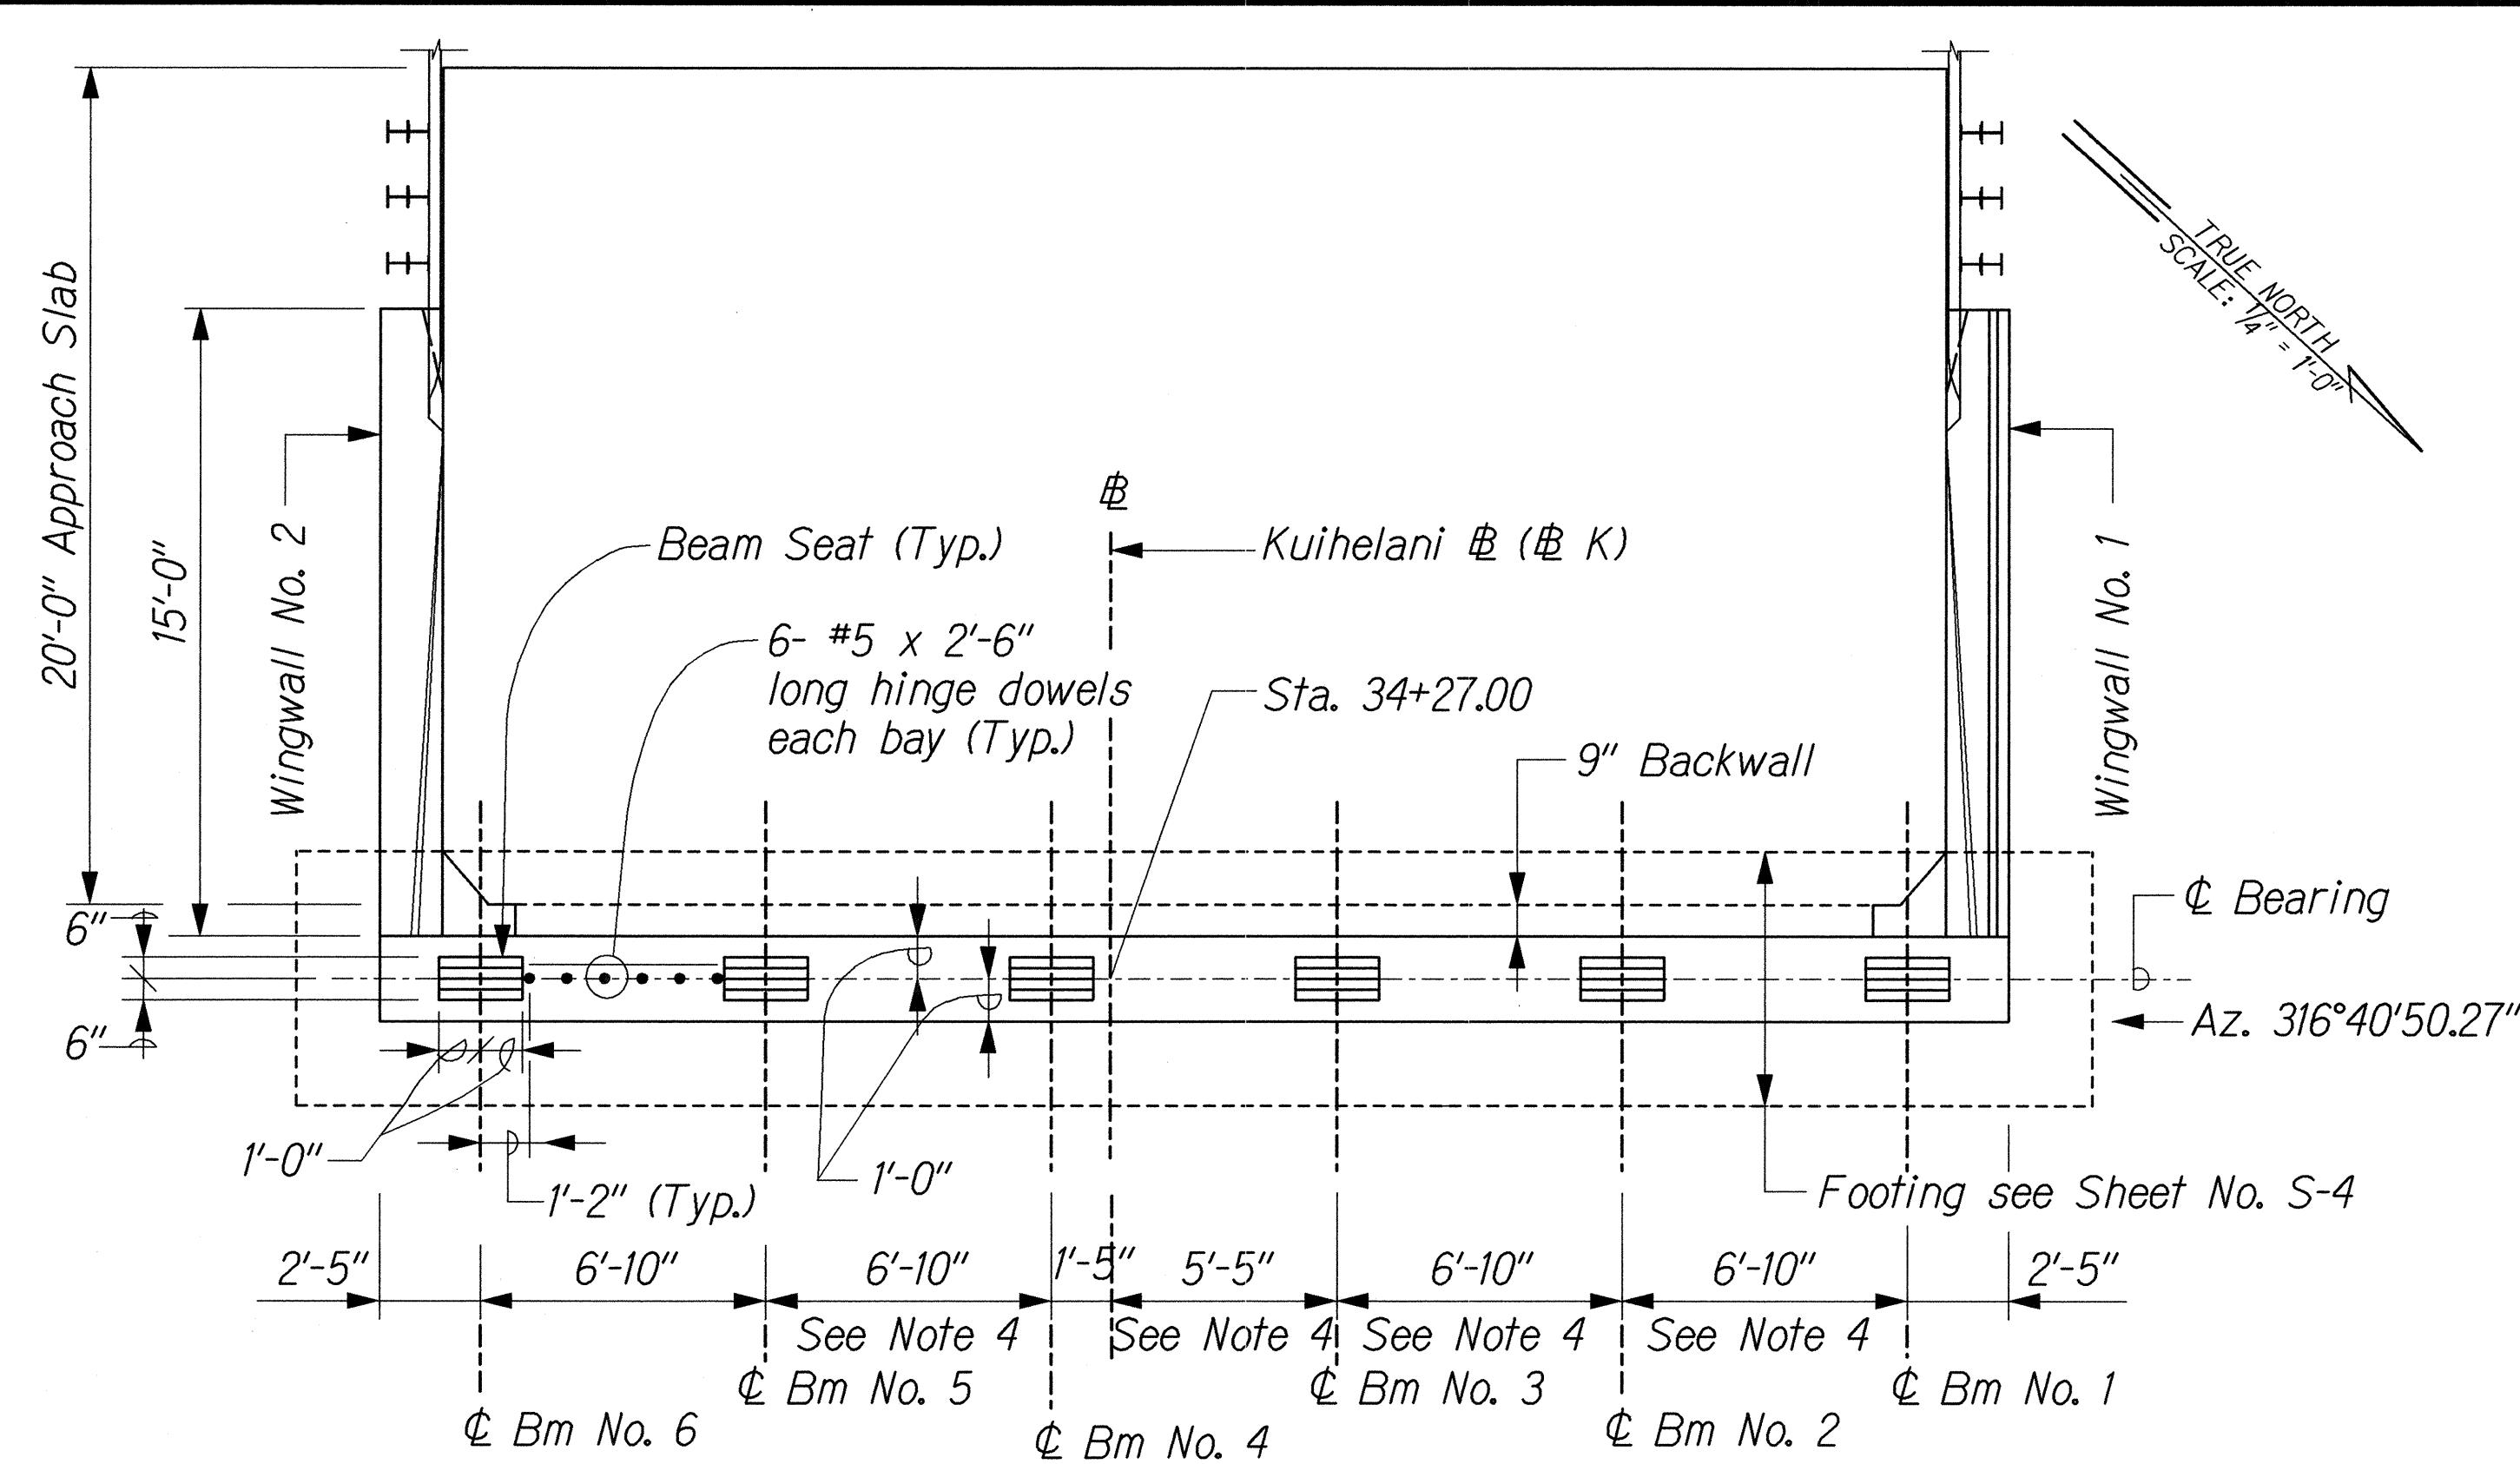


ABUTMENT NO. 1 PLAN

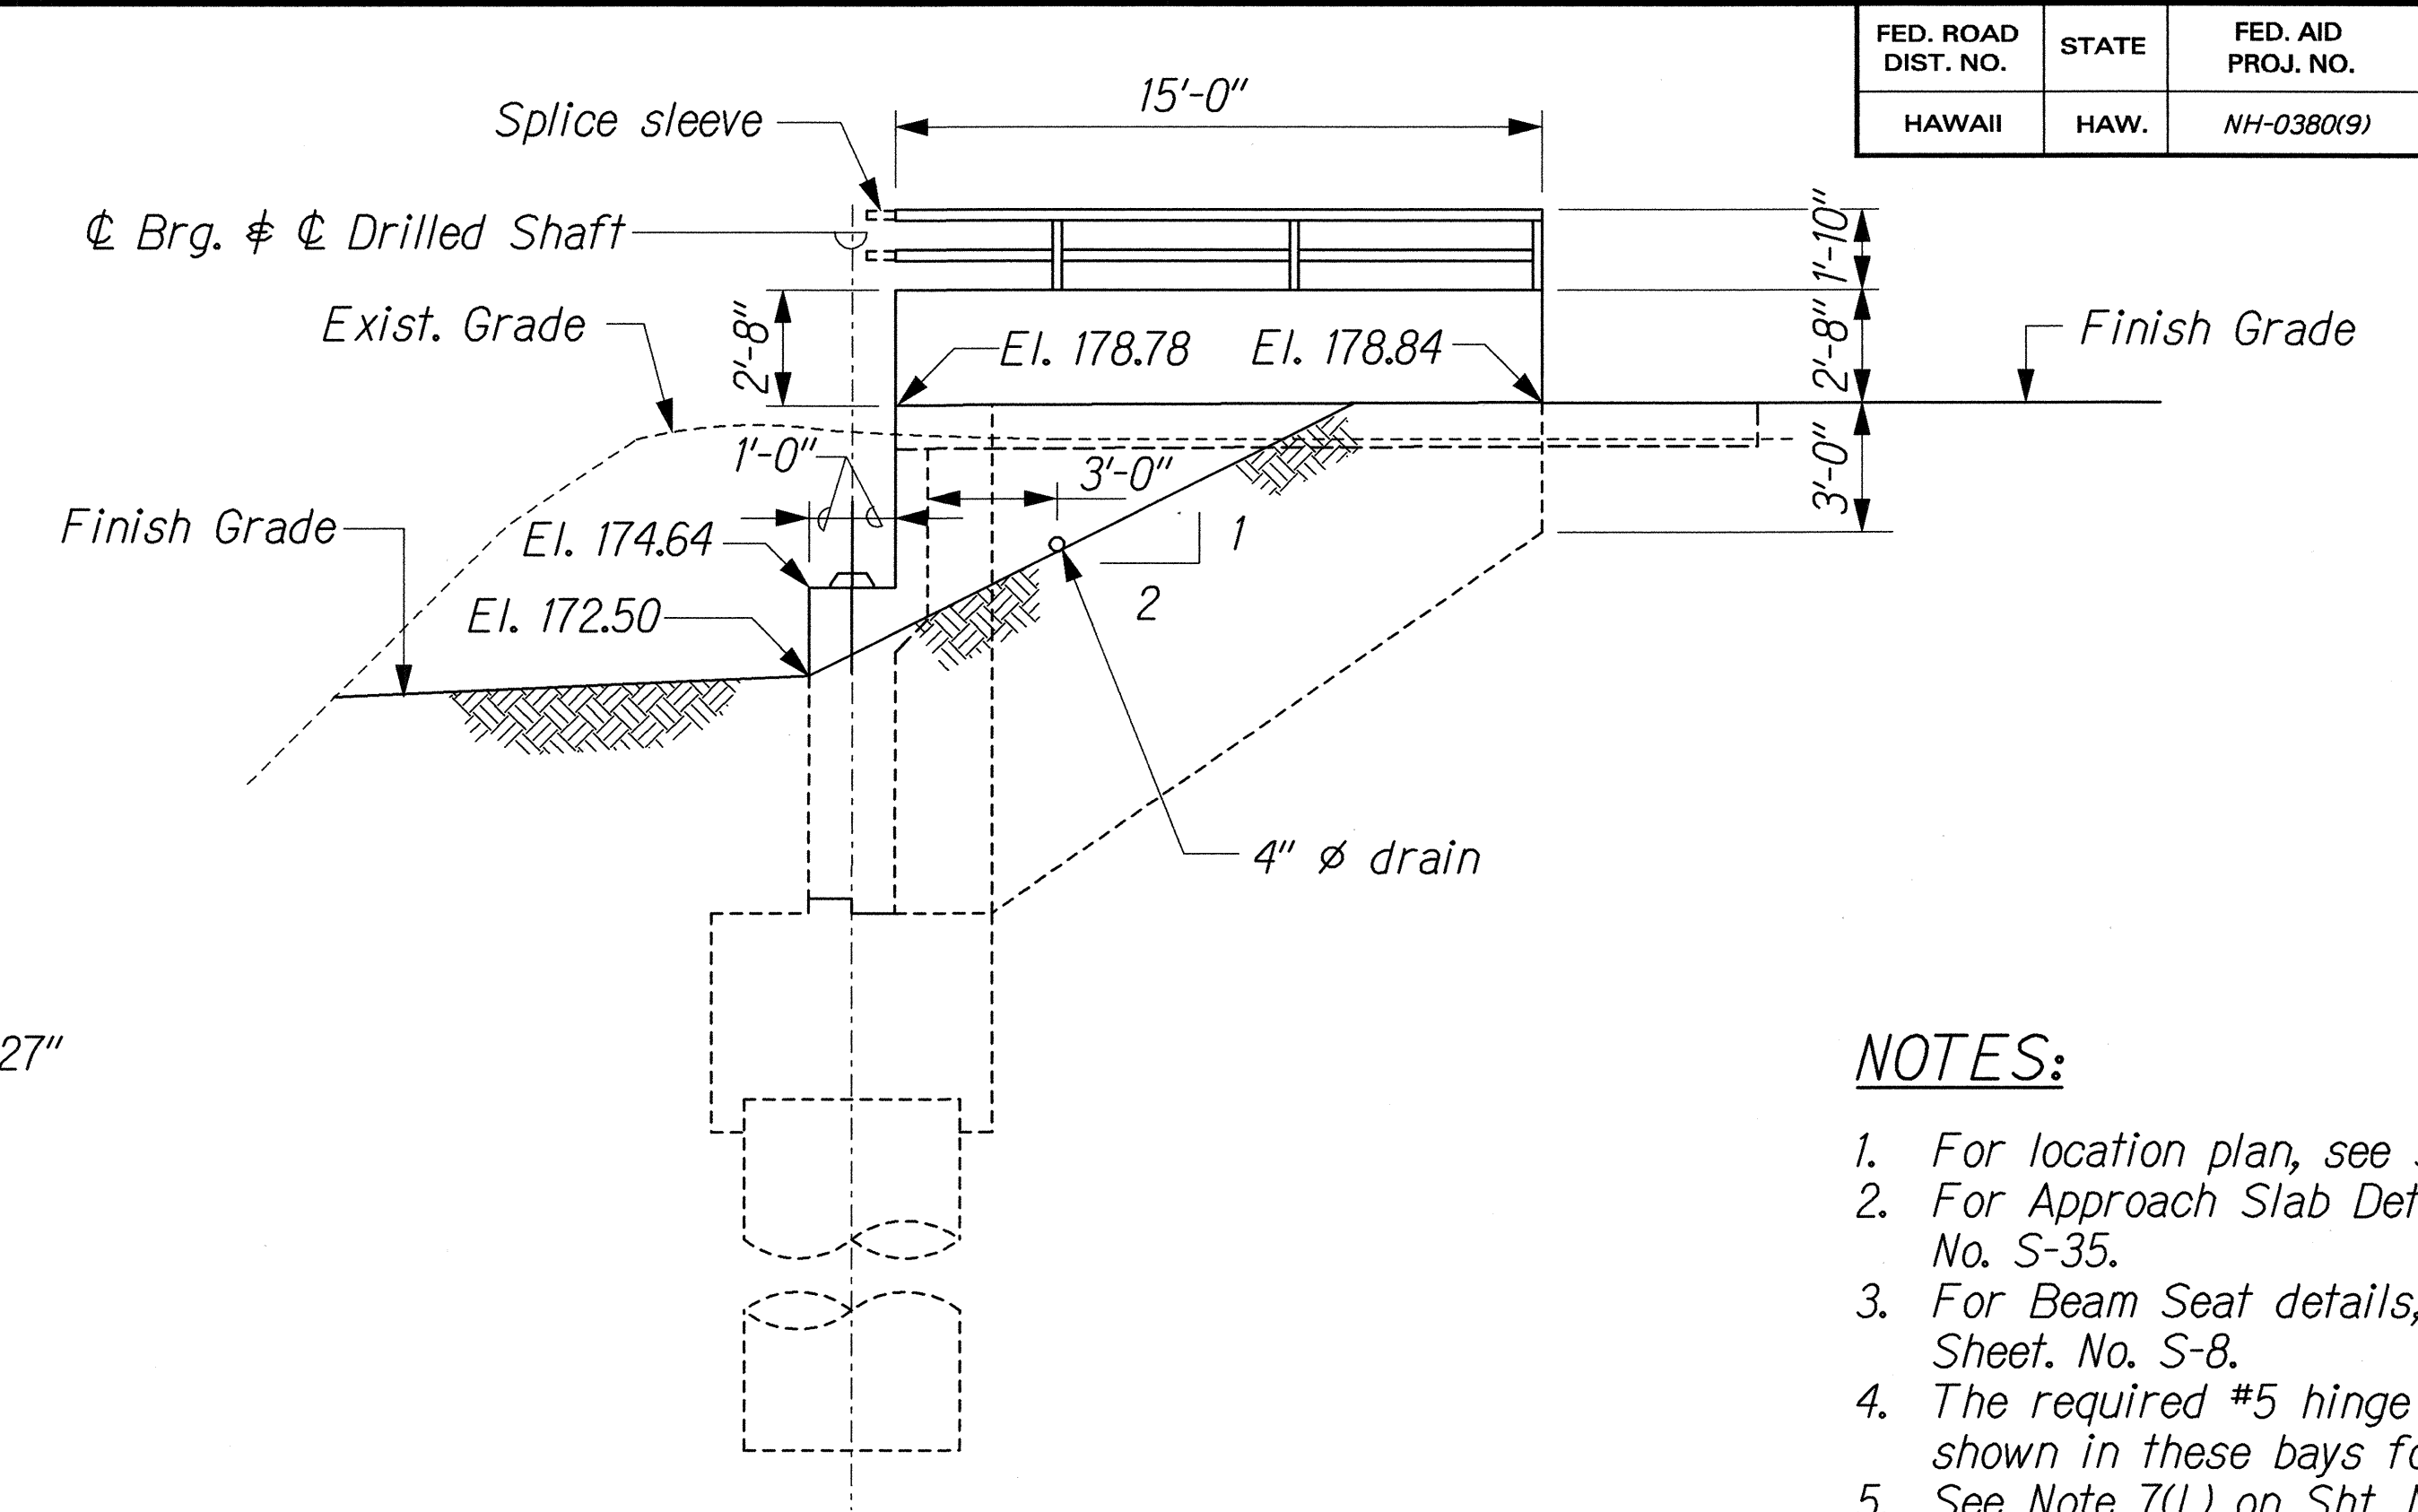


WINGWALL NO. 1 ELEVATION

- NOTES:
1. For location plan, see Sheet No. S-3.
 2. For Approach Slab Details, see Sheet No. S-35.
 3. For Beam Seat details, see Sheet No. S-8.
 4. The required #5 hinge dowels not shown in these bays for clarity.
 5. See Note 7(L) on Sht. No. S-2.

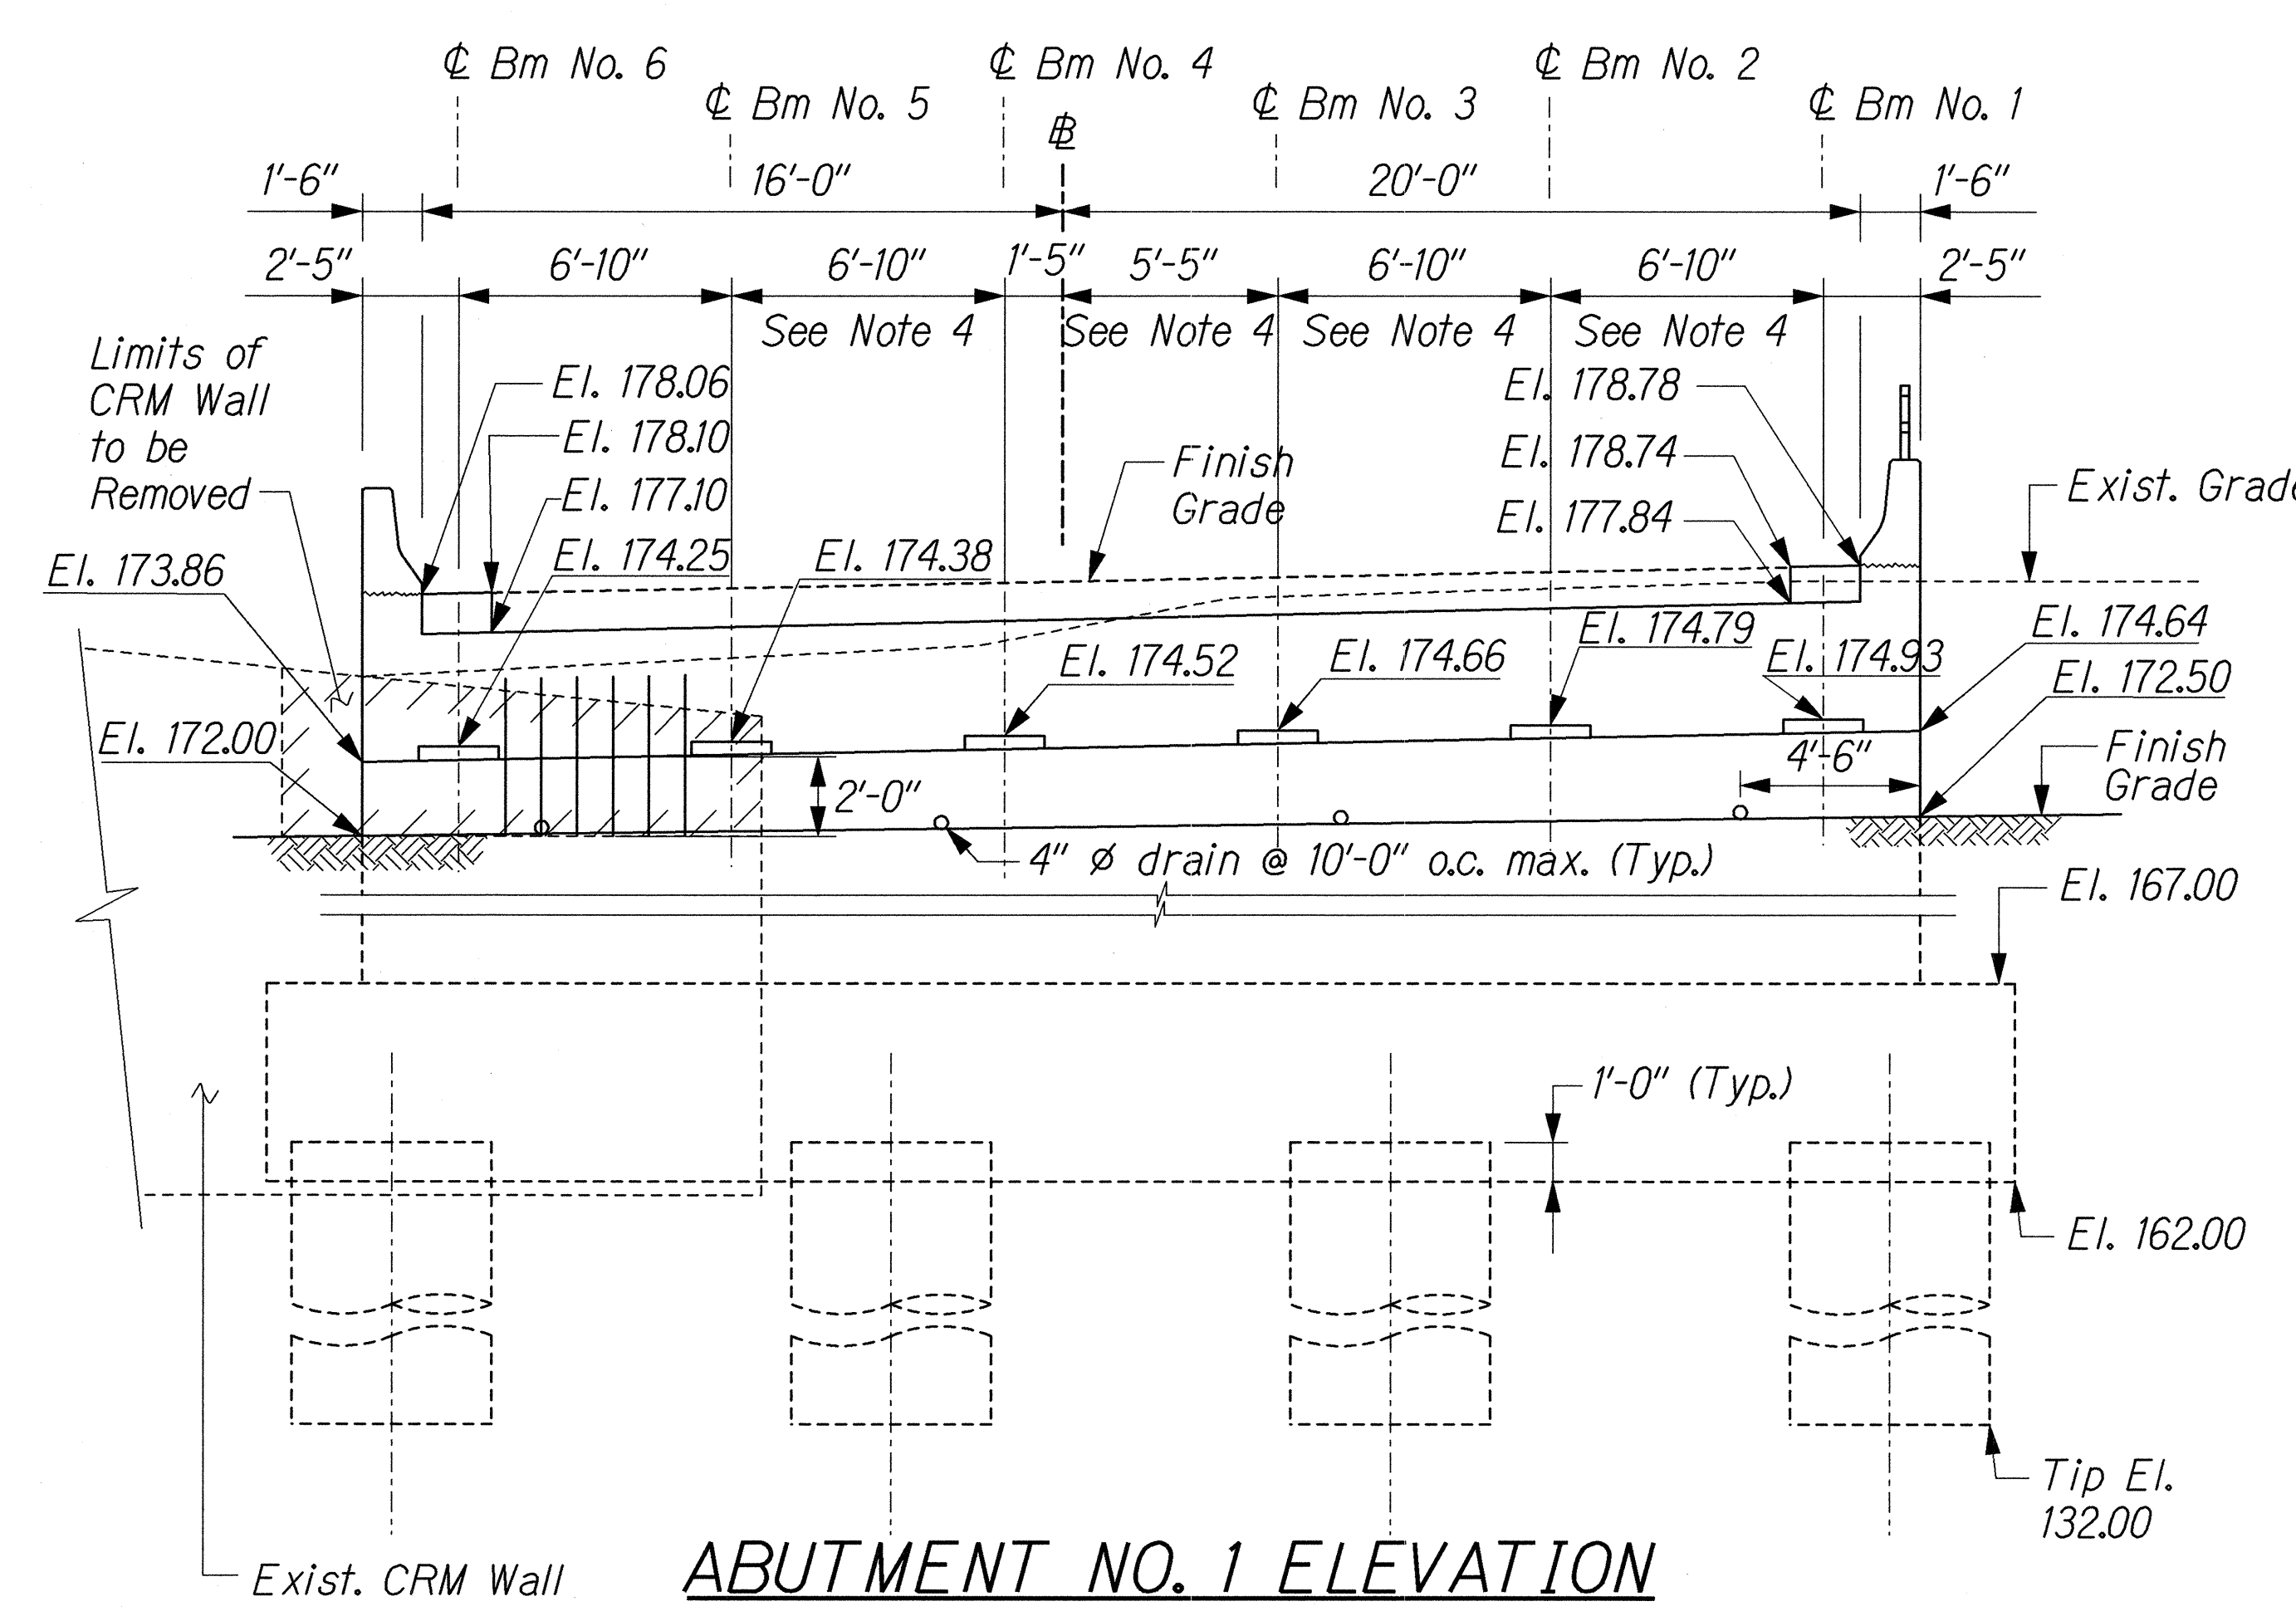

ABUTMENT NO. 1 ELEVATION

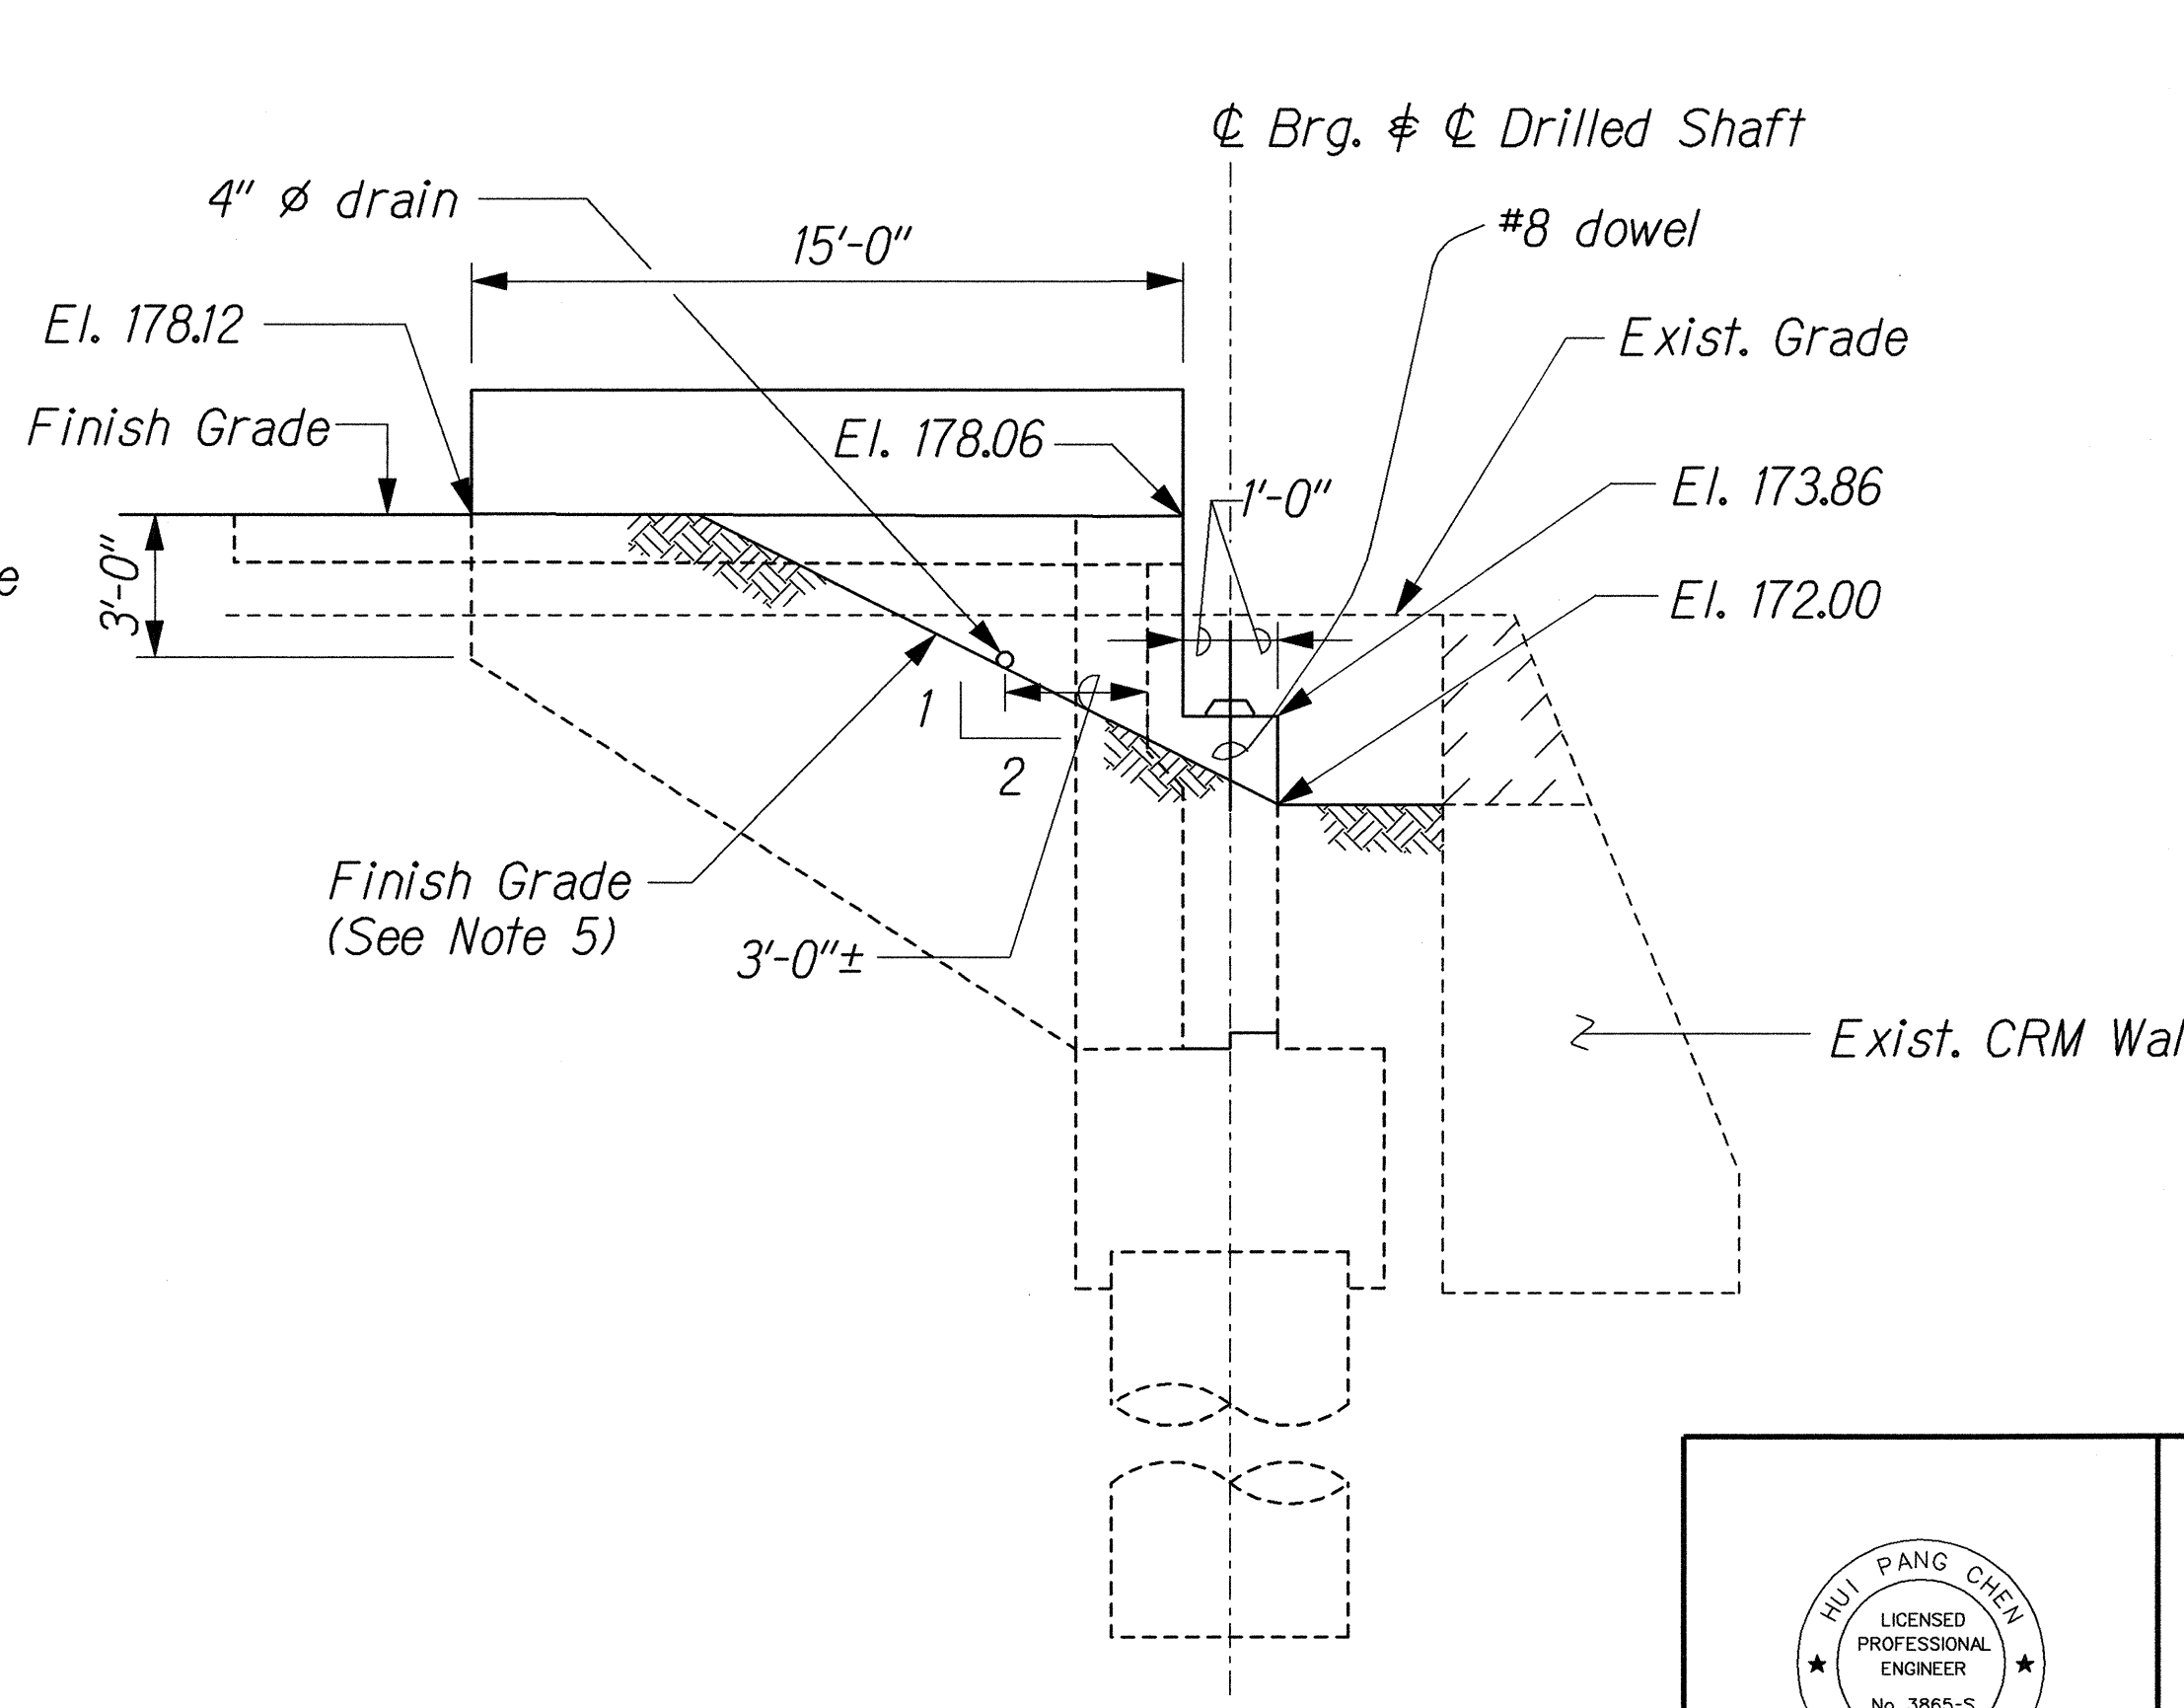

WINGWALL NO. 2 ELEVATION

DATE	_____
SURVEY PLOTTED BY	_____
DRAWN BY	_____
CHECKED BY	_____
NOTE BOOK	_____
BY	_____

66/KUIHELANI/STRUCT/ST-DET9B.dgn

THIS WORK WAS PREPARED BY ME OR UNDER MY SUPERVISION.

Hui Pang Chen

STATE OF HAWAII
DEPARTMENT OF TRANSPORTATION
HIGHWAYS DIVISION

PALEAAHU STREAM BRIDGE

ABUTMENT SHEET 1 OF 4

KUIHELANI HIGHWAY WIDENING


HONOAPIILANI HIGHWAY TO PUUNENE AVENUE

FEDERAL-AID PROJECT NO. NH-0380(9)


Scale: 1/4" = 1'-0" Date: Sept. 14, 2001

SHEET No. S-5 OF 54 SHEETS


FED. ROAD DIST. NO.	STATE	FED. AID PROJ. NO.	FISCAL YEAR	SHEET NO.	TOTAL SHEETS
HAWAII	HAW.	NH-0380(9)	2000	168	380

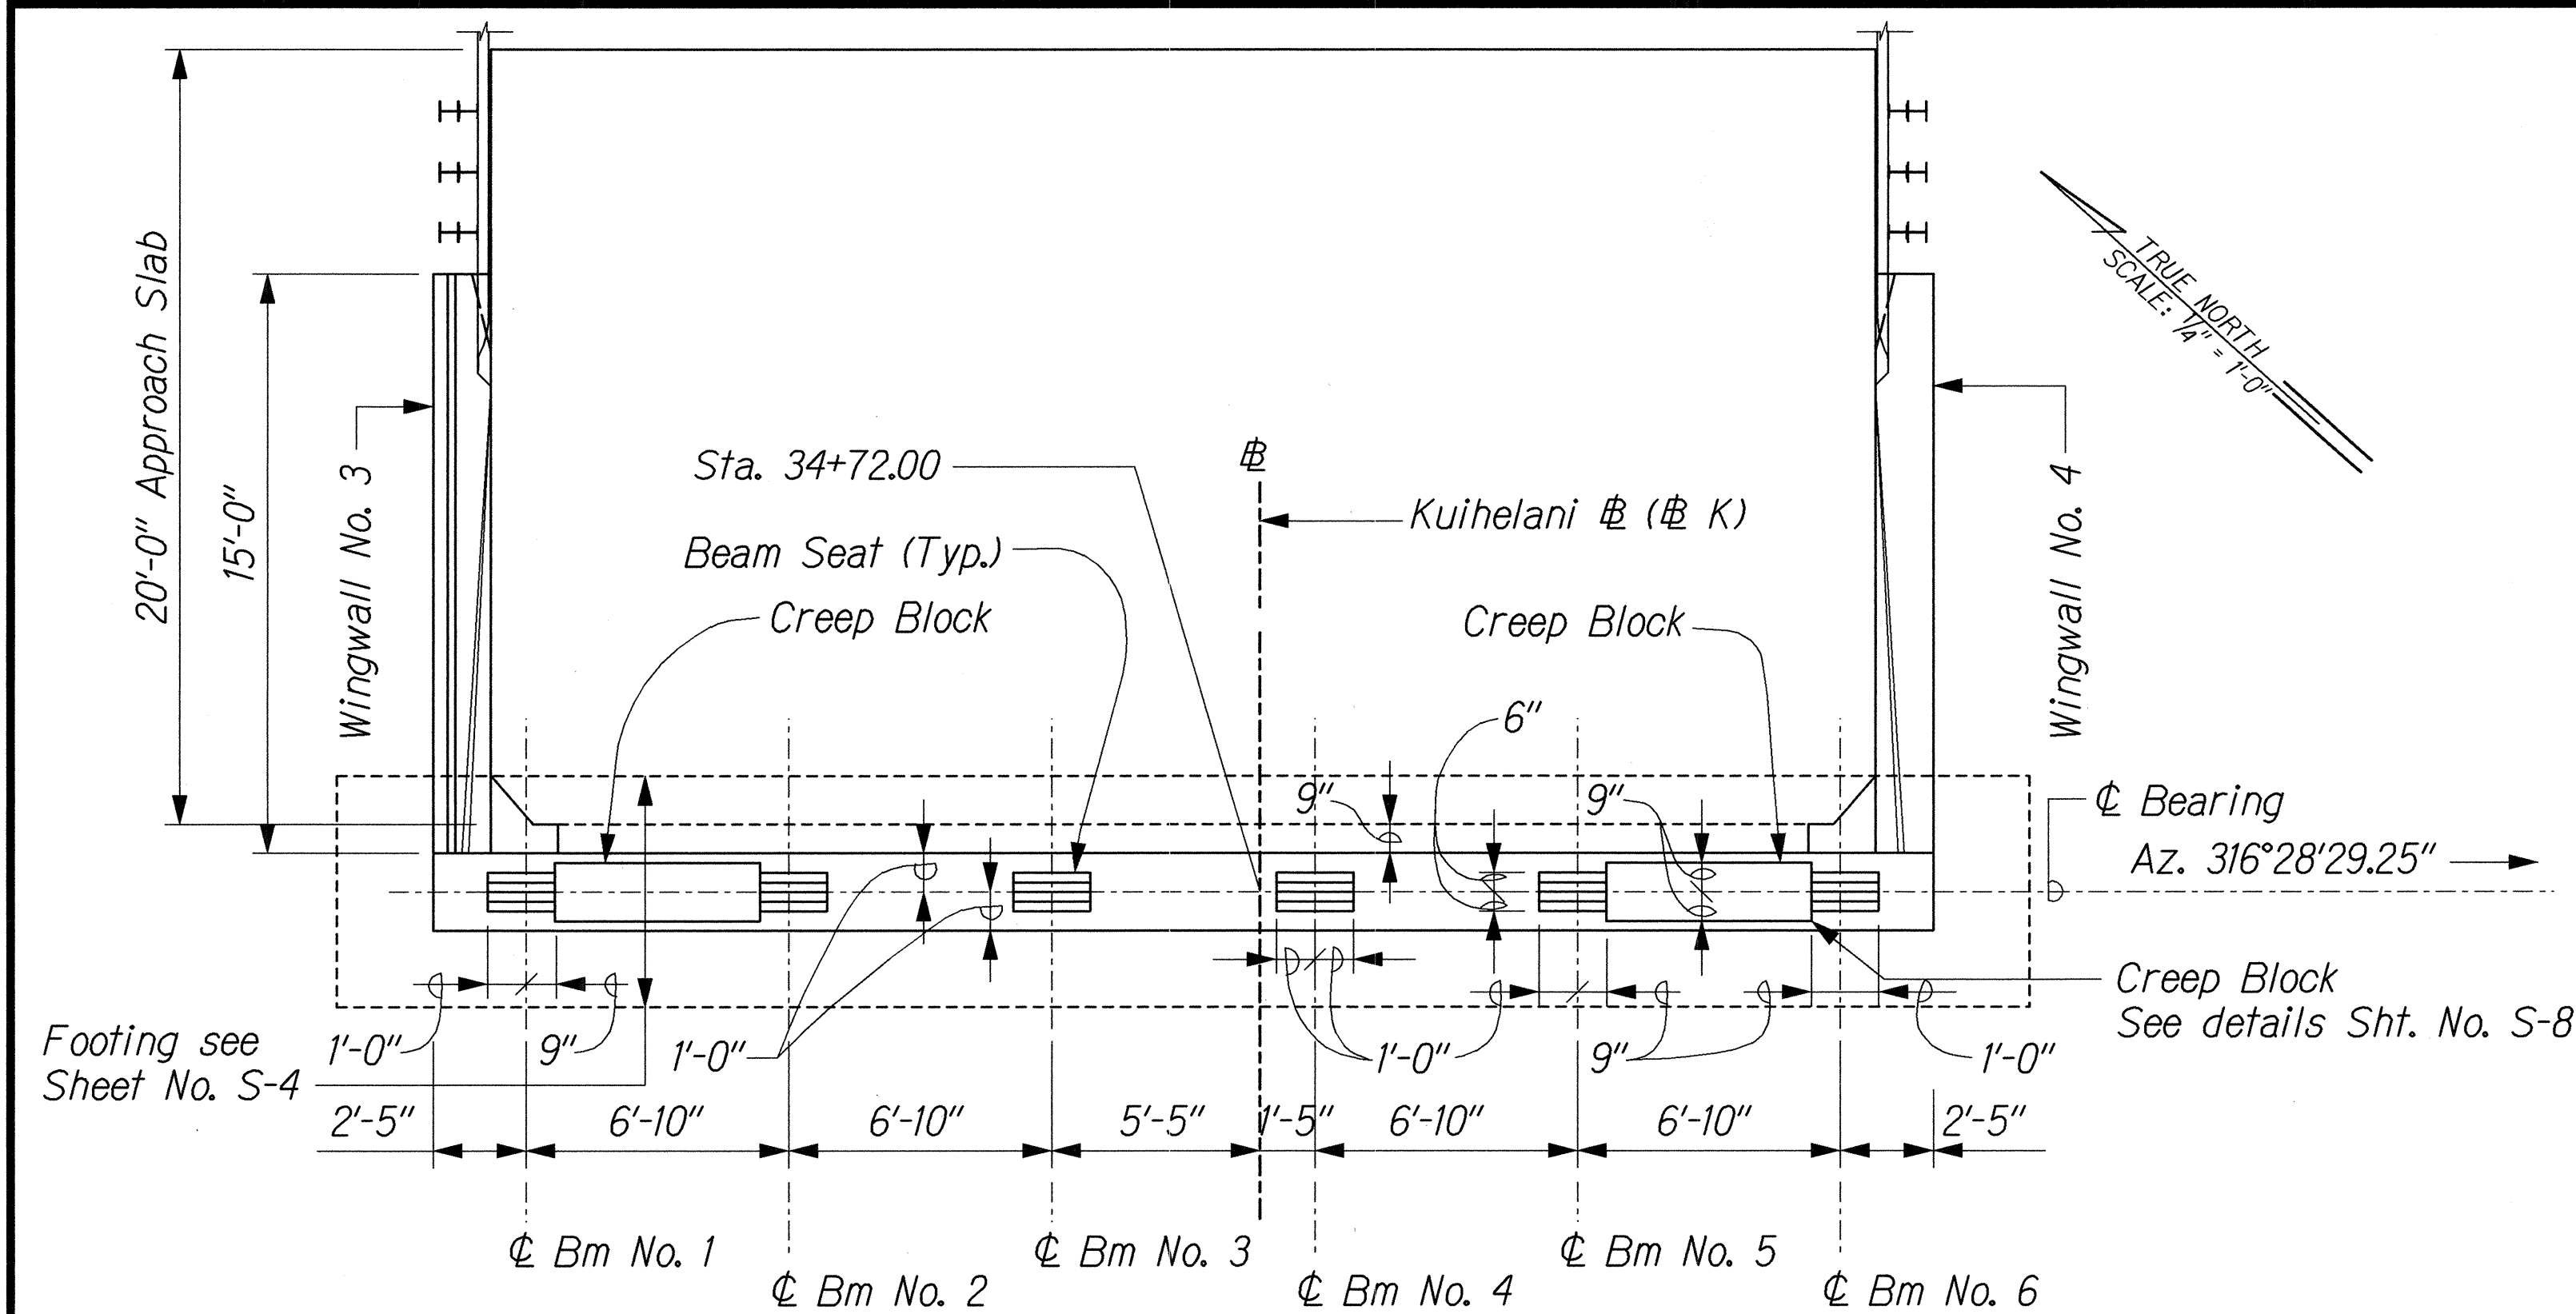


ABUTMENT NO. 2 PLAN

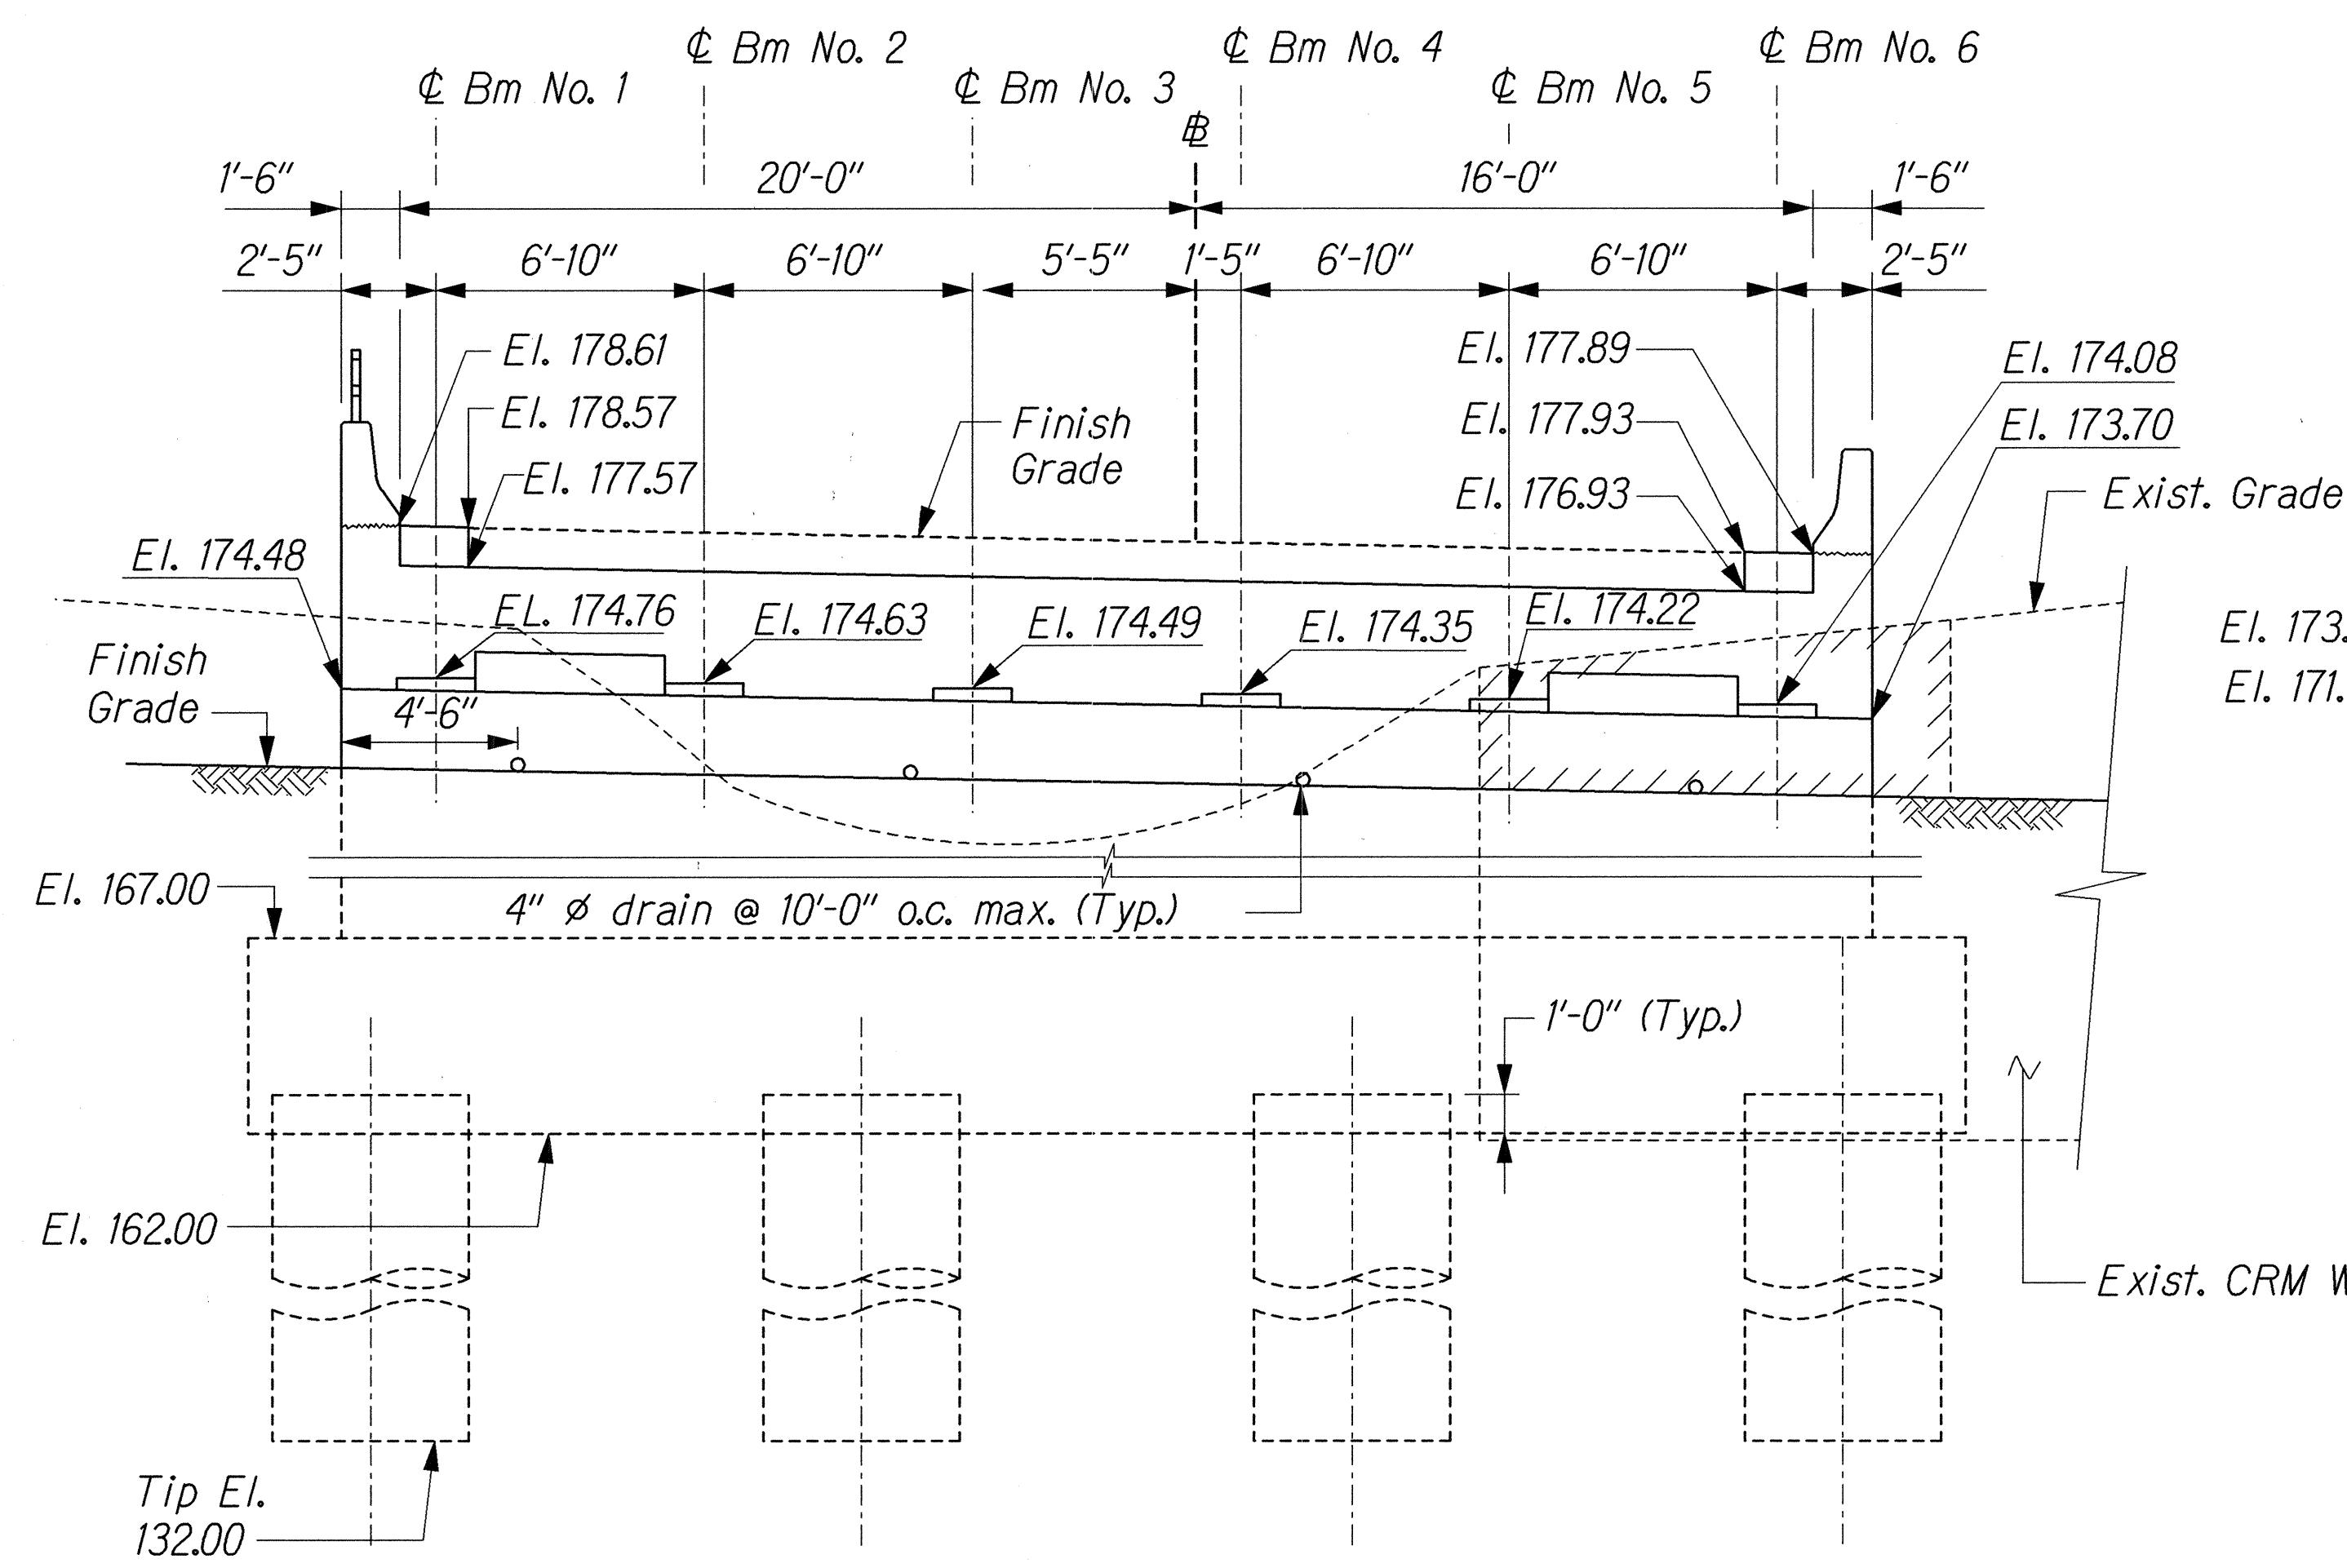

ABUTMENT NO. 2 ELEVATION

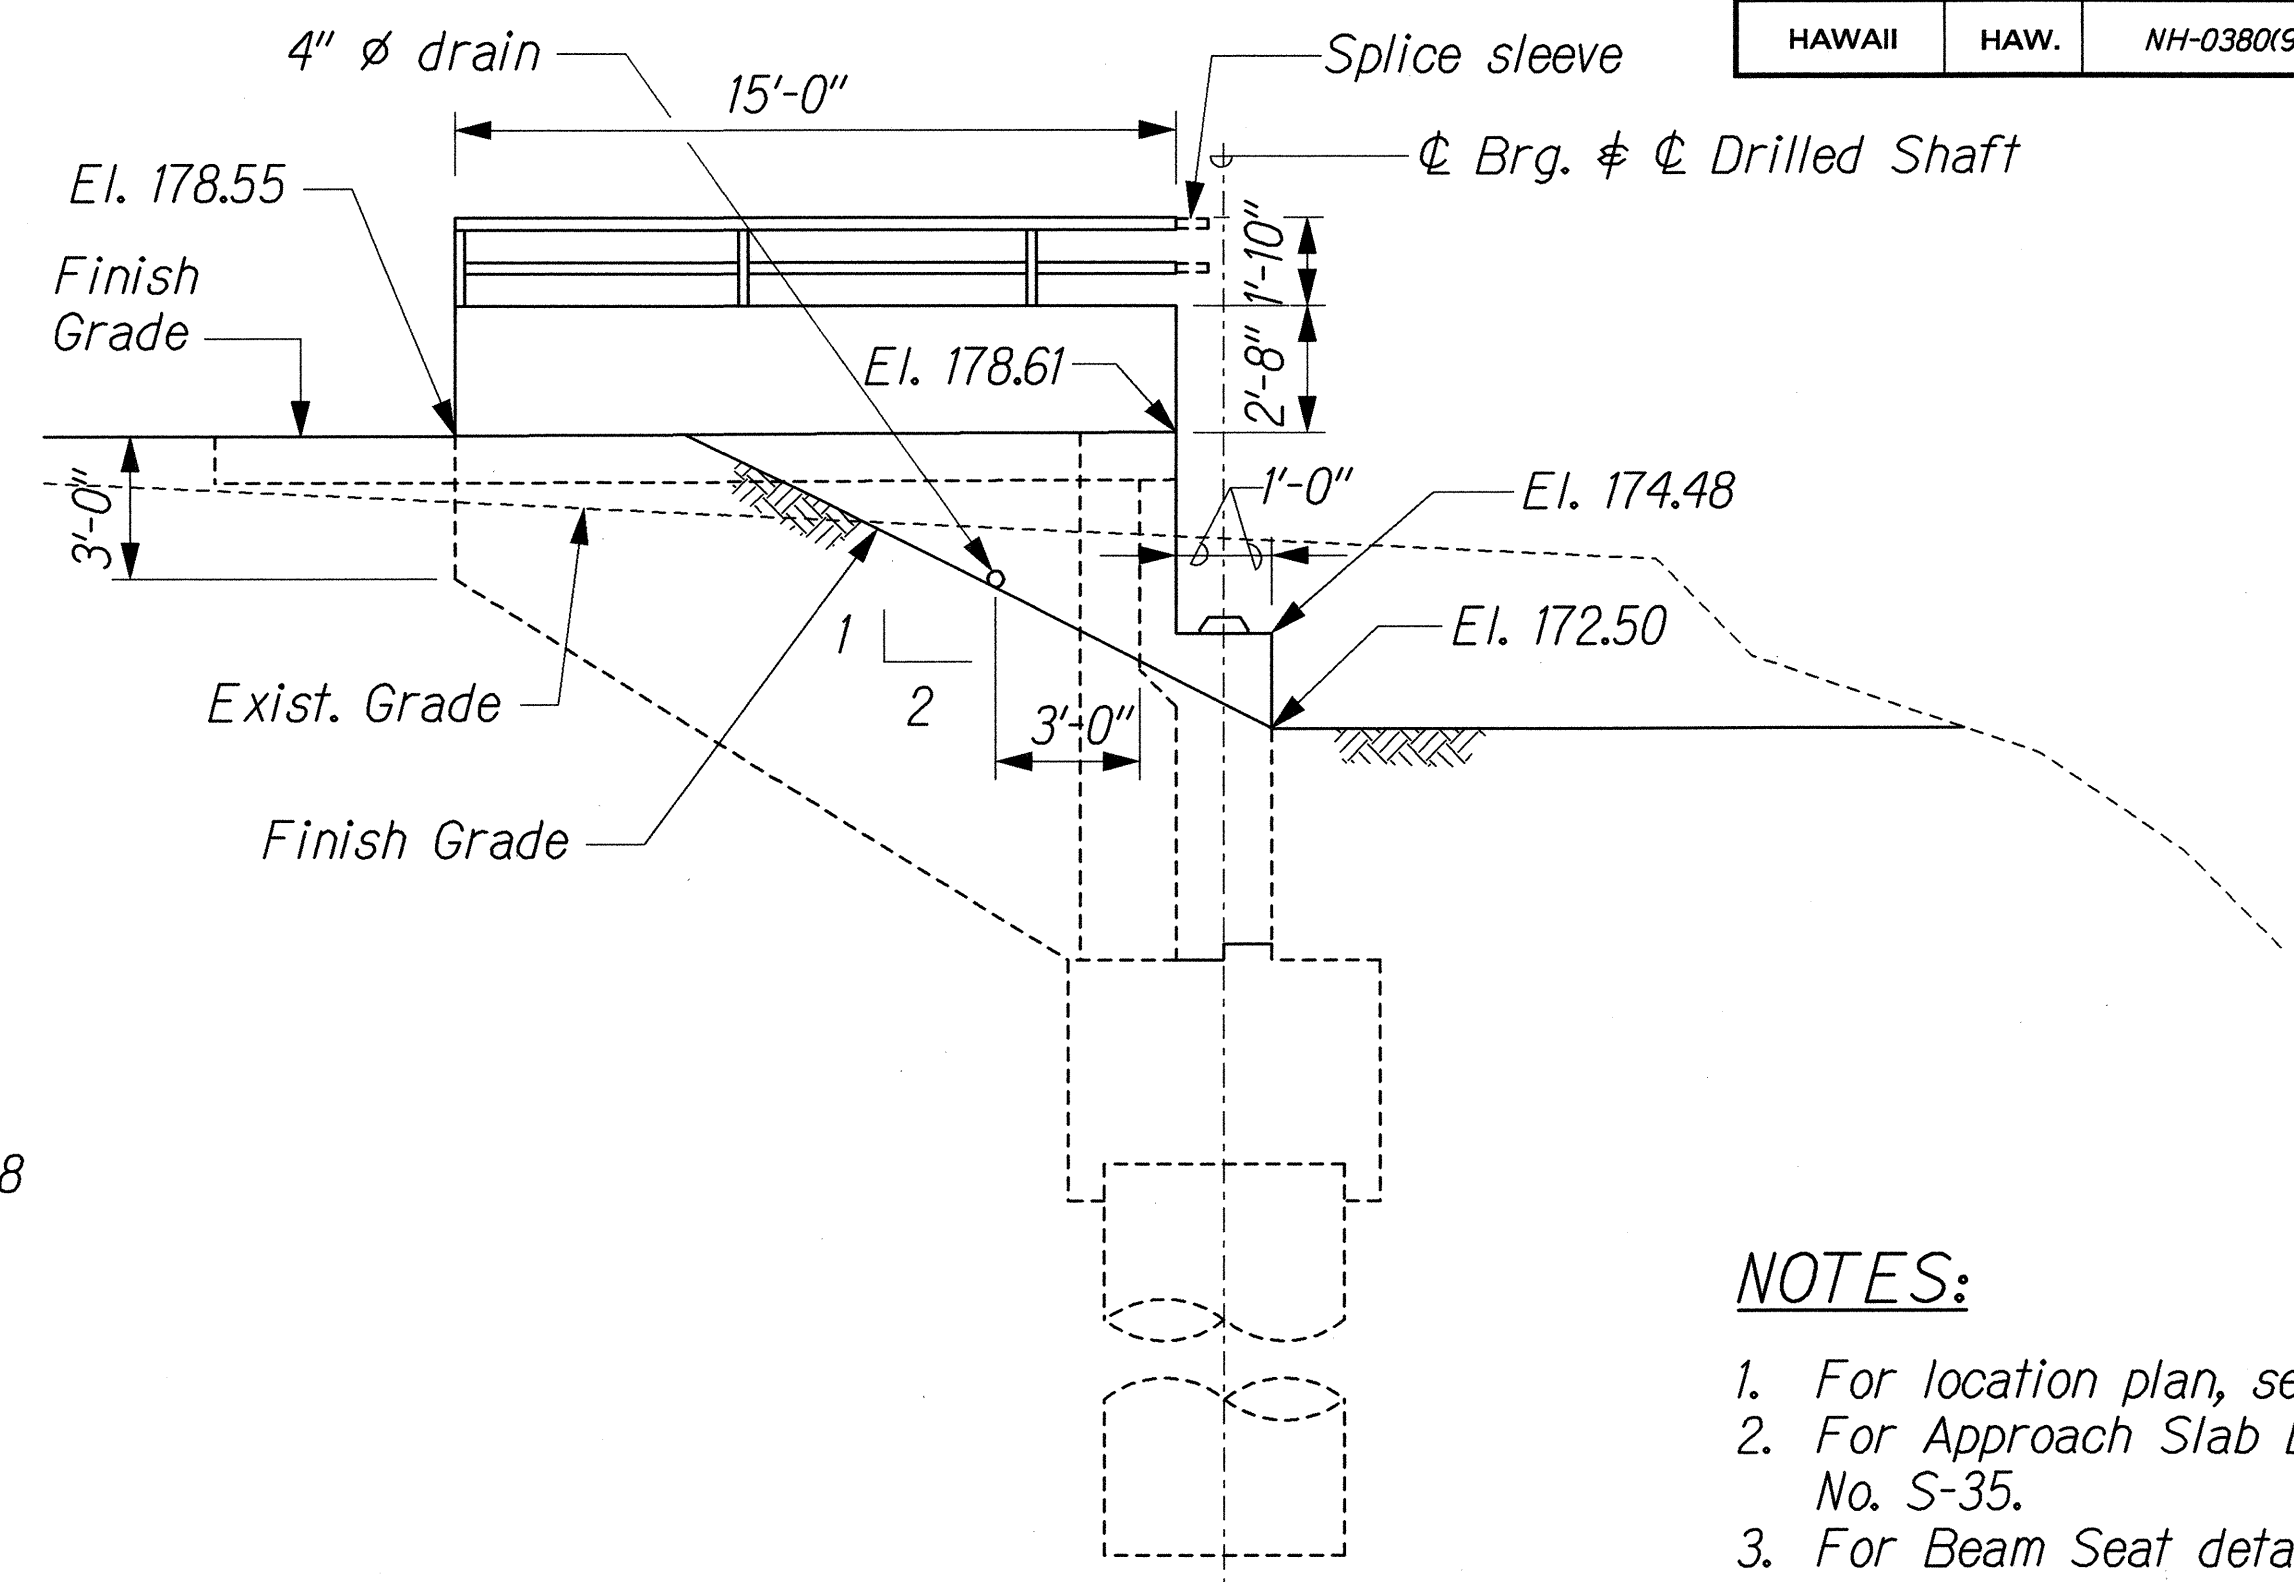

WINGWALL NO. 3

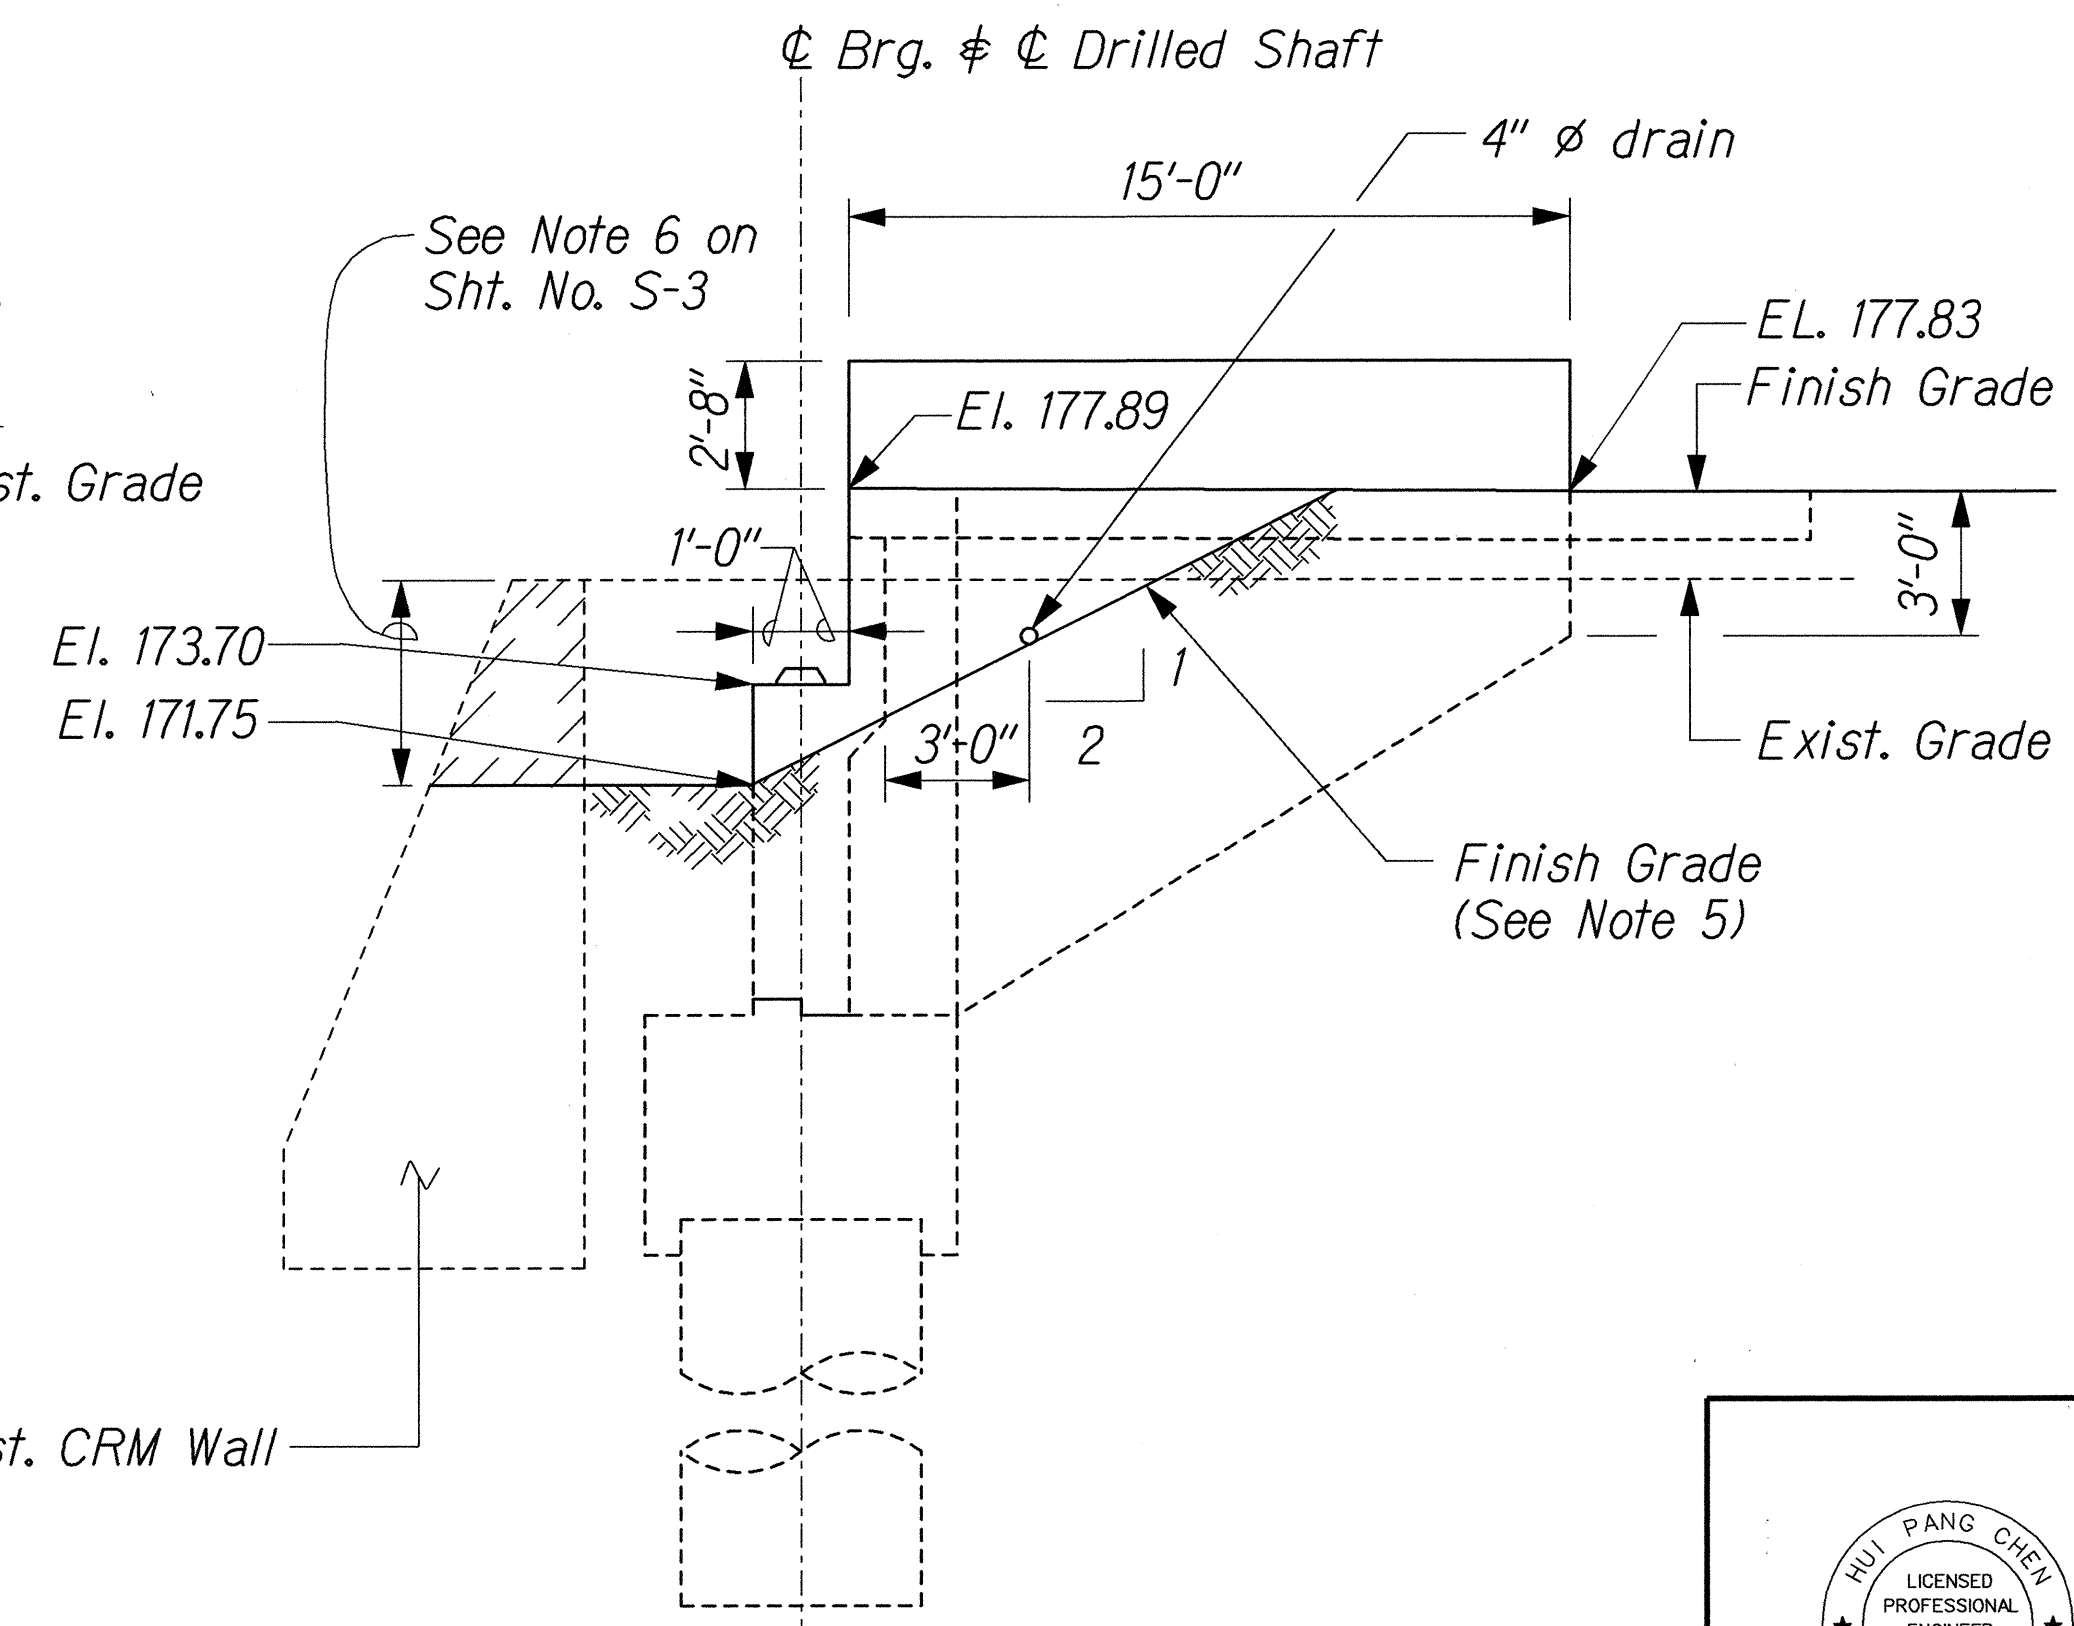

WINGWALL NO. 4

- NOTES:
1. For location plan, see Sheet No. S-3.
 2. For Approach Slab Details, see Sheet No. S-35.
 3. For Beam Seat details, see Sheet No. S-8.
 4. For Creep Block details, see Sheet No. S-8.
 5. See Note 7(L) on Sht. No. S-2.


DATE	_____
SURVEY PLOTTED BY	_____
DRAWN BY	_____
CHECKED BY	_____
NOTED BY	_____
NO. _____	_____

J:\KUIHELANI\STRUCT\ST-DET9Adgn

THIS WORK WAS PREPARED BY ME OR UNDER MY SUPERVISION.
Hui Pang Chen





STATE OF HAWAII
DEPARTMENT OF TRANSPORTATION
HIGHWAYS DIVISION
PALEAAHU STREAM BRIDGE
ABUTMENT SHEET 2 OF 4
KUIHELANI HIGHWAY WIDENING
HONOAPIILANI HIGHWAY TO PUUNENE AVENUE
FEDERAL-AID PROJECT NO. NH-0380(9)
Scale: 1/4" = 1'-0" Date: Sept. 14, 2001
SHEET No. S-6 OF 54 SHEETS

FED. ROAD DIST. NO.	STATE	FED. AID PROJ. NO.	FISCAL YEAR	SHEET NO.	TOTAL SHEETS
HAWAII	HAW.	NH-0380(9)	2000	169	380

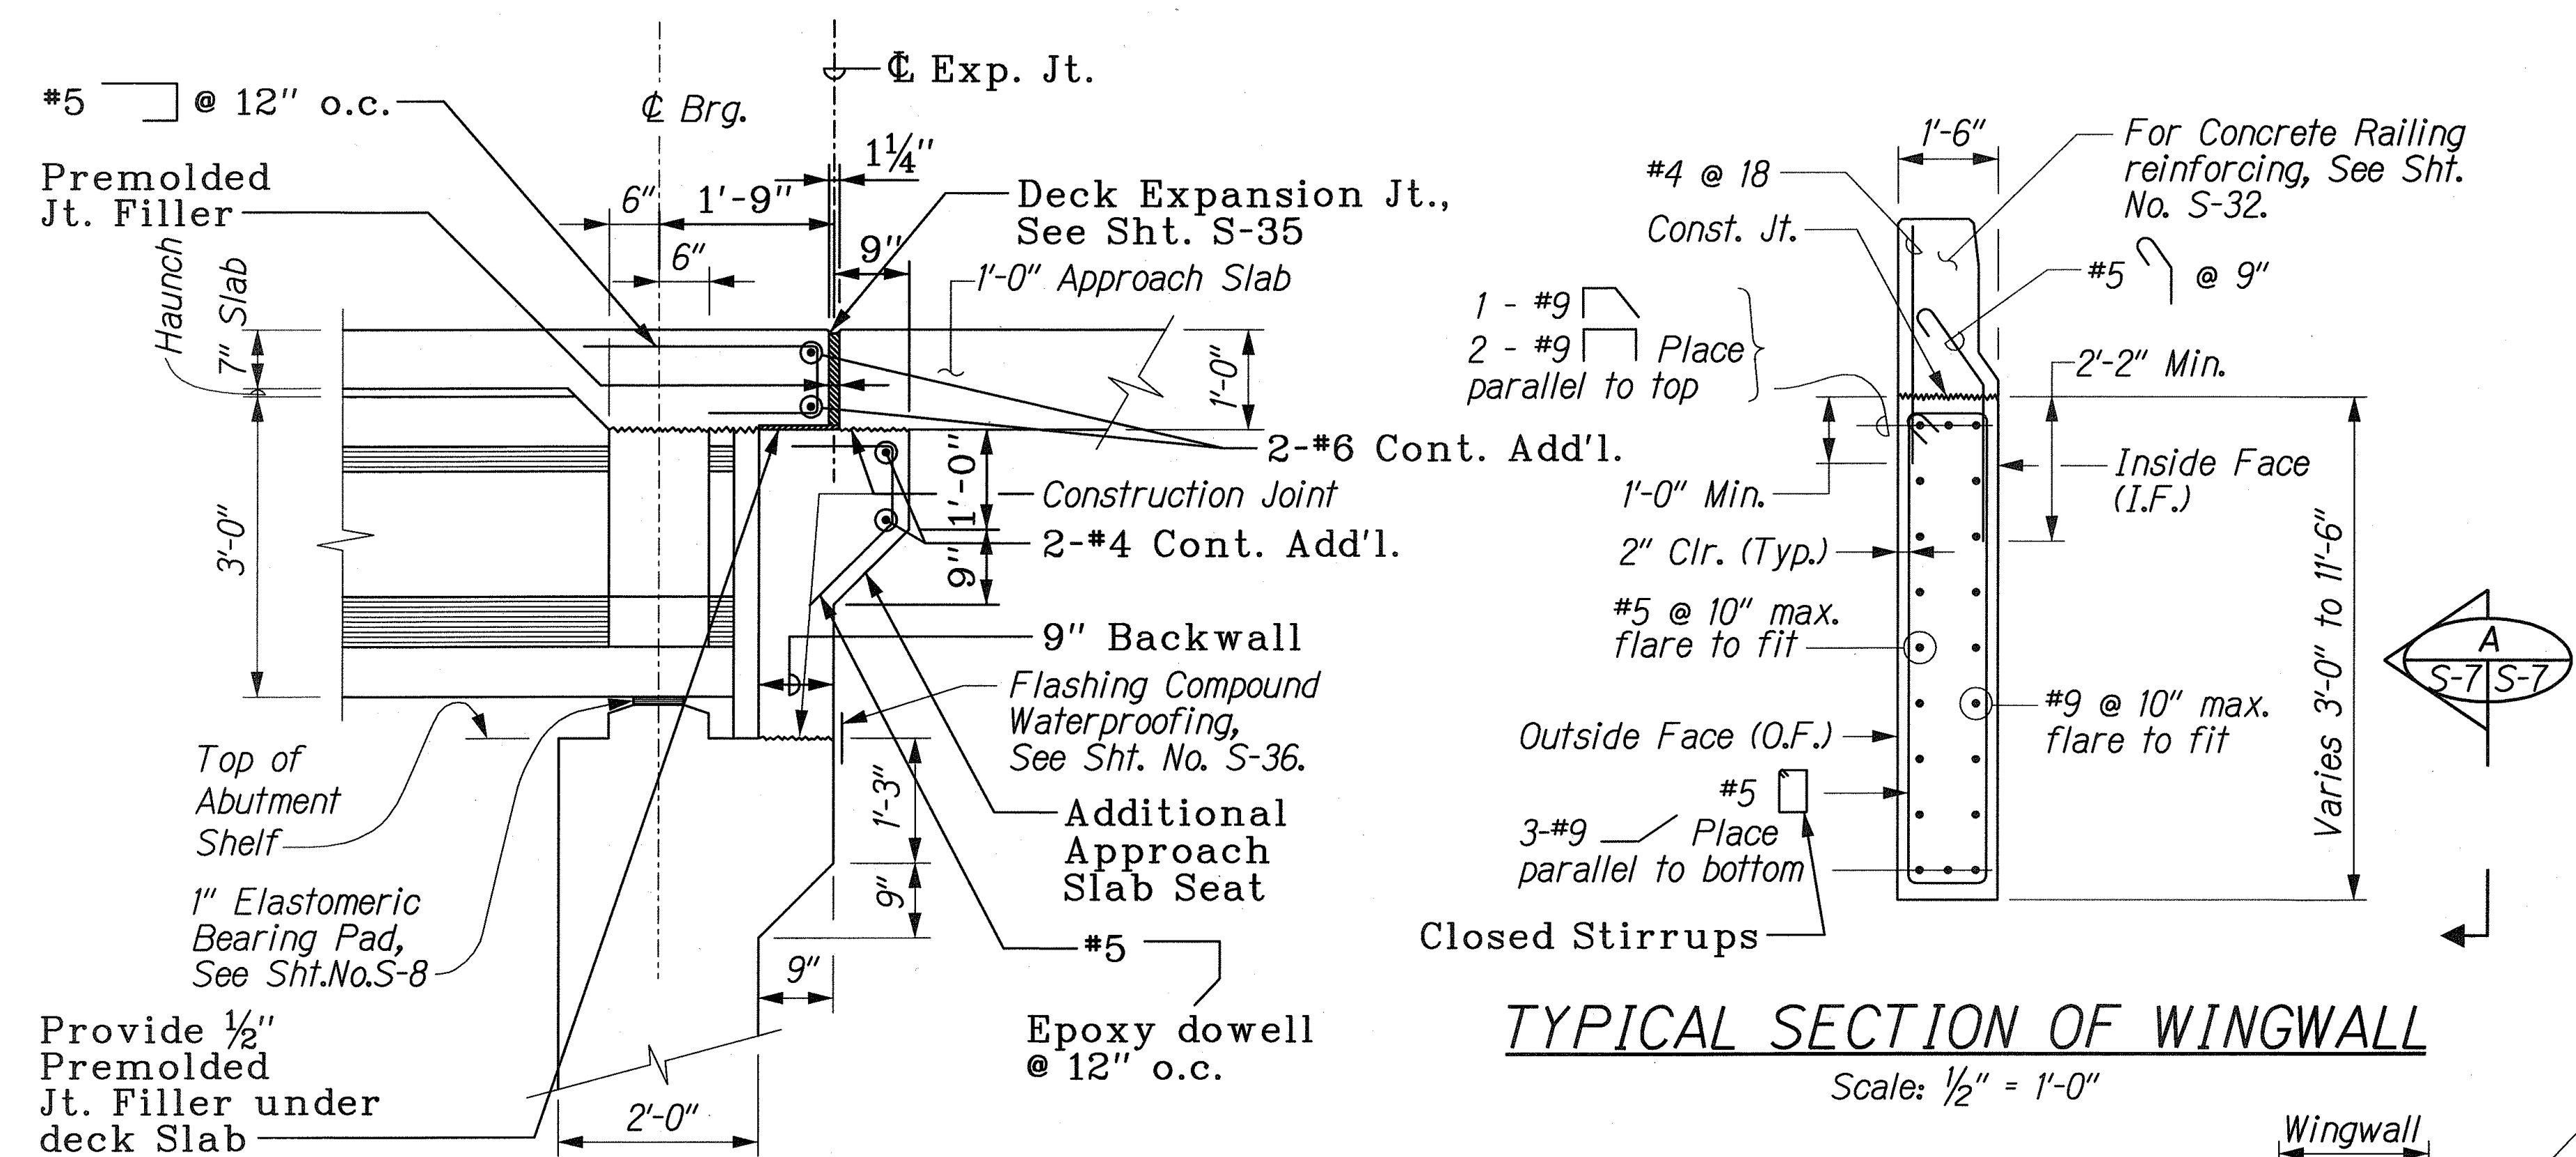


NOTE:

1. For Concrete Railing Details, See Sht. No. S-32.
2. For Approach Slab Details, See Sht. No. S-35.
3. For Deck Expansion Jt., See Sht. No. S-35.

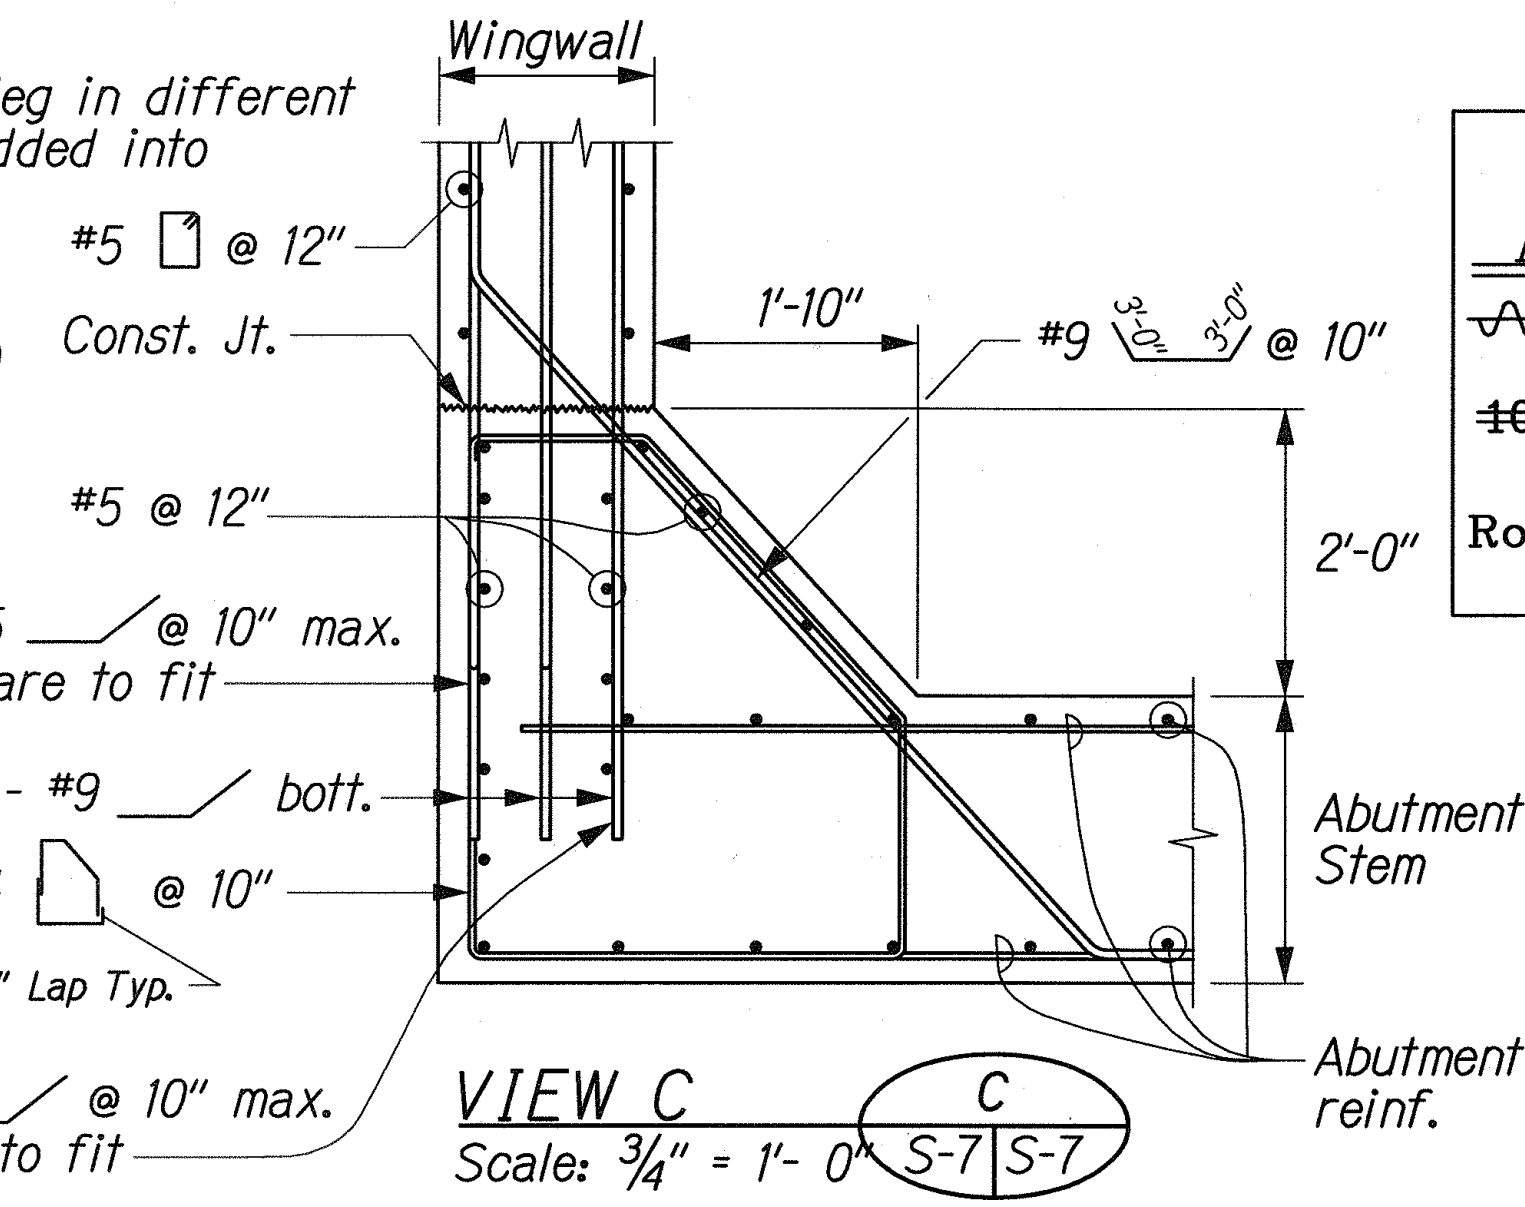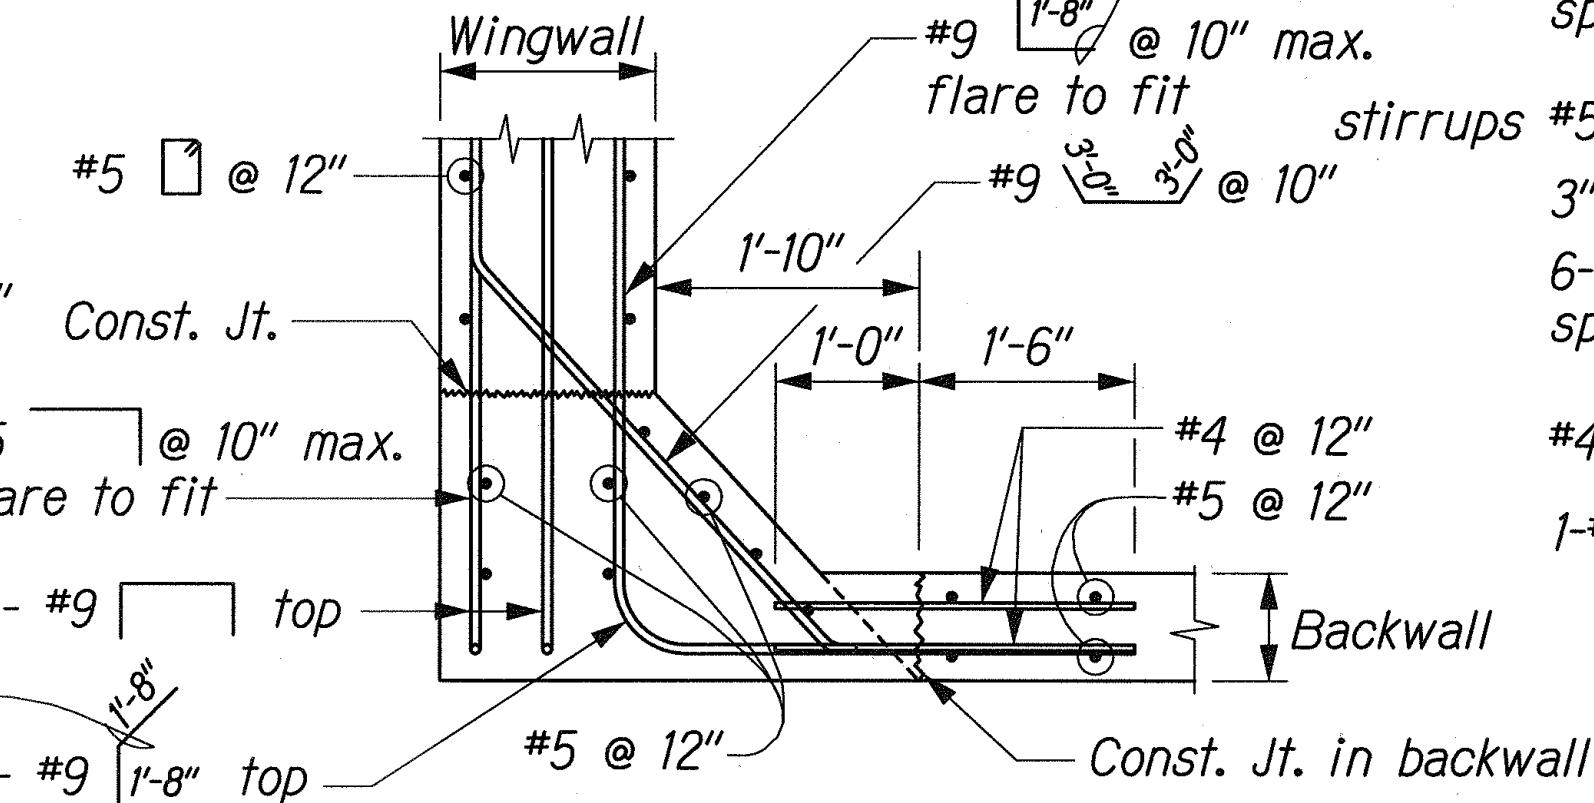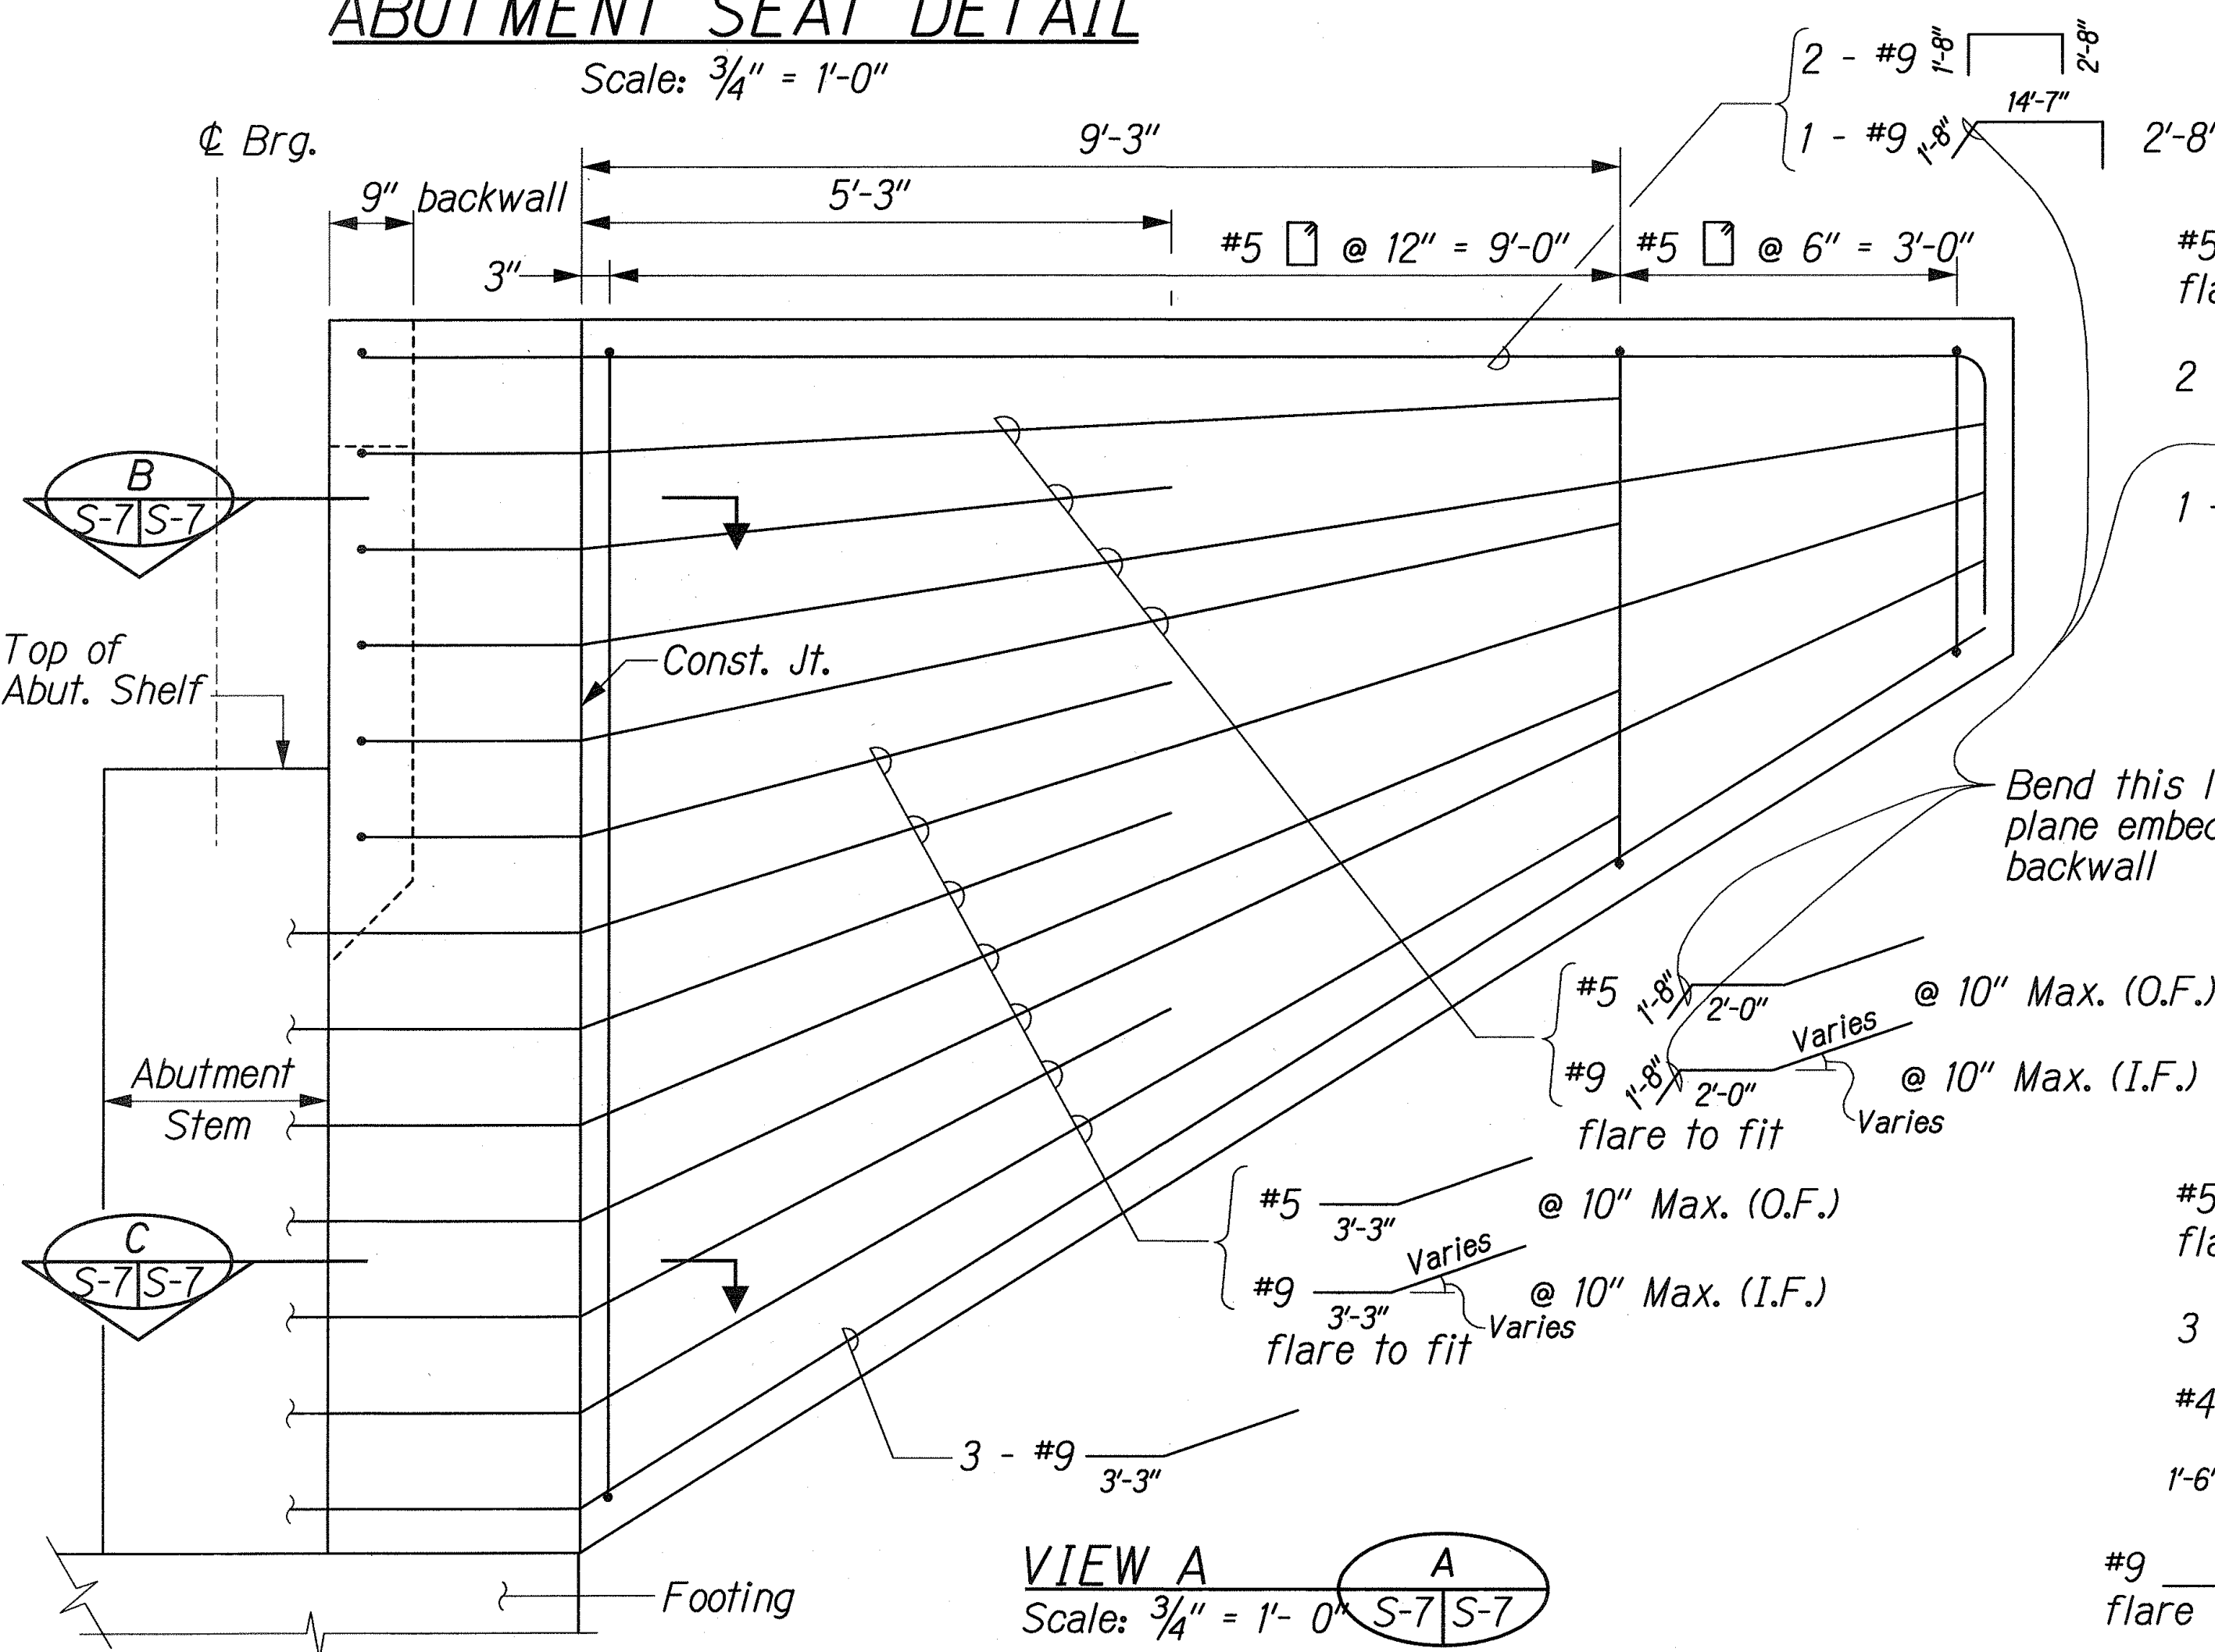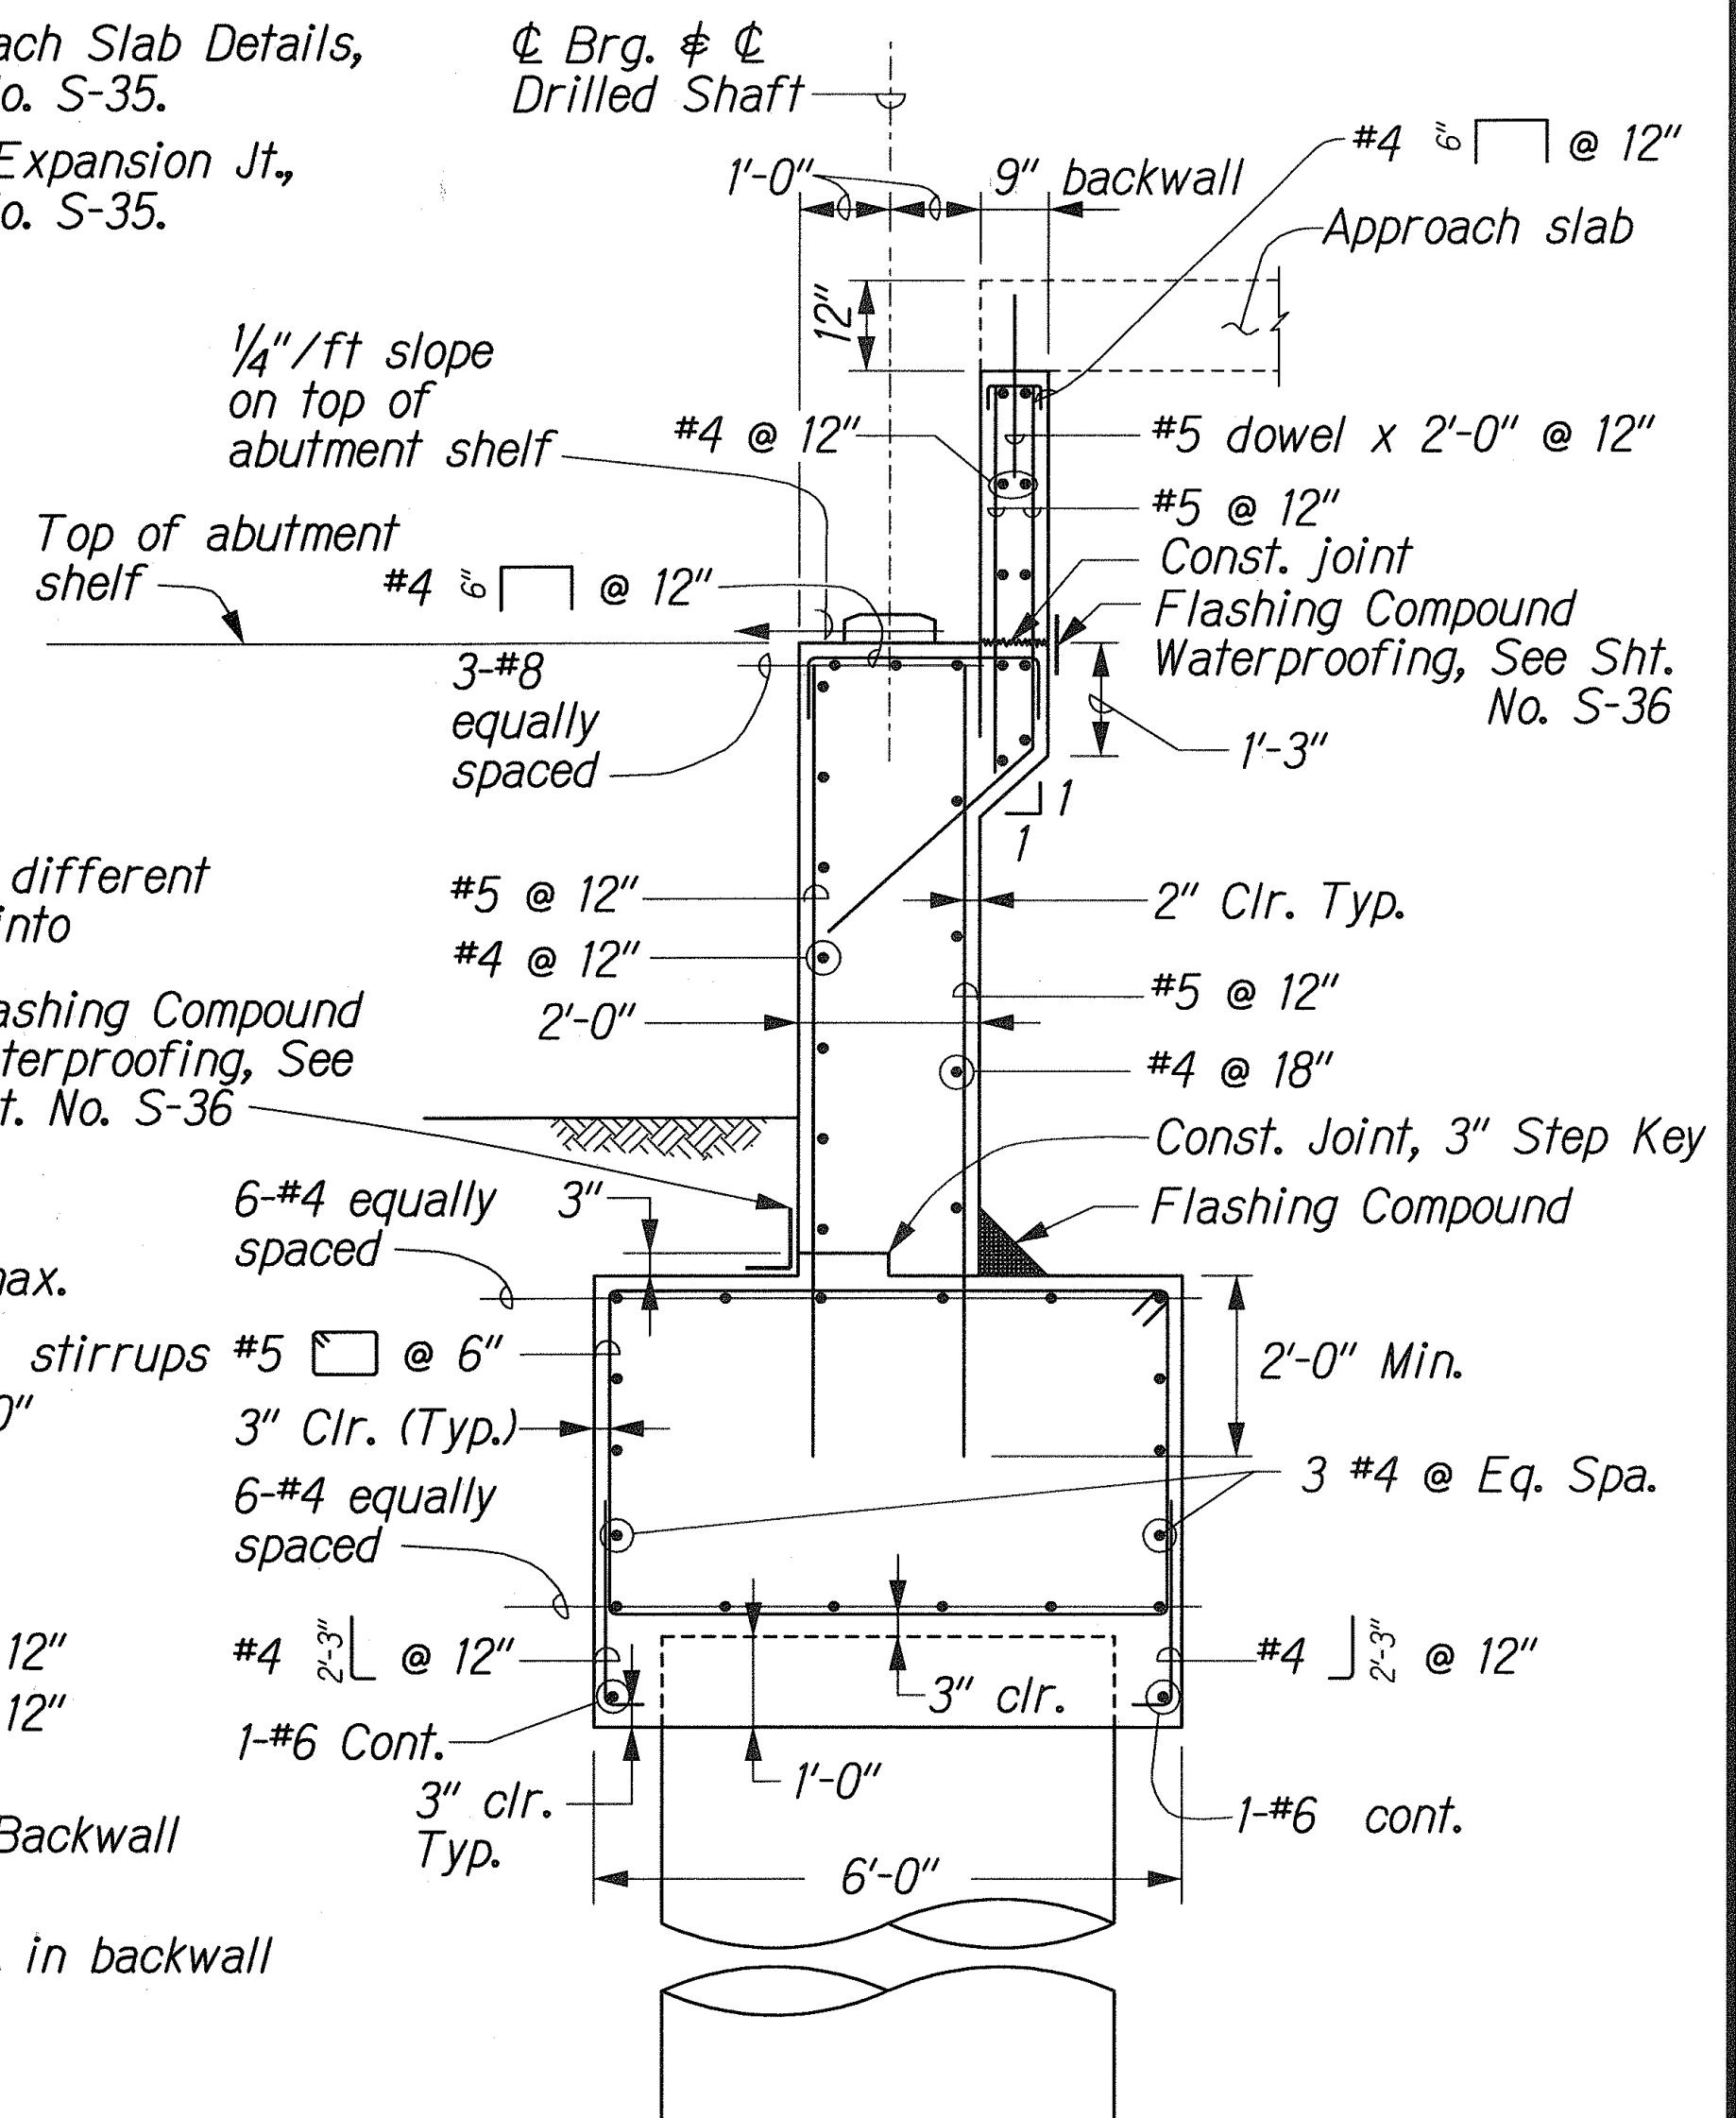

LEGEND FOR AS-BUILT POSTINGS

	Squiggly line for as-built deletion
	Double line for as-built deletion
	Text for as-built posting

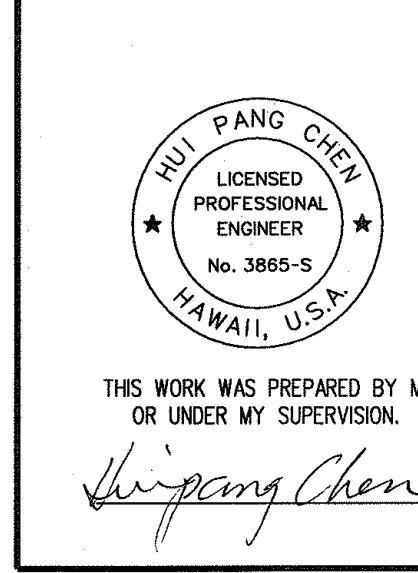


STATE OF HAWAII
DEPARTMENT OF TRANSPORTATION
HIGHWAYS DIVISION
PALEAAHU STREAM BRIDGE
ABUTMENT SHEET 3 OF 4
KUIHELANI HIGHWAY WIDENING
HONOAPIILANI HIGHWAY TO PUUNENE AVENUE
FEDERAL-AID PROJECT NO. NH-0380(9)
Scale: As Shown Date: Sept. 14, 2001


ORIGINAL PLAN	DATE
DRAWN BY	
DESIGNED BY	
CHECKED BY	
NO.	

JG/KUIHELANI/STRUCT/ST-DET&dg

FED. ROAD DIST. NO.	STATE	FED. AID PROJ. NO.	FISCAL YEAR	SHEET NO.	TOTAL SHEETS
HAWAII	HAW.	NH-0380(9)	2000	170	380

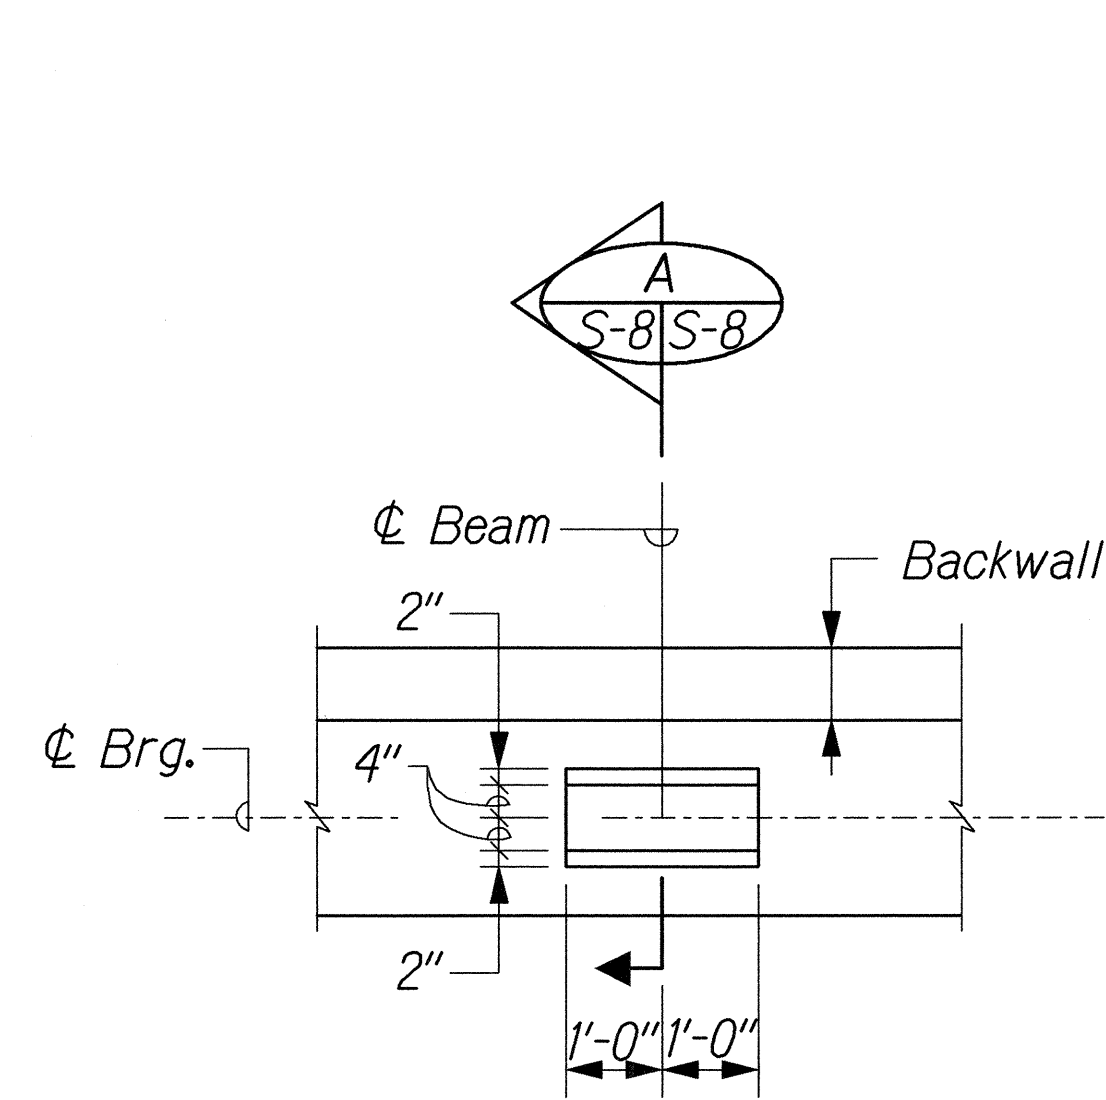


PLAN

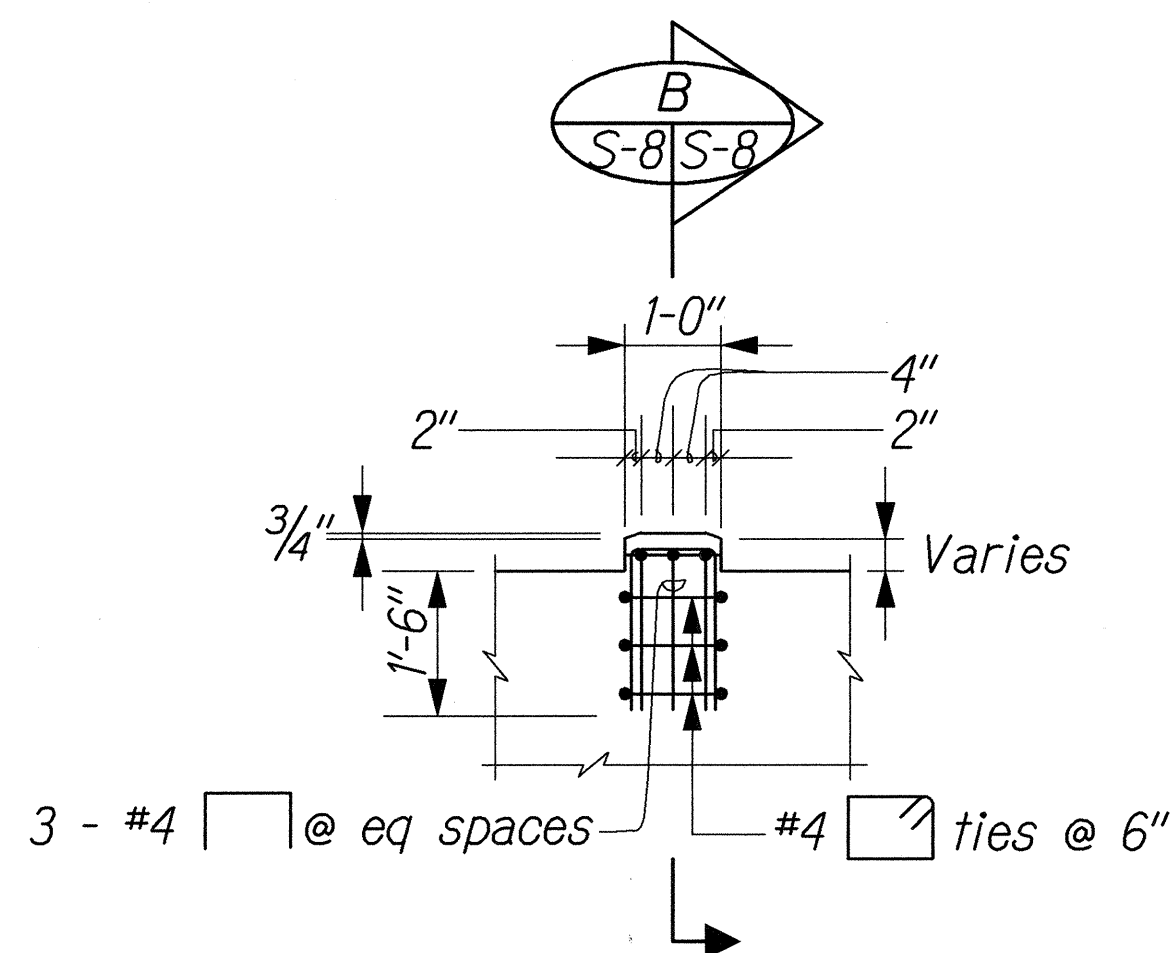


SECTION

BEAM SEAT

Scale: 1/2" = 1'-0"

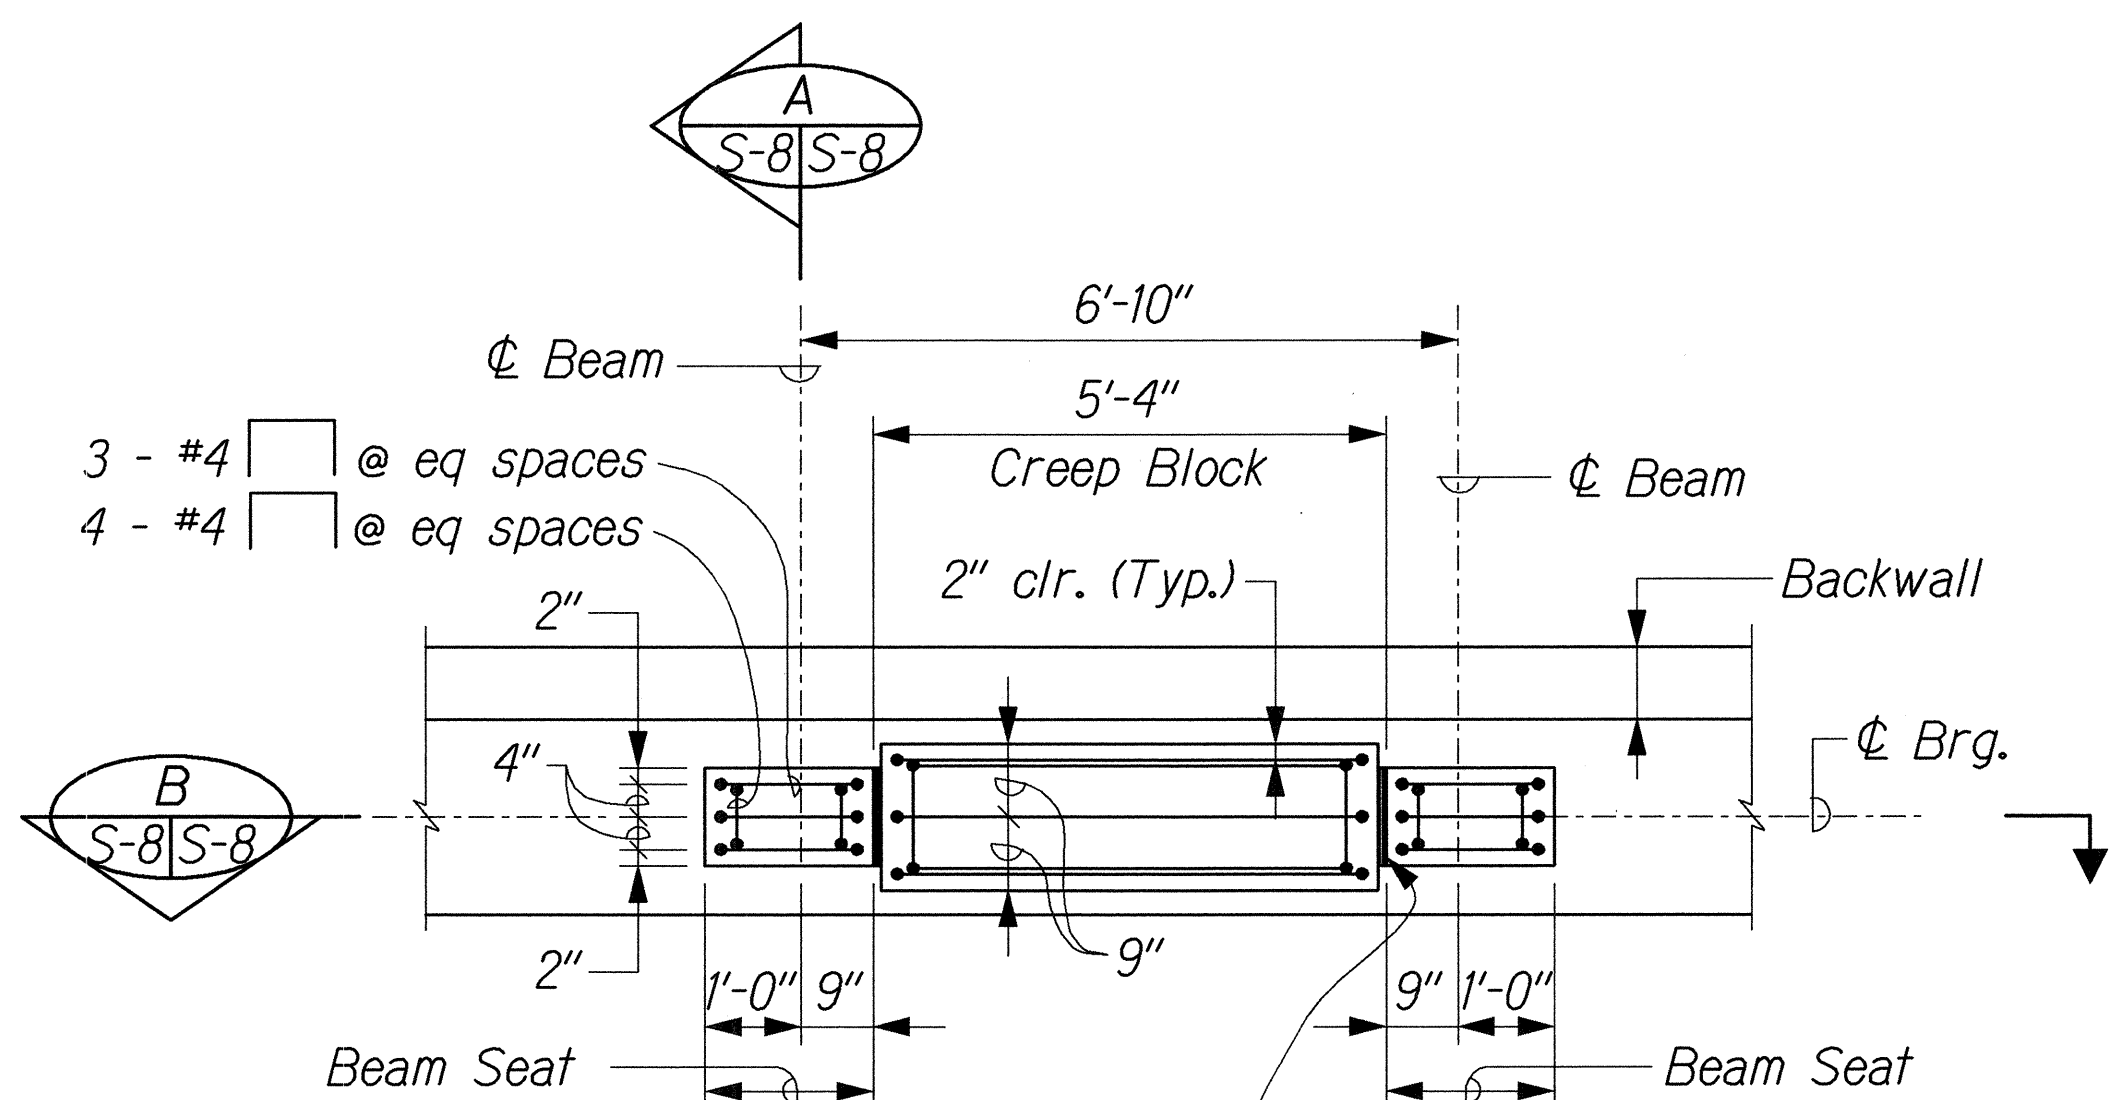


PLAN

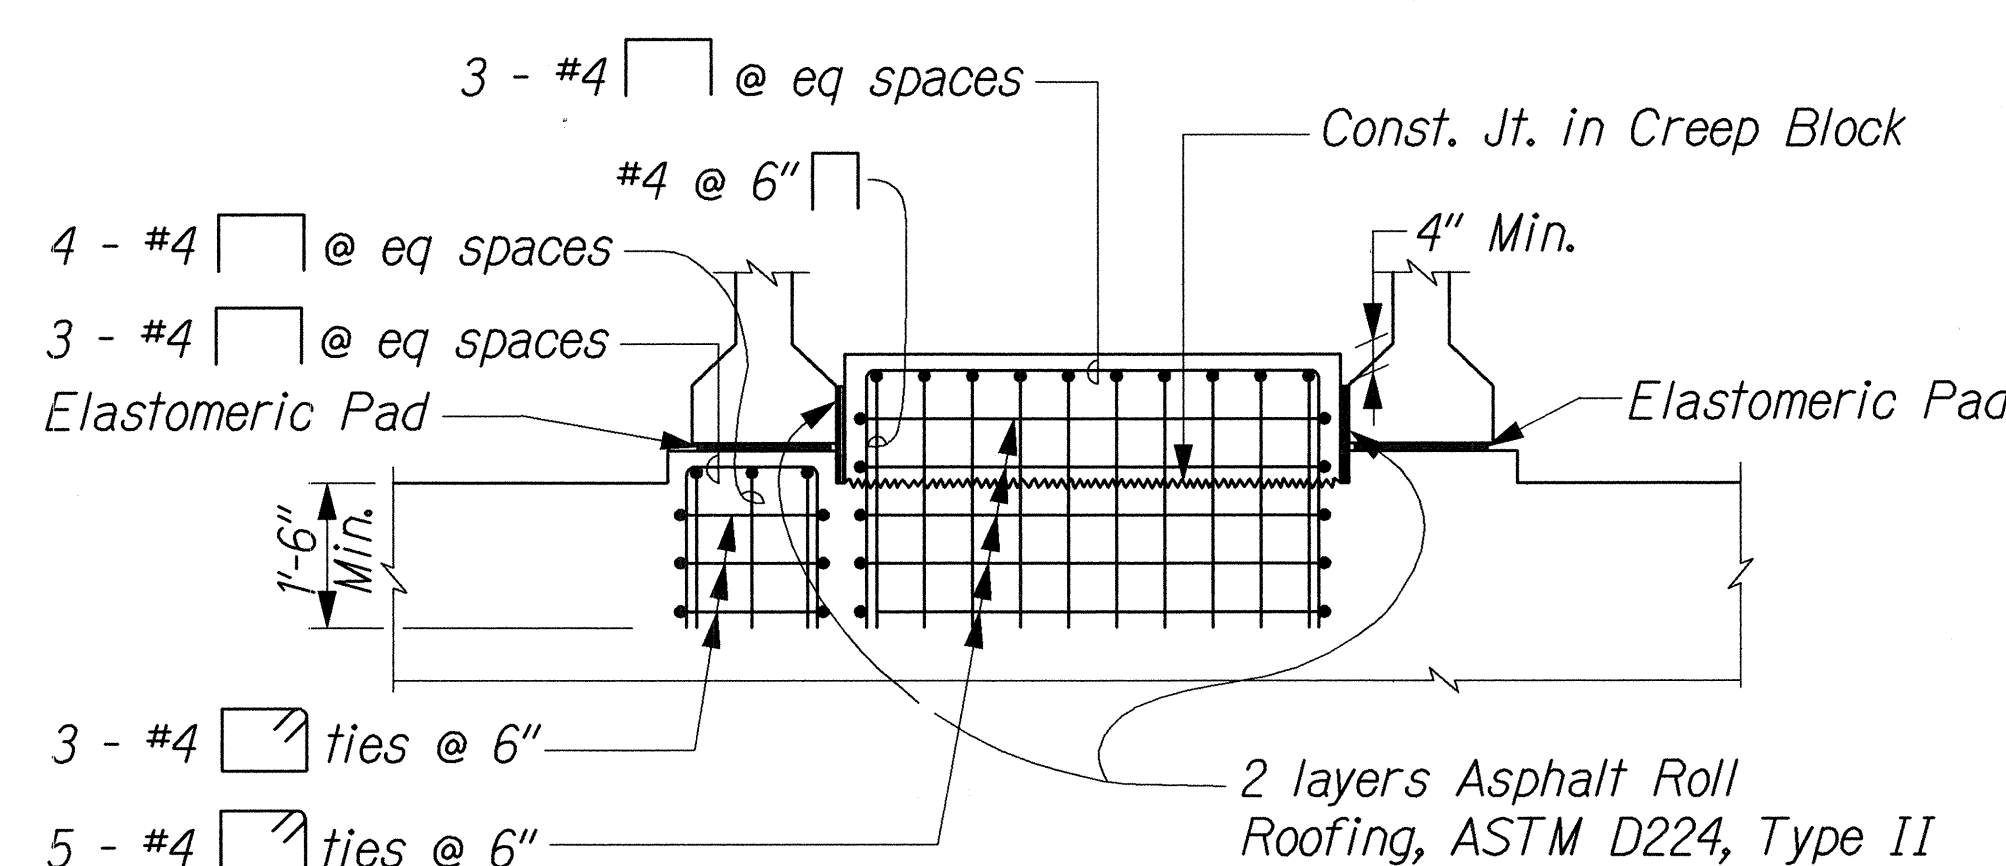


SECTION

BEAM SEAT AND CREEP BLOCK

Scale: 1/2" = 1'-0"

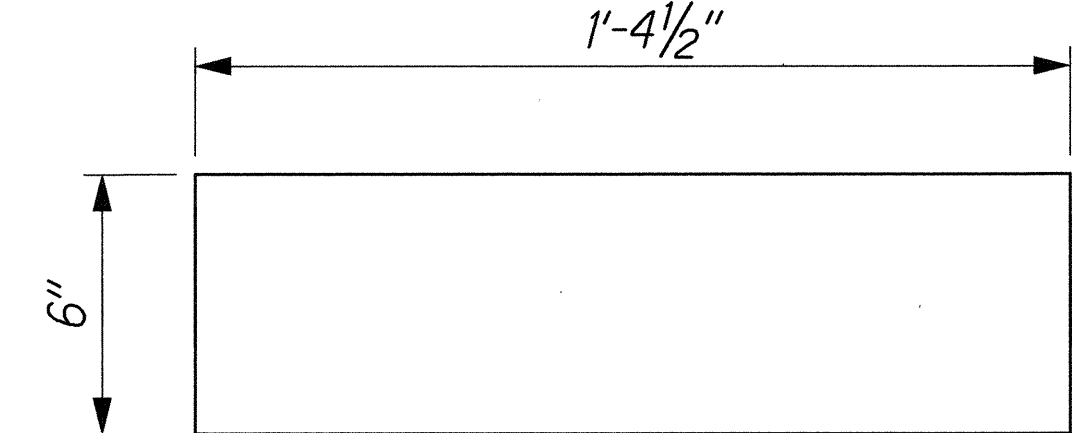

PLAN

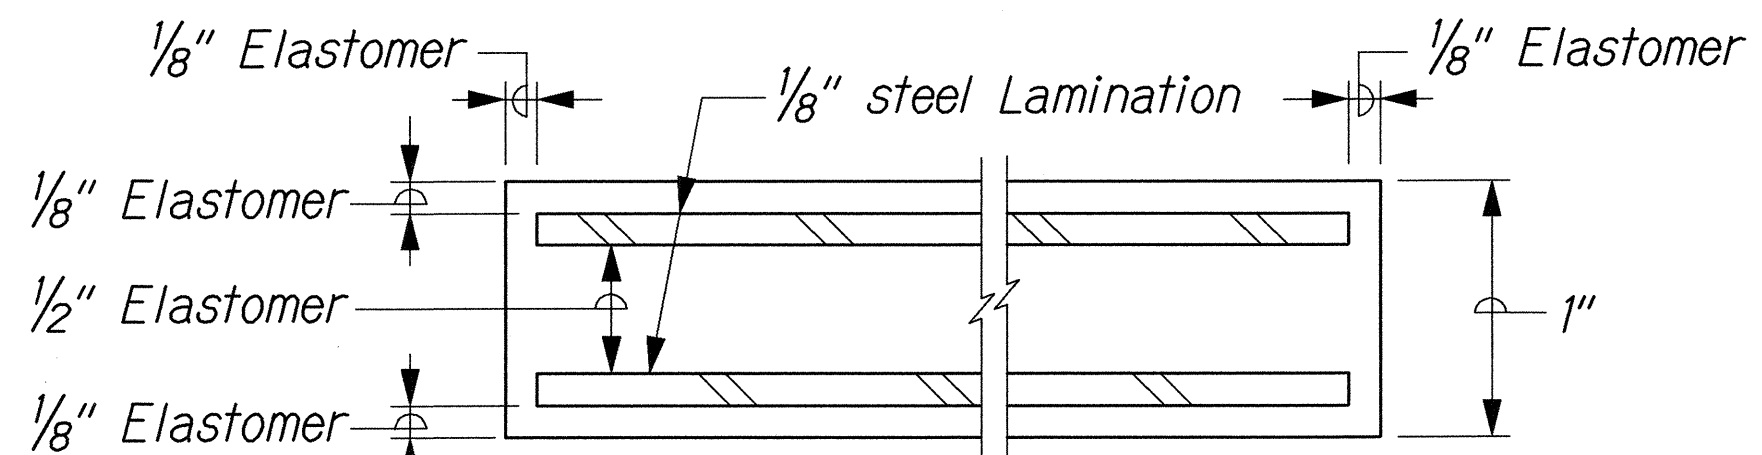


ELEVATION

ELASTOMERIC PAD DETAIL

Scale: Not to Scale



DATE	_____
SURVEY PLOTTED BY	_____
DRAWN BY	_____
CHECKED BY	_____
ORIGINAL PLAN	_____
NOTE BOOK	_____
NO.	_____

J:\KUIHELANI\STRUCT\ST-DET20.dgn




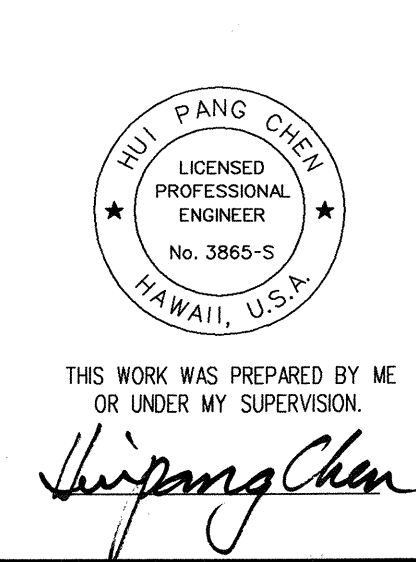


STATE OF HAWAII
DEPARTMENT OF TRANSPORTATION
HIGHWAYS DIVISION
PALEAAHU STREAM BRIDGE
ABUTMENT SHEET 4 OF 4
KUIHELANI HIGHWAY WIDENING
HONOAPIILANI HIGHWAY TO PUUNENE AVENUE
FEDERAL-AID PROJECT NO. NH-0380(9)
Scale: As Shown Date: Sept. 14, 2001


SHEET No. S-8 OF 54 SHEETS

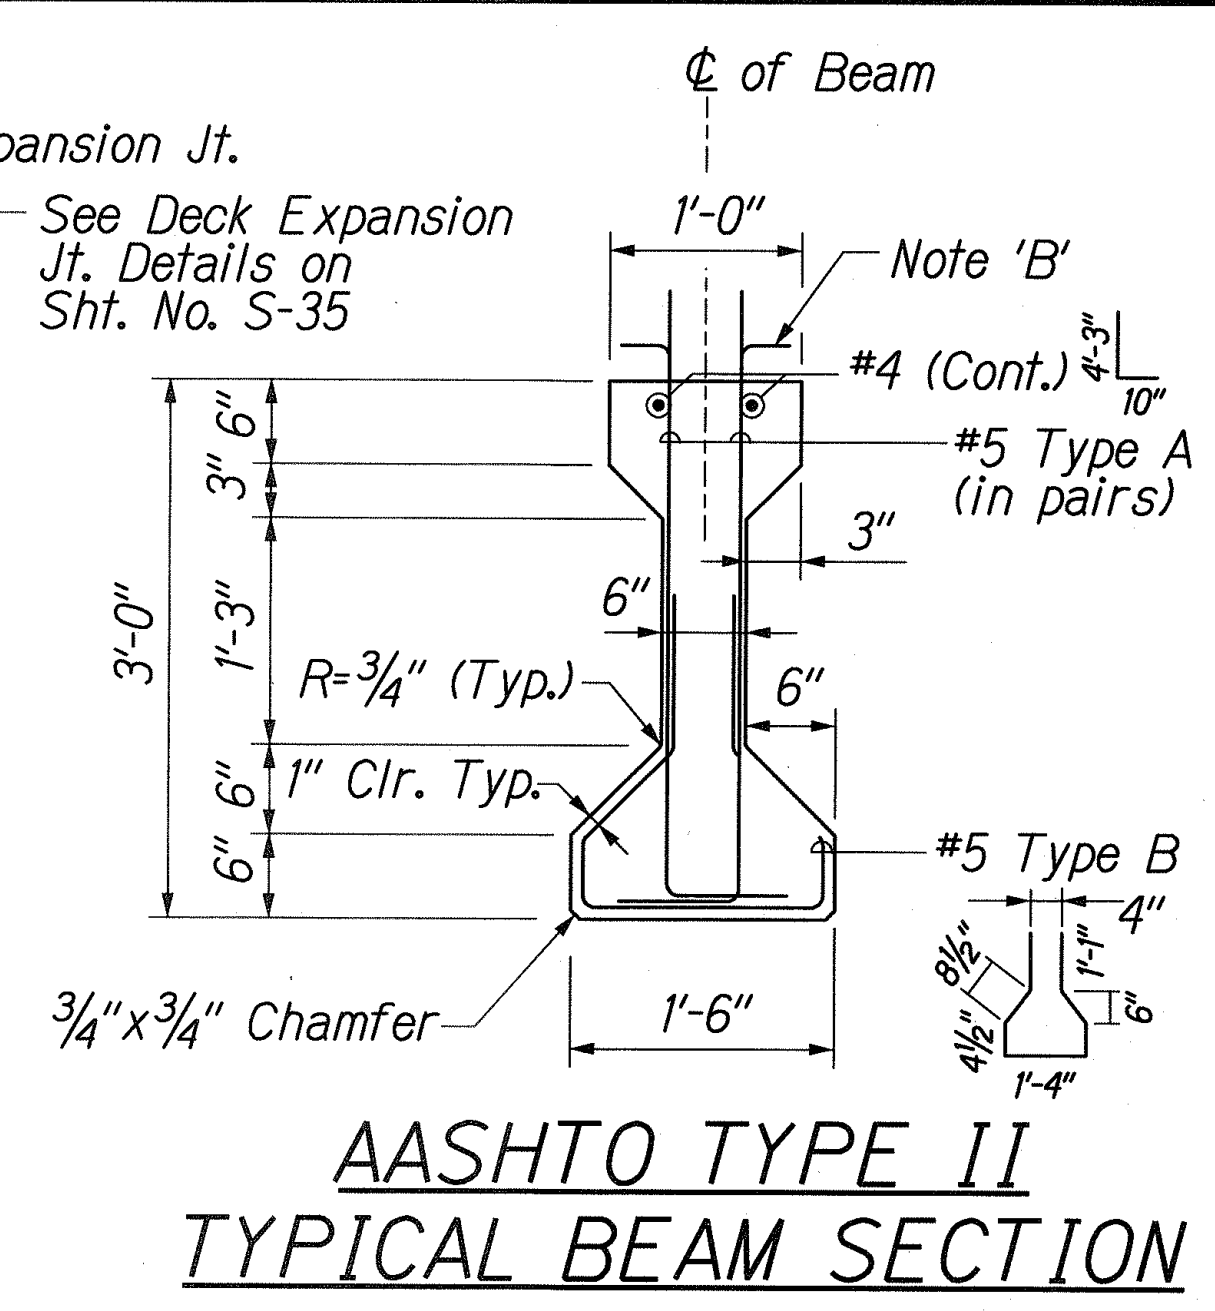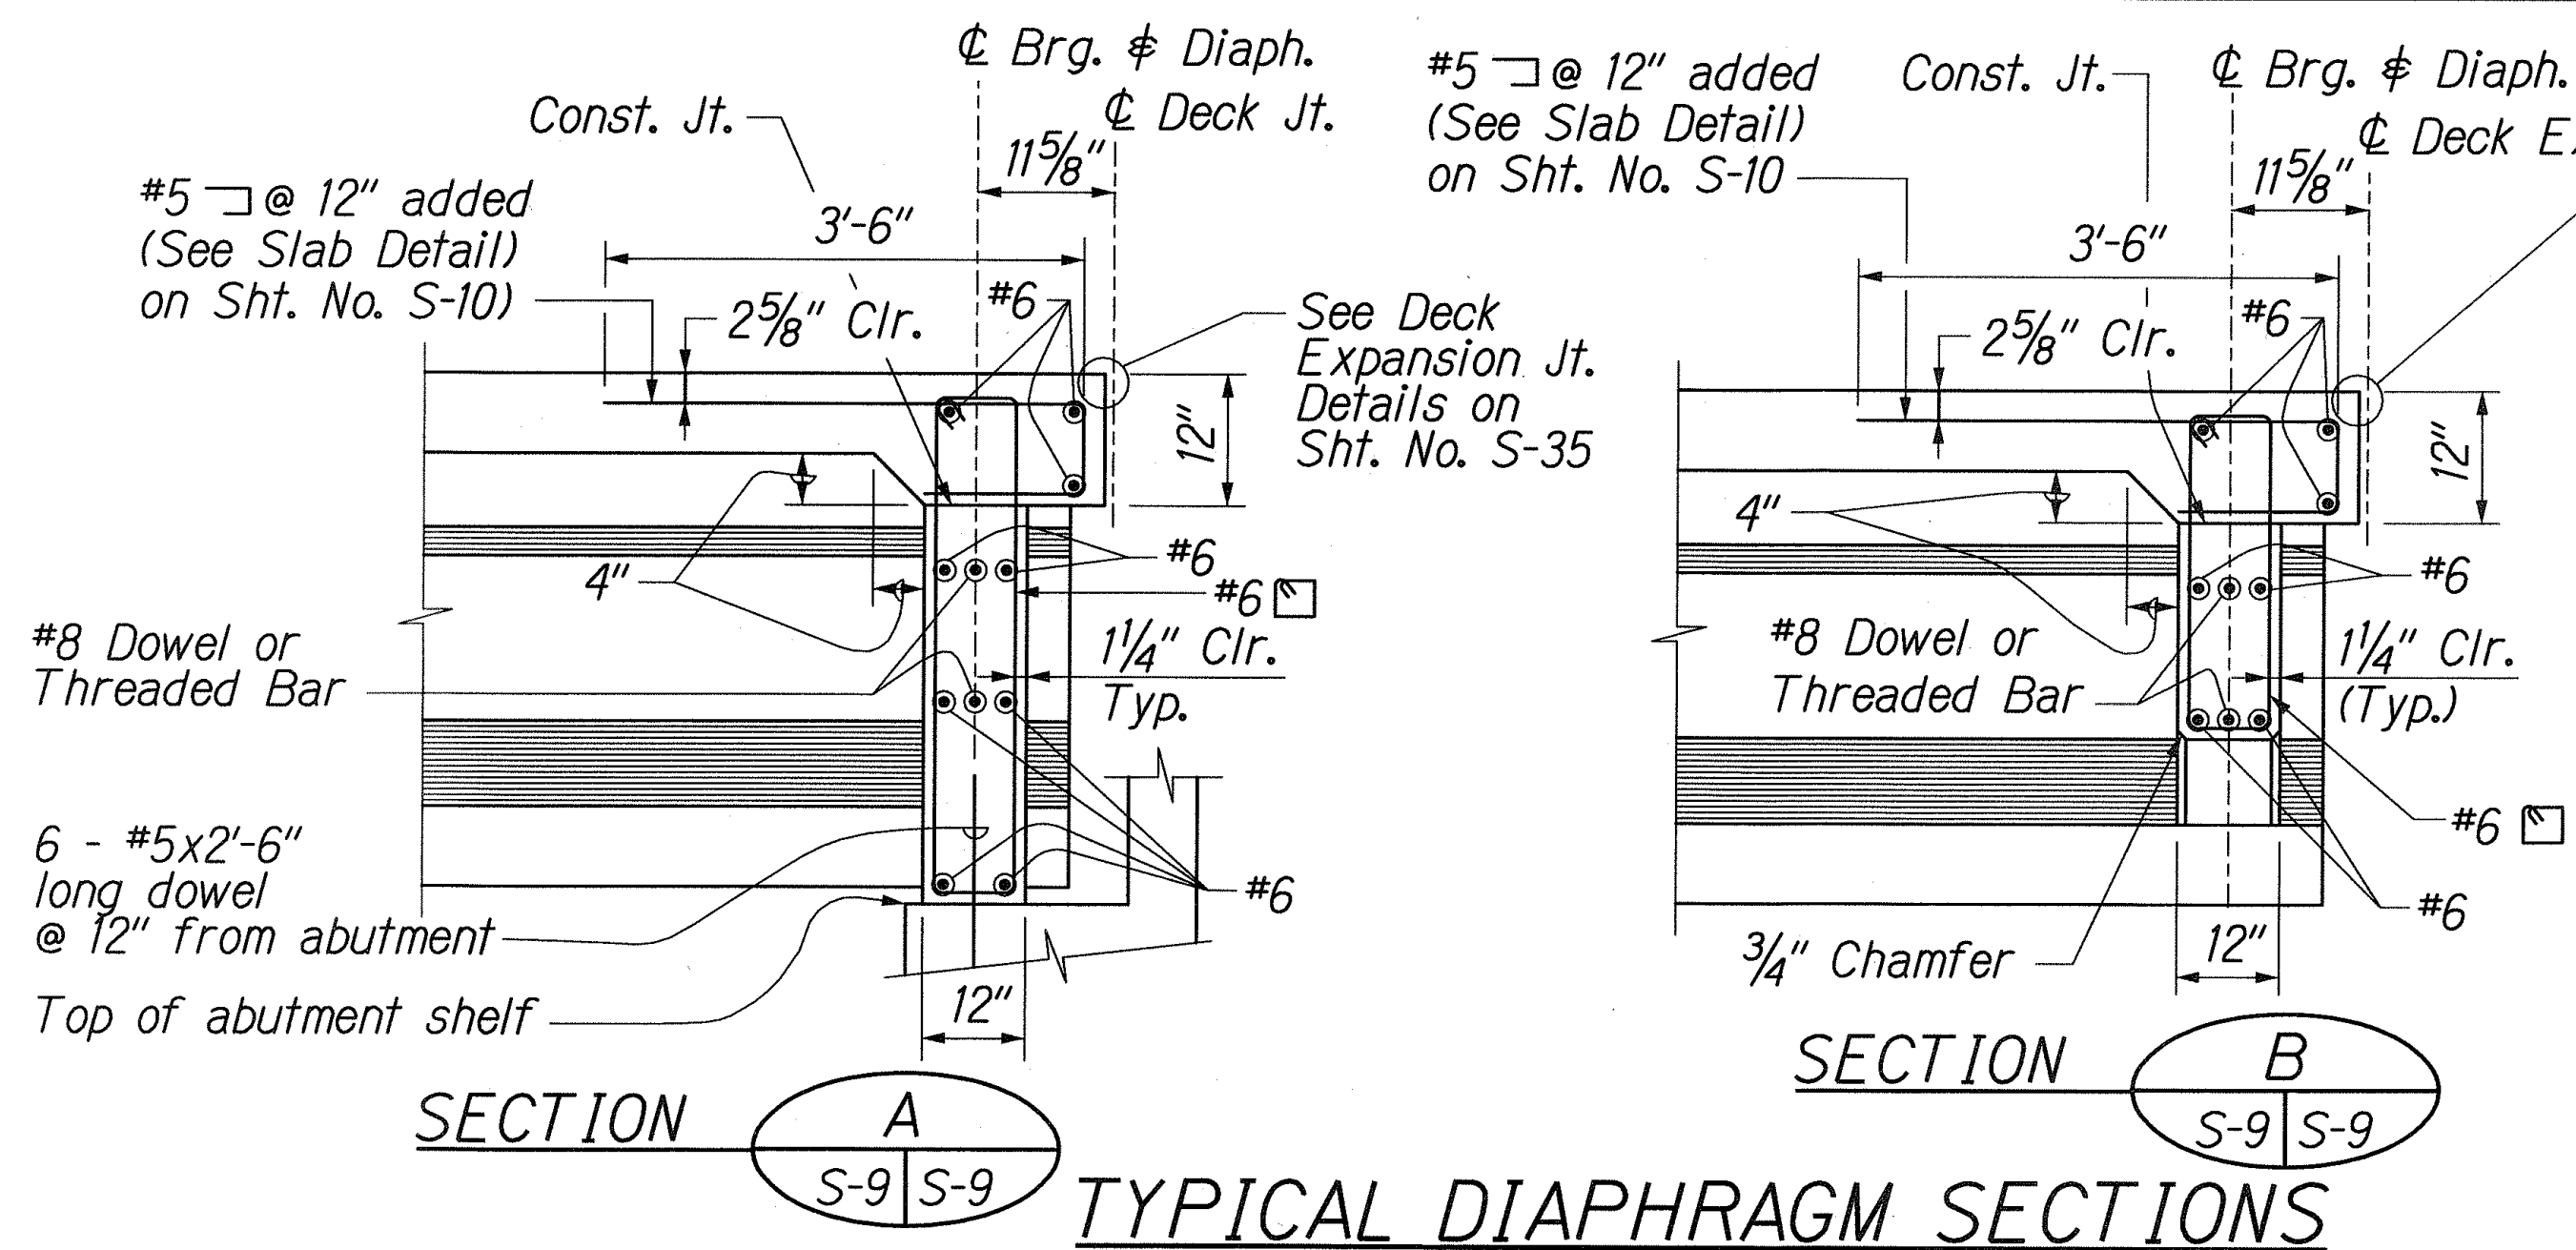


- PRESTRESSED BEAM NOTES:**
- Concrete strength for precast/prestressed concrete beam shall be 6000 psi at 28 days.
 - Minimum compressive strength of concrete at transfer, See Table this sheet.
 - Prestressing strands shall be 1/2" diameter, 270 ksi, low-relax strands conforming to ASTM A 416. The estimated total losses due to creep, shrinkage, elastic shortening, and relaxation of steel are 53,000 psi.
 - Non-prestressed reinforcing steel in prestressed beam shall be Grade 60 unless otherwise noted. For properties, see State Standard Specifications.
 - The calculated camber includes the effect of the initial prestress force and the weight of the beam after removal from the bed. Positive values shown for calculated camber indicate a net upward deflection. The calculated camber value has been multiplied by a factor of 2 to approximate the effect of camber growth and concrete creep. The actual camber shall not exceed the calculated camber by more than 1/2".
 - The dead load deflection includes the combined effects of the weight of beam, slab, haunch, diaphragm, and concrete railing.
 - Strand release sequence shall not induce any lateral deflection of the beam. For Strand release procedures, see Special Provisions.
 - The Contractor shall submit his proposed strand releasing sequence to the Engineer for acceptance.
 - During curing, care shall be taken to avoid any lateral deflection of the beam due to improper orientation.
 - Lifting devices shall be placed as close as possible to the centerline of bearings of the beam. Details and locations of lifting devices shall be submitted to the Engineer for acceptance. Such acceptance does not relieve the Contractor of his responsibilities if beam is damaged due to the failure of the lifting device.

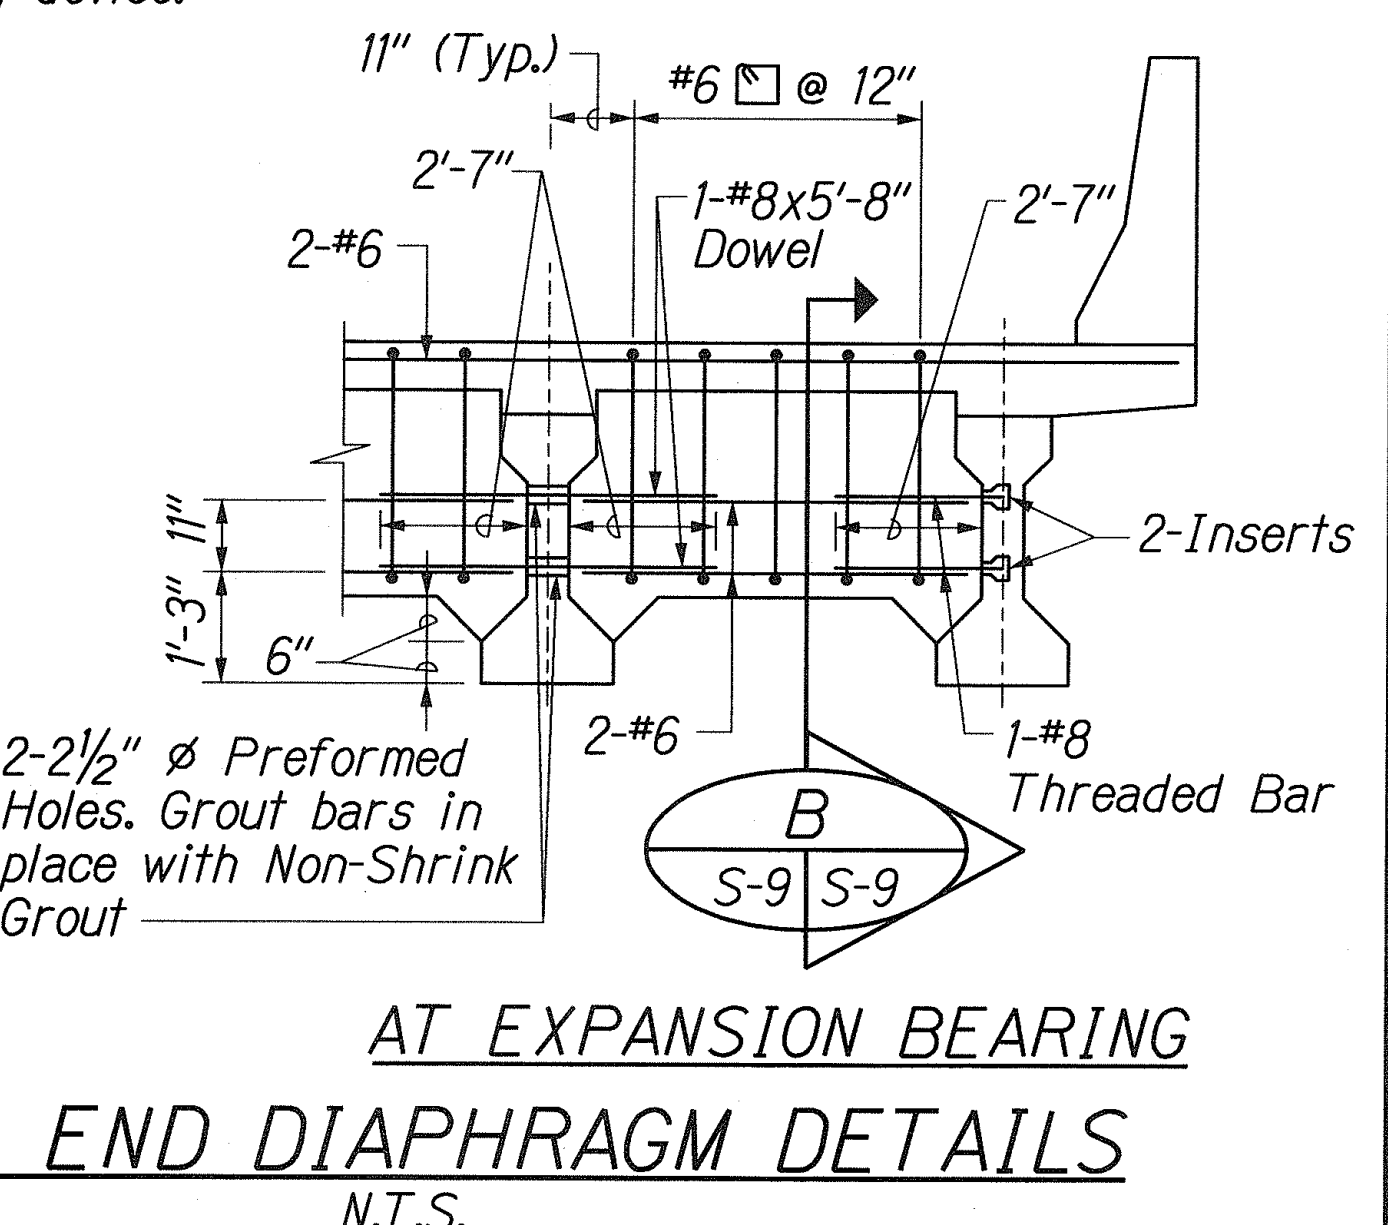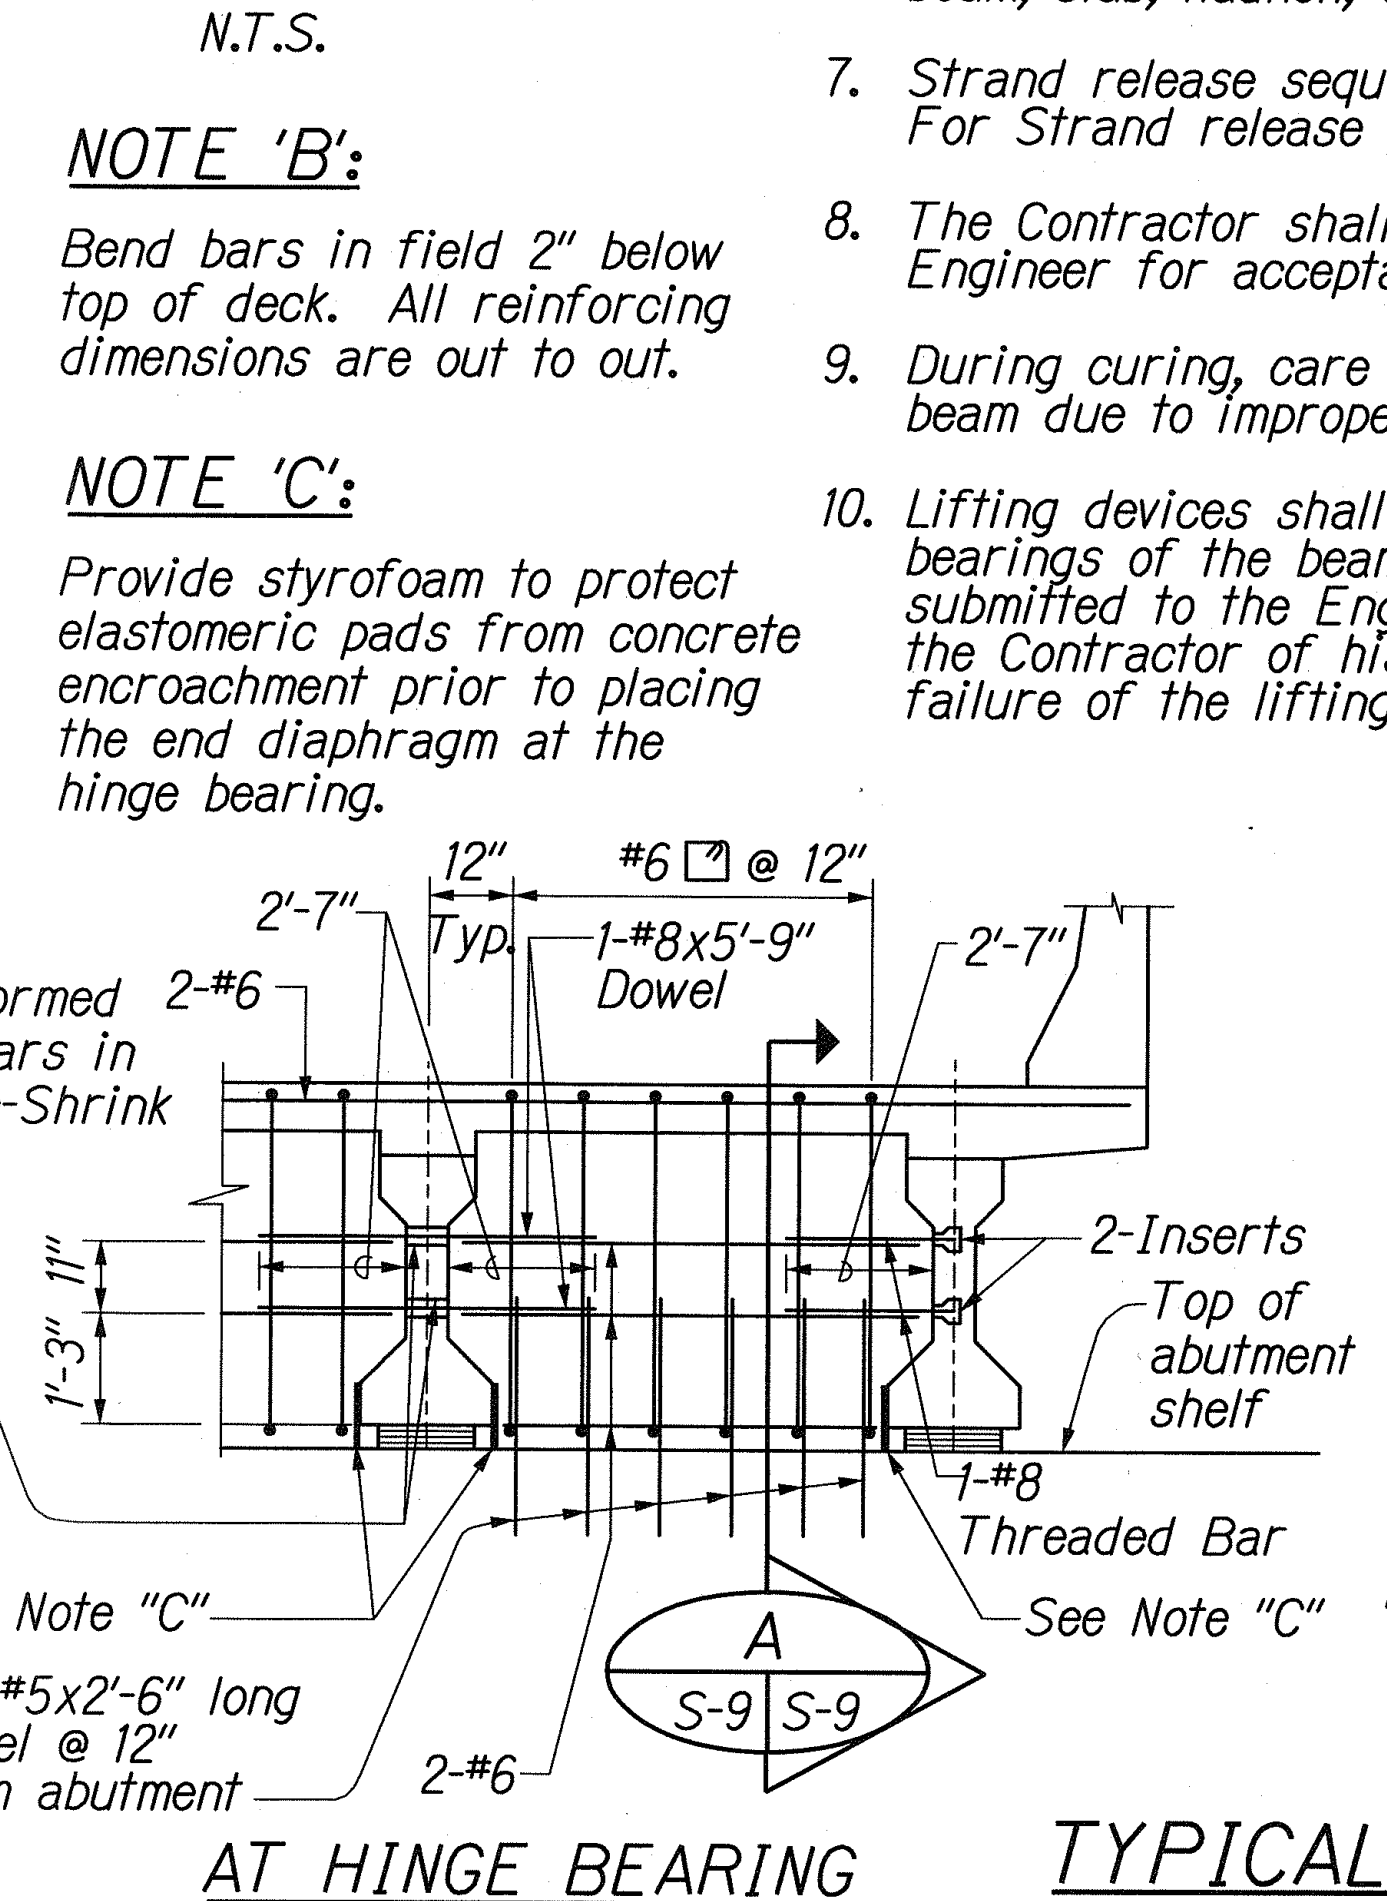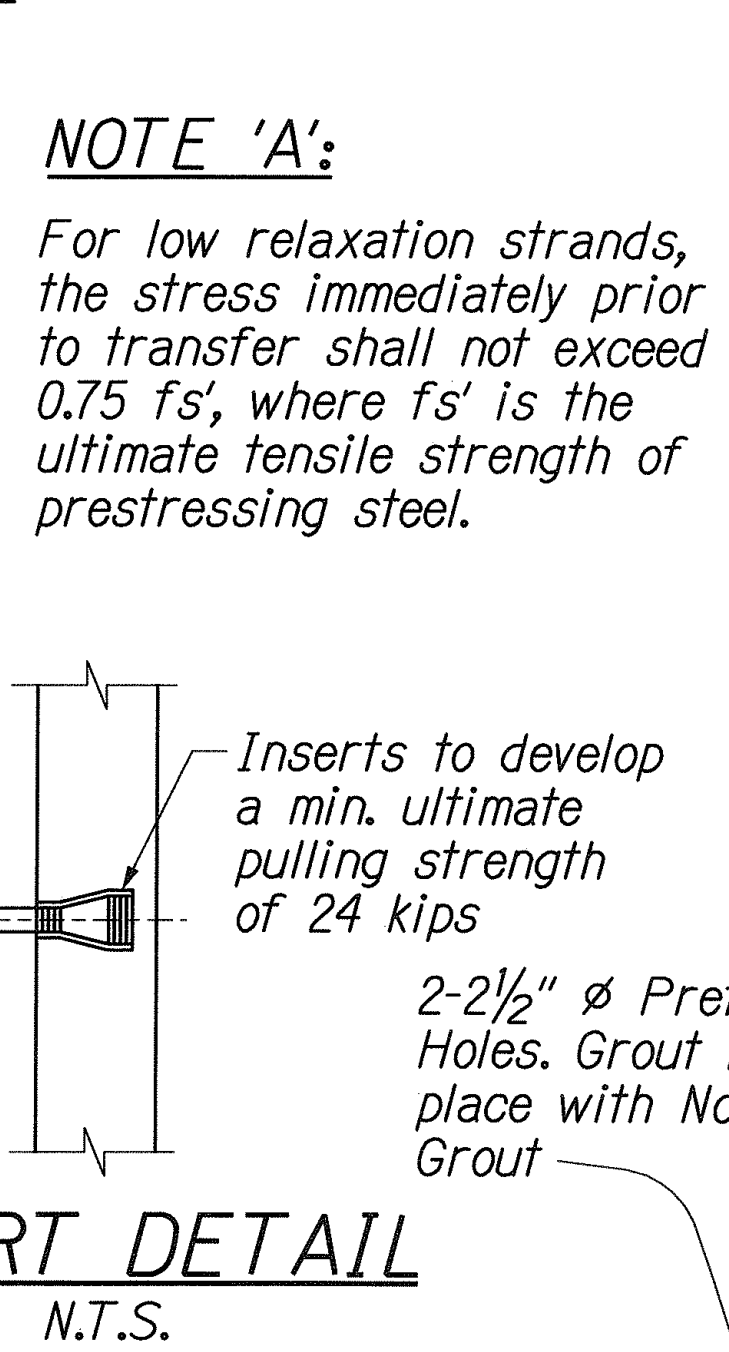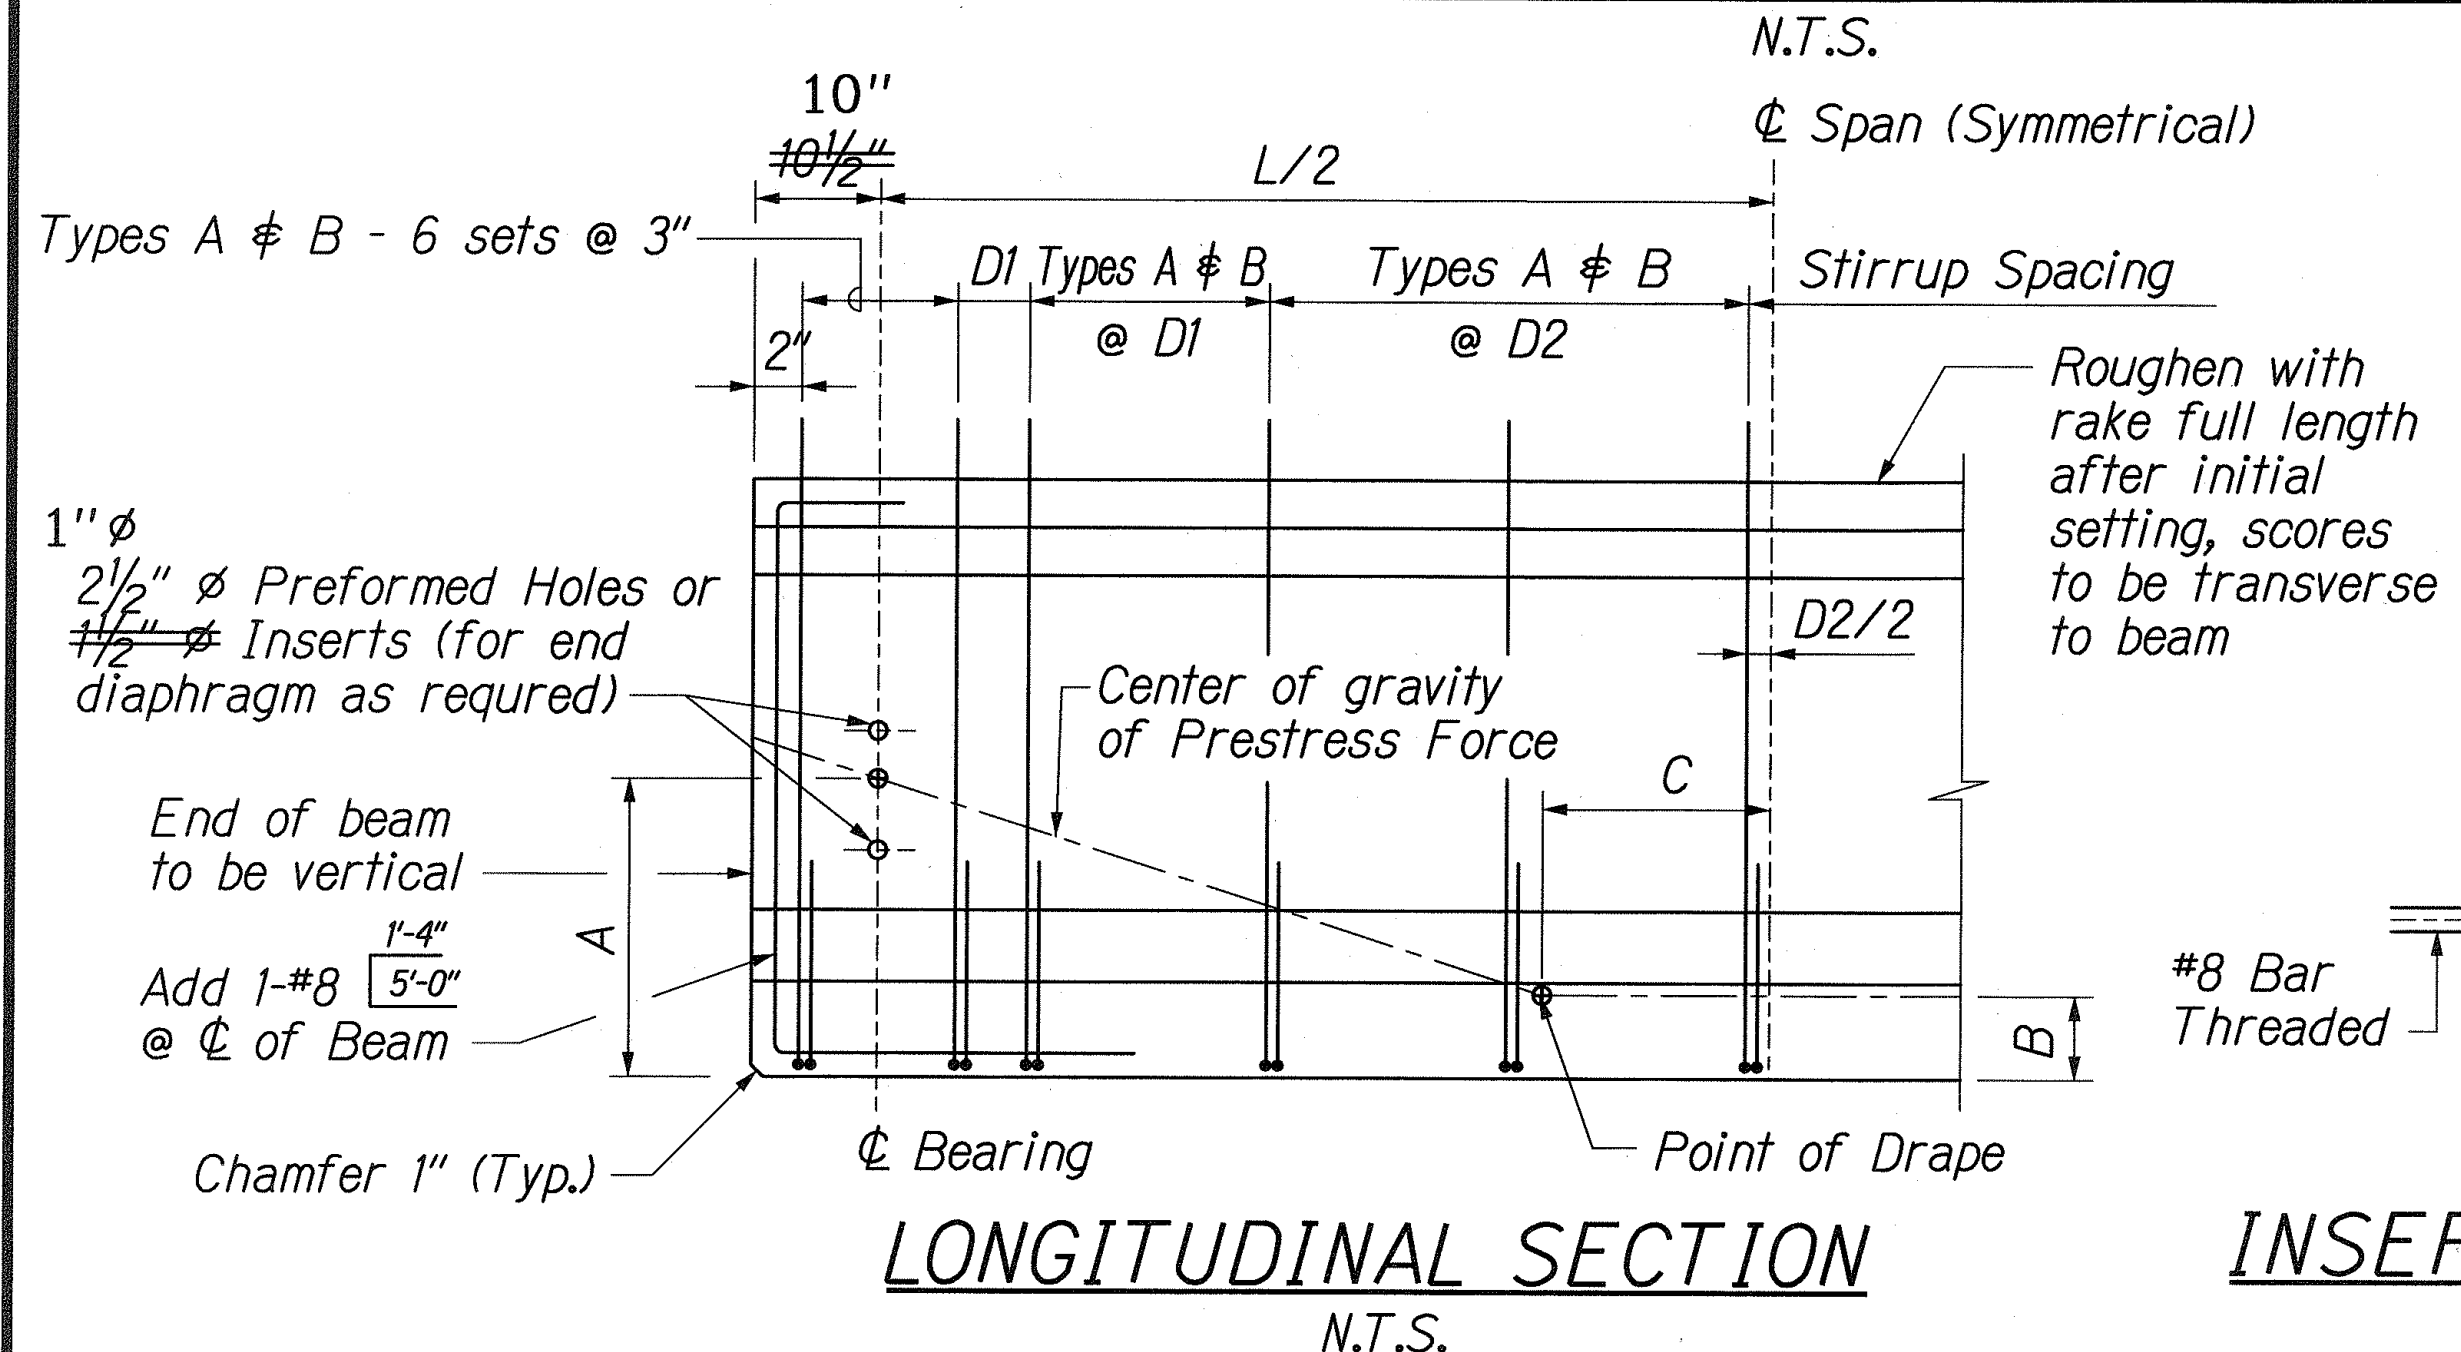

BEAM SCHEDULE										
BEAM TYPE	INITIAL PRESTRESS FORCE (KIPS) (BEFORE ANY LOSS)	FINAL PRESTRESS FORCE (KIPS) (AFTER ALL LOSSES)	CALCULATED CAMBER SEE NOTE 5	DEAD LOAD DEFLECTION SEE NOTE 6	LOCATION OF CENTER OF GRAVITY OF PRESTRESSED FORCE			STIRRUPS		REMARKS
					DIST A	DIST B	DIST. TO PT. OF DRAPE C	NO. OF STIRRUPS @ SPACING D1	NO. OF STIRRUPS @ SPACING D2	
II	619.65	457.30	-0.700"	0.432"	11.6"	7.2"	4.5'	11 @ 12"	Balance @ 18"	4500

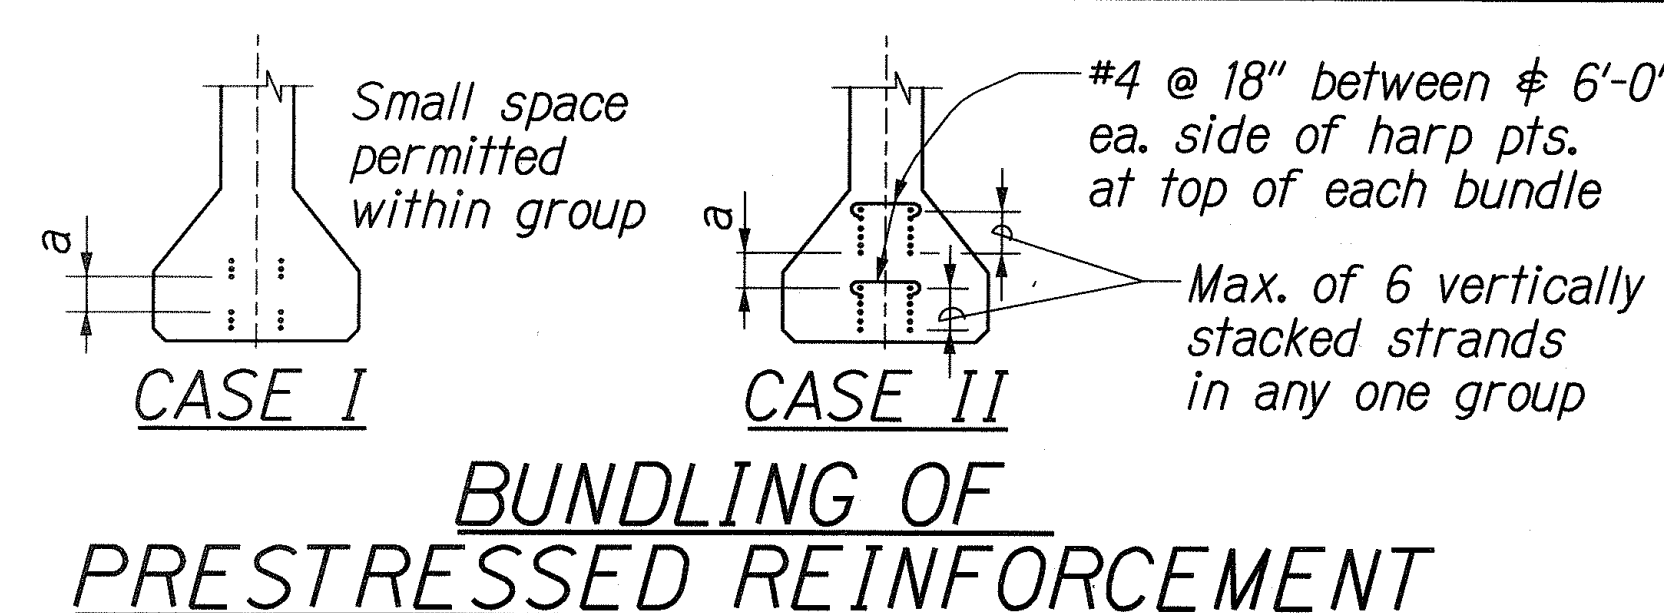


- ARRANGEMENT AND CLEARANCE FOR PRETENSIONED STRANDS**
- Strands may be bundled in groups as shown.
 - The min. distance "a" between groups or individual strands is 2" for 1/2" ϕ Strands.
 - "a" is measured between centers of adjacent strands.

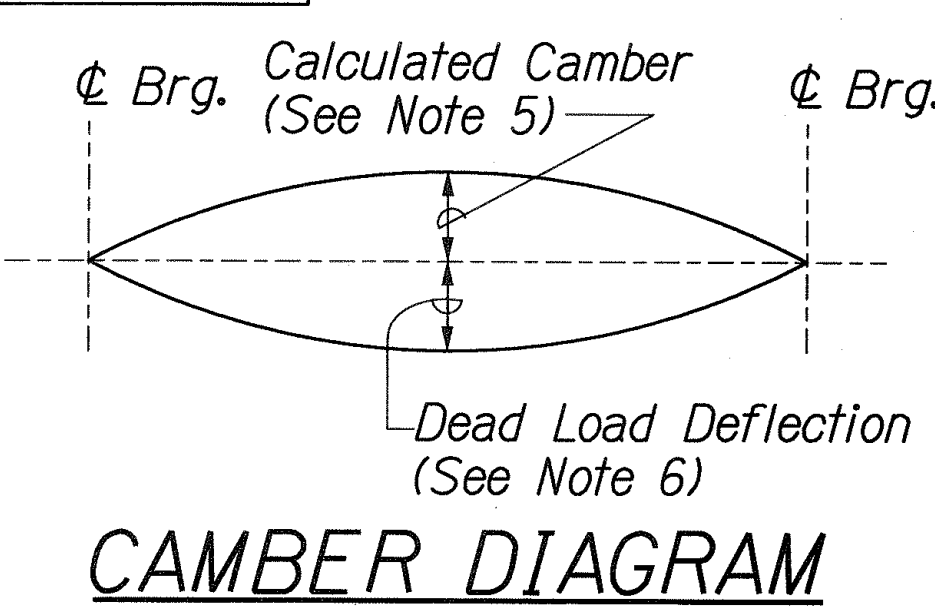


LEGEND FOR AS-BUILT POSTINGS

	Squiggly line for as-built deletion
	Double line for as-built deletion
	Text for as-built posting

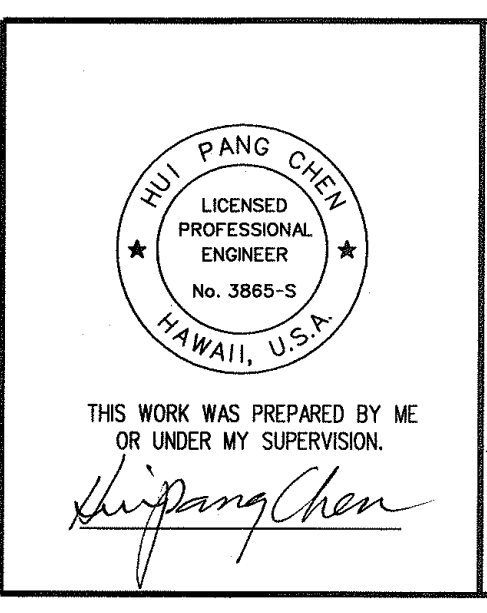


STATE OF HAWAII
DEPARTMENT OF TRANSPORTATION
HIGHWAYS DIVISION
PALEAAHU STREAM BRIDGE
PRESTRESSED BEAM DETAILS
KUIHELANI HIGHWAY WIDENING
HONOAPIILANI HIGHWAY TO PUUNENE AVENUE
FEDERAL-AID PROJECT NO. NH-0380(9)
Scale: Not to Scale Date: Sept. 14, 2001
SHEET No. S-9 OF 54 SHEETS

FED. ROAD DIST. NO.	STATE	FED. AID PROJ. NO.	FISCAL YEAR	SHEET NO.	TOTAL SHEETS
HAWAII	HAW.	NH-0380(9)	2000	172	380

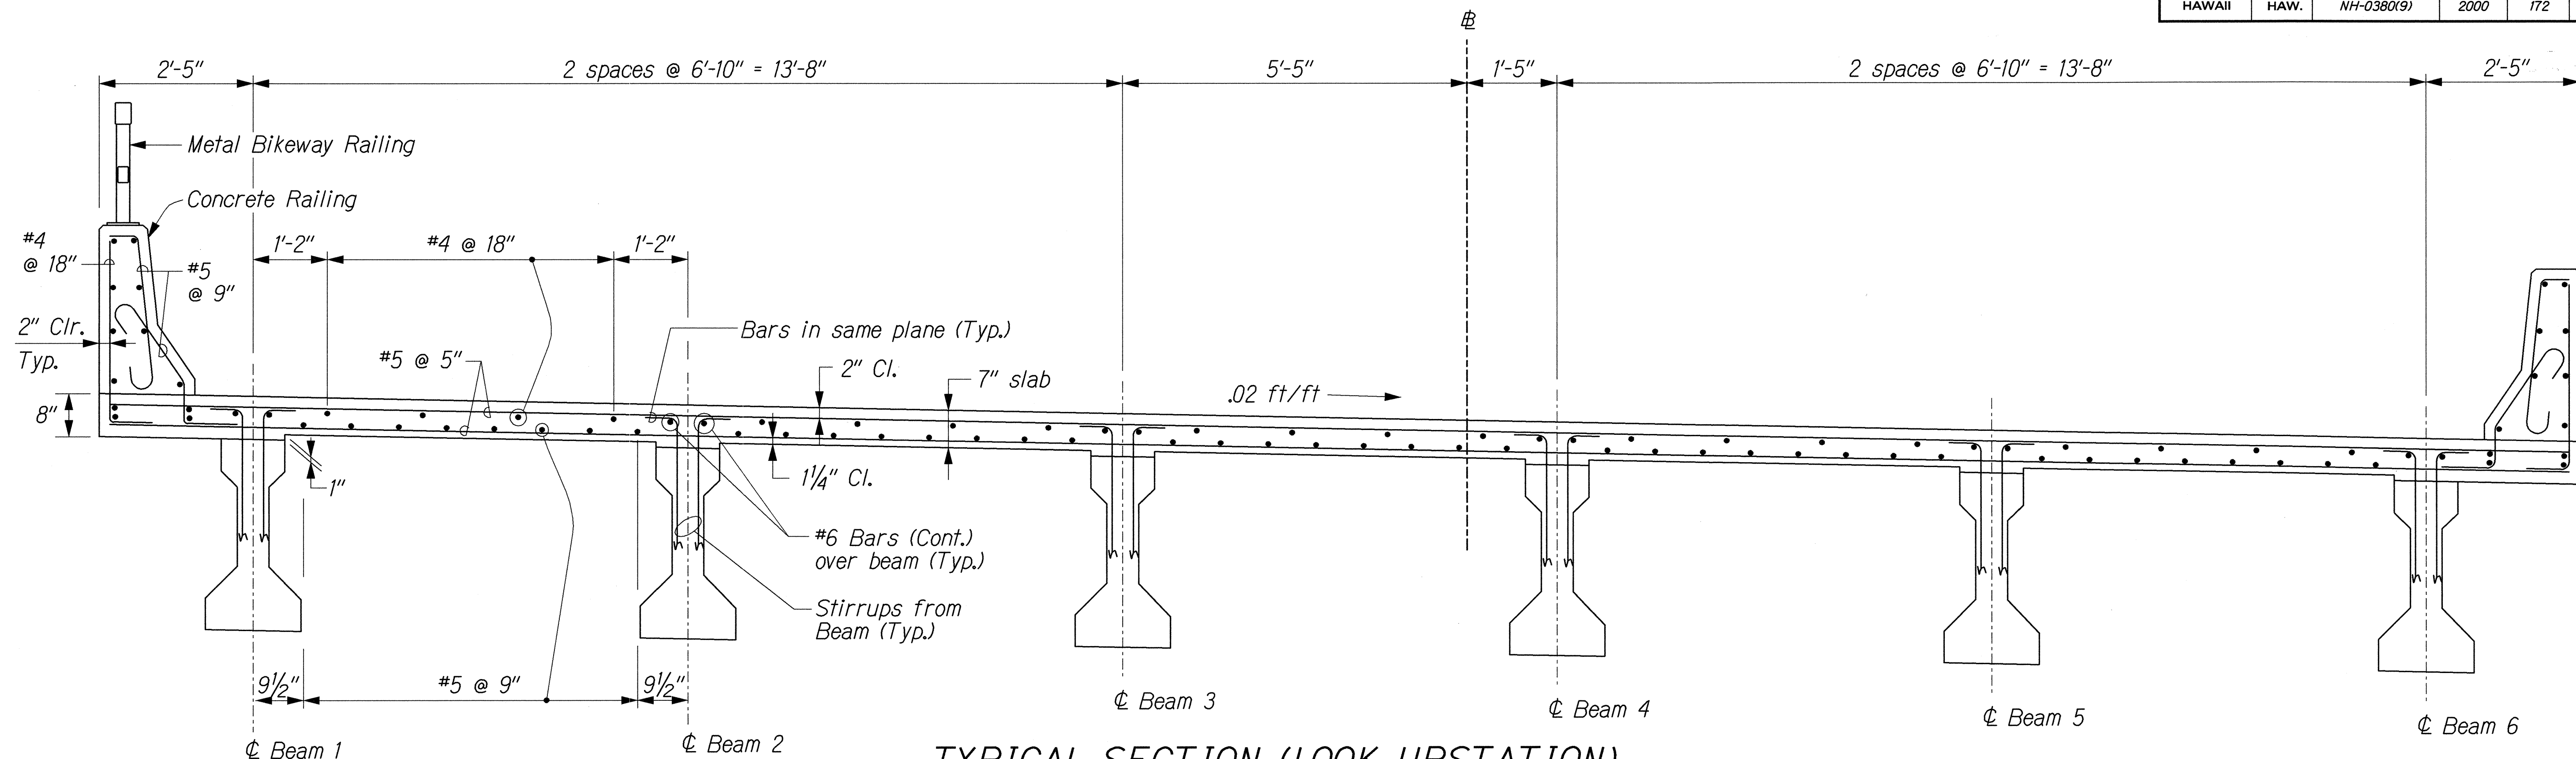


TYPICAL SECTION (LOOK UPSTATION)

Scale: $\frac{3}{4}" = 1'-0"$

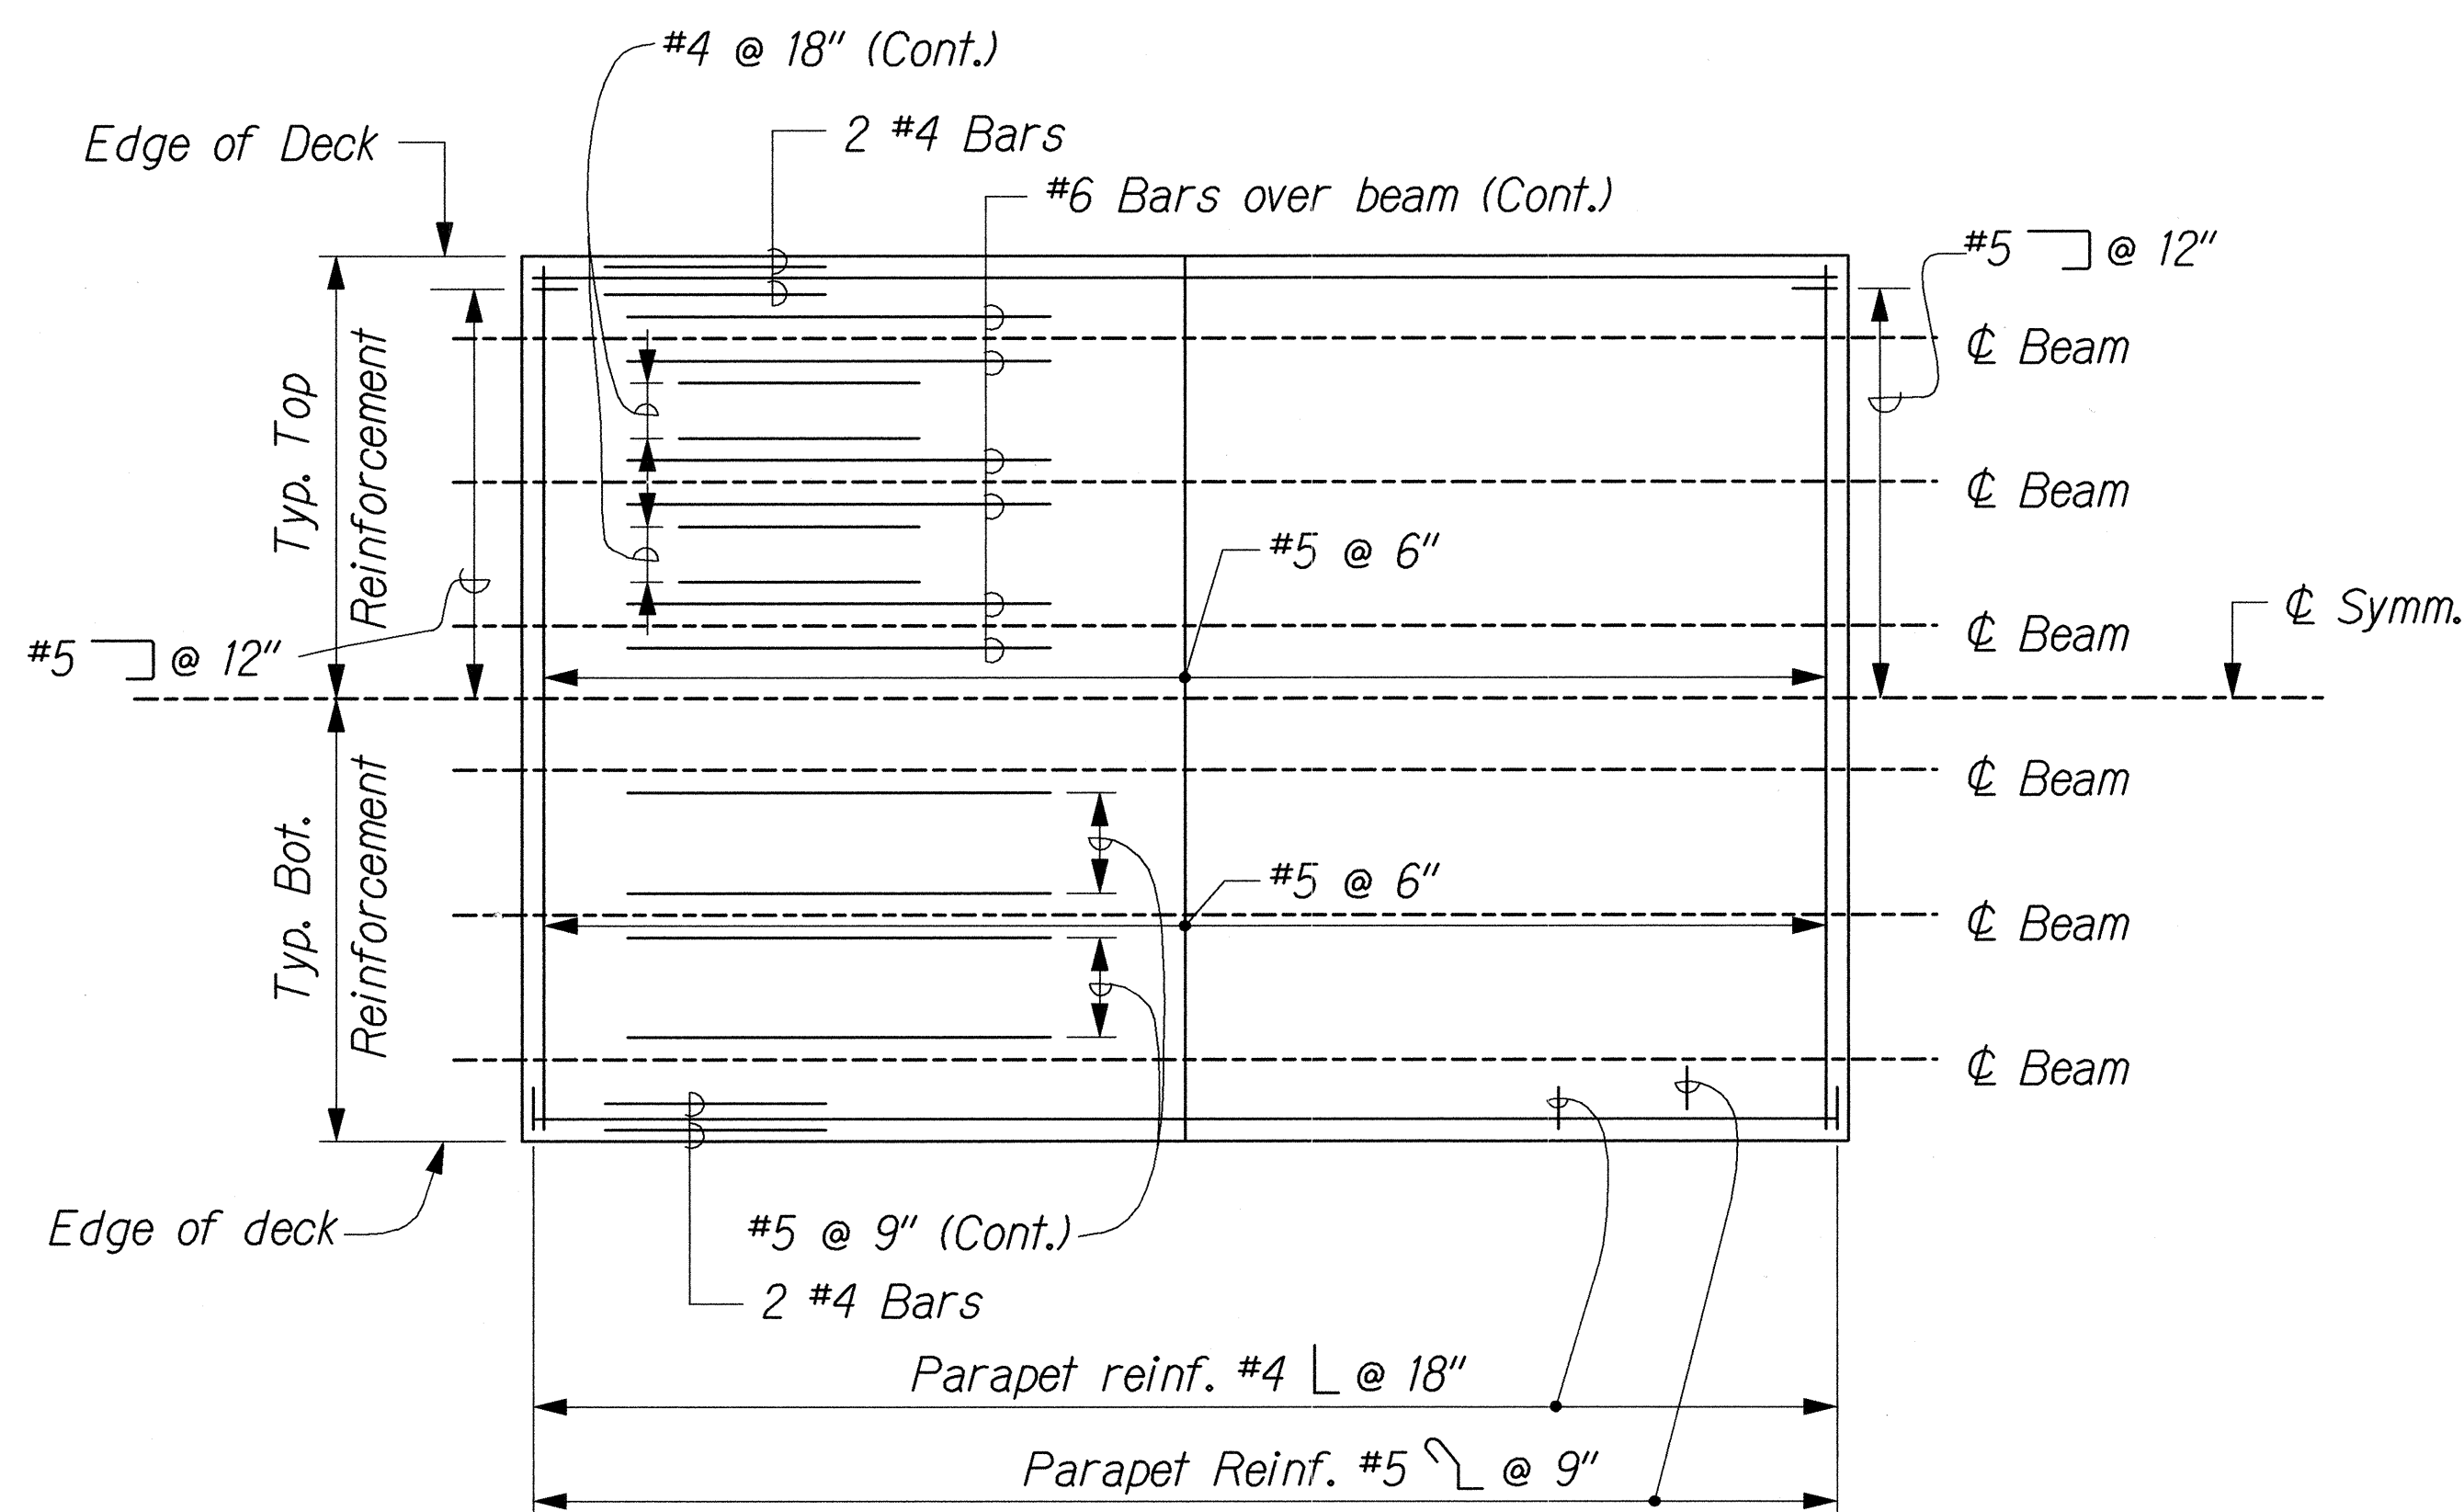

TYPICAL DECK REINF. PLAN

Not to Scale

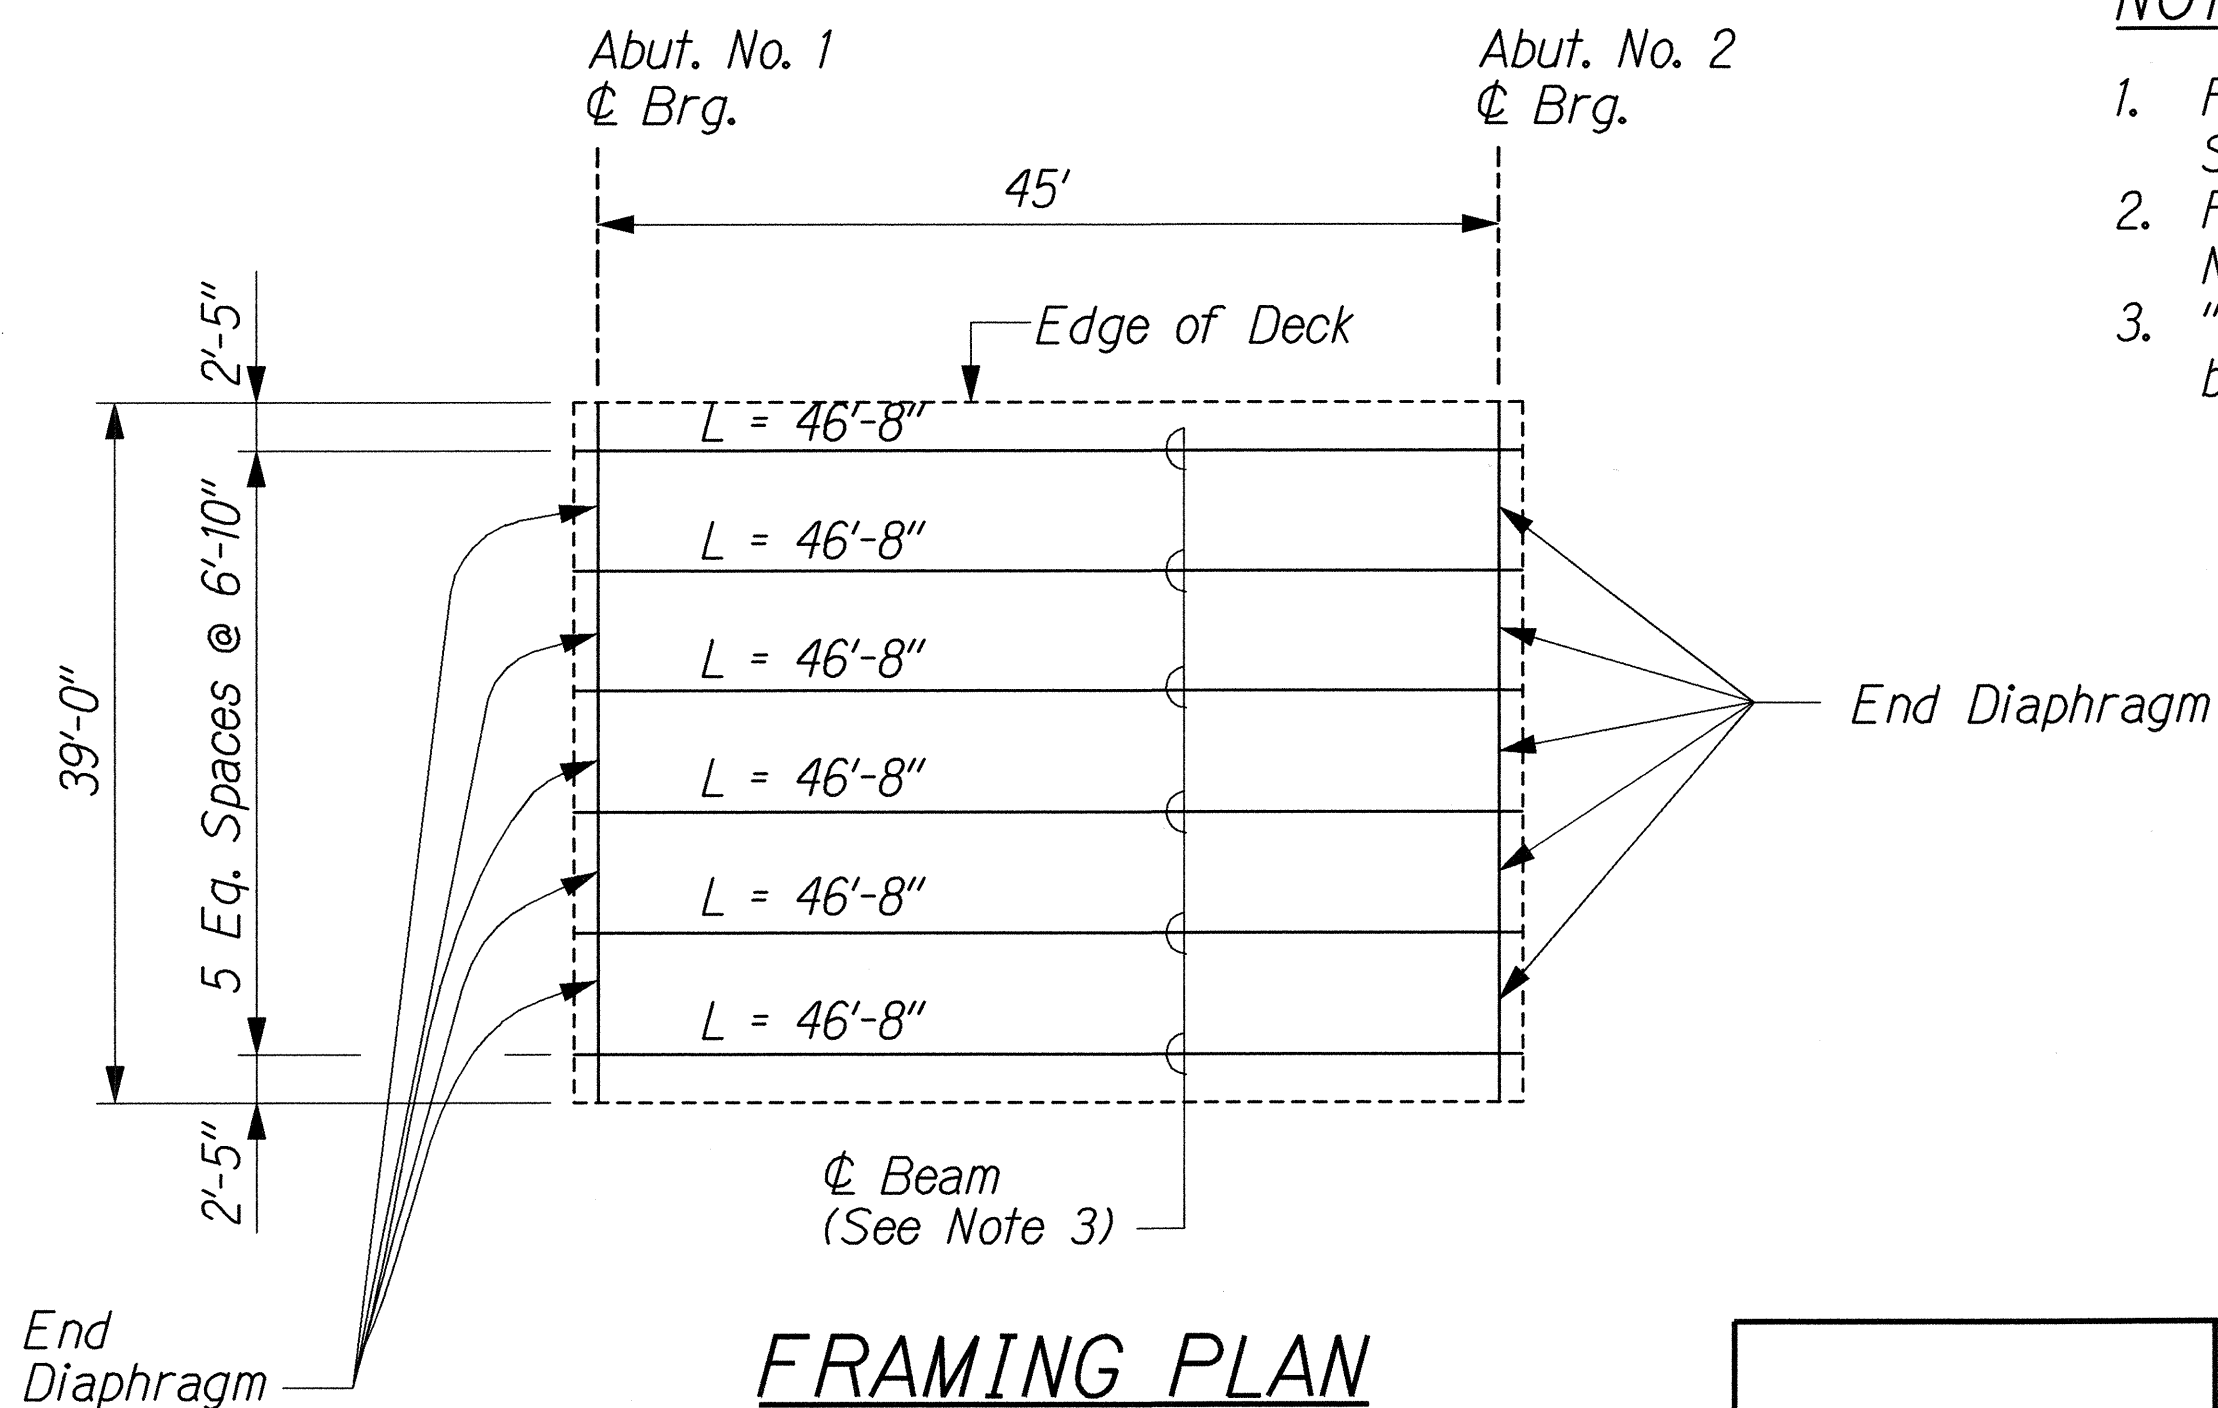

FRAMING PLAN

Not to Scale

NOTES:

1. For Concrete Railing Details, see Sheet No. S-32.
2. For Metal Bikeway Railing, see Sheet No. S-34.
3. "L" denotes the total length of beam along Level line.

ORIGINAL PLAN	SURVEY PLOTTED BY	DATE
NOTE BOOK	DRAWN BY	
	DESIGNED BY	
	CHECKED BY	
	BY	

J:\KUIHELANI\STRUCT\ST-DET16.dgn



THIS WORK WAS PREPARED BY ME OR UNDER MY SUPERVISION.

Hui Pang Chen


STATE OF HAWAII
DEPARTMENT OF TRANSPORTATION
HIGHWAYS DIVISION

PALEAAHU STREAM BRIDGE
DECK REINF. & FRAMING PLAN
KUIHELANI HIGHWAY WIDENING
HONOAPIILANI HIGHWAY TO PUUNENE AVENUE
FEDERAL-AID PROJECT NO. NH-0380(9)
Scale: As Shown Date: Sept. 14, 2001

FED. ROAD DIST. NO.	STATE	FED. AID PROJ. NO.	FISCAL YEAR	SHEET NO.	TOTAL SHEETS
HAWAII	HAW.	NH-0380(9)	2000	173	380

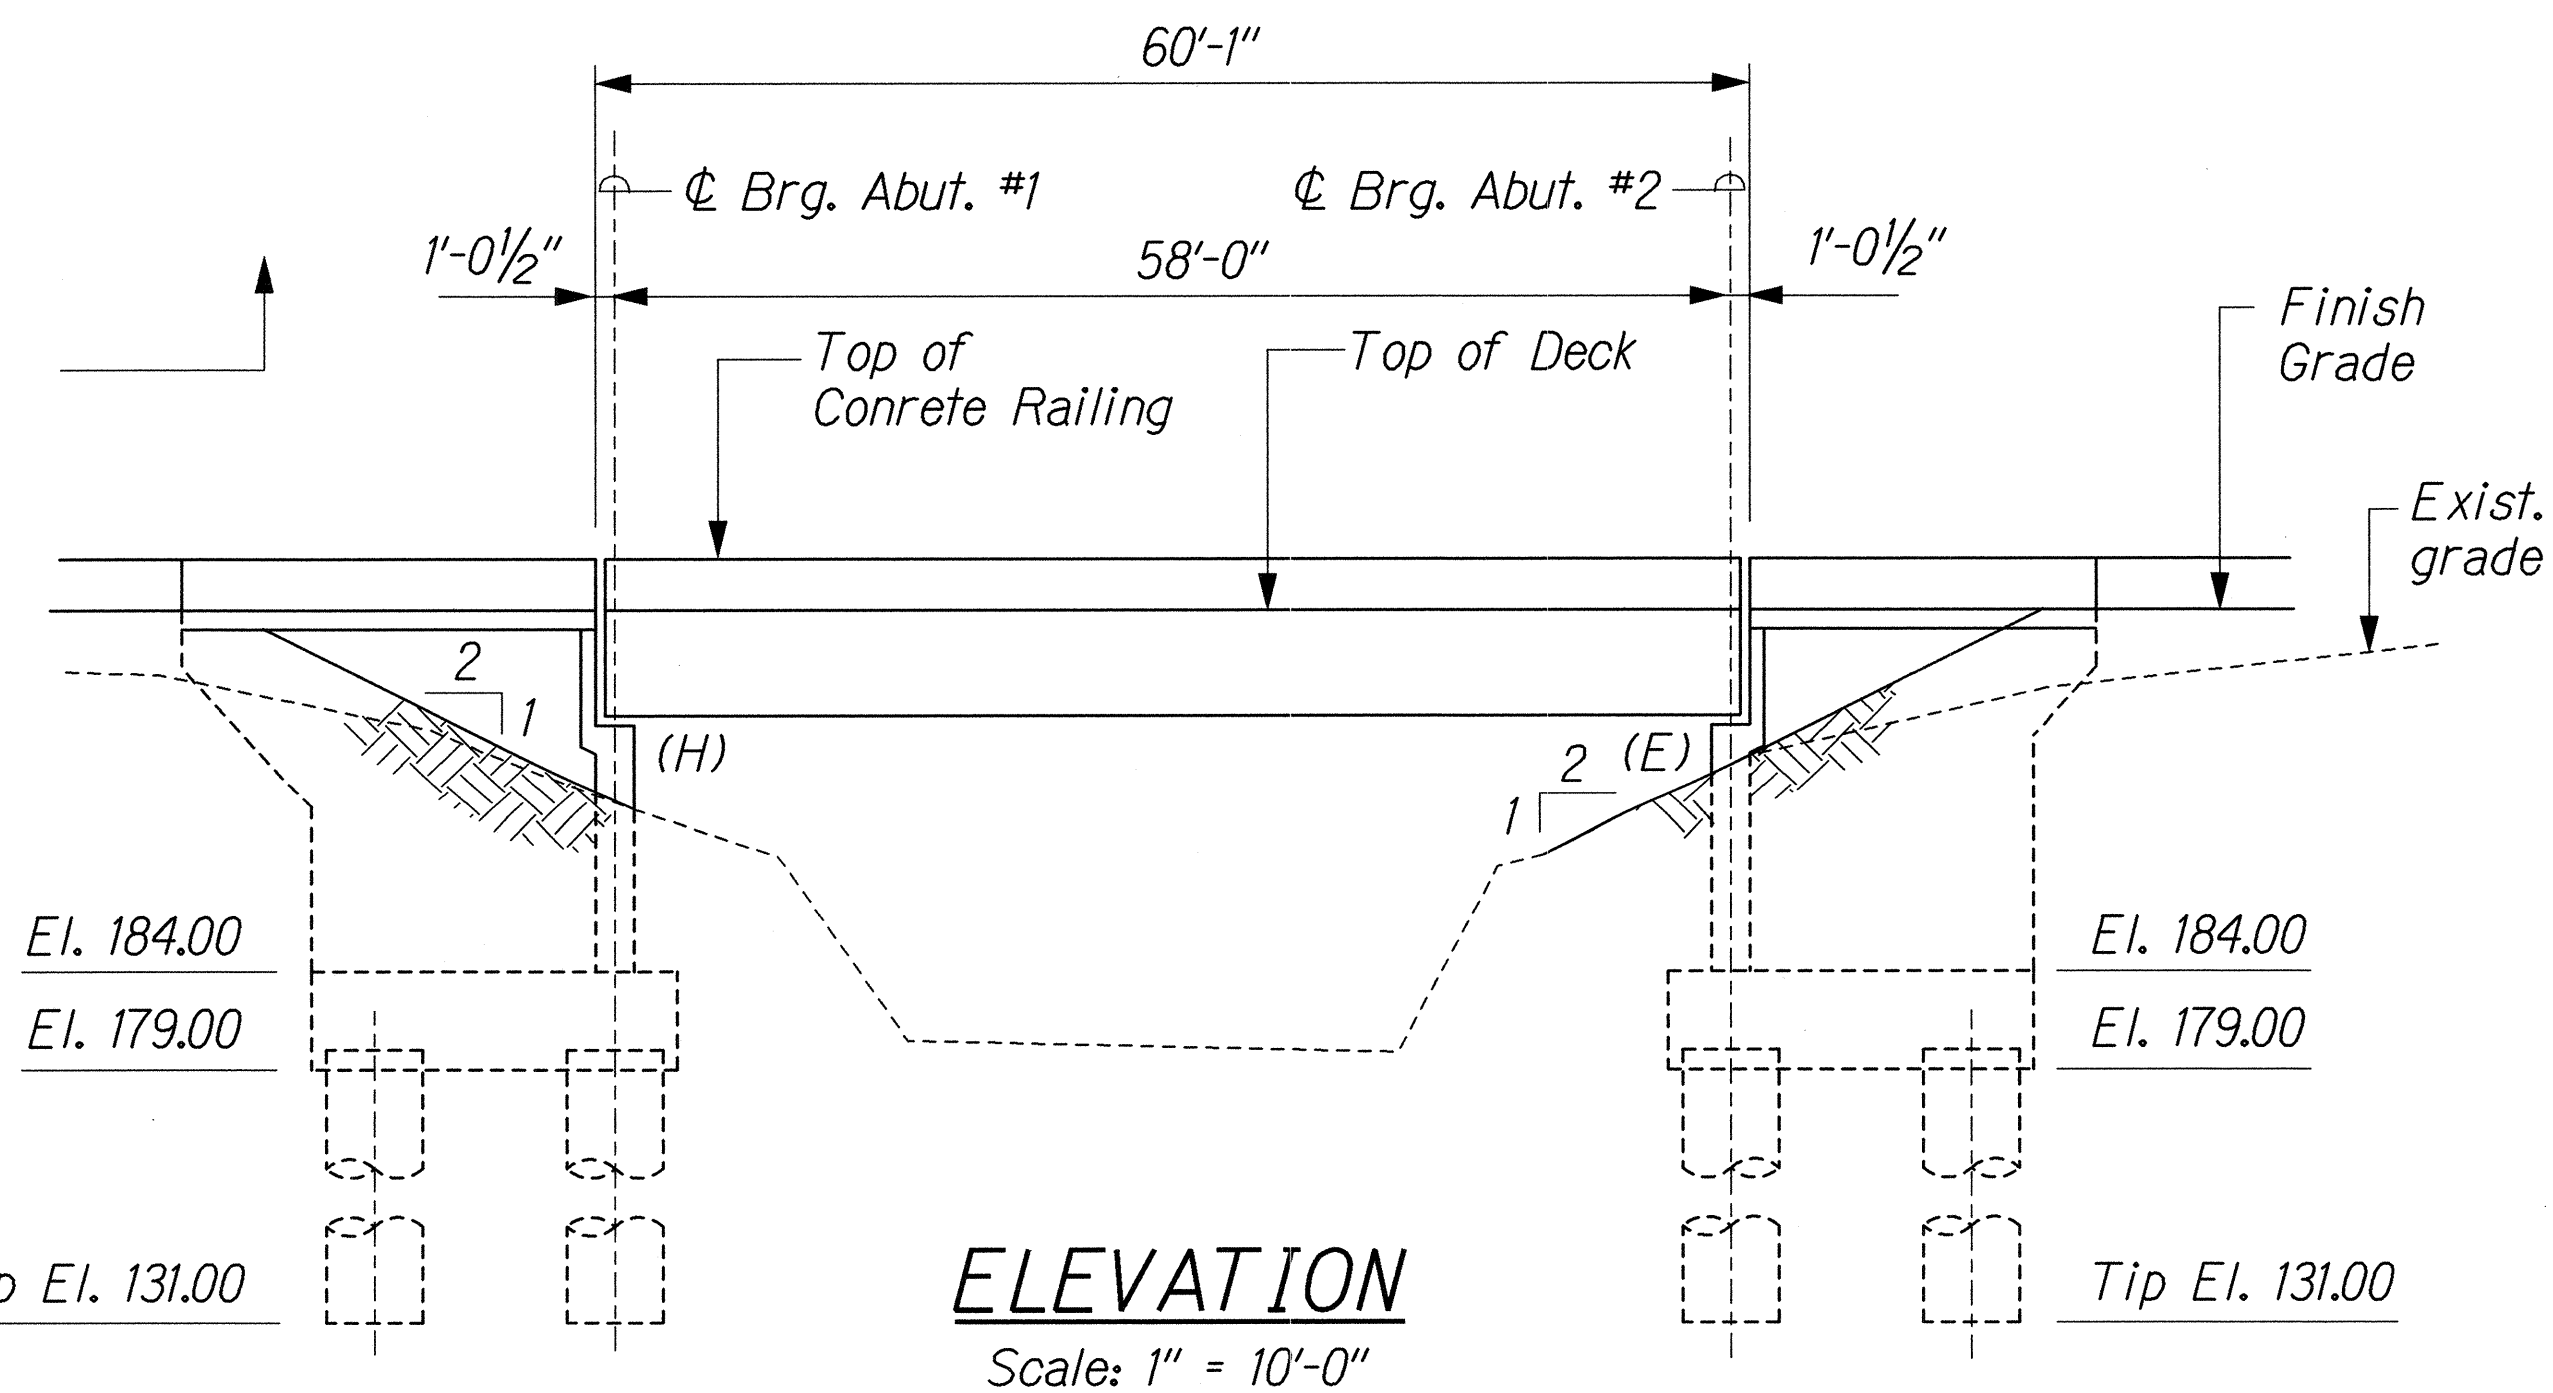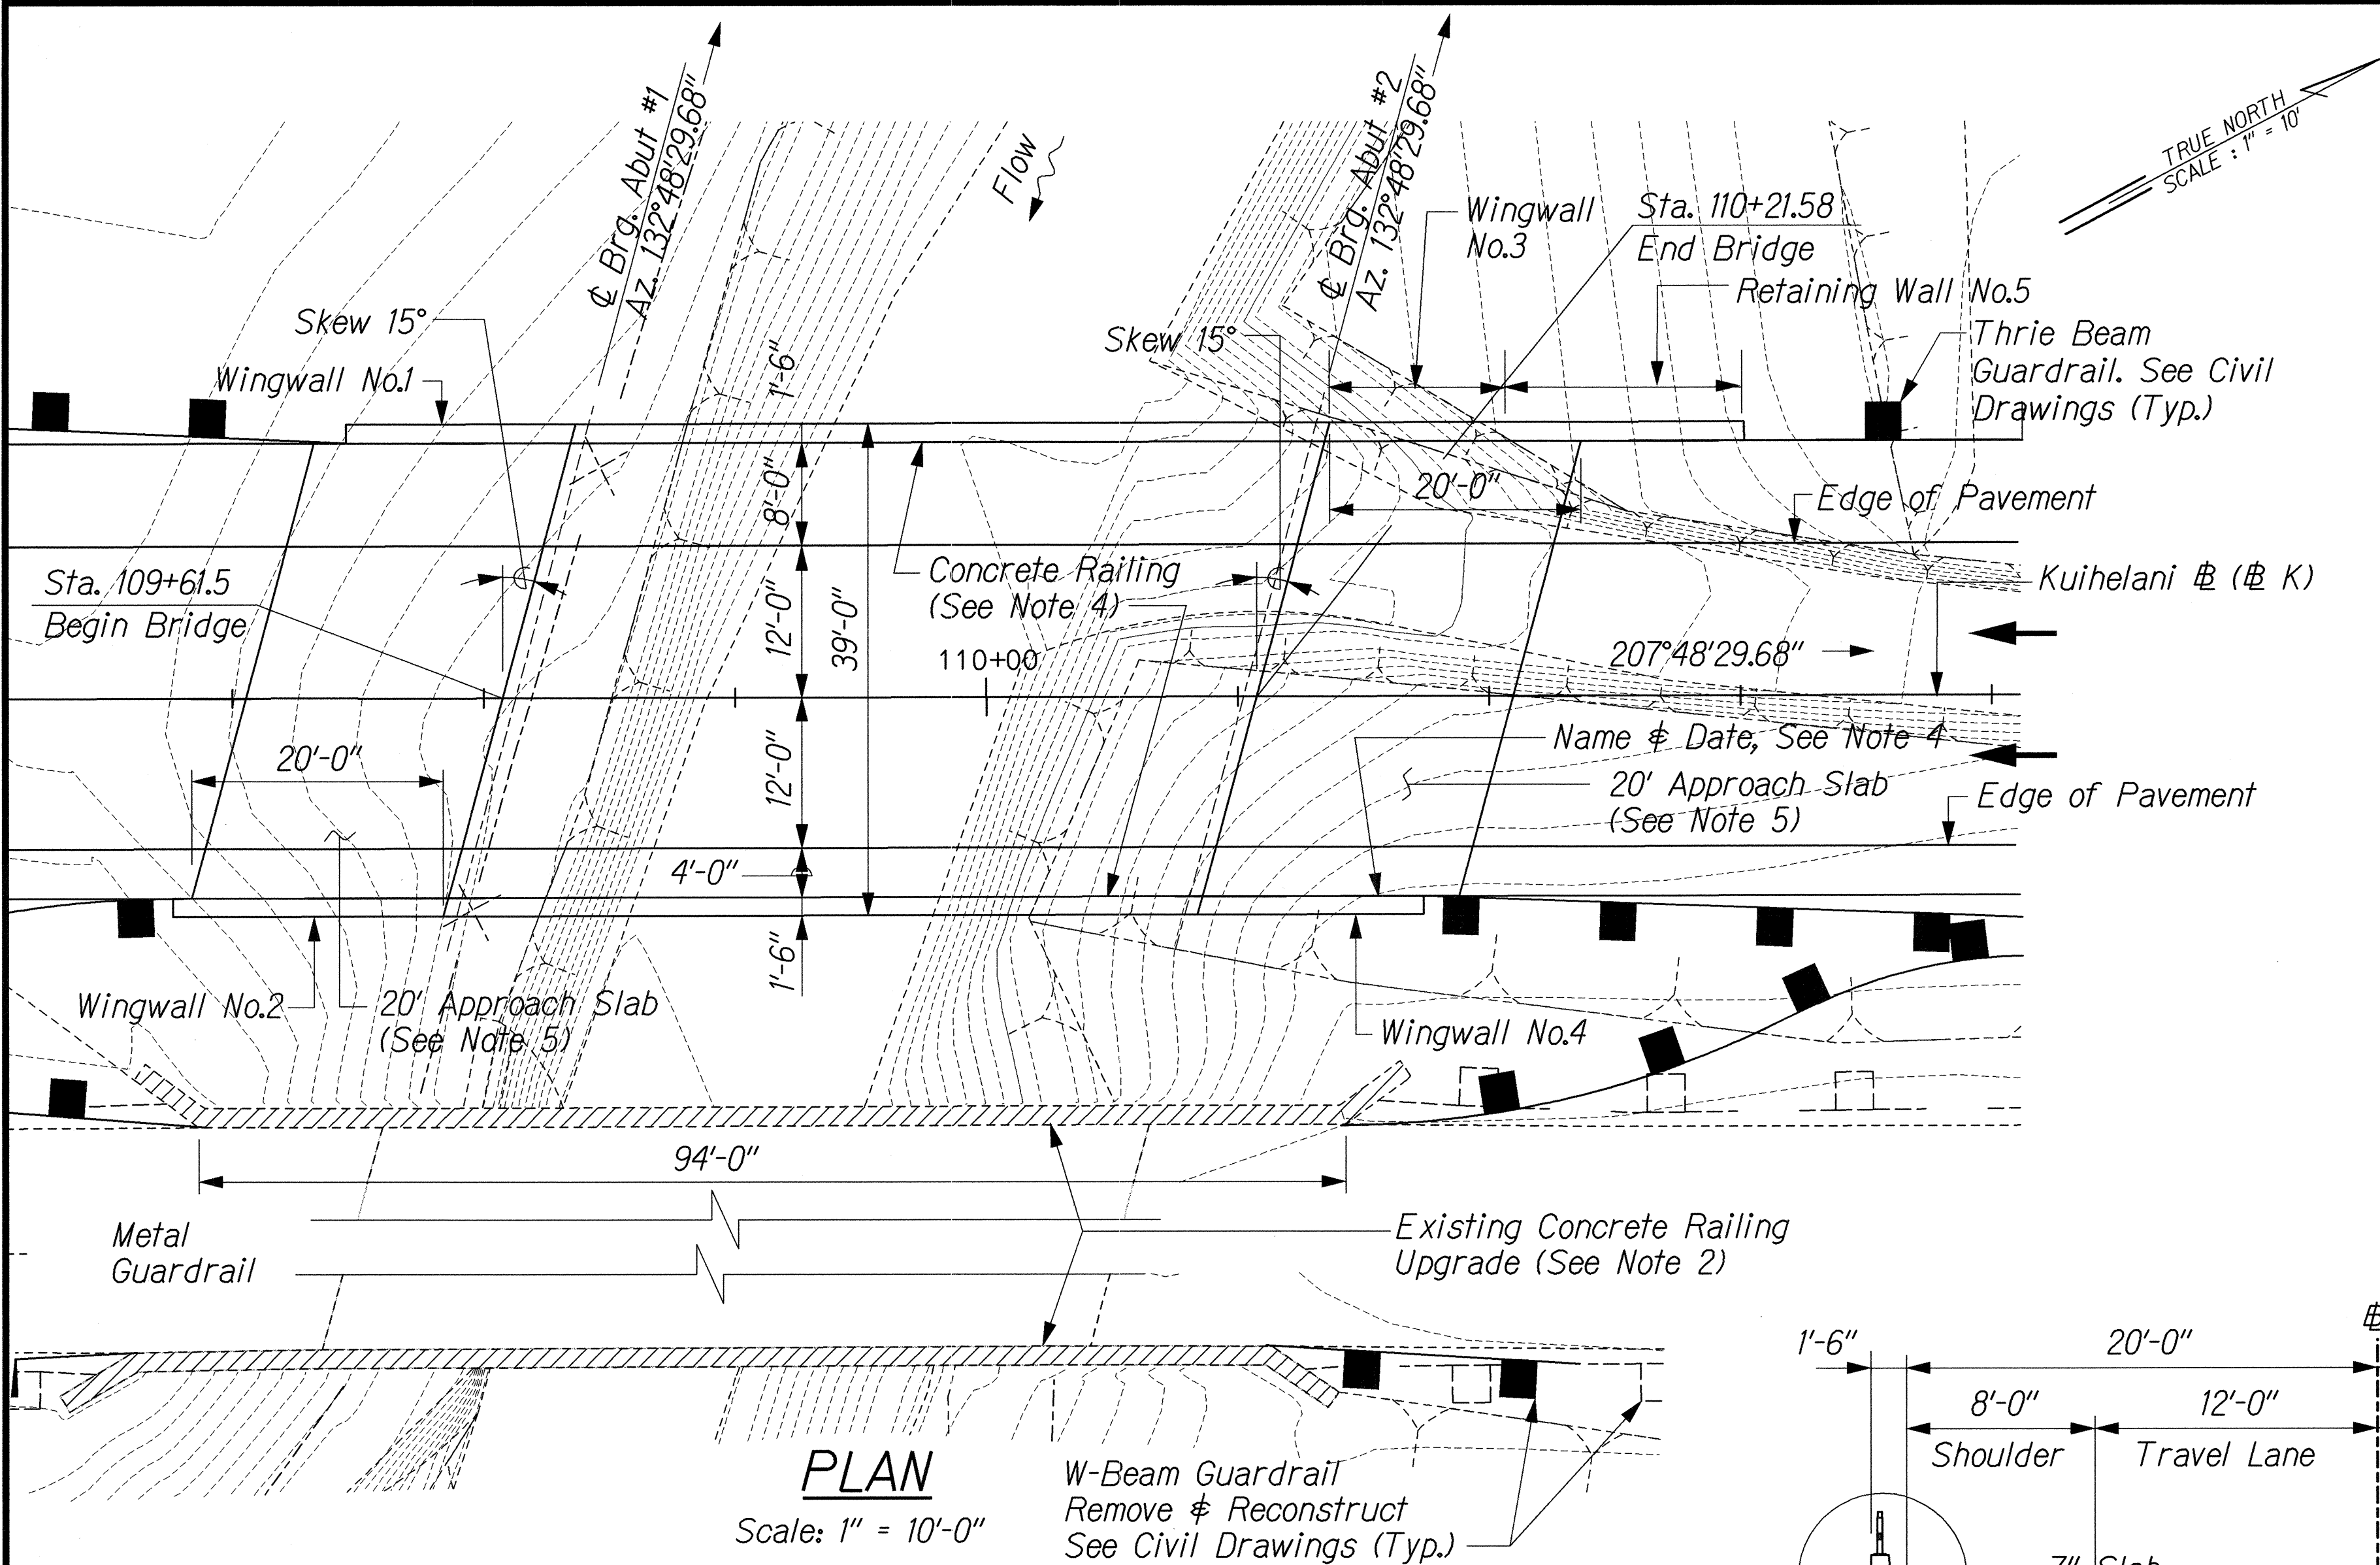

ESTIMATED QUANTITIES				
ITEM NO.	ITEM	UNIT	QUANTITIES	
206.	Structure Excavation For Abutments & Walls	CY	765	
206.	Structure Backfill For Abutments & Walls	CY	448	
646.	Geocomposite Drain For Abutments & Walls	SY	192	
503.	Concrete In Bridge (Except Footing)	LS	(221 CY)	
503.	Concrete In Bridge Footing	LS	(180 CY)	
503.	Concrete In Approach Slab	LS	(54 CY)	
504.	AASHTO Type III Prestressed Concrete Beam	LF	359	
507.	Concrete Railing (Include End Post)	LF	211	
507.	Metal Bikeway Railing	LF	206	
507.	Upgrade of Existing Concrete Railing	LF	188	
511.	Drilled Shafts	LF	588	
511.	Load Test For Drilled Shafts	EA	1	
602.	Reinforcing Steel For Bridge	LS	(80,280 Lbs)	

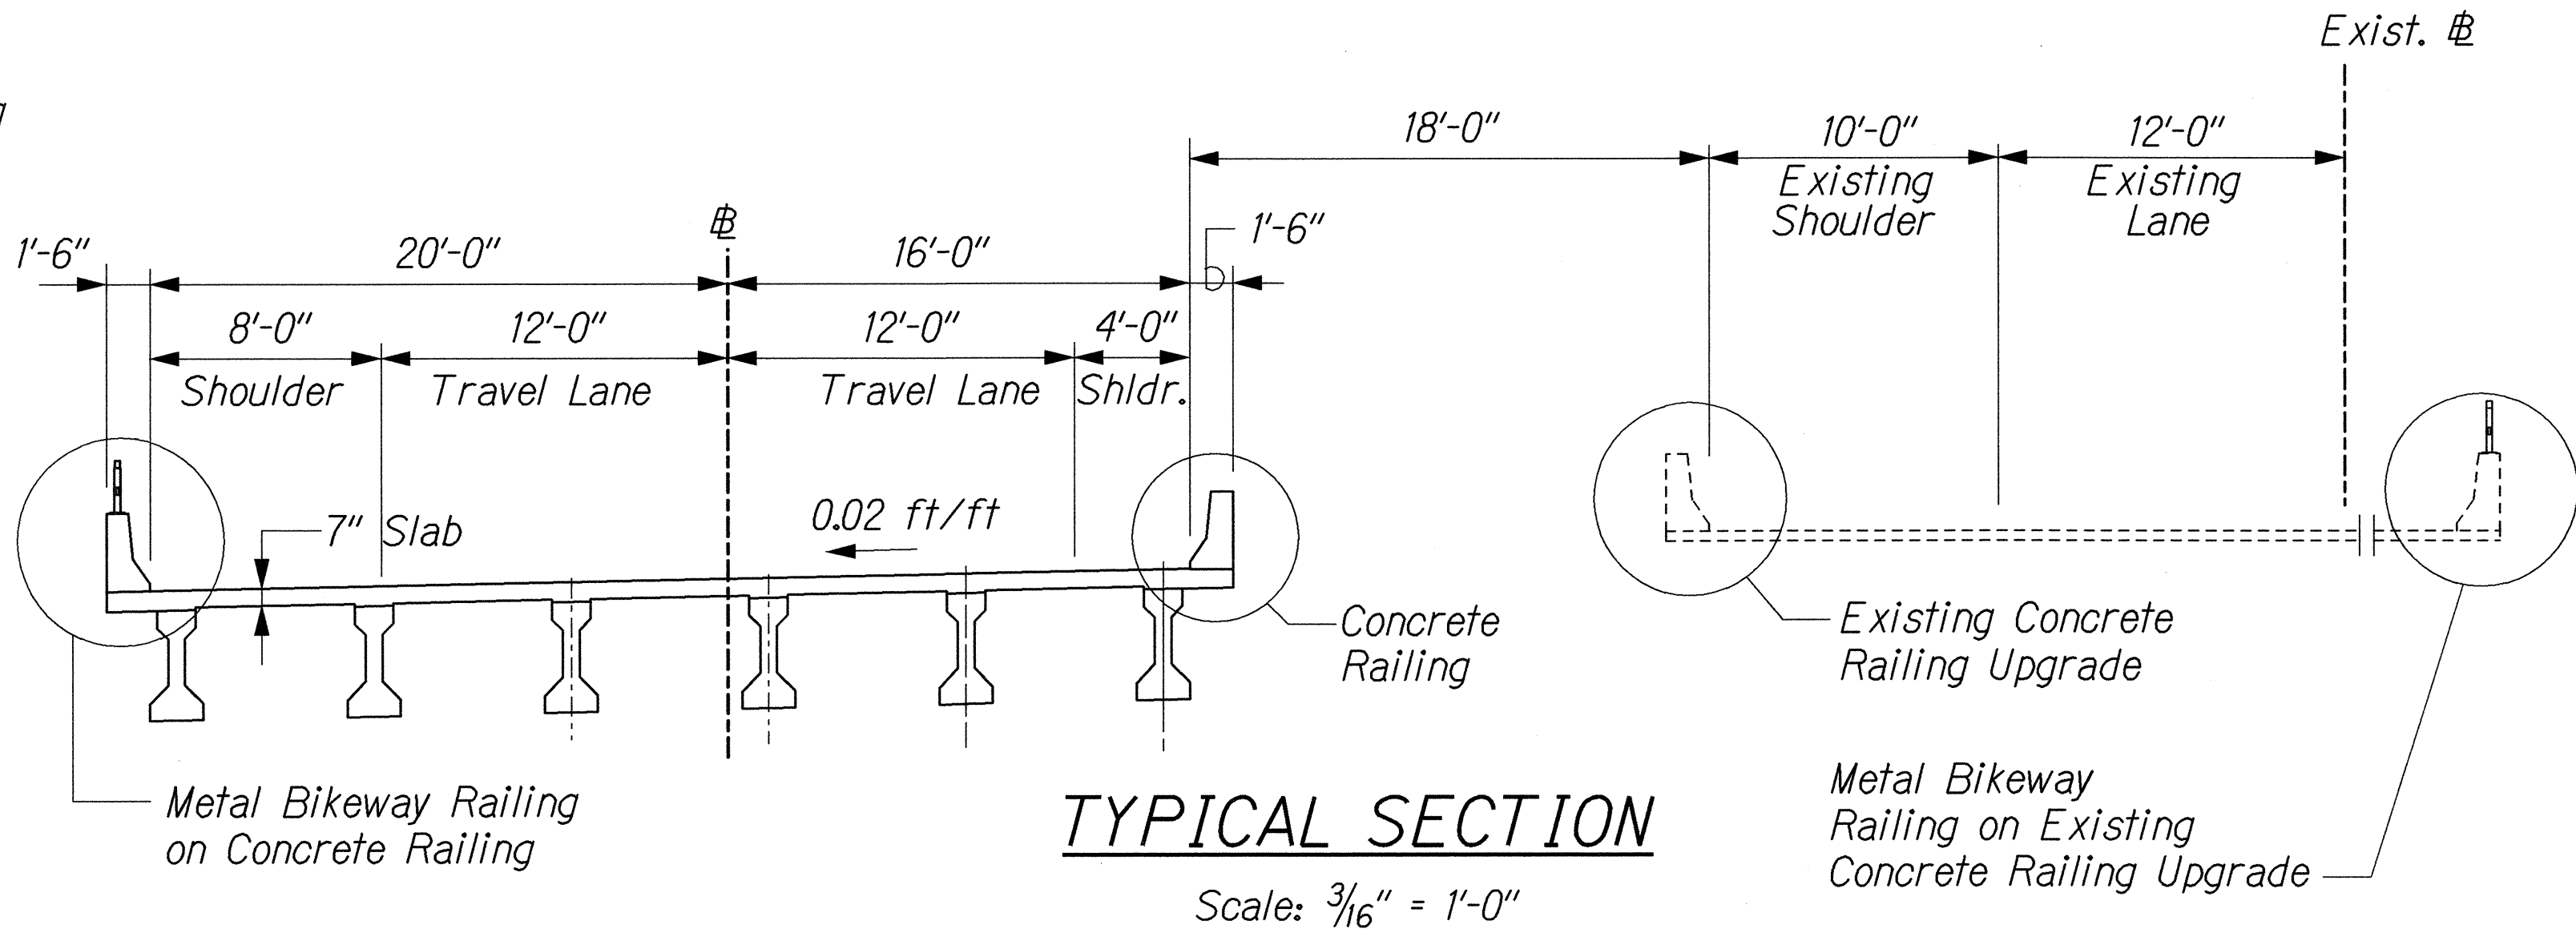

- NOTES:**
- For General Notes, See Sht. No. S-2
 - For Existing Concrete Railing Upgrade Details, See Sht. No. S-33
 - For Drilled Shaft details and Cut Off Elevation, See Sht. No. S-31
 - For Bridge Name & Date location, Concrete Railing Details, See Sht. No. S-32
 - For Approach Slab Details, See Sht. No. S-35
 - For Metal Bikeway Railing Details, See Sht. No. S-34
 - For Payment Limit, See Sht. No. S-30

ORIGINAL PLAN	SURVEY PLOTTED BY	DATE
NOTE BOOK	DRAWN BY	
	DESIGNED BY	
	CHECKED BY	
	BY	
	DATE	


THIS WORK WAS PREPARED BY ME OR UNDER MY SUPERVISION.

Hui Pang Chen


STATE OF HAWAII
DEPARTMENT OF TRANSPORTATION
HIGHWAYS DIVISION

WAIKAPU STREAM BRIDGE
PLAN, ELEVATION & SECTION
KUIHELANI HIGHWAY WIDENING
HONOAPIILANI HIGHWAY TO PUUNENE AVENUE
FEDERAL-AID PROJECT NO. NH-0380(9)
Scale: As Shown Date: Sept. 14, 2001

FED. ROAD DIST. NO.	STATE	FED. AID PROJ. NO.	FISCAL YEAR	SHEET NO.	TOTAL SHEETS
HAWAII	HAW.	NH-0380(9)	2000	C.O. 174	380

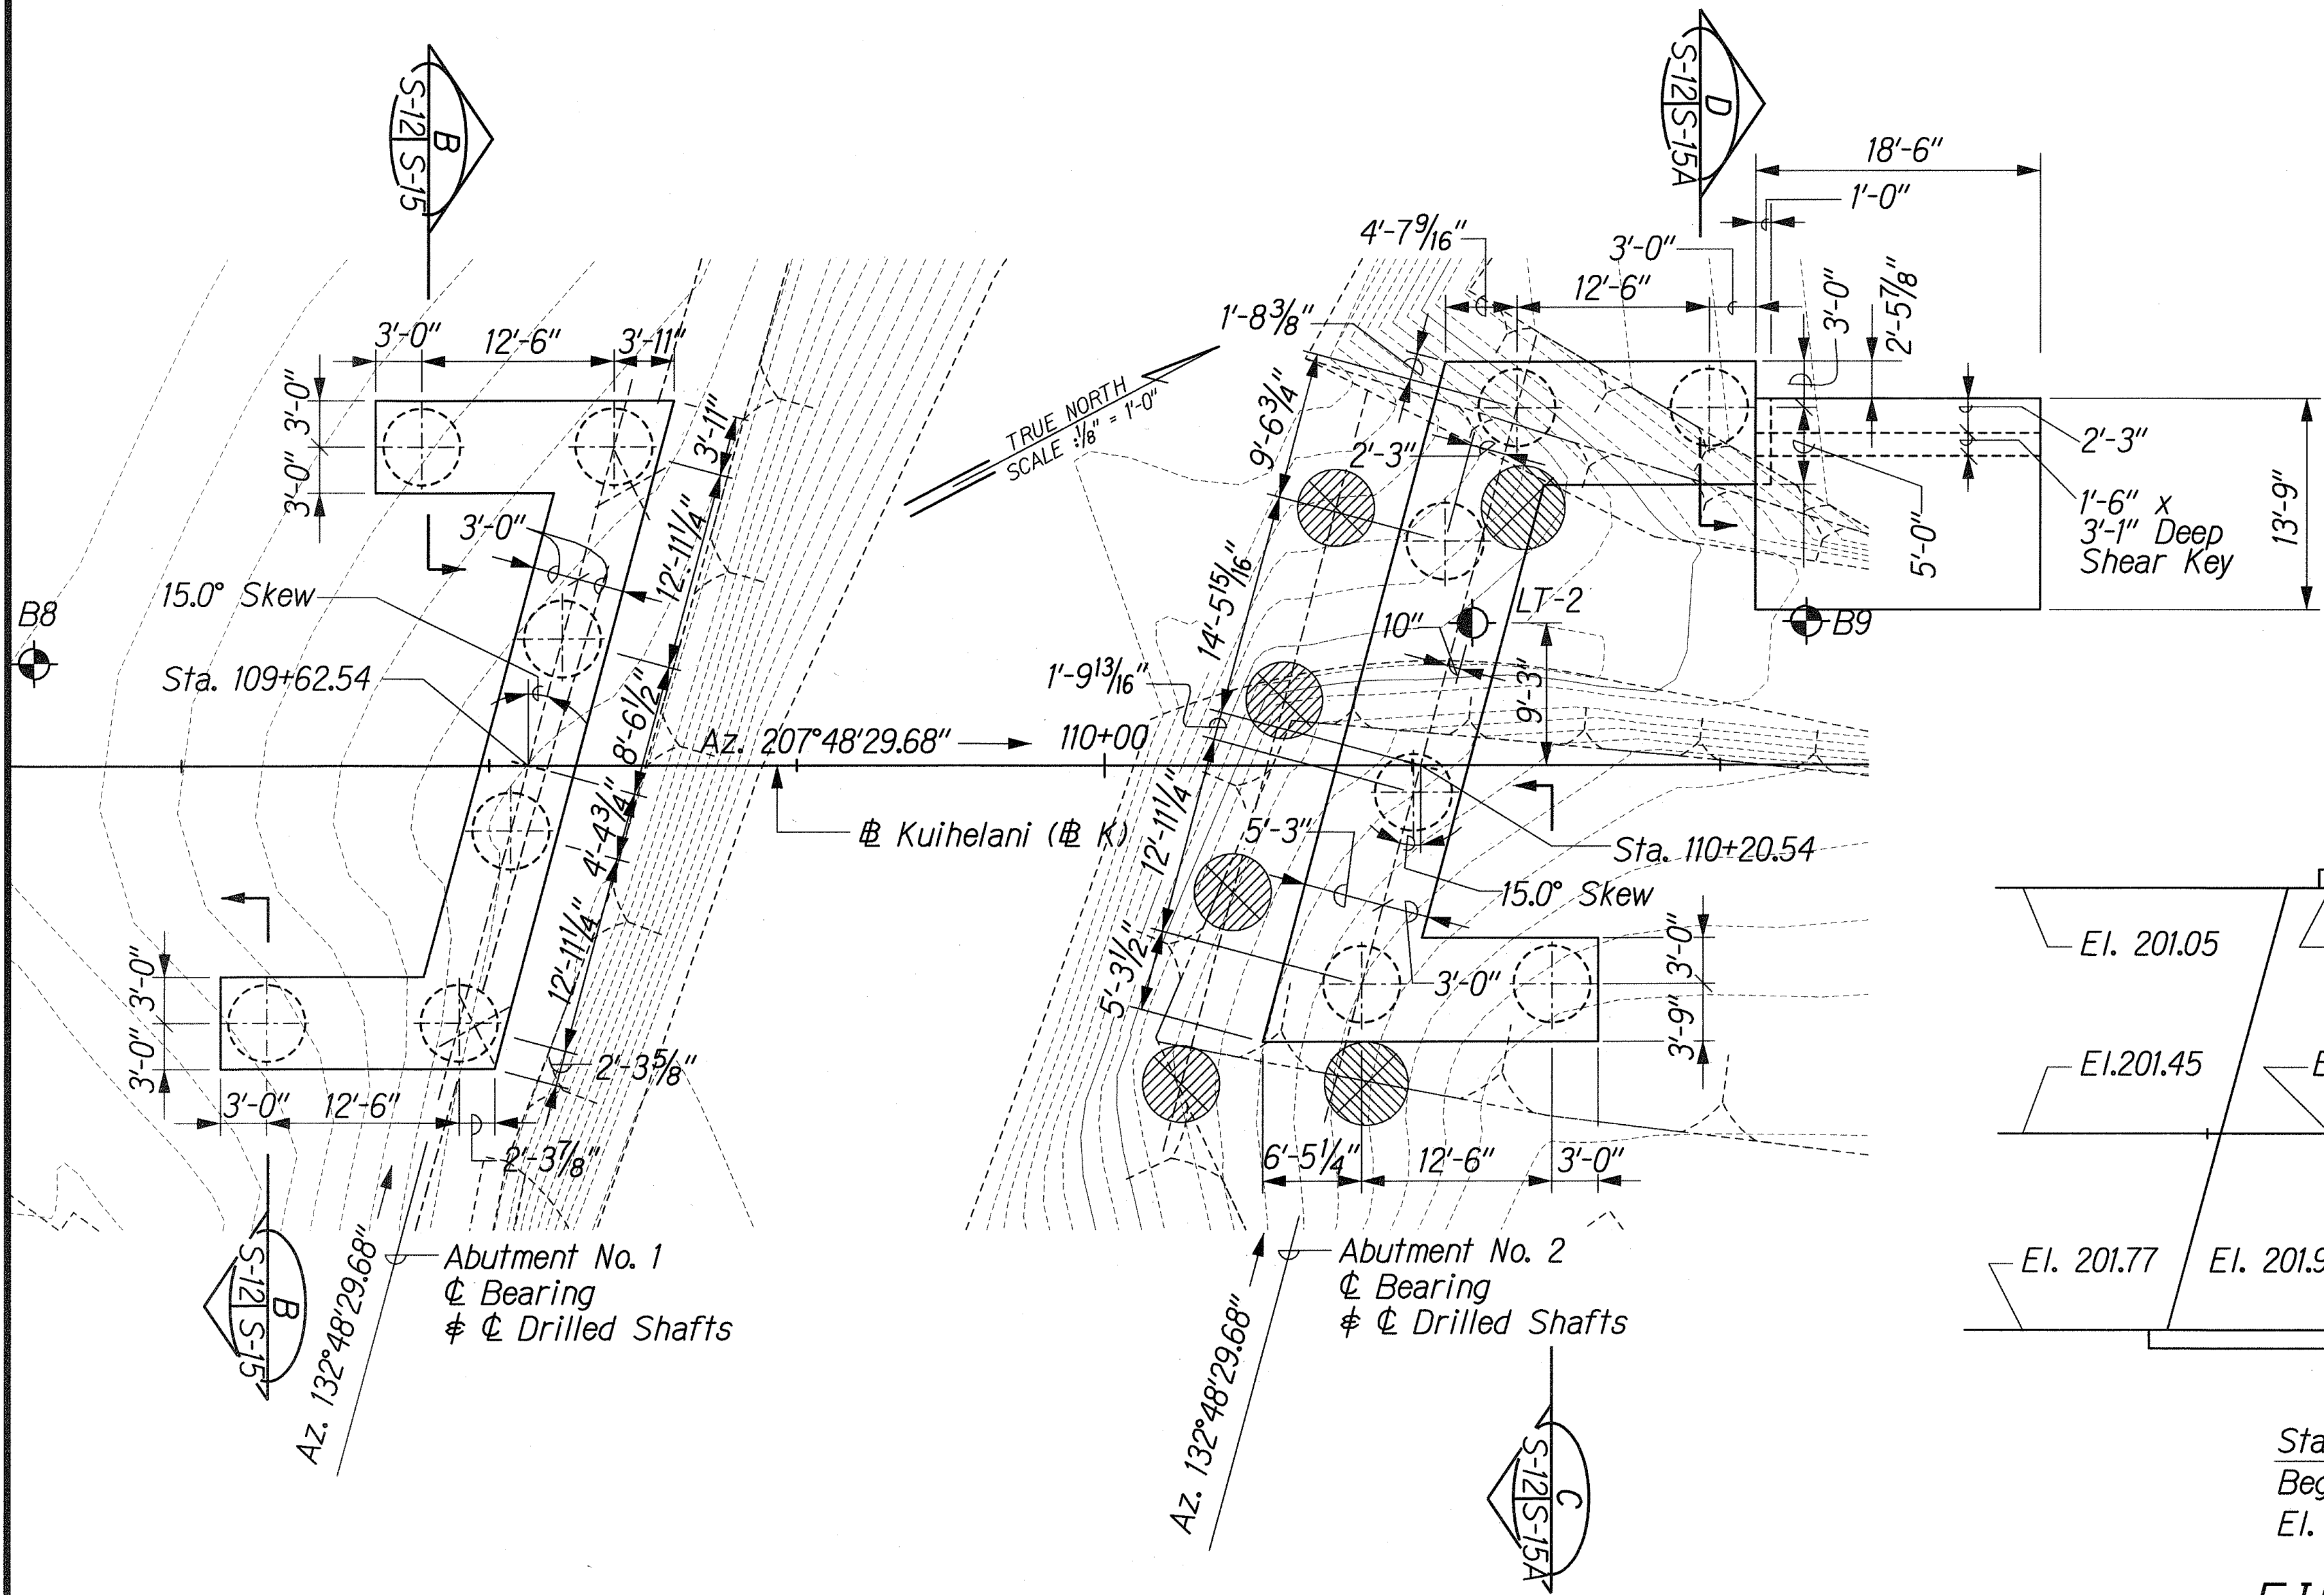

ABUTMENT NO. 1 & NO. 2 FOUNDATION PLAN
Scale: 1/8" = 1'-0"

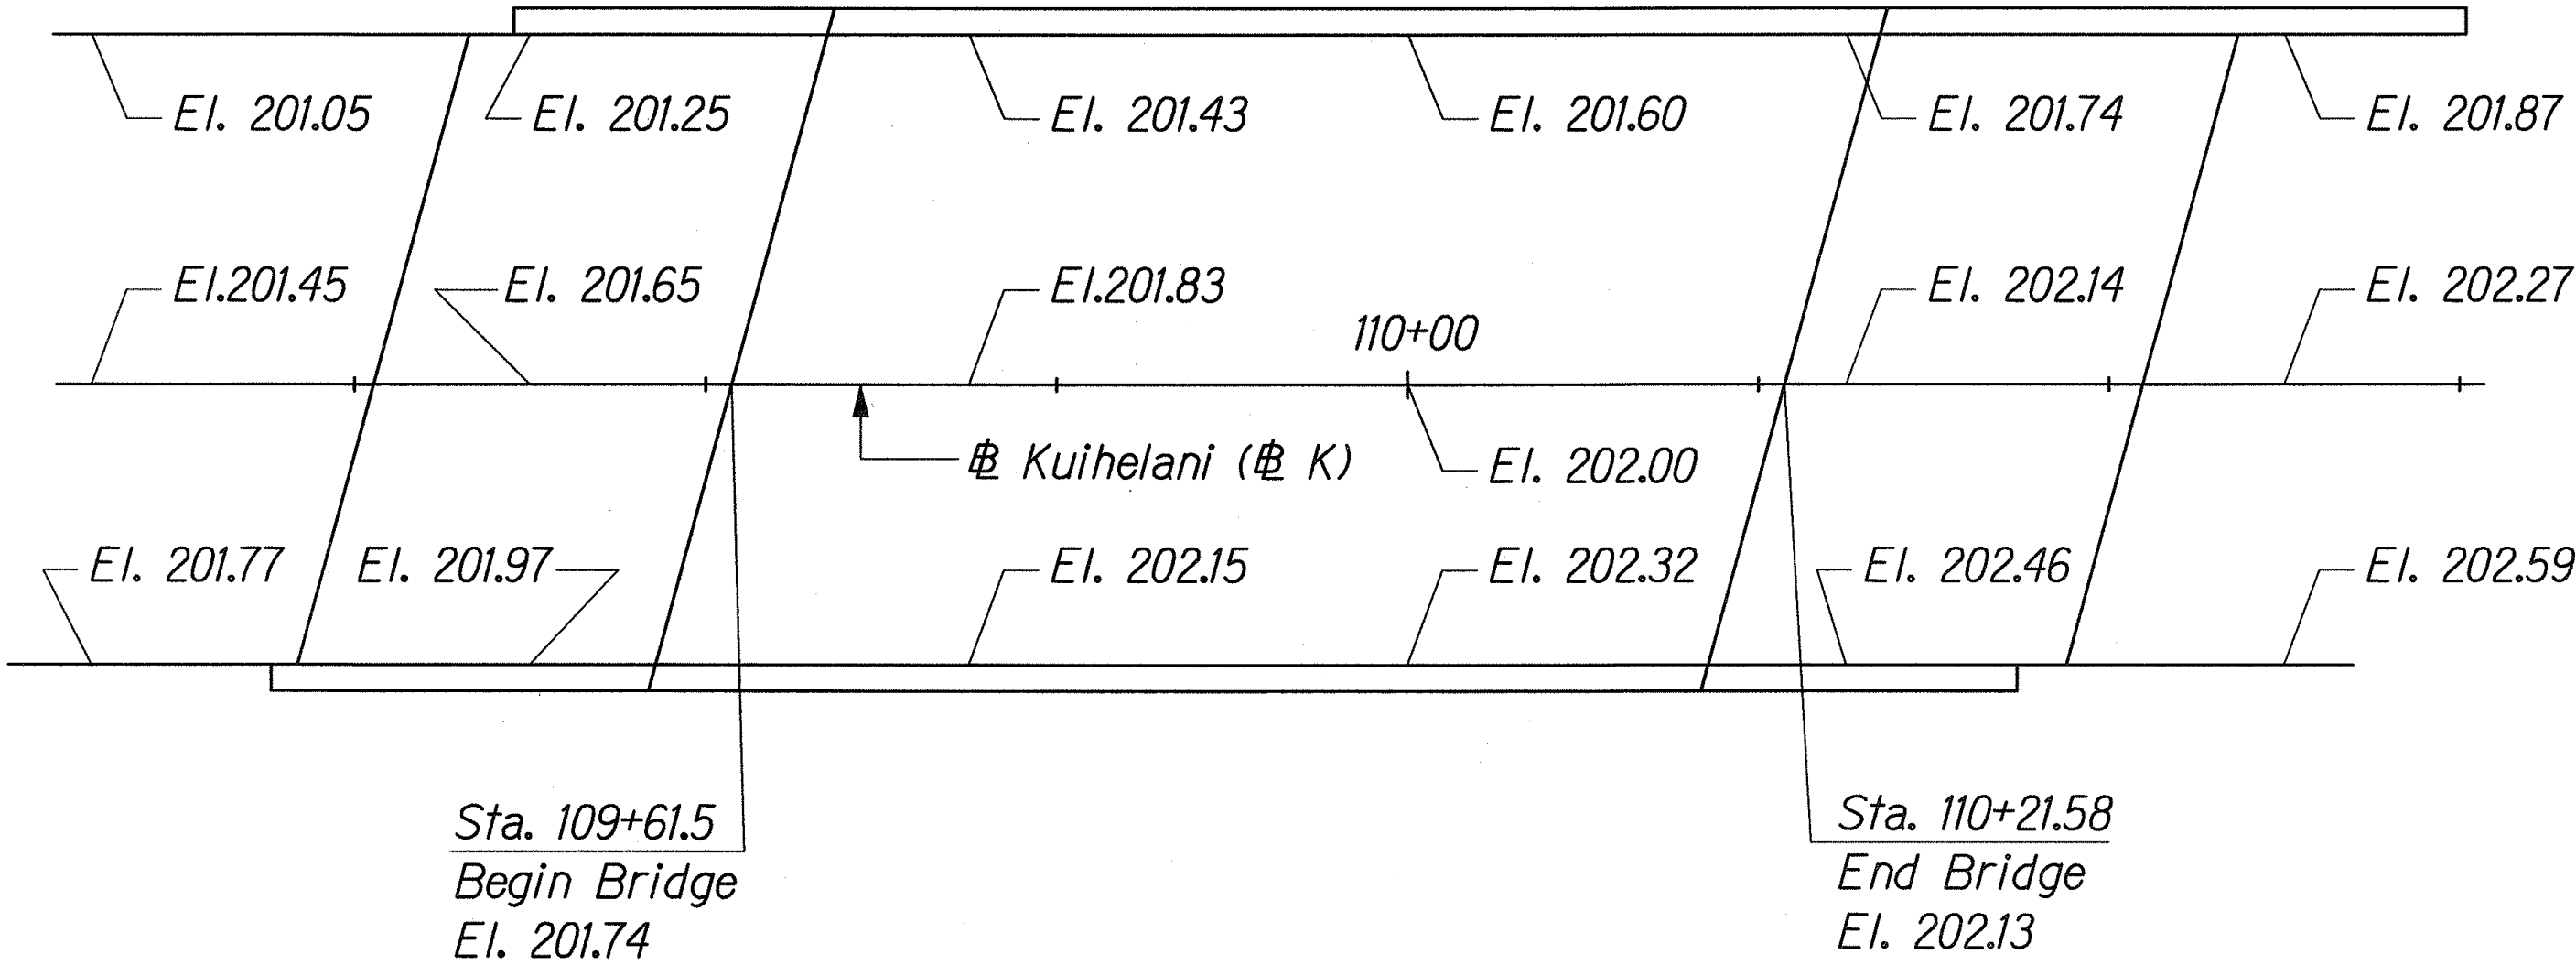

FINISH SPOT ELEVATIONS (@ 25'-0" Interval)
Scale: 1" = 10'-0"

LEGEND:

- B8
Denotes Locations of Borings
- LT-2
Denotes Location of Trial and Load Test Shaft
- Denotes existing shaft to be removed. See Note 4.

NOTES:


- For Boring Logs, See Sht. Nos. B1 to B12.
- For Drilled Shaft Tip Elevations, See Sht. No. S-11.
- For Drilled Shaft Details and Drilled Shaft Cutoff Elevations, See Sht. No. S-31.
- Remove the existing shafts, which do not interfere with footings, to 2'-0" below existing ground. Remove the existing shafts, which interfere with footing, to 2'-0" below bottom of footing.

6/27/02	Revised Abutment #2 shaft locations and footing size.
5/15/02	Revised Abutment #2 shaft locations and footing size. Added Note No. 4 and legend for existing shaft.
Date	Revision


THIS WORK WAS PREPARED BY ME OR UNDER MY SUPERVISION.
Hui Pang Chen

STATE OF HAWAII
DEPARTMENT OF TRANSPORTATION
HIGHWAYS DIVISION
WAIKAPU STREAM BRIDGE
FOUNDATION PLAN & SPOT ELEV.
KUIHELANI HIGHWAY WIDENING
HONOAPIILANI HIGHWAY TO PUUNENE AVENUE
FEDERAL-AID PROJECT NO. NH-0380(9)
Scale: As Shown Date: Sept. 14, 2001


FED. ROAD DIST. NO.	STATE	FED. AID PROJ. NO.	FISCAL YEAR	SHEET NO.	TOTAL SHEETS
HAWAII	HAW.	NH-0380(9)	2000	175	380

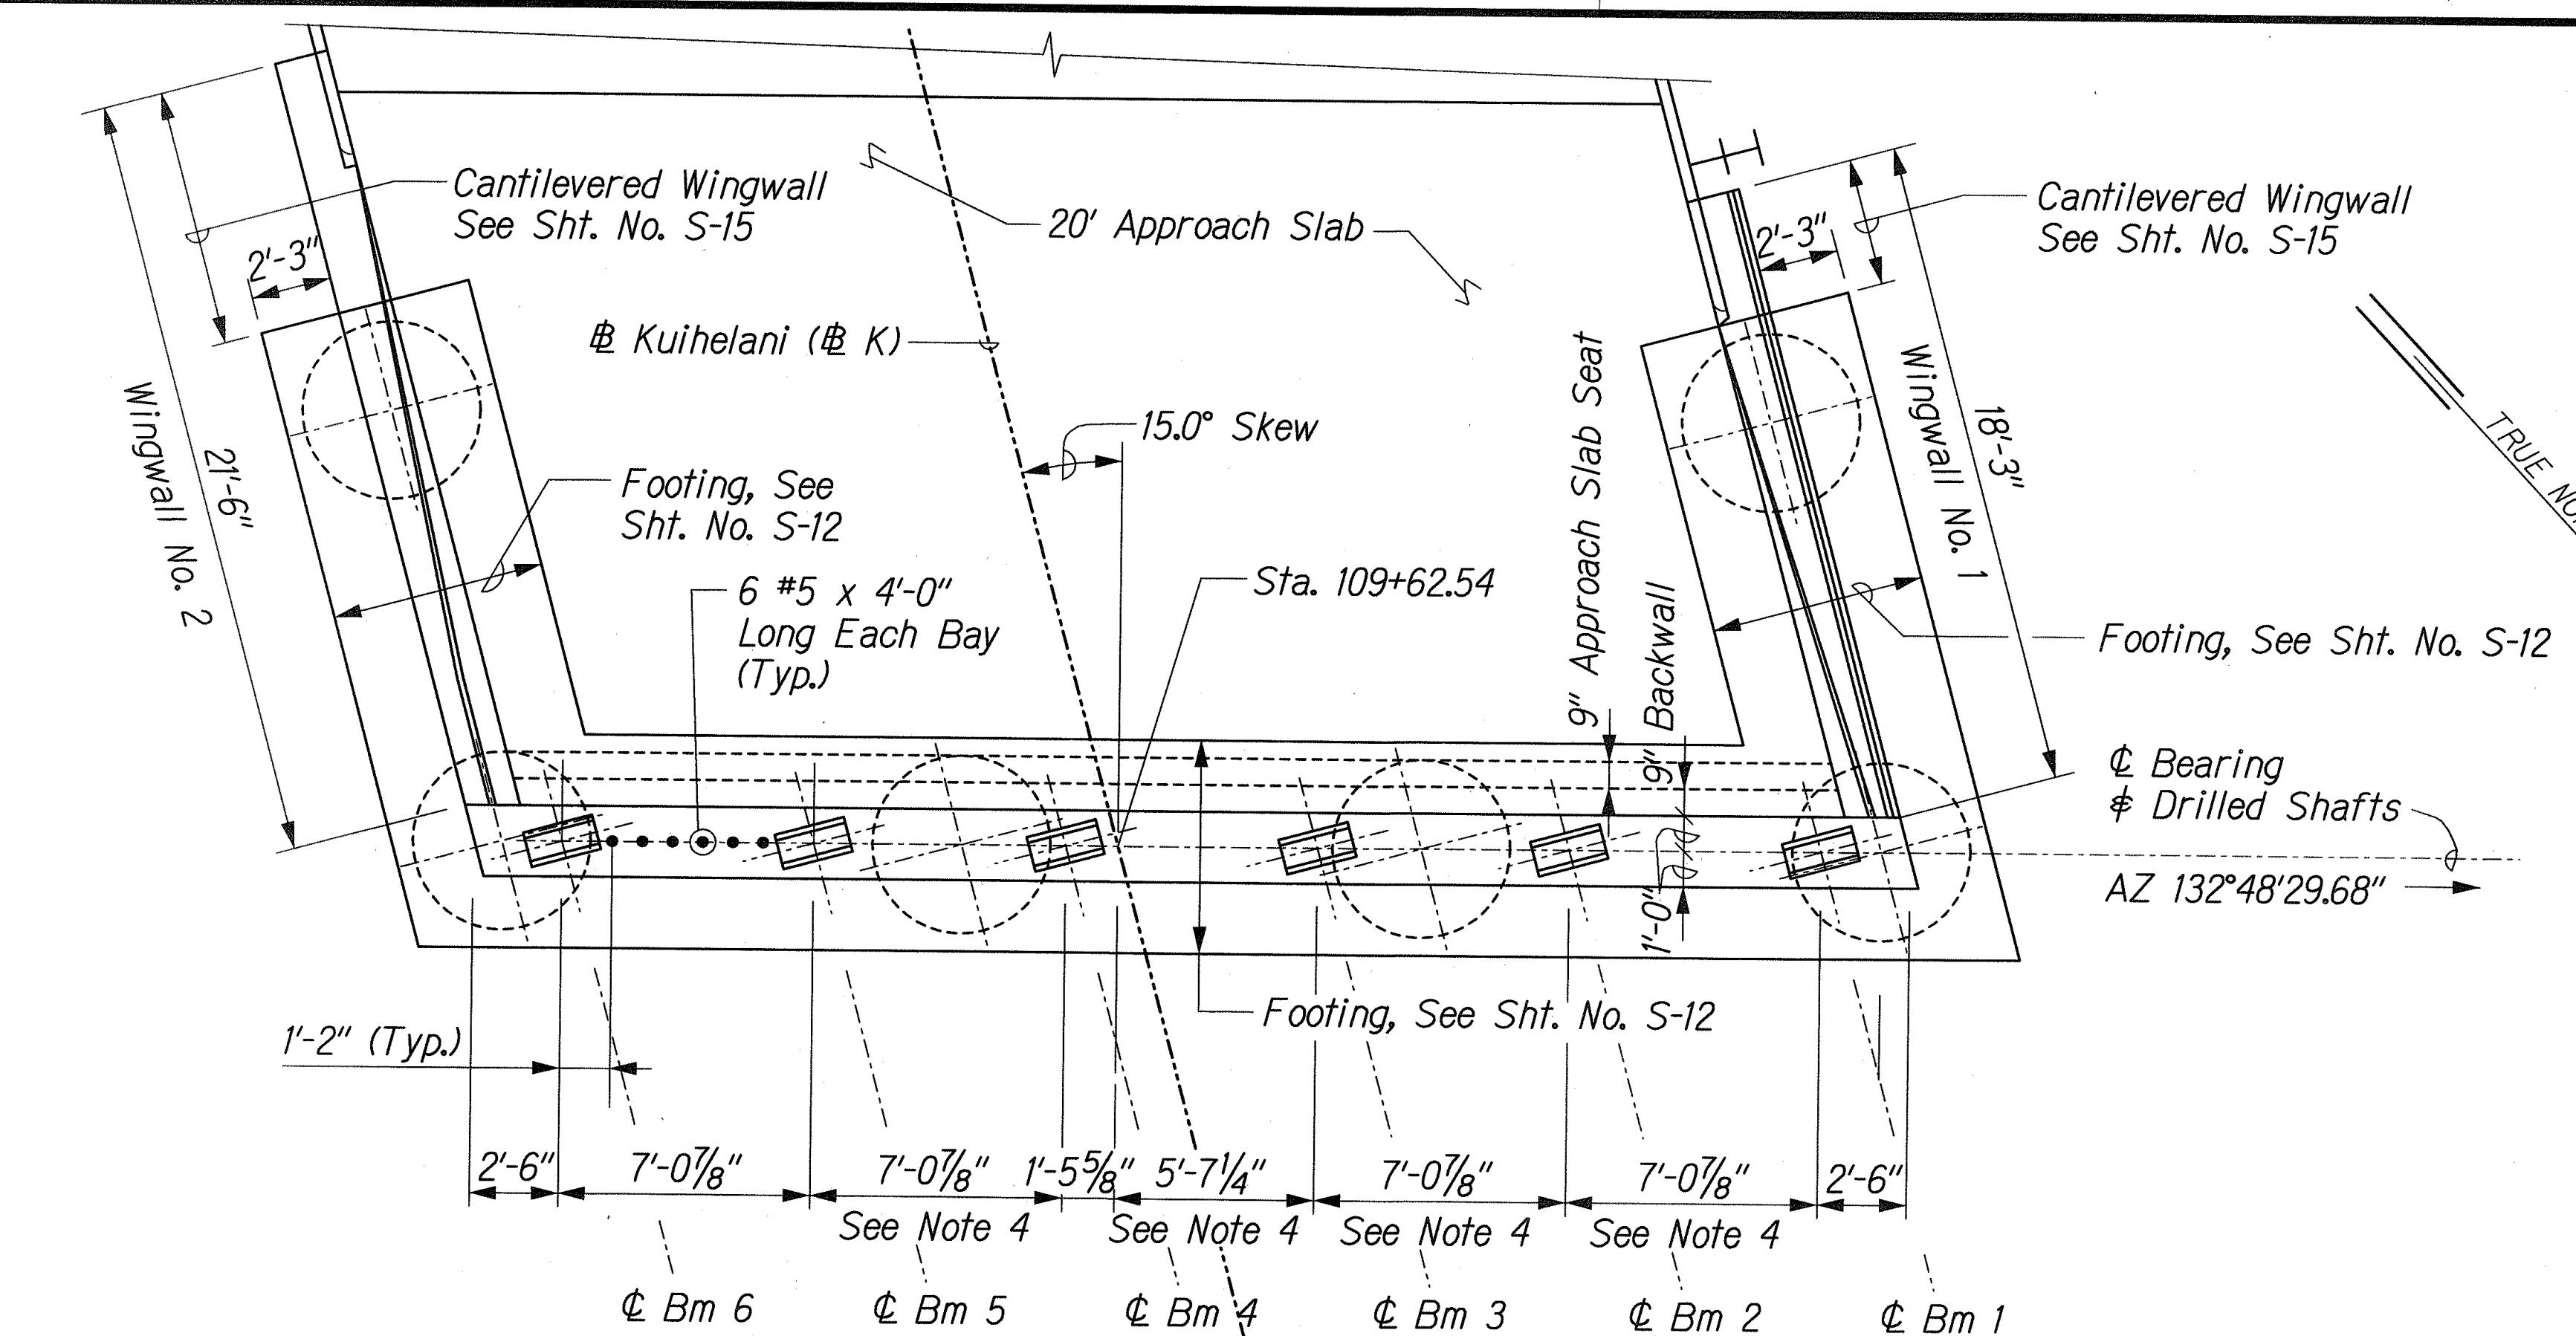

ABUTMENT NO. 1 PLAN

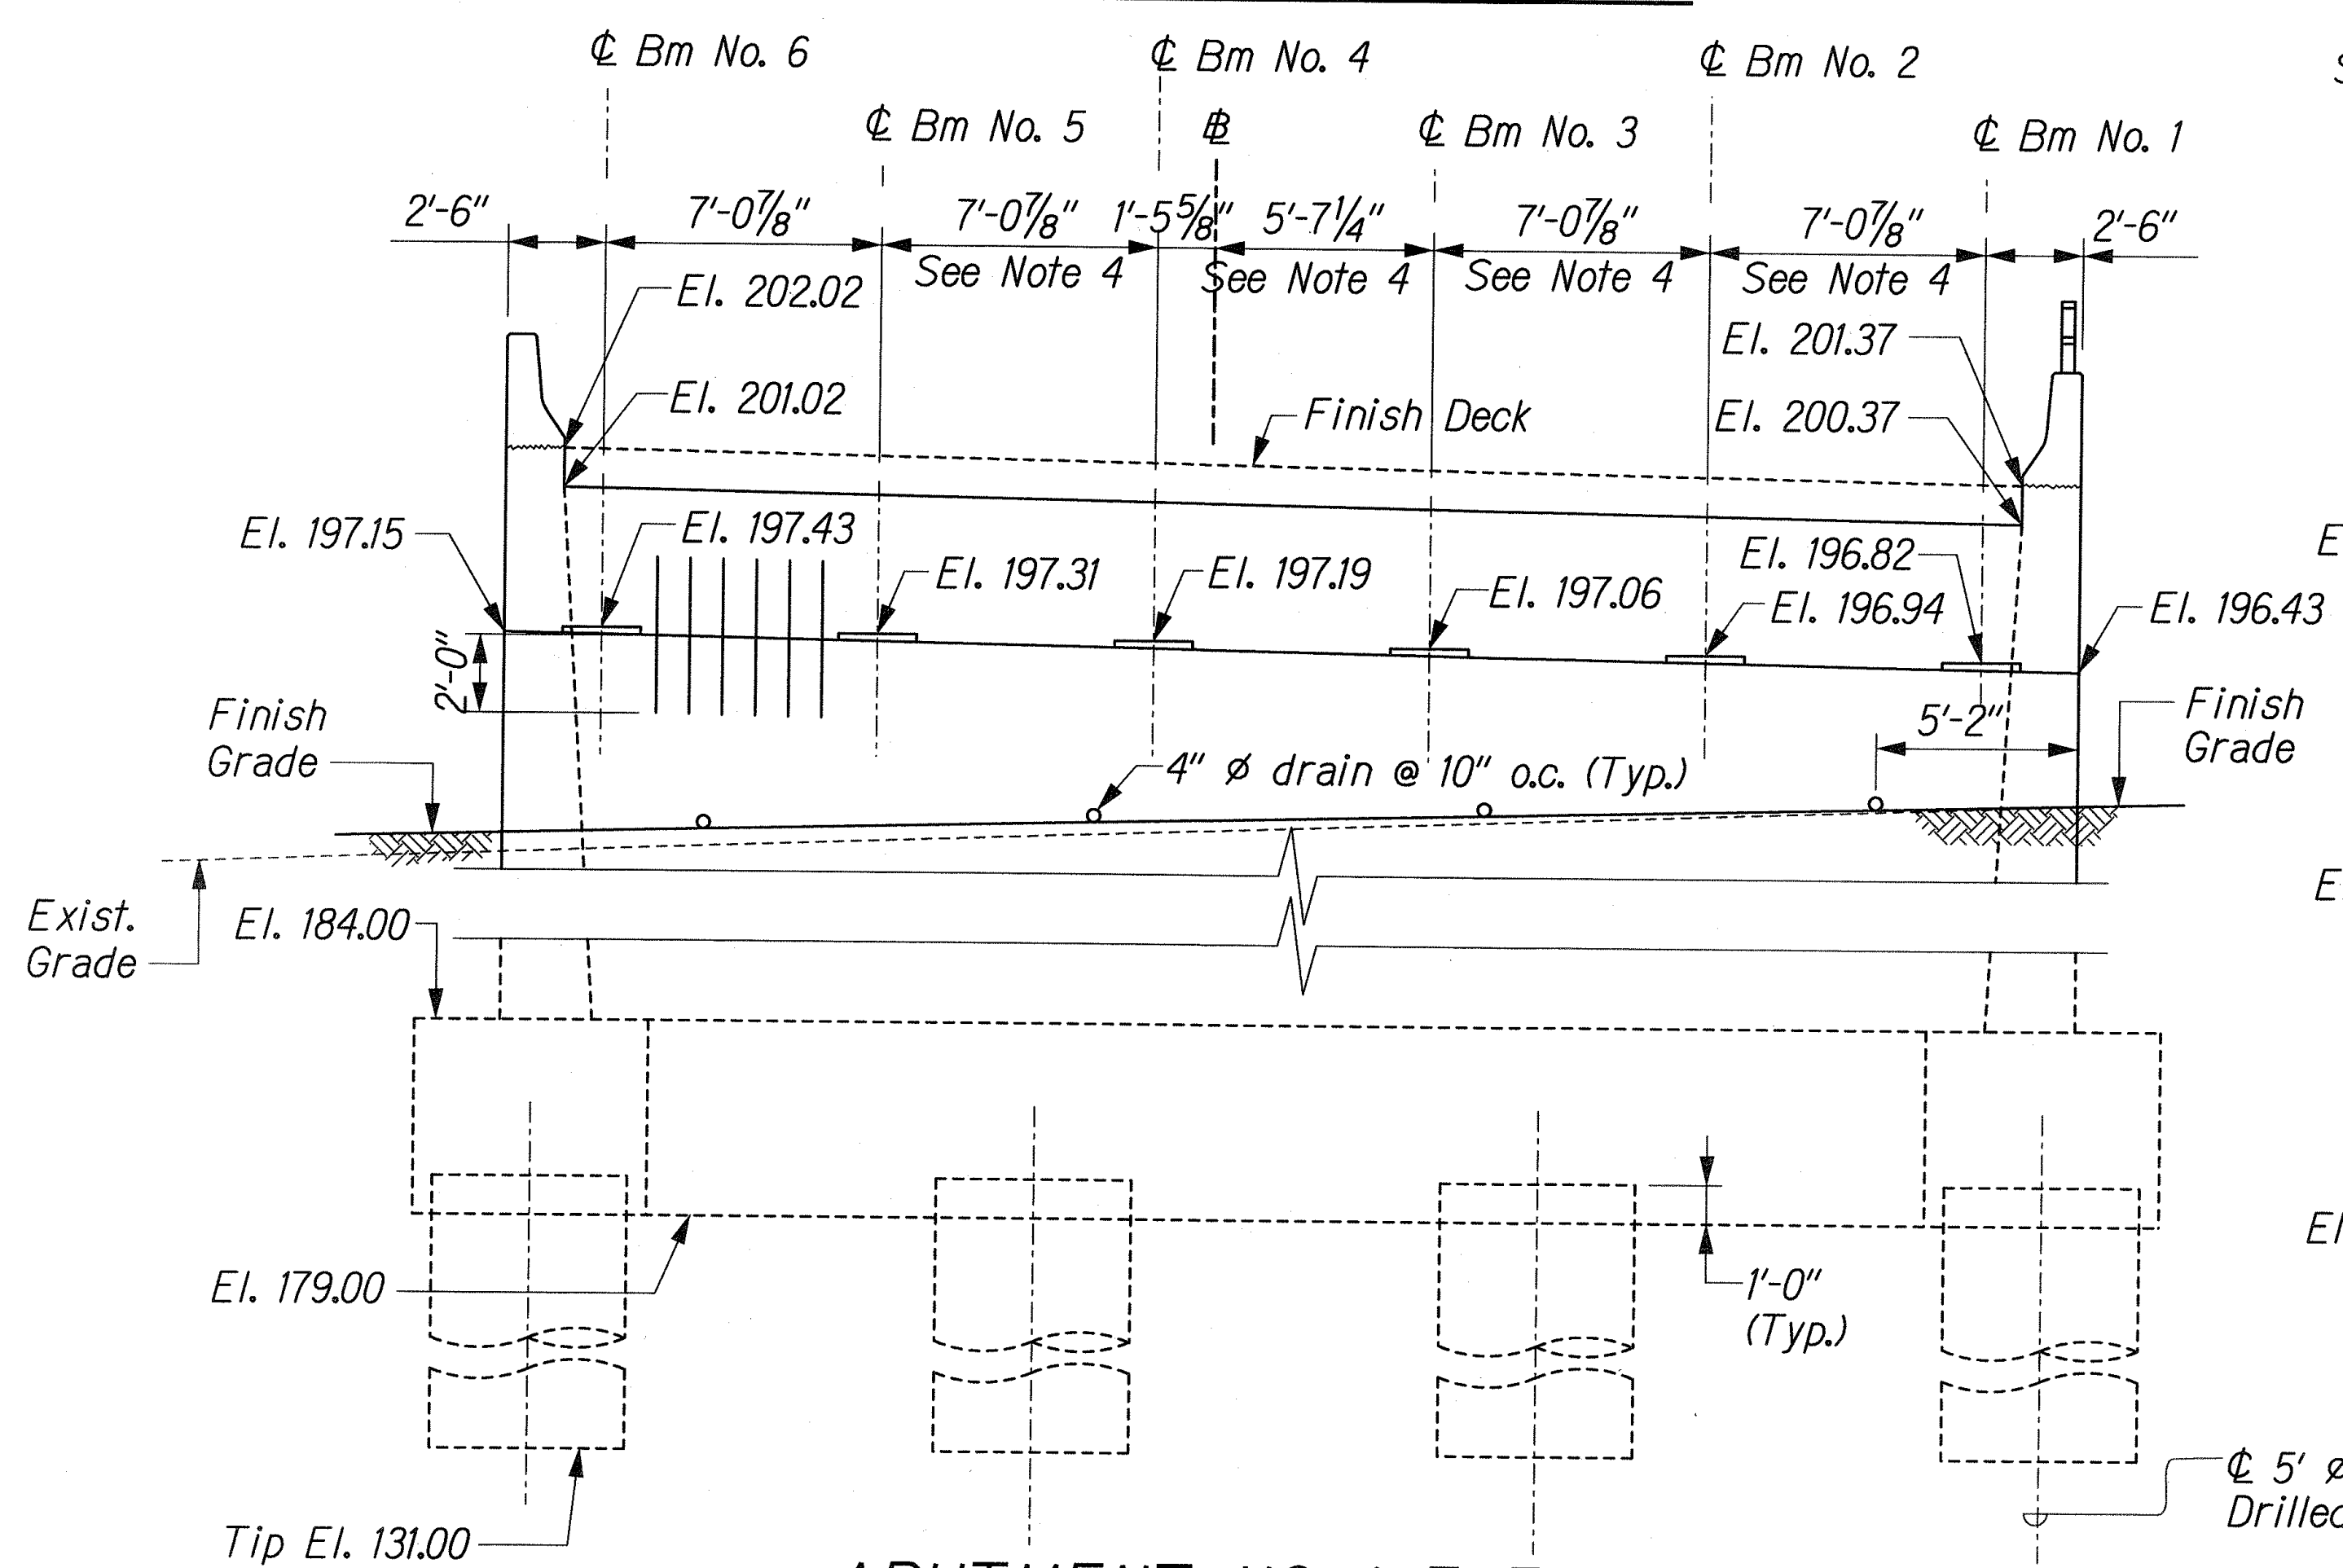


ABUTMENT NO. 1 ELEVATION

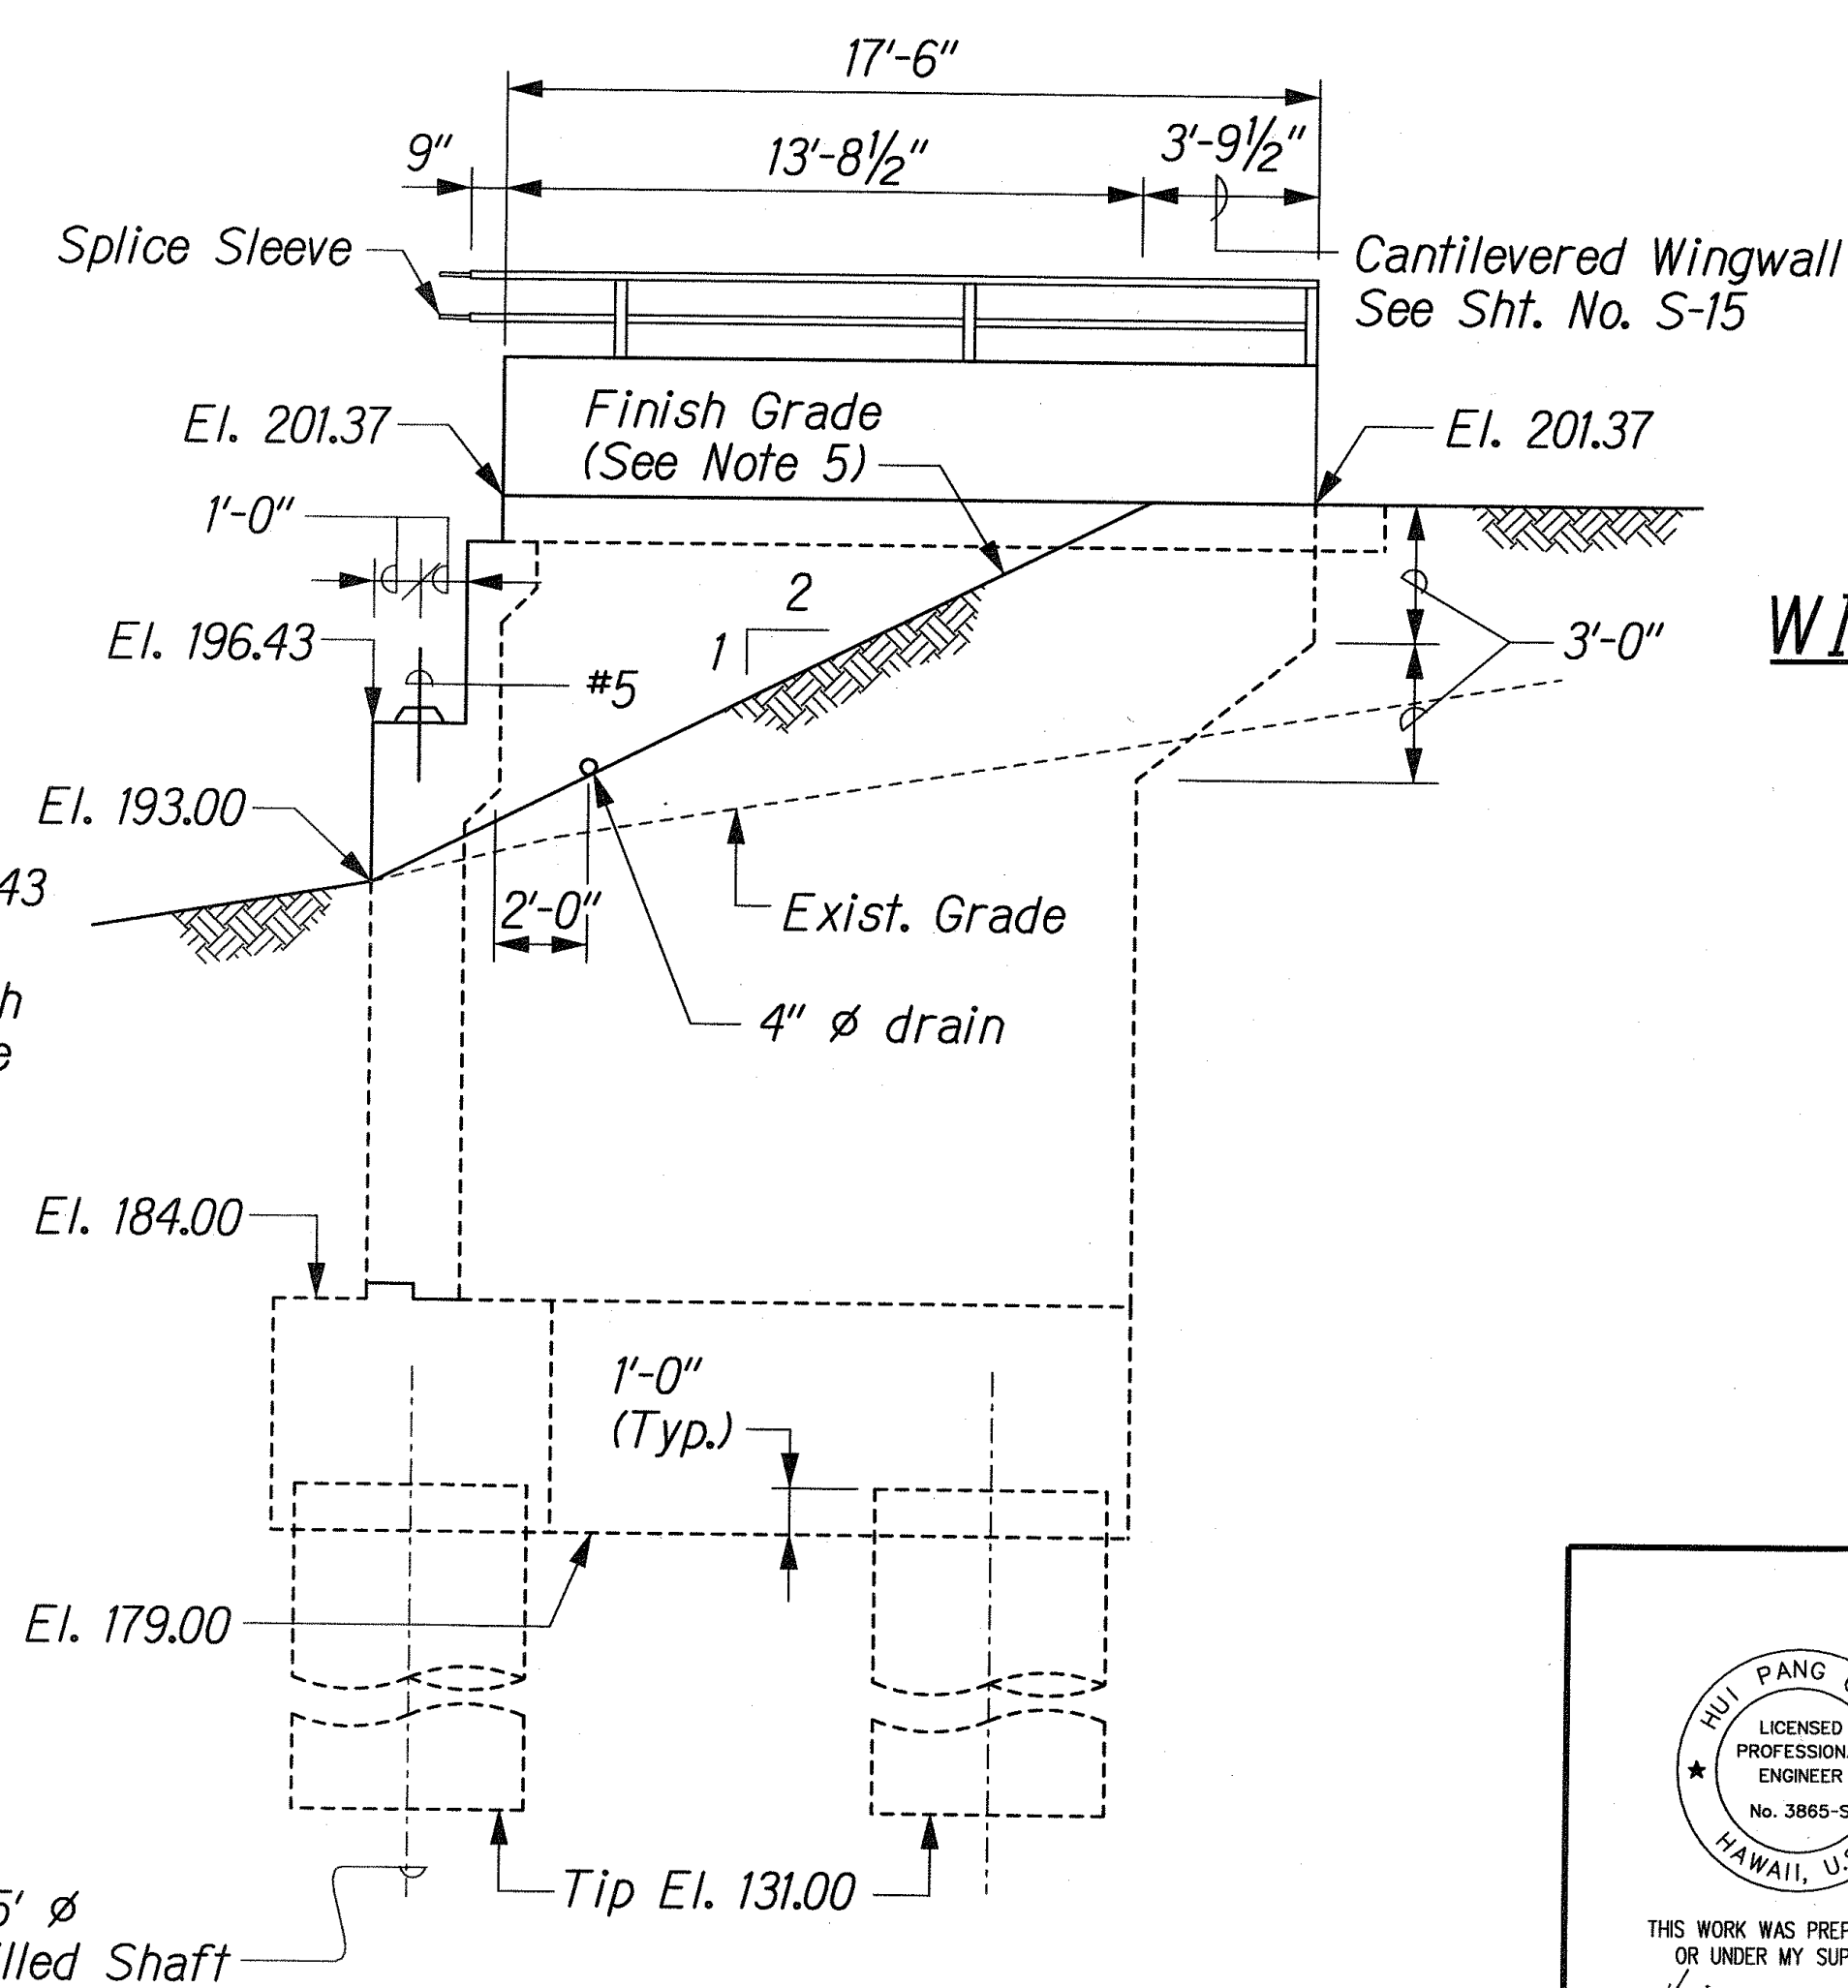

WINGWALL NO. 1 ELEVATION

NOTES:

1. For location plan, see Sheet No. S-11.
2. For Approach Slab Details, see Sheet No. S-35.
3. For Beam Seat details, see Sheet No. S-16.
4. The #5 hinge dowels not shown in these bays for clarity.
5. See Note 7(L) on Sht. No. S-2.

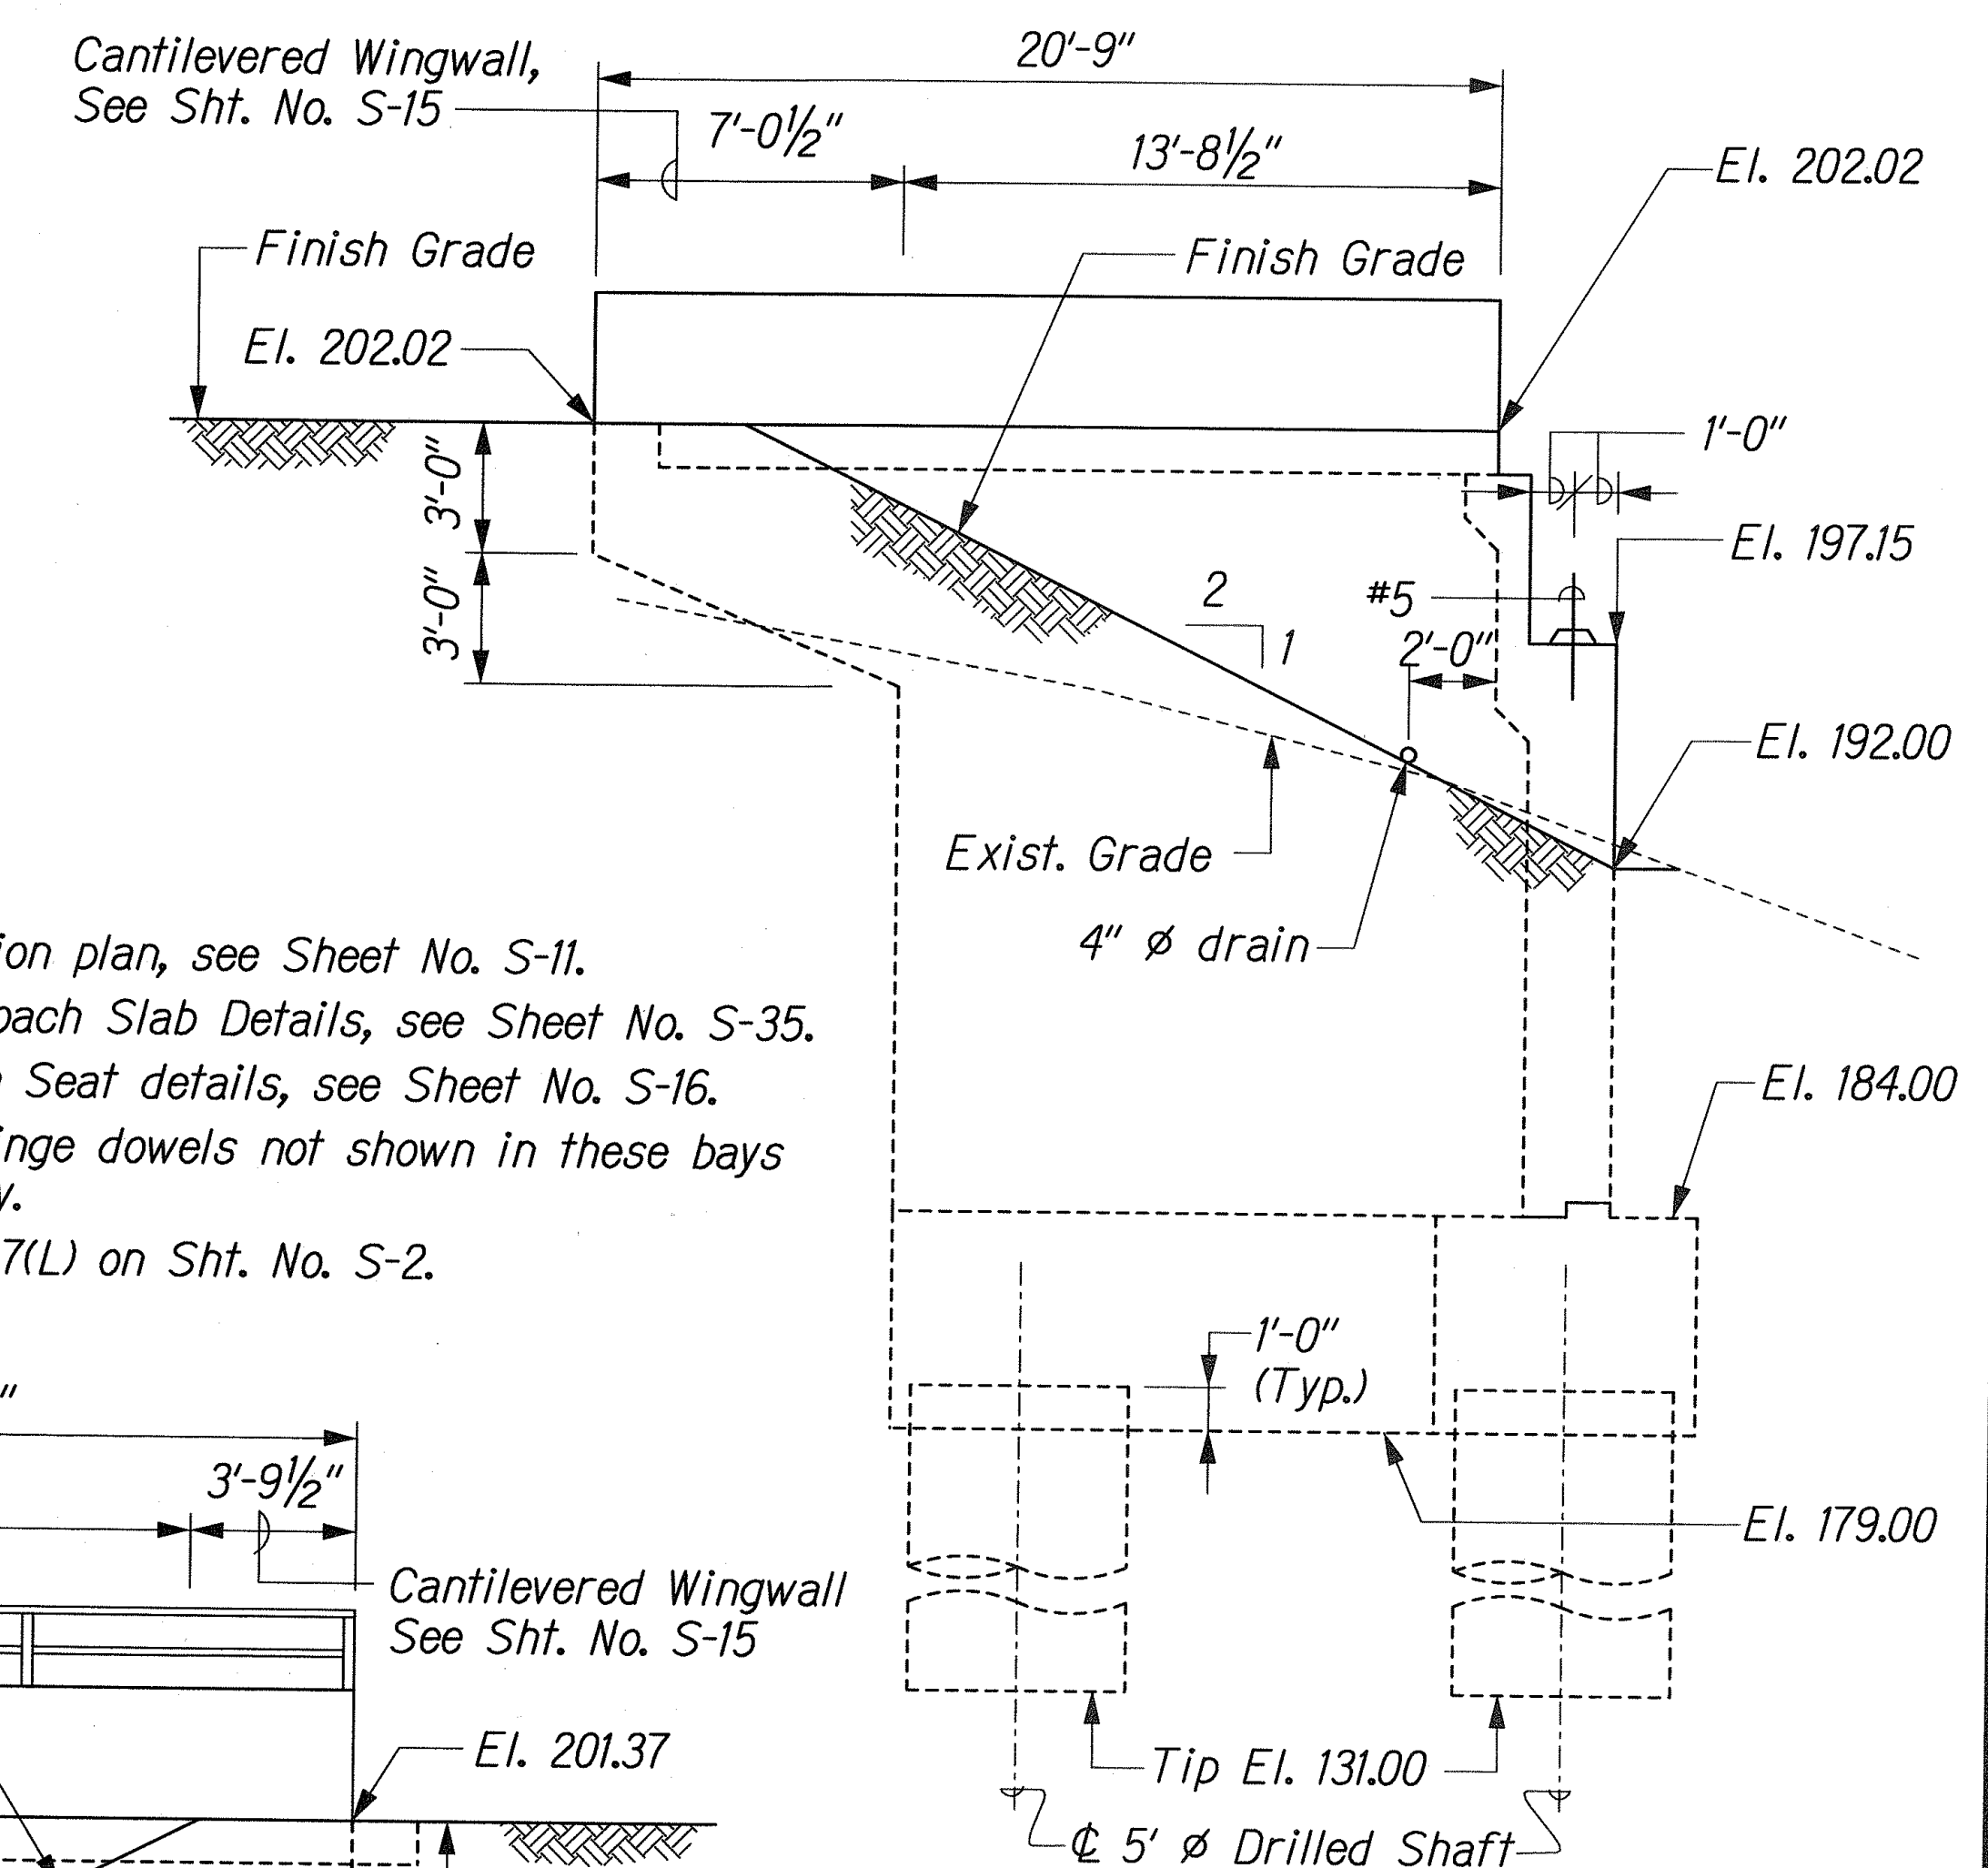

WINGWALL NO. 2 ELEVATION

DESIGNED BY	DATE
NOTED BY	
CHECKED BY	
QUANTITIES BY	
REVISIONS	


1/6 KUIHELANI/STRUCT/ST-DET/ldgn

6/27/02	Revised wall length in Wingwall No. 1 Elevation and Wingwall No. 2 Elevation.
Date	Revision


THIS WORK WAS PREPARED BY ME OR UNDER MY SUPERVISION.
Hui Pang Chen

STATE OF HAWAII
DEPARTMENT OF TRANSPORTATION
HIGHWAYS DIVISION
WAIKAPU STREAM BRIDGE
ABUTMENT SHEET 1 OF 4
KUIHELANI HIGHWAY WIDENING
HONOAHIILANI HIGHWAY TO PUUNENE AVENUE
FEDERAL-AID PROJECT NO. NH-0380(9)
Scale: 1/4" = 1'-0" Date: Sept. 14, 2001


FED. ROAD DIST. NO.	STATE	FED. AID PROJ. NO.	FISCAL YEAR	SHEET NO.	TOTAL SHEETS
HAWAII	HAW.	NH-0380(9)	2000	C.O. 176	380

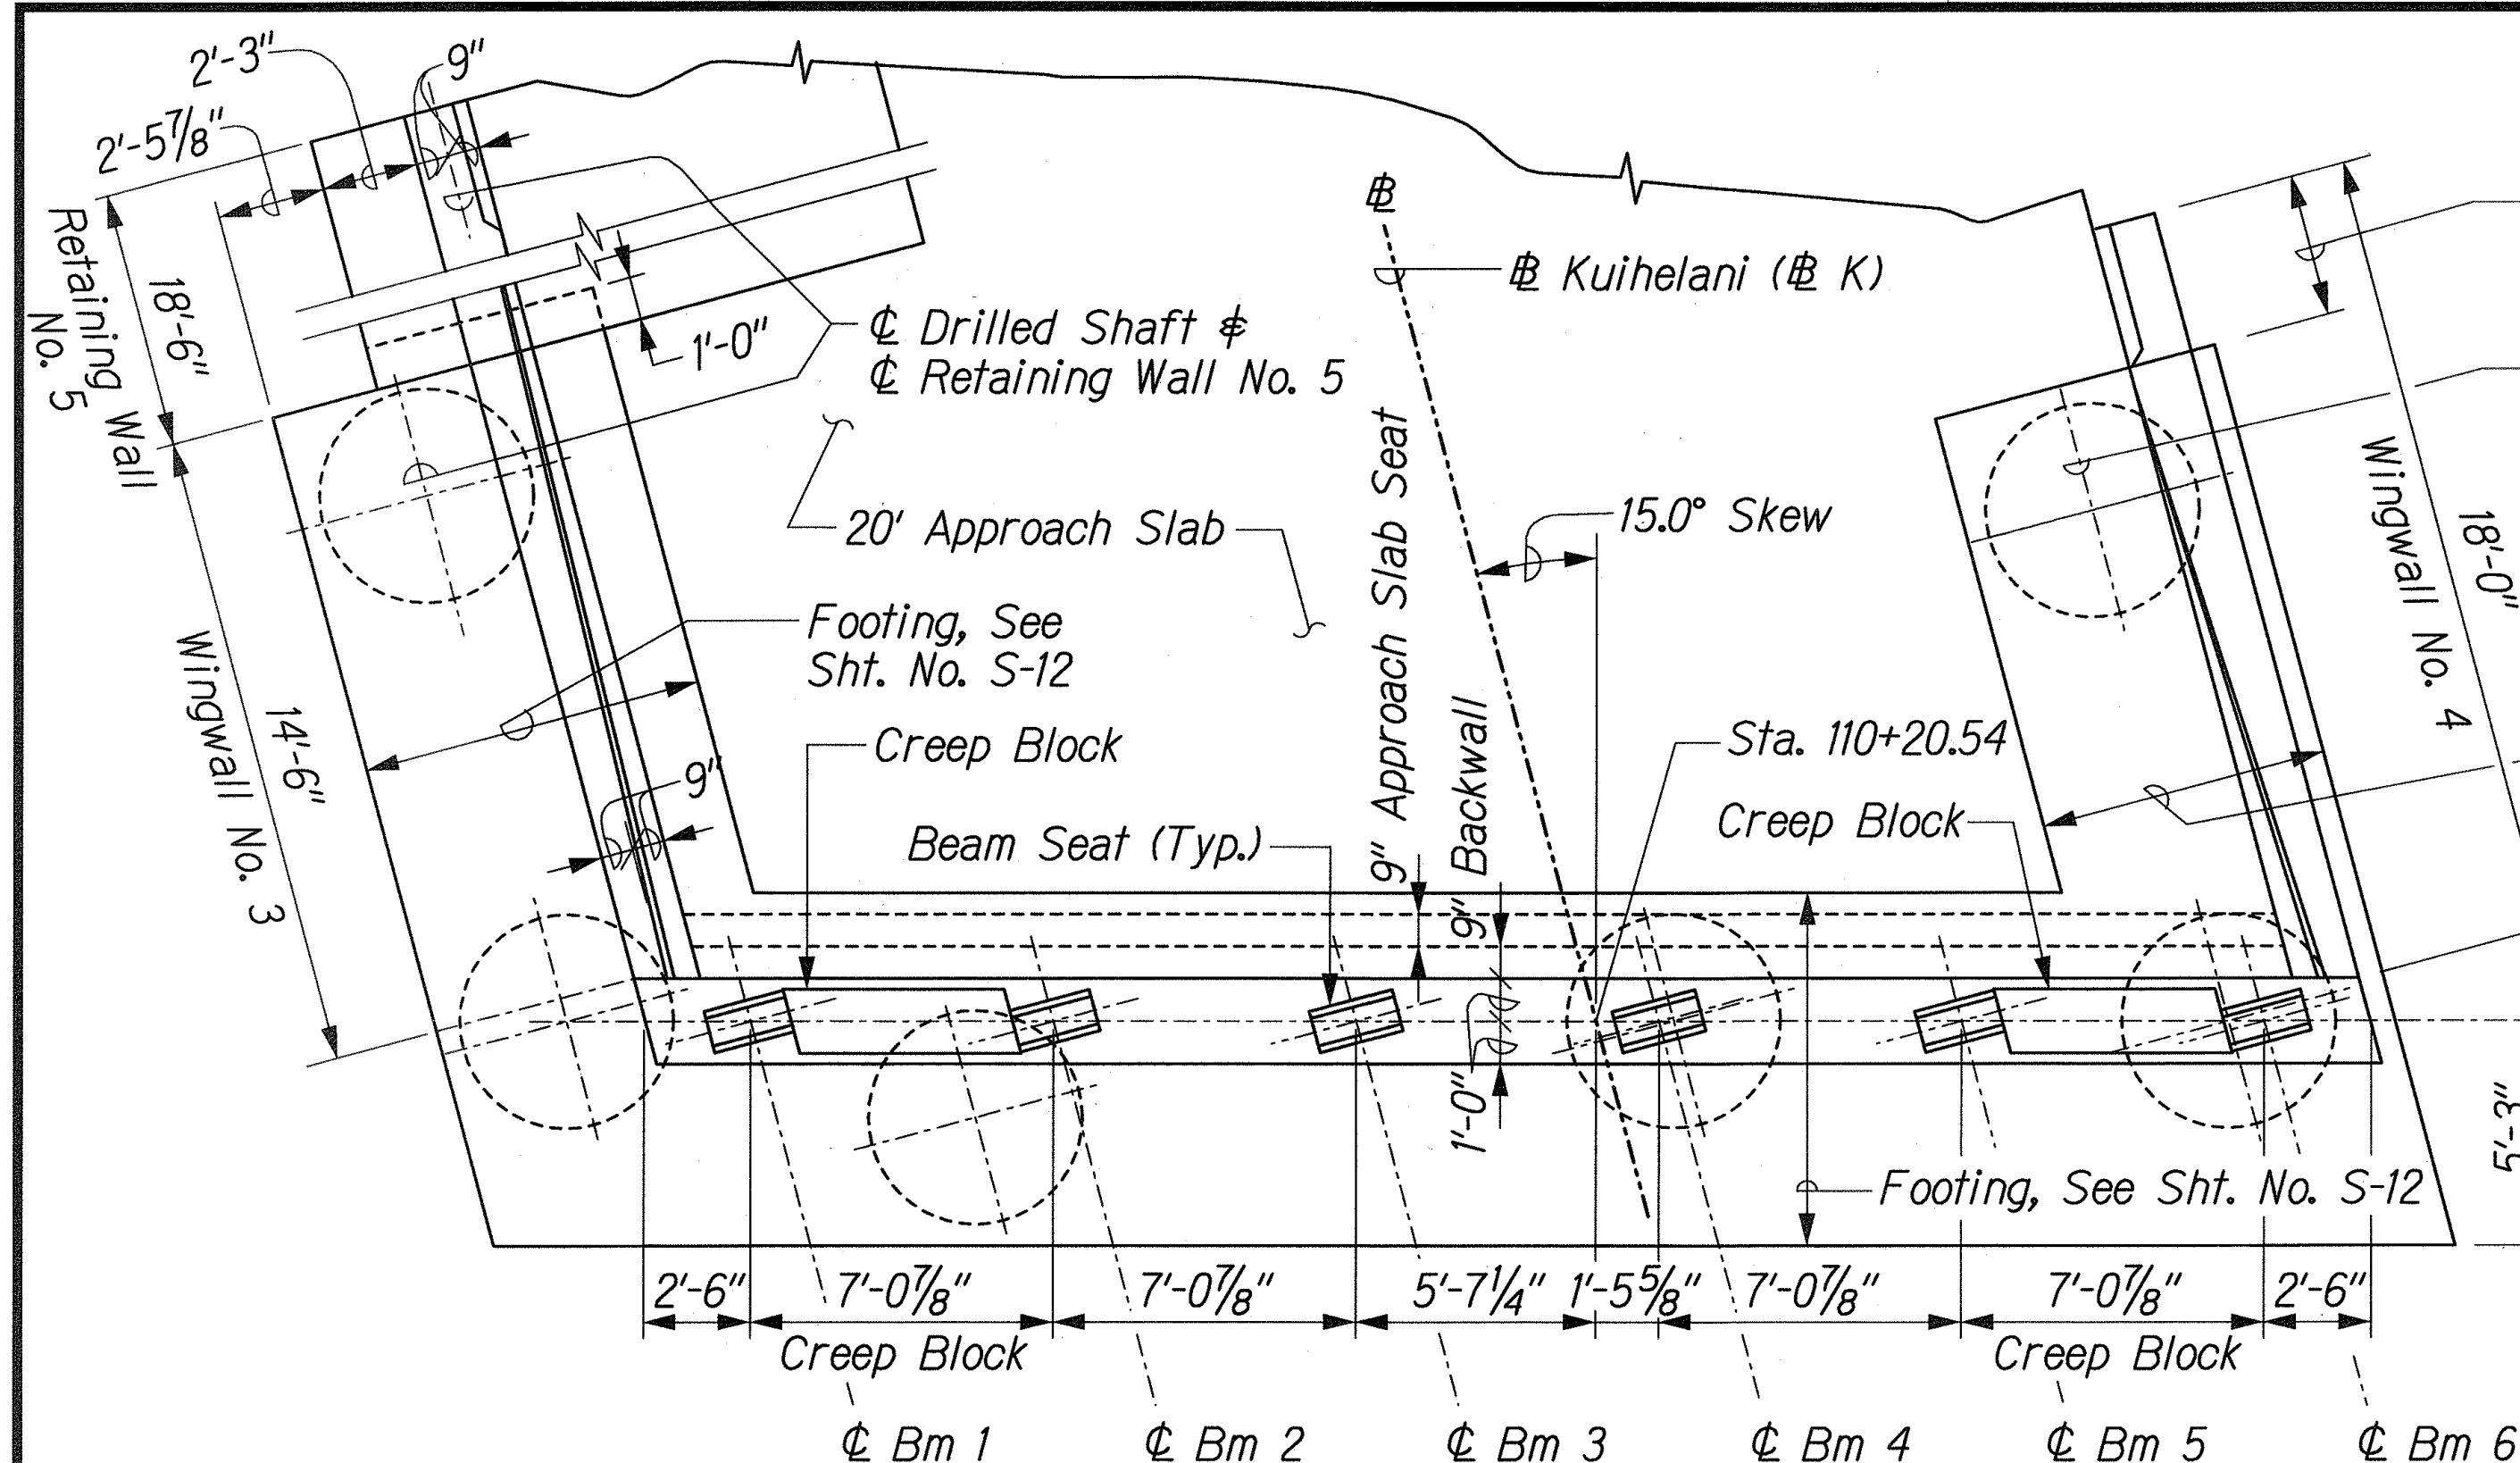


ABUTMENT NO. 2 PLAN

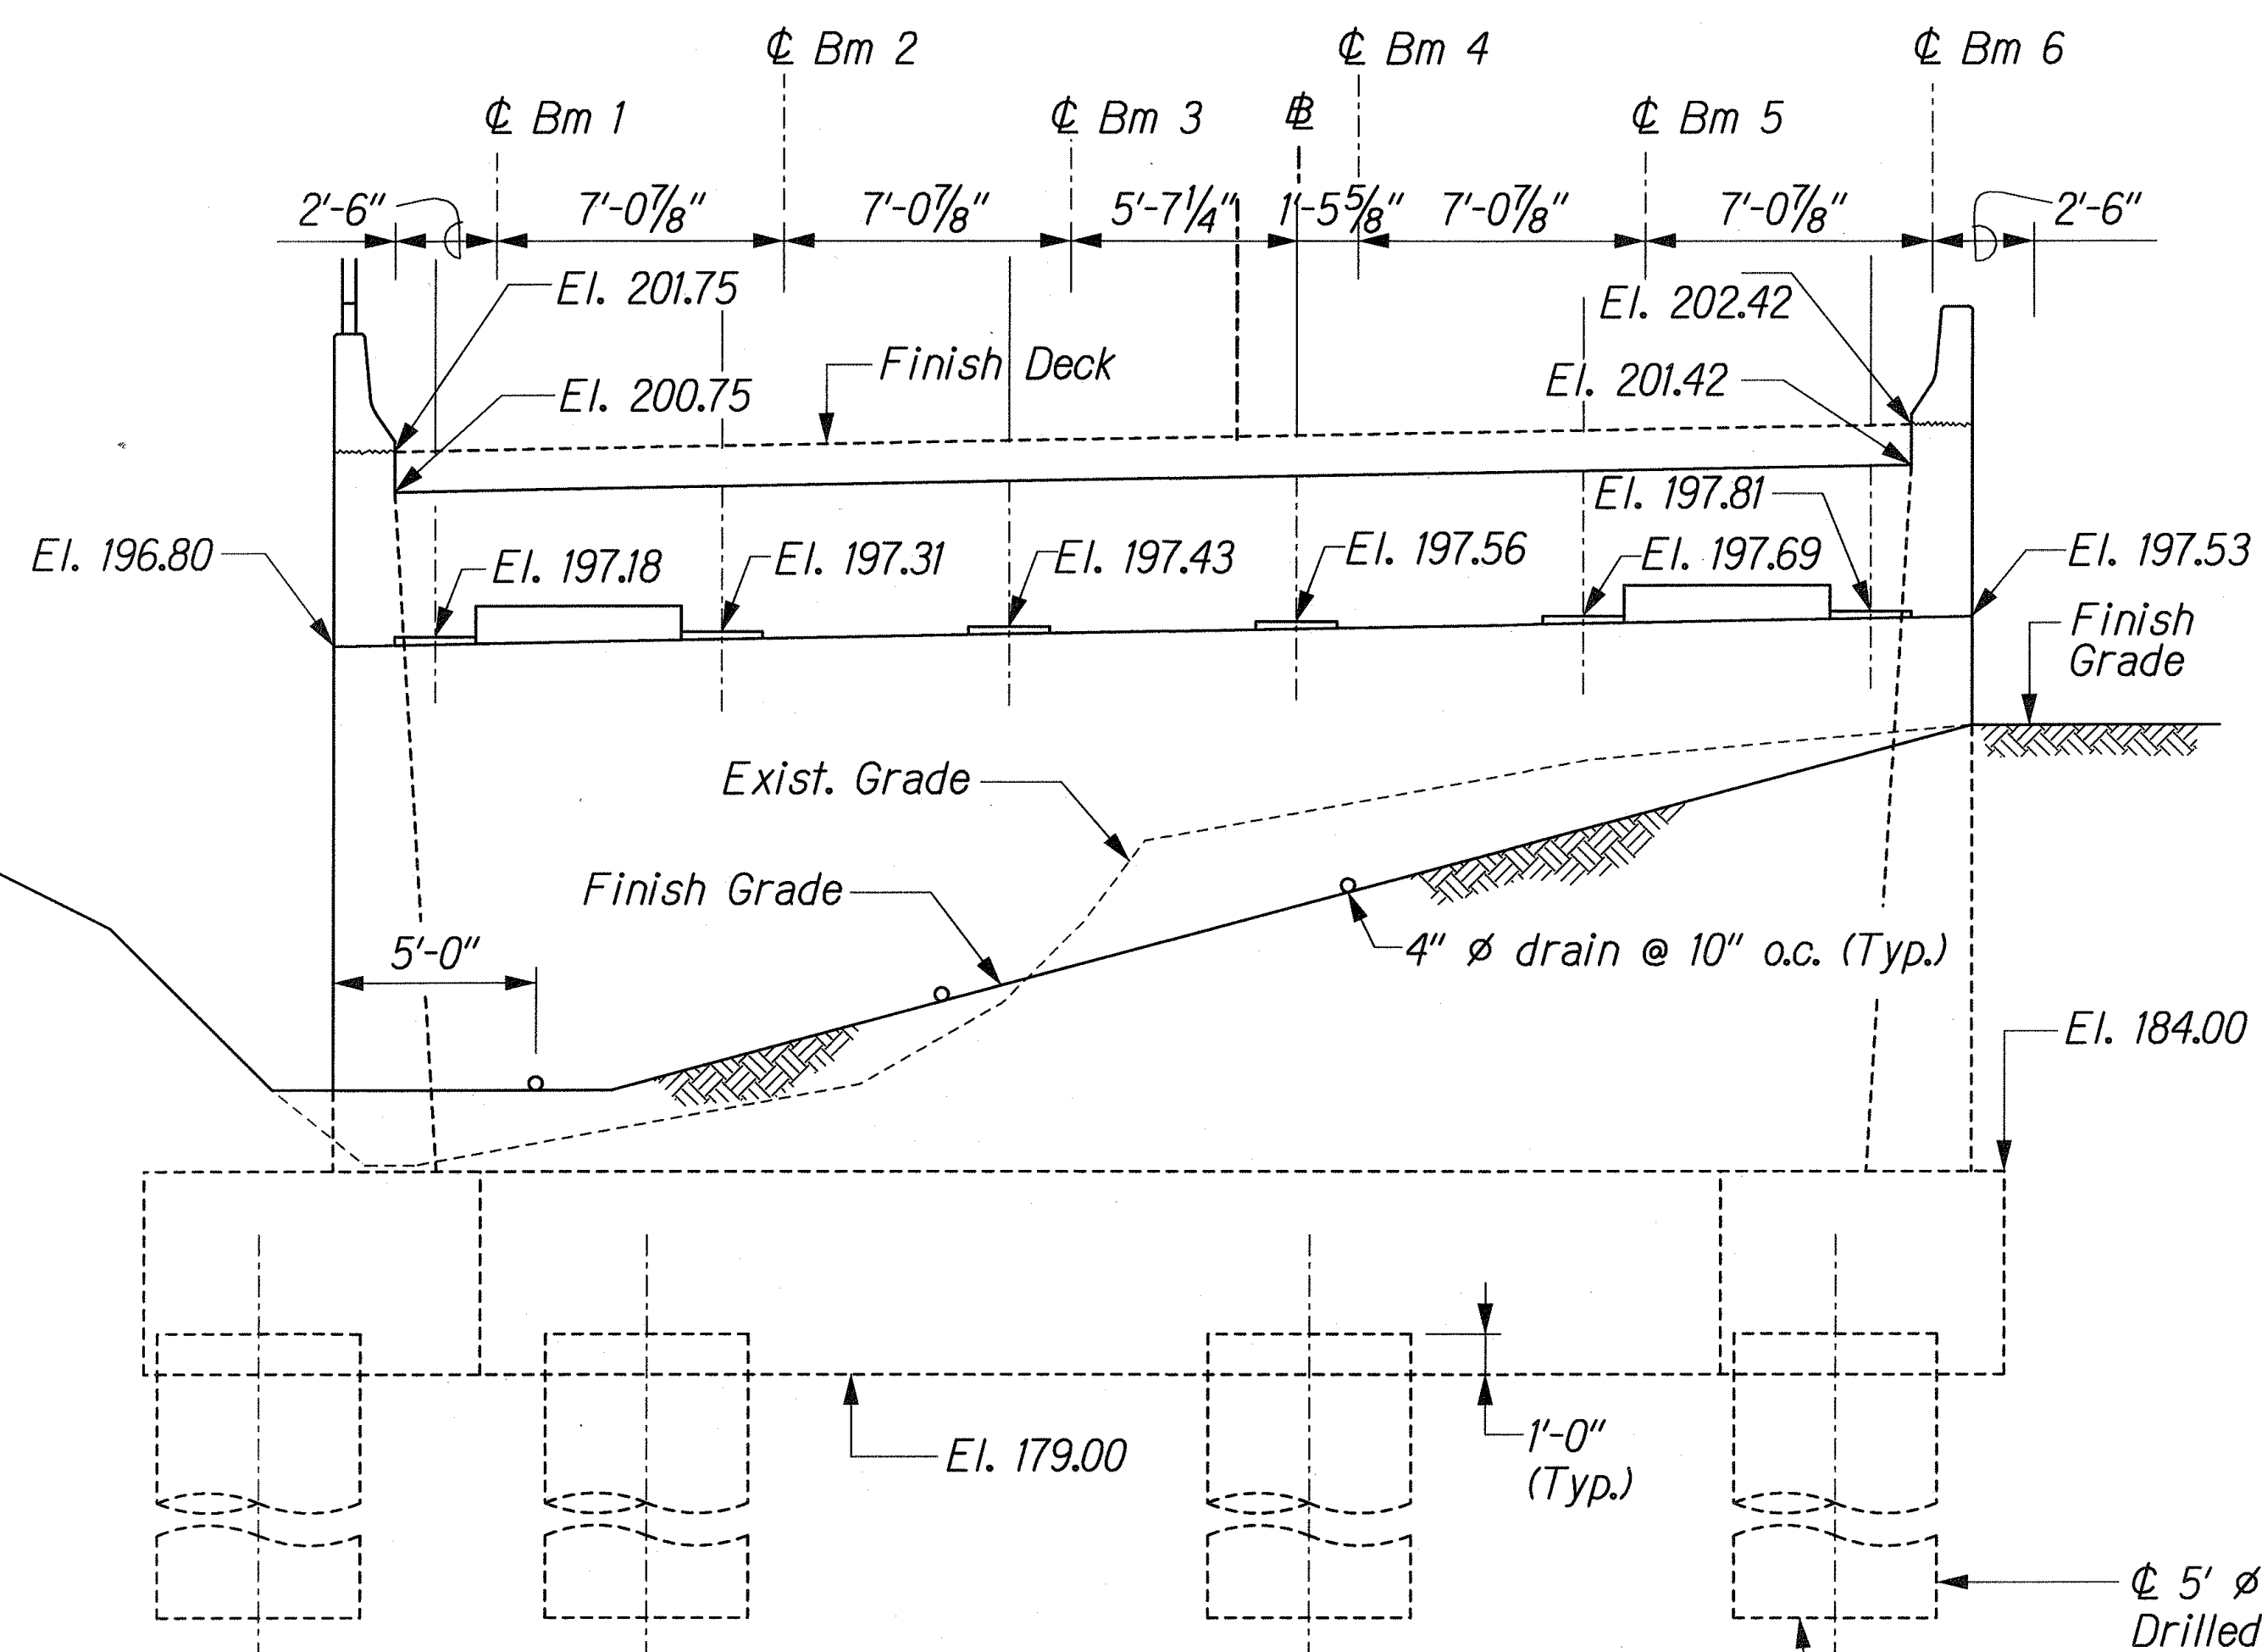

ABUTMENT NO. 2 ELEVATION

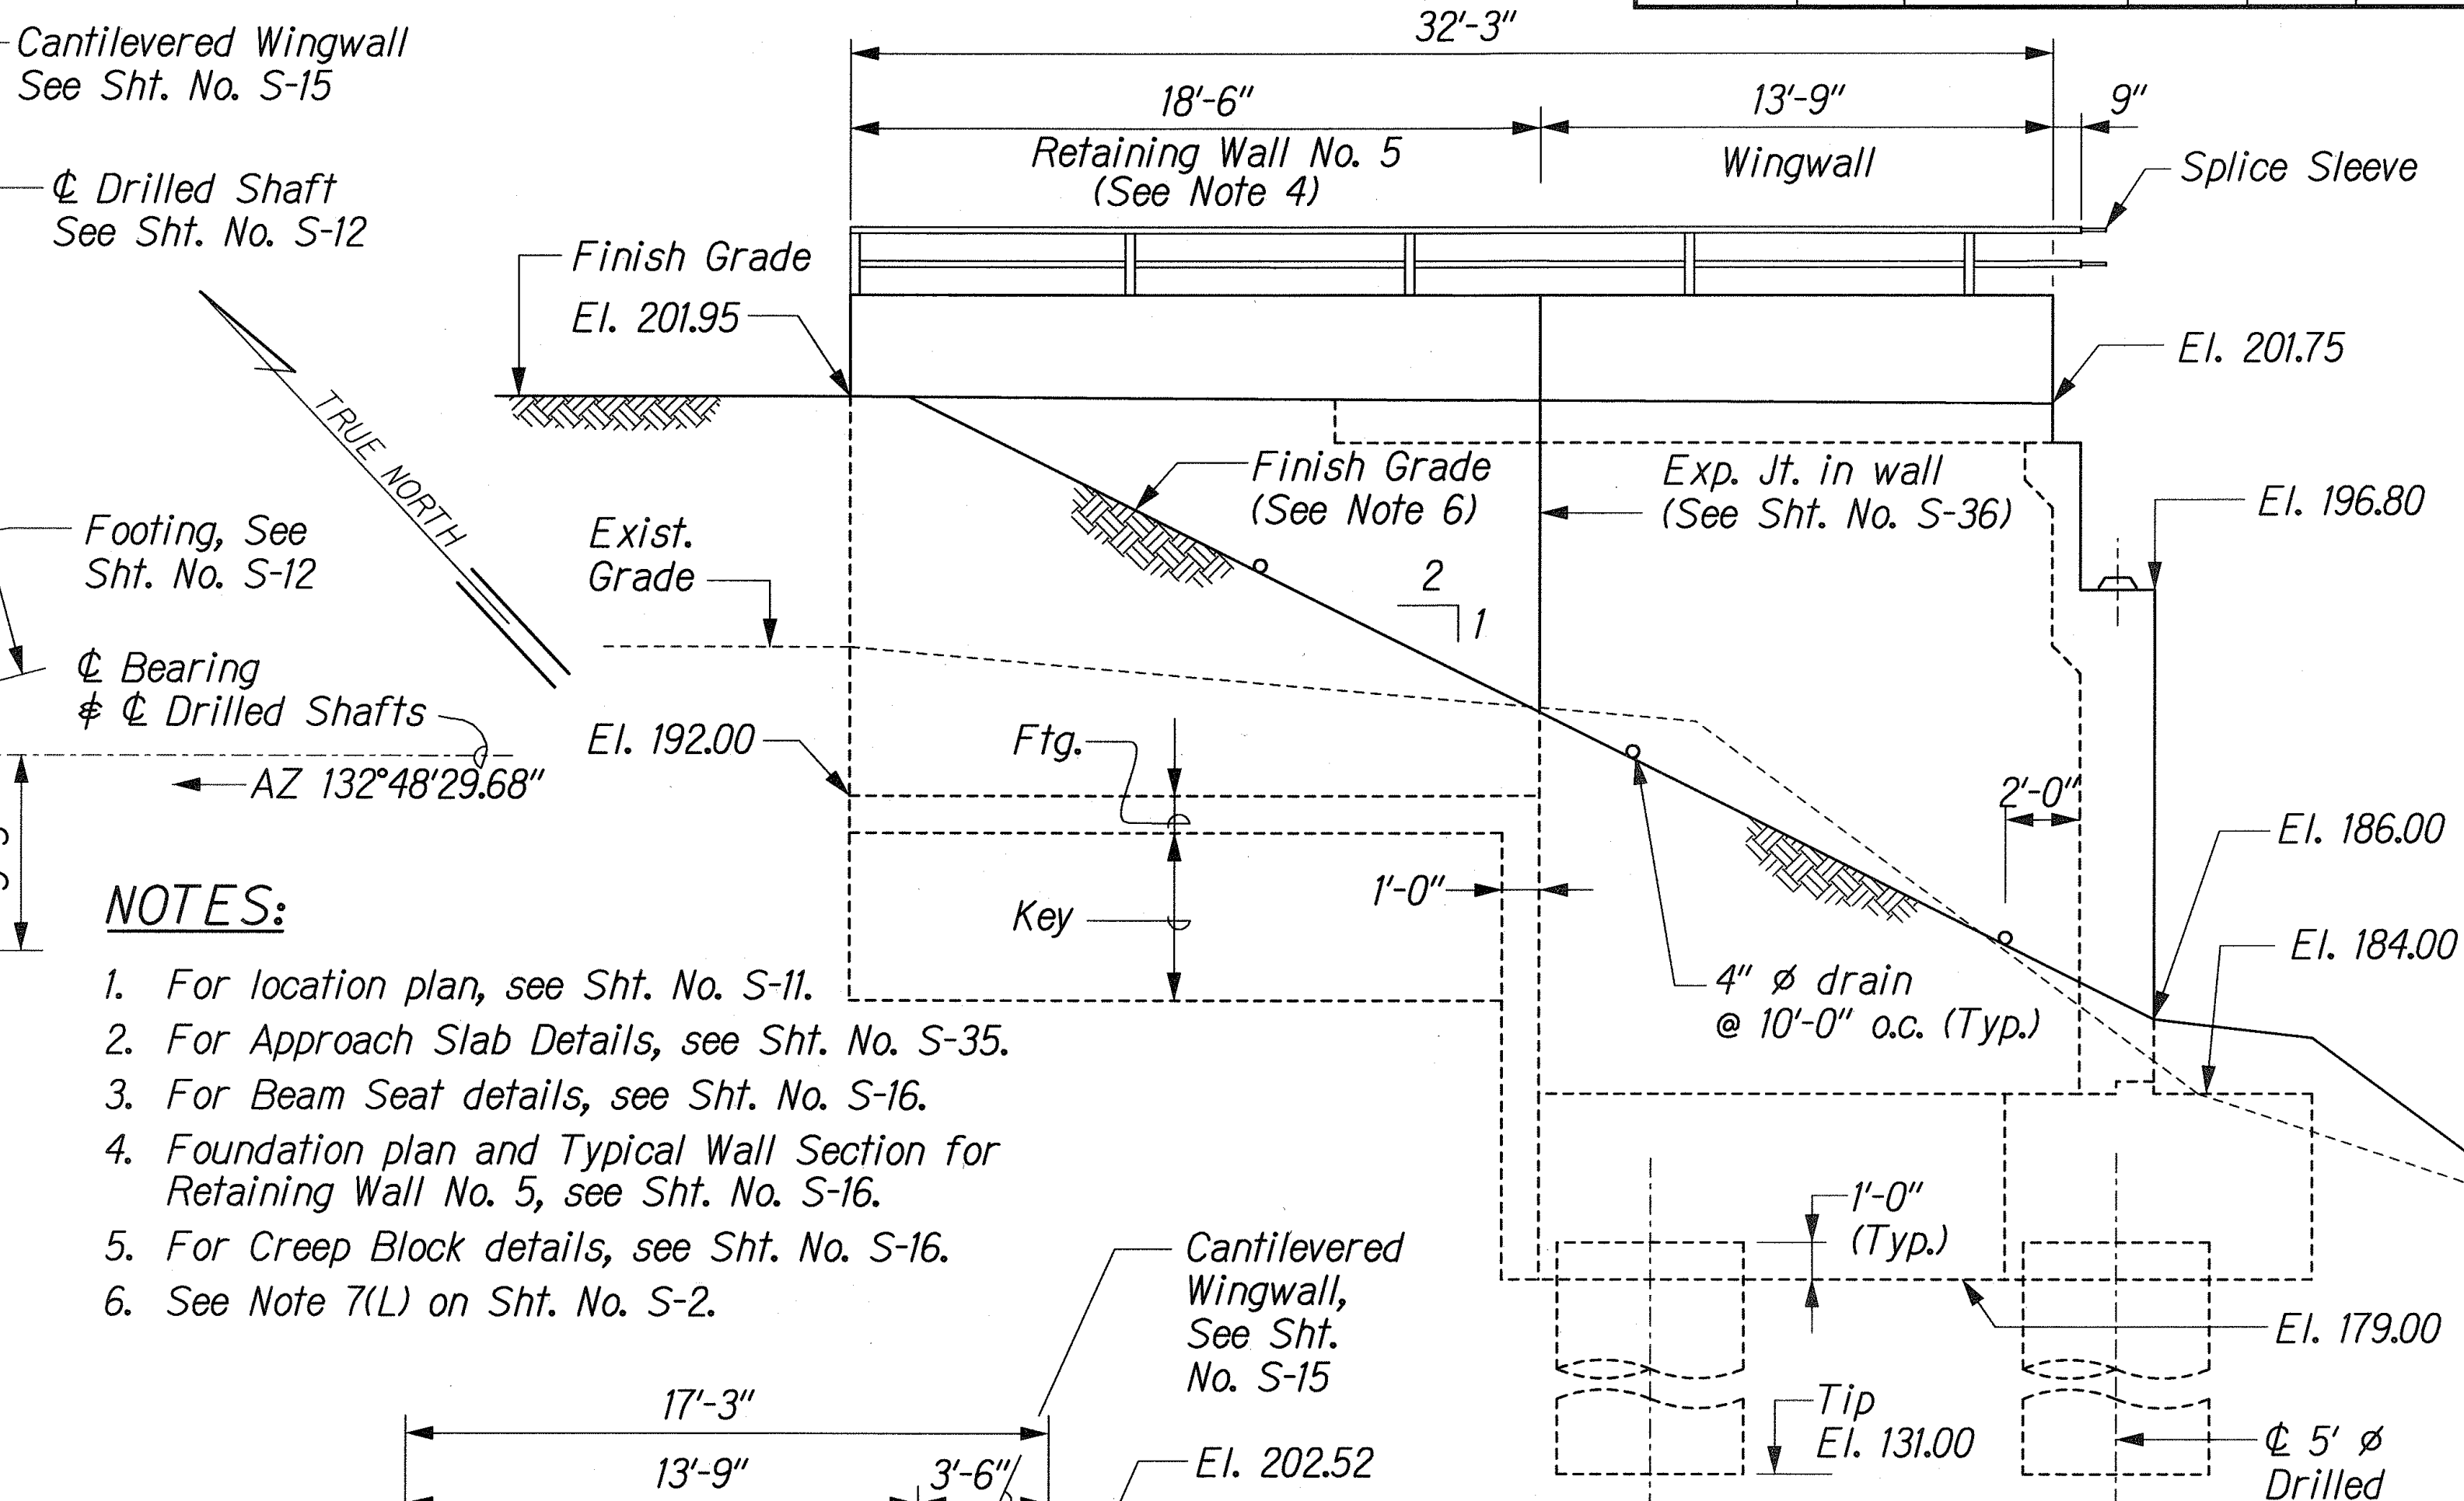

WINGWALL NO. 3 ELEVATION

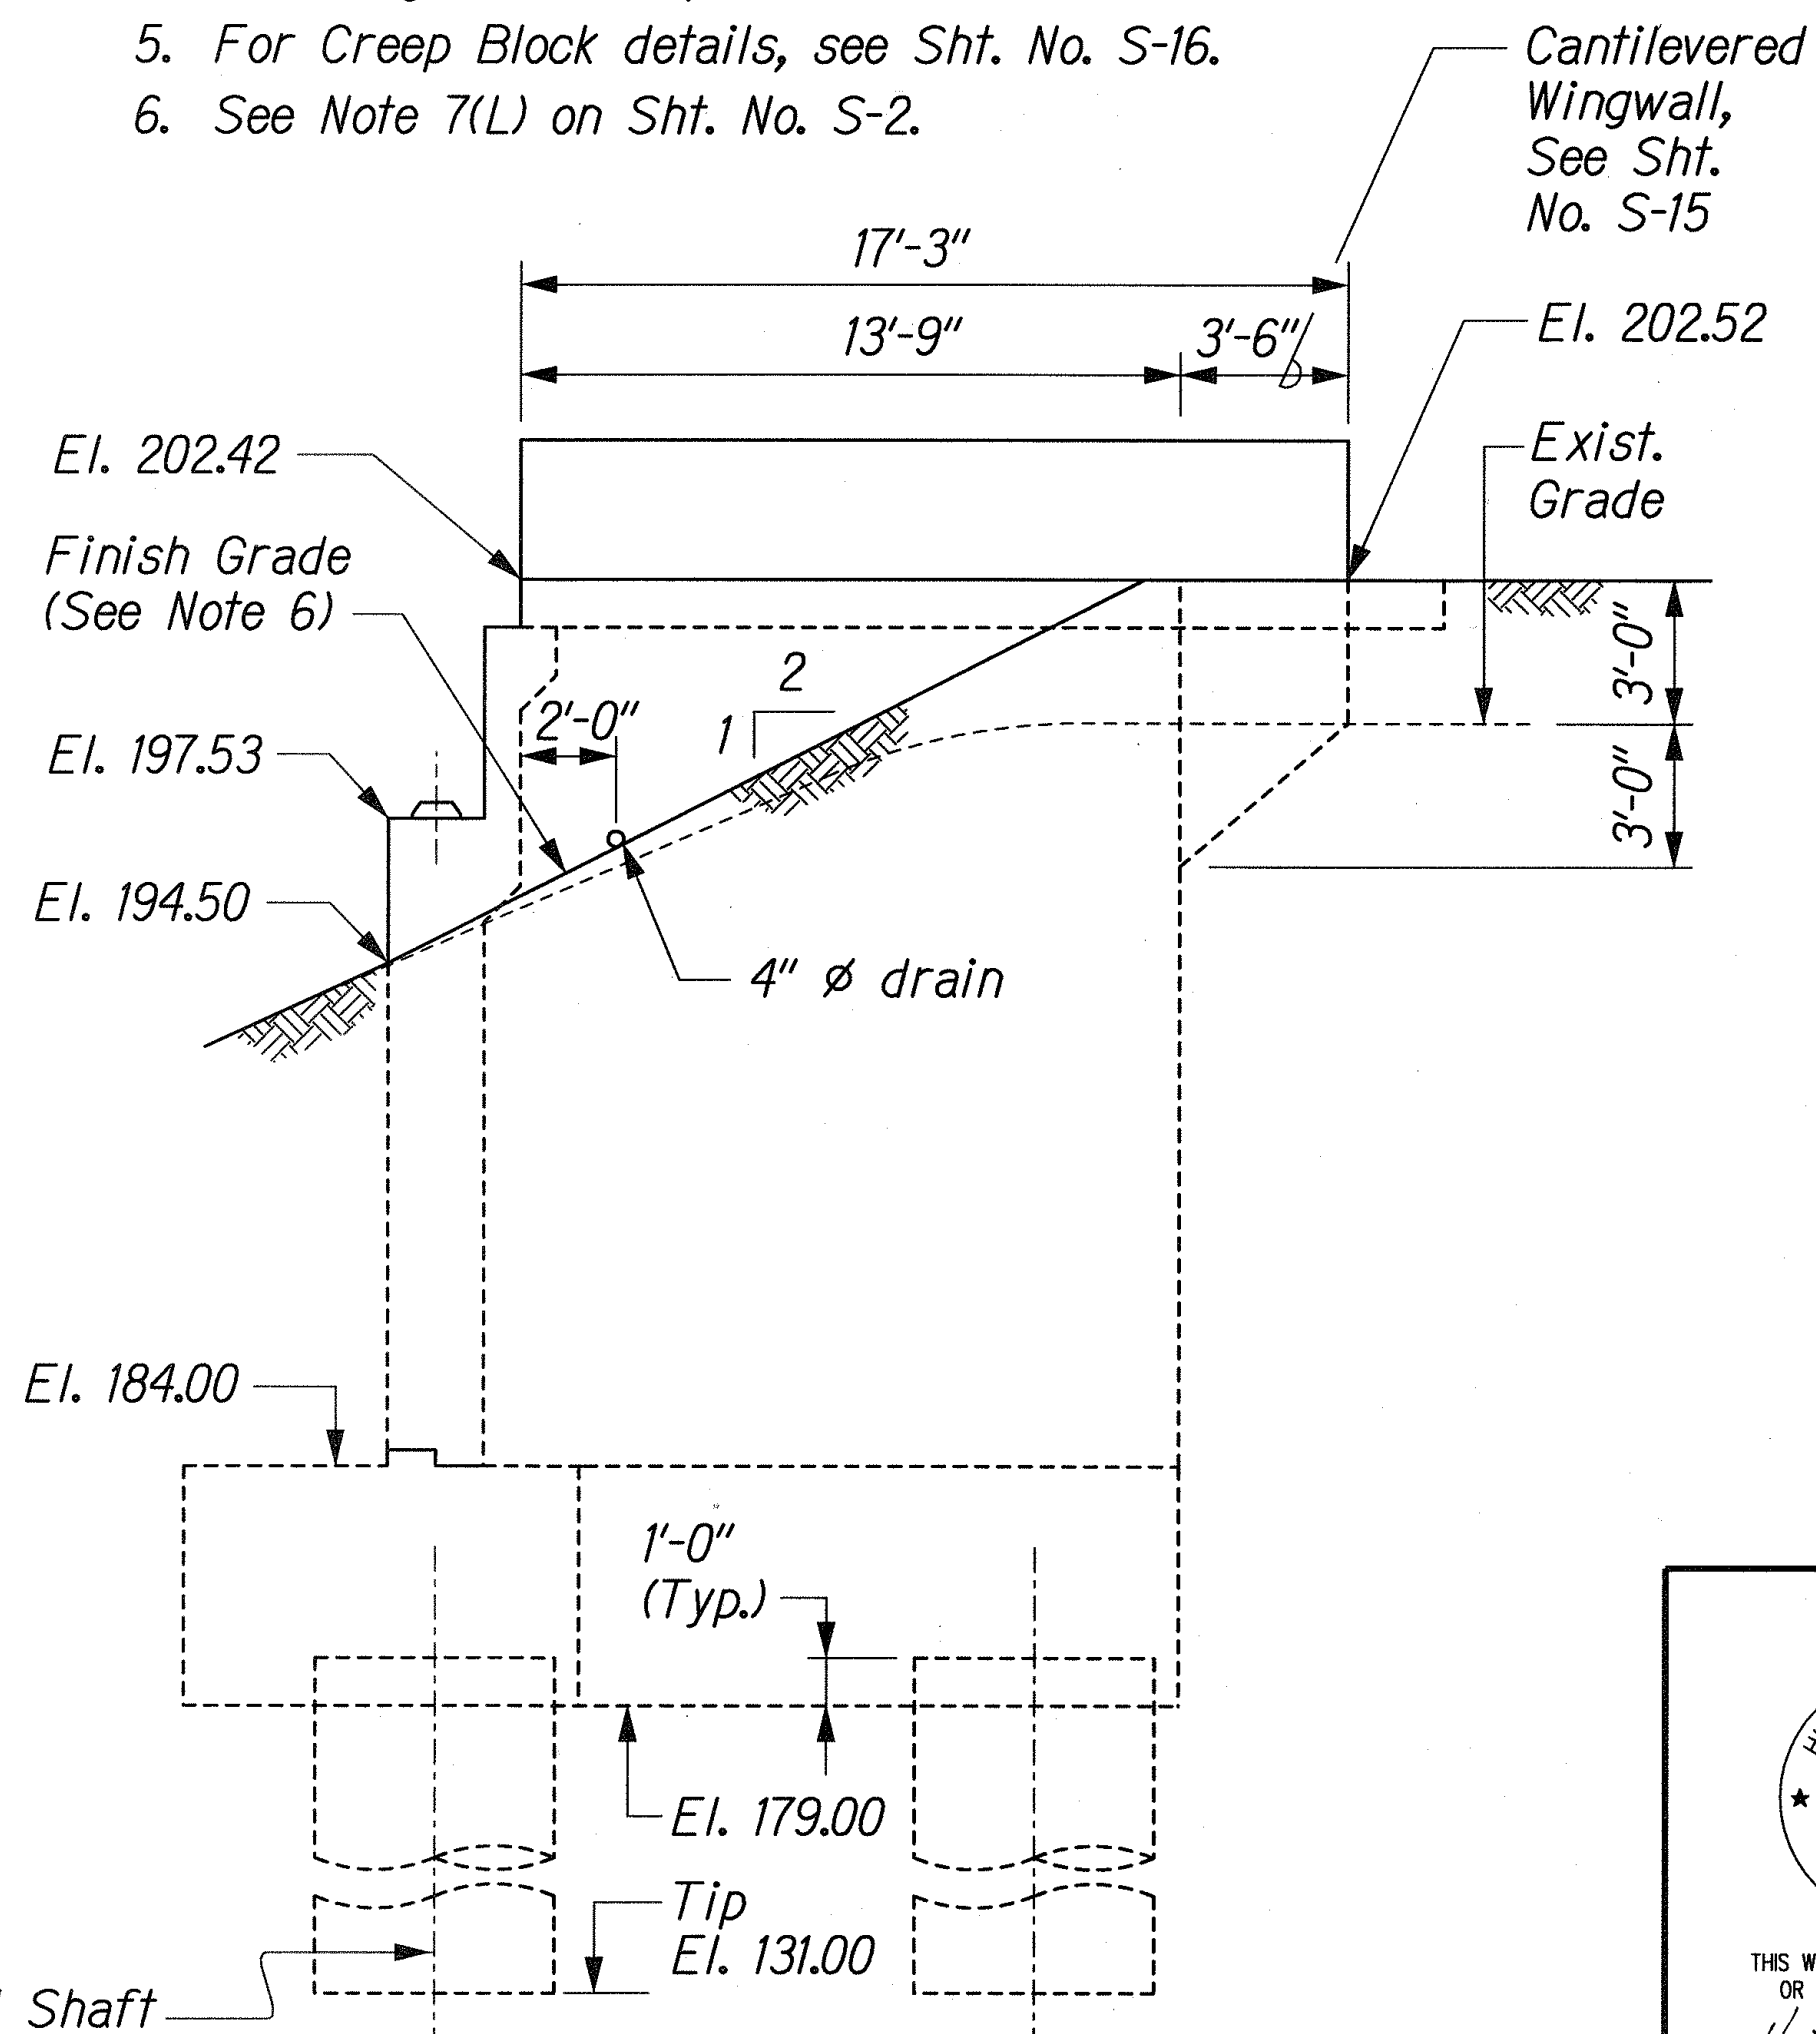

WINGWALL NO. 4 ELEVATION

NOTES:

1. For location plan, see Sht. No. S-11.
2. For Approach Slab Details, see Sht. No. S-35.
3. For Beam Seat details, see Sht. No. S-16.
4. Foundation plan and Typical Wall Section for Retaining Wall No. 5, see Sht. No. S-16.
5. For Creep Block details, see Sht. No. S-16.
6. See Note 7(L) on Sht. No. S-2.

6/27/02	Revised shaft locations, wall length and Ftg. size in Abutment No. 2 Plan View, Wingwall No. 3 Elevation and Wingwall No. 4 Elevation.
5/15/02	Revised shaft locations and Bridge Stationing of Abutment # 2, Plan View and Elevation View.
Date	Revision

HUI PANG CHEN
LICENSED PROFESSIONAL ENGINEER
No. 3865-S
HAWAII, U.S.A.

THIS WORK WAS PREPARED BY ME OR UNDER MY SUPERVISION.
Hui Pang Chen


STATE OF HAWAII
DEPARTMENT OF TRANSPORTATION
HIGHWAYS DIVISION

WAIKAPU STREAM BRIDGE
ABUTMENT SHEET 2 OF 4
KUIHELANI HIGHWAY WIDENING
HONOAPIILANI HIGHWAY TO PUUNENE AVENUE
FEDERAL-AID PROJECT NO. NH-0380(9)
Scale: 1/4" = 1'-0" Date: Sept. 14, 2001

SHEET No. S-14 OF 54 SHEETS

FED. ROAD DIST. NO.	STATE	FED. AID PROJ. NO.	FISCAL YEAR	SHEET NO.	TOTAL SHEETS
HAWAII	HAW.	NH-0380(9)	2000	C.O. 177	380

LEGEND FOR AS-BUILT POSTINGS	
	Squiggly line for as-built deletion
	Double line for as-built deletion
Roadway	Text for as-built posting

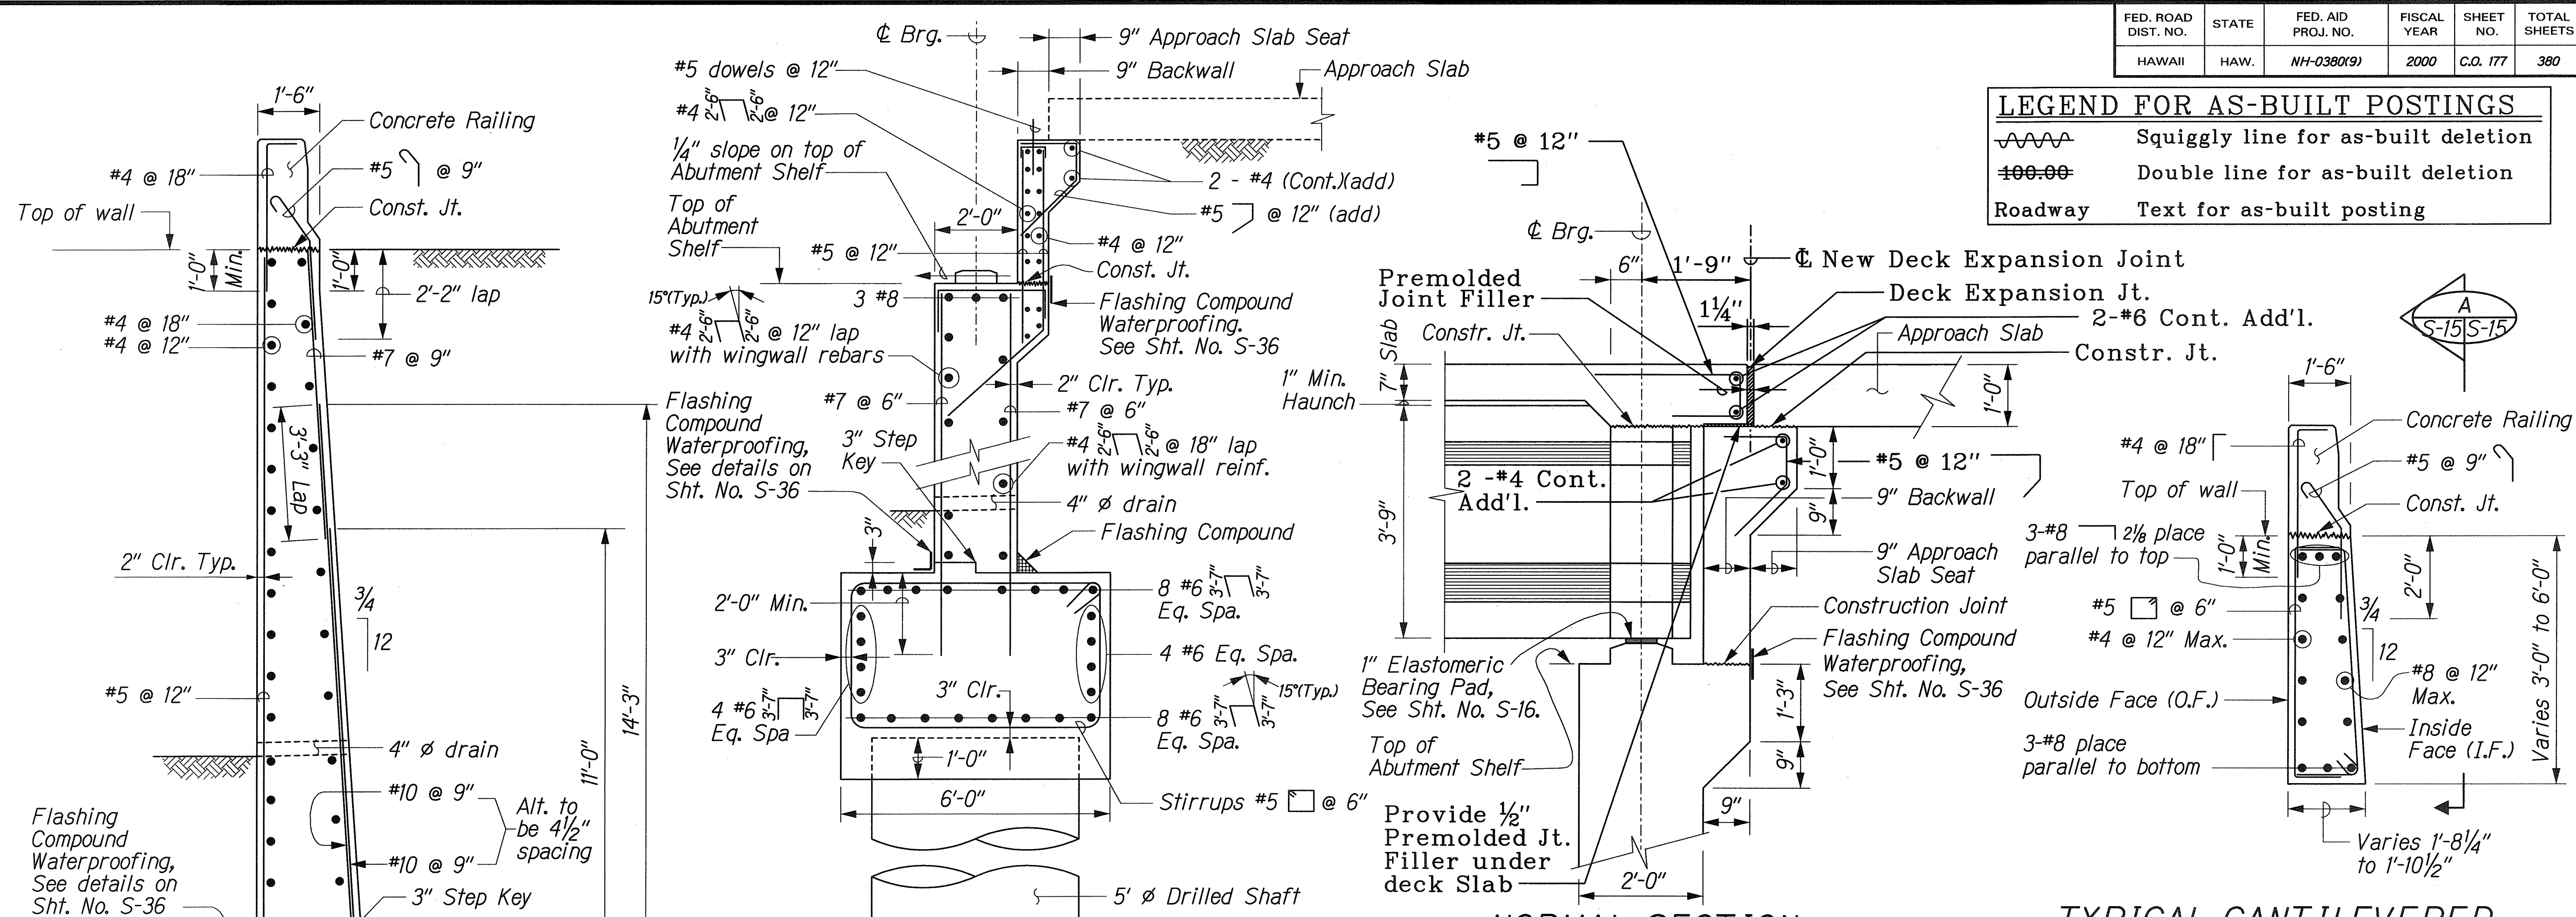

ABUTMENT NO. 1 SECTION


Scale: 1/2" = 1'-0"

NORMAL SECTION
ABUTMENT SEAT DETAIL


Scale: 3/4" = 1'-0"

TYPICAL CANTILEVERED
WINGWALL SECTION

Scale: 1/2" = 1'-0"

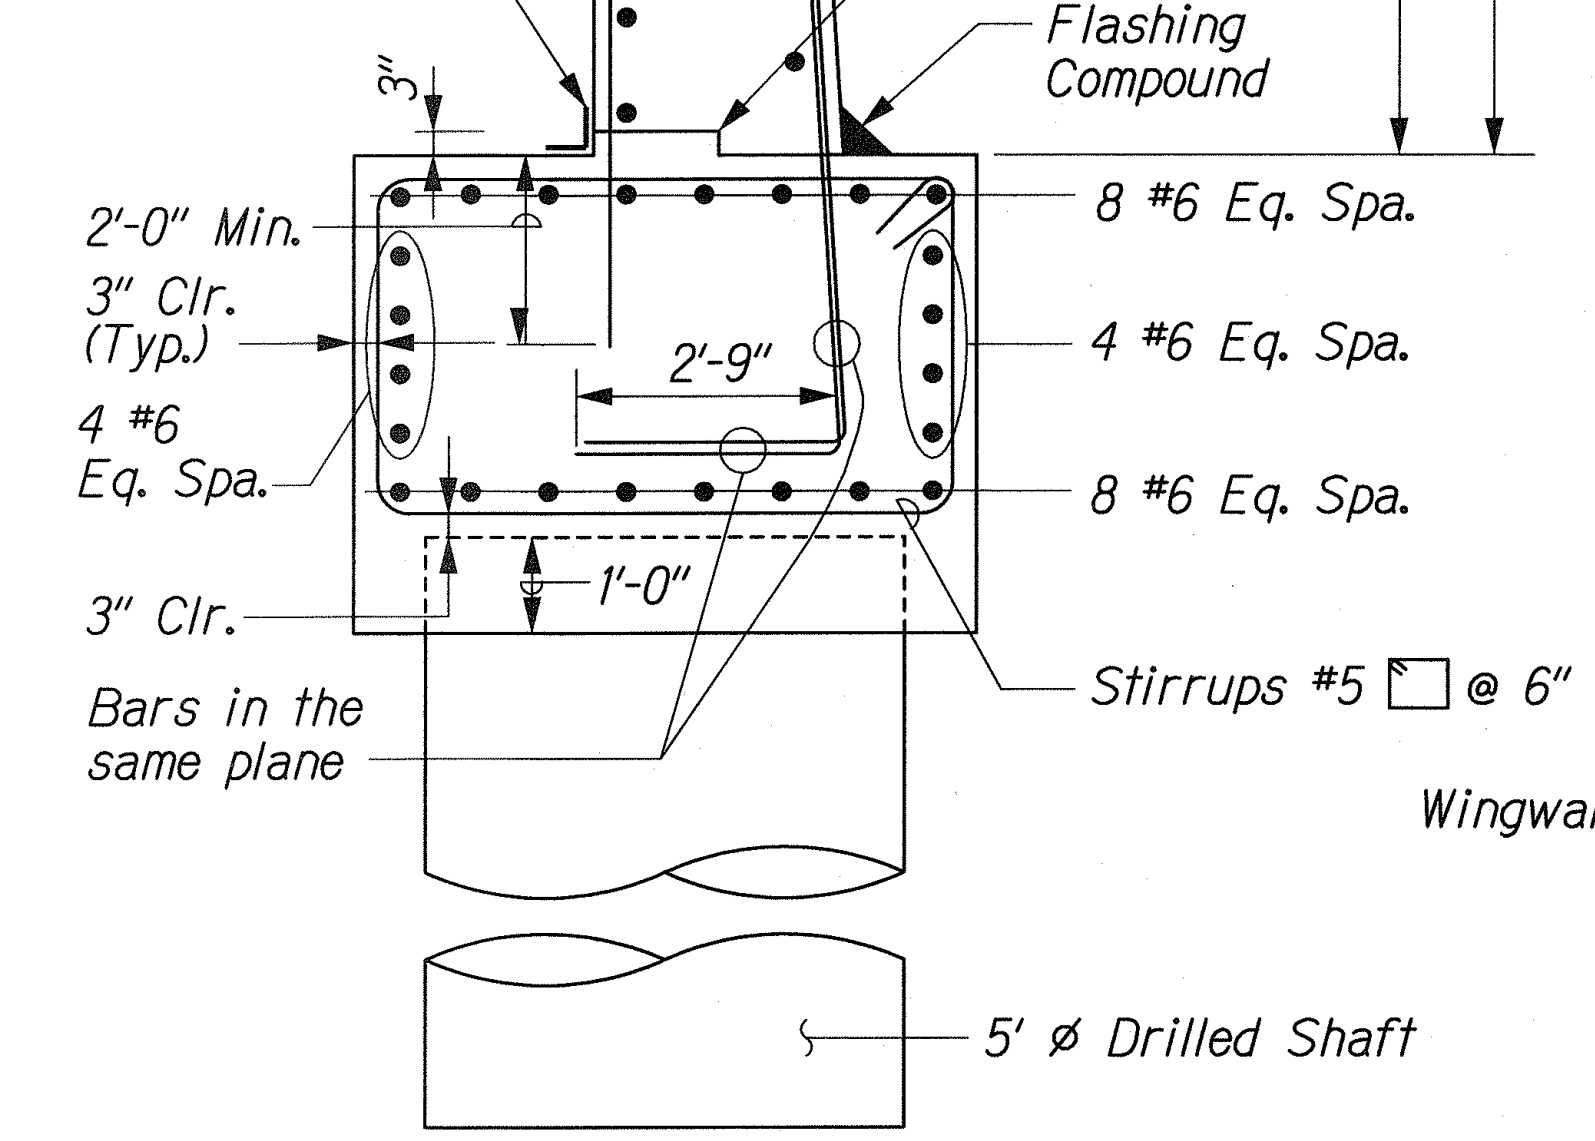

SECTION B
Scale: 1/2" = 1'-0"

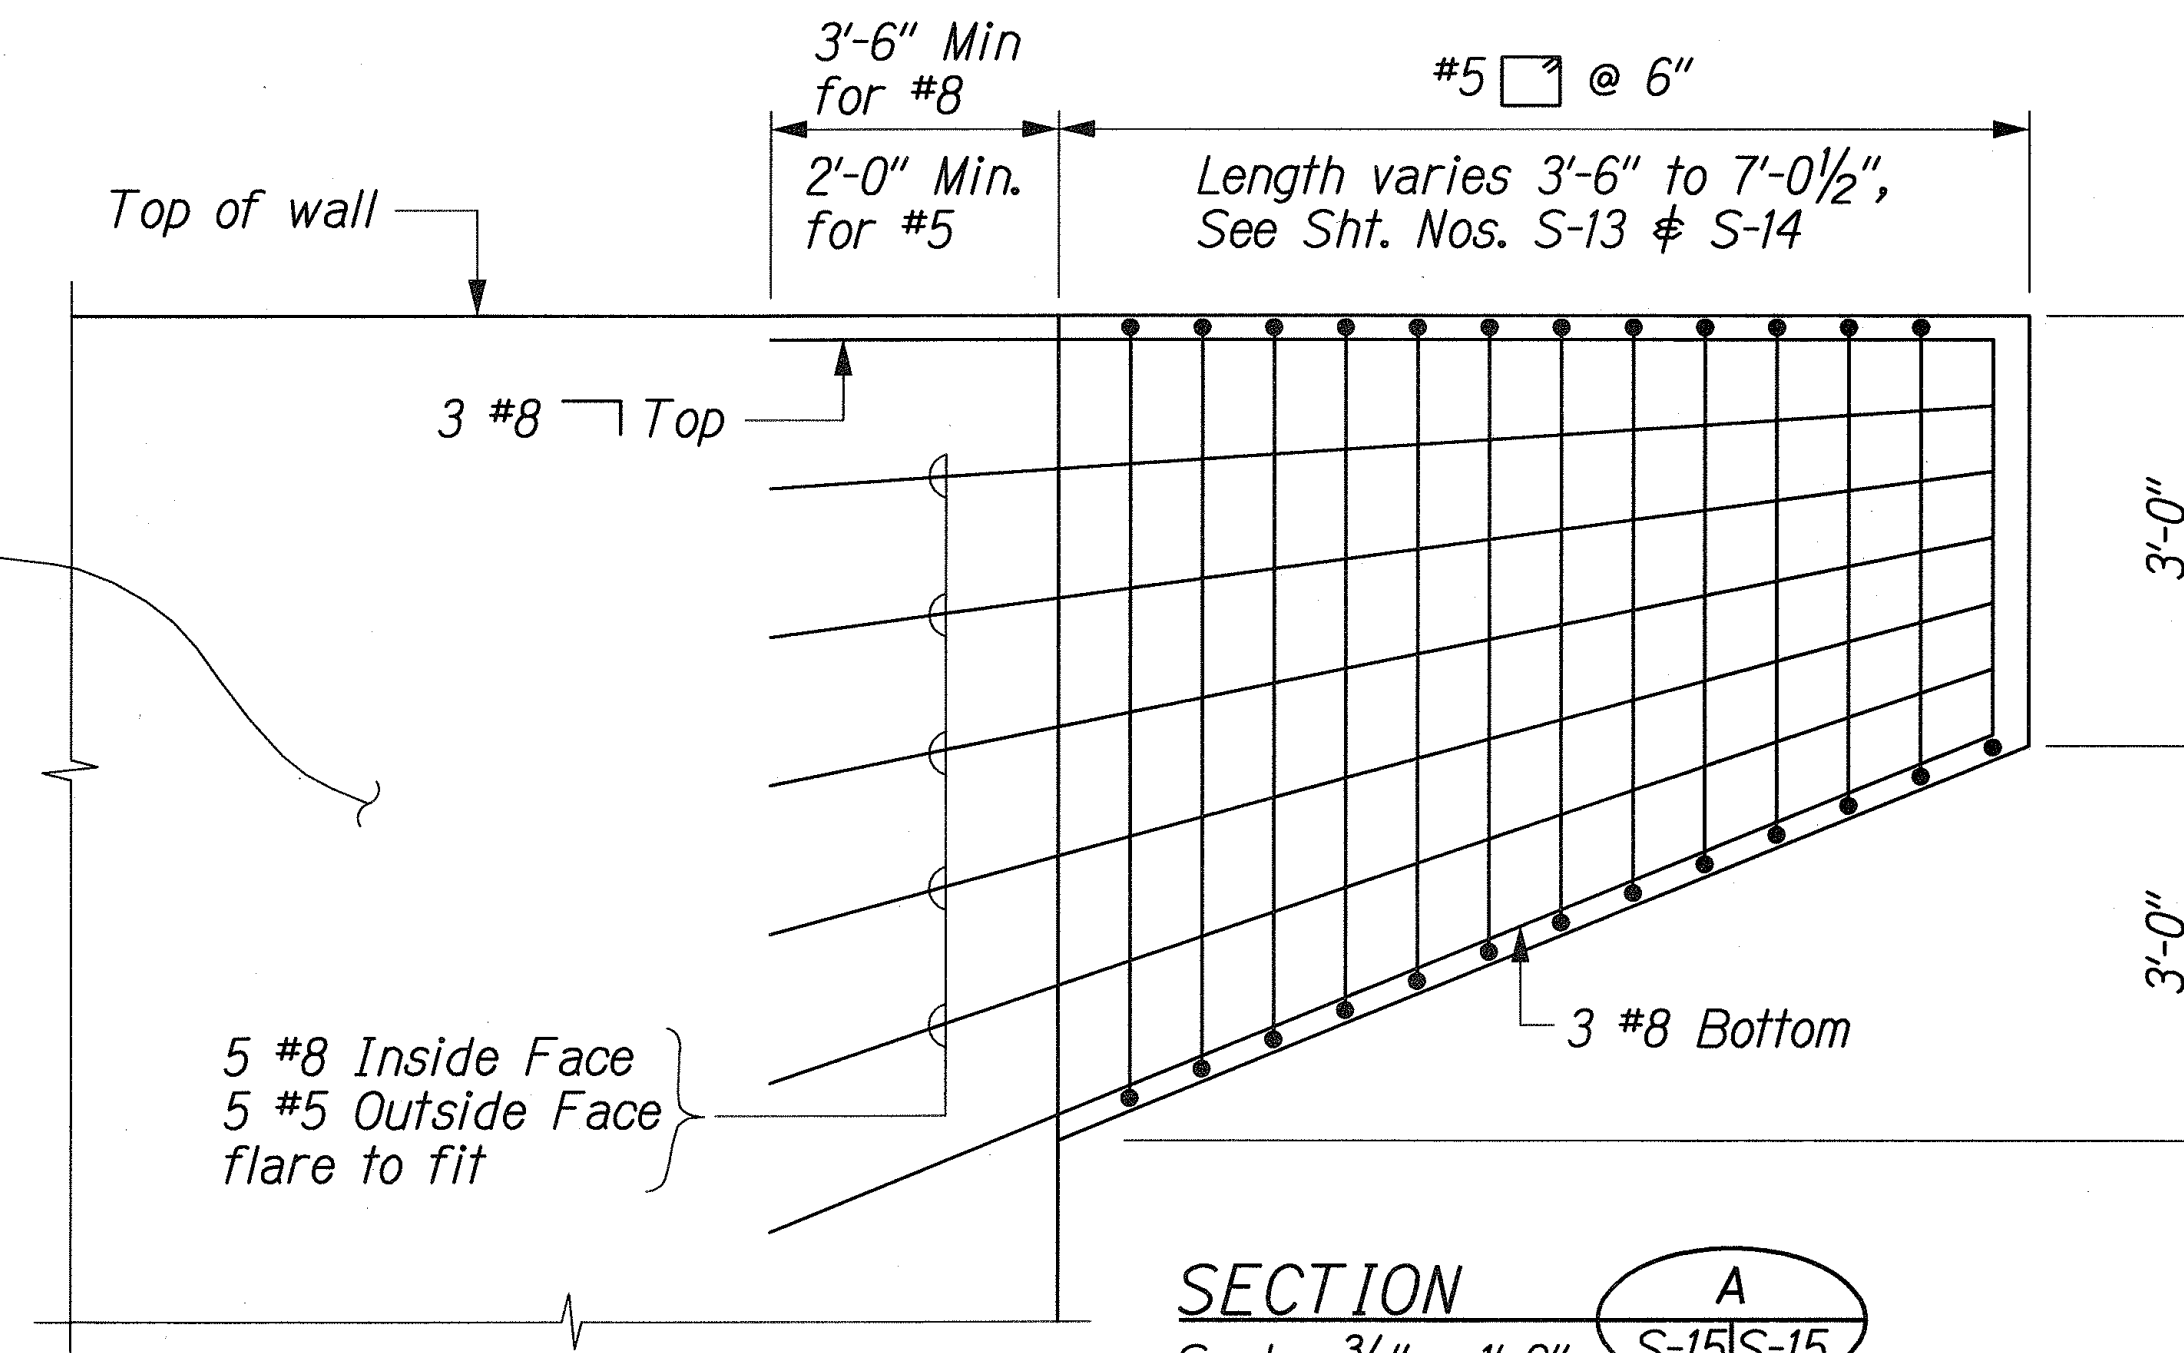


SECTION A
Scale: 3/4" = 1'-0"



NOTES:

- For Concrete Railing Details, See Sht. No. S-32.
- For Approach Slab Details, See Sht. No. S-35.
- For Deck Expansion Jt. Details, See Sht. S-35.

6/27/02	Revised Title of Typical Abutment Section to Abutment No. 1 Section. Revised Exp. Jt. and back wall detail in Normal Section Abutment Seat Detail and Abutment No. 1 Section.
5/15/02	Revised Title of Typical Wingwall Section to Section B/S-12/S-15. Added rebar clearance in Typical Abutment Section B/S-12/S-15.
Date	Revision

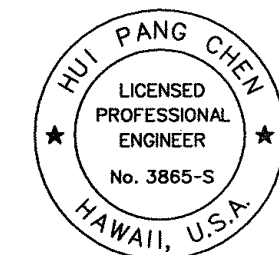

STATE OF HAWAII
DEPARTMENT OF TRANSPORTATION
HIGHWAYS DIVISION
WAIKAPU STREAM BRIDGE
ABUTMENT SHEET 3 OF 4
KUIHELANI HIGHWAY WIDENING
HONOAPIILANI HIGHWAY TO PUUNENE AVENUE
FEDERAL-AID PROJECT NO. NH-0380(9)
Scale: As Shown Date: Sept. 14, 2001

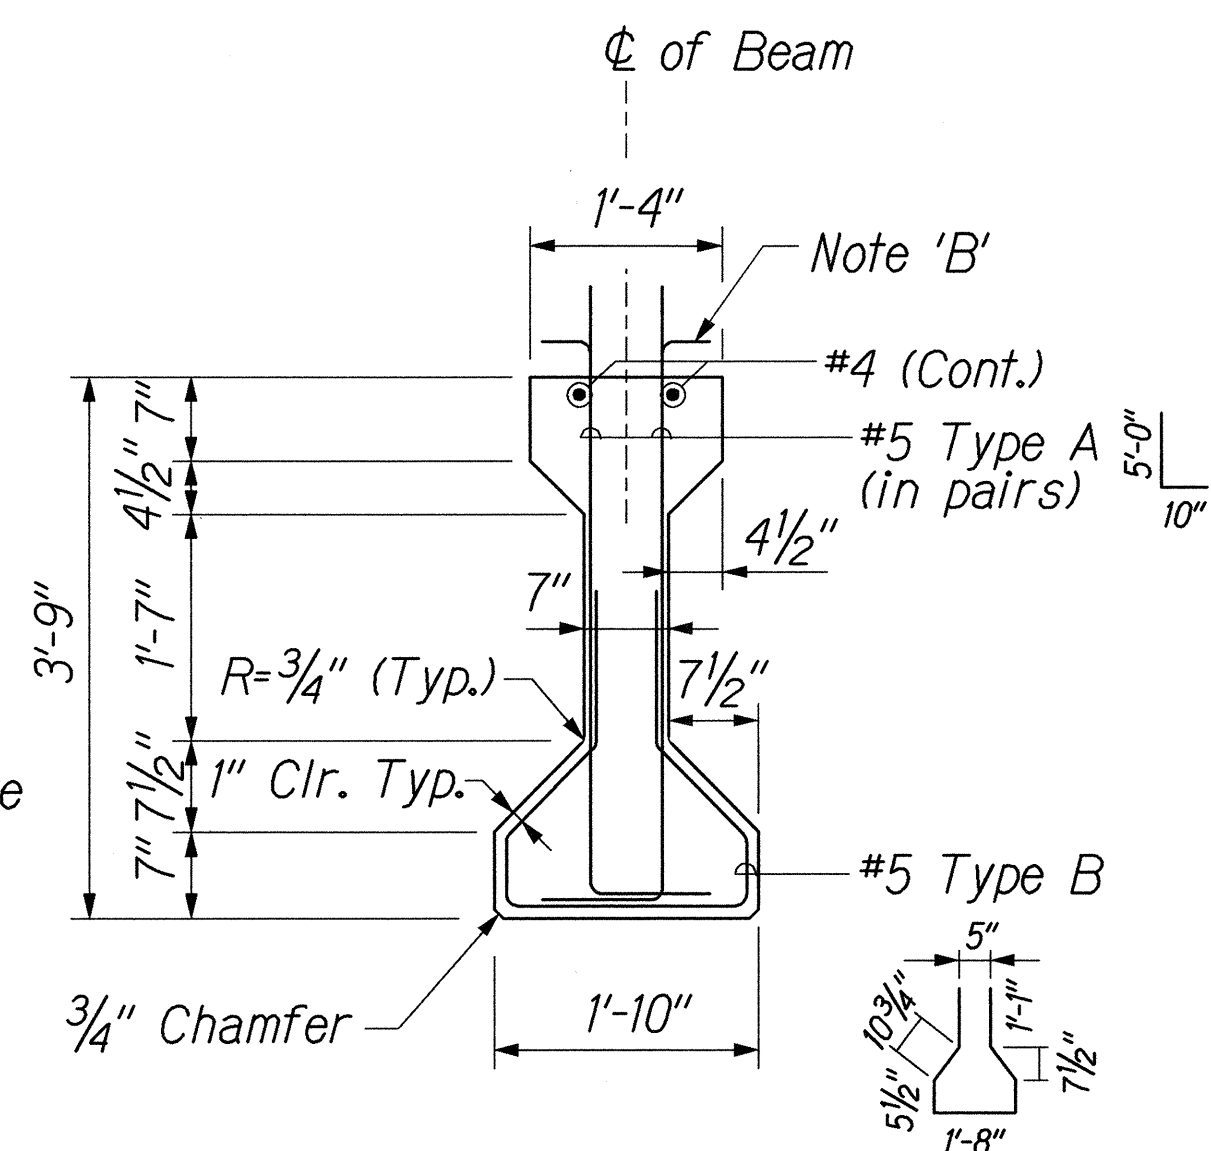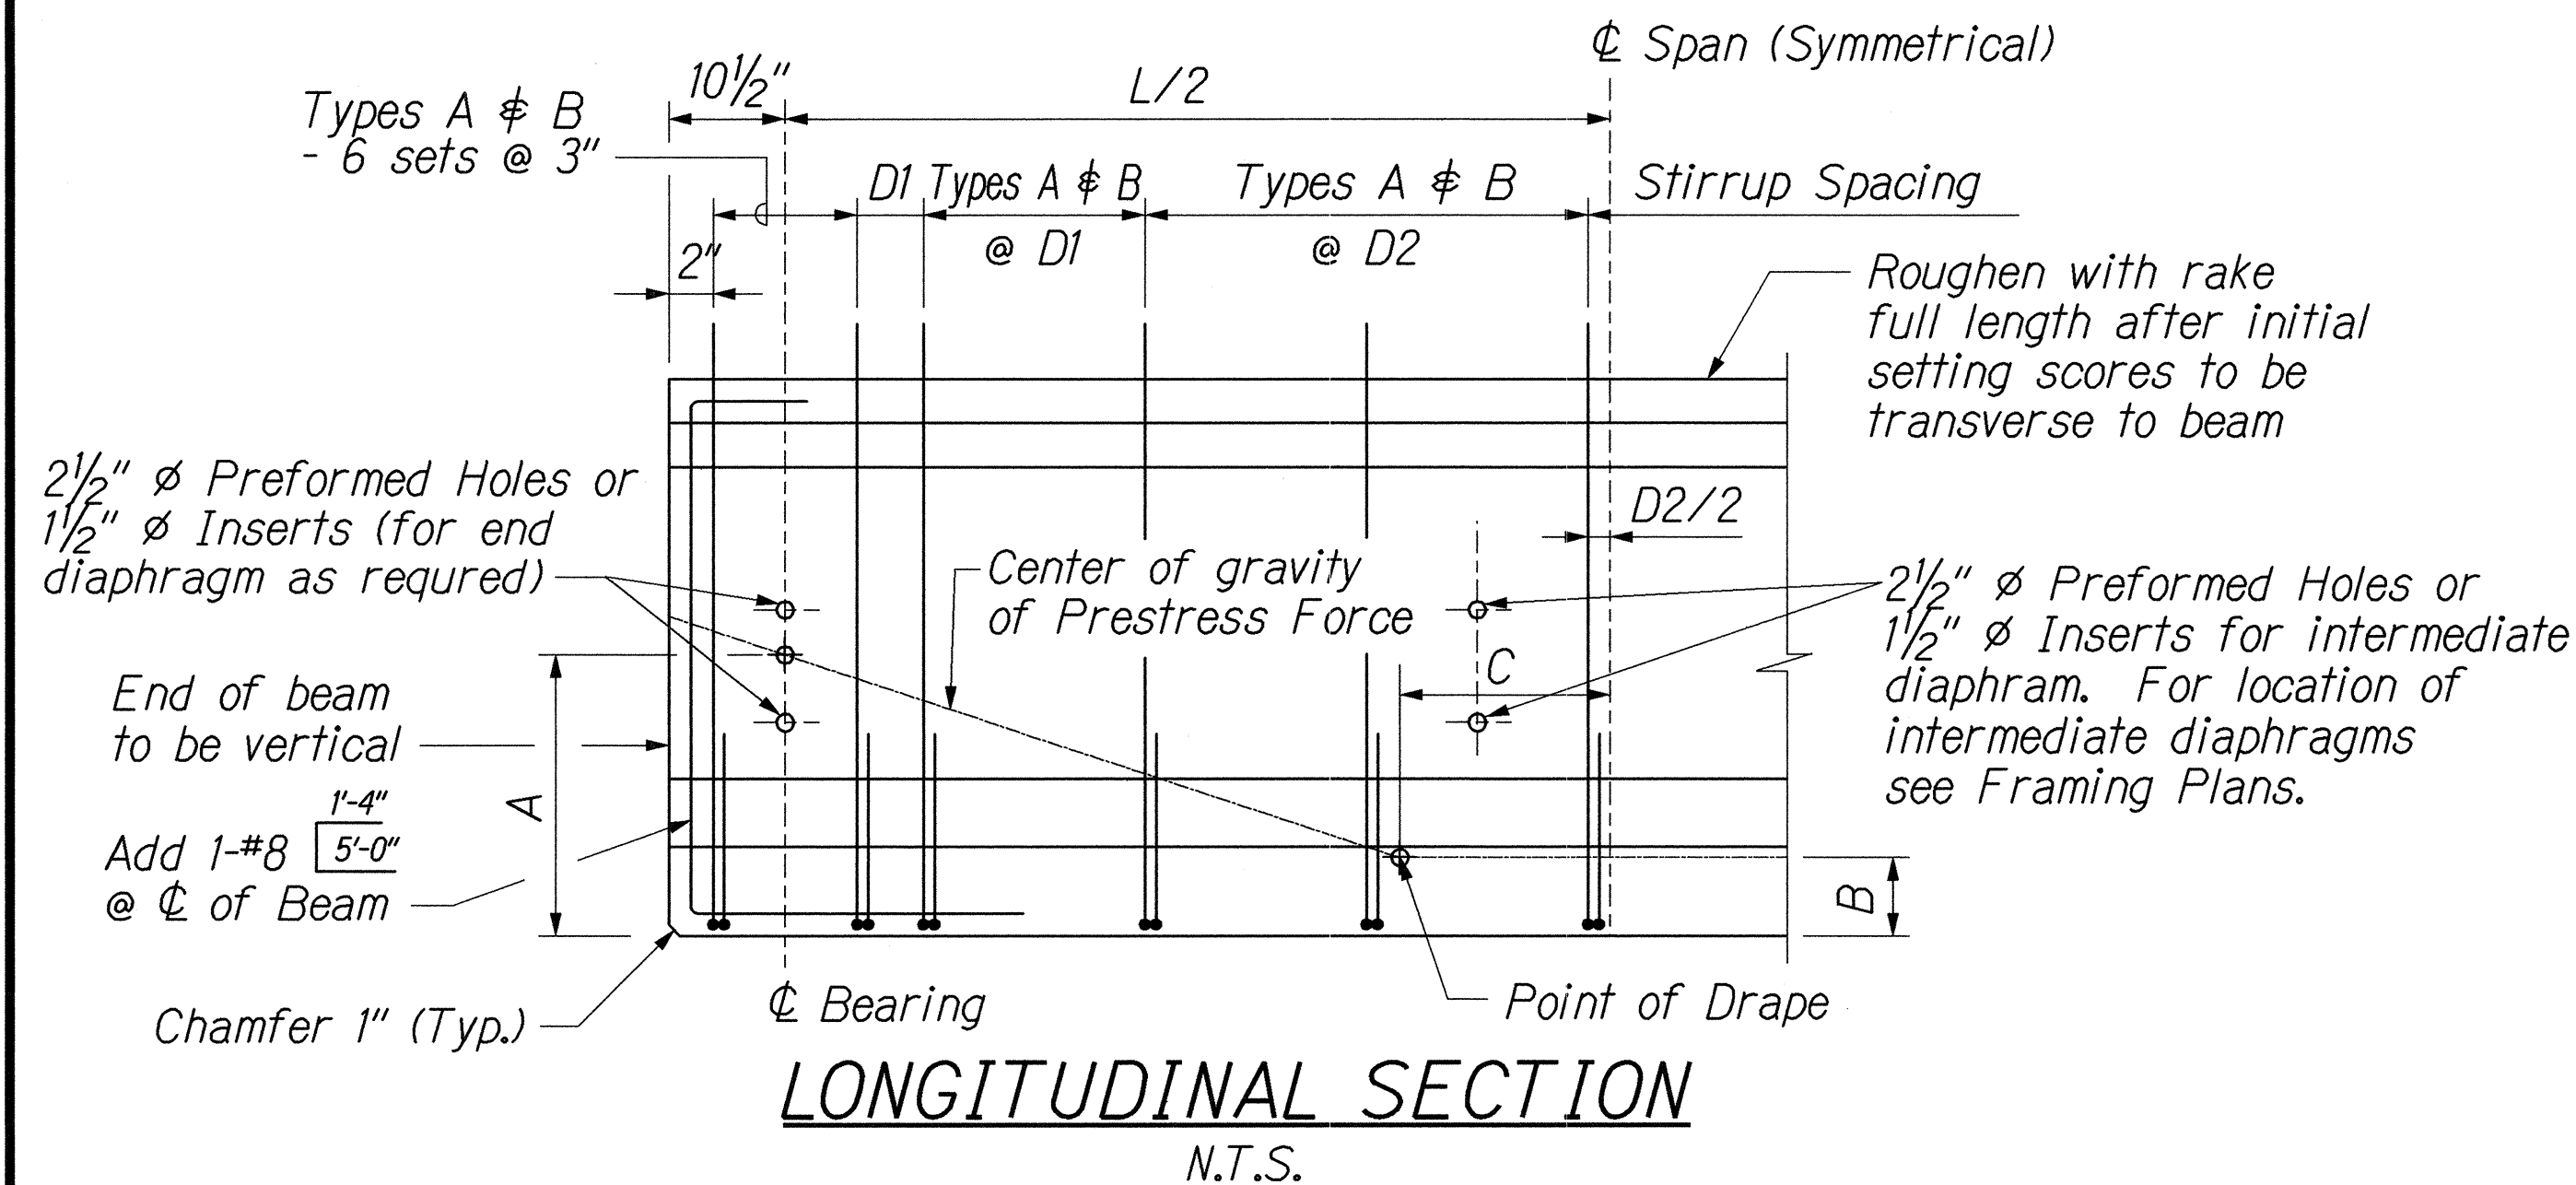

PRESTRESSED BEAM NOTES:



- Concrete strength for precast/prestressed concrete beam shall be 6000 psi at 28 days.
- Minimum compressive strength of concrete at transfer, see Table this Sheet.
- Prestressing strands shall be 1/2" diameter, 270 ksi, low-relax strands conforming to ASTM A 416. The estimated total losses due to creep, shrinkage, elastic shortening, and relaxation of steel are 53,000 psi.
- Non-prestressed reinforcing steel in prestressed beam shall be Grade 60 unless otherwise noted. For properties, see State Standard Specifications.
- The calculated camber includes the effect of the initial prestress force and the weight of the beam after removal from the bed. Positive values shown for calculated camber indicate a net upward deflection. The calculated camber value has been multiplied by a factor of 2 to approximate the effect of camber growth and concrete creep. The actual camber shall not exceed the calculated camber by more than 1/2".
- The dead load deflection includes the combined effects of the weight of beam, slab, haunch, diaphragm, and concrete railing.
- Strand release sequence shall not induce any lateral deflection of the beam. For Strand release procedures, see Special Provisions.
- The Contractor shall submit his proposed strand releasing sequence to the Engineer for acceptance.
- During curing, care shall be taken to avoid any lateral deflection of the beam due to improper orientation.
- Lifting devices shall be placed as close as possible to the centerline of bearings of the beam. Details and locations of lifting devices shall be submitted to the Engineer for acceptance. Such approval does not relieve the Contractor of his responsibilities if beam is damaged due to the failure of the lifting device.
- For details of end and intermediate diagrams see Sheet No. S-18.

NOTE 'A':


For low relaxation strands, the stress immediately prior to transfer shall not exceed 0.75 fs', where fs' is the ultimate tensile strength of prestressing steel.

NOTE 'B':


Bend bars in field 2" below top of deck. All reinforcing dimensions are out to out.

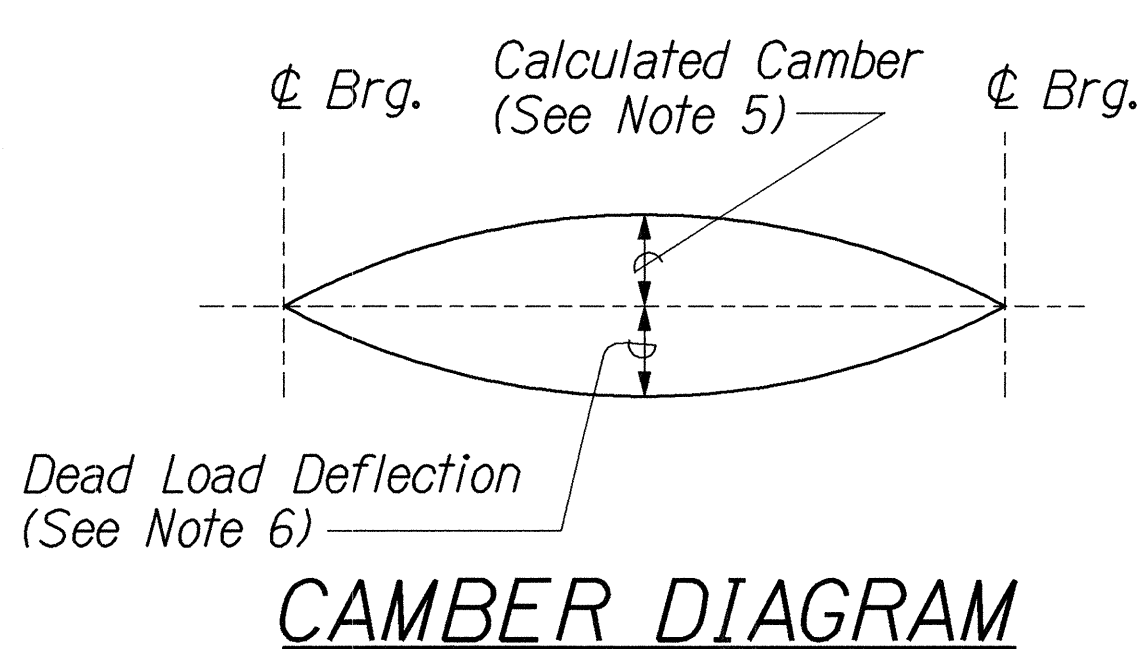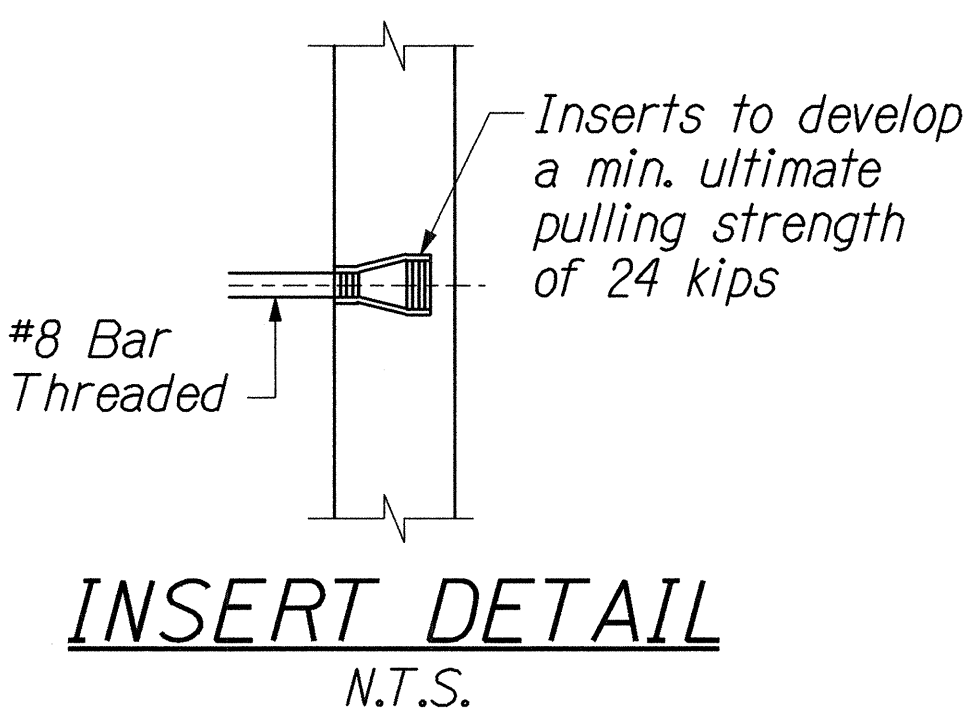

BEAM SCHEDULE										
BEAM TYPE	INITIAL PRESTRESS FORCE (KIPS) (BEFORE ANY LOSS)	FINAL PRESTRESS FORCE (KIPS) (AFTER ALL LOSSES)	CALCULATED CAMBER SEE NOTE 5	DEAD LOAD DEFLECTION SEE NOTE 6	LOCATION OF CENTER OF GRAVITY OF PRESTRESSED FORCE			STIRRUPS		REMARKS
					DIST A	DIST B	DIST. TO PT. OF DRAPE C	NO. OF STIRRUPS @ SPACING D1	NO. OF STIRRUPS @ SPACING D2	
III	743.58	548.76	-0.969"	0.59"	12.5"	5.667"	5.8'	11 @ 12"	Balance @ 18"	4500

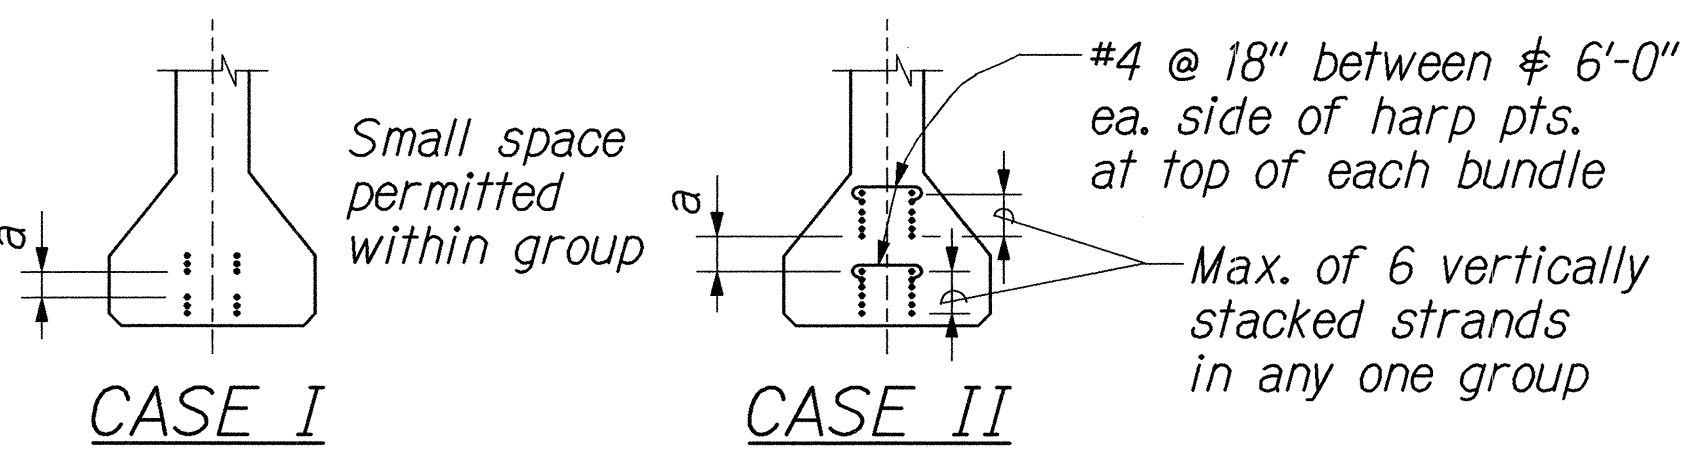

- ARRANGEMENT AND CLEARANCE FOR PRETENSIONED STRANDS
- Strands may be bundled in groups as shown.
 - The min. distance "a" between groups or individual strands is 2" for 1/2" ϕ Strands.
 - "a" is measured between centers of adjacent strands.

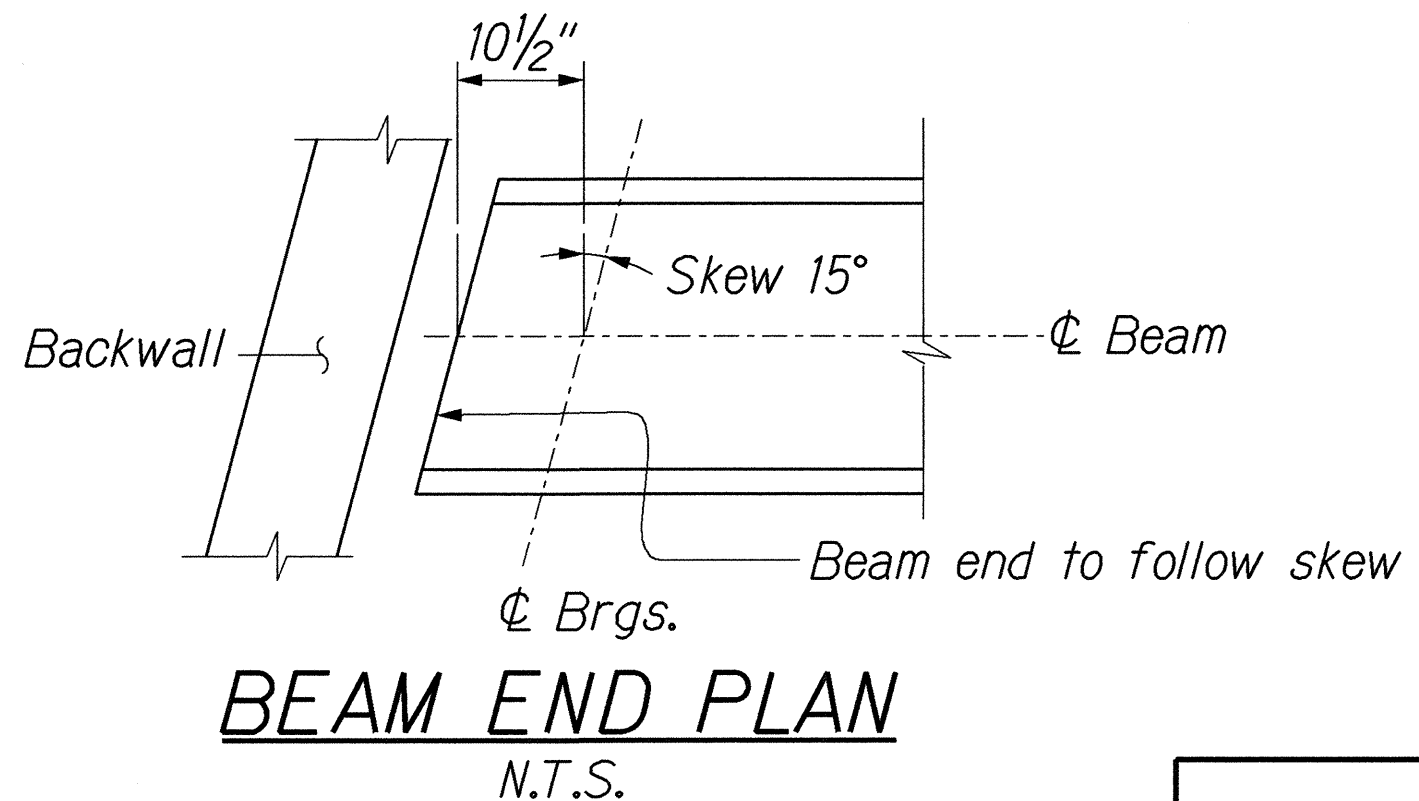


THIS WORK WAS PREPARED BY ME OR UNDER MY SUPERVISION.


Hui Pang Chen

STATE OF HAWAII
DEPARTMENT OF TRANSPORTATION
HIGHWAYS DIVISION
WAIKAPU STREAM BRIDGE
PRESTRESSED BEAM DETAILS-1
KUIHELANI HIGHWAY WIDENING
HONOAPIILANI HIGHWAY TO PUUNENE AVENUE
FEDERAL-AID PROJECT NO. NH-0380(9)
Scale: Not to Scale Date: Sept. 14, 2001


FED. ROAD DIST. NO.	STATE	FED. AID PROJ. NO.	FISCAL YEAR	SHEET NO.	TOTAL SHEETS
HAWAII	HAW.	NH-0380(9)	2000	181	380

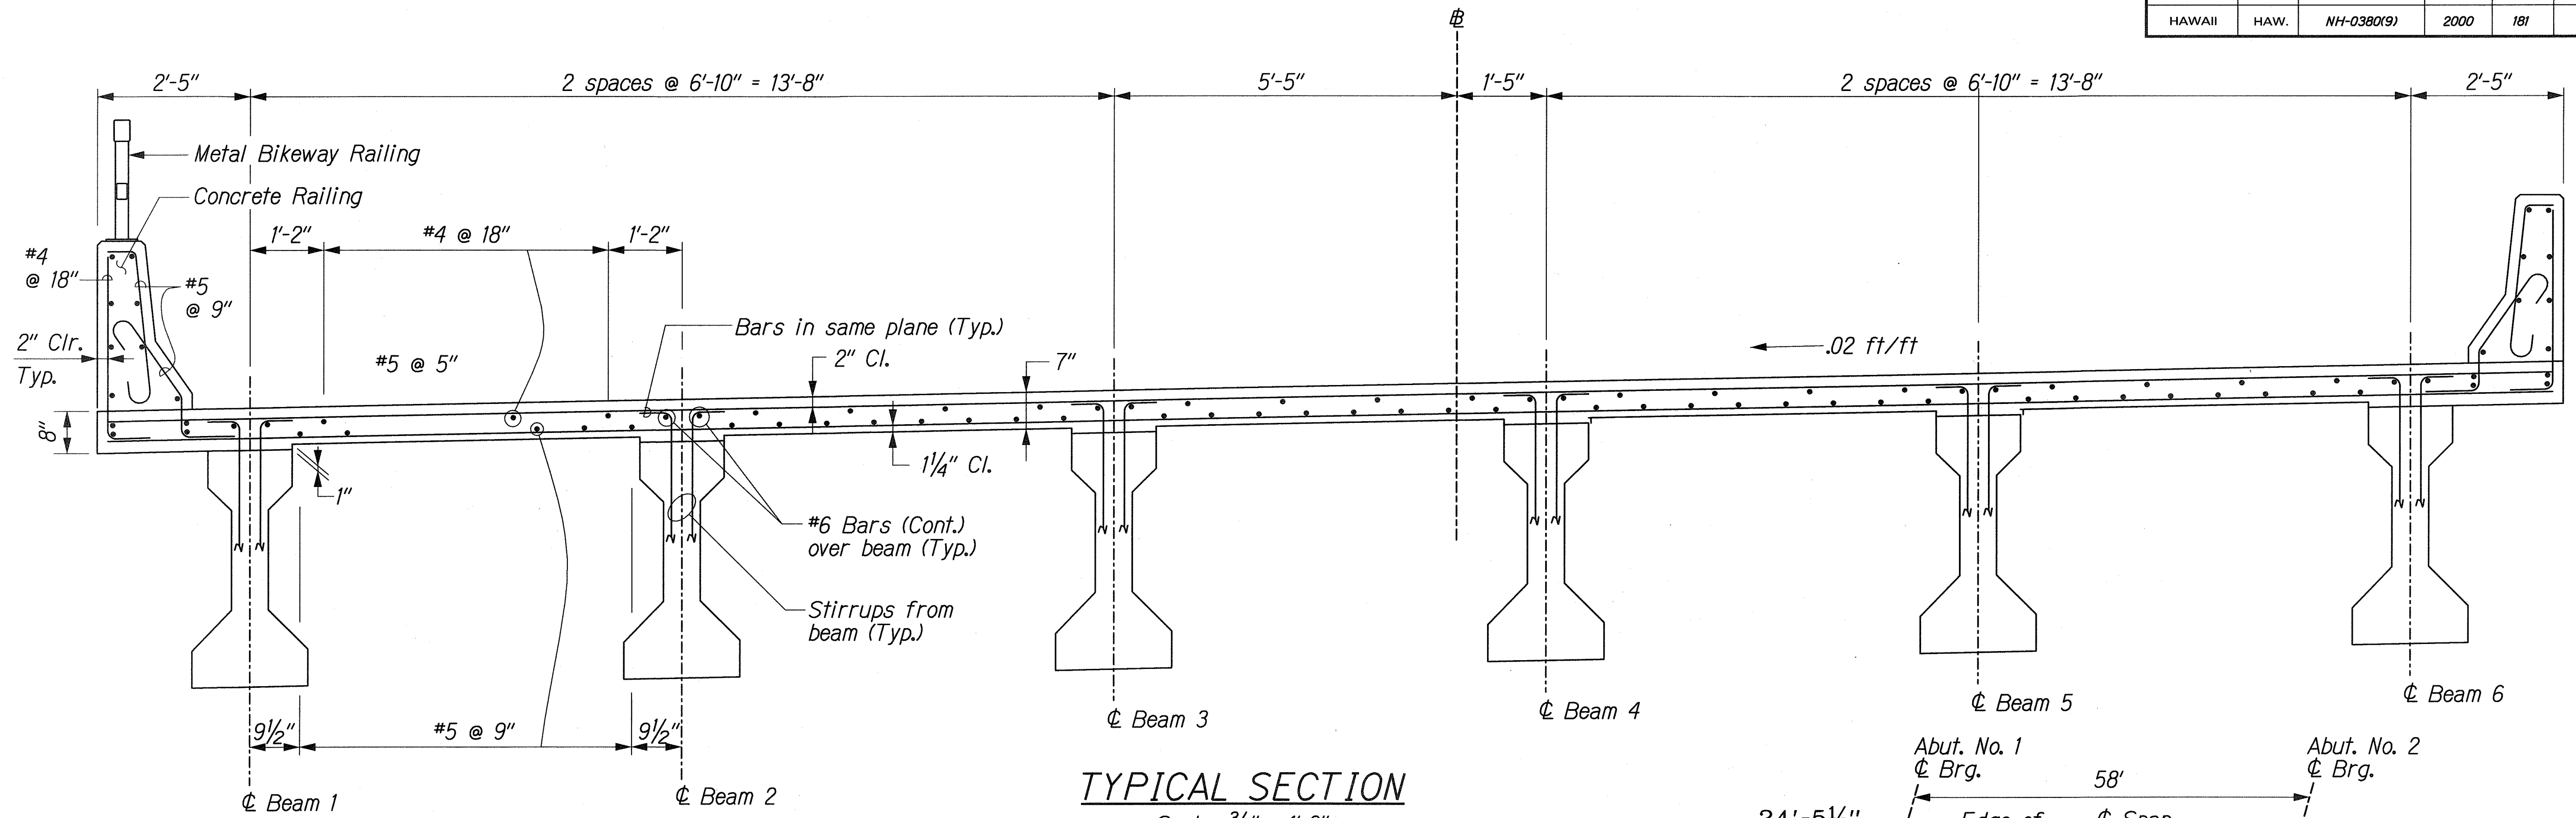

TYPICAL SECTION
Scale: 3/4" = 1'-0"

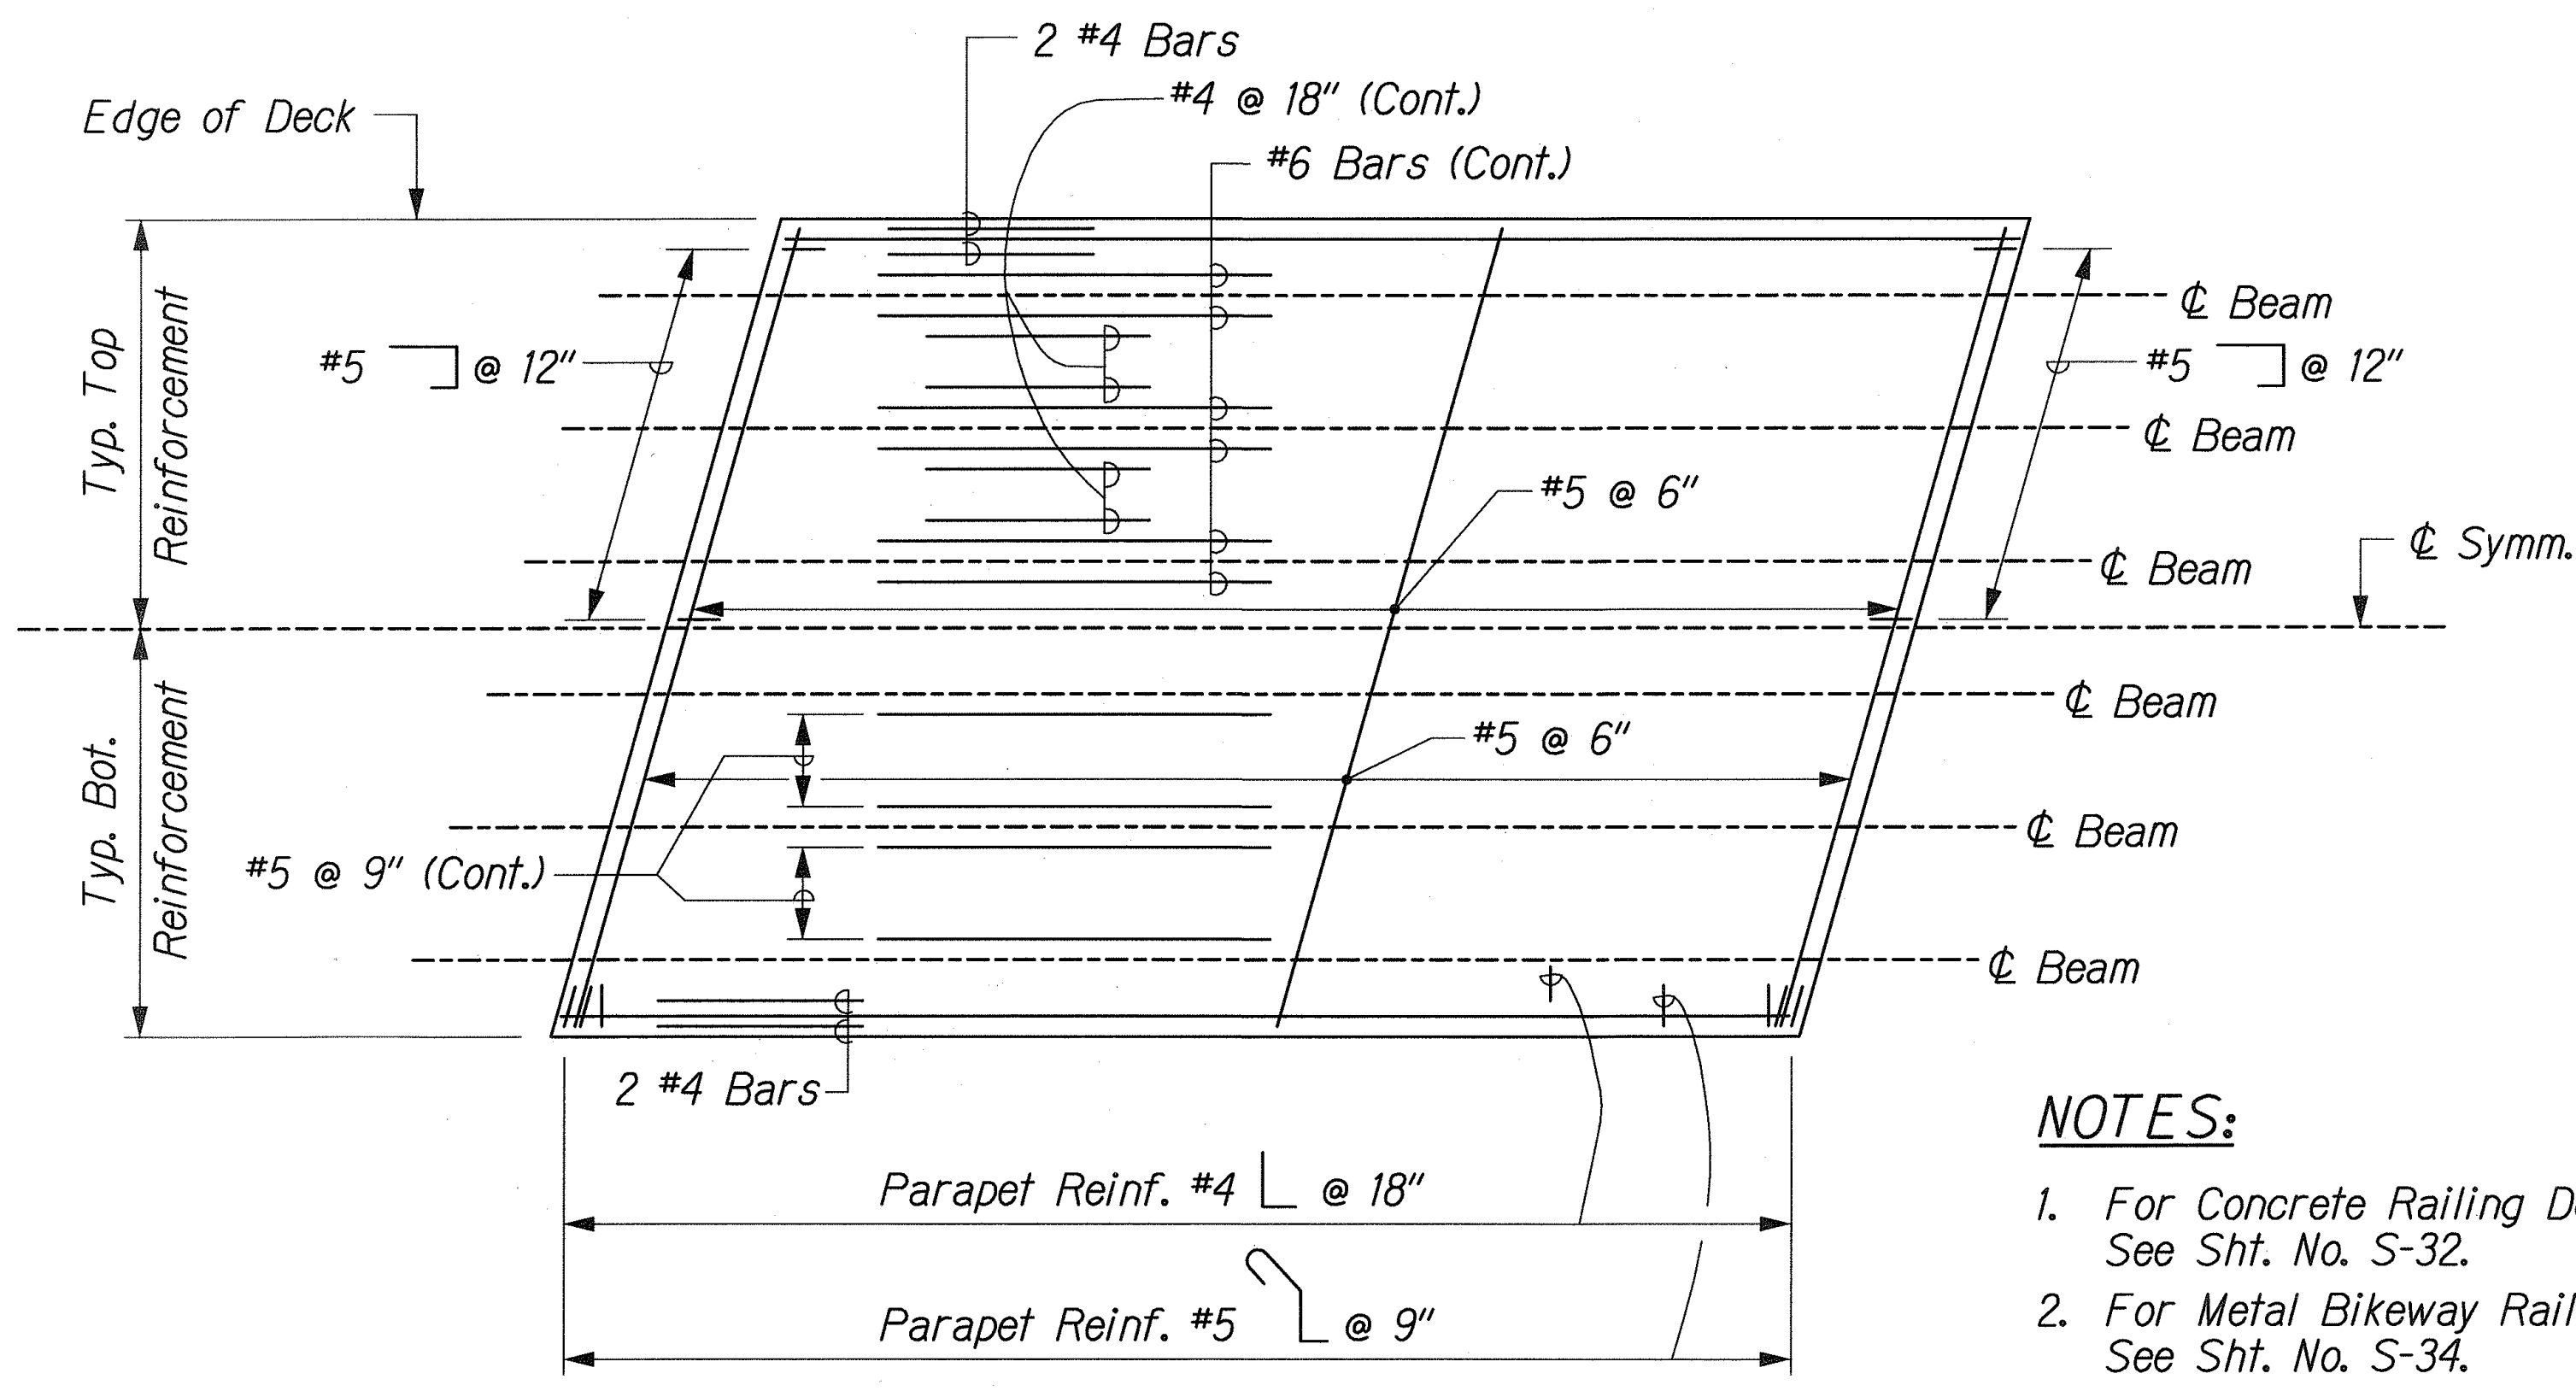

TYPICAL DECK REINF. PLAN
Not to Scale

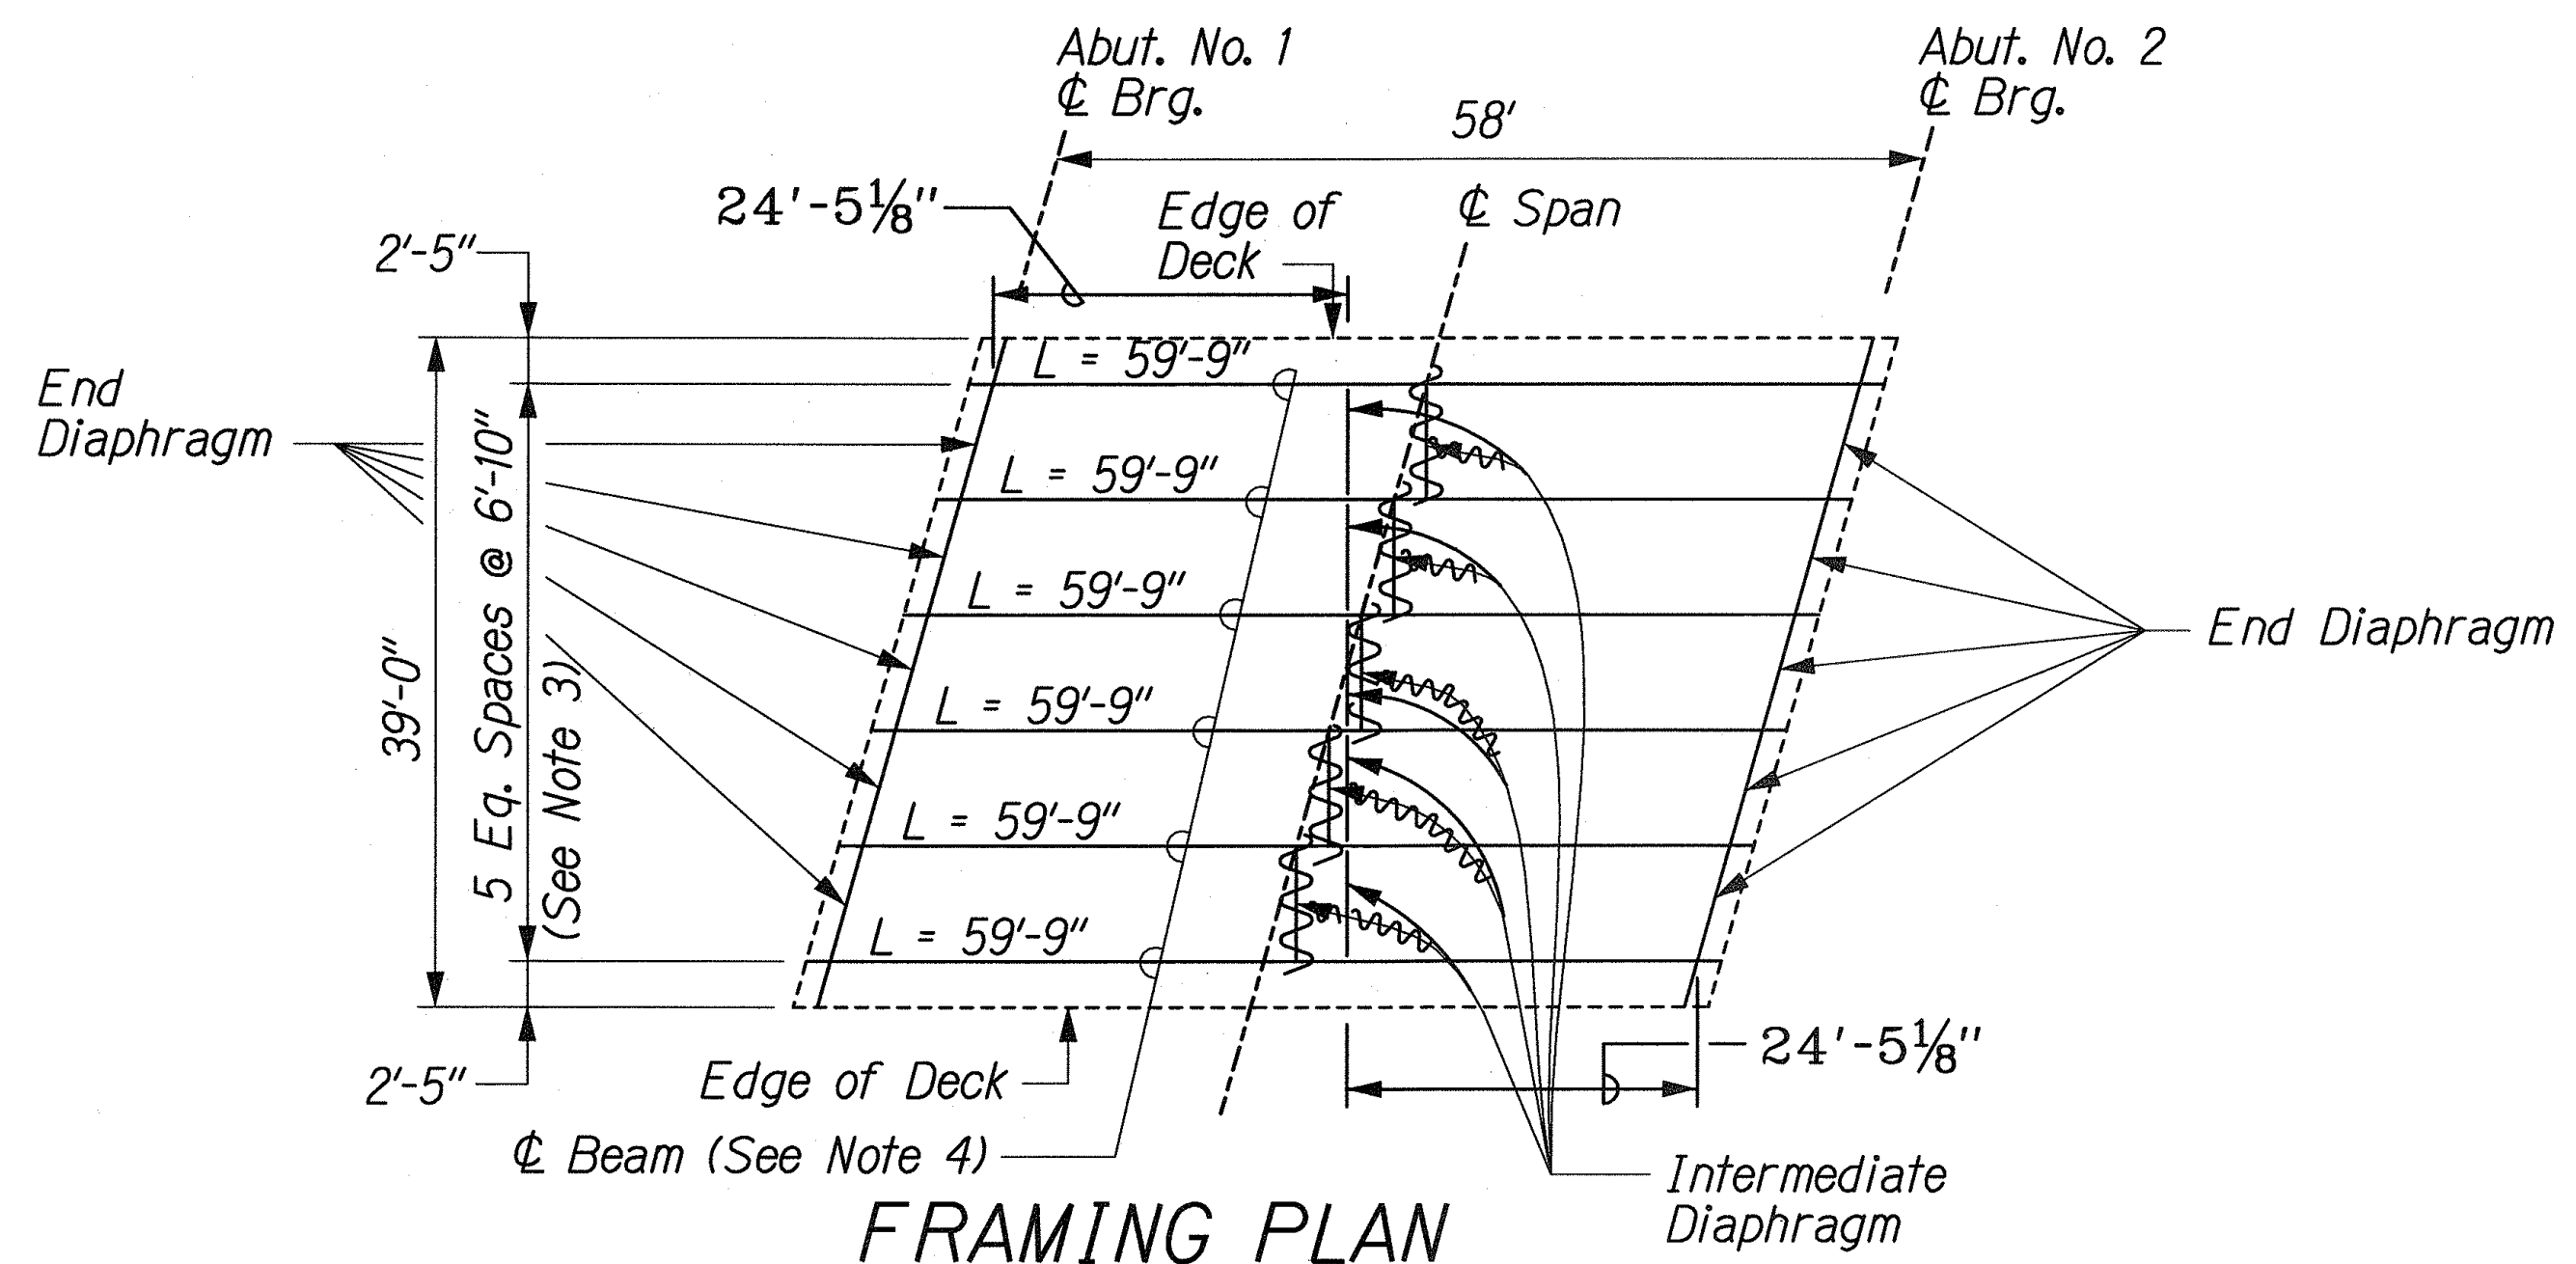

FRAMING PLAN
Not to Scale

- NOTES:
1. For Concrete Railing Detail, See Sht. No. S-32.
 2. For Metal Bikeway Railing Details, See Sht. No. S-34.
 3. For skew dimensions along C. Brg., See Sht. No. S-13 & S-14.
 4. "L" denotes the total length of plank along Level line.



LEGEND FOR
AS-BUILT POSTINGS

	Squiggly line for as-built deletion
	Double line for as-built deletion
	Text for as-built posting

Roadway

THIS WORK WAS PREPARED BY ME OR UNDER MY SUPERVISION.
Rui Pang Chen

STATE OF HAWAII
DEPARTMENT OF TRANSPORTATION
HIGHWAYS DIVISION
WAIKAPU STREAM BRIDGE
DECK REINF. & FRAMING PLAN
KUIHELANI HIGHWAY WIDENING
HONOAPIILANI HIGHWAY TO PUUNENE AVENUE
FEDERAL-AID PROJECT NO. NH-0380(9)
Scale: As Shown Date: Sept. 14, 2001

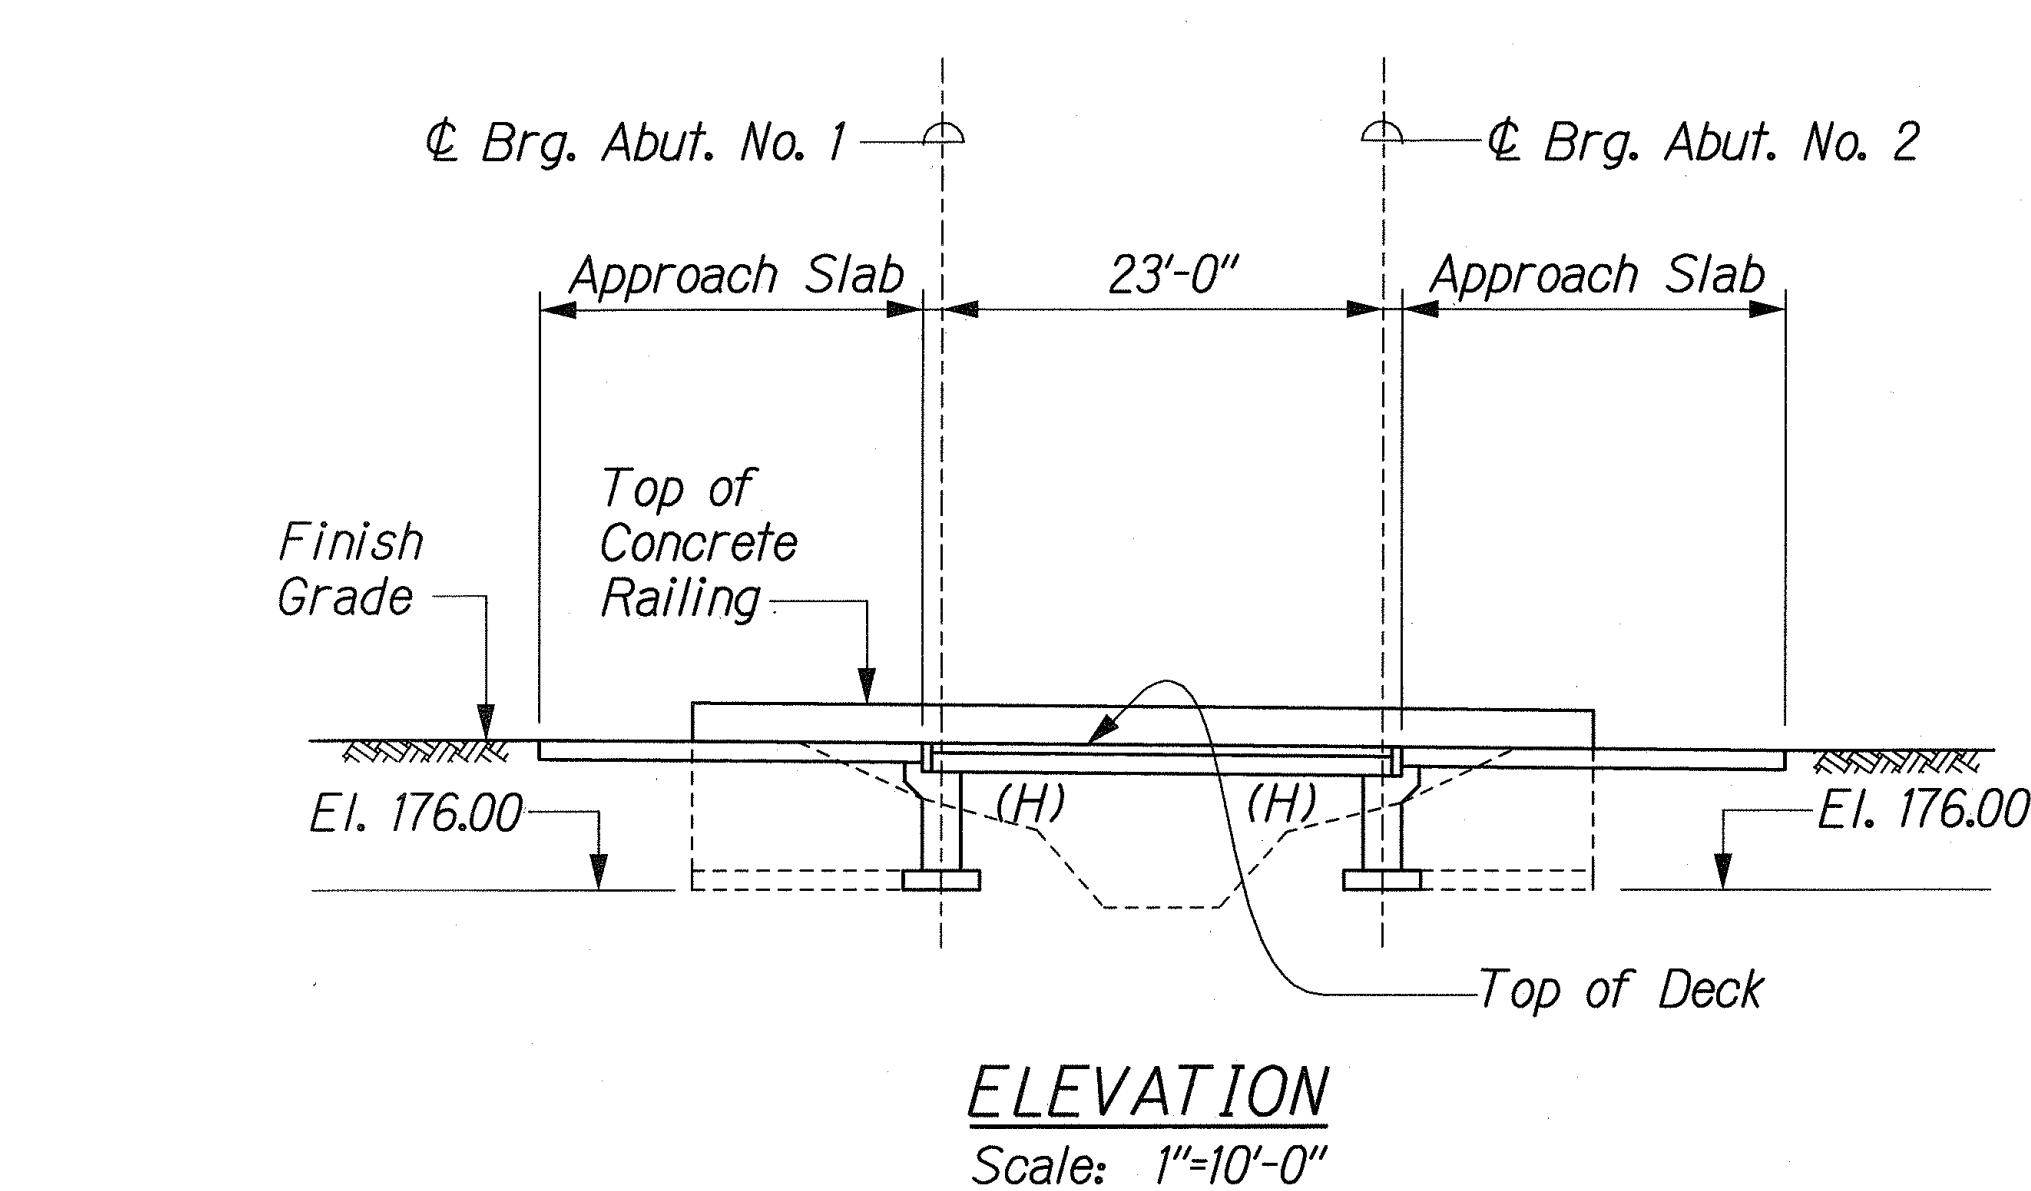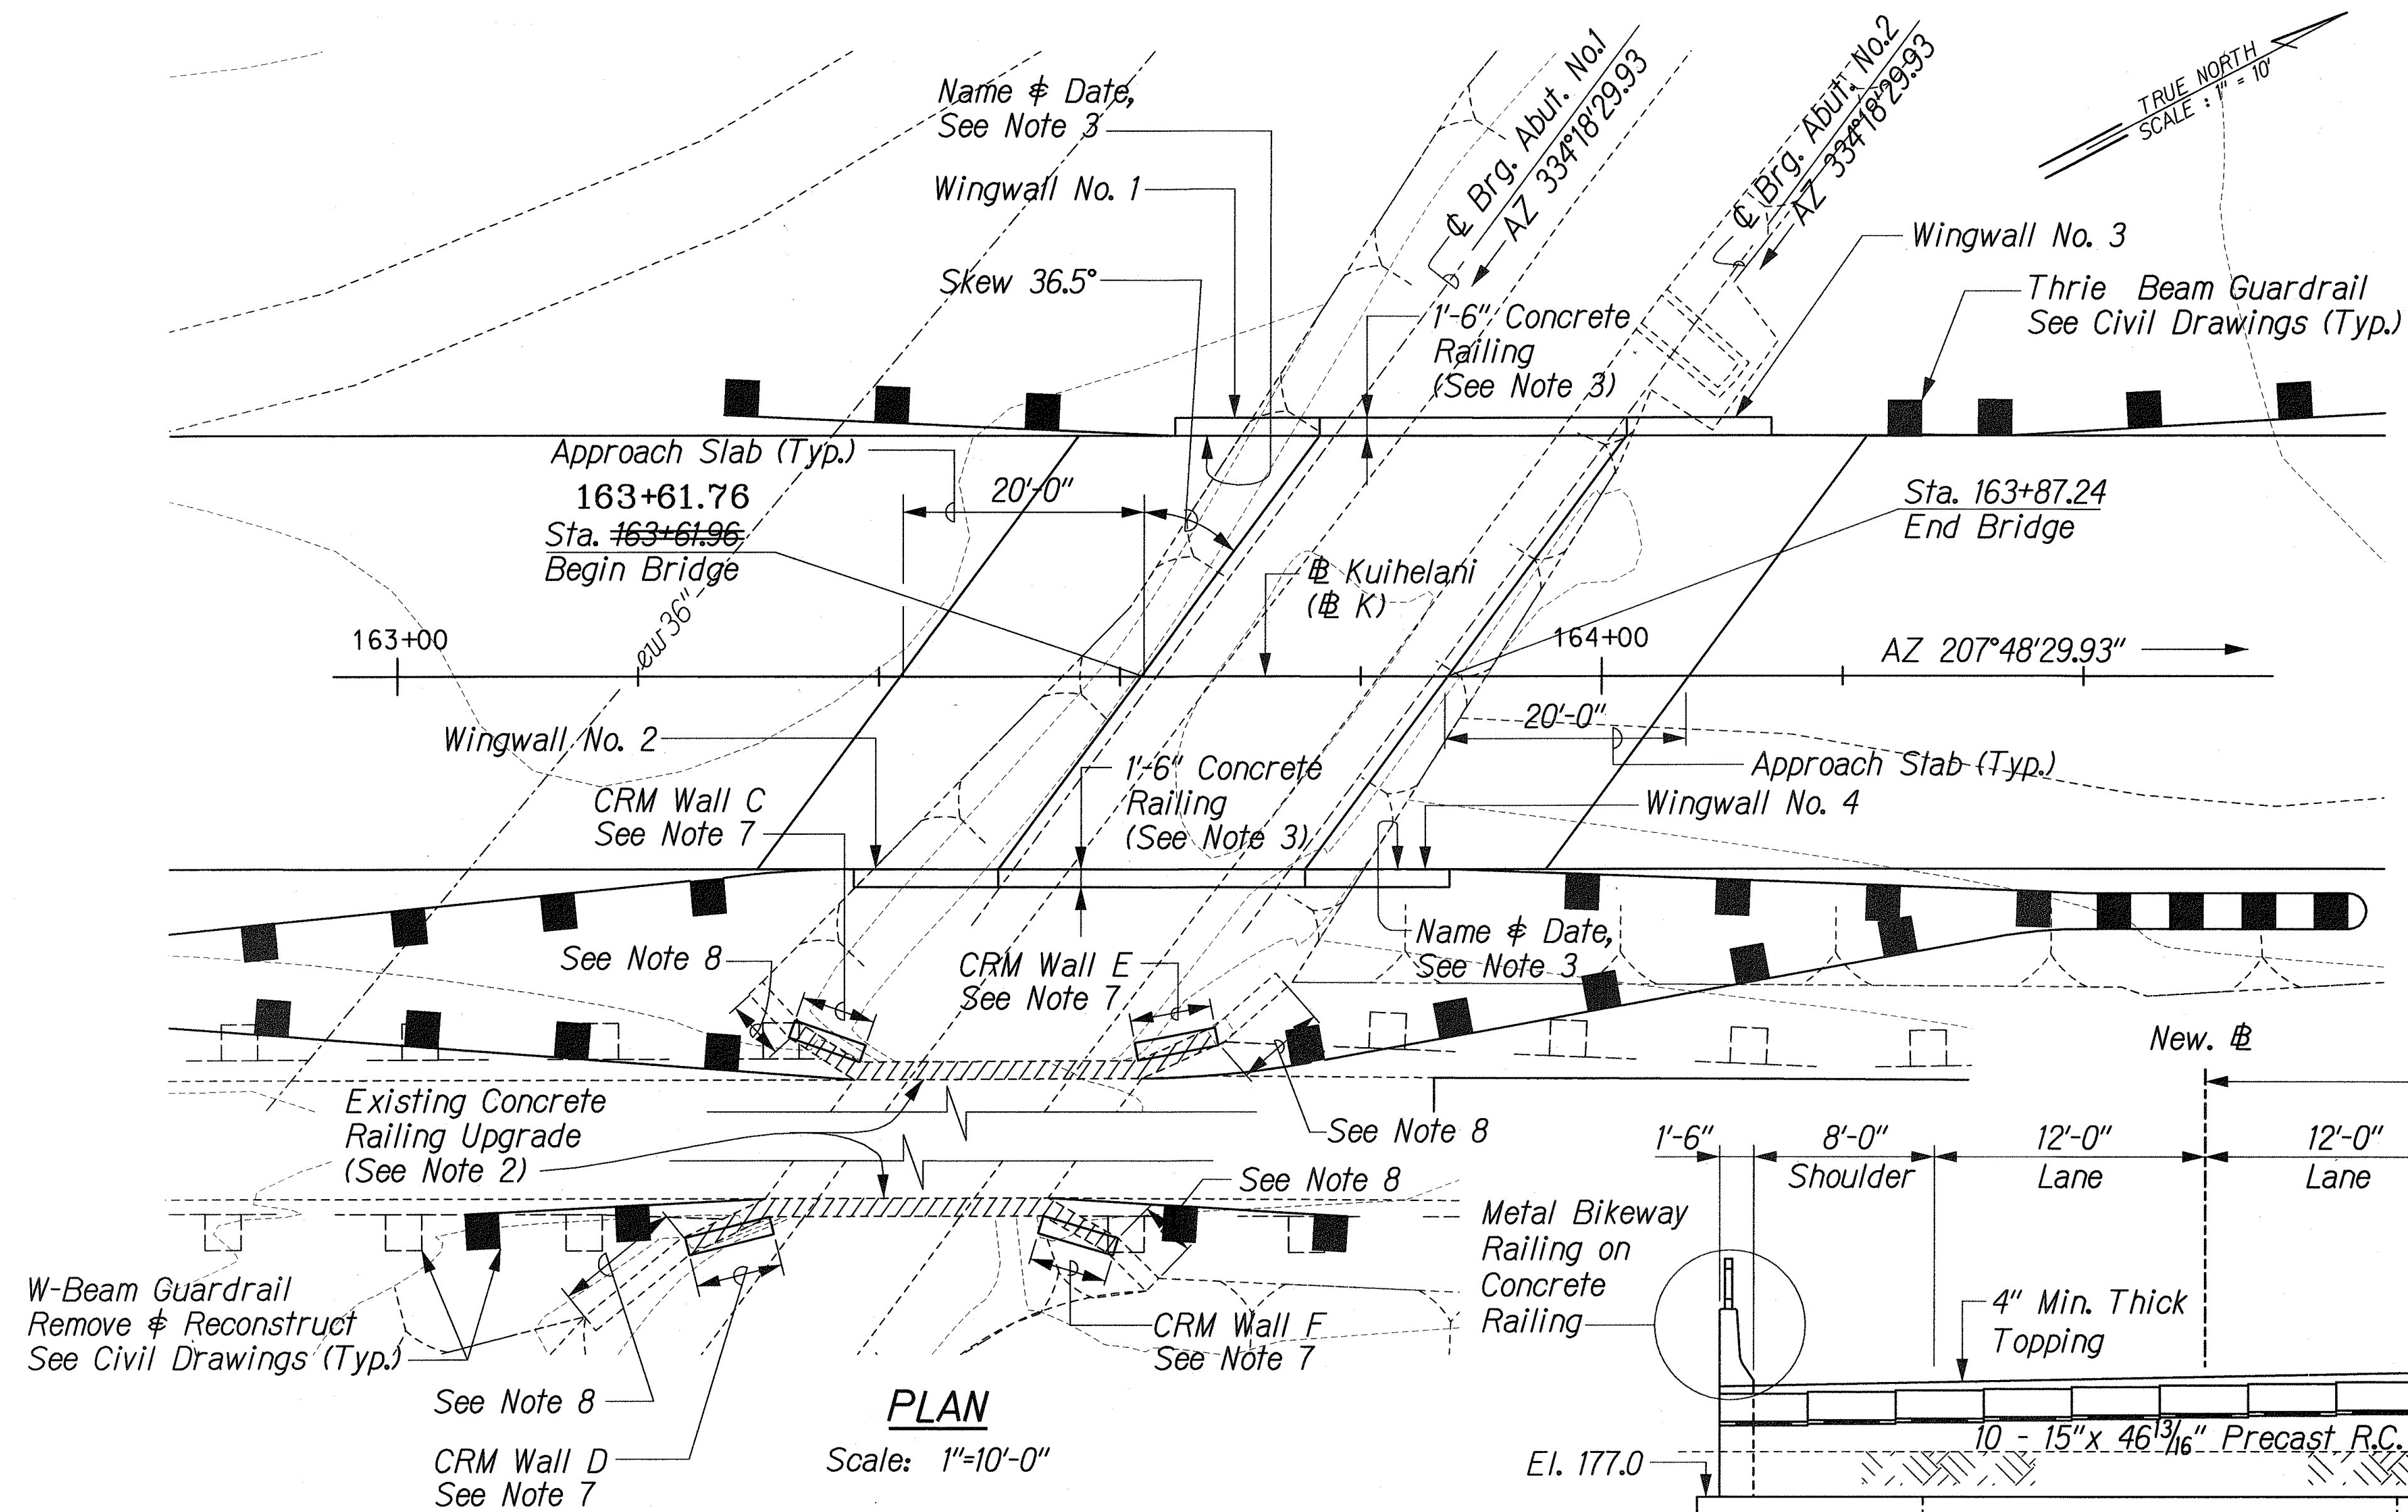


NOTES:


- For General Notes, See Sht. No. S-2.
- For Existing Concrete Railing Upgrade Details, See Sht. No. S-33.
- For Bridge Name & Date location, Concrete Railing Details, See Sht. No. S-32.
- For Approach Slab Details, See Sht. No. S-35.
- For Metal Bikeway Railing Details, See Sht. No. S-34.
- For Payment Limit, See Sht. No. S-30.
- Existing Curved Concrete end post to be removed for upgrade of metal guardrail connection as shown on Sht. No. S-33. Reconstruct CRM Walls behind the restored metal guardrail posts. For Details, See Sht. No. S-37.
- Existing Concrete Walls to remain.

TYPICAL SECTION

Scale: 3/16" = 1'-0"

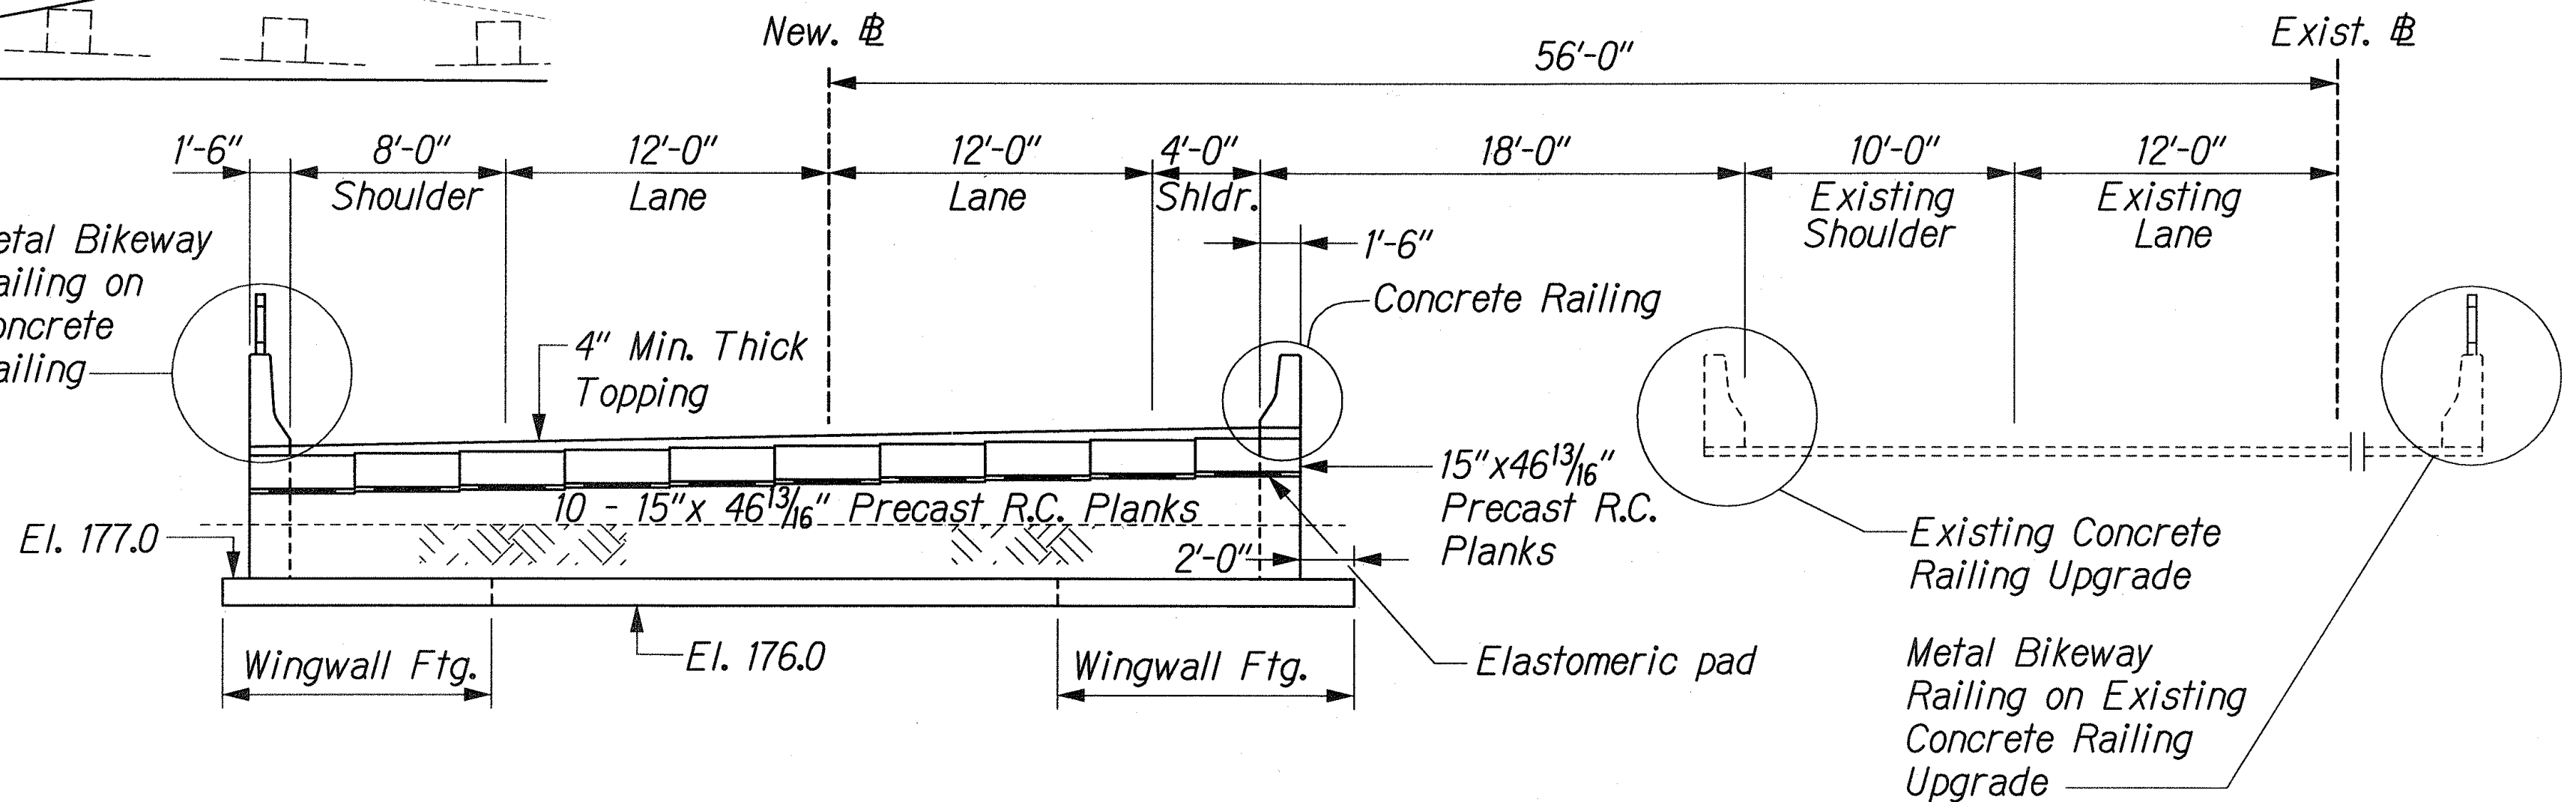


LEGEND FOR AS-BUILT POSTINGS	
	Squiggly line for as-built deletion
	Double line for as-built deletion
	Text for as-built posting

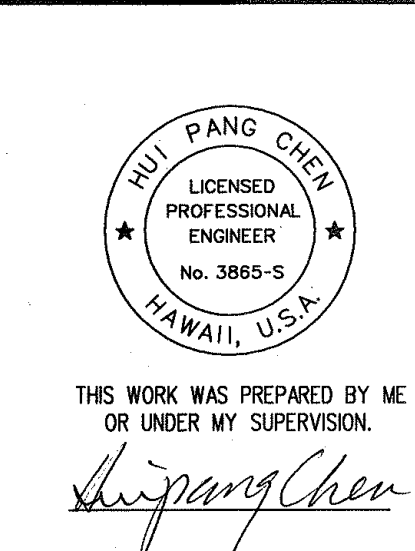

STATE OF HAWAII
DEPARTMENT OF TRANSPORTATION
HIGHWAYS DIVISION
WAIHEE DITCH BRIDGE
PLAN & LONGITUDINAL SECTION
KUIHELANI HIGHWAY WIDENING
HONOAPIILANI HIGHWAY TO PUUNENE AVENUE
FEDERAL-AID PROJECT NO. NH-0380(9)
Scale: As Shown Date: Sept. 14, 2001


THIS WORK WAS PREPARED BY ME OR UNDER MY SUPERVISION.
Hui Pang Chen
PROFESSIONAL ENGINEER
No. 3885-S
HAWAII, U.S.A.

FED. ROAD DIST. NO.	STATE	FED. AID PROJ. NO.	FISCAL YEAR	SHEET NO.	TOTAL SHEETS
HAWAII	HAW.	NH-0380(9)	2000	183	380

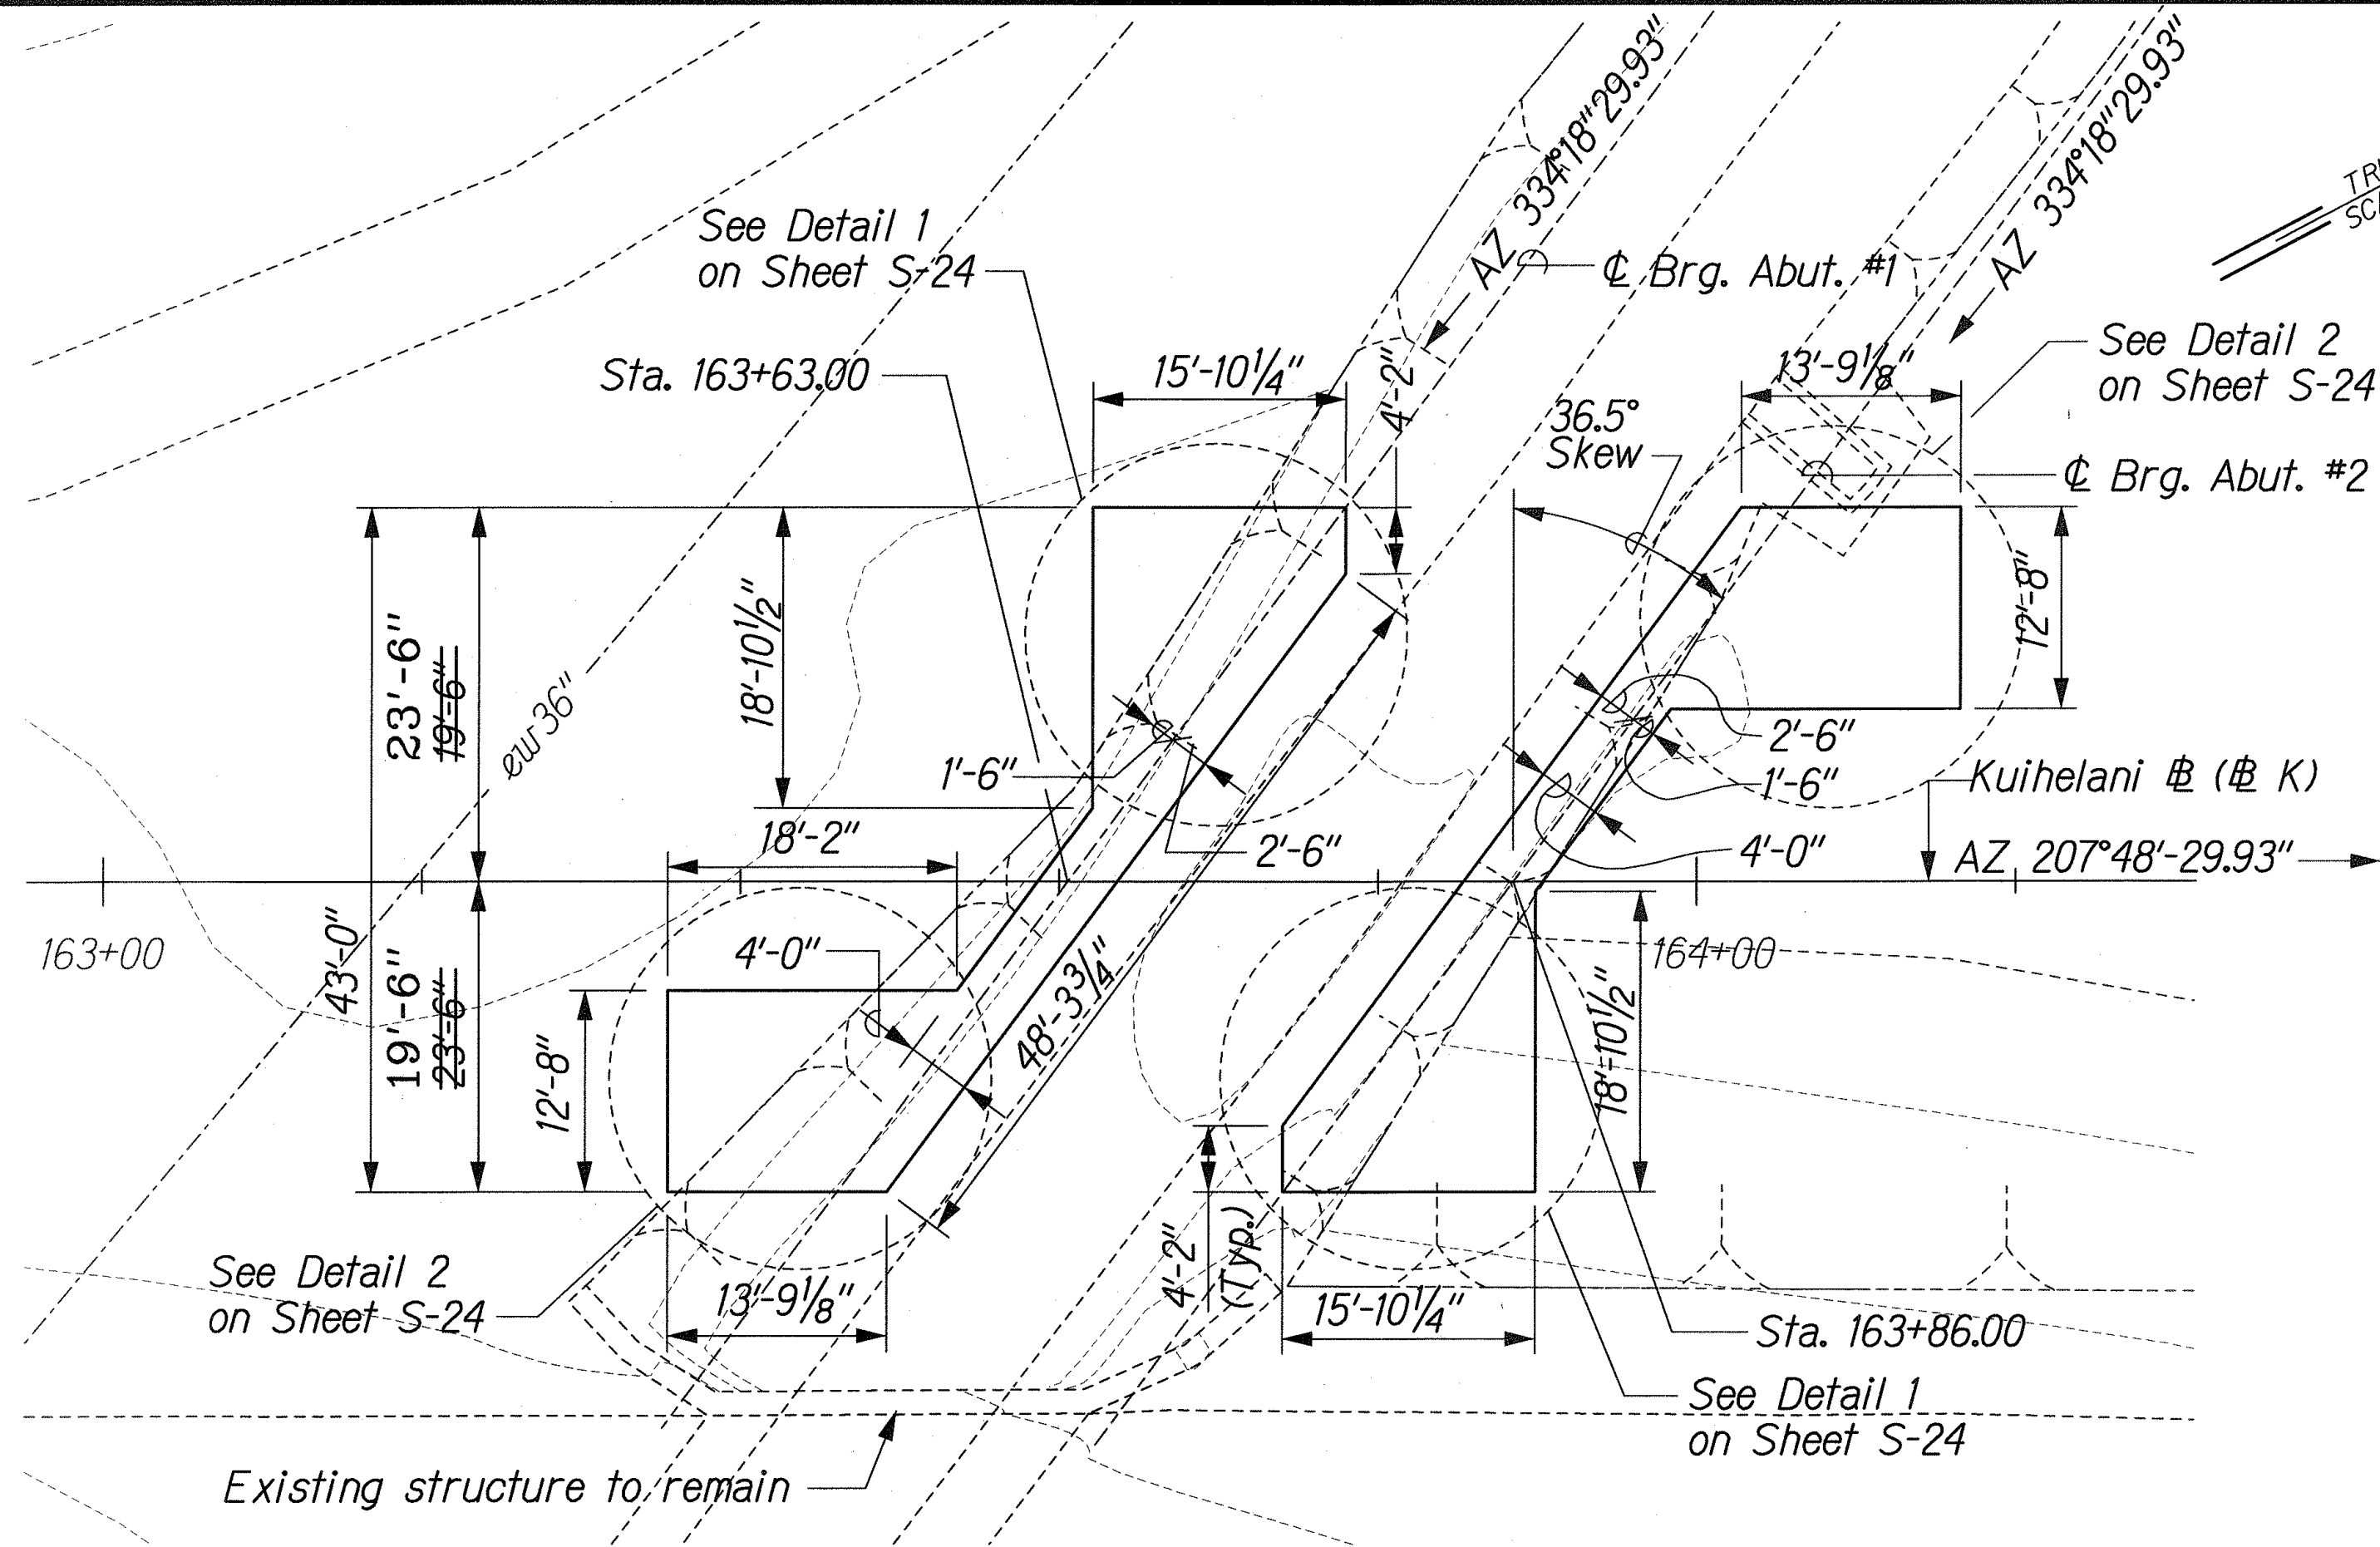


FOUNDATION PLAN

Scale: 1"=10'

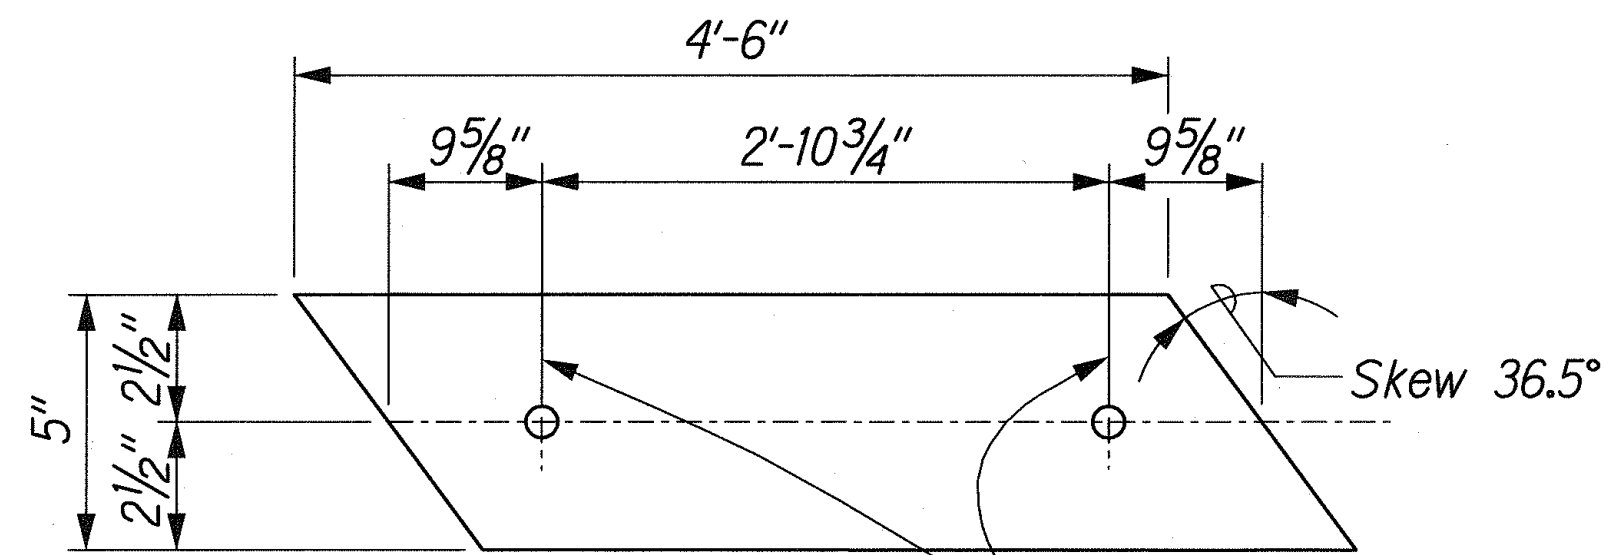


PLAN

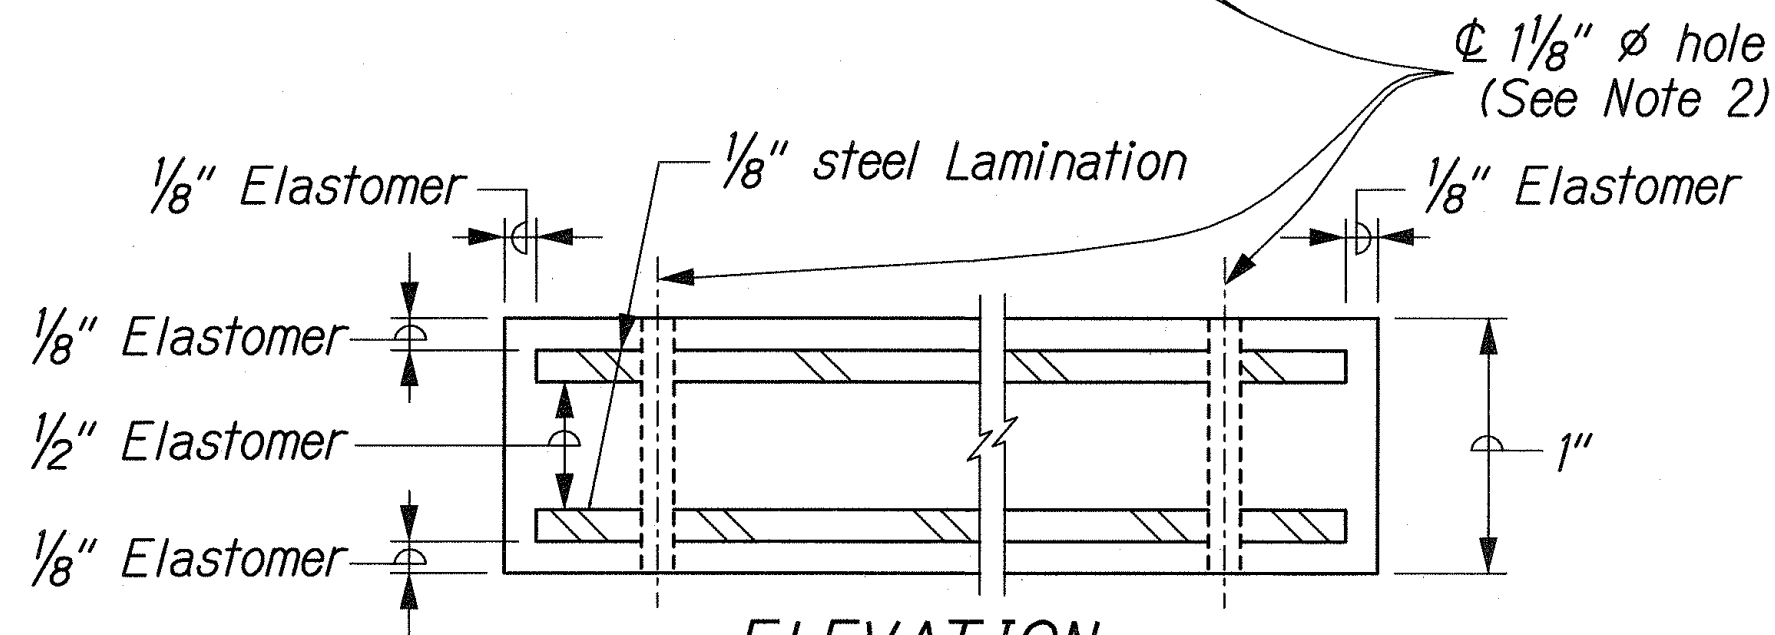

ELEVATION

ELASTOMERIC PAD DETAIL

Not to Scale

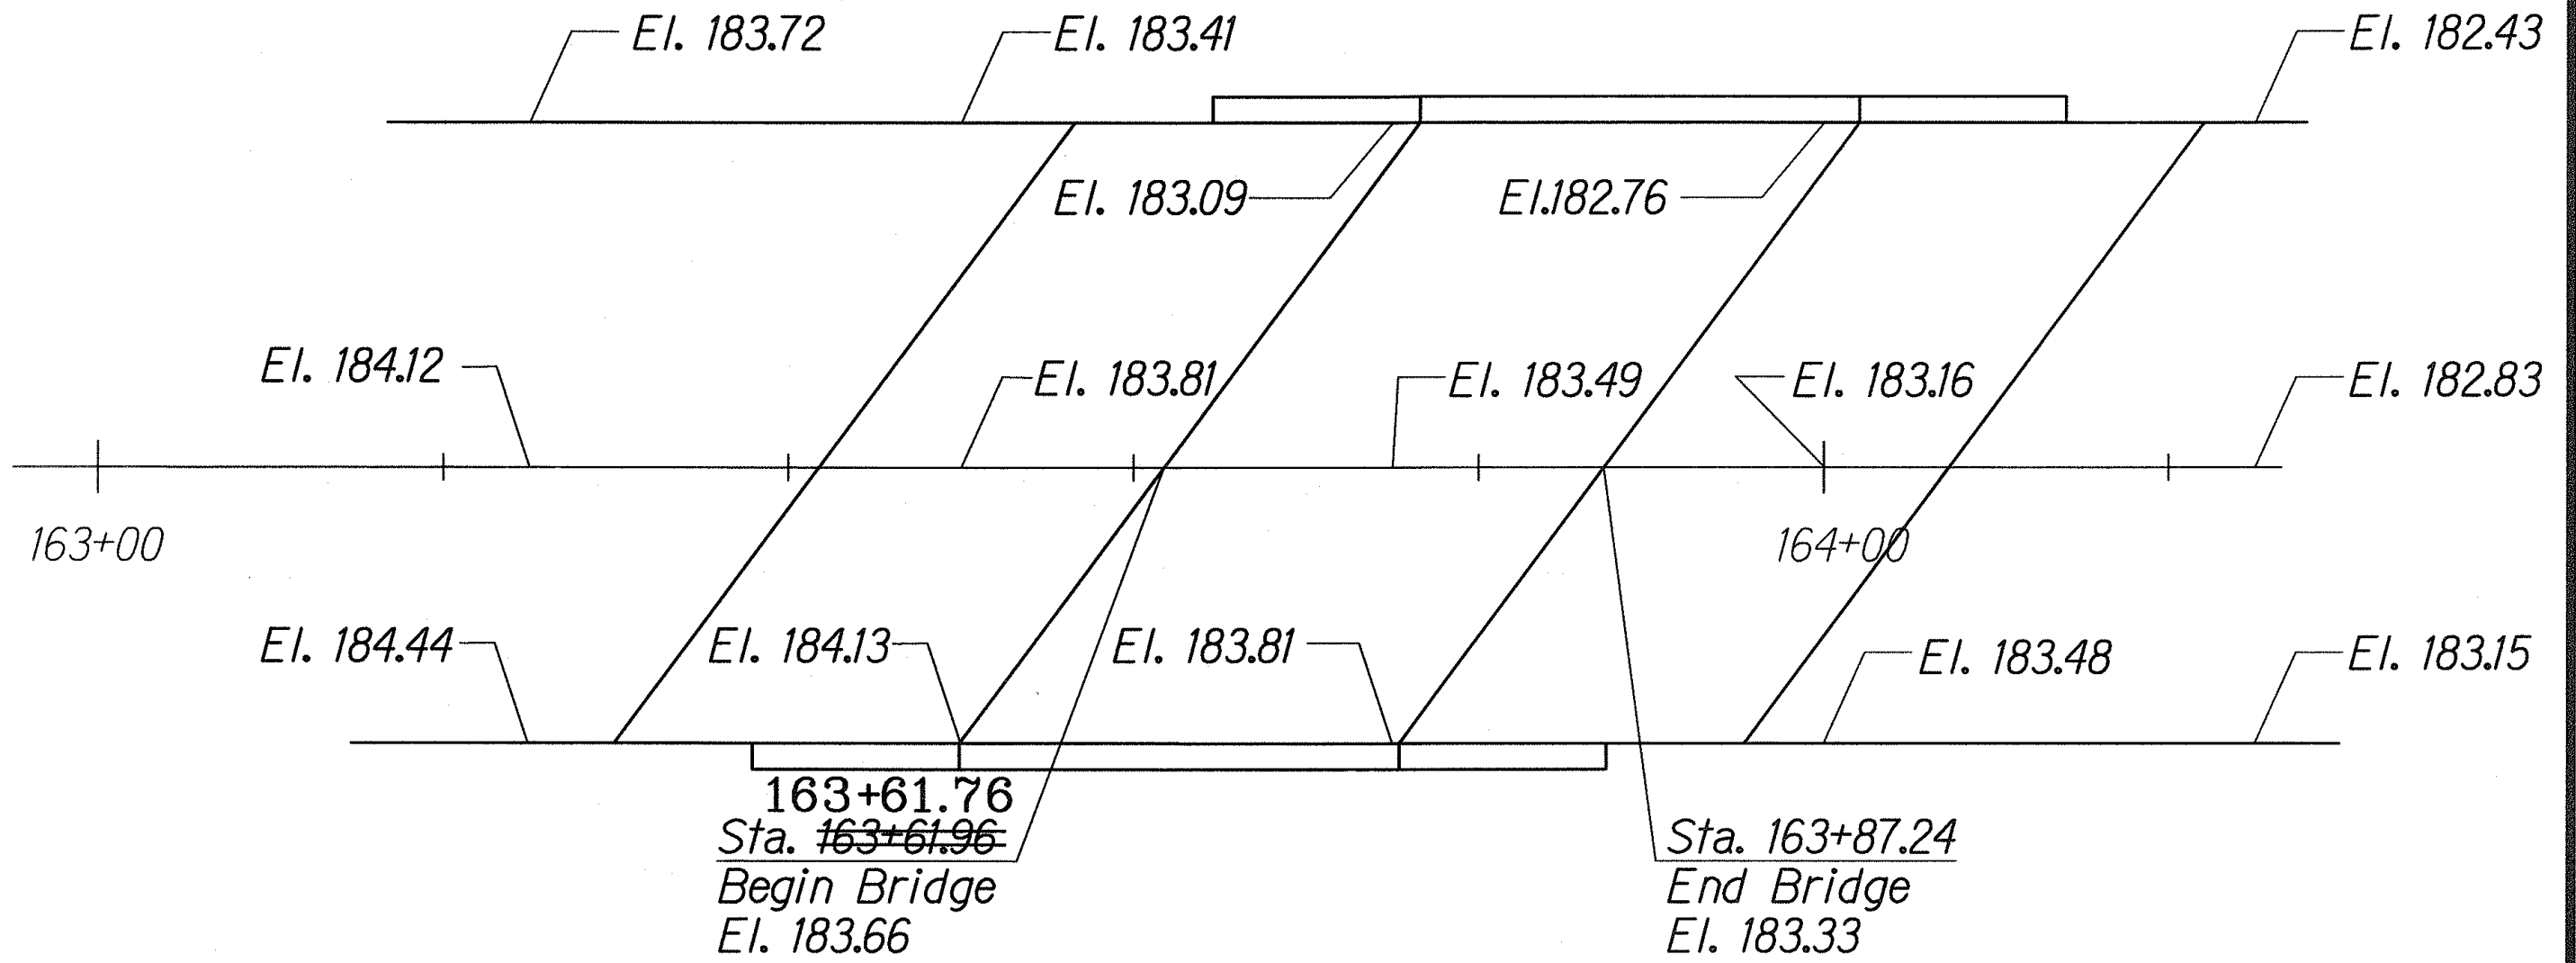

FINISH SPOT ELEVATION PLAN (@ 25'-0" INTERVALS)

Scale: 1"=10'

NOTE:


- For additional footing reinforcing information, see Typical Abutment and Wingwall Section on Sheet S-24.
- After the elastomeric pads are in place, the Contractor shall fill the annular space between the dowel and the elastomeric pad with styrofoam or other acceptable material to prevent grout from flowing into the hole prior to installation of planks.
- For locations of Elastomeric Pads, See Sht. Nos. S-22, S-23 and S-24.

LEGEND FOR AS-BUILT POSTINGS	
	Squiggly line for as-built deletion
	Double line for as-built deletion
Roadway	Text for as-built posting


THIS WORK WAS PREPARED BY ME OR UNDER MY SUPERVISION.
Hui Pang Chen

STATE OF HAWAII
 DEPARTMENT OF TRANSPORTATION
 HIGHWAYS DIVISION
WAIHEE DITCH BRIDGE
FOUNDATION PLAN & SPOT ELEV.
 KUIHELANI HIGHWAY WIDENING
 HONOAPIILANI HIGHWAY TO PUUNENE AVENUE
 FEDERAL-AID PROJECT NO. NH-0380(9)
 Scale: As Shown Date: Sept. 14, 2001


FED. ROAD DIST. NO.	STATE	FED. AID PROJ. NO.	FISCAL YEAR	SHEET NO.	TOTAL SHEETS
HAWAII	HAW.	NH-0380(9)	2000	184	380

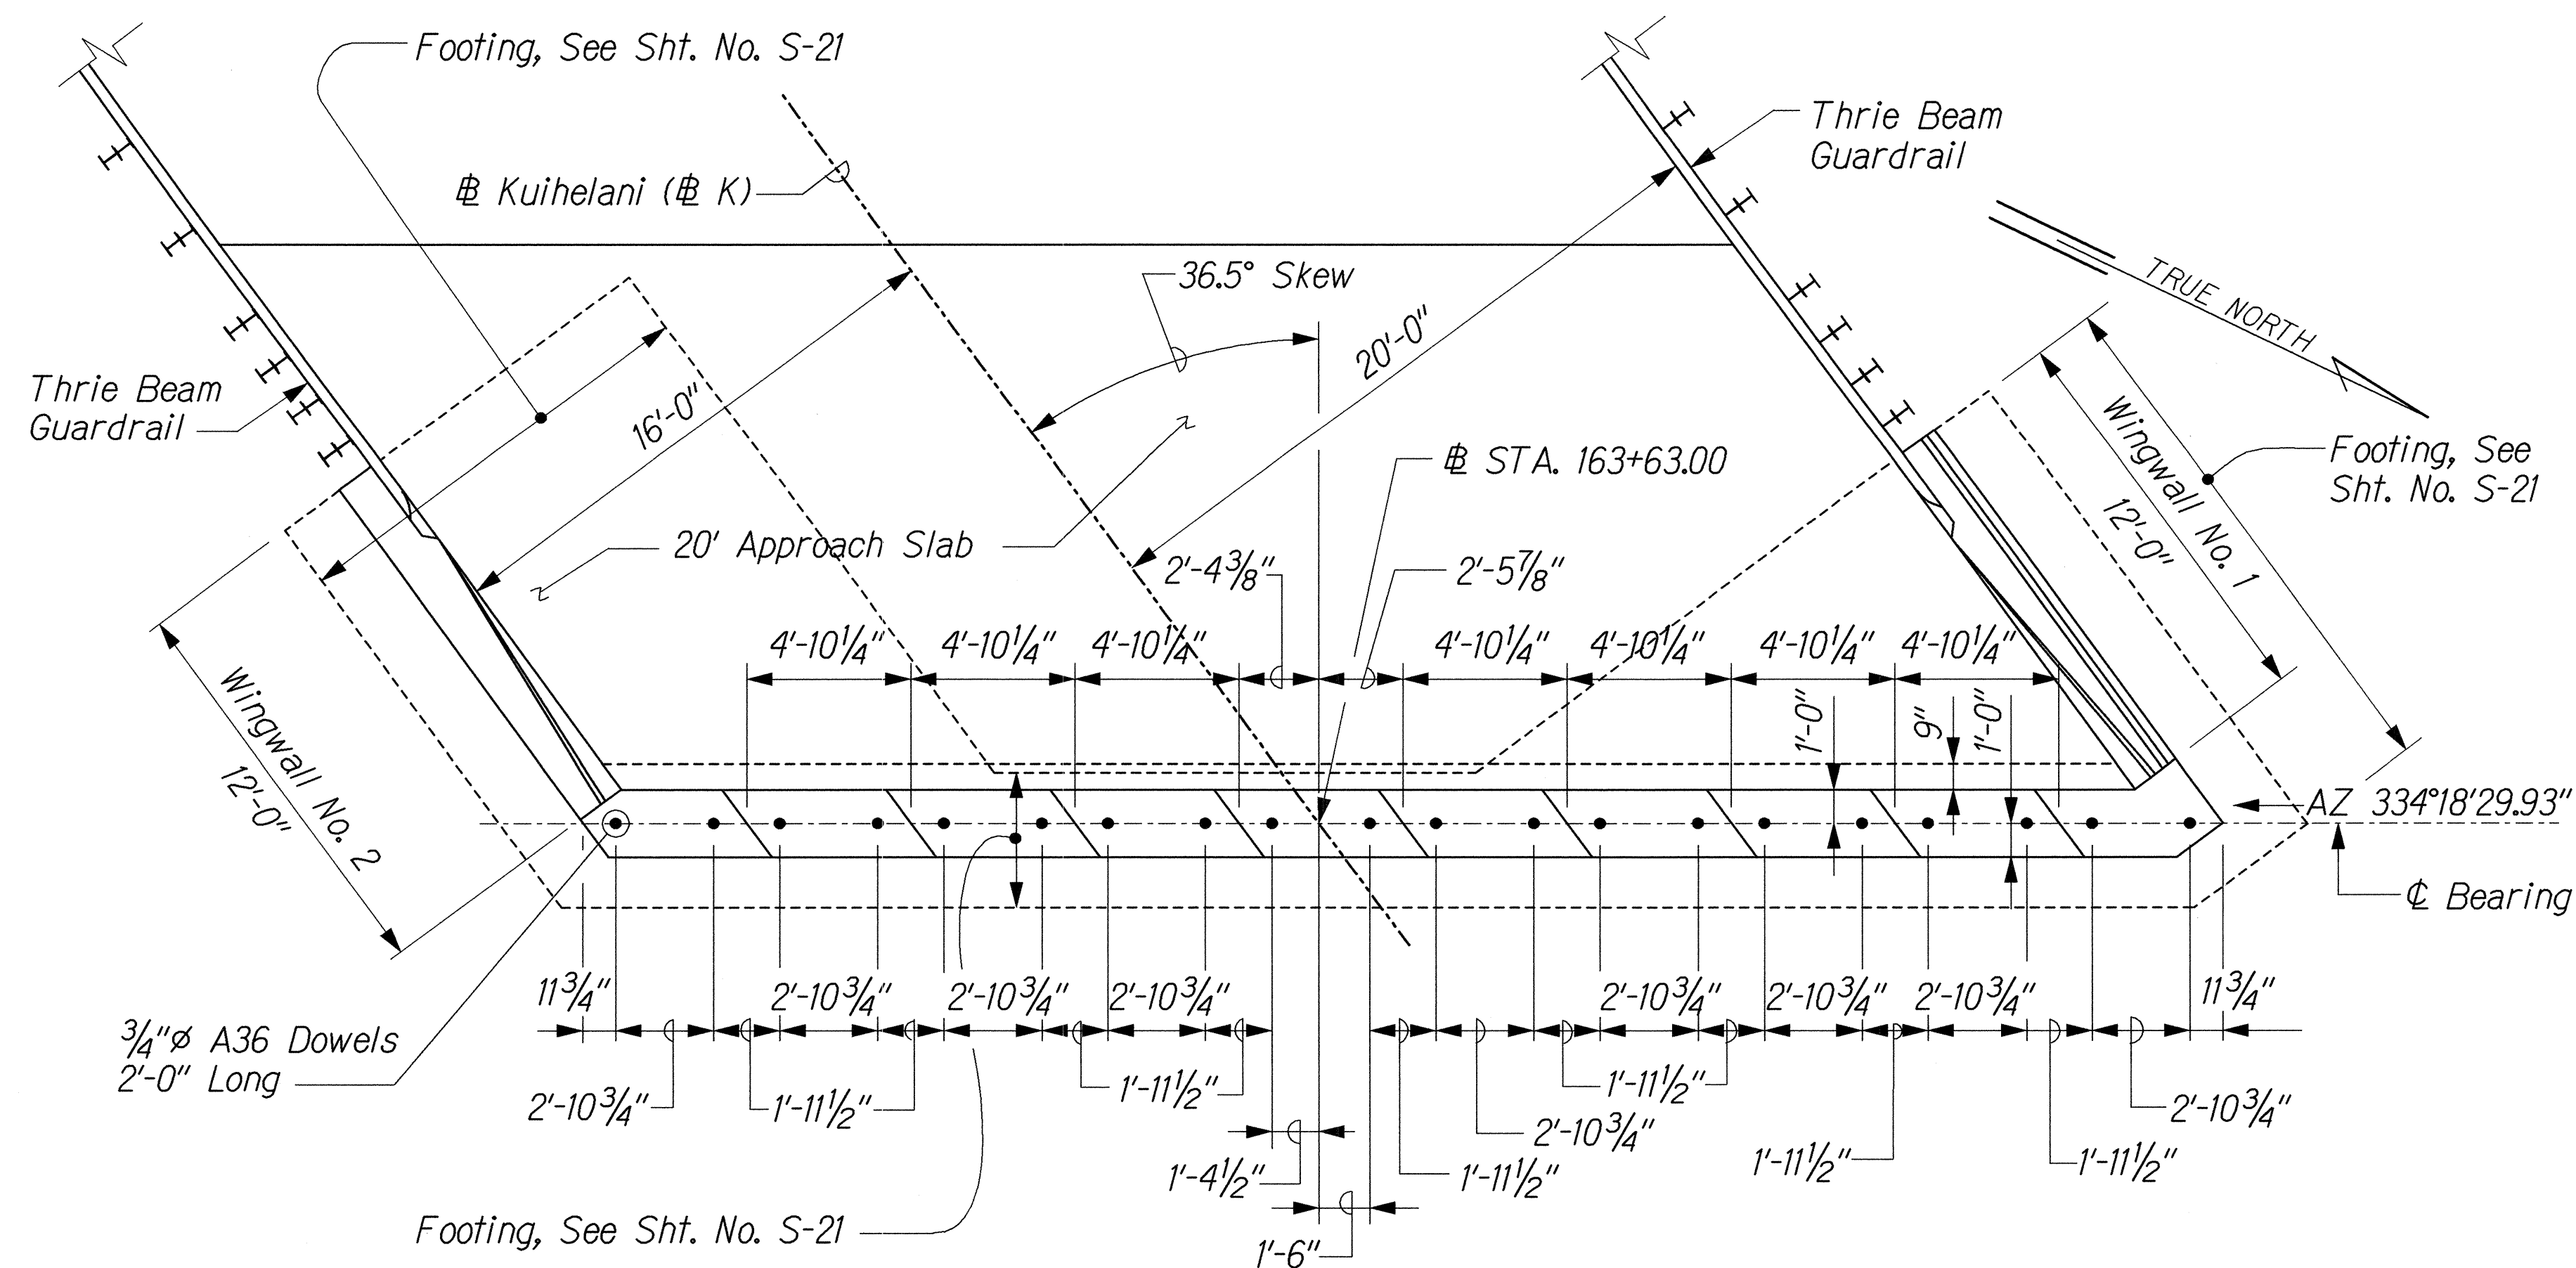


ABUTMENT NO. 1 PLAN
Scale: 1/4" = 1'-0"

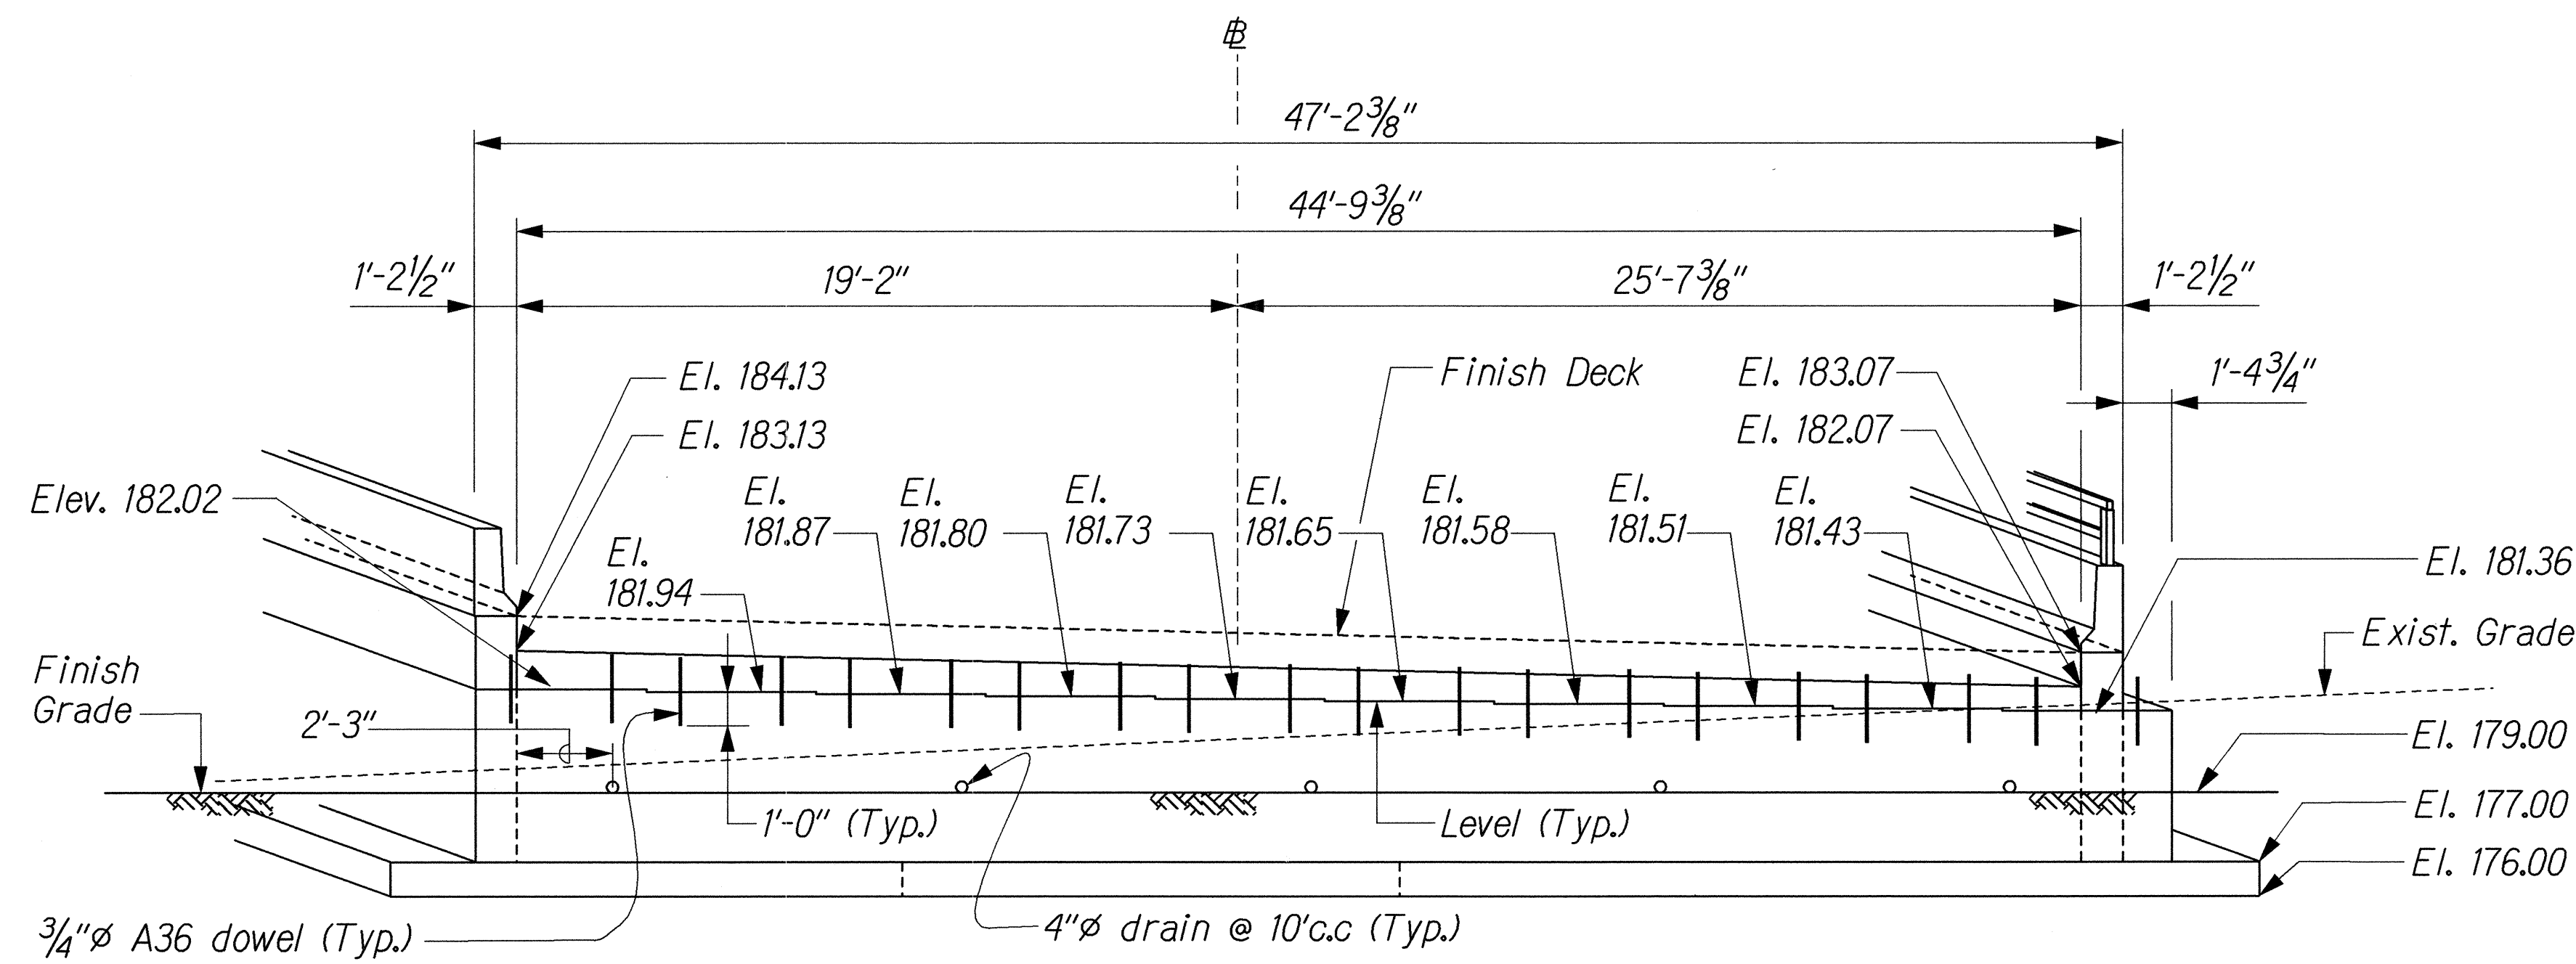

ABUTMENT NO. 1 ELEVATION
Scale: 1/4" = 1'-0"

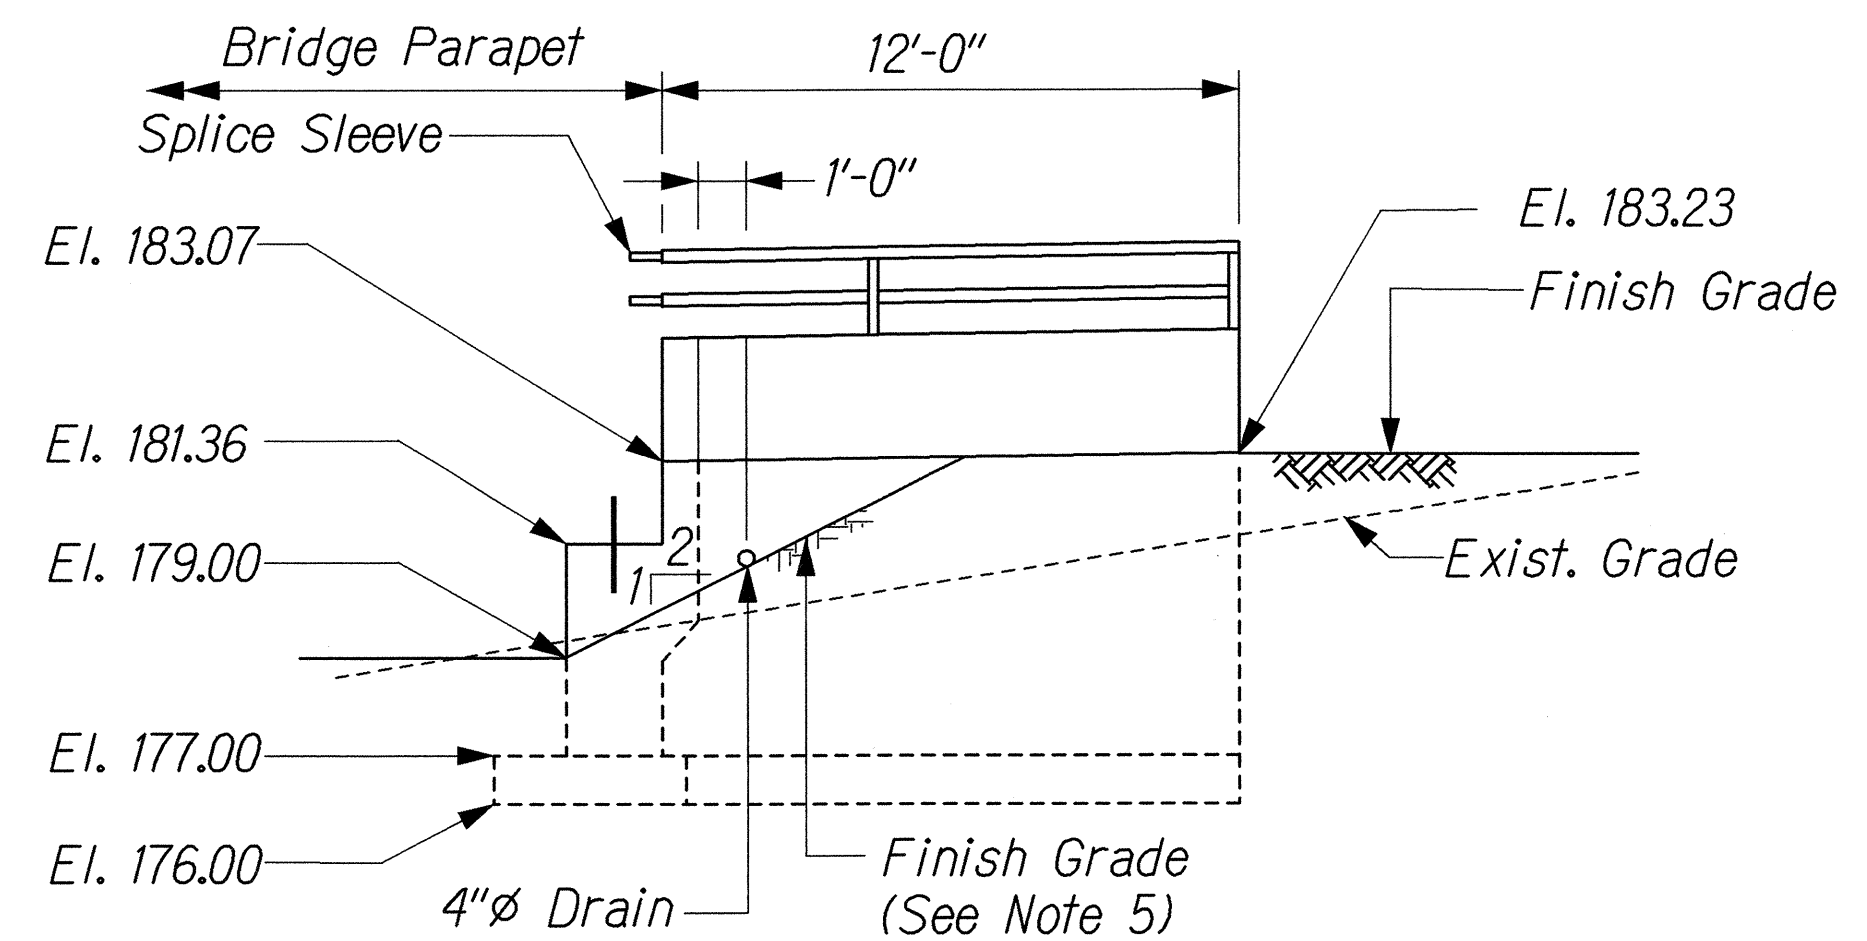

WINGWALL NO. 1 ELEVATION
Scale: 1/4" = 1'-0"

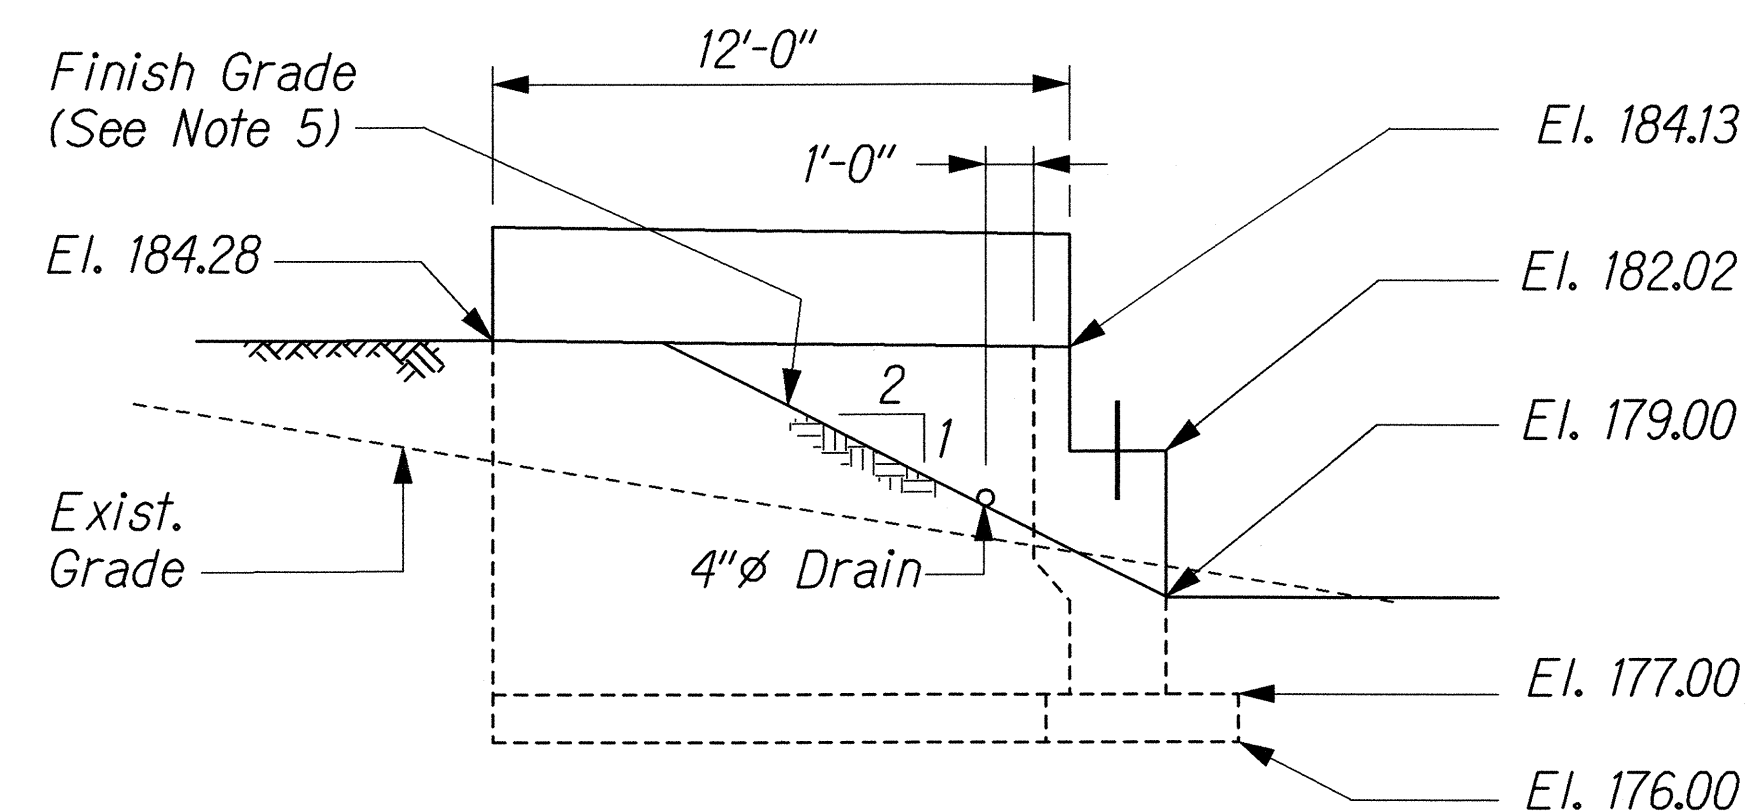

WINGWALL NO. 2 ELEVATION
Scale: 1/4" = 1'-0"

NOTES:

1. For location plan, See Sht. No. S-20.
2. For Approach Slab Details, See Sht. No. S-35.
3. The Contractor shall use rigid template to install the 3/4" A36 dowels to the locations as shown.
4. For 4" PVC Electric Conduit in concrete railing and wall, See Sht. No. S-32.
5. See Note 7(L) on Sht. No. S-2.

ORIGINAL PLAN	SURVEY PLOTTED BY	DATE
NOTE BOOK	DRAWN BY	
	DESIGNED BY	
	CHECKED BY	

J:\KUIHELANI\STRUCT\ST-DET13.dgn

HUI PANG CHEN
LICENSED PROFESSIONAL ENGINEER
No. 3865-S
HAWAII, U.S.A.

THIS WORK WAS PREPARED BY ME OR UNDER MY SUPERVISION.

Hui Pang Chen

STATE OF HAWAII
DEPARTMENT OF TRANSPORTATION
HIGHWAYS DIVISION

WAIHEE STREAM BRIDGE

ABUTMENT SHEET 1 OF 3


KUIHELANI HIGHWAY WIDENING

HONOAPIILANI HIGHWAY TO PUUNENE AVENUE

FEDERAL-AID PROJECT NO. NH-0380(9)


Scale: 1/4" = 1'-0" Date: Sept. 14, 2001

FED. ROAD DIST. NO.	STATE	FED. AID PROJ. NO.	FISCAL YEAR	SHEET NO.	TOTAL SHEETS
HAWAII	HAW.	NH-0380(9)	2000	185	380

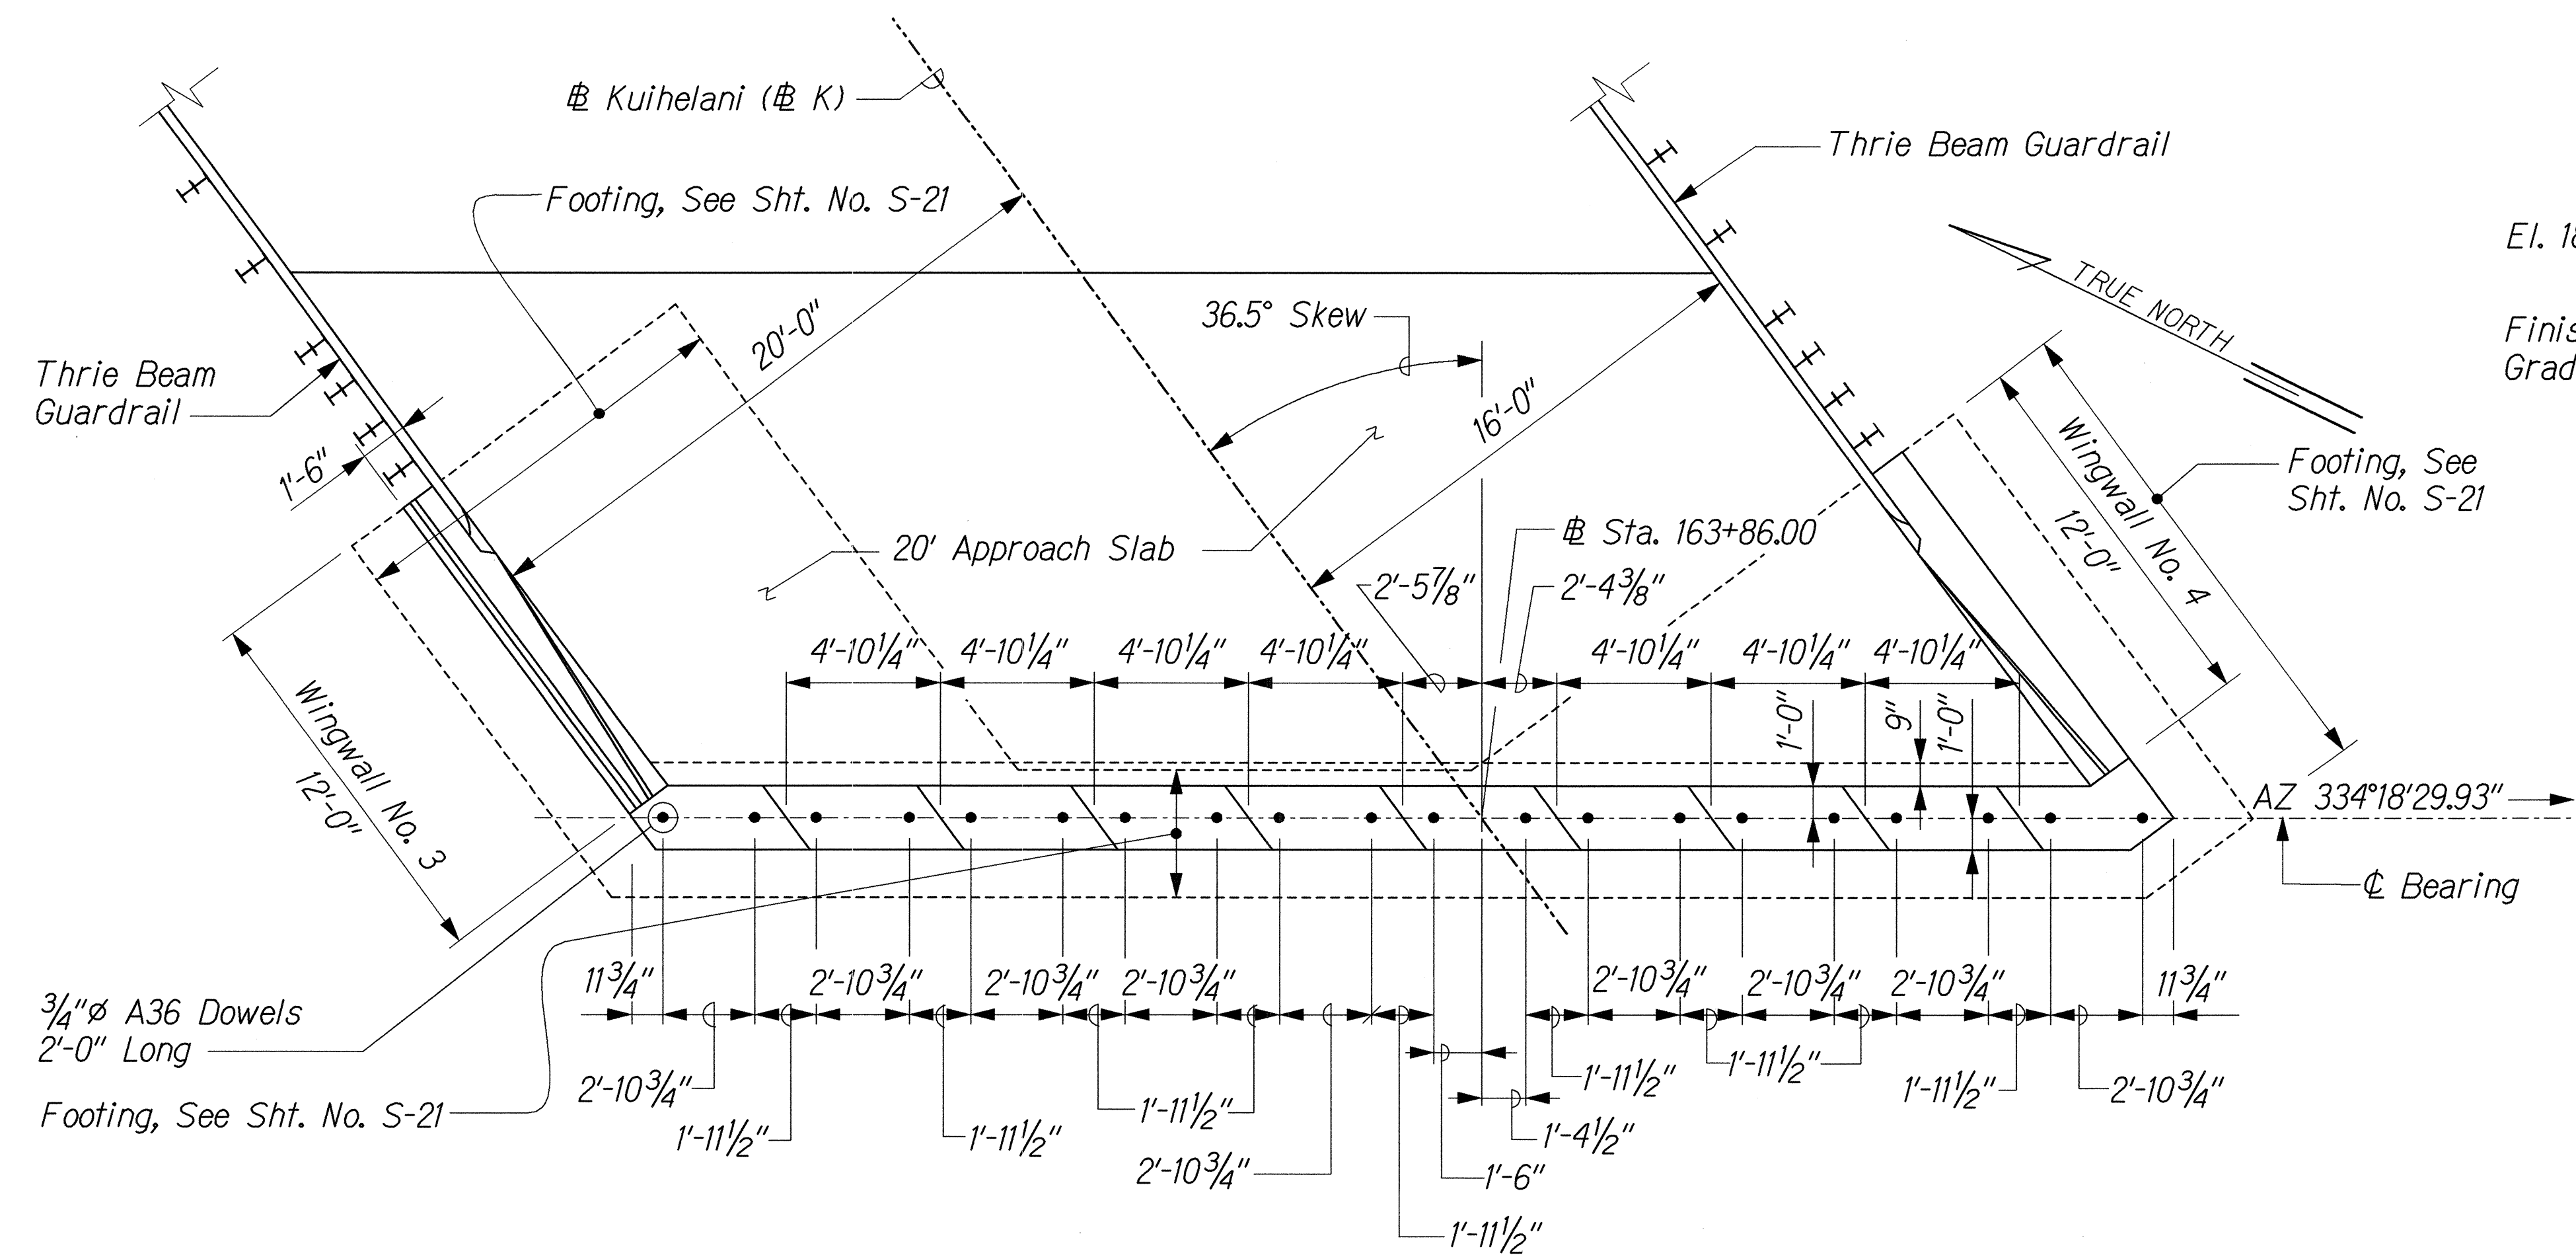


ABUTMENT NO. 2 PLAN

Scale: 1/4" = 1'-0"

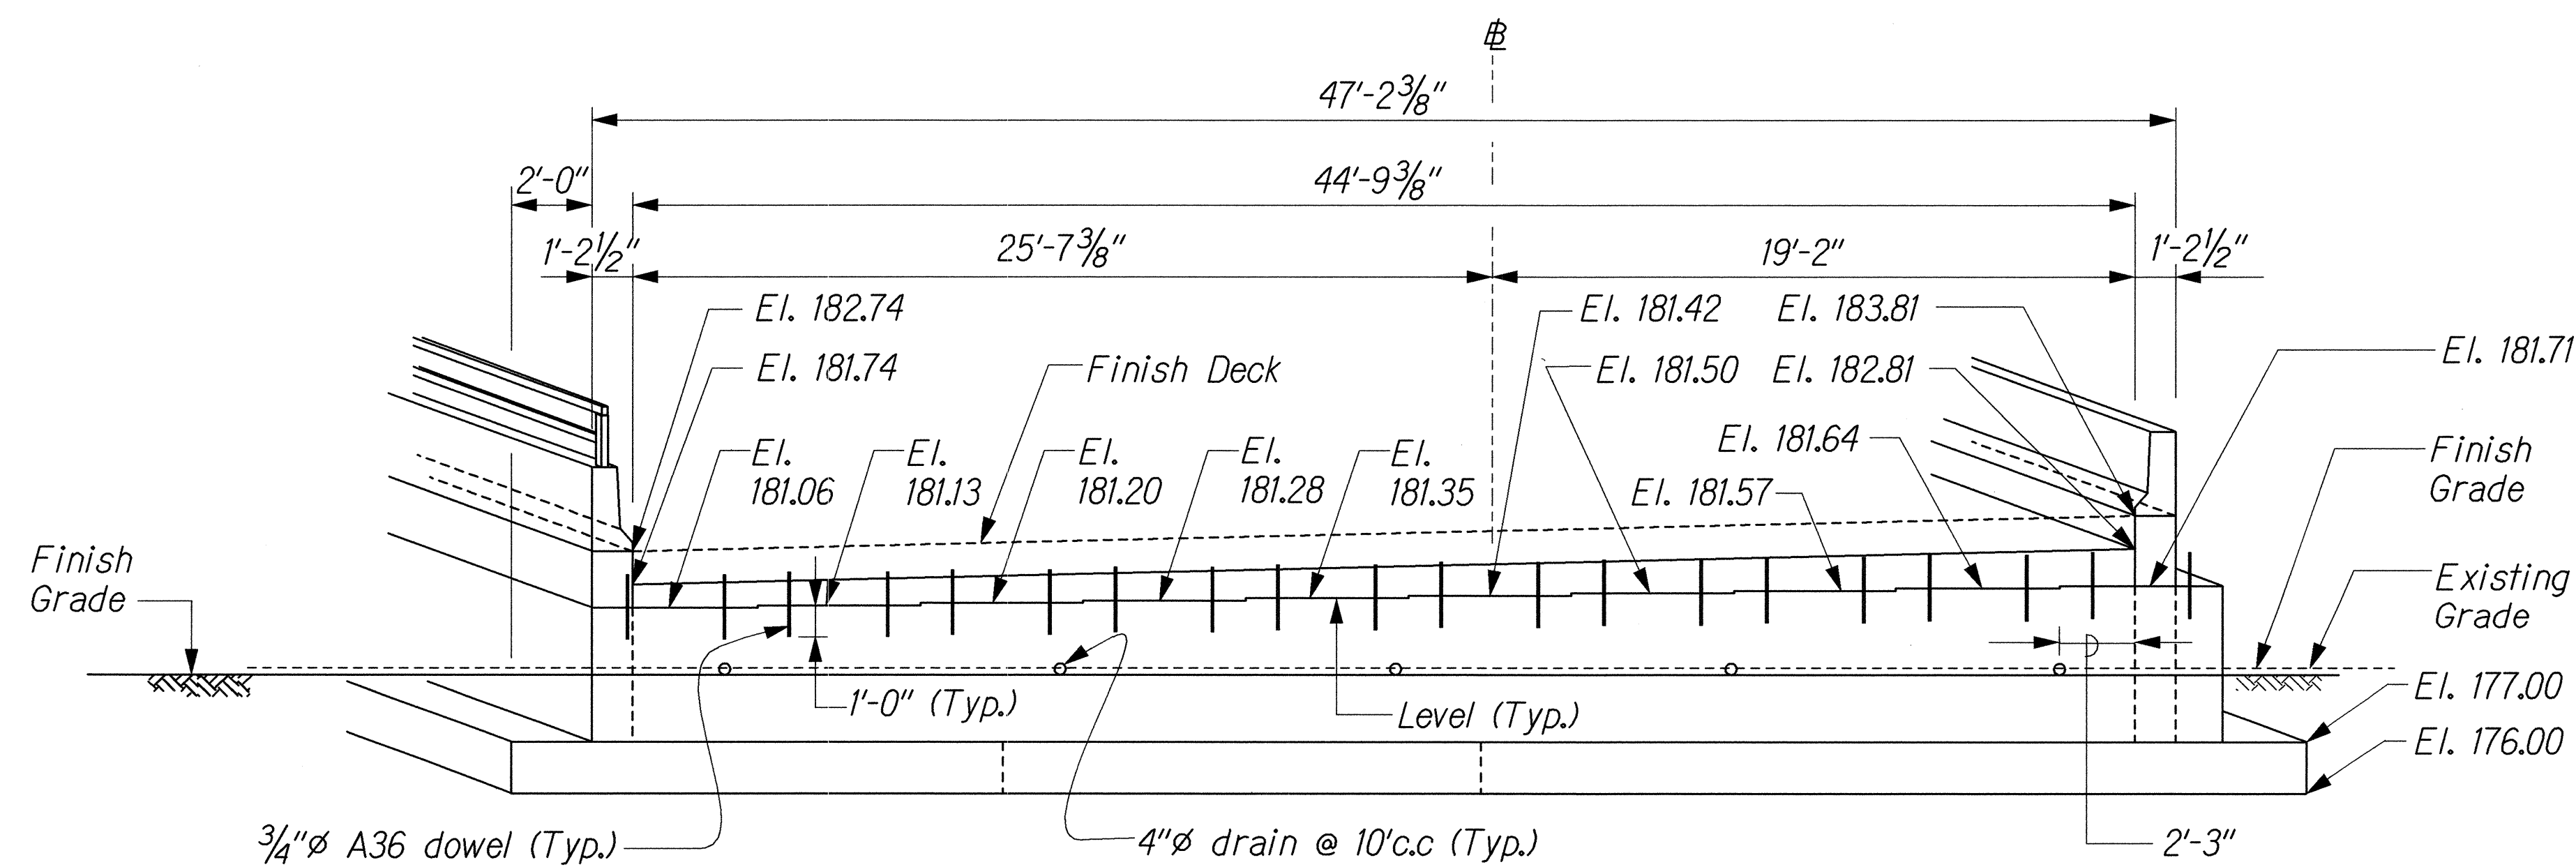


ABUTMENT NO. 2 ELEVATION

Scale: 1/4" = 1'-0"

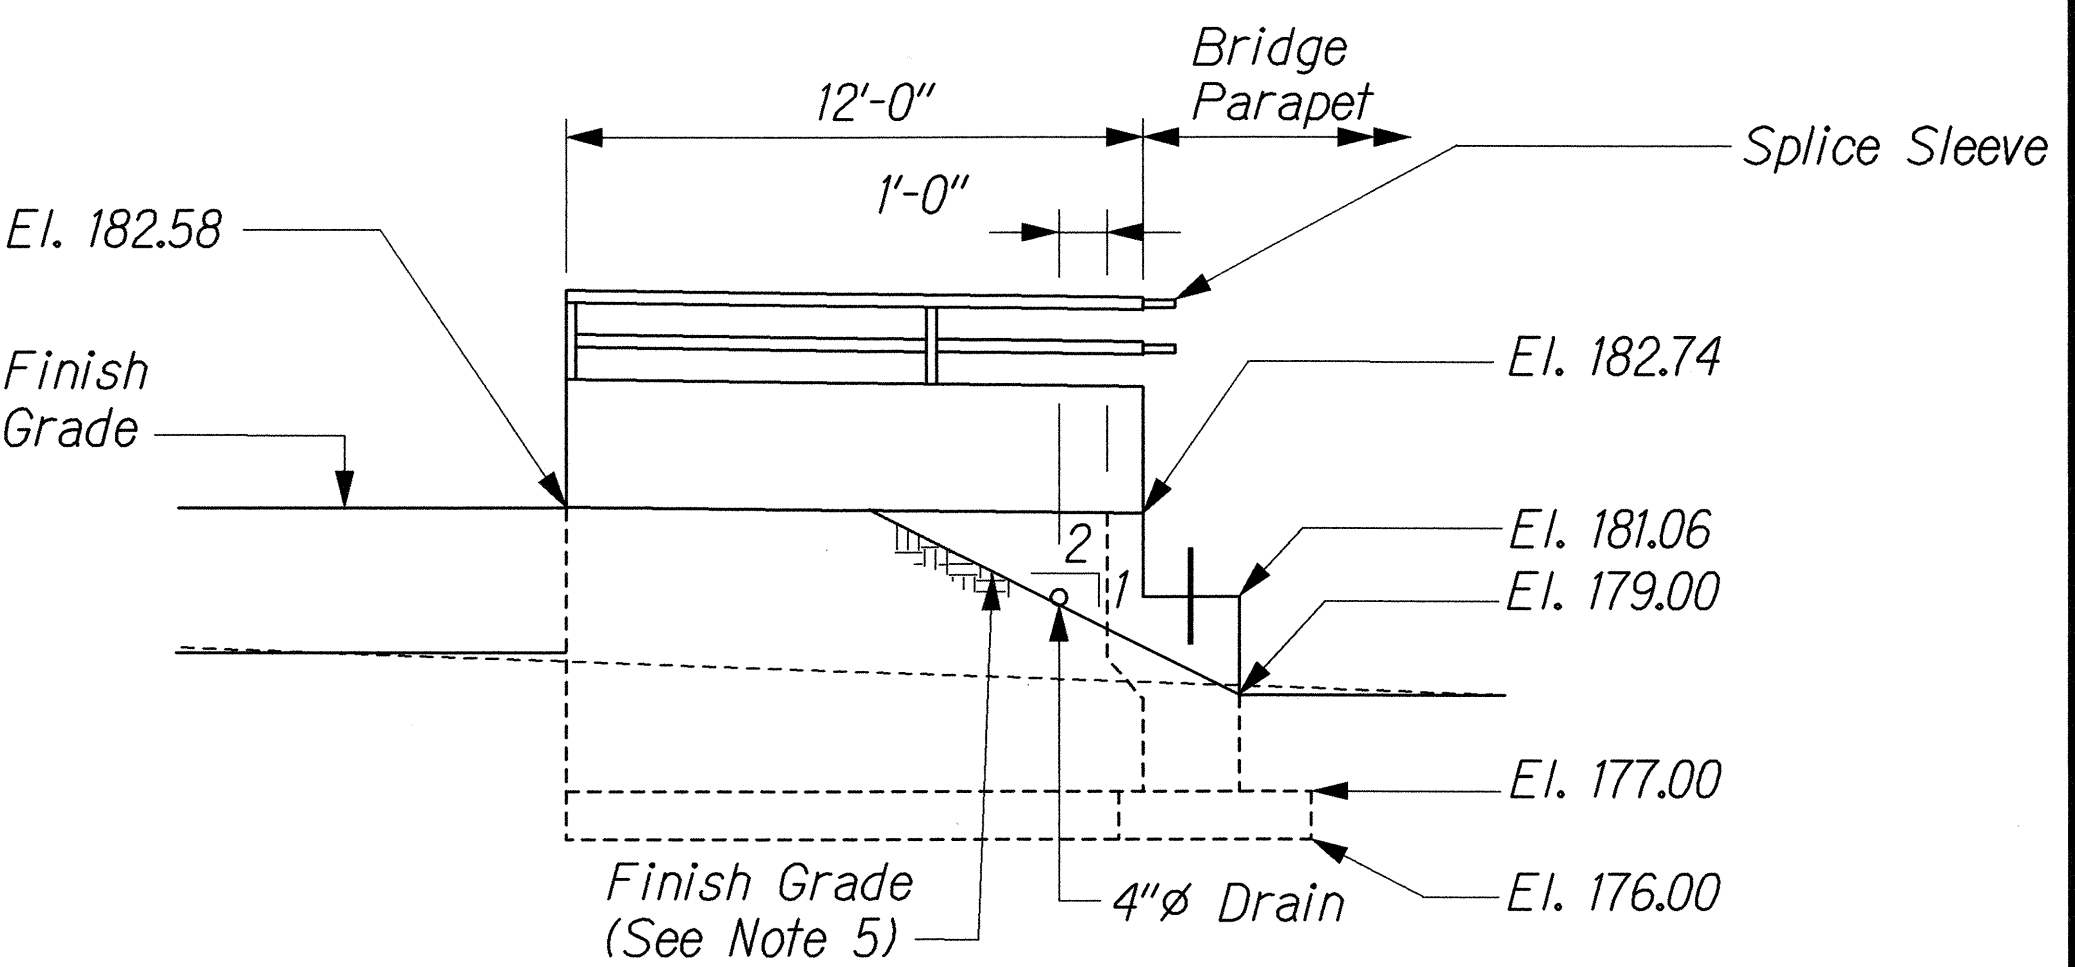

WINGWALL NO. 3 ELEVATION

Scale: 1/4" = 1'-0"

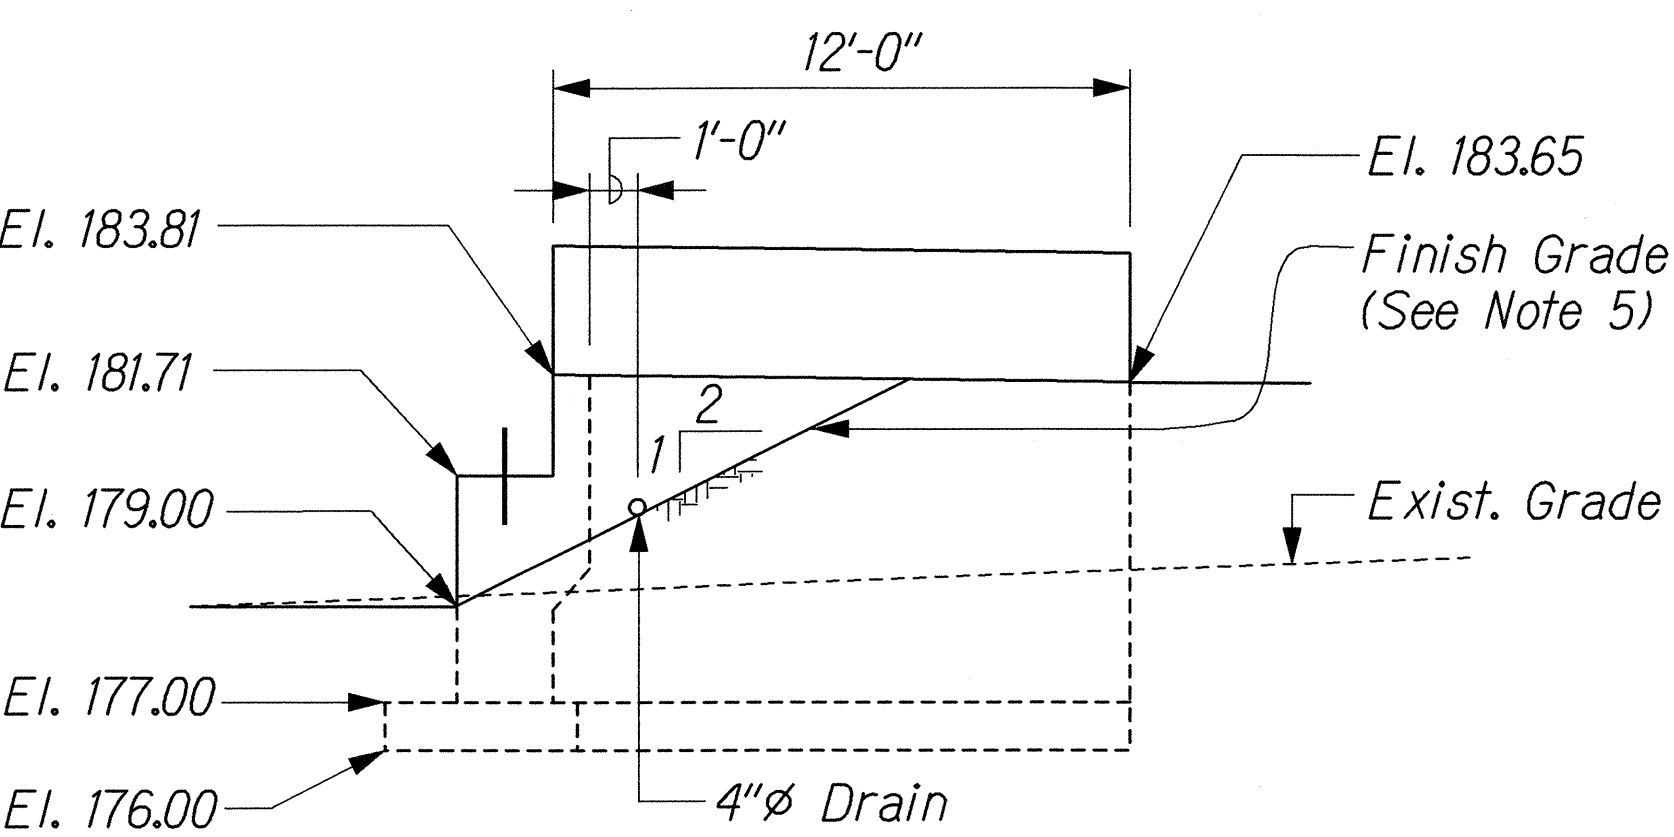

WINGWALL NO. 4 ELEVATION

Scale: 1/4" = 1'-0"

NOTES:

1. For location plan, See Sht. No. S-20.
2. For Approach Slab Details, See Sht. No. S-35.
3. The Contractor shall use rigid template to install the 3/4"Ø A36 dowels to the locations as shown.
4. See Note 4 on Sht. S-22.
5. See Note 7(L) on Sht. No. S-2.

DATE	_____
SURVEY PLOTTED BY	_____
DRAWN BY	_____
DESIGNED BY	_____
CHECKED BY	_____
NO.	_____

W/ KUIHELANI / STRUCT / ST-DET / adgn

THIS WORK WAS PREPARED BY ME
OR UNDER MY SUPERVISION.

Rui Pang Chen

STATE OF HAWAII
DEPARTMENT OF TRANSPORTATION
HIGHWAYS DIVISION

WAIHEE STREAM BRIDGE

ABUTMENT SHEET 2 OF 3


KUIHELANI HIGHWAY WIDENING

HONOAPIILANI HIGHWAY TO PUUNENE AVENUE


FEDERAL-AID PROJECT NO. NH-0380(9)

Scale: As Shown Date: Sept. 14, 2001


FED. ROAD DIST. NO.	STATE	FED. AID PROJ. NO.	FISCAL YEAR	SHEET NO.	TOTAL SHEETS
HAWAII	HAW.	NH-0380(9)	2000	186	380

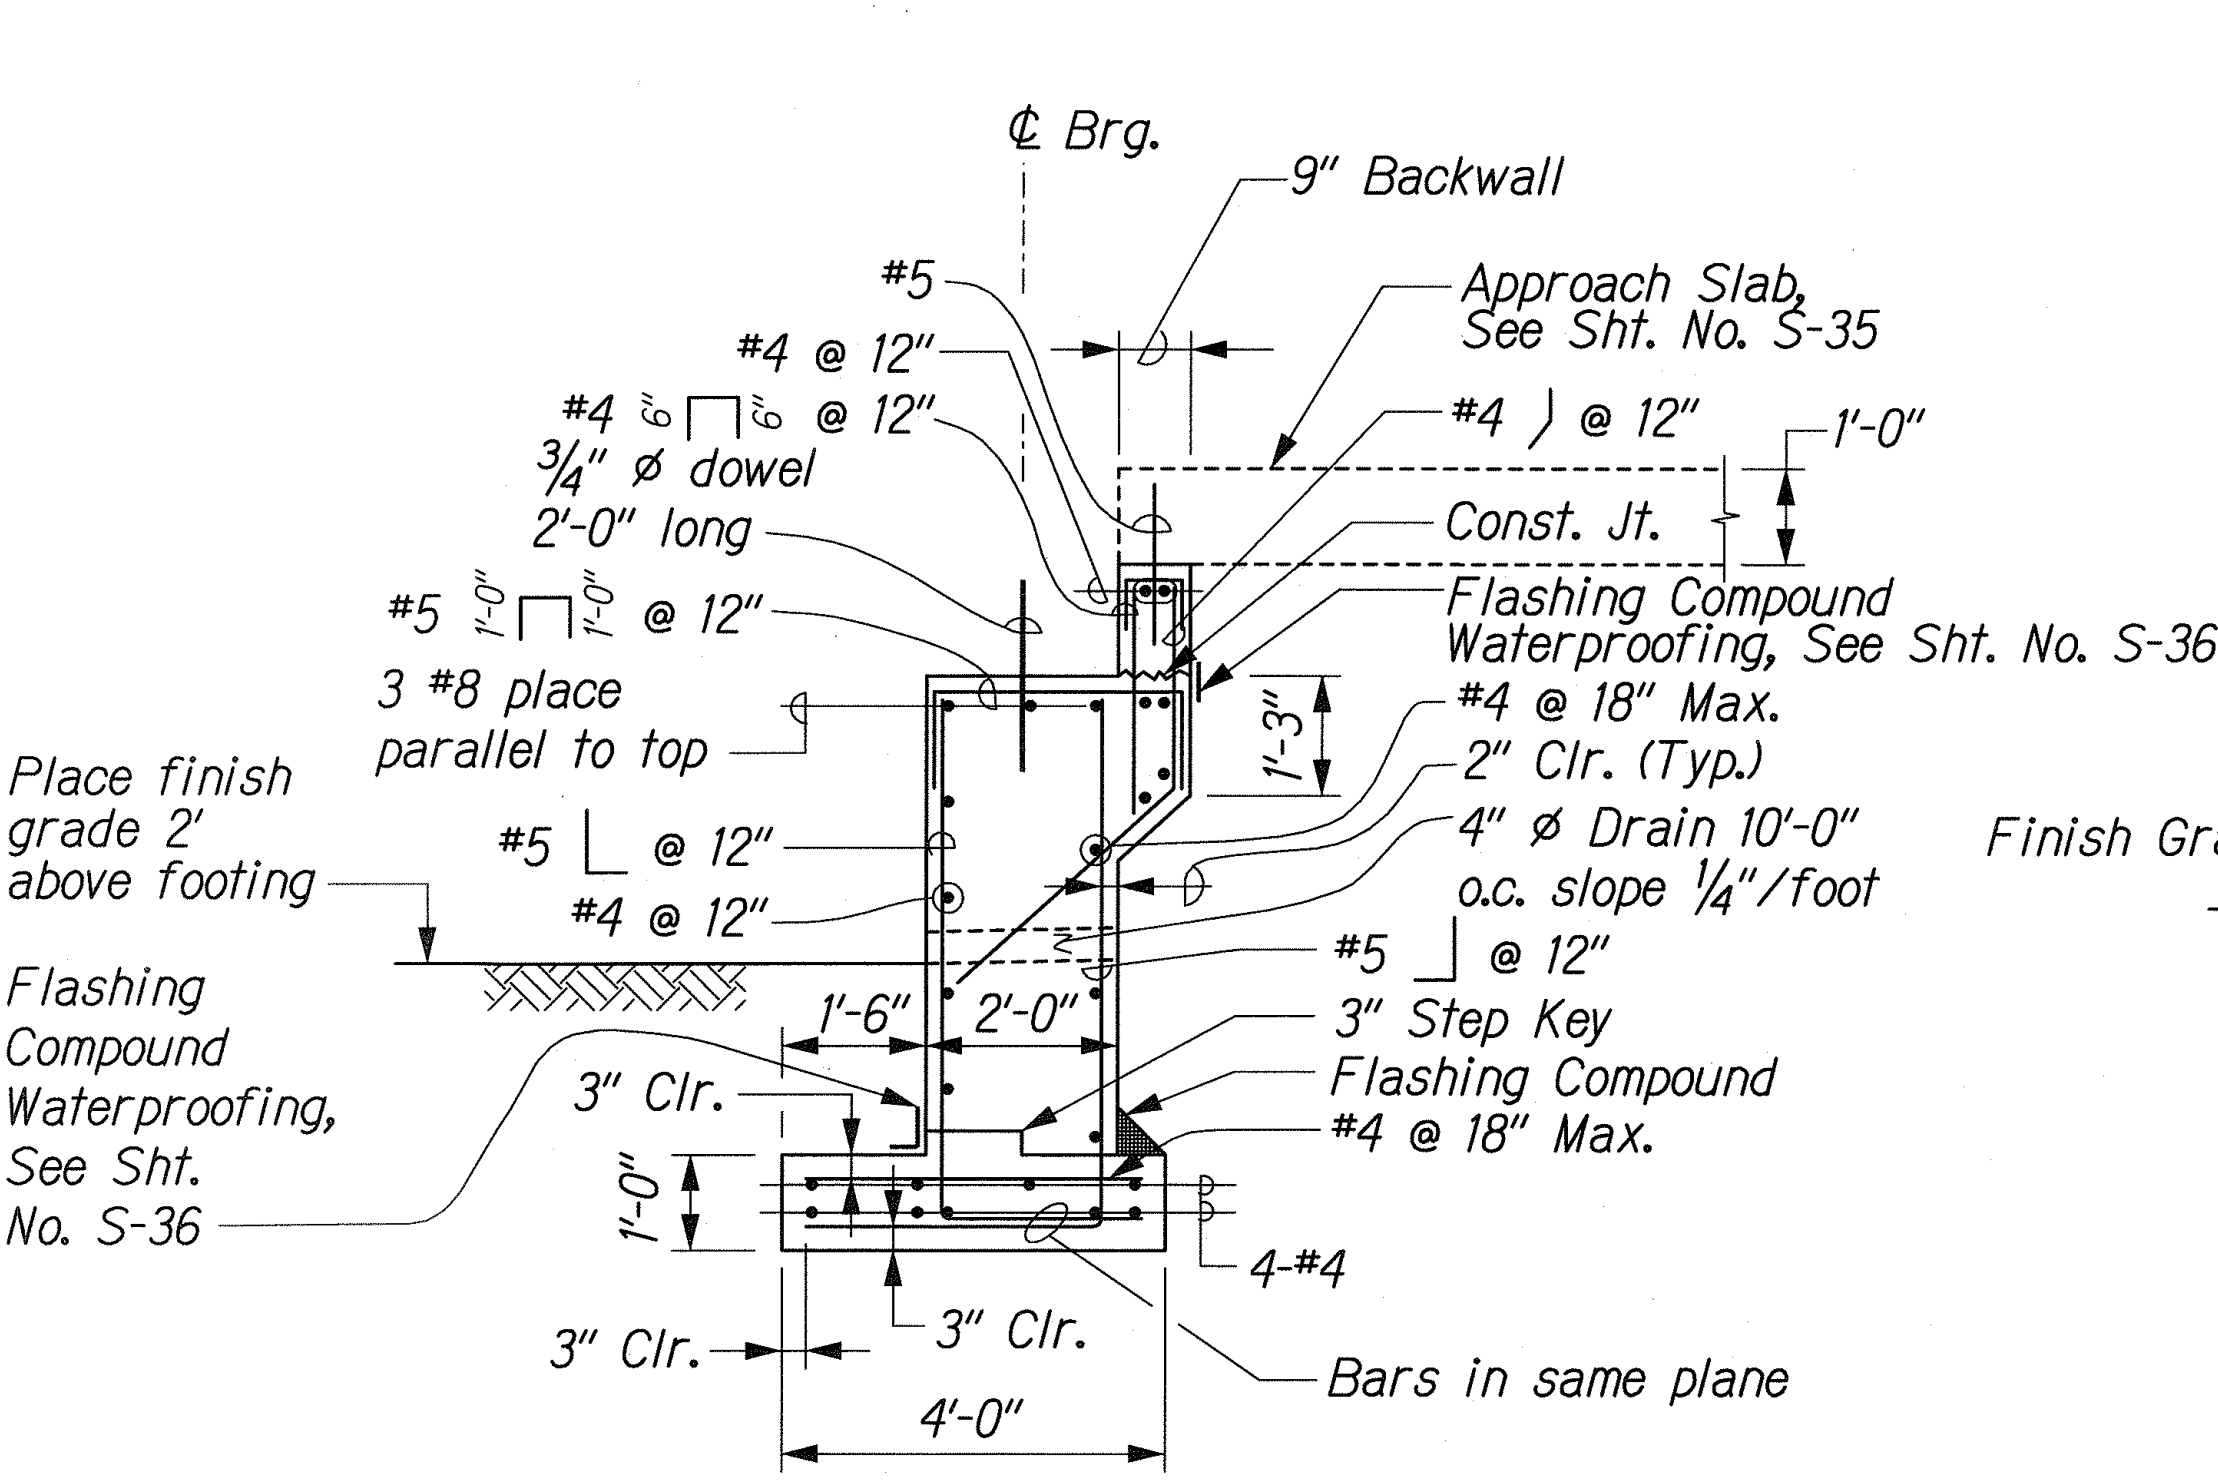

TYPICAL ABUTMENT SECTION
Scale: 1/2" = 1'-0"

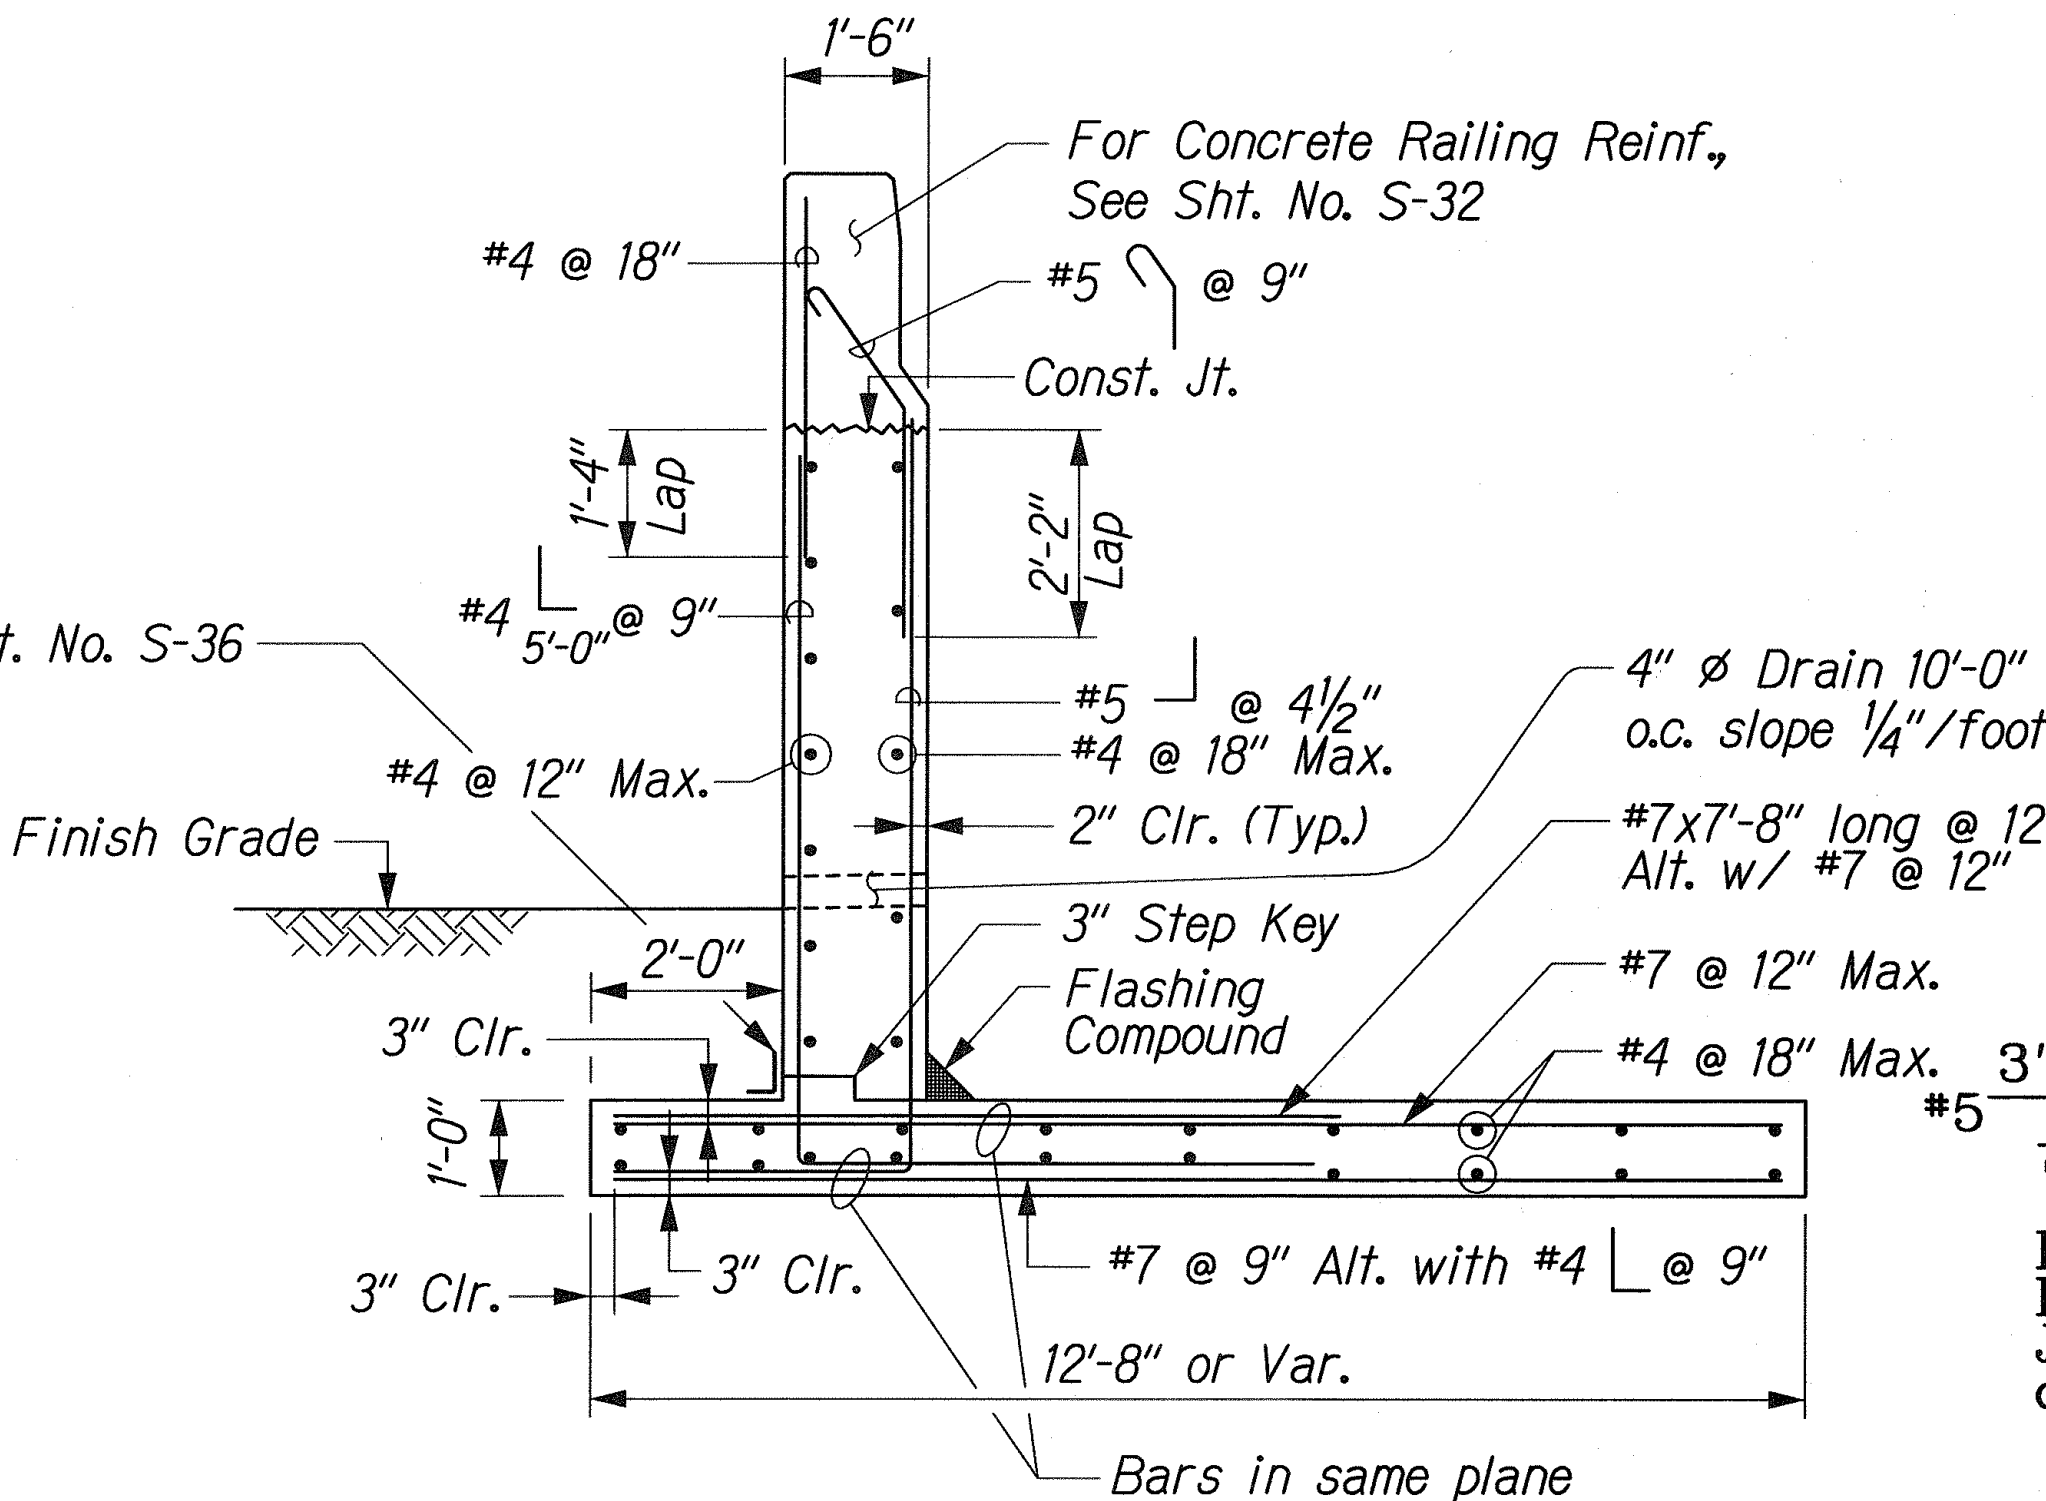


TYPICAL WINGWALL SECTION
Scale: 1/2" = 1'-0"

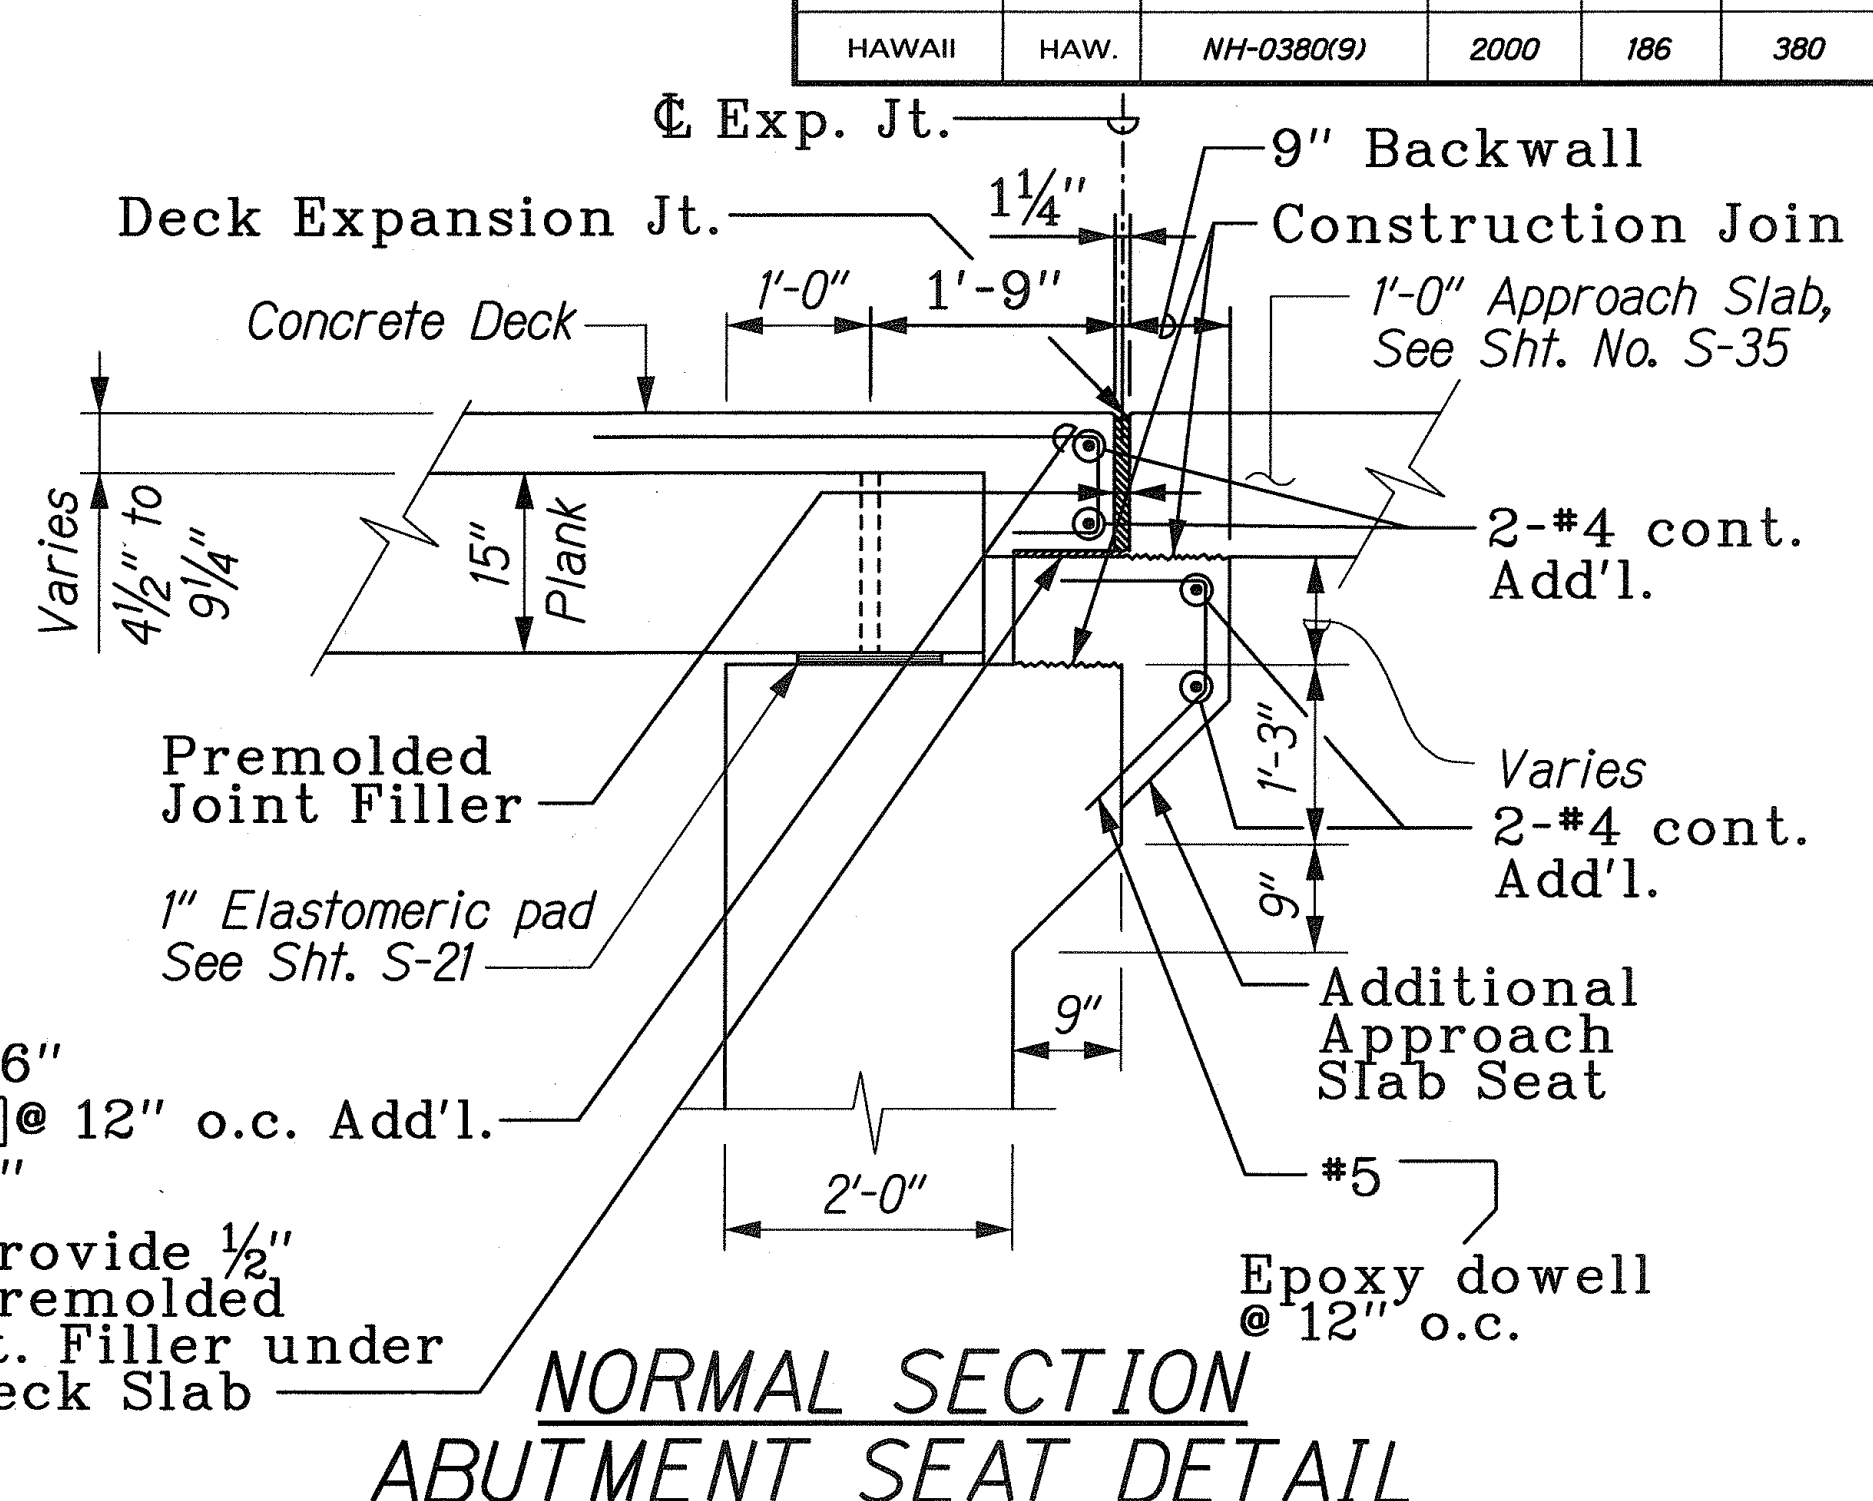


NORMAL SECTION
ABUTMENT SEAT DETAIL
Scale: 3/4" = 1'-0"

LEGEND FOR AS-BUILT POSTINGS

	Squiggly line for as-built deletion
	Double line for as-built deletion
	Text for as-built posting

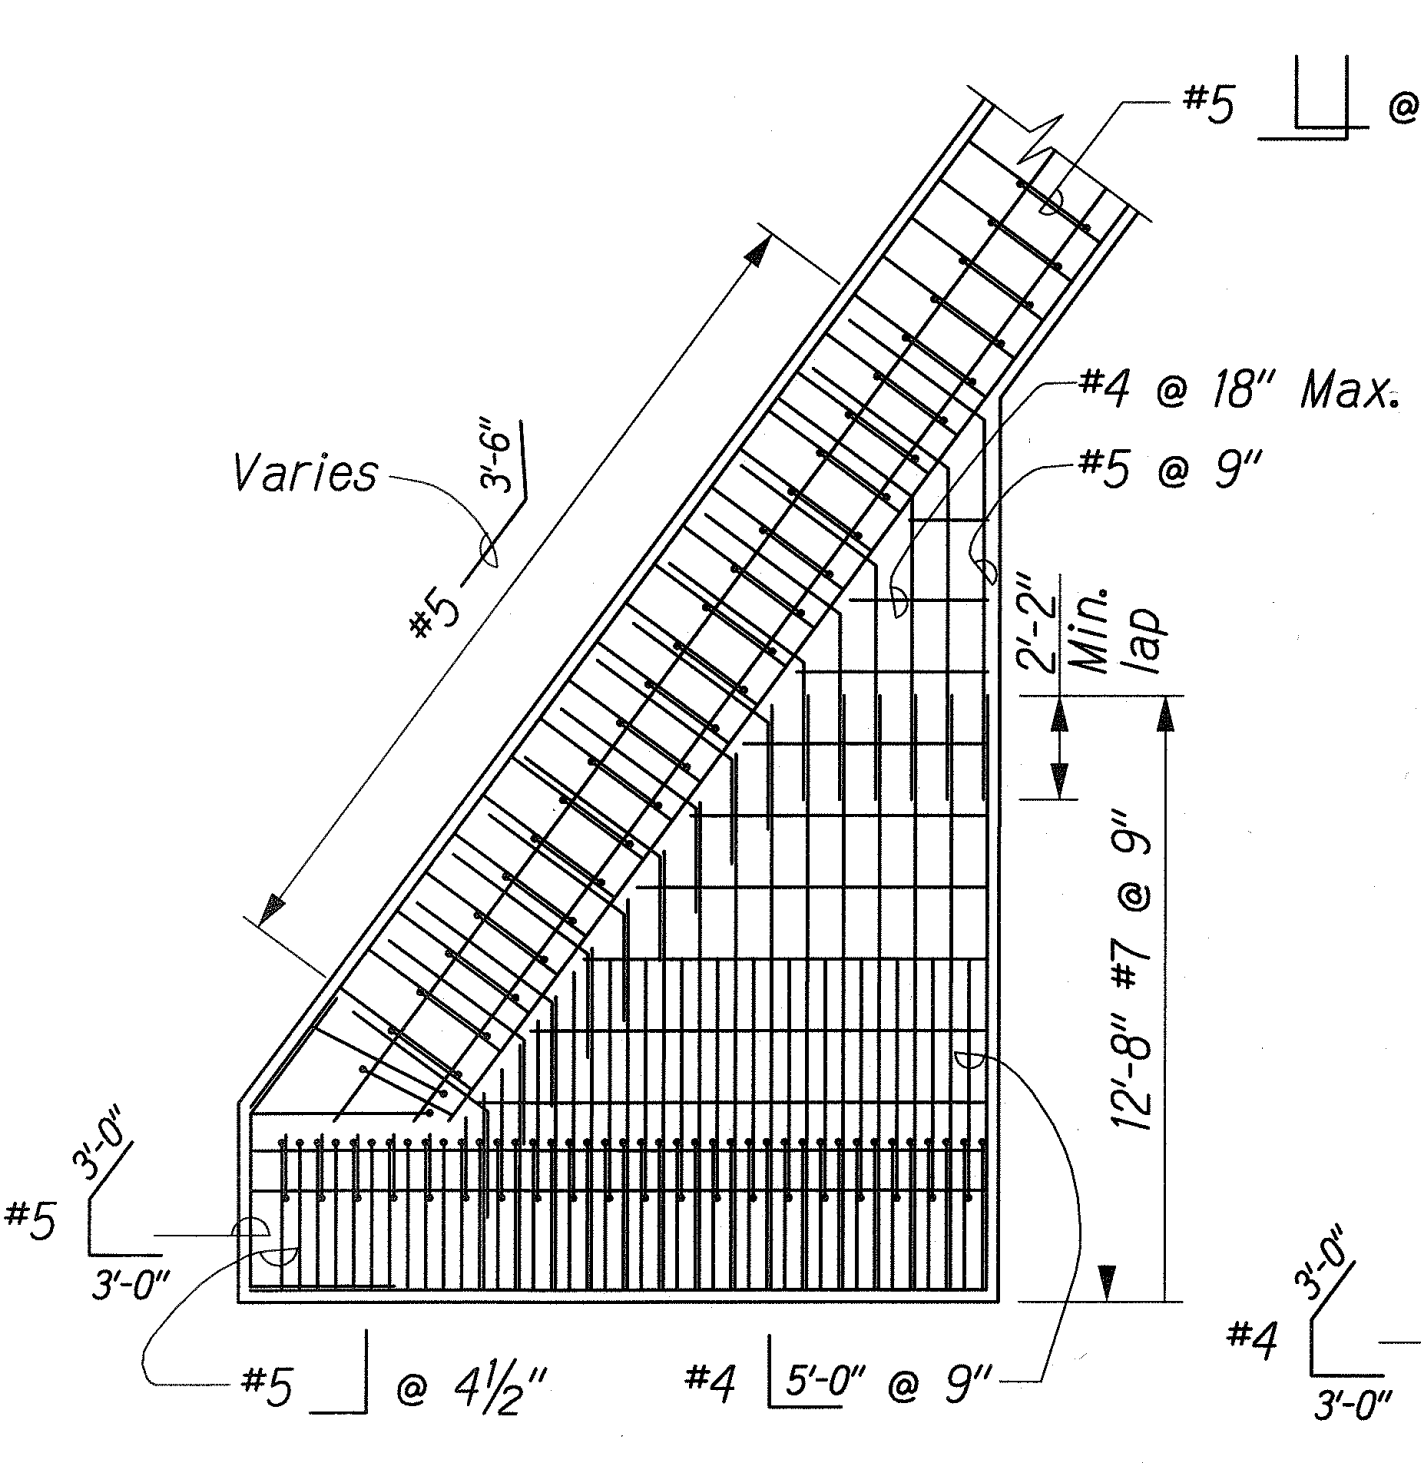


BOTTOM MAT
Scale: 1/4" = 1'-0"

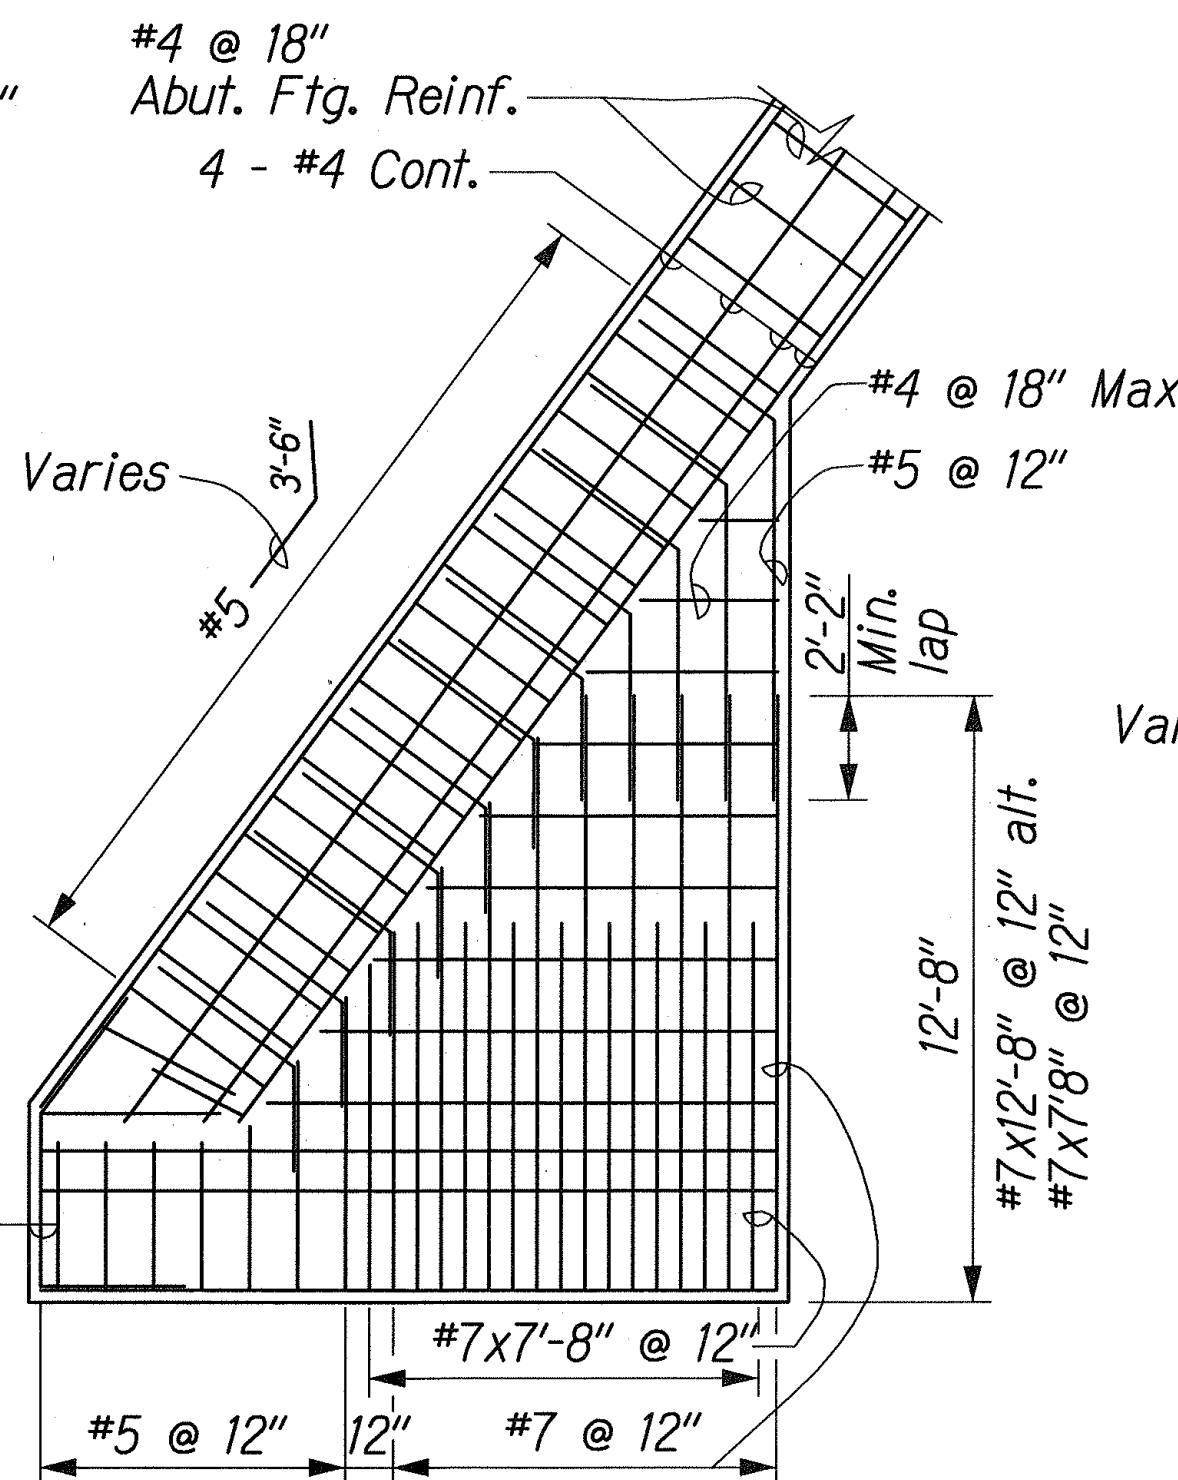


TOP MAT
Scale: 1/4" = 1'-0"

DETAIL 1
FOOTING REINFORCING PLAN

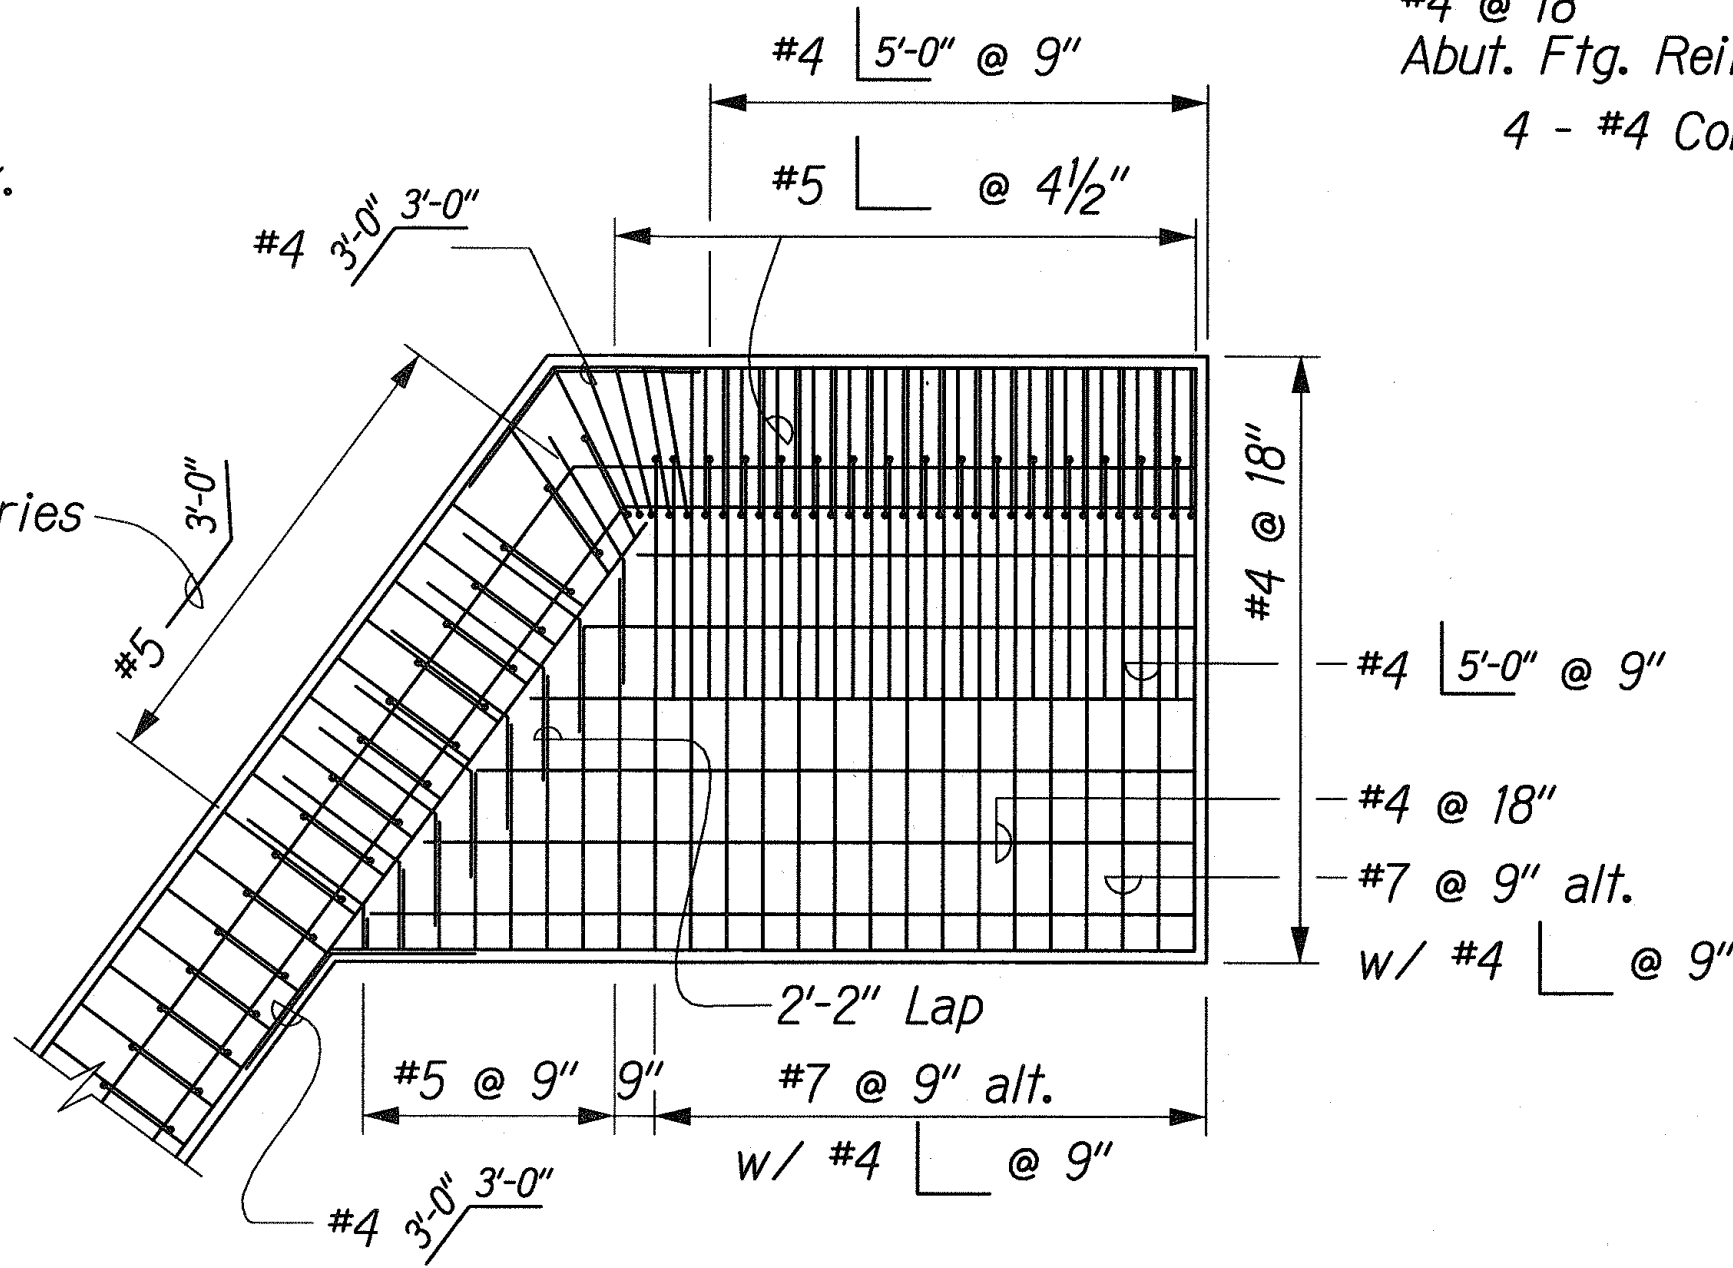

BOTTOM MAT
Scale: 1/4" = 1'-0"

DETAIL 2
FOOTING REINFORCING PLAN

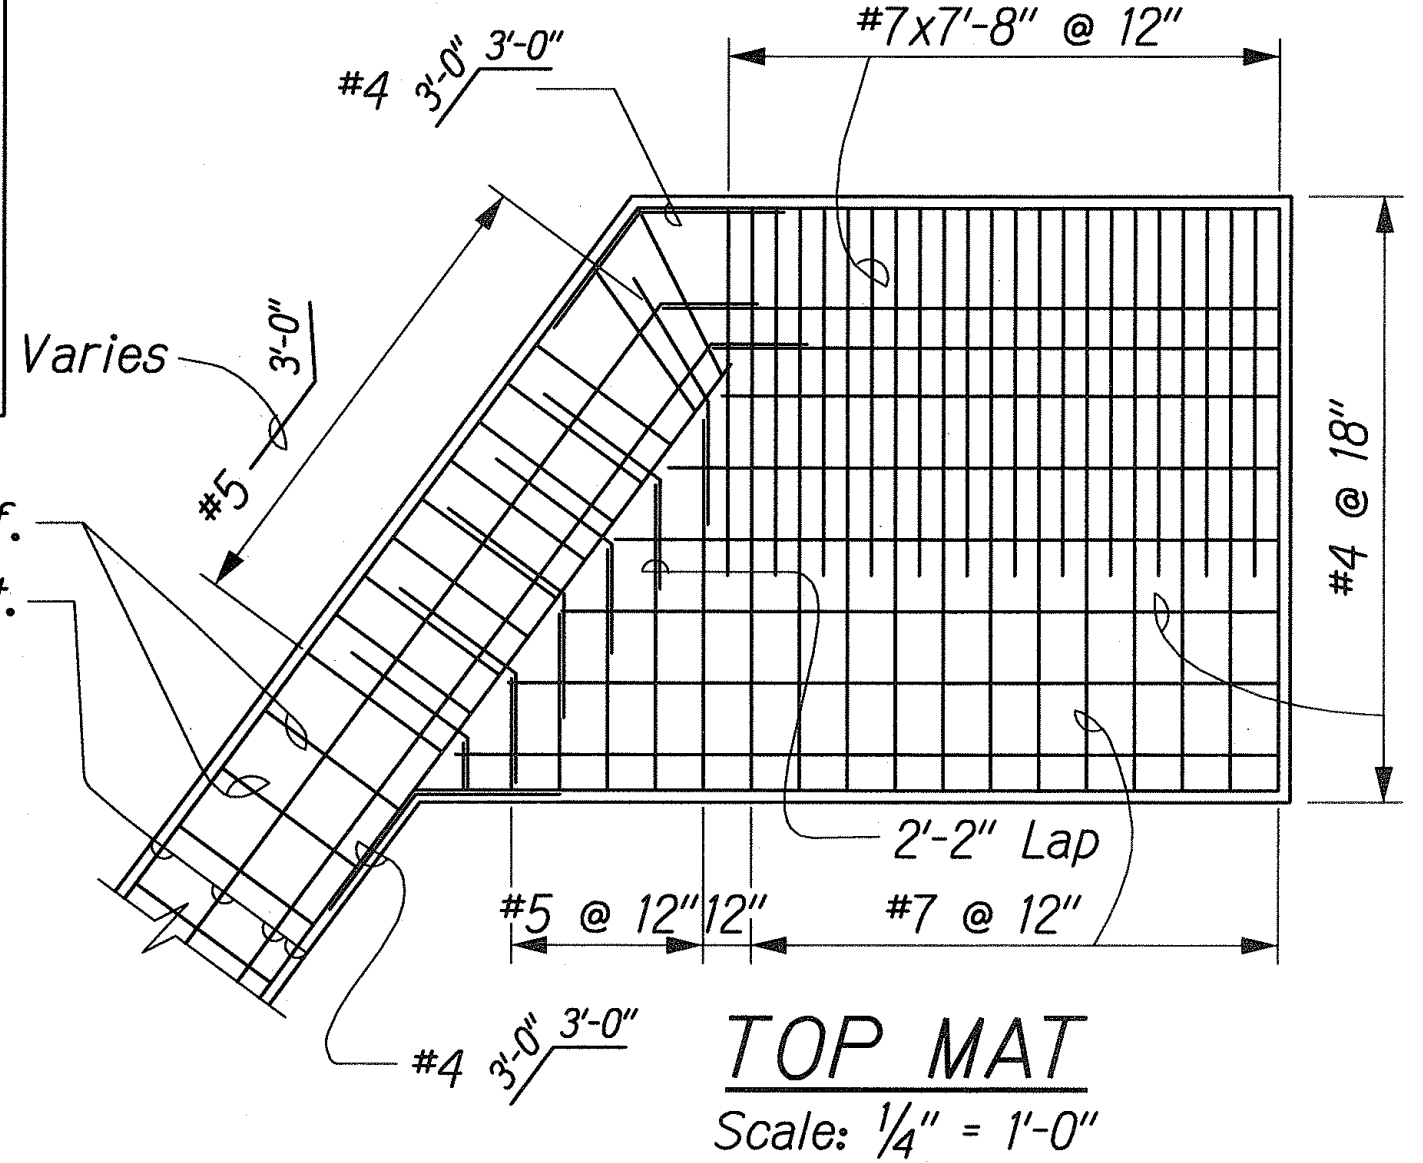

TOP MAT
Scale: 1/4" = 1'-0"



ORIGINAL PLAN	SURVEY PLOTTED BY	DATE
NOTE BOOK	DRAWN BY	
	DESIGNED BY	
	CHECKED BY	

JG/KUIHELANI/STRUCT/ST-DET1.dgn


THIS WORK WAS PREPARED BY ME OR UNDER MY SUPERVISION.
Hui Pang Chen

STATE OF HAWAII
DEPARTMENT OF TRANSPORTATION
HIGHWAYS DIVISION
WAIHEE STREAM BRIDGE
ABUTMENT SHEET 3 OF 3
KUIHELANI HIGHWAY WIDENING
HONOAPIILANI HIGHWAY TO PUUNENE AVENUE
FEDERAL-AID PROJECT NO. NH-0380(9)
Scale: As Shown Date: Sept. 14, 2001


FED. ROAD DIST. NO.	STATE	FED. AID PROJ. NO.	FISCAL YEAR	SHEET NO.	TOTAL SHEETS
HAWAII	HAW.	NH-0380(9)	2000	187	380

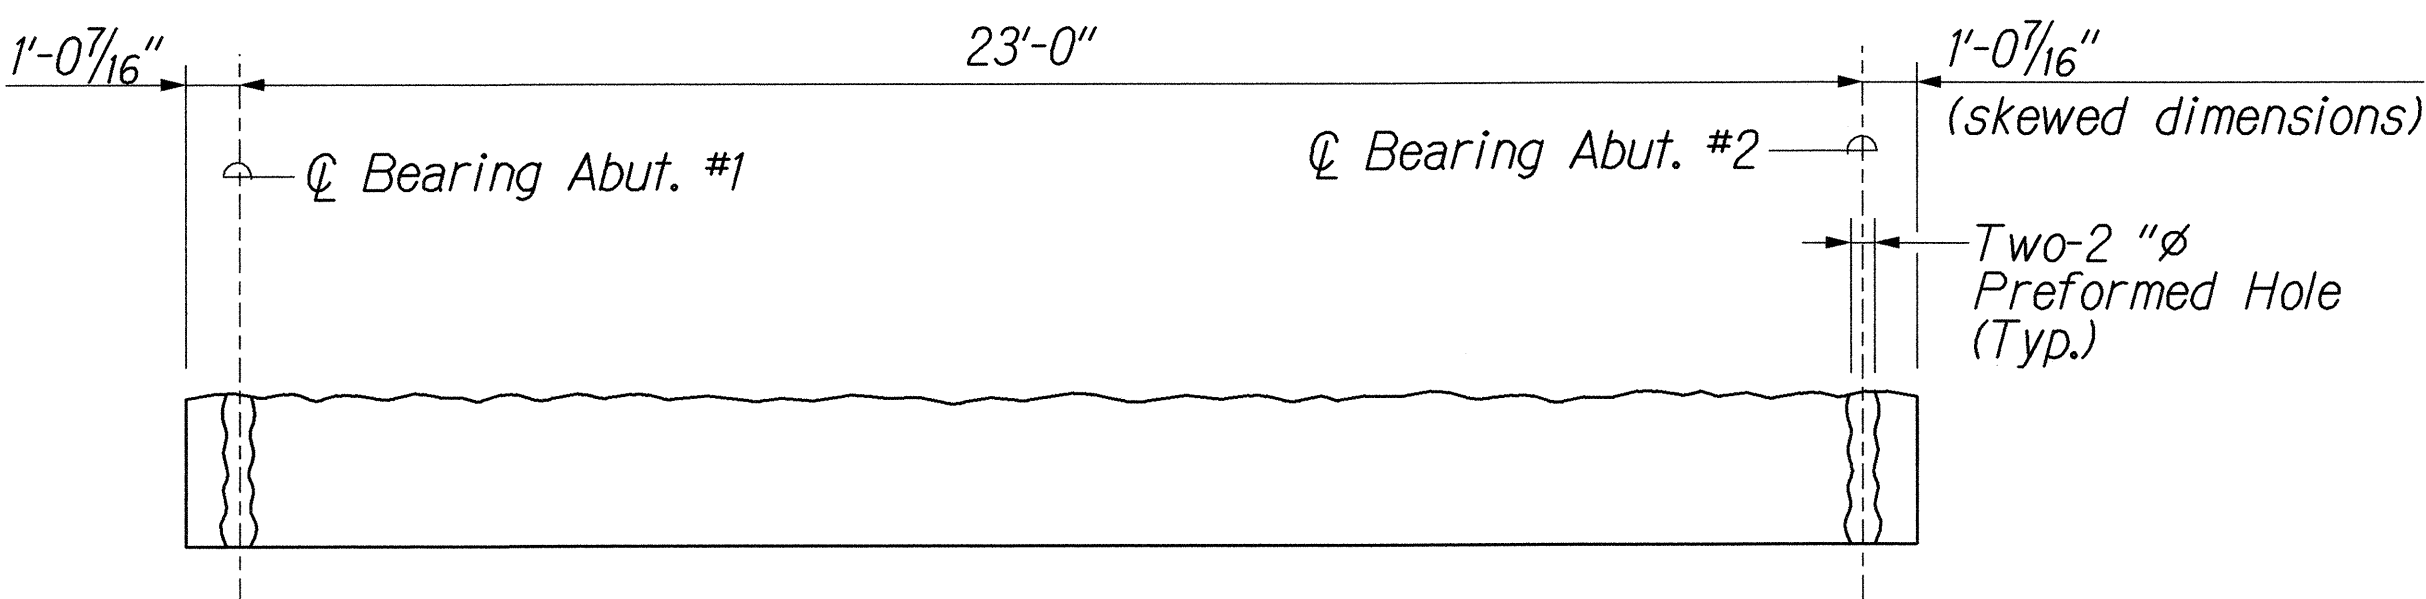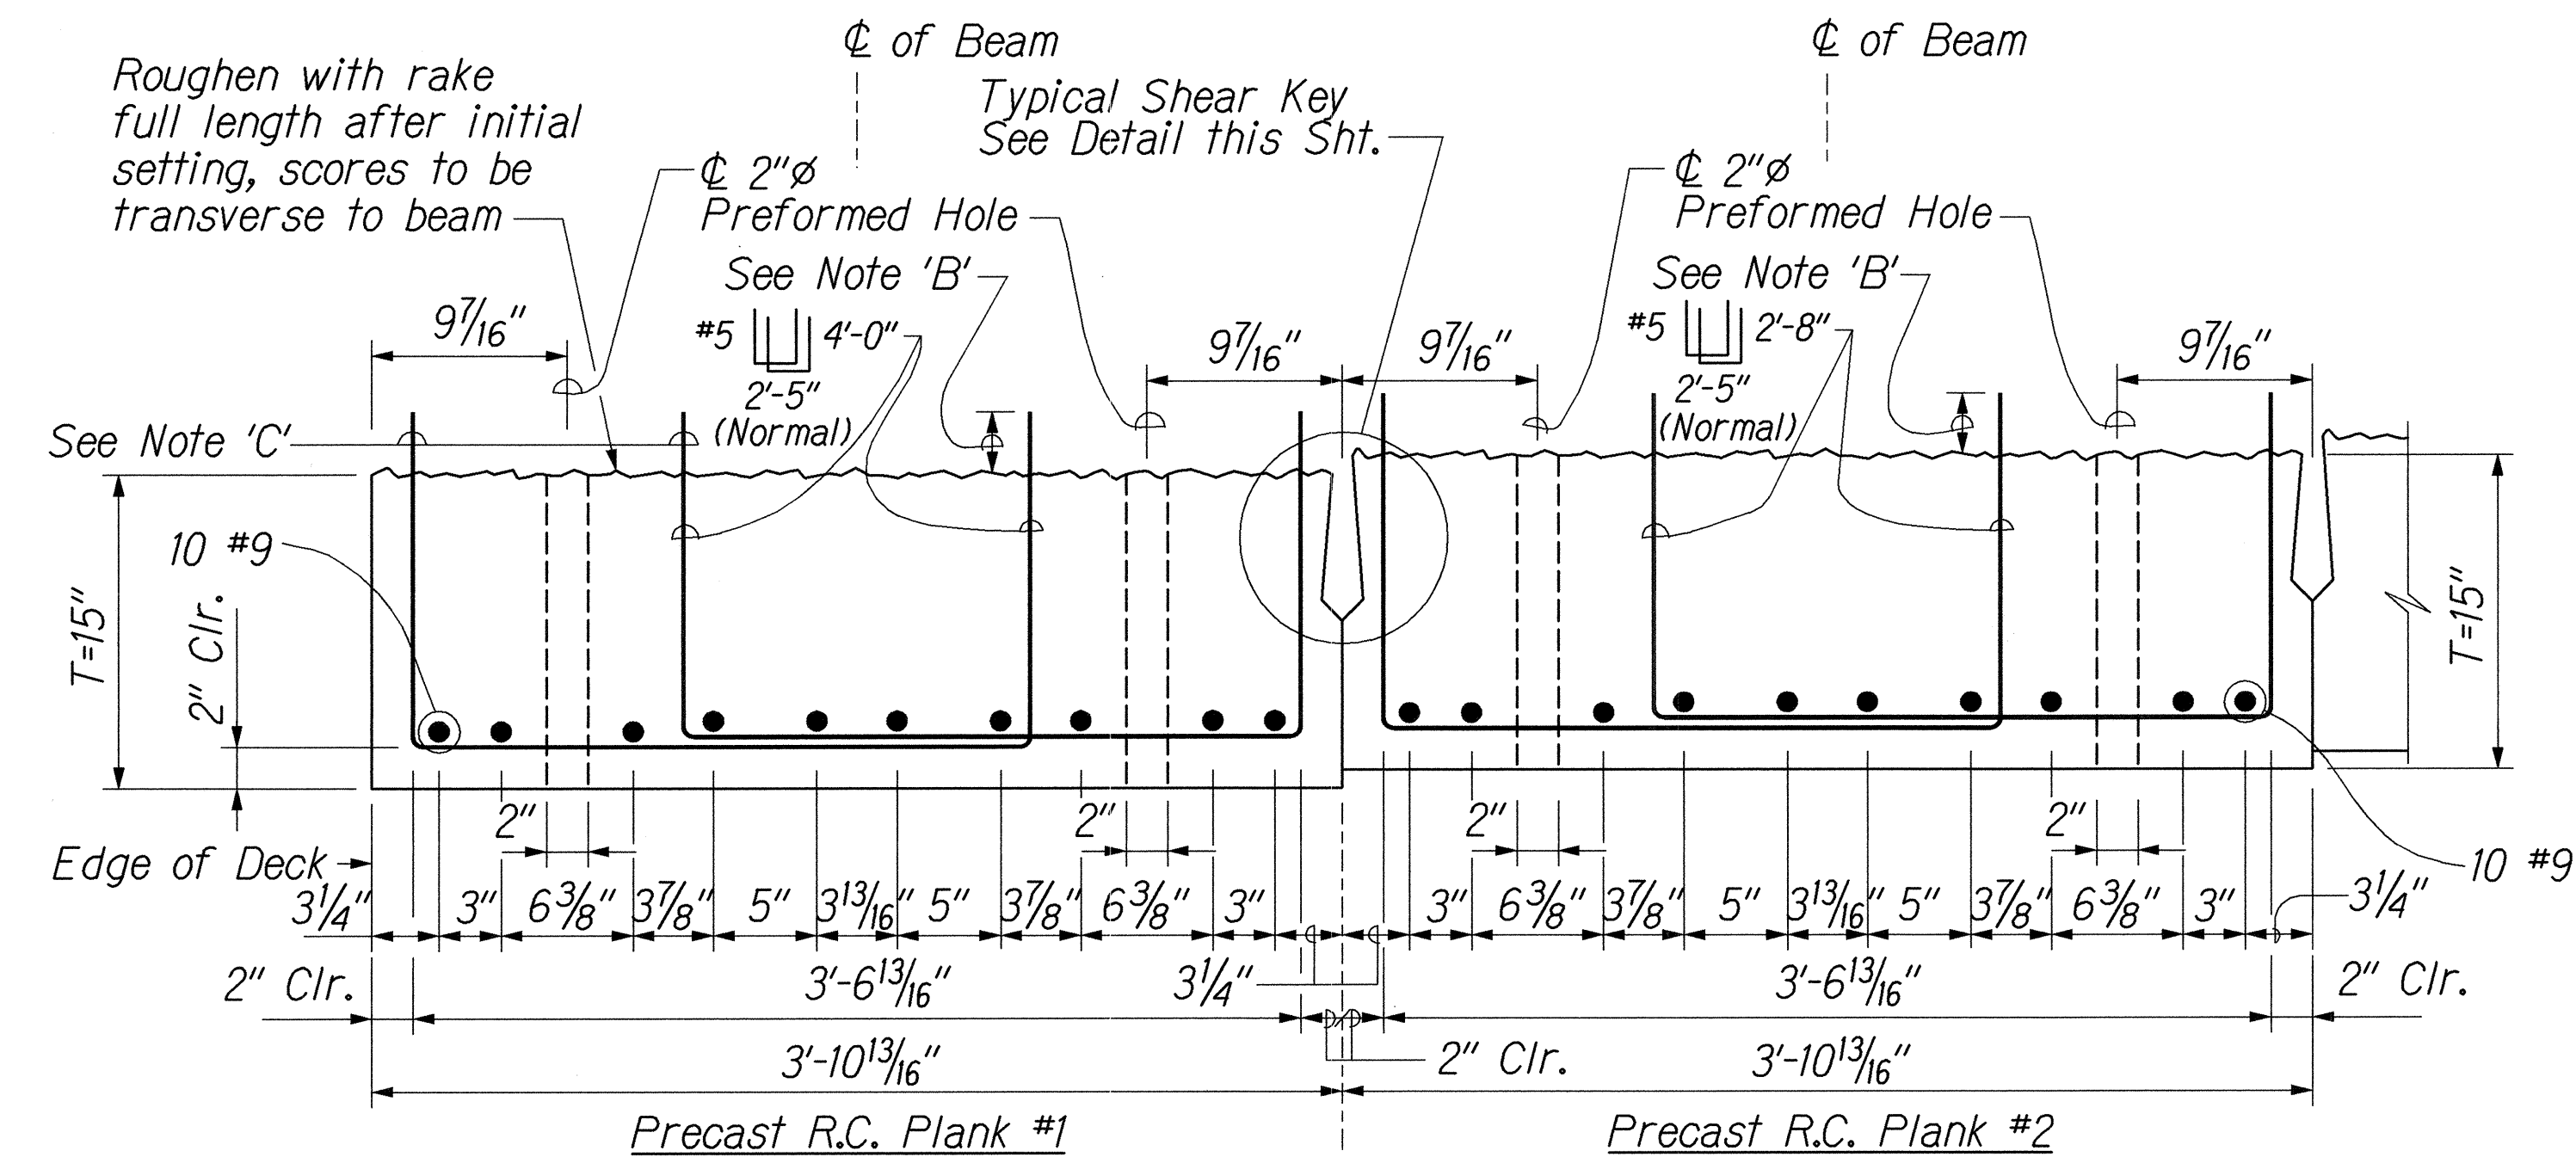

R.C. PRECAST PLANK - LONGITUDINAL SECTION
N.T.S.

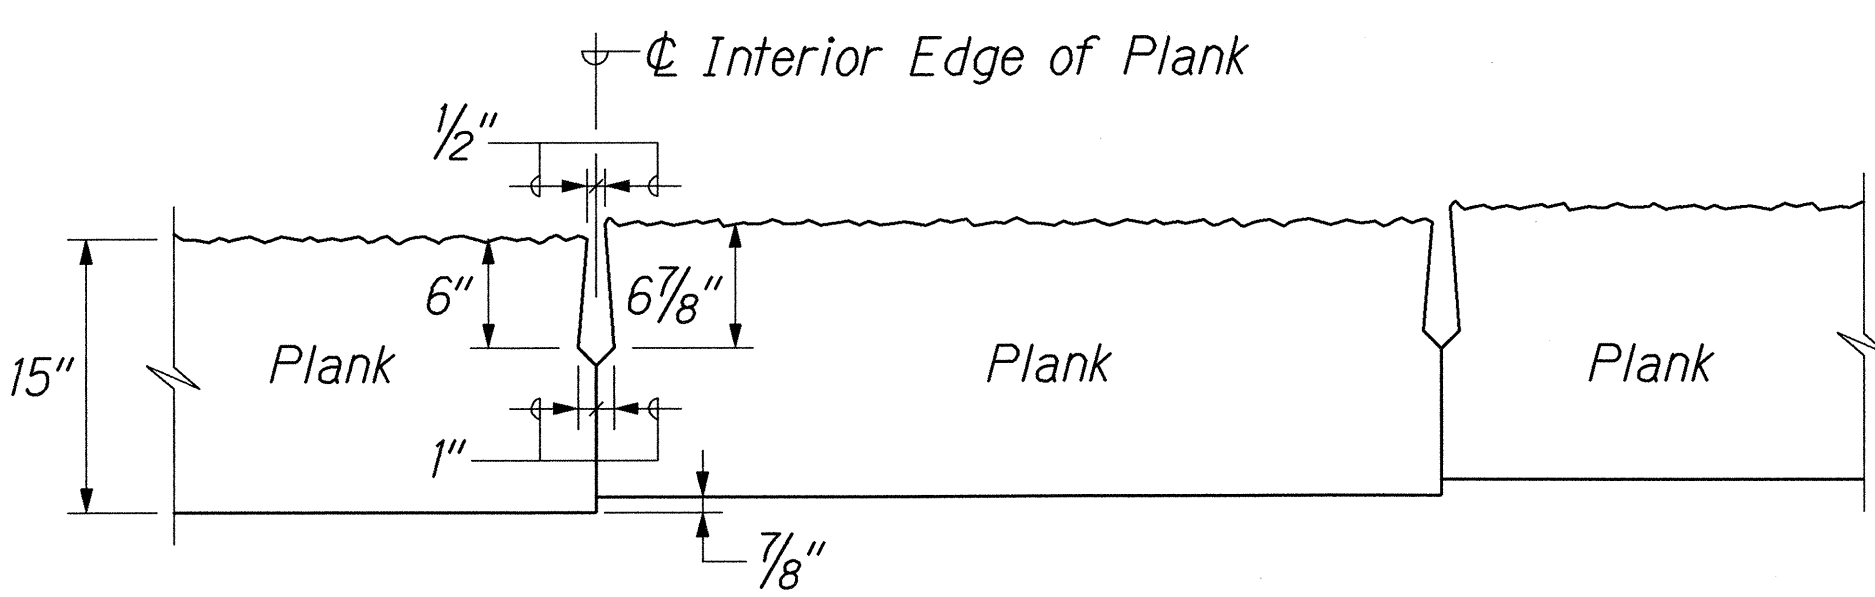

SHEAR KEY DETAIL (See Note 6)
N.T.S.

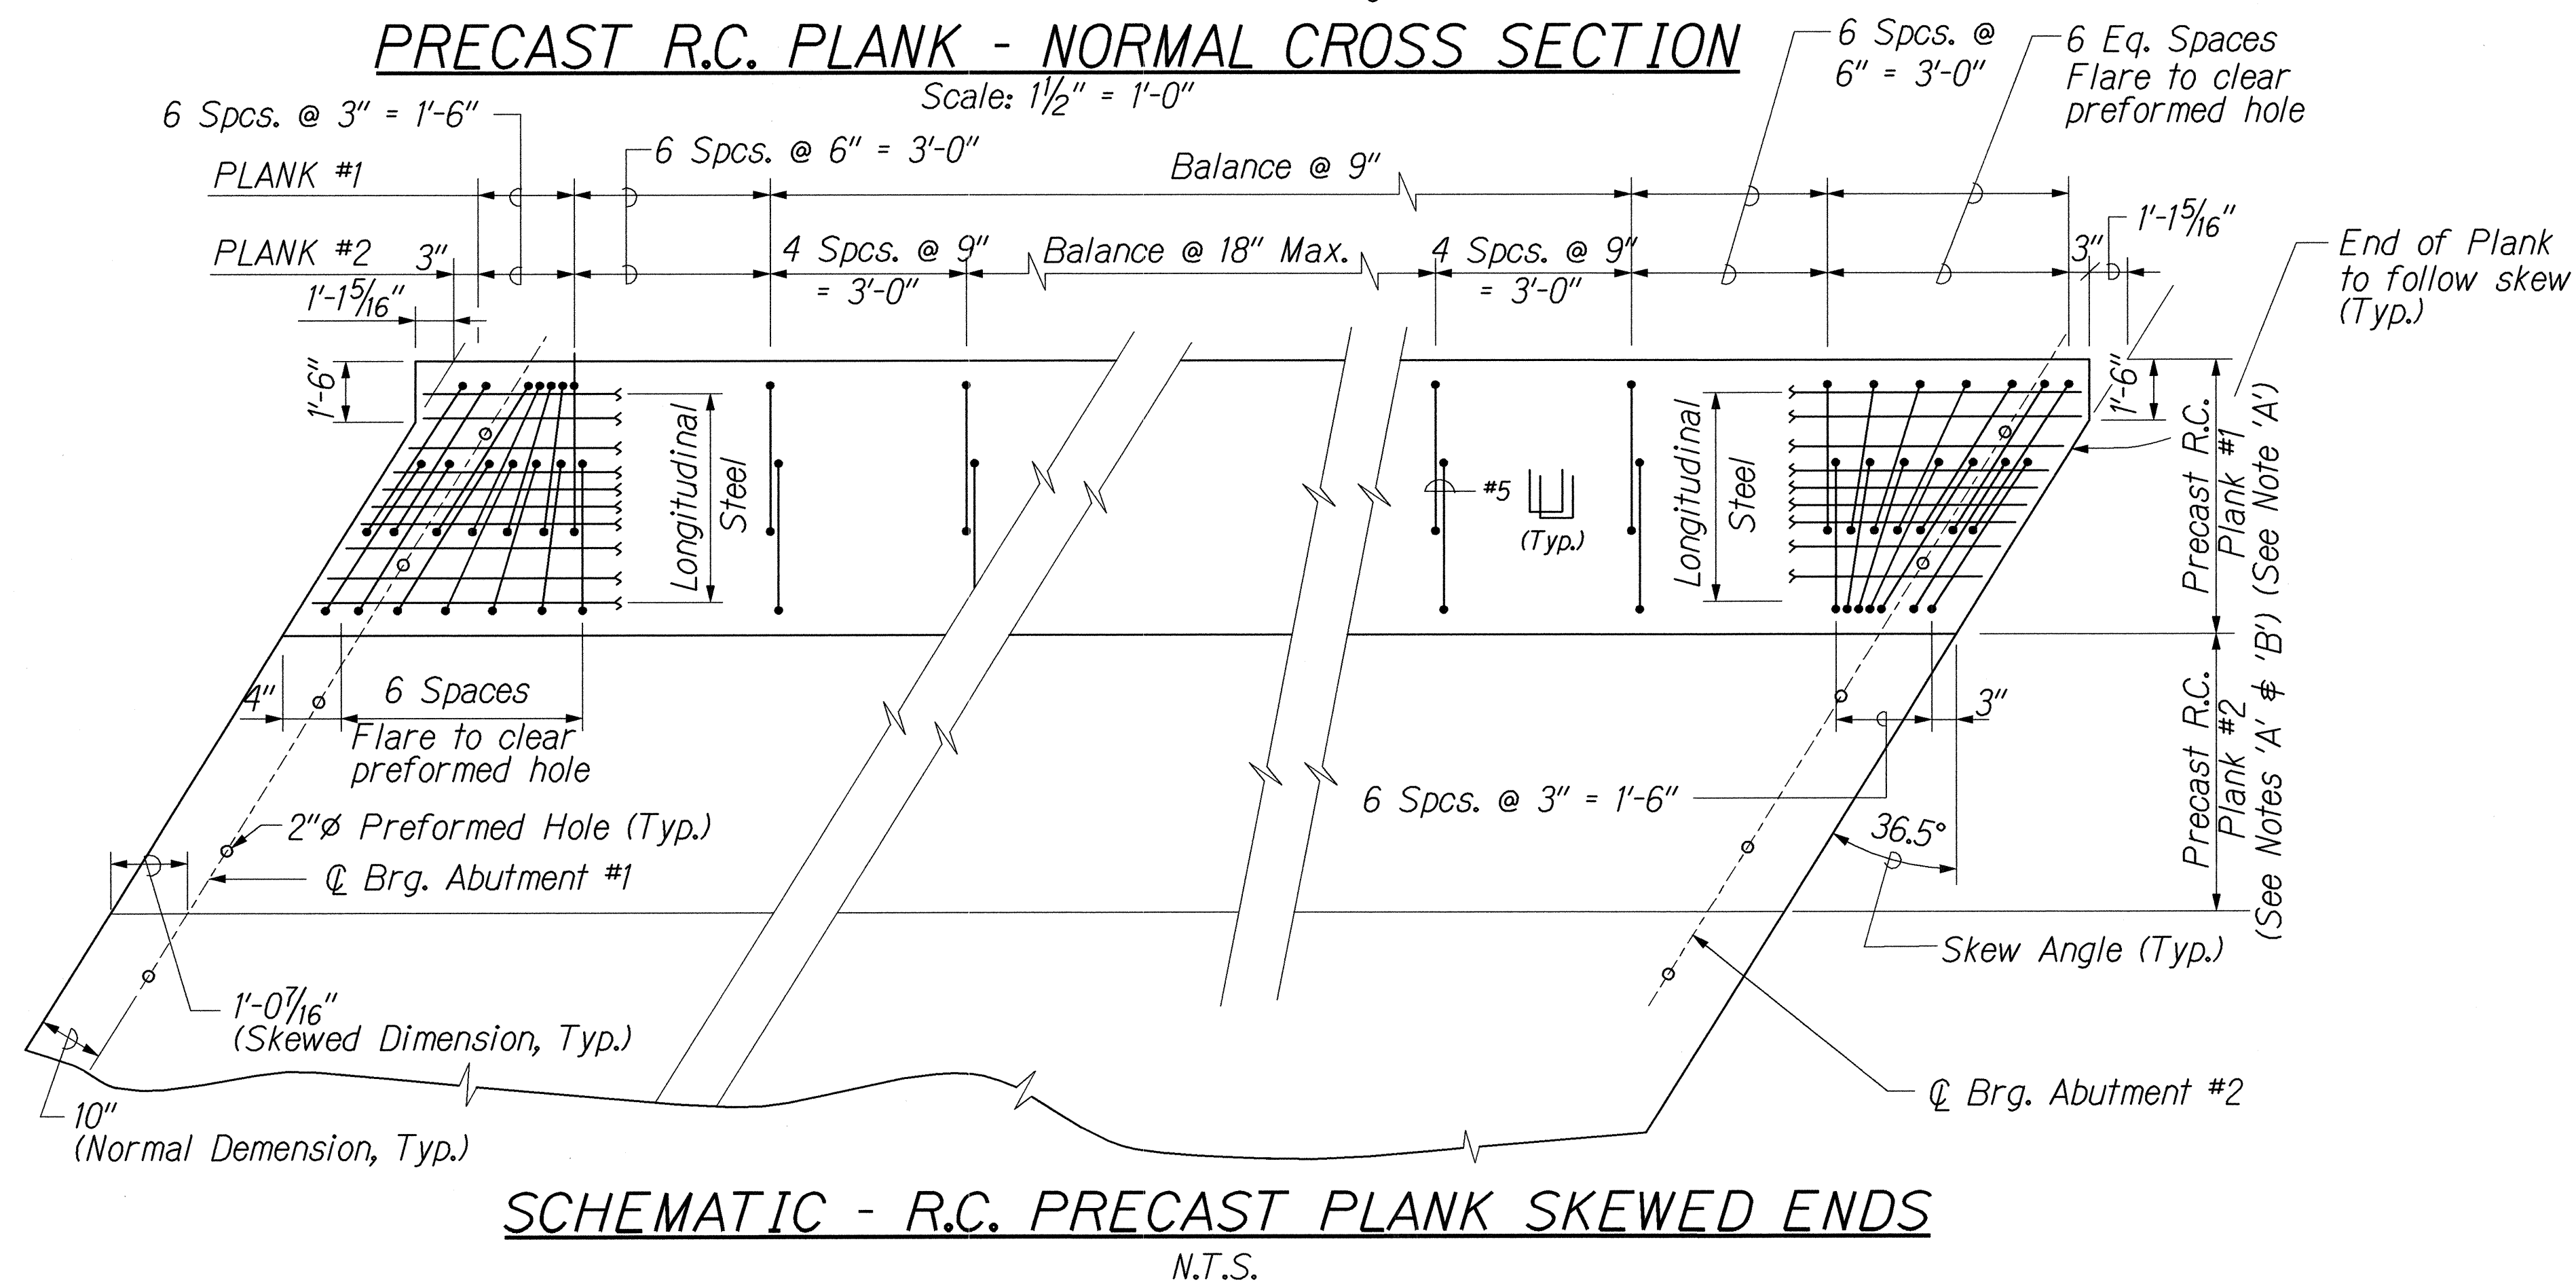


R.C. PRECAST PLANK NOTES:

- Concrete strength for precast concrete plank shall be 5000 psi at 28 days.
- Reinforcing steel precast plank shall be Grade 60 unless otherwise noted. For properties, see State Standard Specifications.
- The dead load deflection includes the combined effects of the weight of the precast plank concrete, concrete topping and concrete railing. The Contractor shall provide appropriate camber to accommodate this deflection.
- During curing, care shall be taken to avoid any lateral deflection of the beam due to improper orientation.
- Lifting devices shall be placed as close as possible to the centerline of bearings of the plank. Details and locations of lifting devices shall be submitted to the Engineer for acceptance. Such acceptance does not relieve the Contractor of his responsibilities if beam is damaged due to the failure of the lifting device.
- After joining all planks, place grout in the shear key prior to placing topping concrete. The grout shall have a minimum 28-day strength of 5000 psi.

NOTES:

- Precast R.C. Plank #1 stirrup spacings are shown. Precast R.C. Plank #2 stirrup spacings are similar.
- Bend bars in field 2" below top of deck when deck thickness is limited.
- Extend the vertical legs of rebars of Precast R.C. Plank #1 into Concrete Railing to lap with Concrete Railing rebars as shown on Sht. No. S-32.

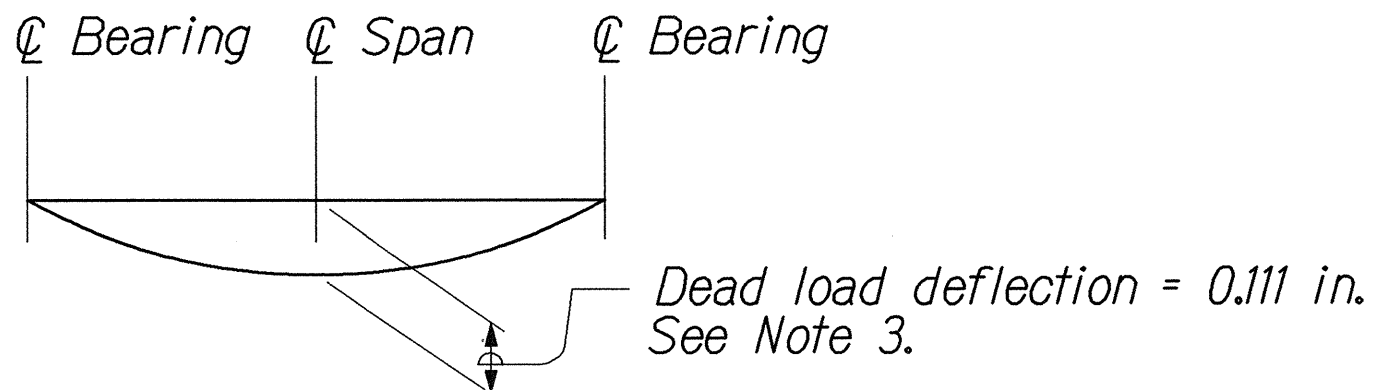


PLANK D.L. DEFLECTION DIAGRAM
N.T.S.

THIS WORK WAS PREPARED BY ME OR UNDER MY SUPERVISION.
Rui Pang Chen


STATE OF HAWAII
DEPARTMENT OF TRANSPORTATION
HIGHWAYS DIVISION
WAIHEE DITCH BRIDGE
PRECAST R.C. PLANK DETAILS
KUIHELANI HIGHWAY WIDENING
HONOAPIILANI HIGHWAY TO PUUNENE AVENUE
FEDERAL-AID PROJECT NO. NH-0380(9)
Scale: As Shown Date: Sept. 14, 2001

DIST. NO.	PROJ. NO.	YEAR	NO.
HAWAII	HAW. NH-0380(9)	2000	188

Scale: $\frac{3}{4}'' = 1'-0''$

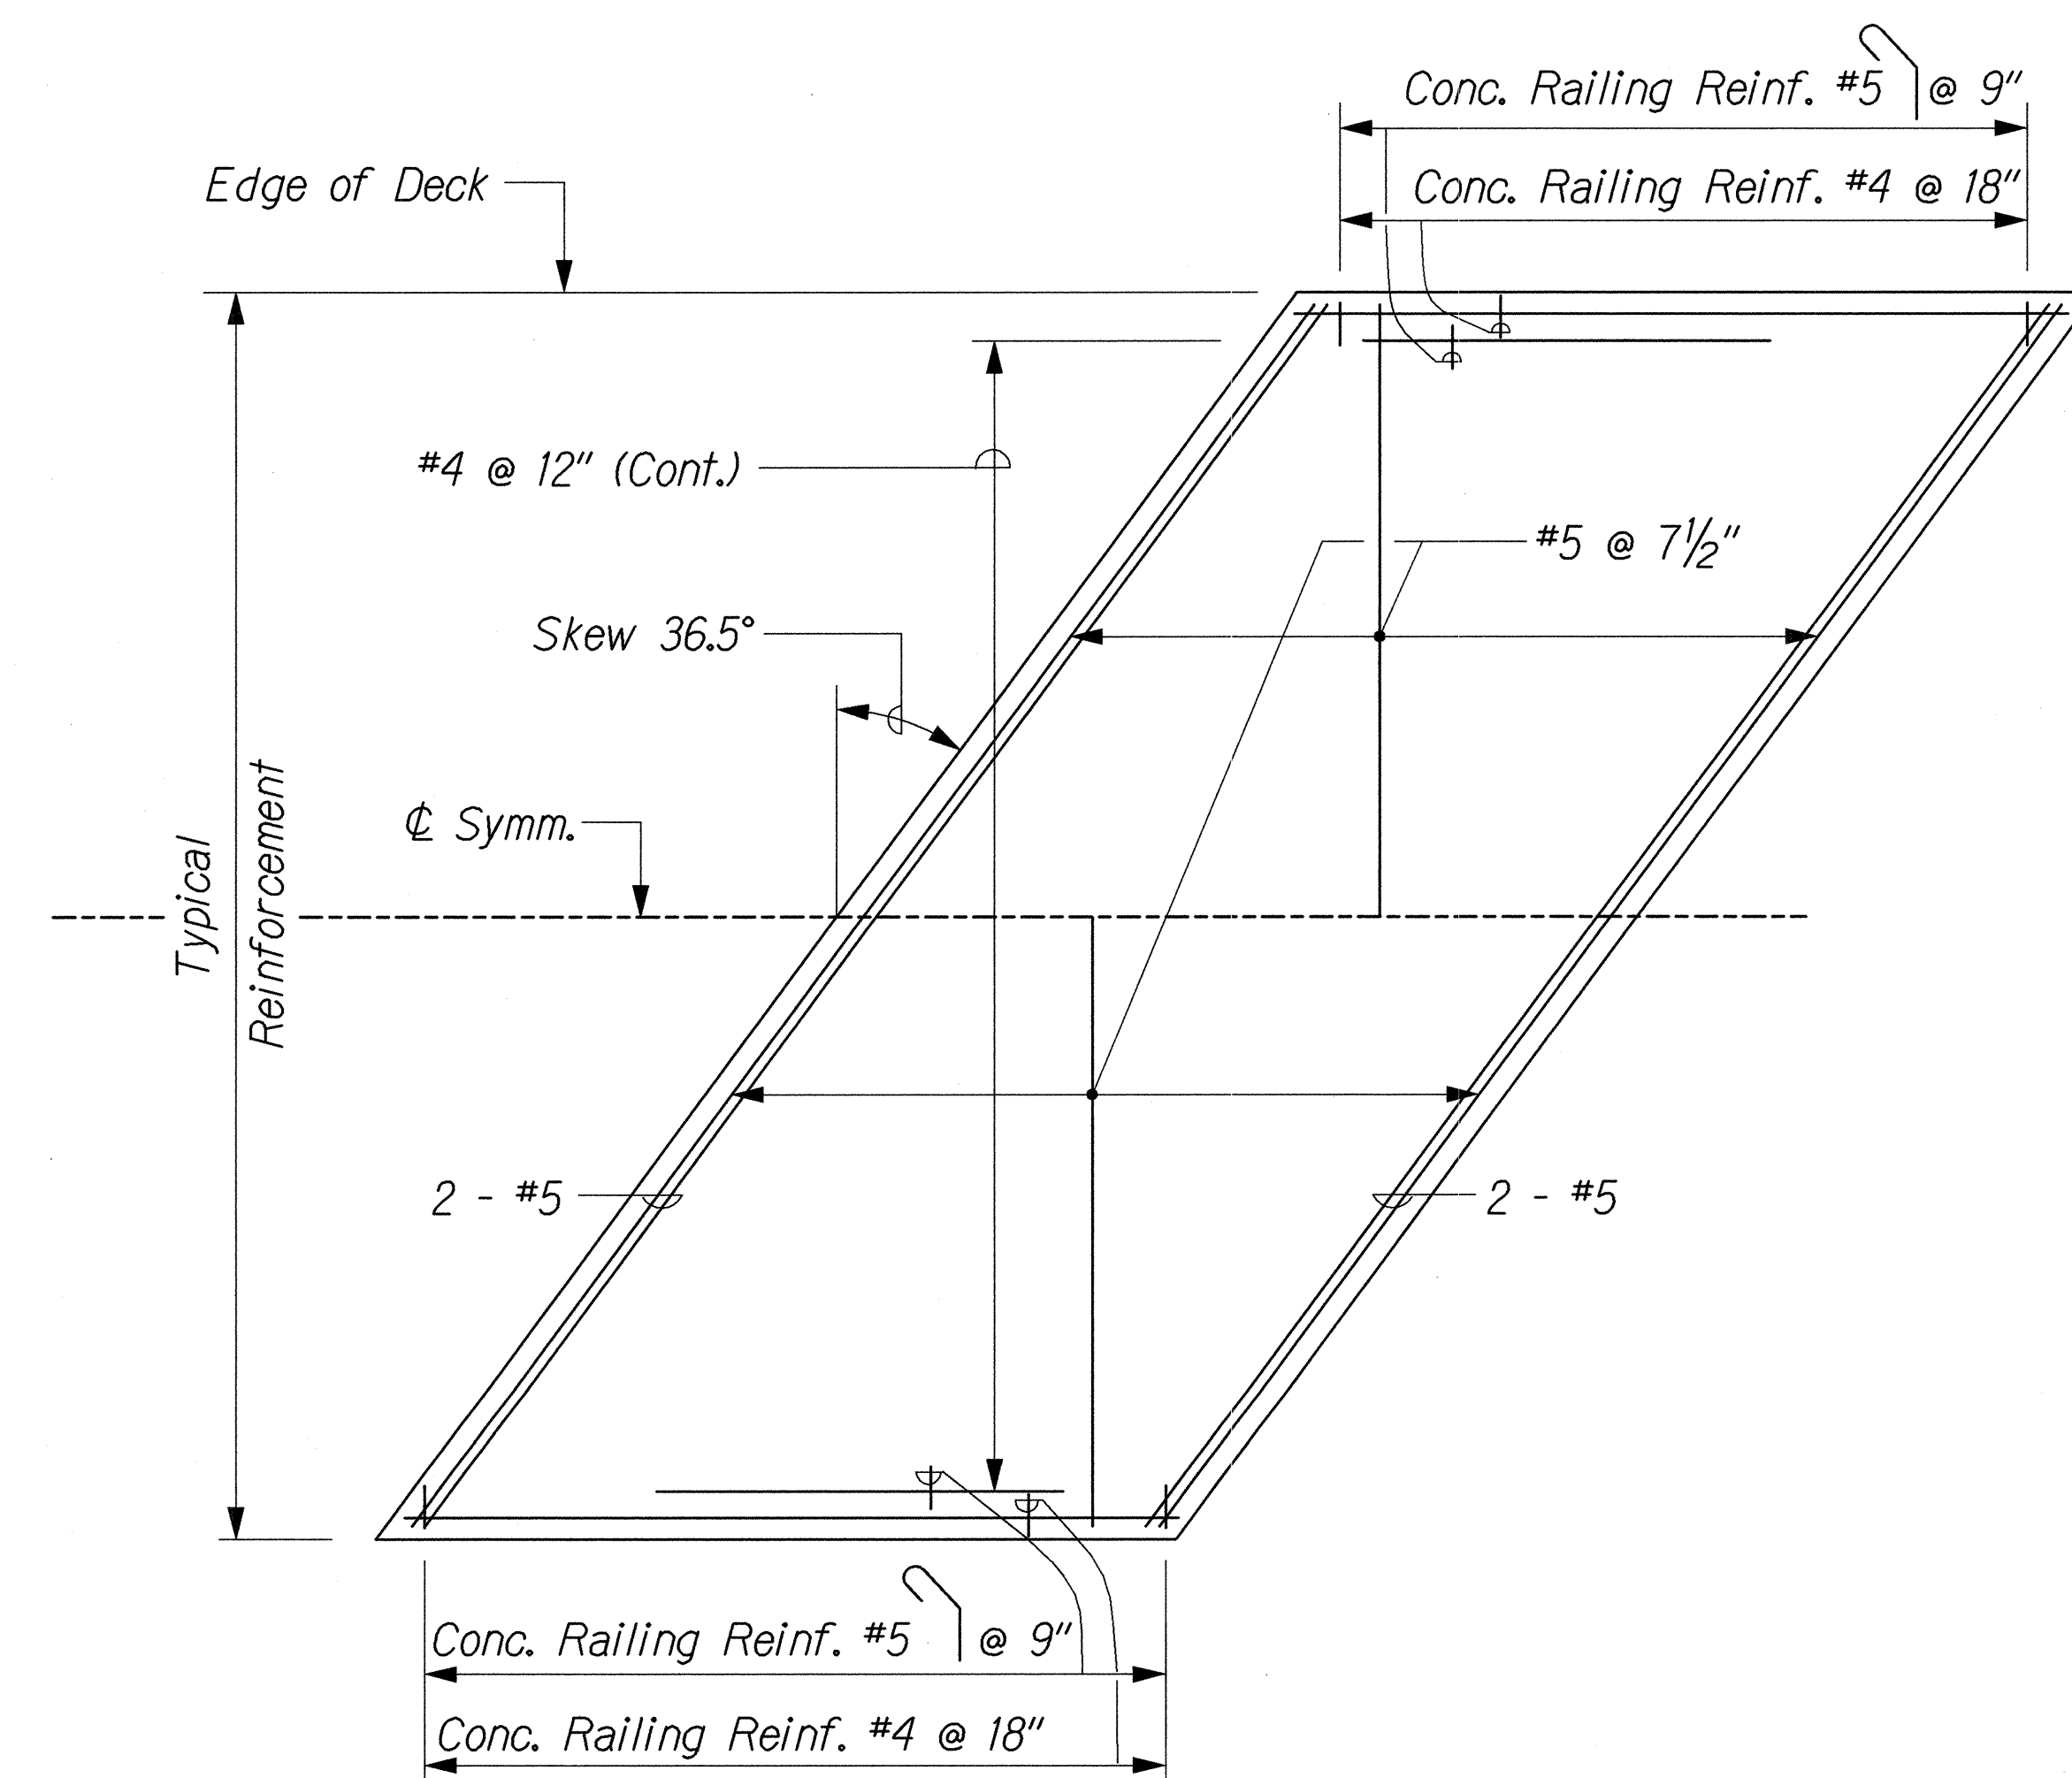

Scale: $\frac{3}{16}'' = 1'-0''$

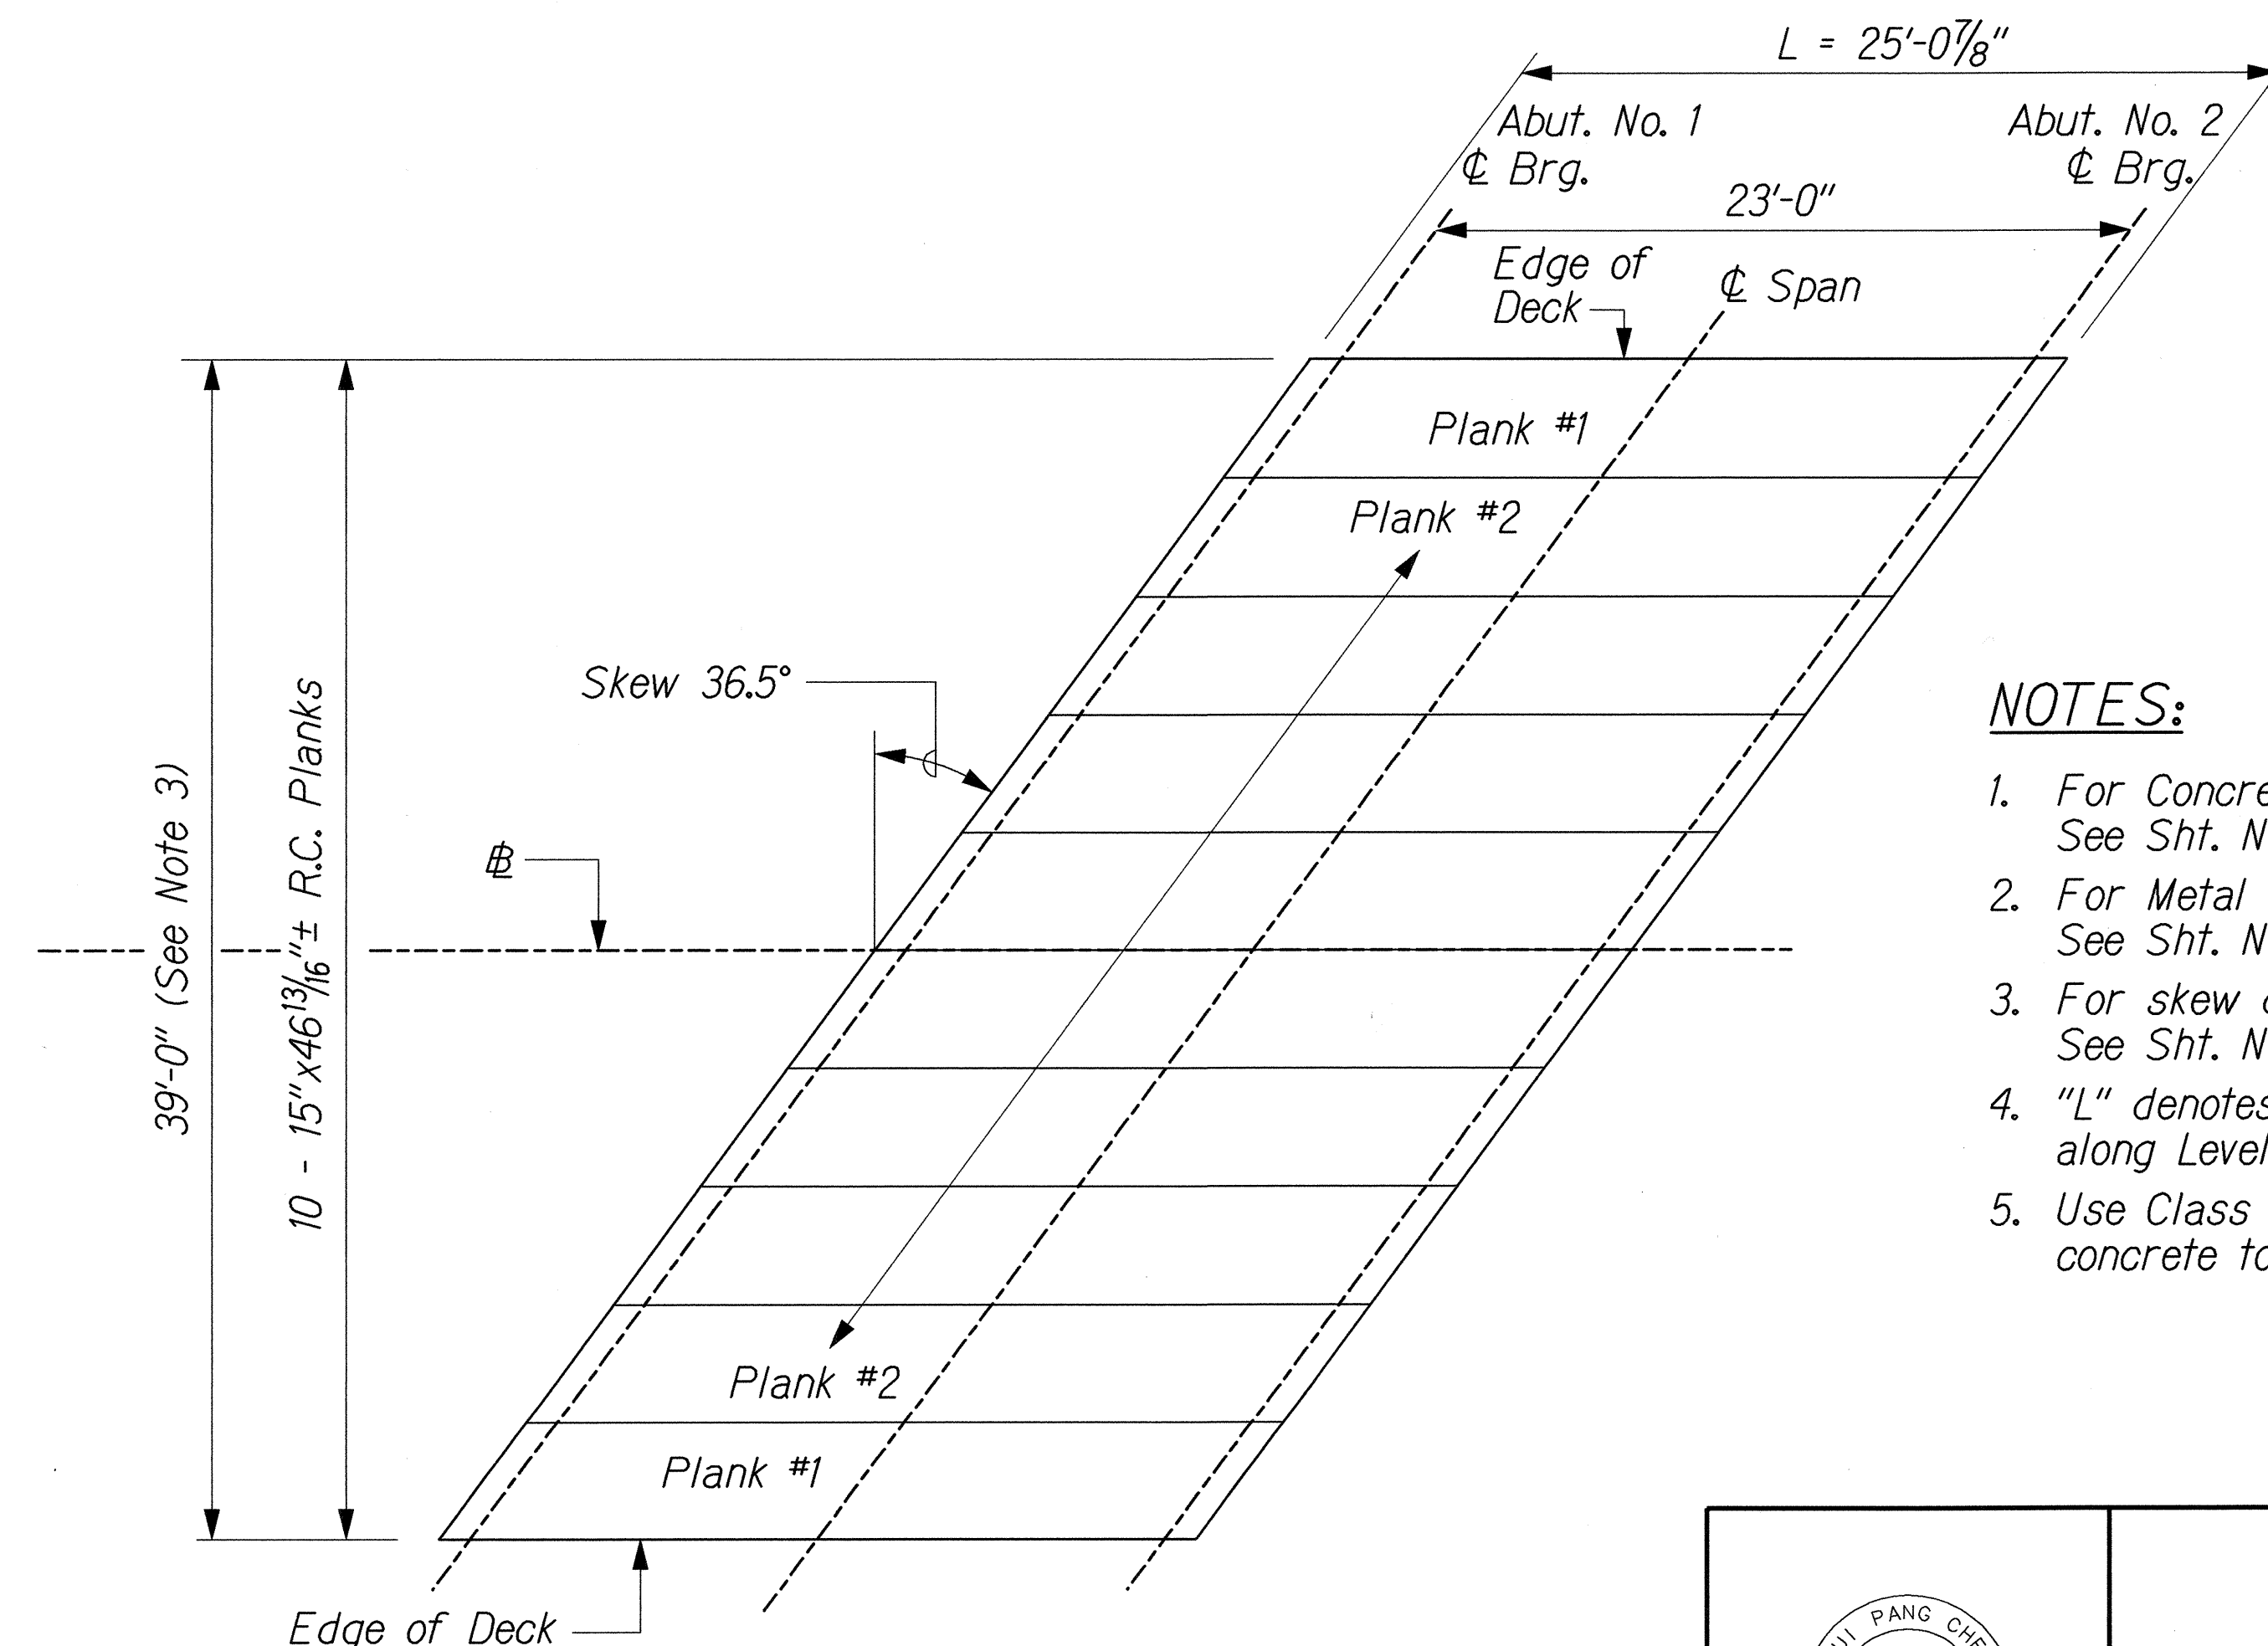


Scale: $\frac{3}{16}'' = 1'-0''$

1. *For Concrete Railing Detail,
See Sht. No. S-32.*
2. *For Metal Bikeway Railing Details,
See Sht. No. S-34.*
3. *For skew dimensions along ∇ Brg.,
See Sht. No. S-22 & S-23.*
4. *"L" denotes the total length of plank
along Level line.*
5. *Use Class BD concrete strength for
concrete topping over planks.*


ORIGINAL PLAN	SURVEY PLOTTED BY _____ DATE _____
NOTE BOOK	DRAWN BY _____
	TRACED BY _____
	DESIGNED BY _____
	QUANTITIES BY _____
No. _____	CHECKED BY _____

J:/KUIHELANI/STRUCT/ST-DET18.dgn

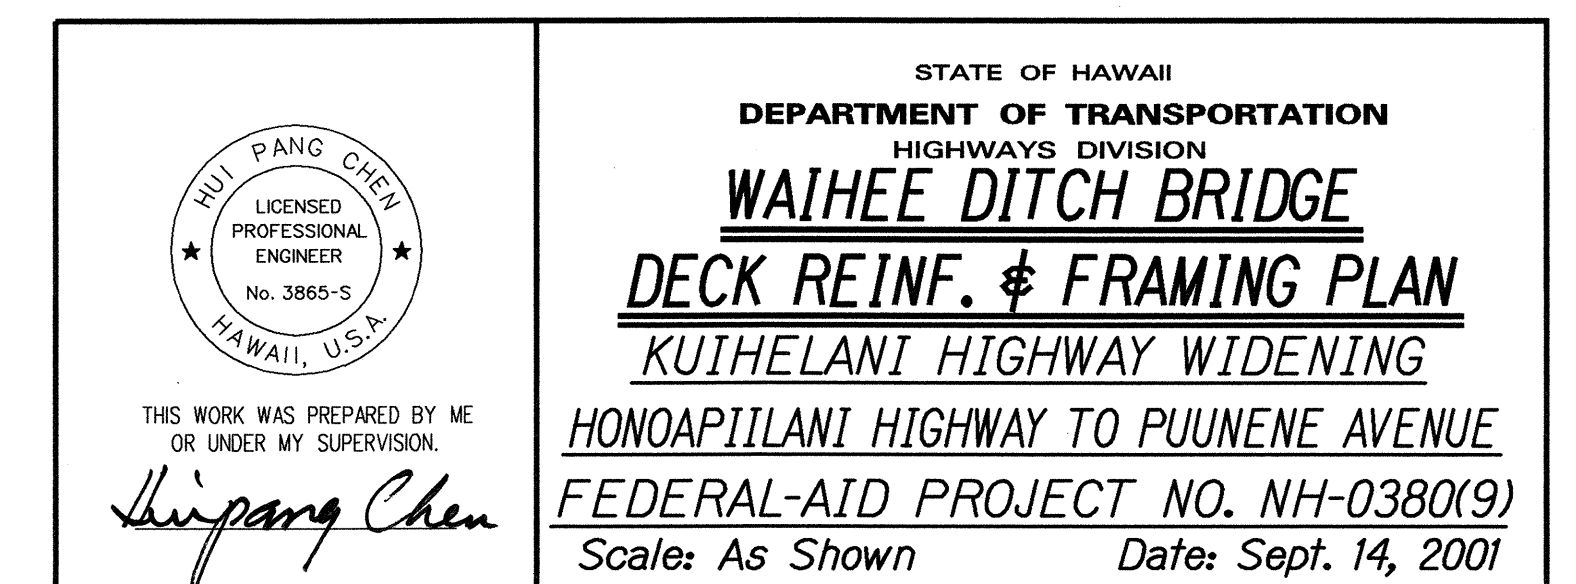

FED. ROAD DIST. NO.	STATE	FED. AID PROJ. NO.	FISCAL YEAR	SHEET NO.	TOTAL SHEETS
HAWAII	HAW.	NH-0380(9)	2000	189	380

ESTIMATED QUANTITIES				
ITEM NO.	ITEM	UNIT	QUANTITIES	
206.	Structure Excavation for Wingwalls & CRM Walls	CY	287	
206.	Structure Backfill for Wingwalls & CRM Walls	CY	231	
646.	Geocomposite Drain for Wingwalls & CRM Walls	SY	34	
503.	Concrete In Wingwalls (Except Footing)	LS	(26 CY)	
503.	Concrete In Wingwall Footings	LS	(39 CY)	
503.	Conspan Arched Culvert (Including Footing & Headwall)	LS	1	
507.	Concrete Railing (Include End Post)	LF	208	
507.	Metal Bikeway Railing	LF	194	
507.	Upgrade of Existing Concrete Railing	LF	152	
508.	Cement Rubble Masonry	LS	(44 CY)	
602.	Reinforcing Steel for Wingwalls	LS	(6,330 Lbs)	

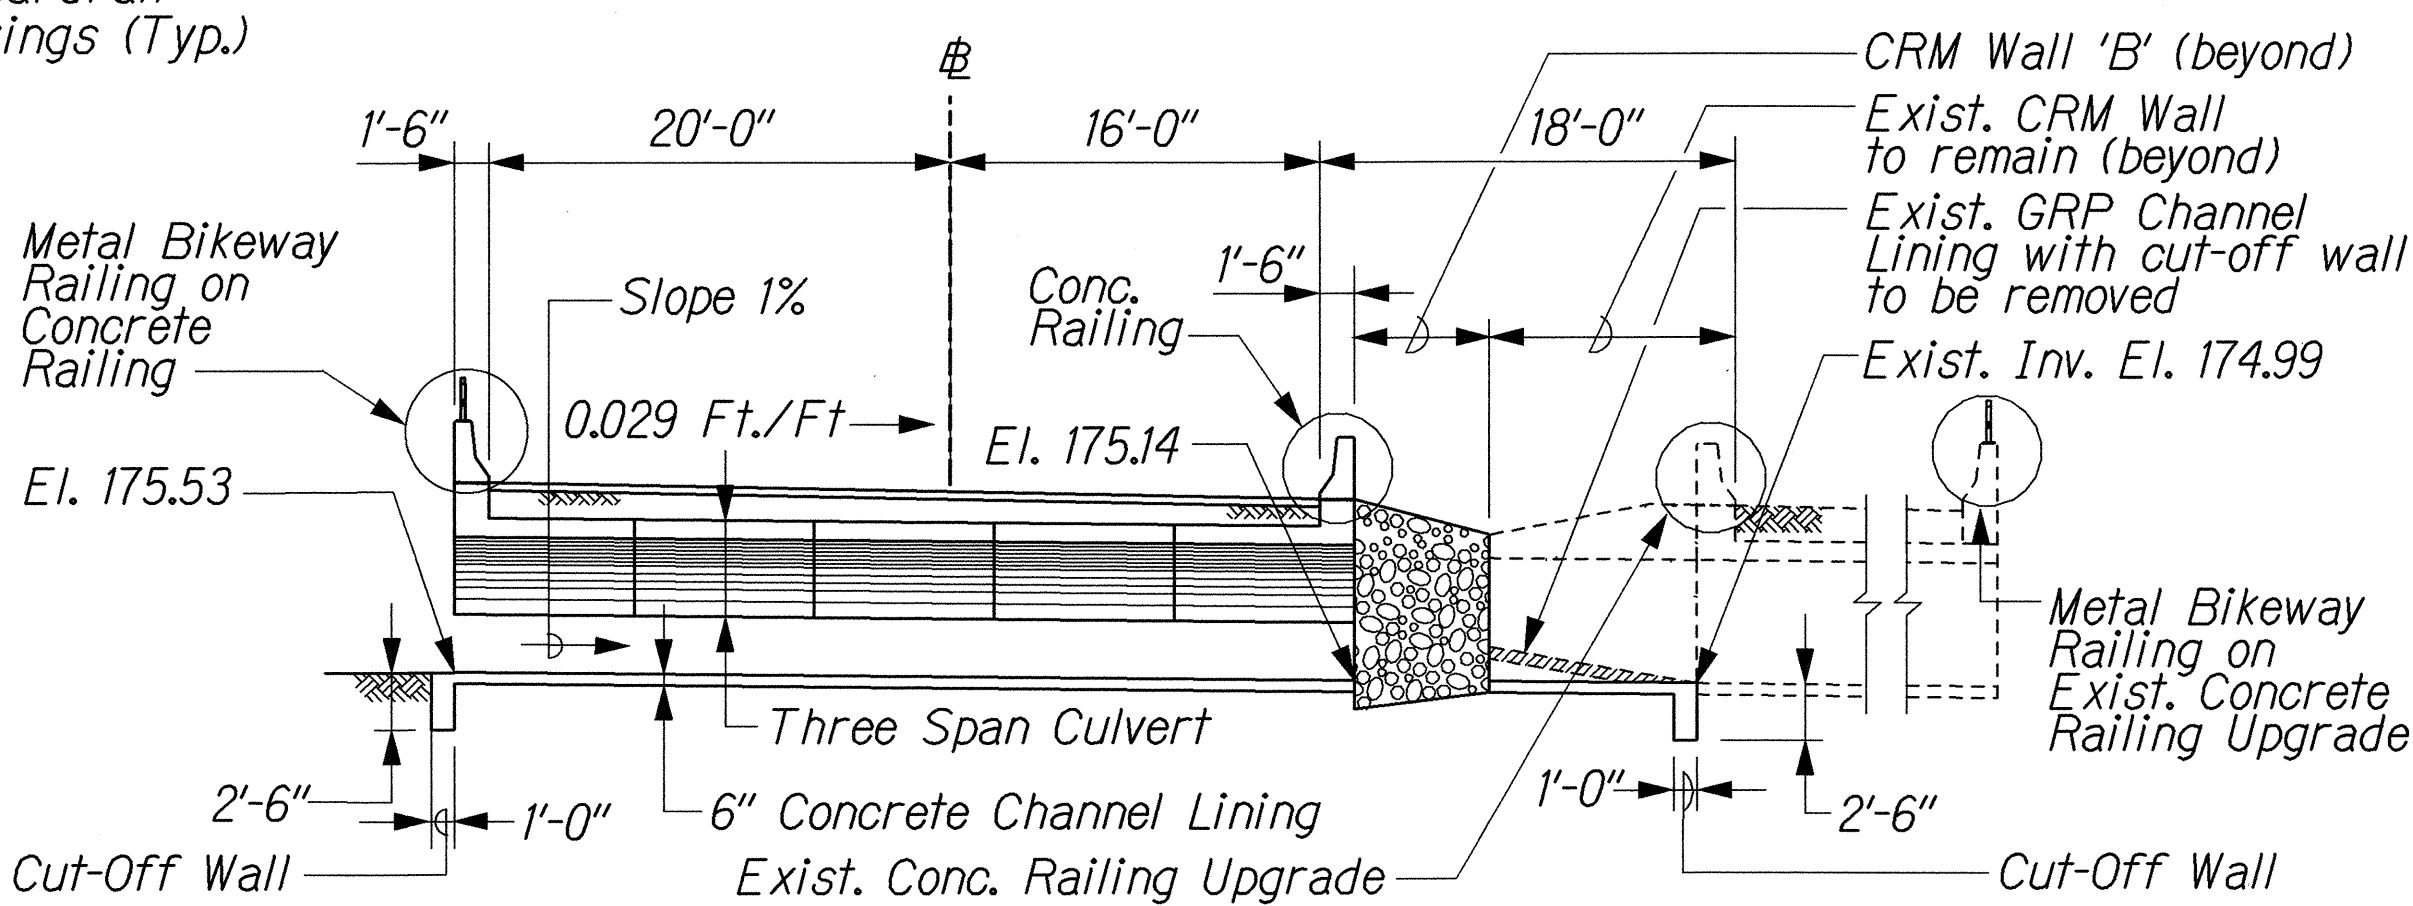

SECTION ALONG ϕ STREAM

Scale: $\frac{1}{8}$ " = 1'-0" (Looking upstation)

NOTES:


- For General Notes, See Sheet No. S-2.
- For Payment Limit for Three Span Culvert, See Sheet No. S-28.
- For Grading Plan, See Civil Drawings.
- For Existing Concrete Railing Upgrade Details See Sht. S-33.
- For Bridge Name & Date Location, Concrete Railing details, See Sht. S-32.
- Existing GRP channel lining shall be removed for replacement of concrete channel lining. The removal of the existing GRP channel lining shall be incidental to structure excavation.
- For Payment Limit for Wingwall, See Sht. S-29.
- For Three Span Culvert, headwall, and footing, See Note 1 on Sht. No. S-28.
- For Curve Data for Curve (K-4), See alignment drawing on Sht. No. A11.
- In order to prevent undermining the Three Span Culvert Footings, the Contractor shall install wingwall footings prior to excavate the Three Span Culvert Footings.
- For Details of CRM Walls A & B, See Sheet No. S-37.

THIS WORK WAS PREPARED BY ME OR UNDER MY SUPERVISION.

Rui Pang Chen


STATE OF HAWAII
DEPARTMENT OF TRANSPORTATION
HIGHWAYS DIVISION

KUIHELANI THREE SPAN CULVERT
PLAN, ELEVATION & SECTION
KUIHELANI HIGHWAY WIDENING
HONOAPIILANI HIGHWAY TO PUUNENE AVENUE
FEDERAL-AID PROJECT NO. NH-0380(9)
Scale: 1"=10' Date: Sept. 14, 2001

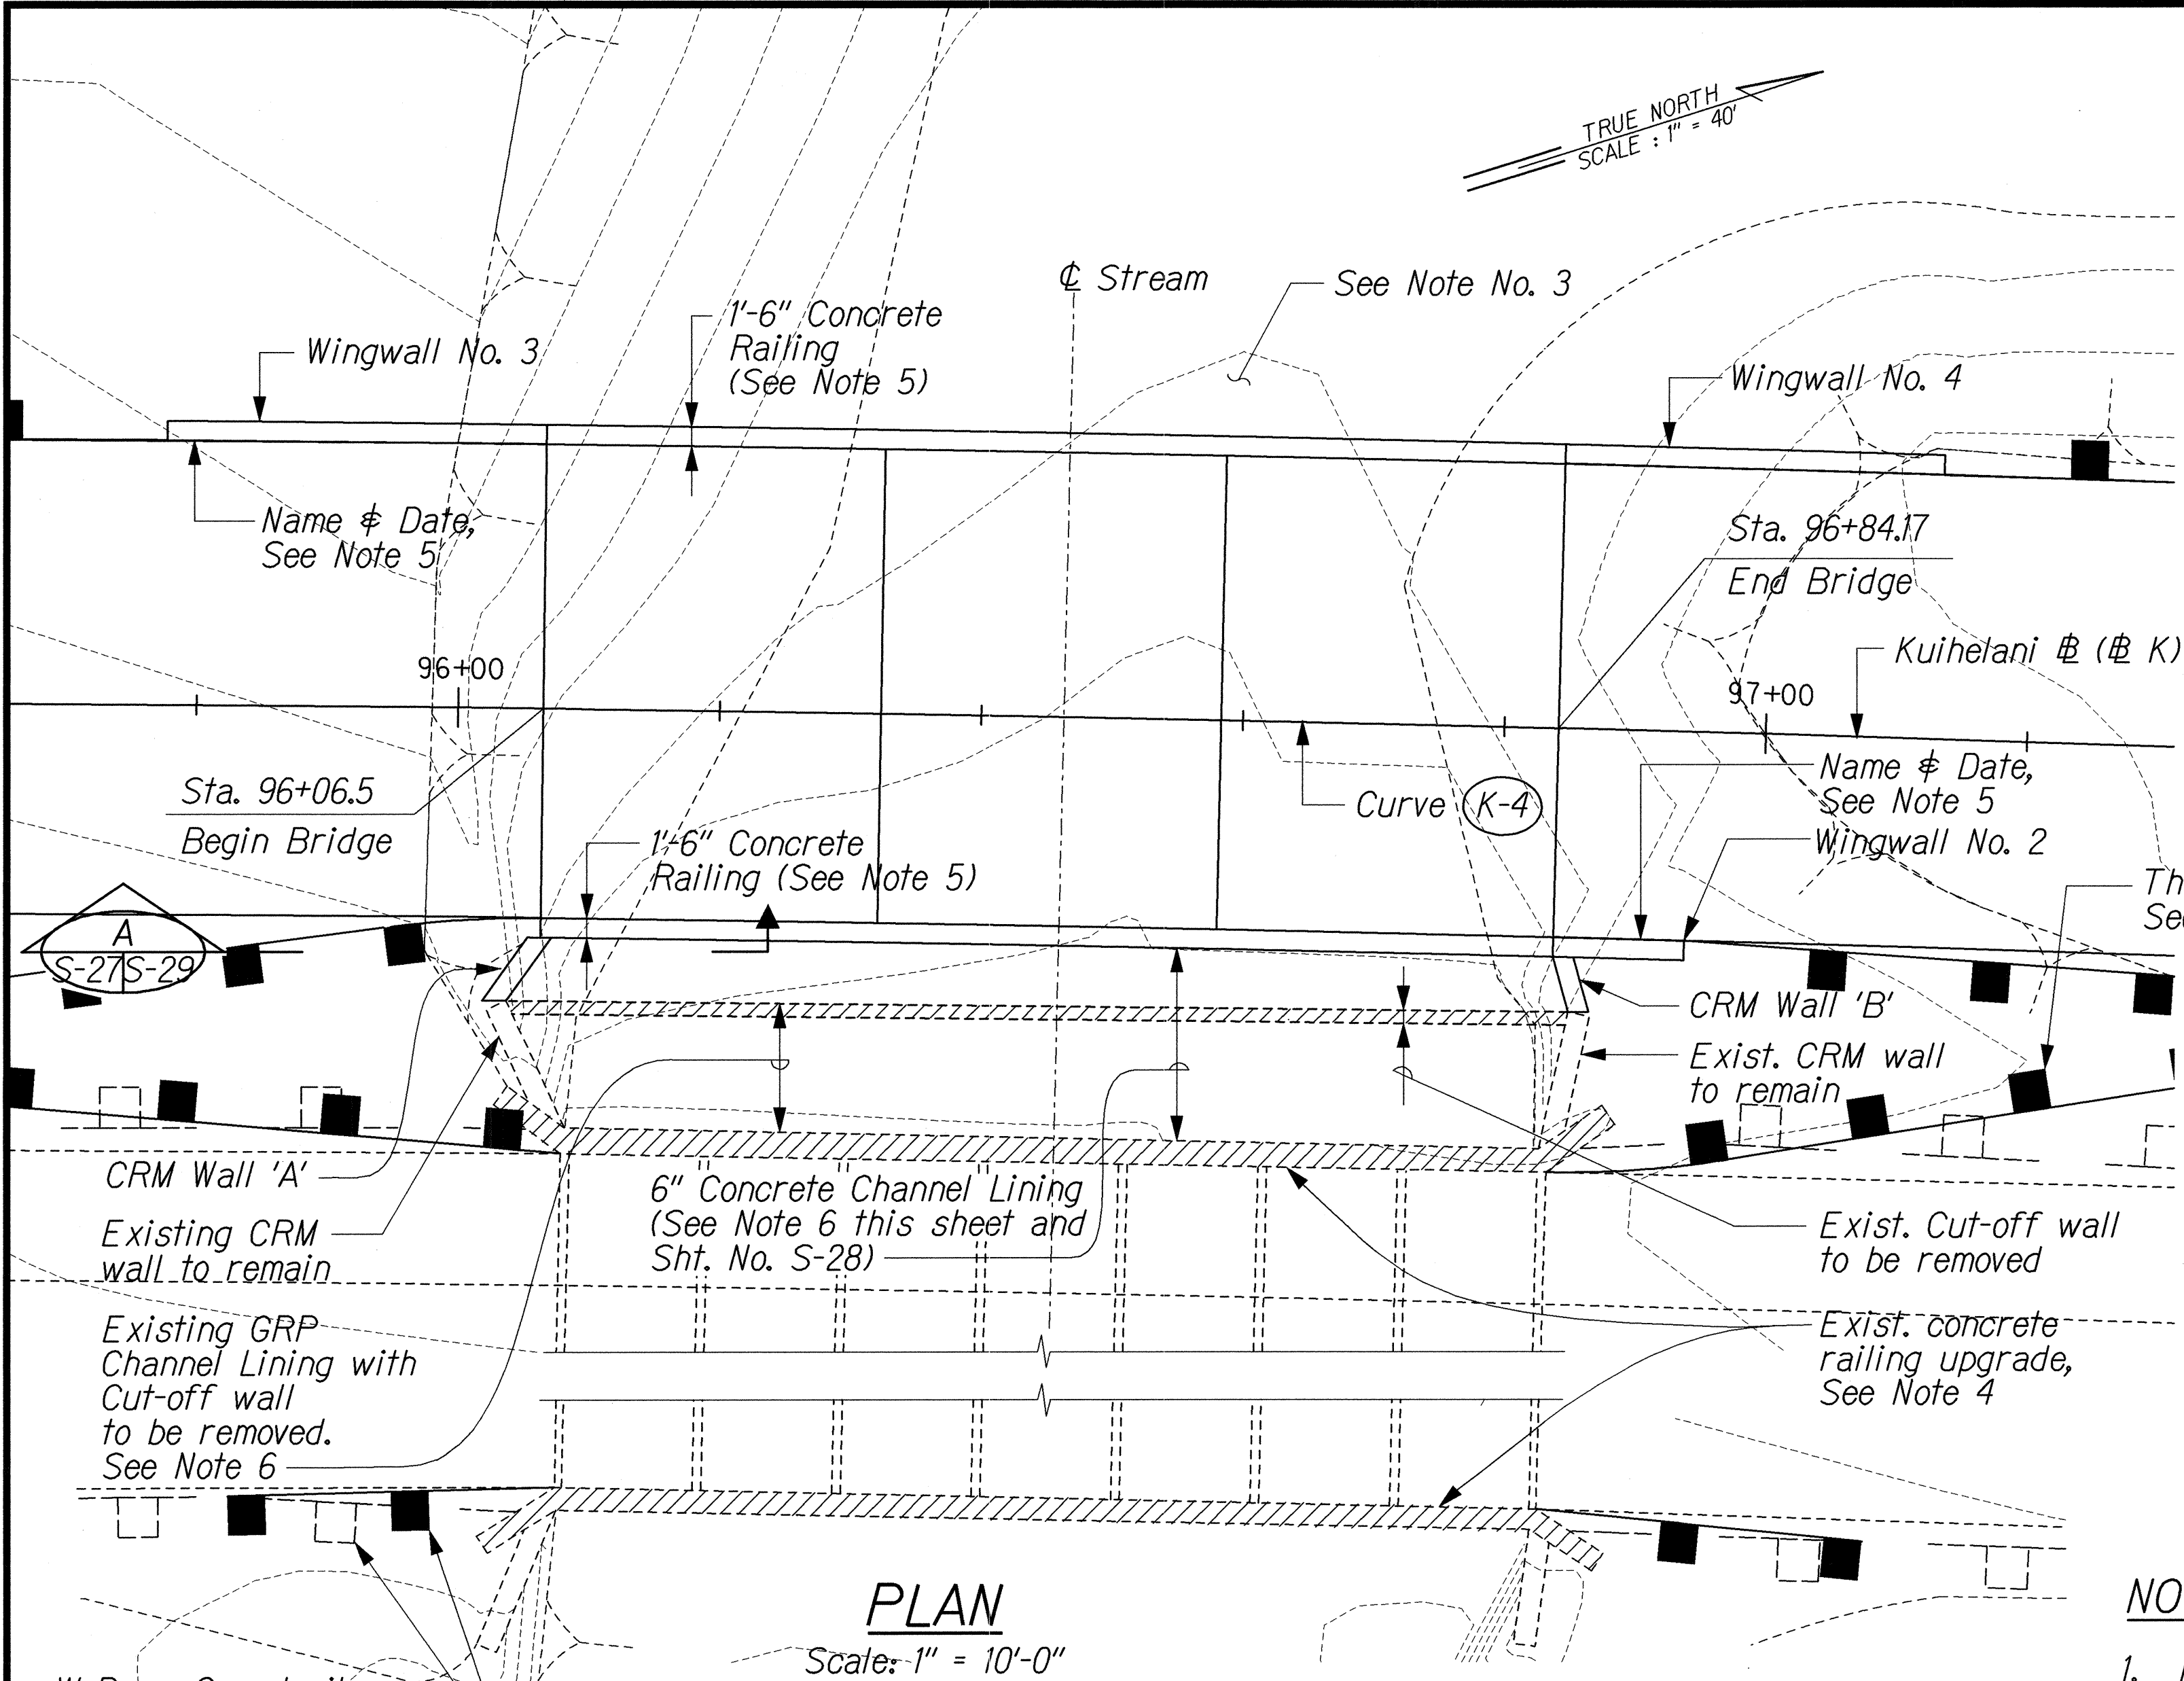

PLAN

Scale: 1" = 10'-0"

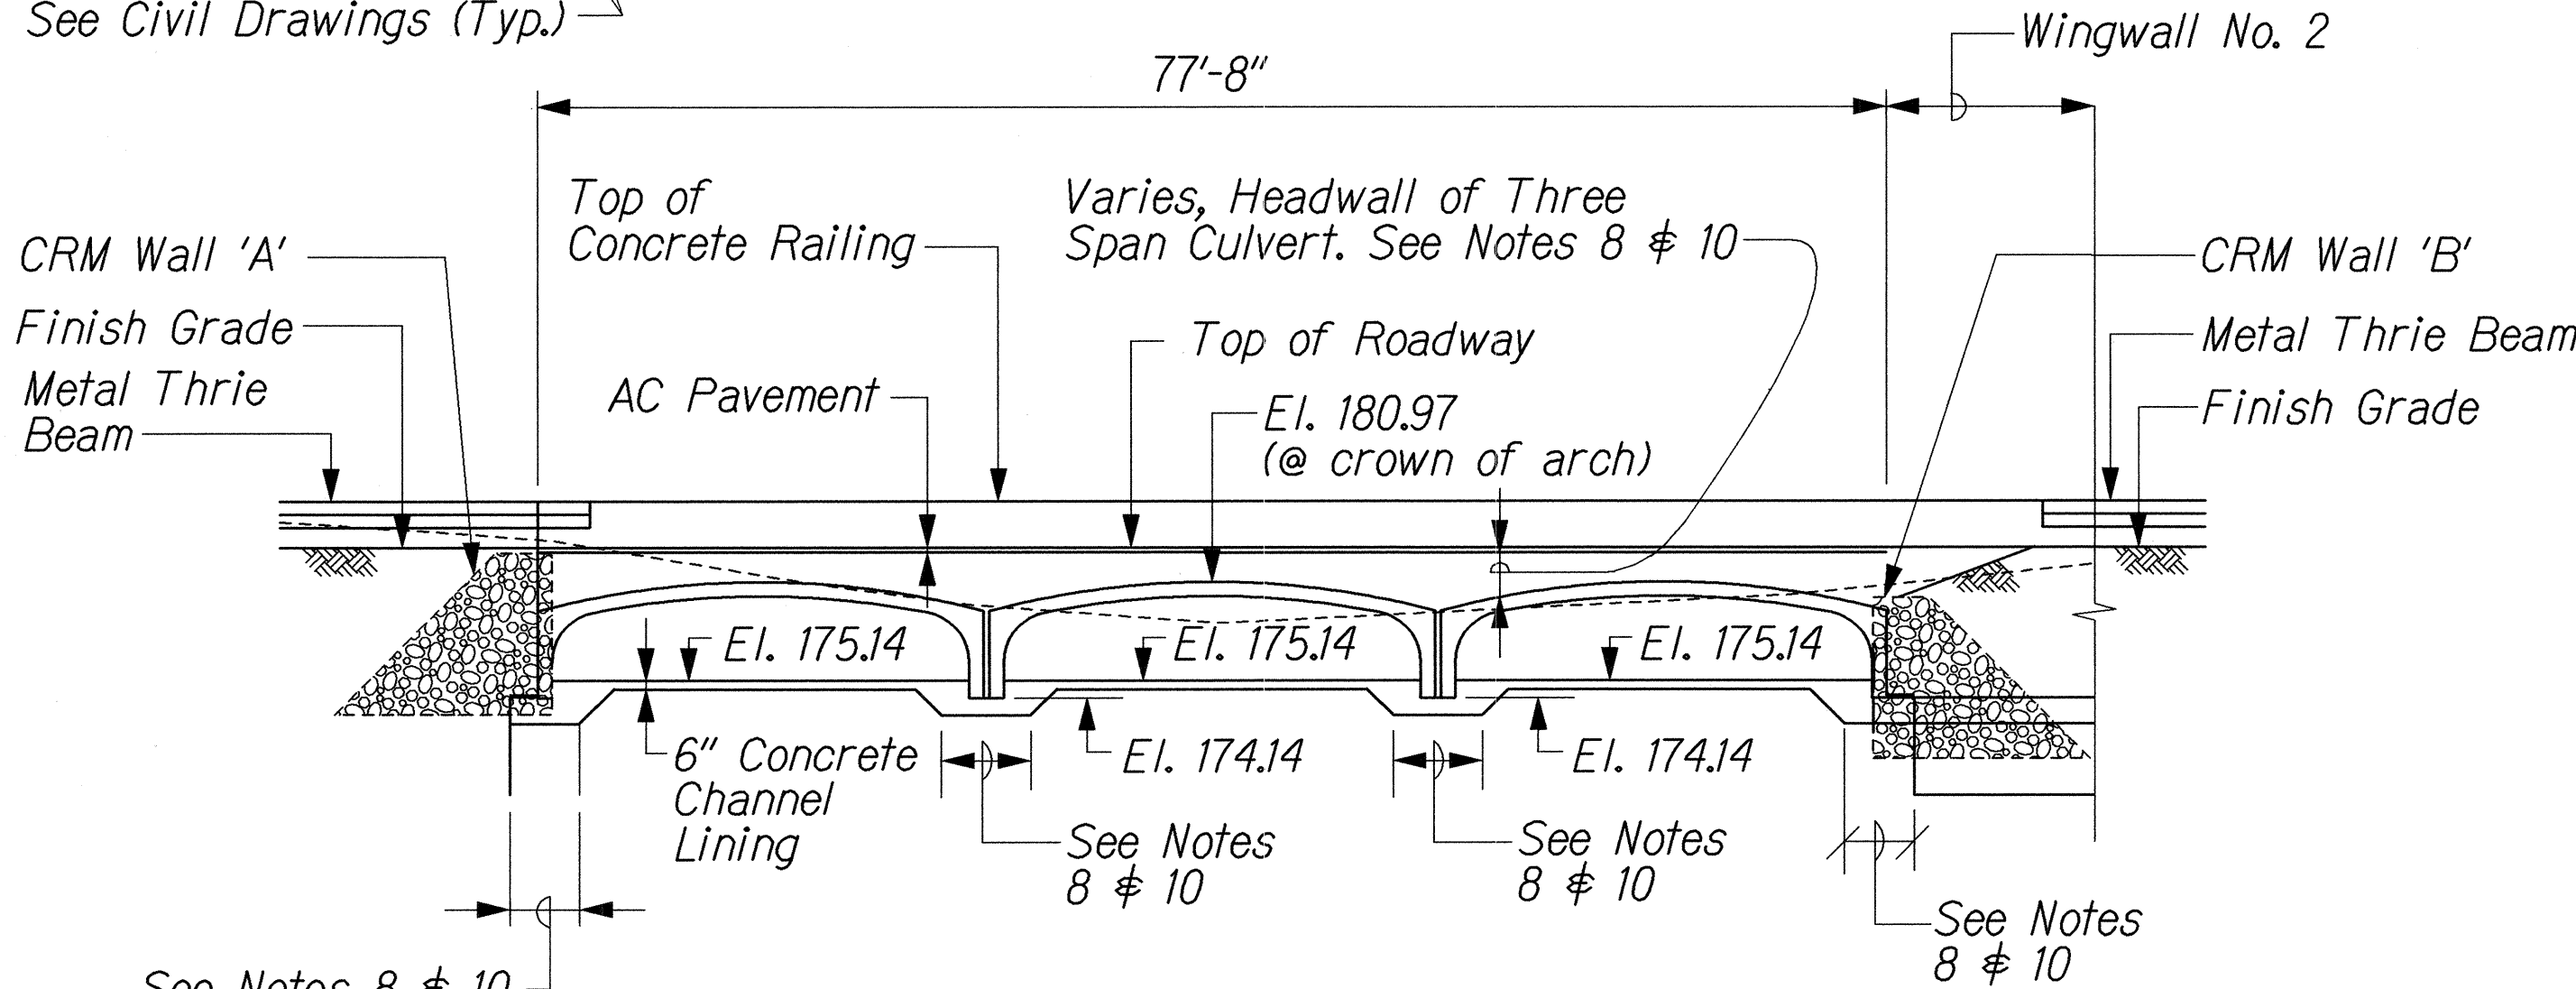




ELEVATION

Scale: 1" = 10'-0"

SURVEY PLOTTED BY	DATE
DRAWN BY	
DESIGNED BY	
CHECKED BY	
ORIGINAL PLAN	
NOTE BOOK	

J:\KUIHELANI\STRUCT\BR-02.dgn

FED. ROAD DIST. NO.	STATE	FED. AID PROJ. NO.	FISCAL YEAR	SHEET NO.	TOTAL SHEETS
HAWAII	HAW.	NH-0380(9)	2000	190	380

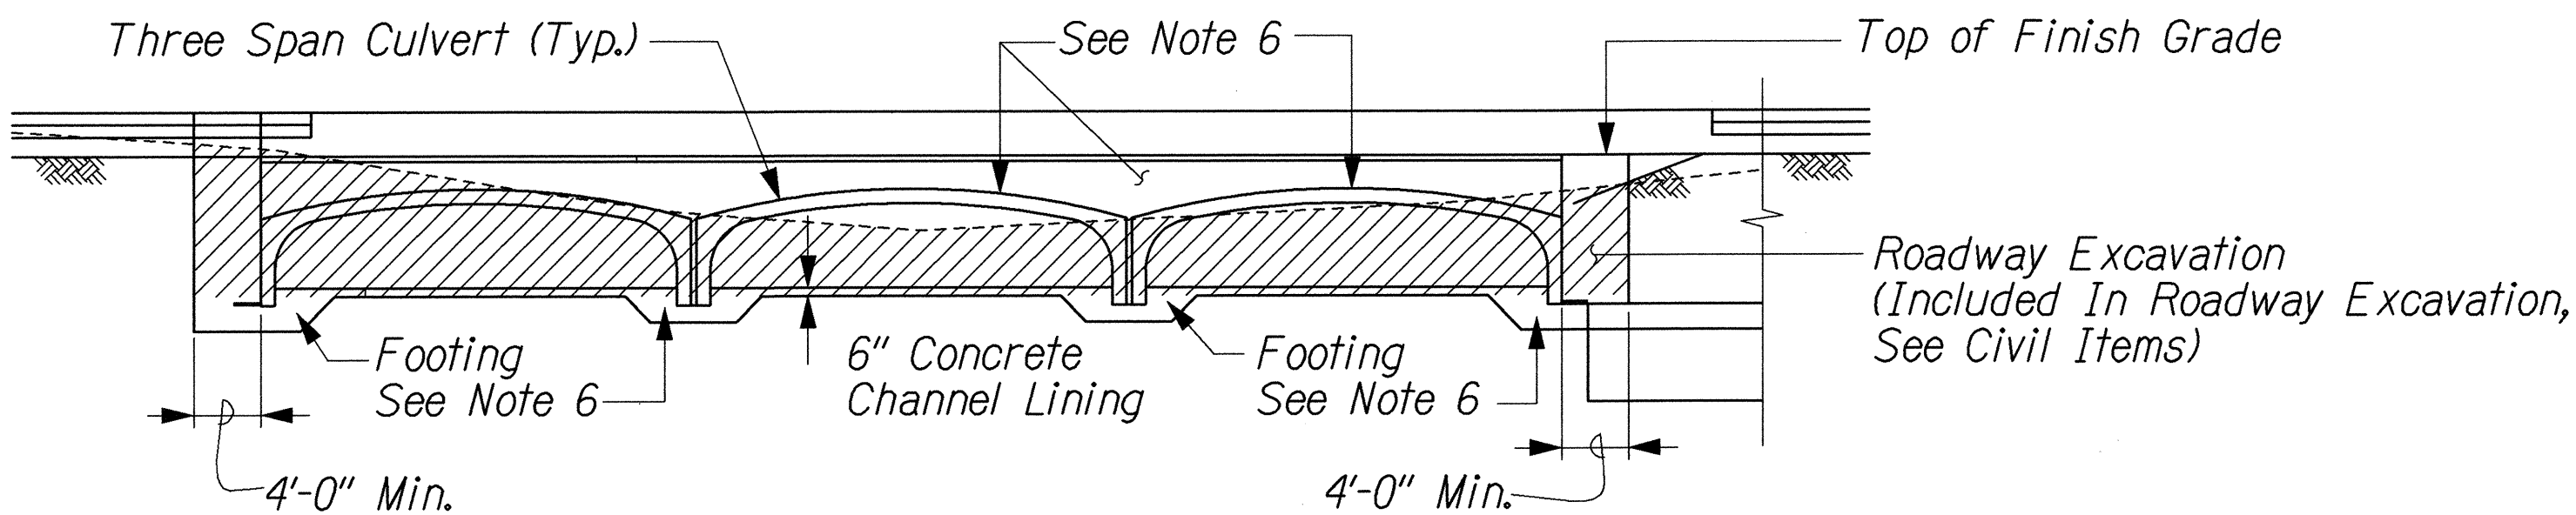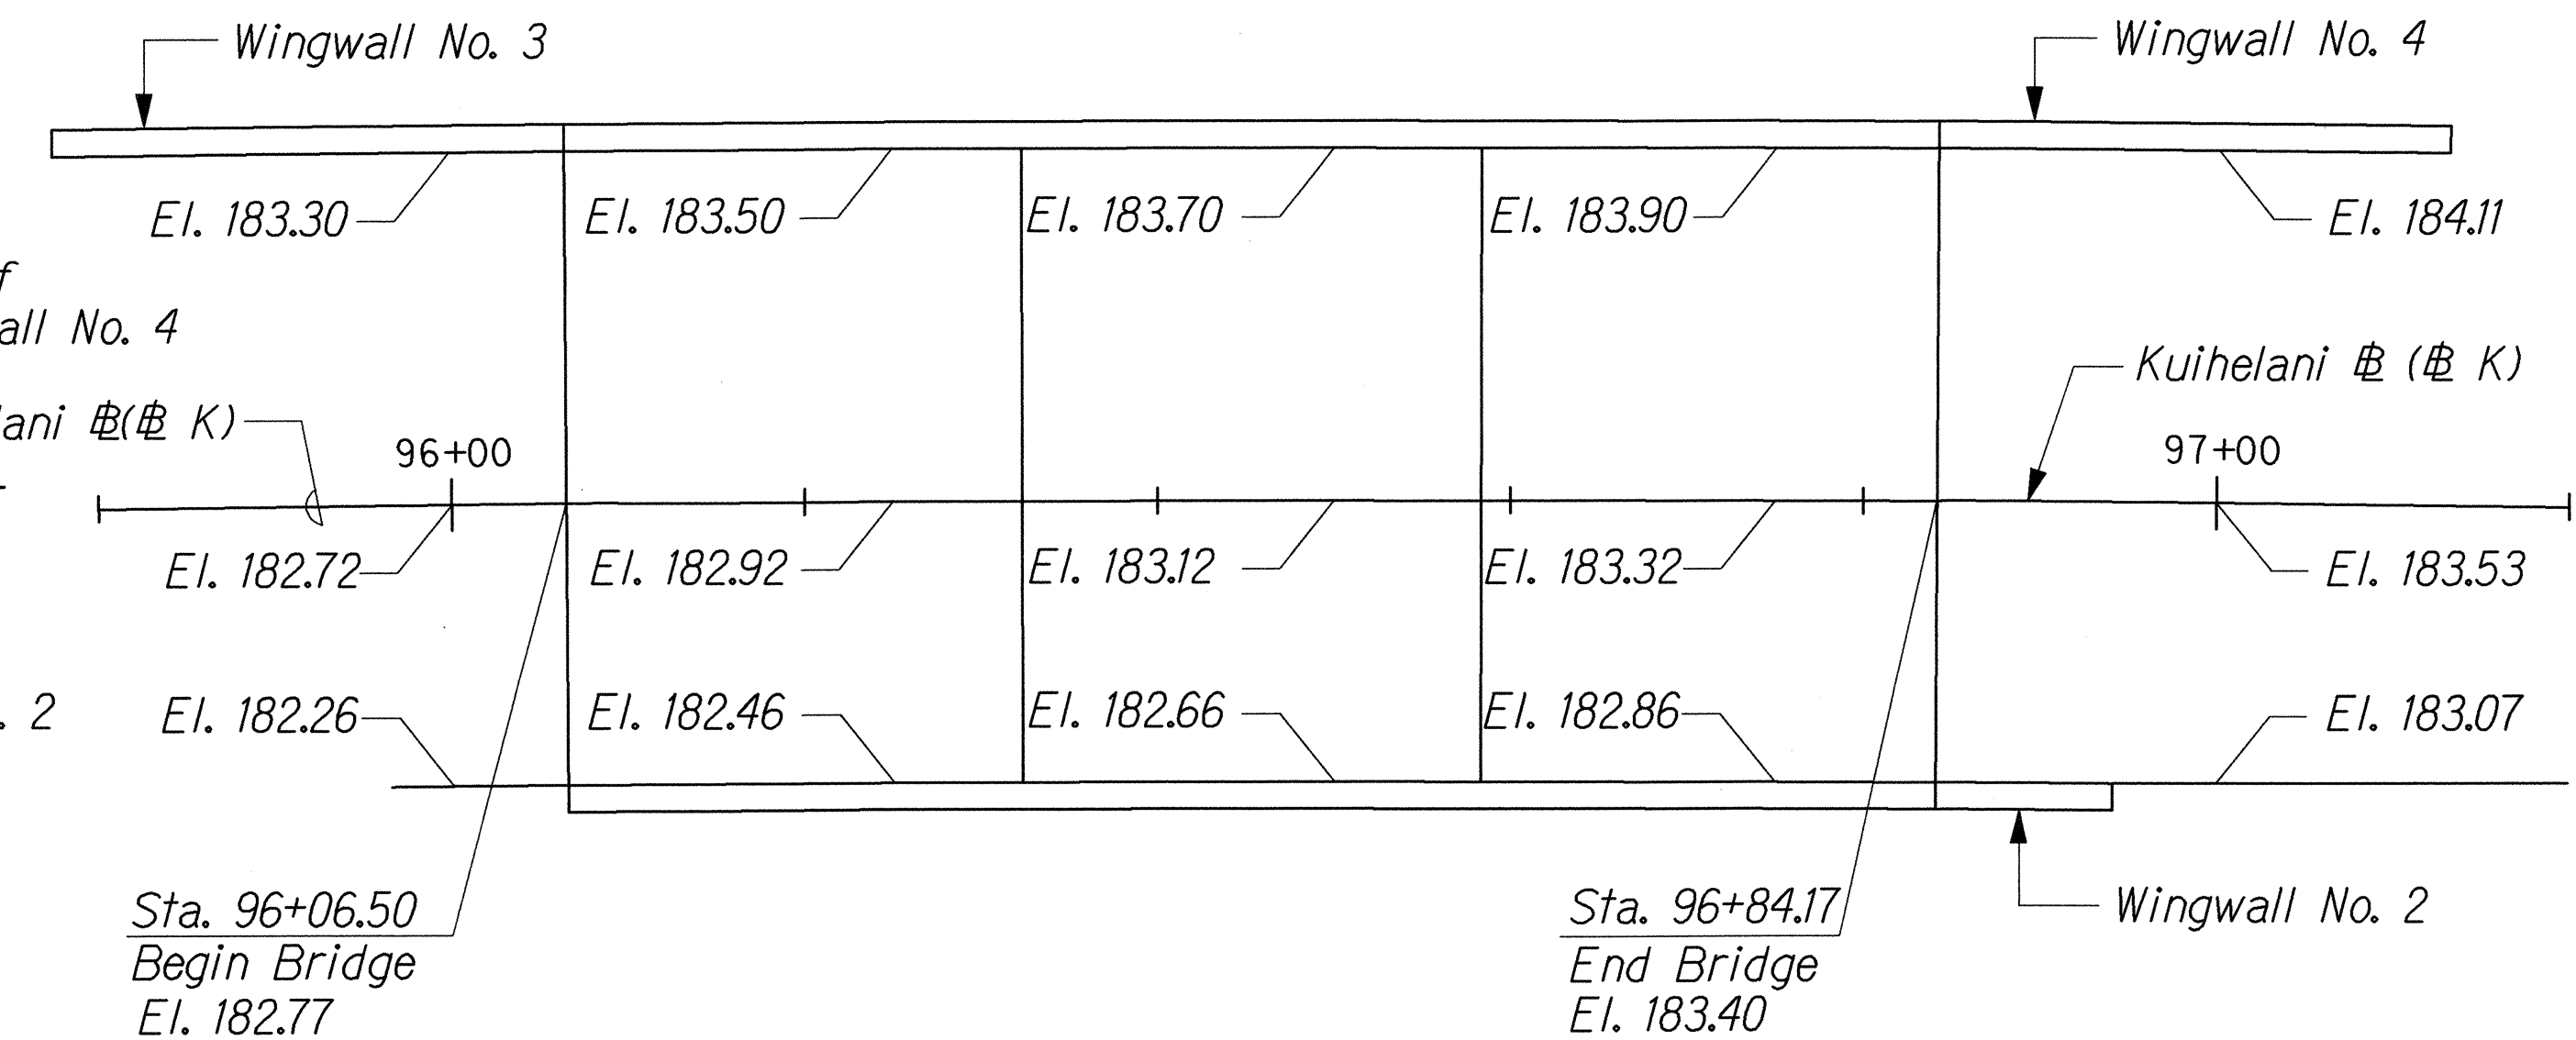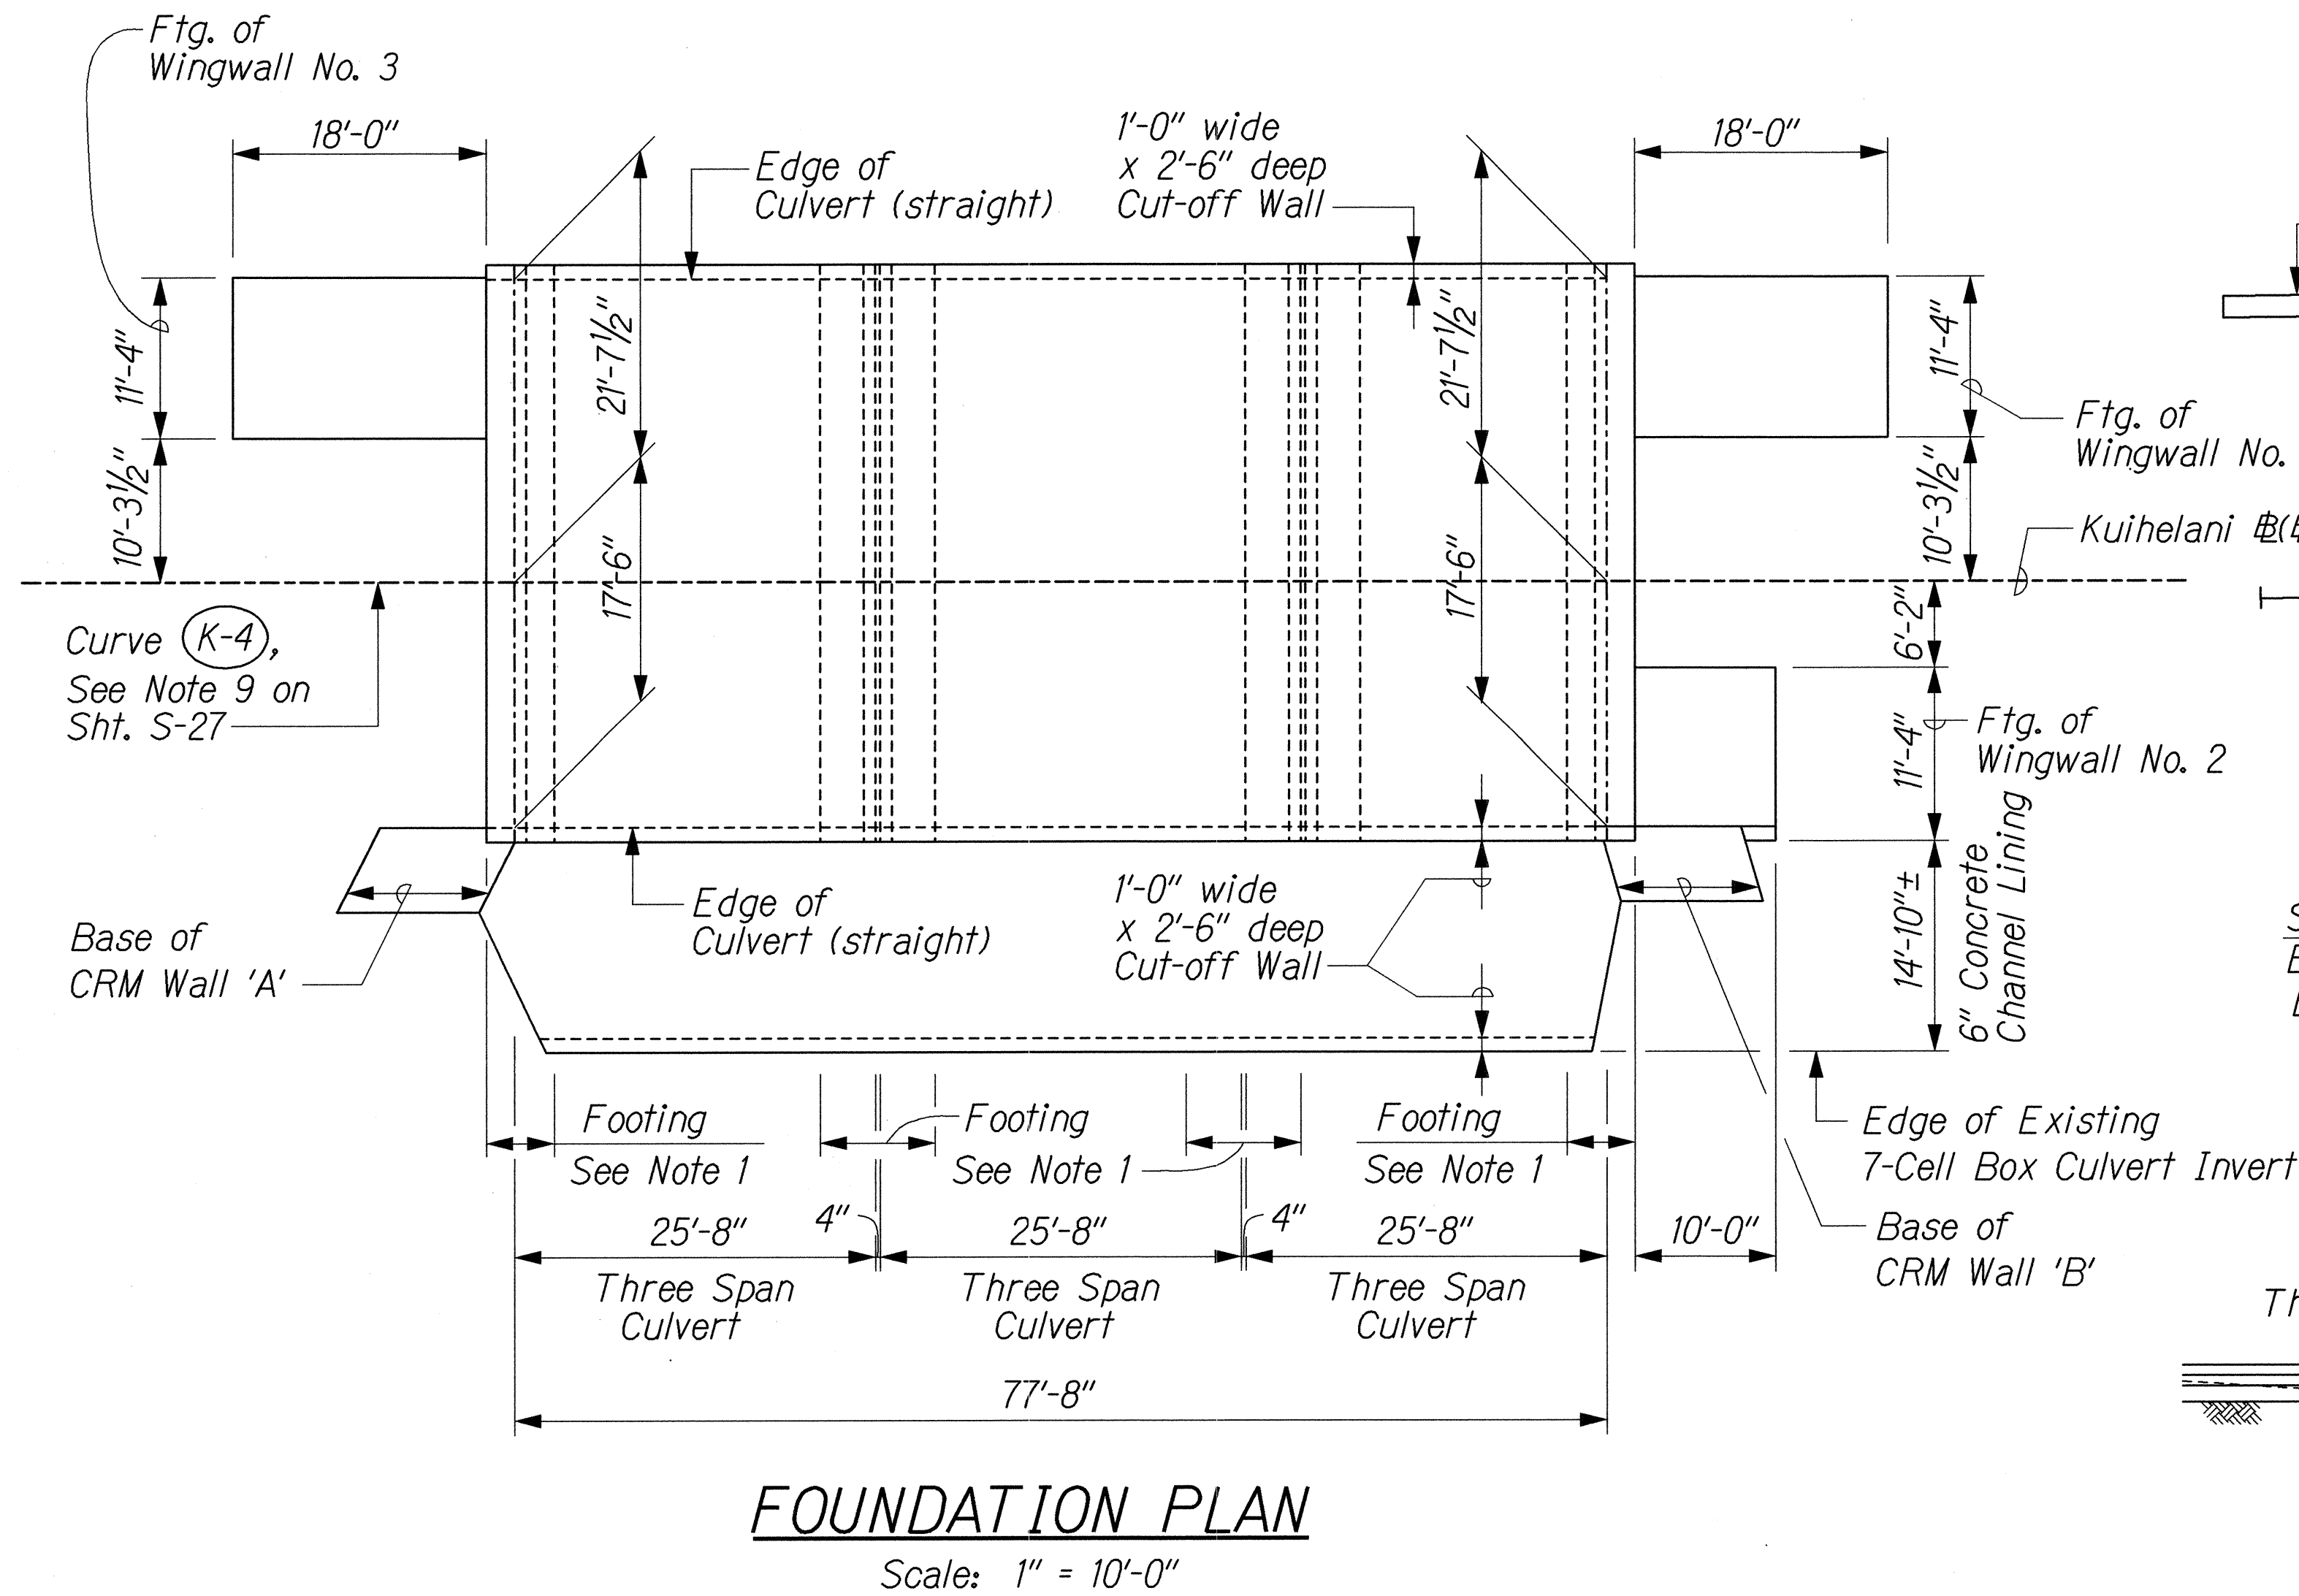

- NOTE:**
- The Three Span Culvert and footing shall be sized according to Conspan manufacturer's recommendation based on the design criteria shown on Notes 2 thru 6 below.
 - For General Specifications, Design Specifications and Loads, See General Notes 1, 2 & 3 on Sht. No. S-2.
 - Footing Design parameters shall conform to General Note 9 (C) shown on Sht. No. S-2.
 - Design head walls to support the concrete railing resisting the dynamic Load conforming to TL-4 test level specified in General Note 3 (D) on Sht. No. S-2.
 - For reinforcing details, See Note 5 on Sht. No. S-2.
 - The payment for "Three Span Culvert" shall include Three Span Culvert units, headwalls, footings, structure excavations for footings, compacted fill material around the culvert units, structural backfill from compacted material to finish grade, No. 2 aggregate fill between units, filter fabric over joints, 6" concrete Channel Lining and incidental necessary to complete in place.
 - For installation of Three Span Culvert Footings, See Note 10 on Sht. No. S-27.

ORIGINAL PLAN	SURVEY PLOTTED BY	DATE
NOTE BOOK	DRAWN BY	
	DESIGNED BY	
	CHECKED BY	

J:\KUIHELANI\STRUCT\ST-DET5.dgn

THIS WORK WAS PREPARED BY ME OR UNDER MY SUPERVISION.


Hui Pang Chen

STATE OF HAWAII
DEPARTMENT OF TRANSPORTATION
HIGHWAYS DIVISION

**KUIHELANI THREE SPAN CULVERT
FOUNDATION PLAN & SPOT ELEV.**

KUIHELANI HIGHWAY WIDENING
HONOAPIILANI HIGHWAY TO PUUNENE AVENUE
FEDERAL-AID PROJECT NO. NH-0380(9)
Scale: As Shown Date: Sept. 14, 2001


FED. ROAD DIST. NO.	STATE	FED. AID PROJ. NO.	FISCAL YEAR	SHEET NO.	TOTAL SHEETS
HAWAII	HAW.	NH-0380(9)	2000	C.O. 190 S-1	380

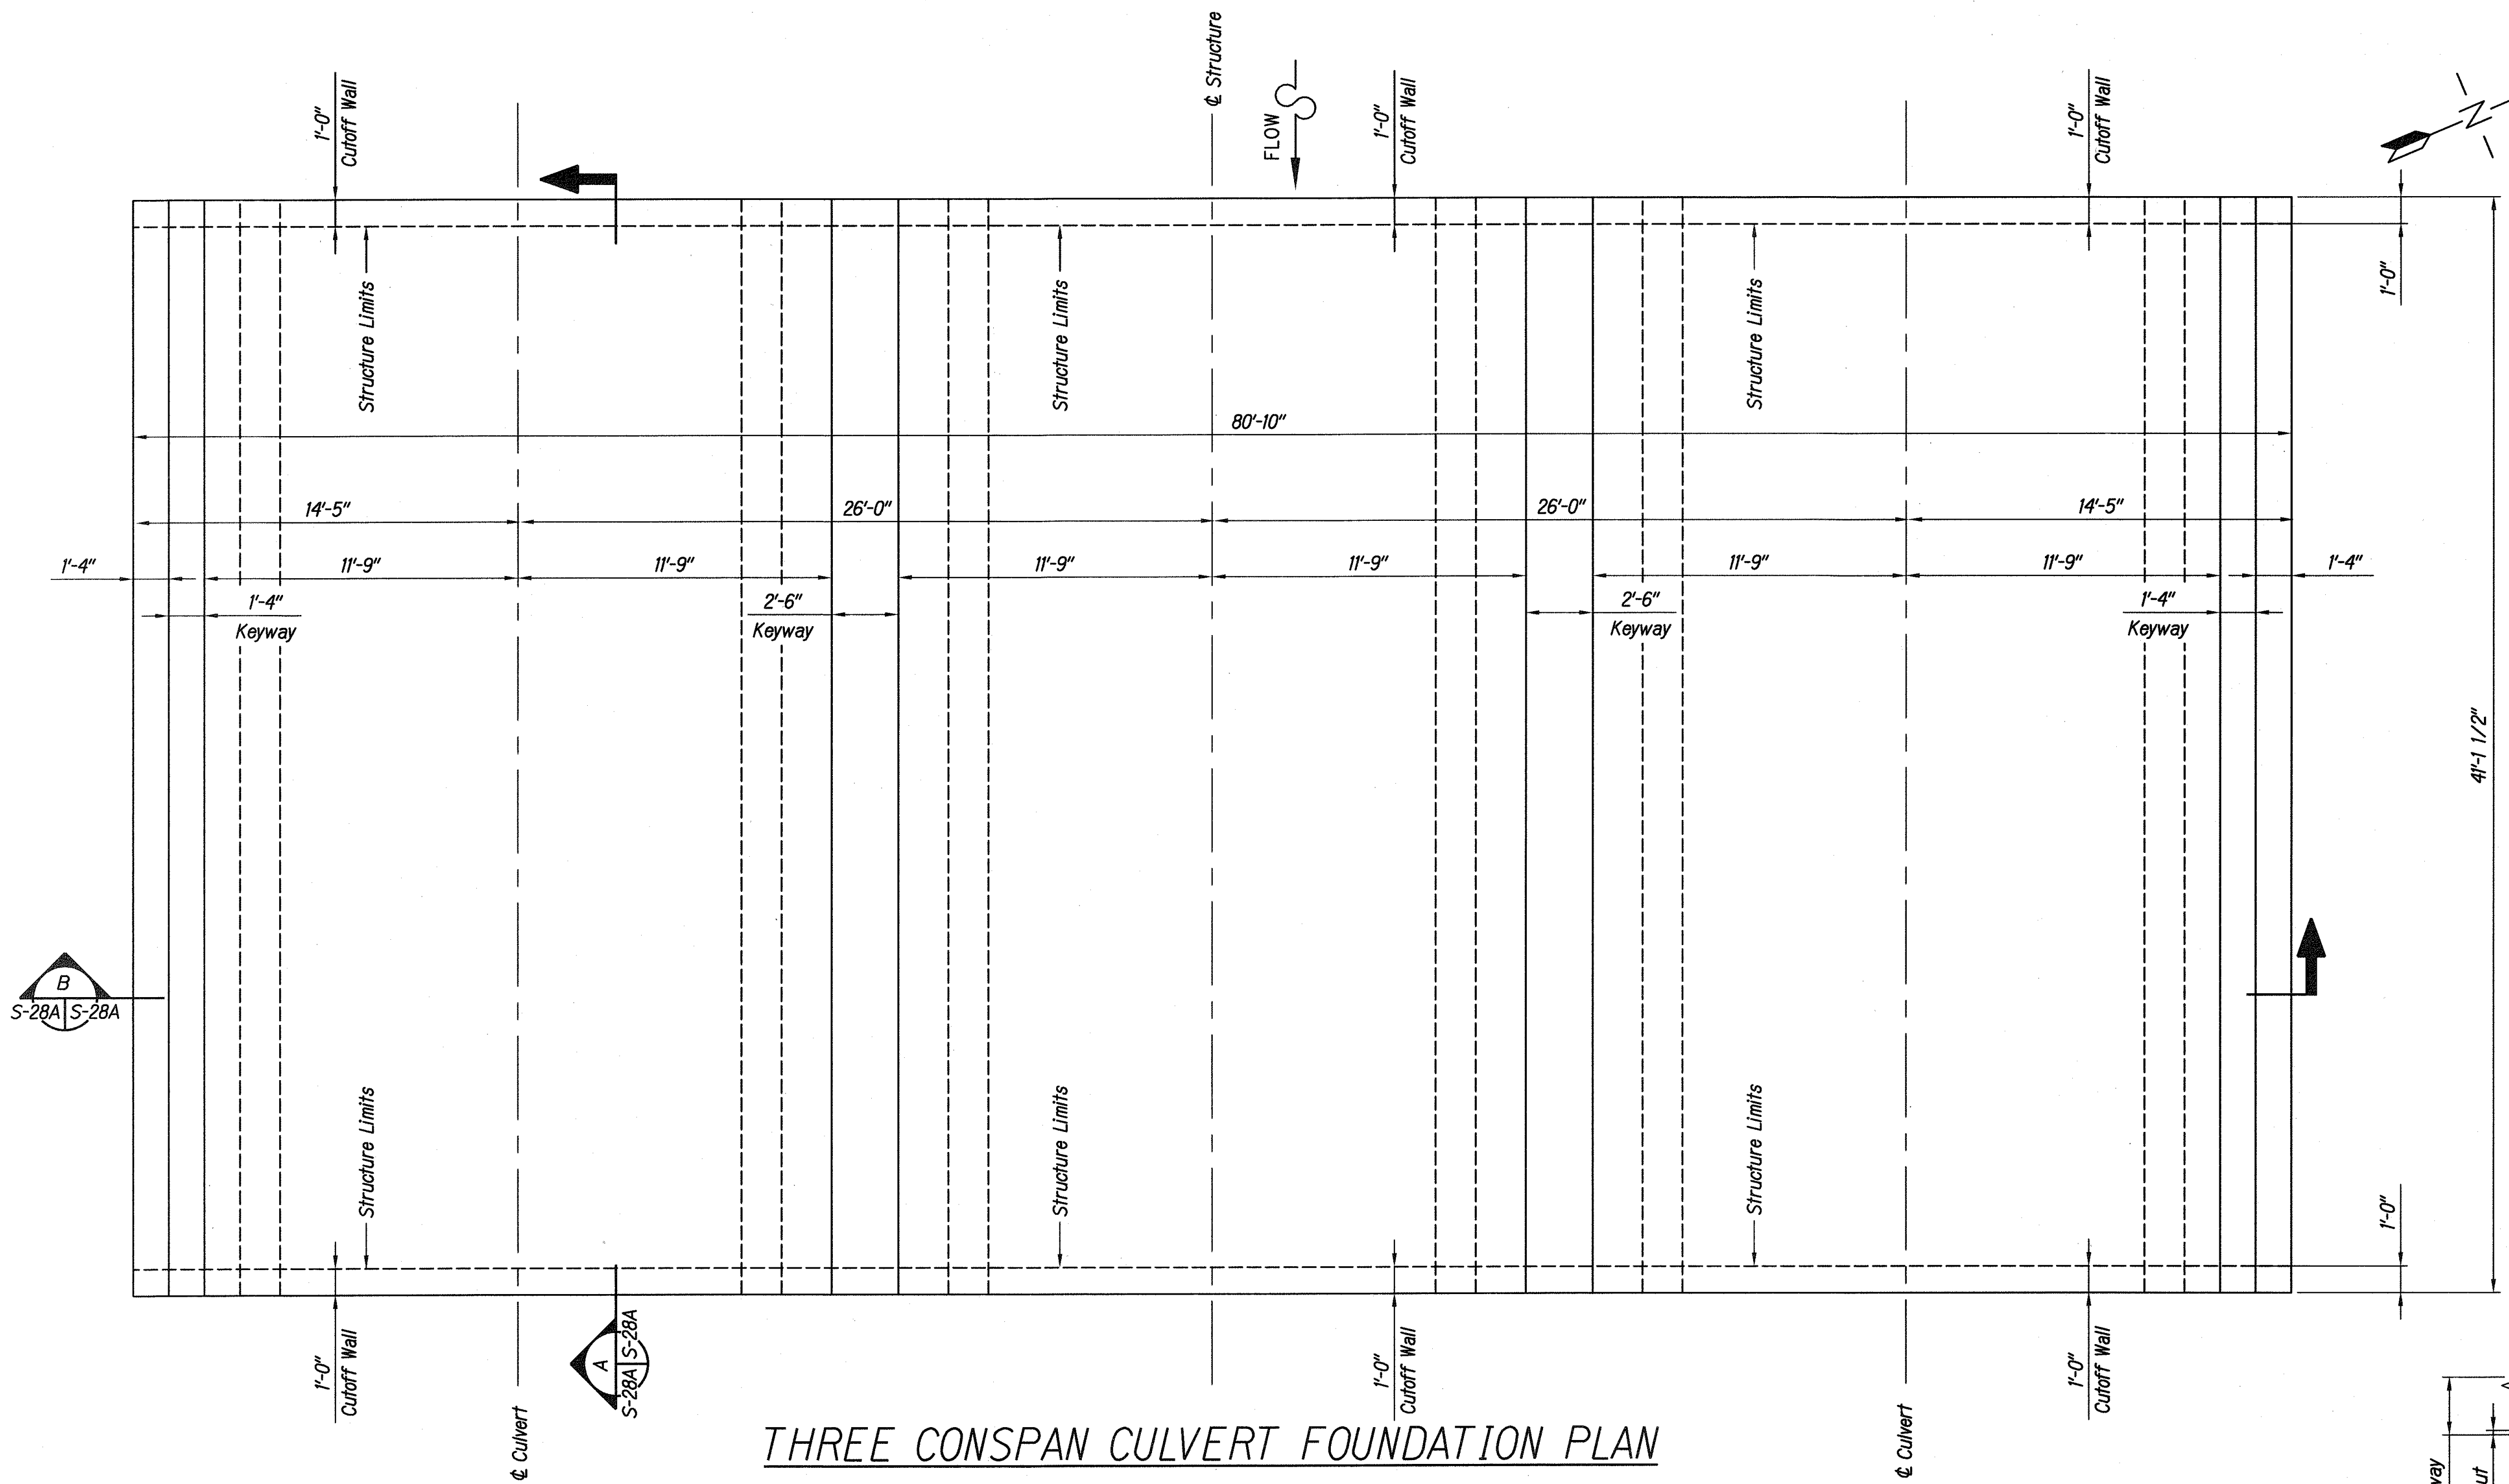


THREE CONSPAN CULVERT FOUNDATION PLAN




Note: For Foundations of Wingwalls not shown
See Sht No. S-28

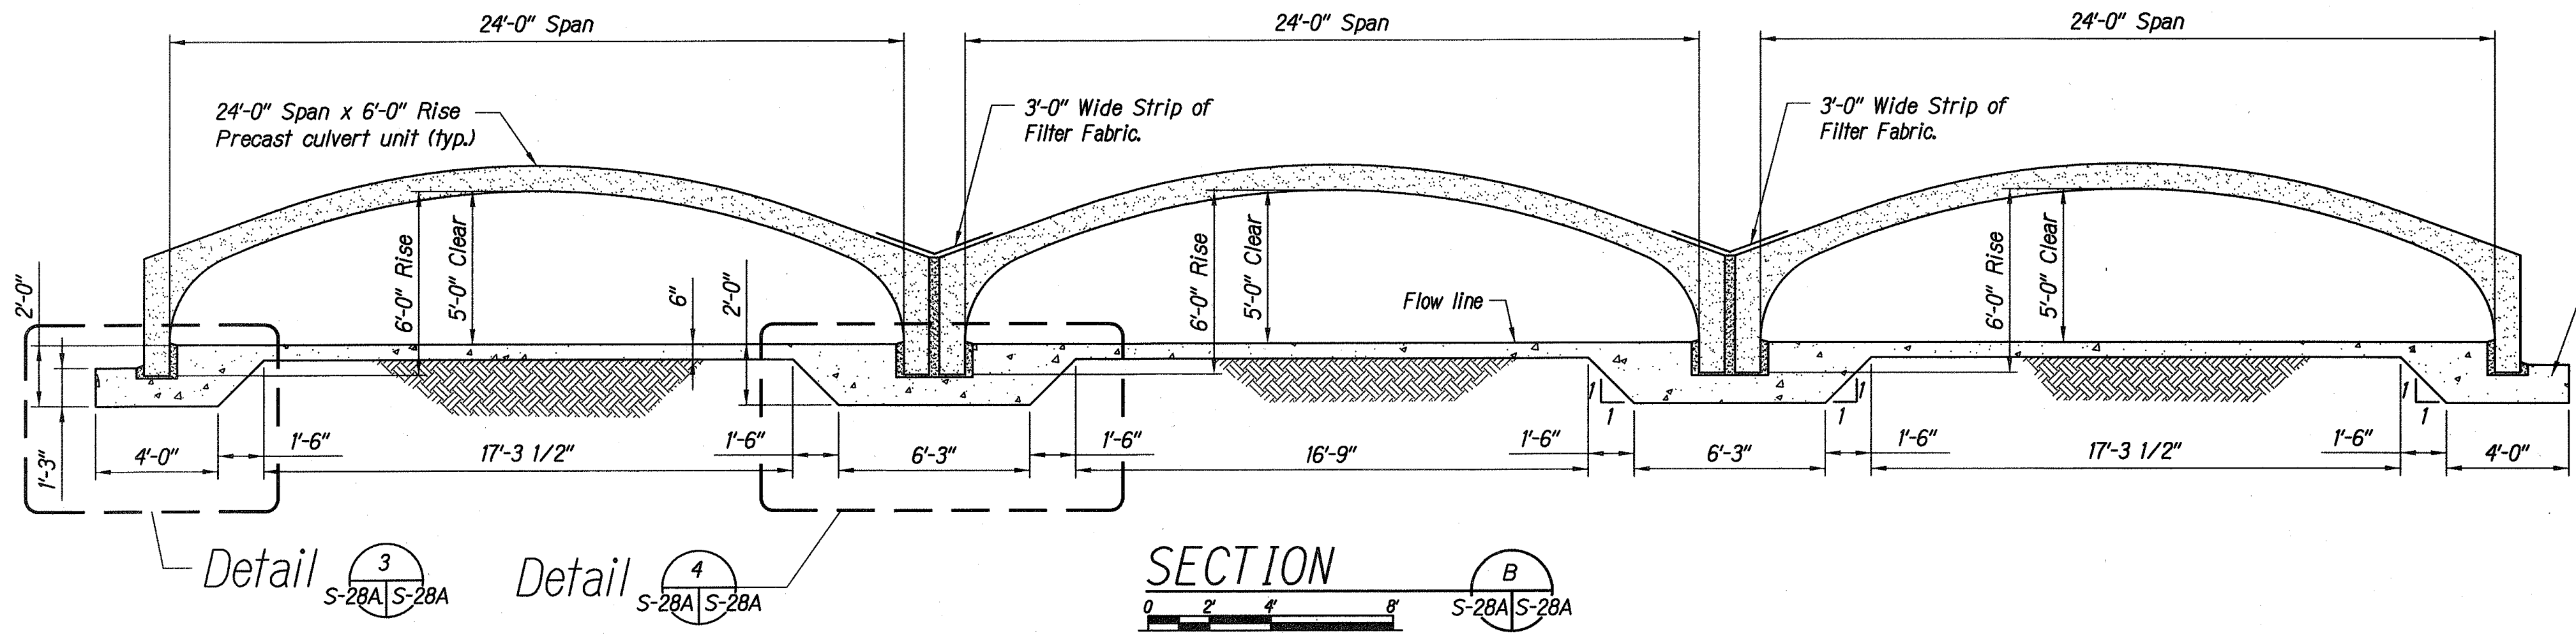


SECTION

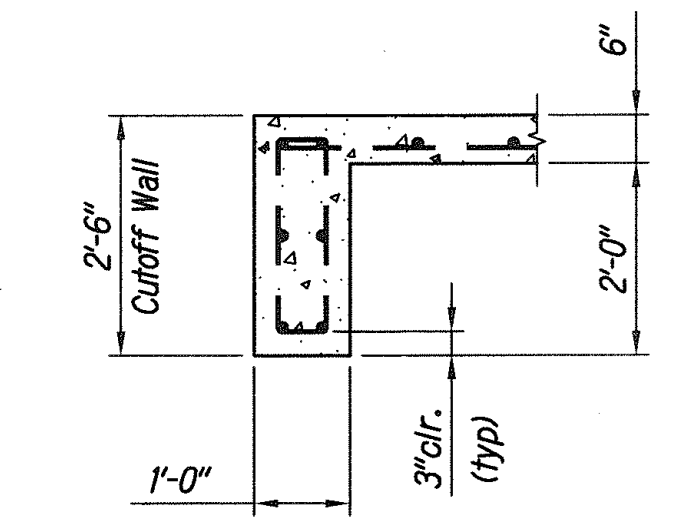

DETAIL 2

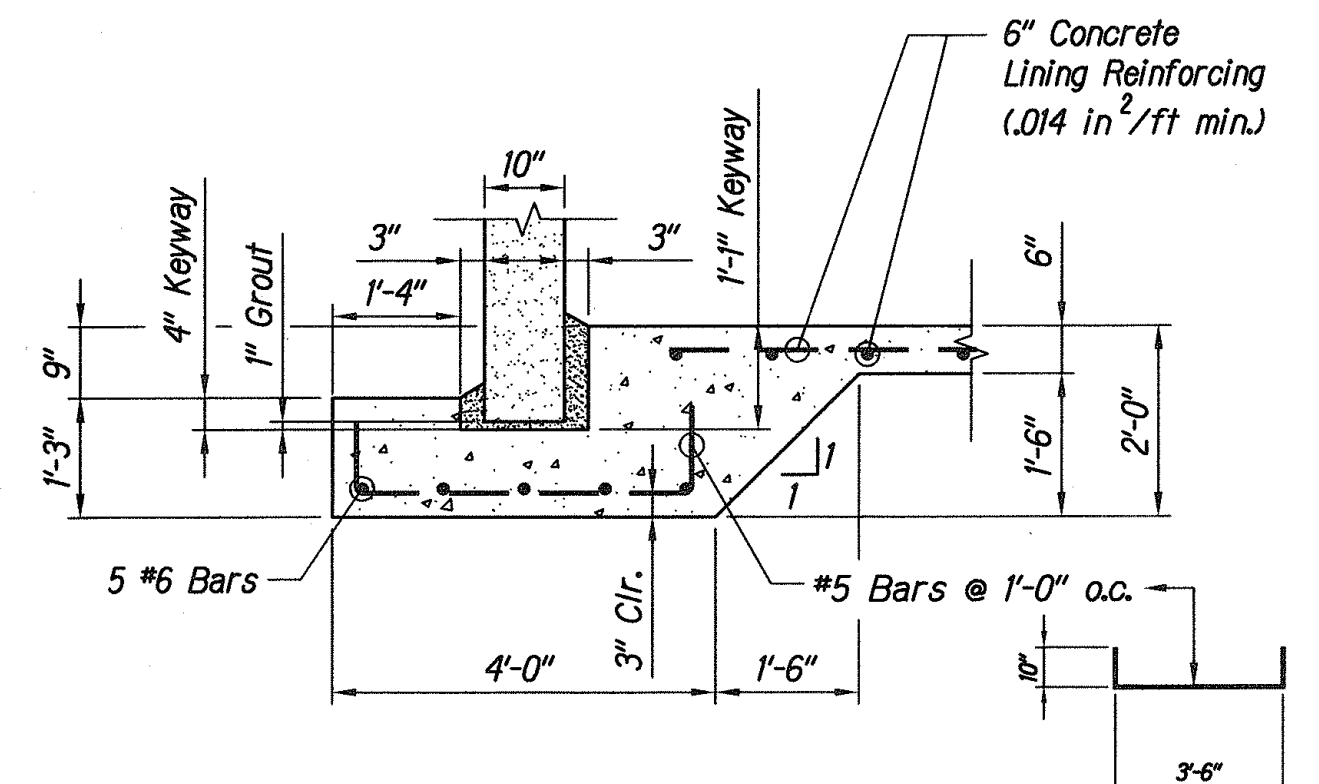

DETAIL 3

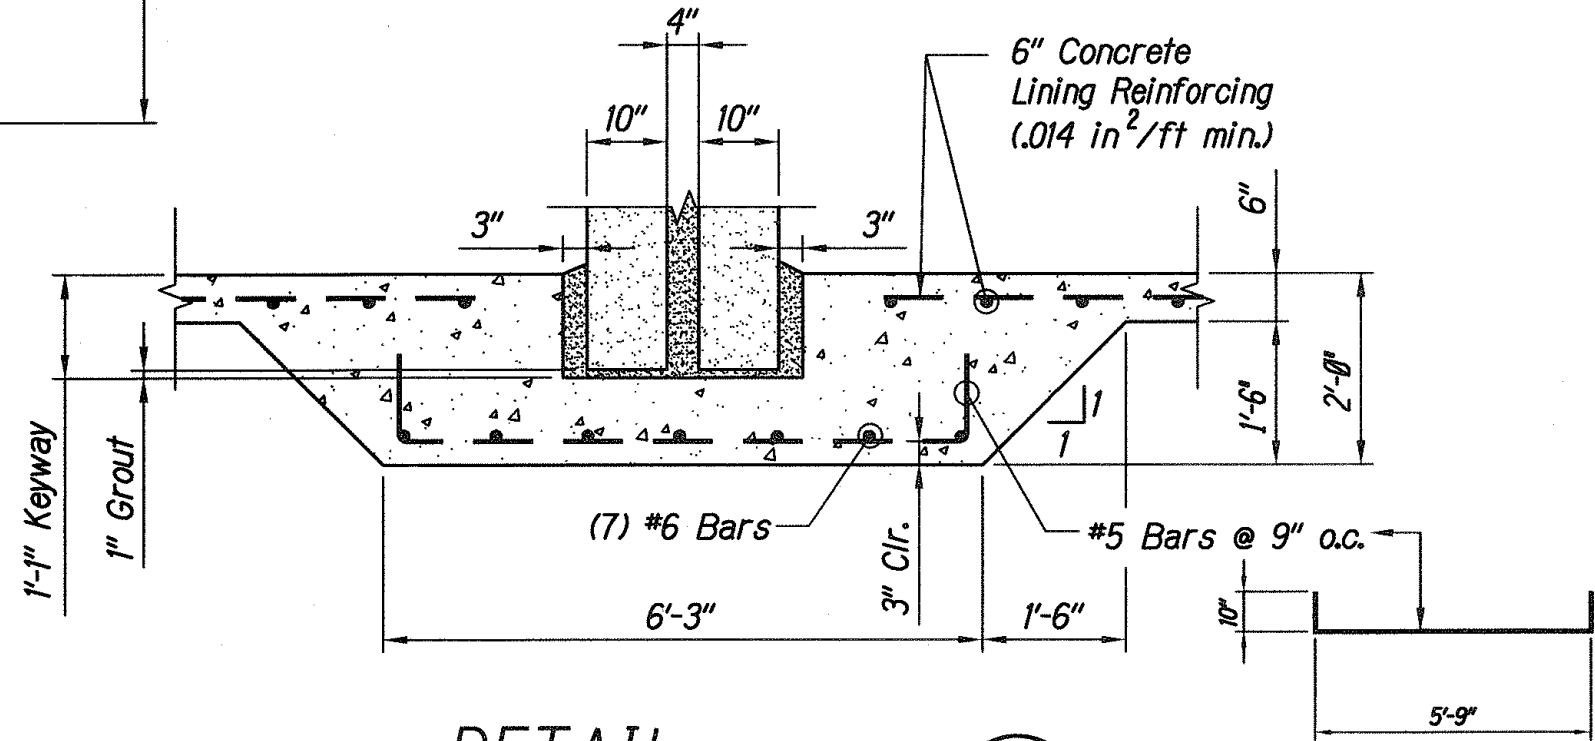

DETAIL 4

4/30/02	Added This Sheet
Date	Revision

HUI PANG CHEN
 LICENSED PROFESSIONAL ENGINEER
 No. 3865-S
 HAWAII, U.S.A.

THIS WORK WAS PREPARED BY ME OR UNDER MY SUPERVISION.

Hui Pang Chen

STATE OF HAWAII
DEPARTMENT OF TRANSPORTATION
HIGHWAYS DIVISION

KUIHELANI THREE SPAN CULVERT FOUNDATION PLAN

KUIHELANI HIGHWAY WIDENING
HONOAPIILANI HIGHWAY TO PUUNENE AVENUE
FEDERAL-AID PROJECT NO. NH-0380(9)


Scale: As Shown Date: Apr. 30, 2002

SHEET No. S-28A OF 54 SHEETS

C.O. 190 S-1


SURVEY PLOTTED BY	DATE
PLAN	
DESIGNED BY	
NOTE BOOK	
QUANTITIES BY	
CHECKED BY	
No.	

FED. ROAD DIST. NO.	STATE	FED. AID PROJ. NO.	FISCAL YEAR	SHEET NO.	TOTAL SHEETS
HAWAII	HAW.	NH-0380(9)	2000	191	380

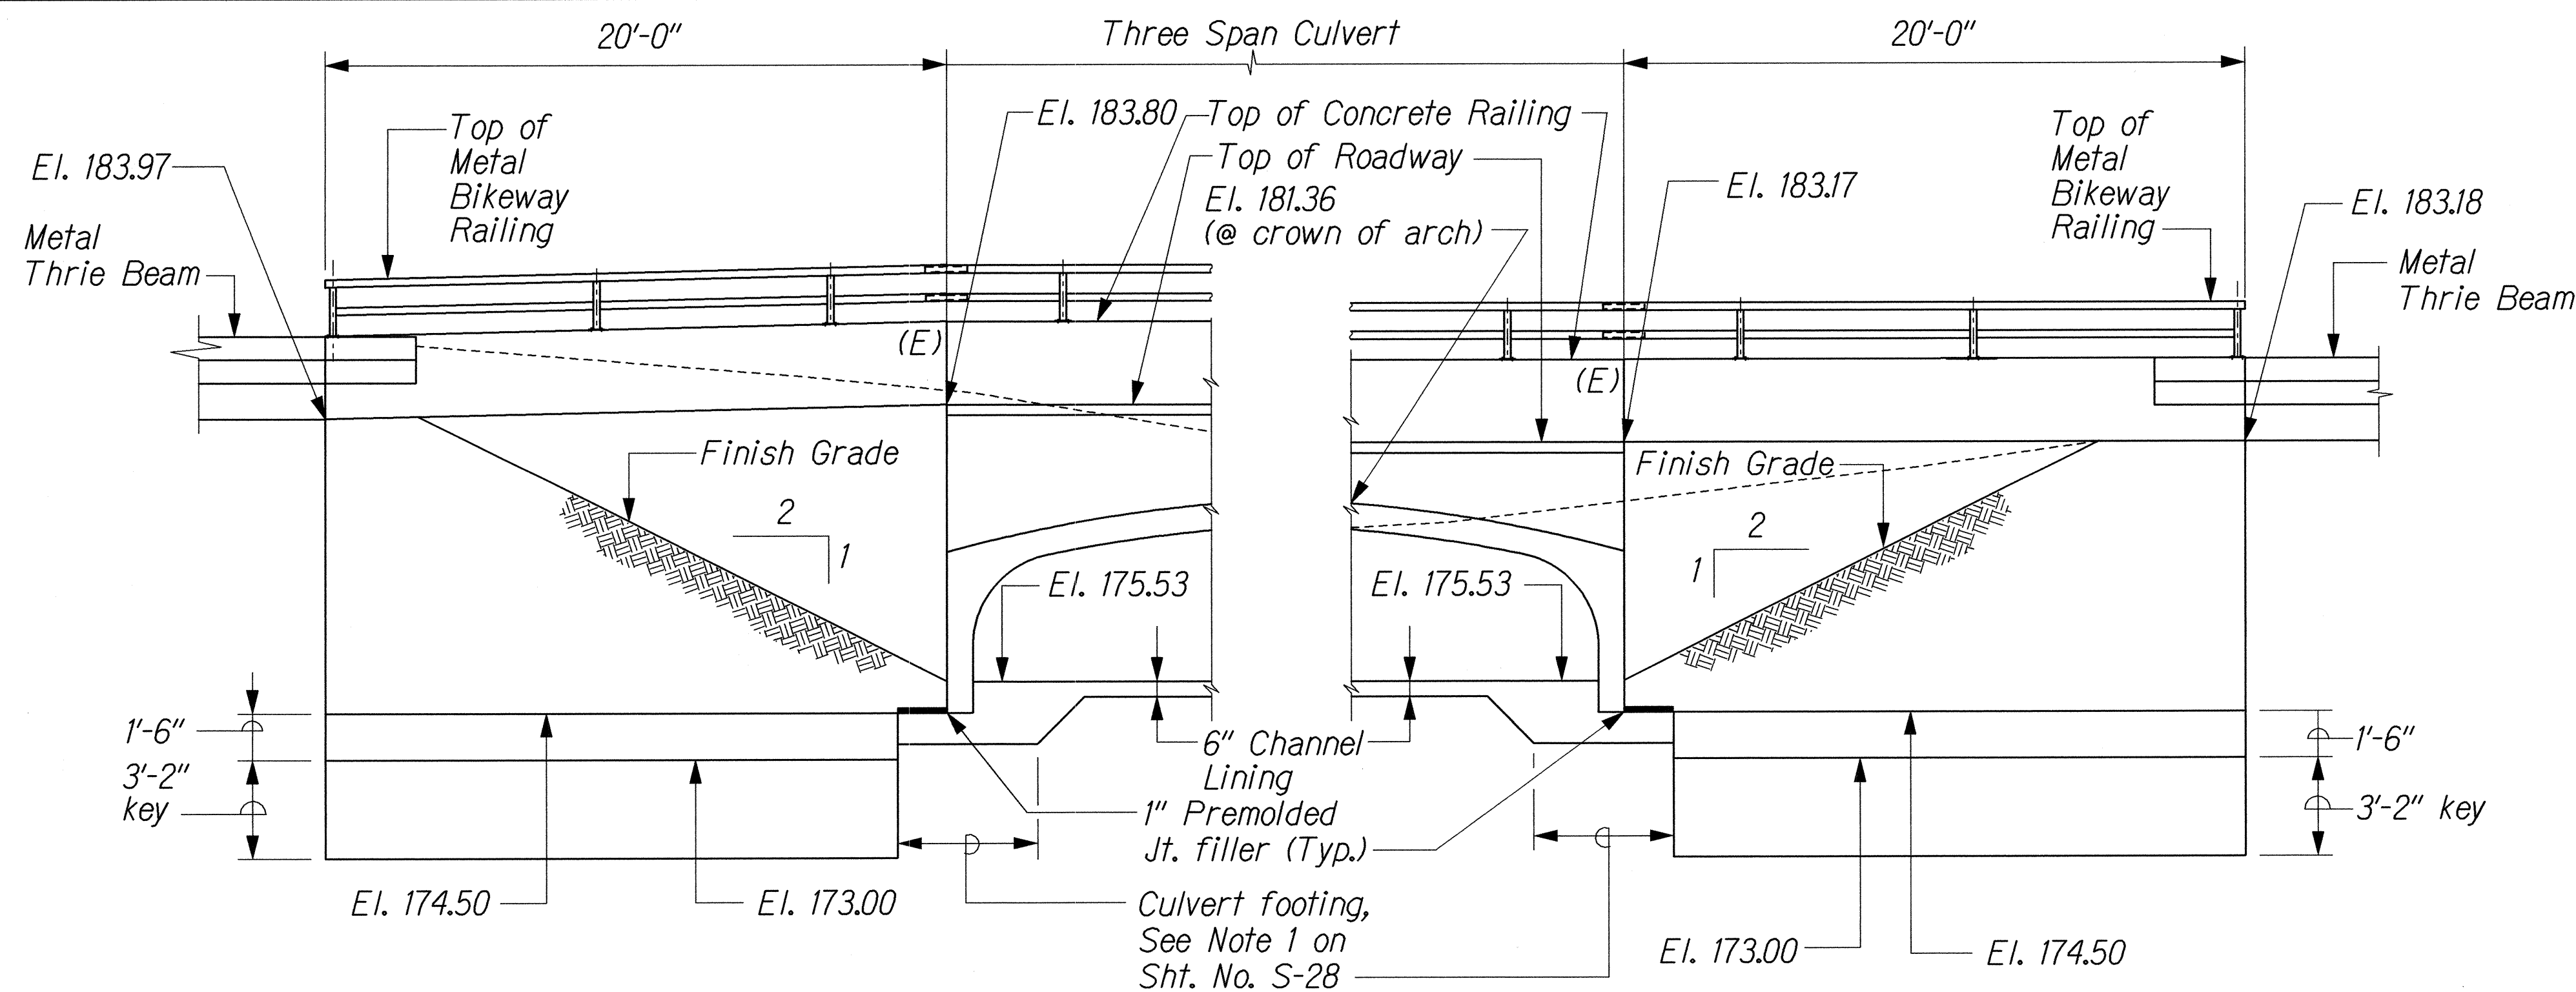


WINGWALL NO. 4 ELEVATION
Scale: 1/4" = 1'-0"


WINGWALL NO. 3 ELEVATION
Scale: 1/4" = 1'-0"

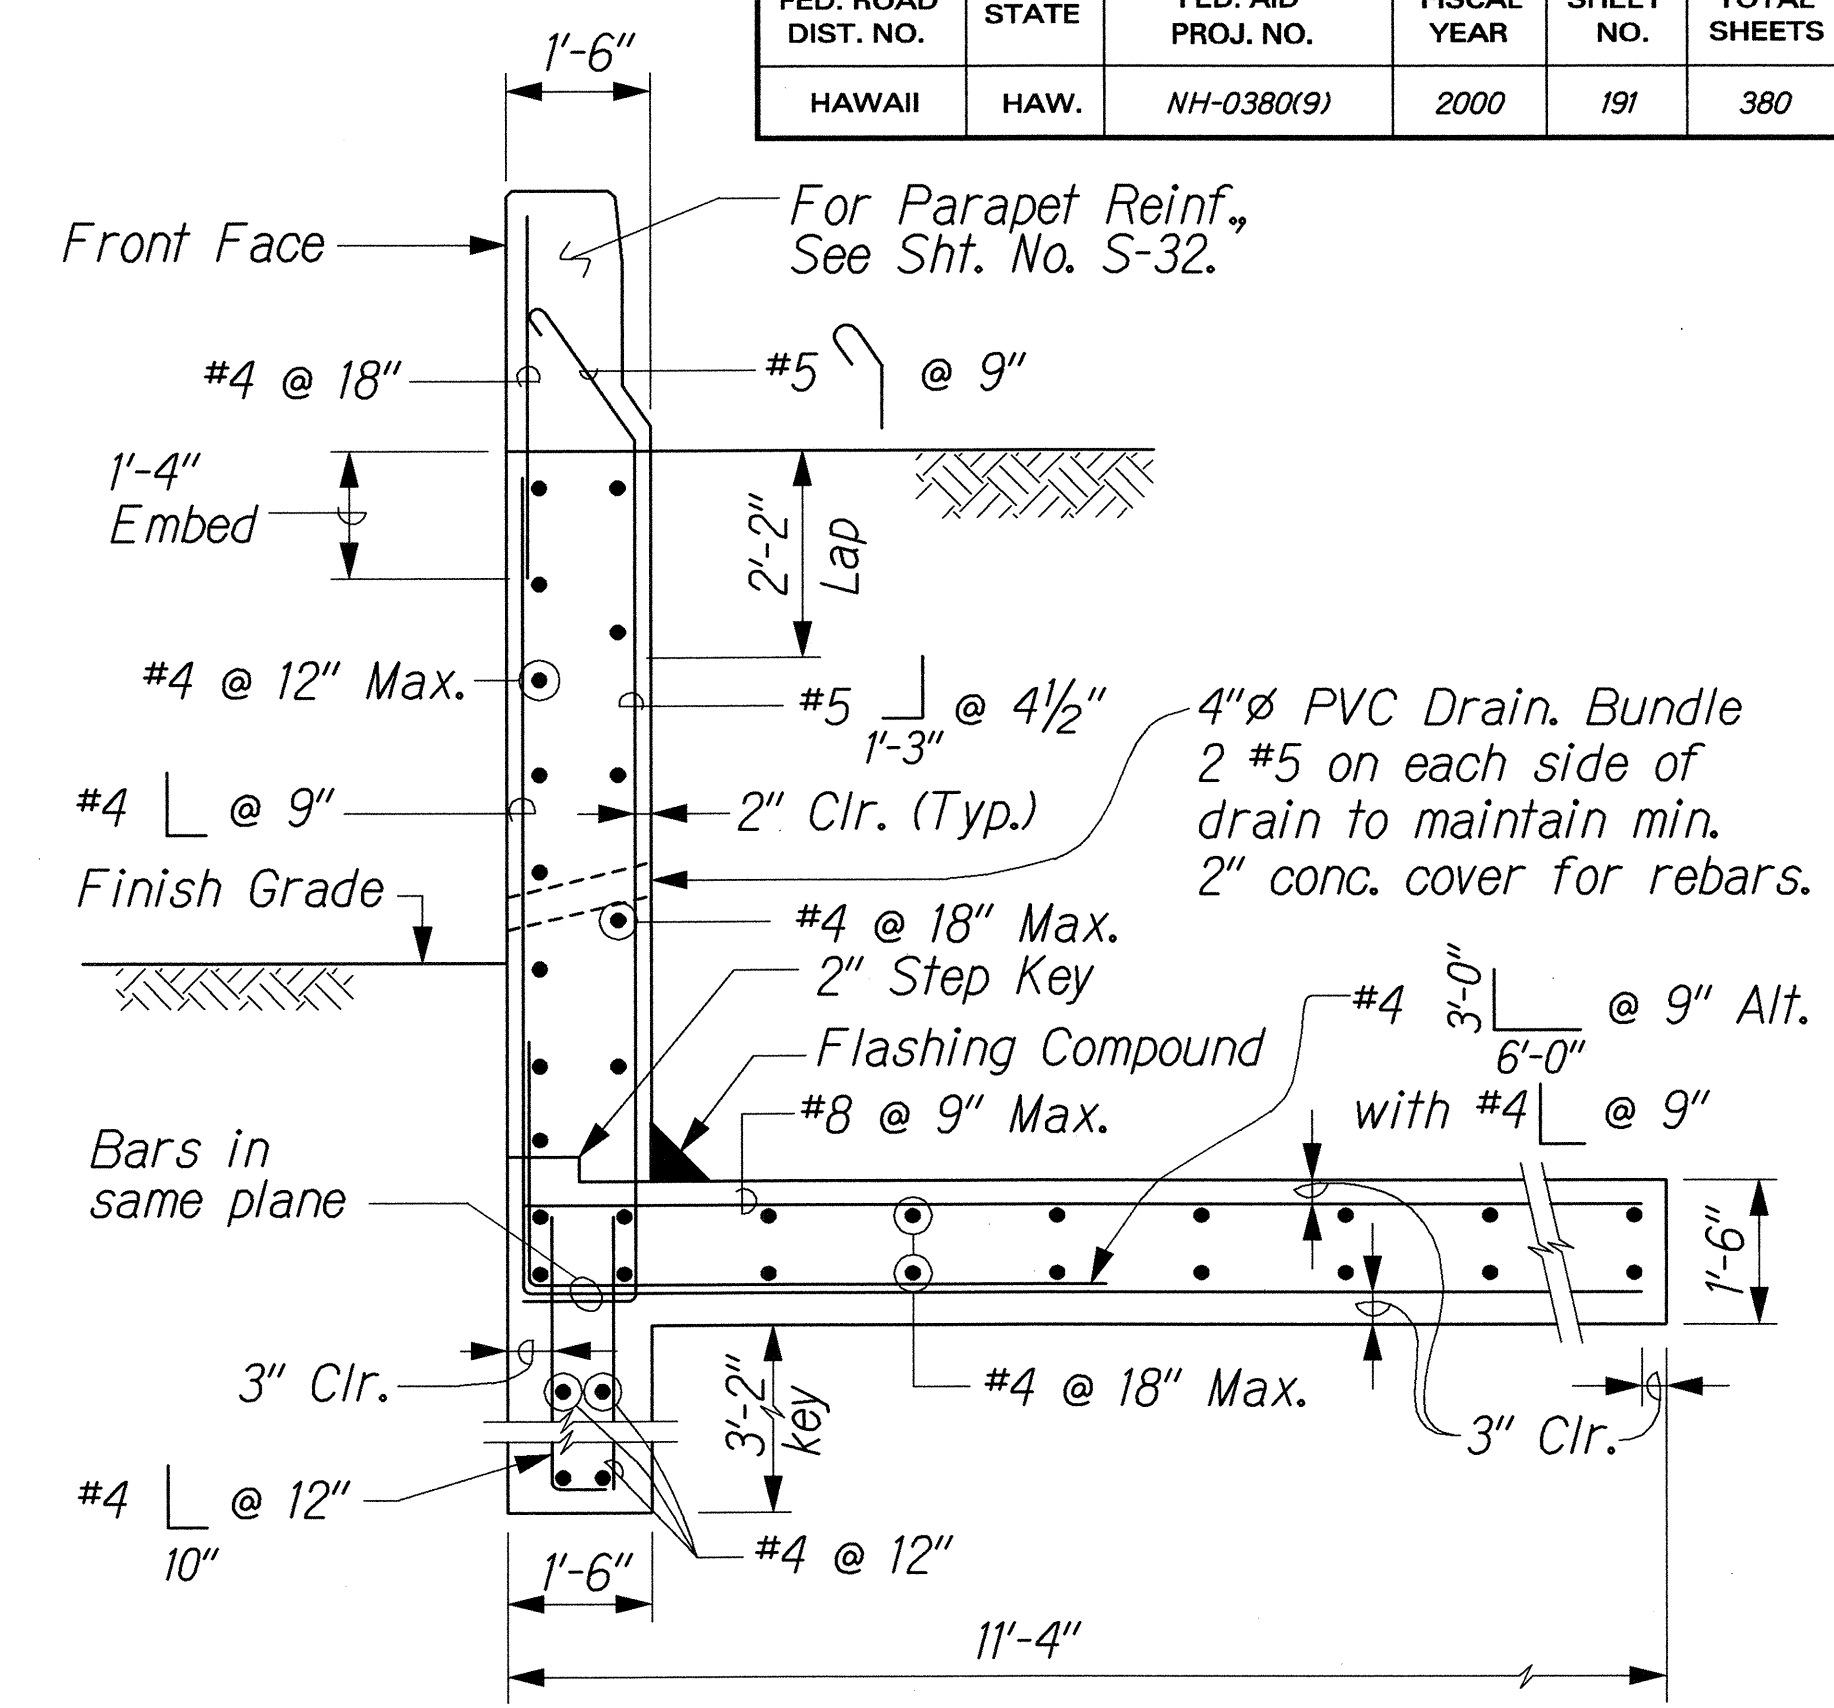


TYPICAL WINGWALL SECTION
Scale: 1/2" = 1'-0"

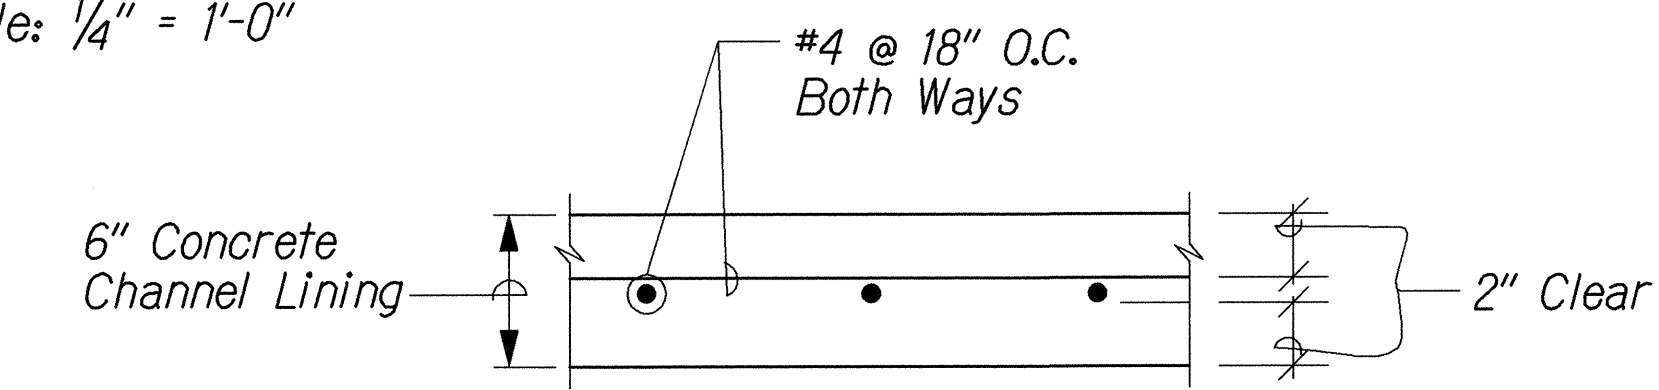

CONCRETE CHANNEL LINING DETAIL
Not To Scale

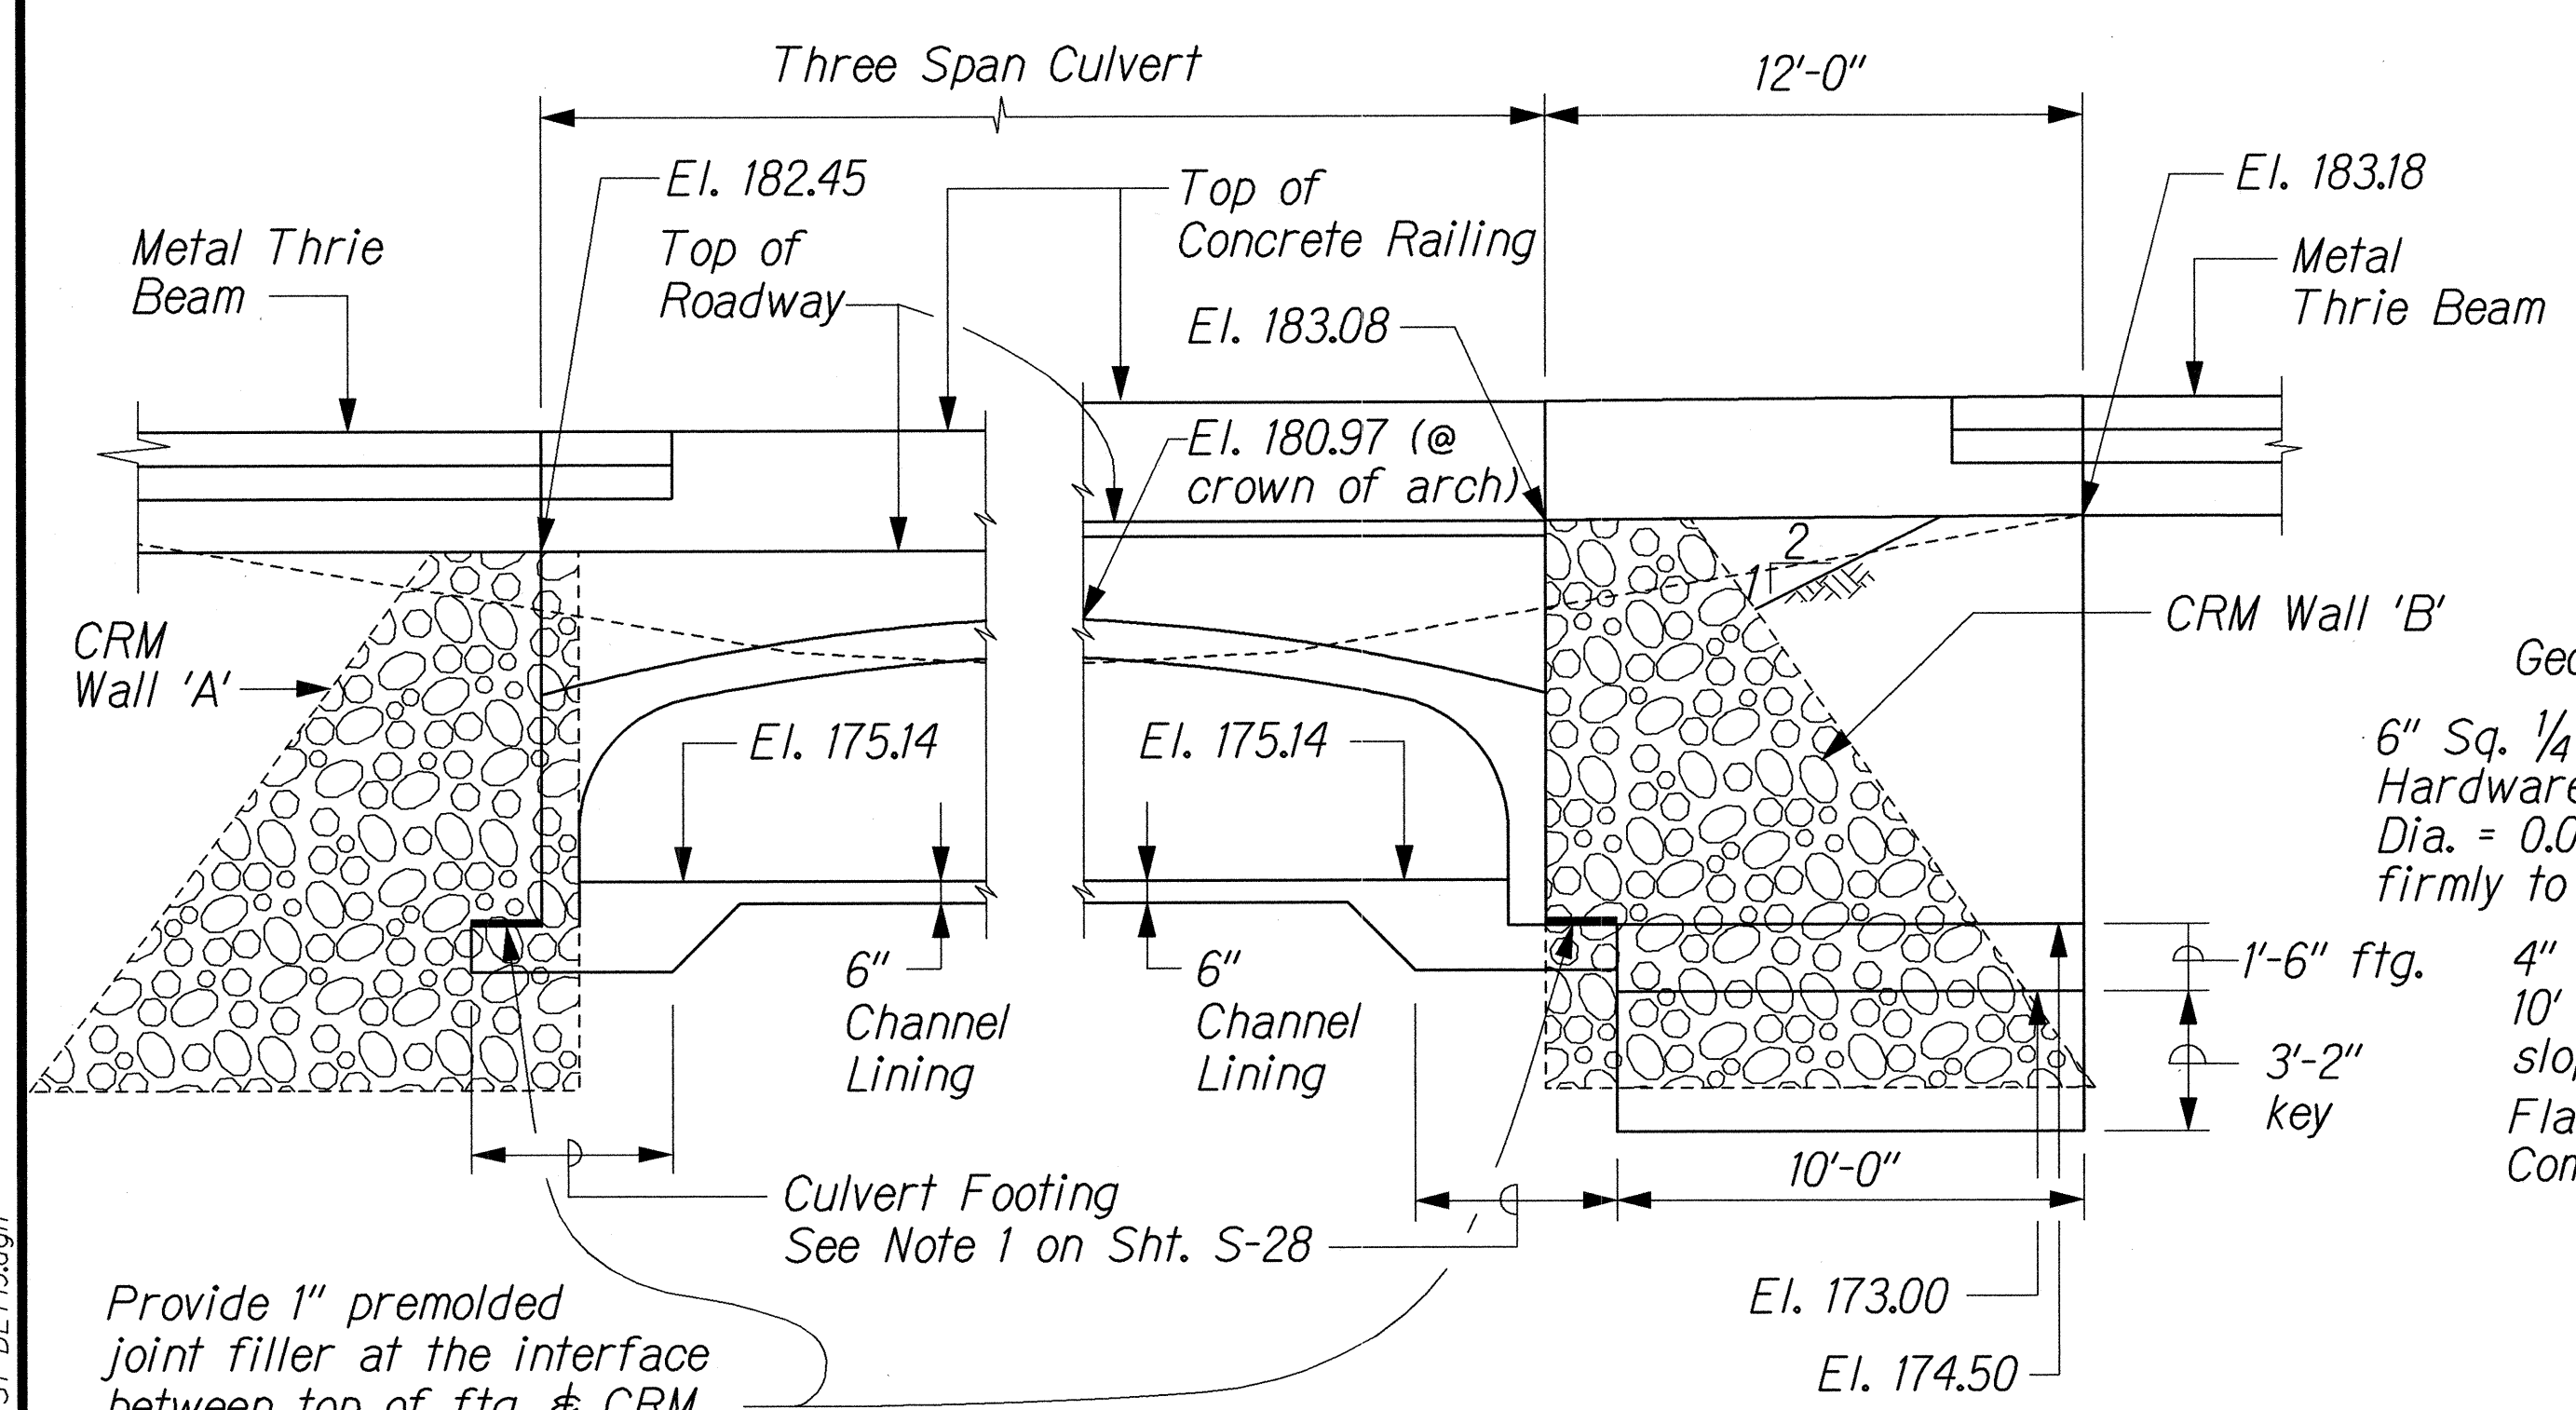

WINGWALL NO. 2 ELEVATION
Scale: 1/4" = 1'-0"

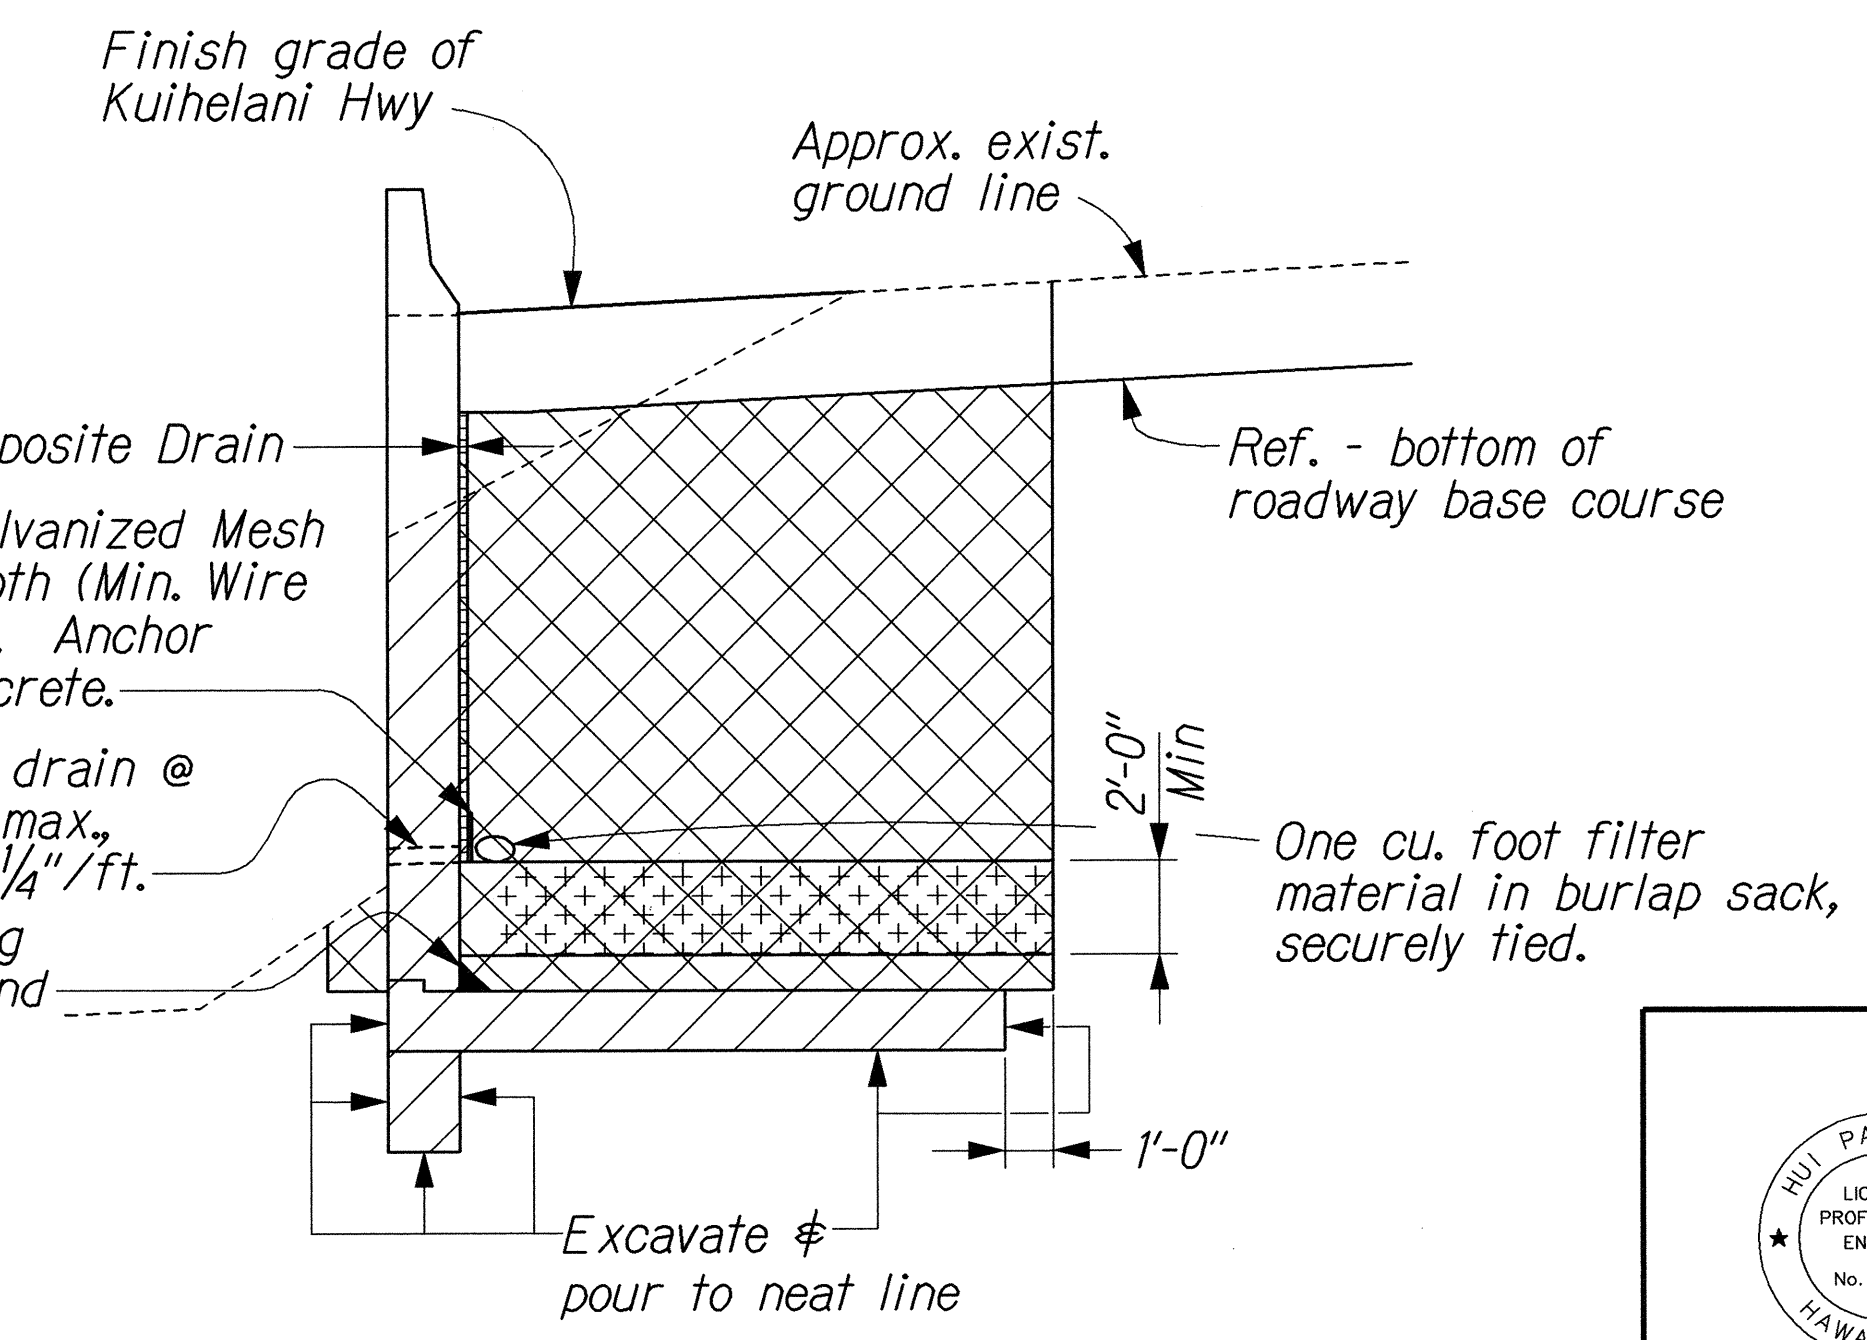

PAYMENT LIMIT FOR WINGWALL
Not To Scale

- LEGEND**
- Structure Excavation
 - Filter Material
 - Structure Backfill
 - Impervious material to be incidental to structure backfill

- NOTE:**
- See Notes 1 & 2 on Sht. No. S-30.
 - See Note 7(L) on Sht. No. S-2.


DATE	_____
SURVEY PLOTTED BY	_____
DRAWN BY	_____
DESIGNED BY	_____
CHECKED BY	_____
ORIGINAL PLAN	_____
NOTE BOOK	_____

SECTION A
Scale: 1/4" = 1'-0"


THIS WORK WAS PREPARED BY ME OR UNDER MY SUPERVISION.
Hui Pang Chen

STATE OF HAWAII
DEPARTMENT OF TRANSPORTATION
HIGHWAYS DIVISION
KUIHELANI THREE SPAN CULVERT
WINGWALL DETAILS
KUIHELANI HIGHWAY WIDENING
HONOAPIILANI HIGHWAY TO PUUNENE AVENUE
FEDERAL-AID PROJECT NO. NH-0380(9)
Scale: As Shown Date: Sept. 14, 2001


FED. ROAD DIST. NO.	STATE	FED. AID PROJ. NO.	FISCAL YEAR	SHEET NO.	TOTAL SHEETS
HAWAII	HAW.	NH-0380(9)	2000	192	380

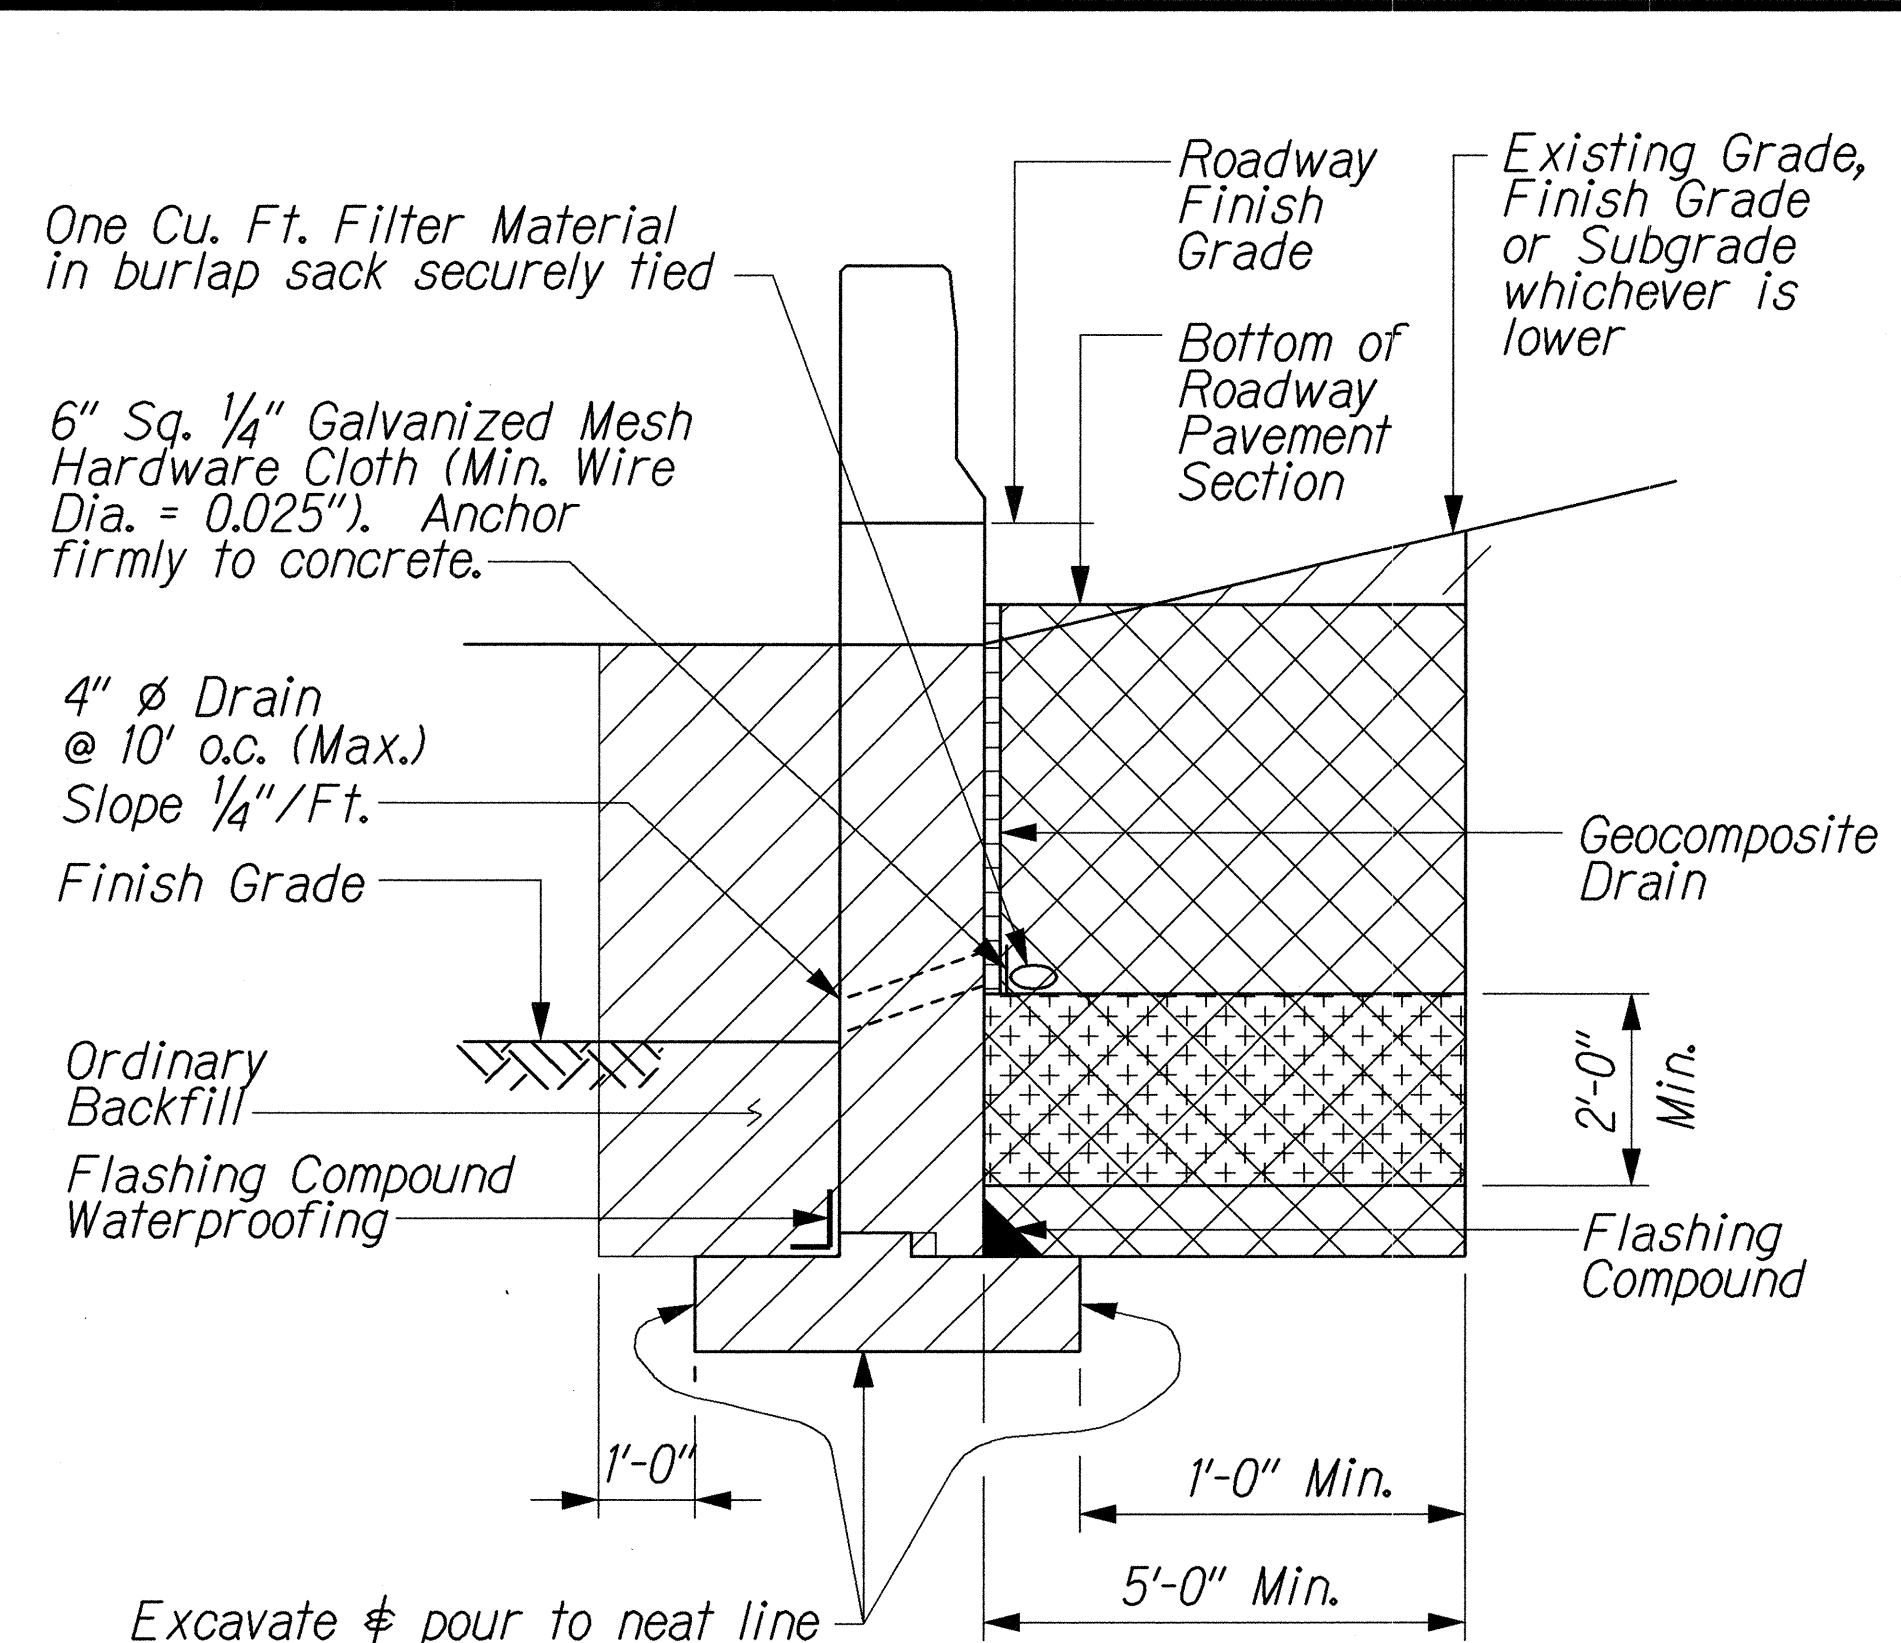


RETAINING WALL OR WINGWALL

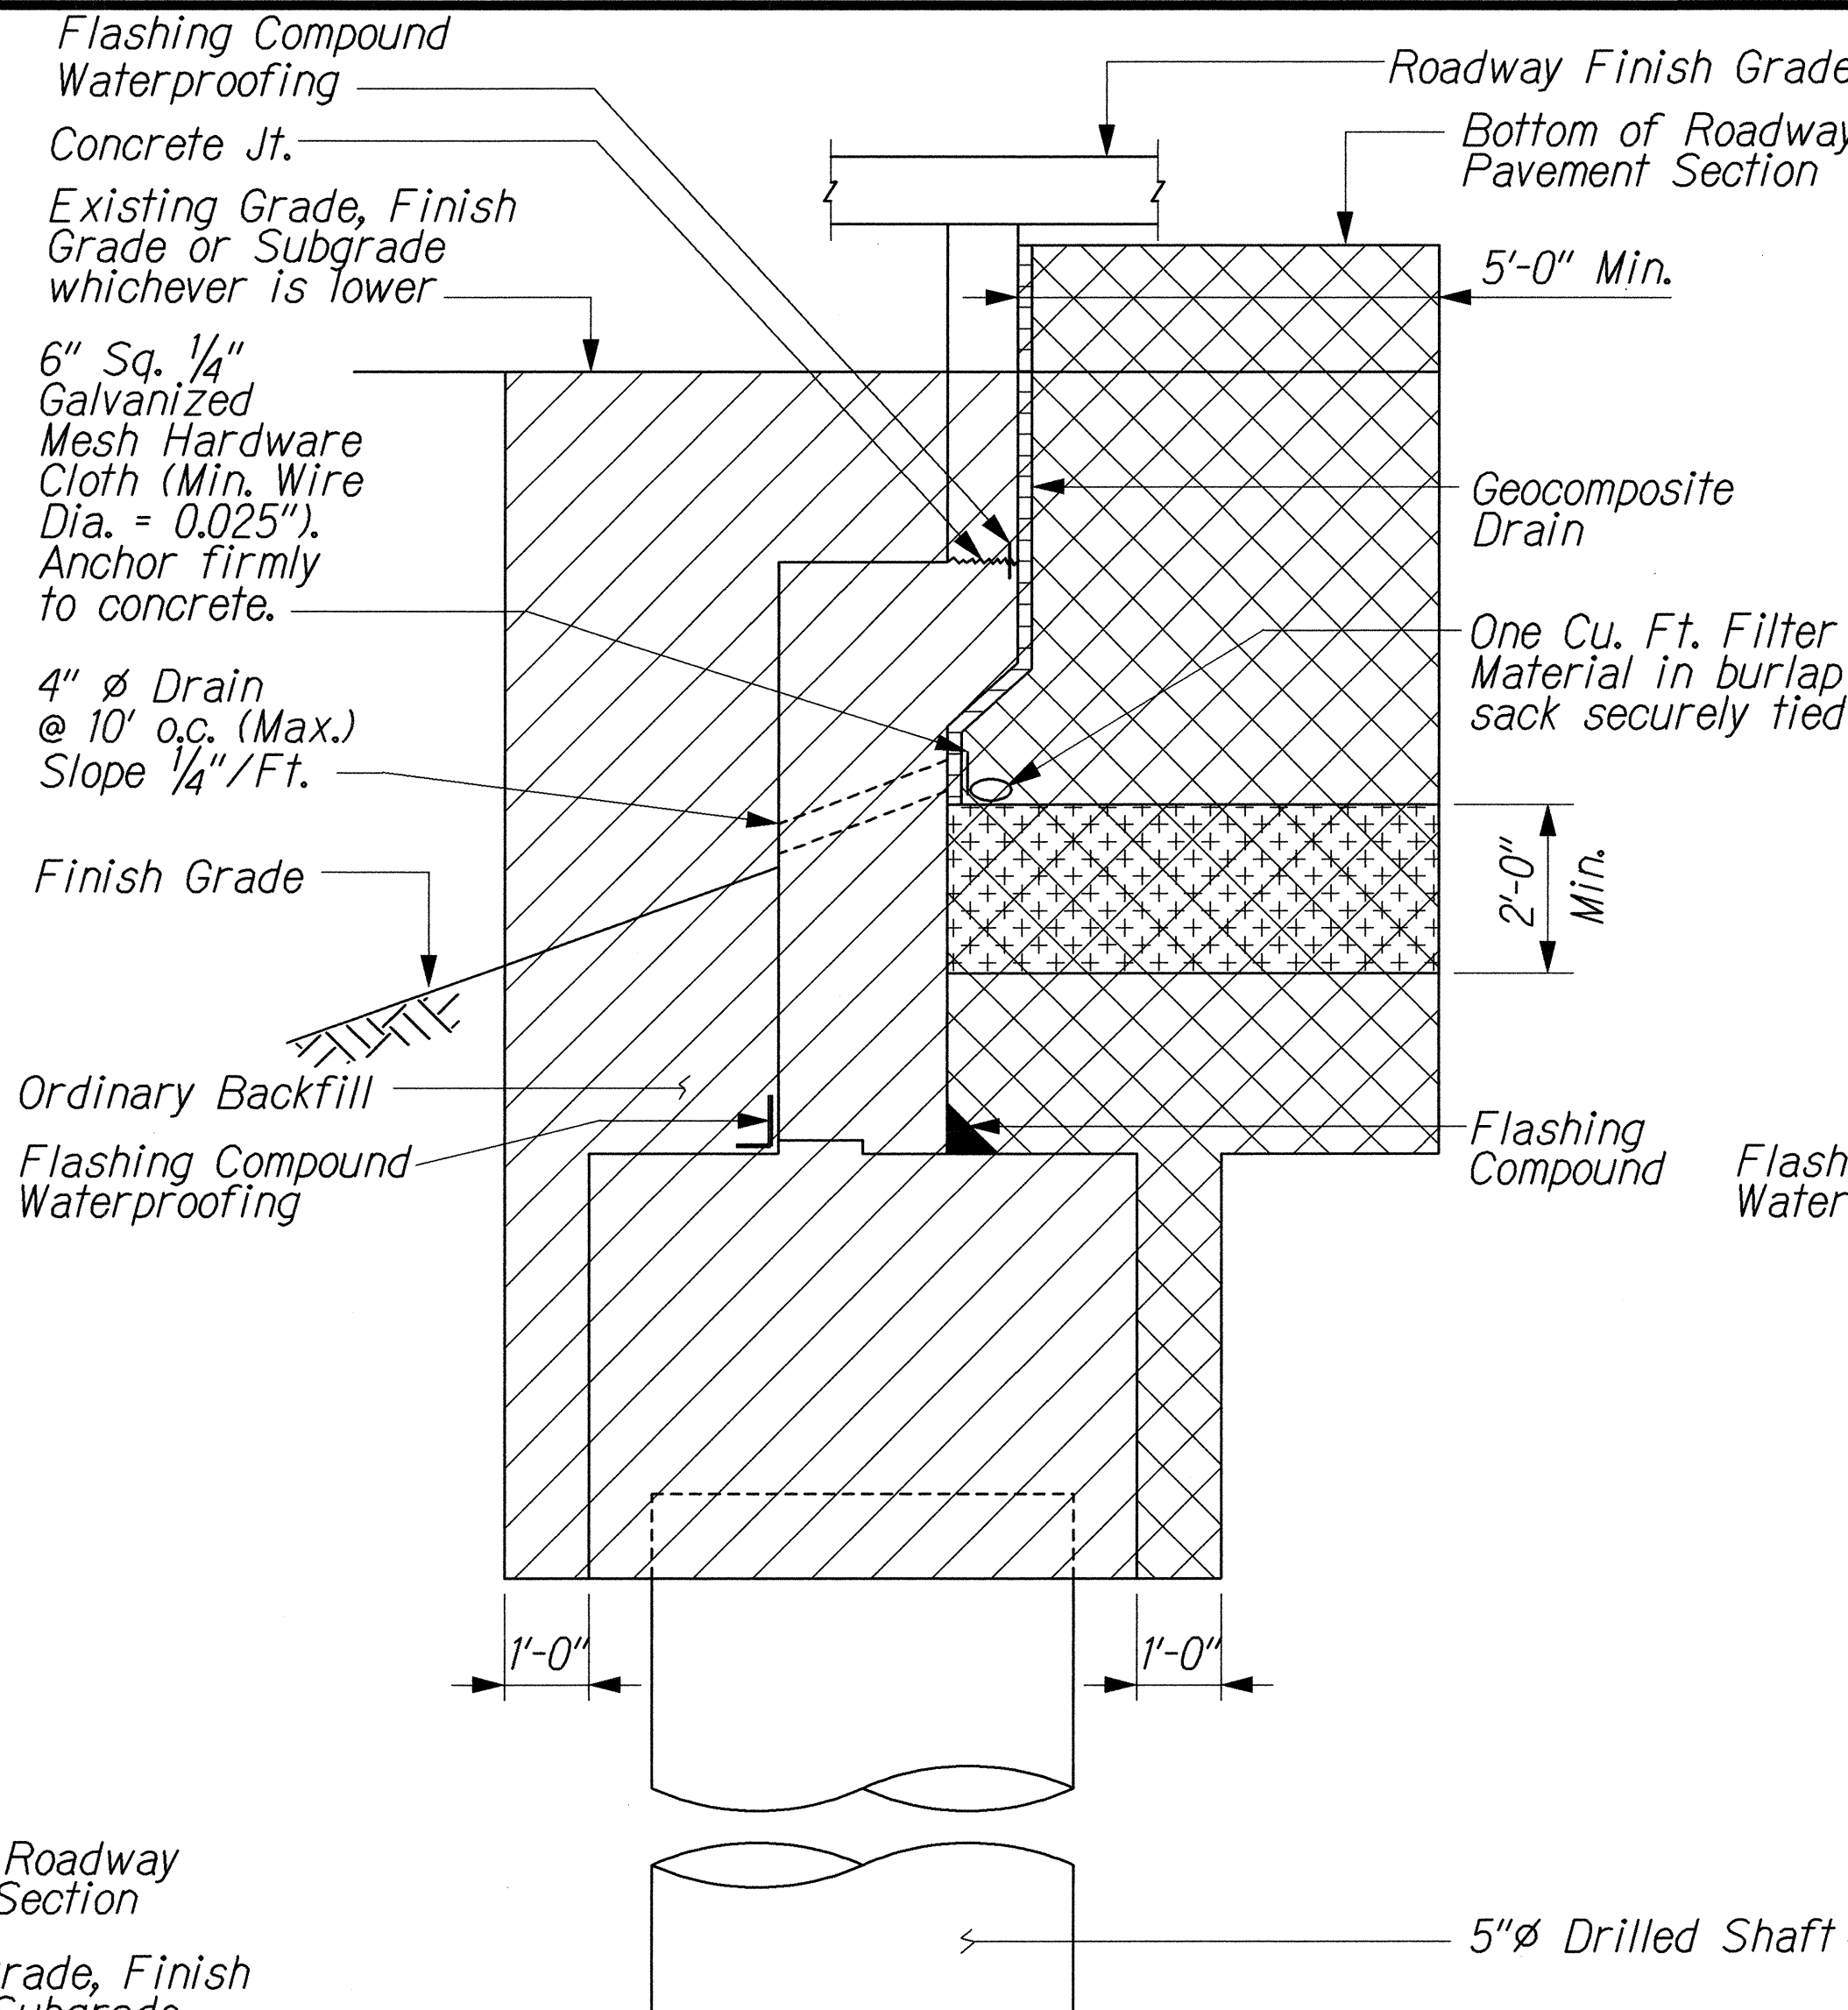


ABUTMENT SECTION ON DRILLED SHAFT

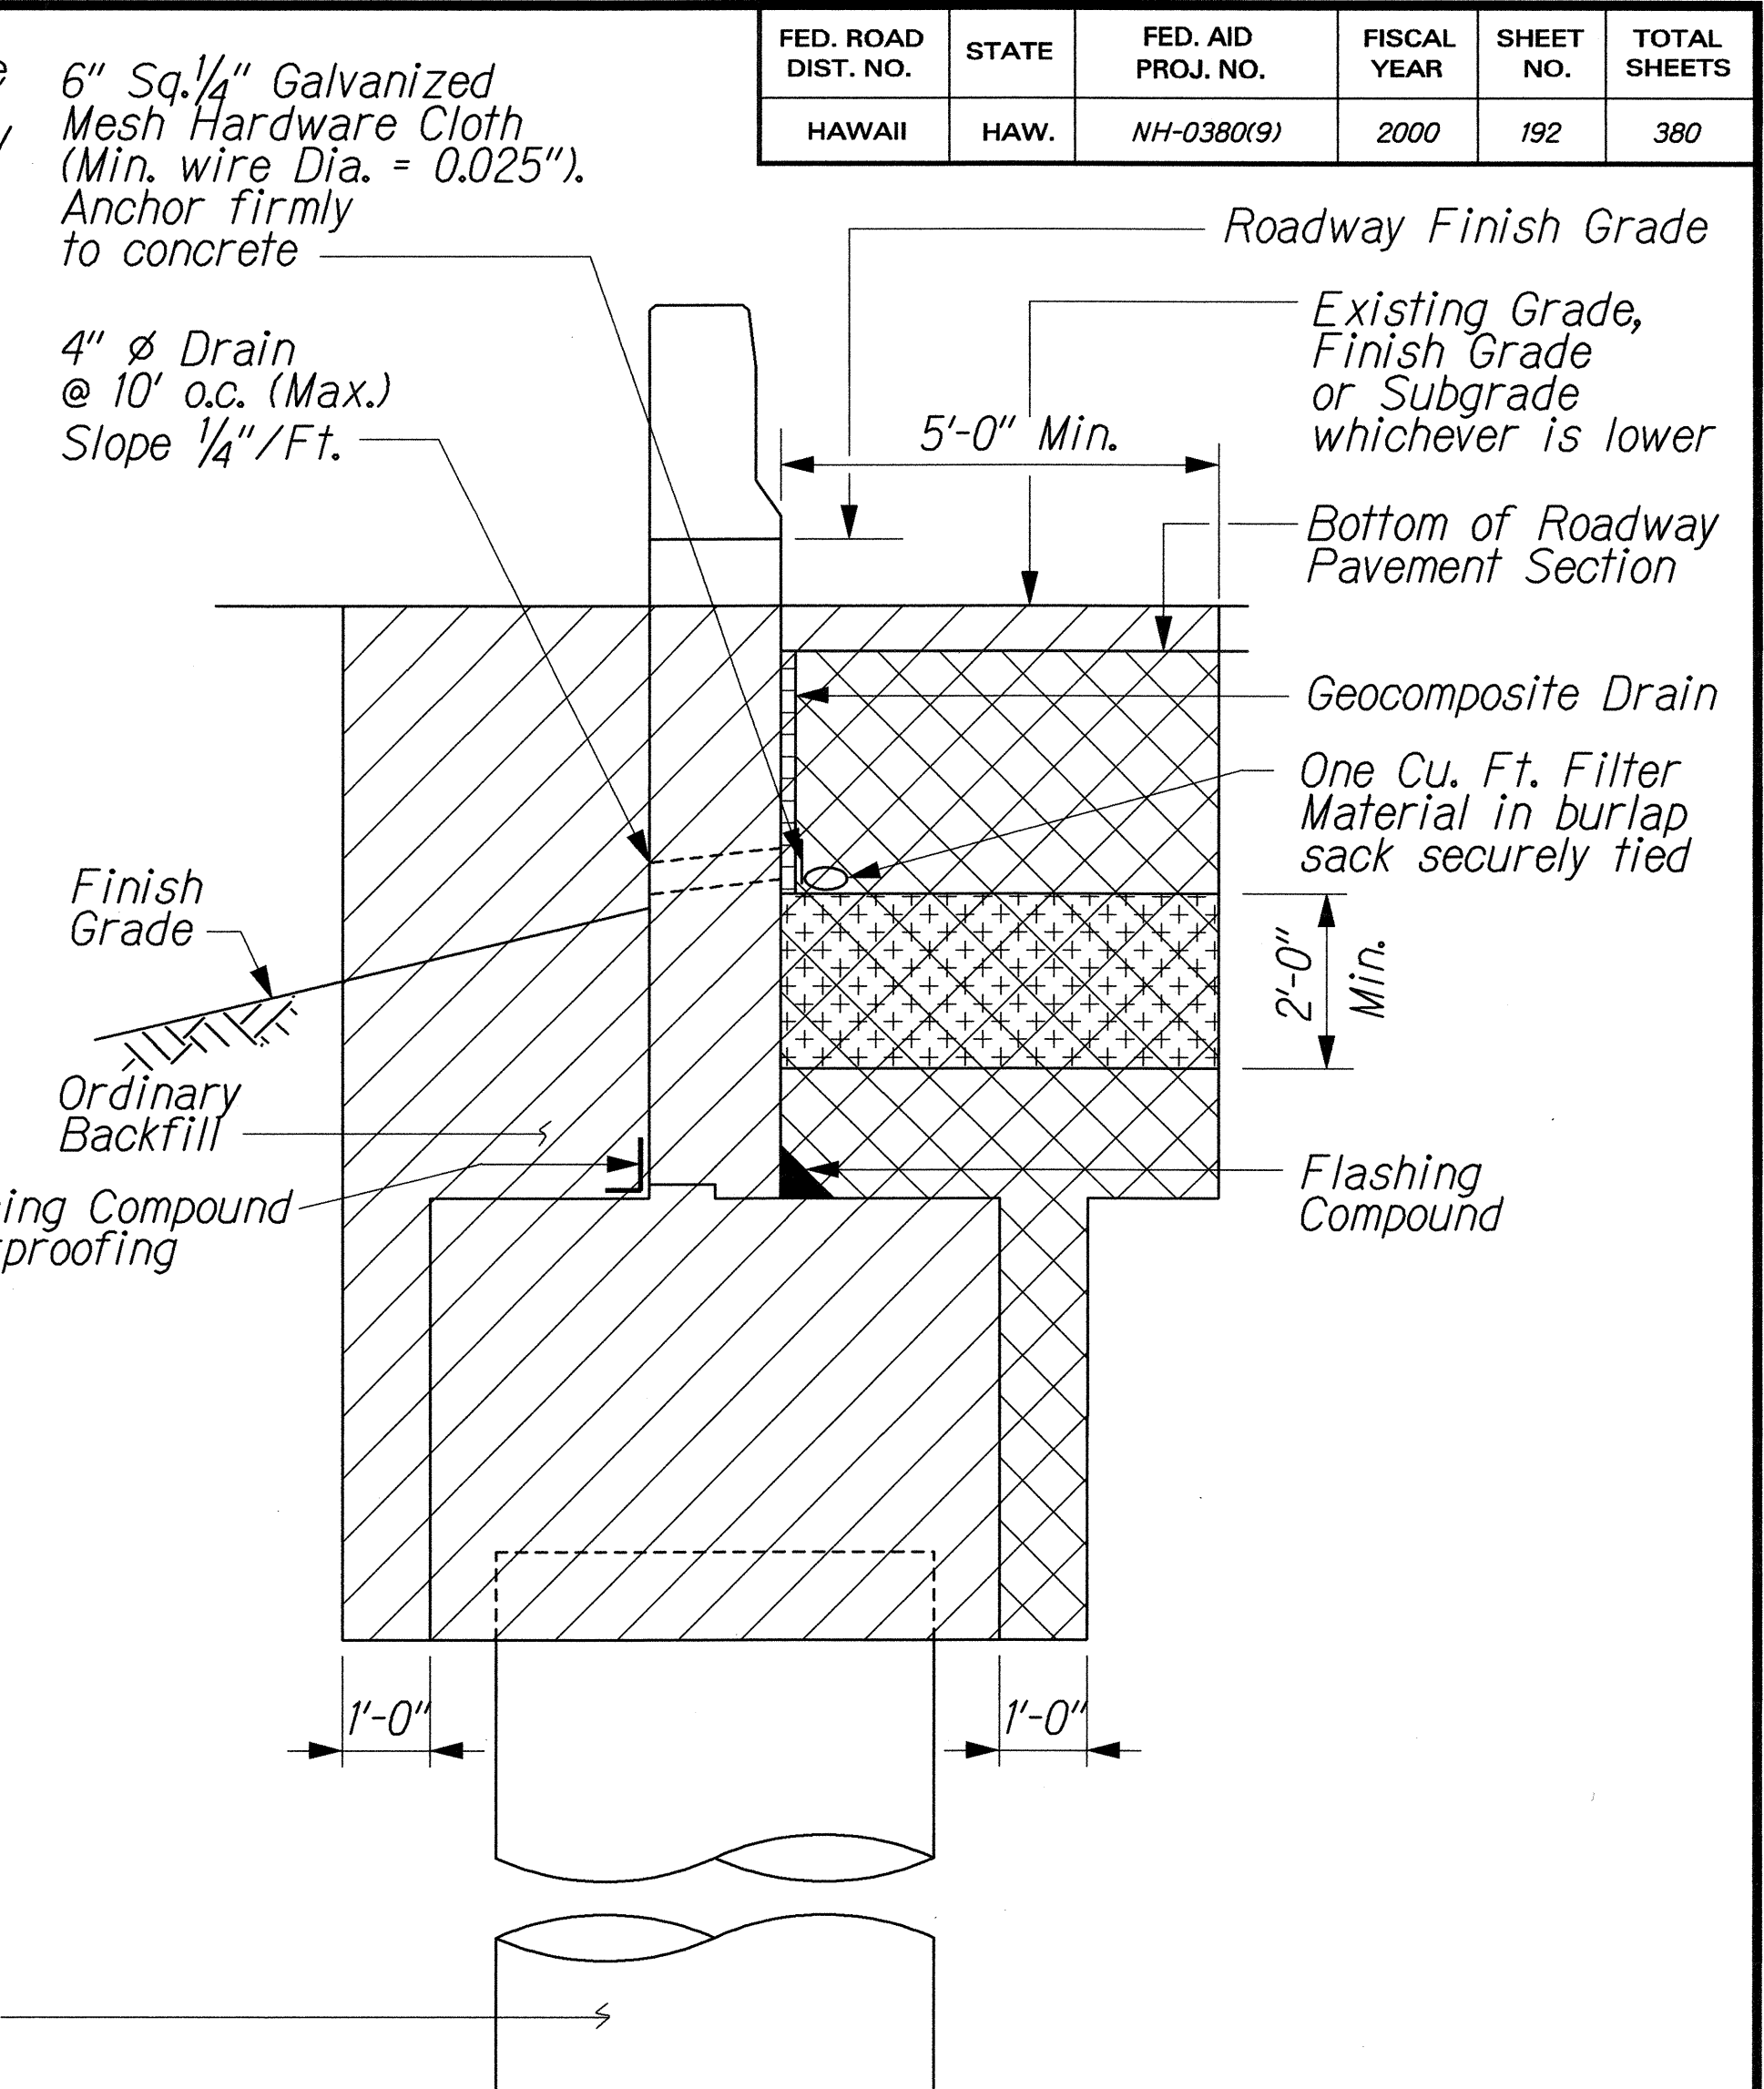

WINGWALL SECTION ON DRILLED SHAFT

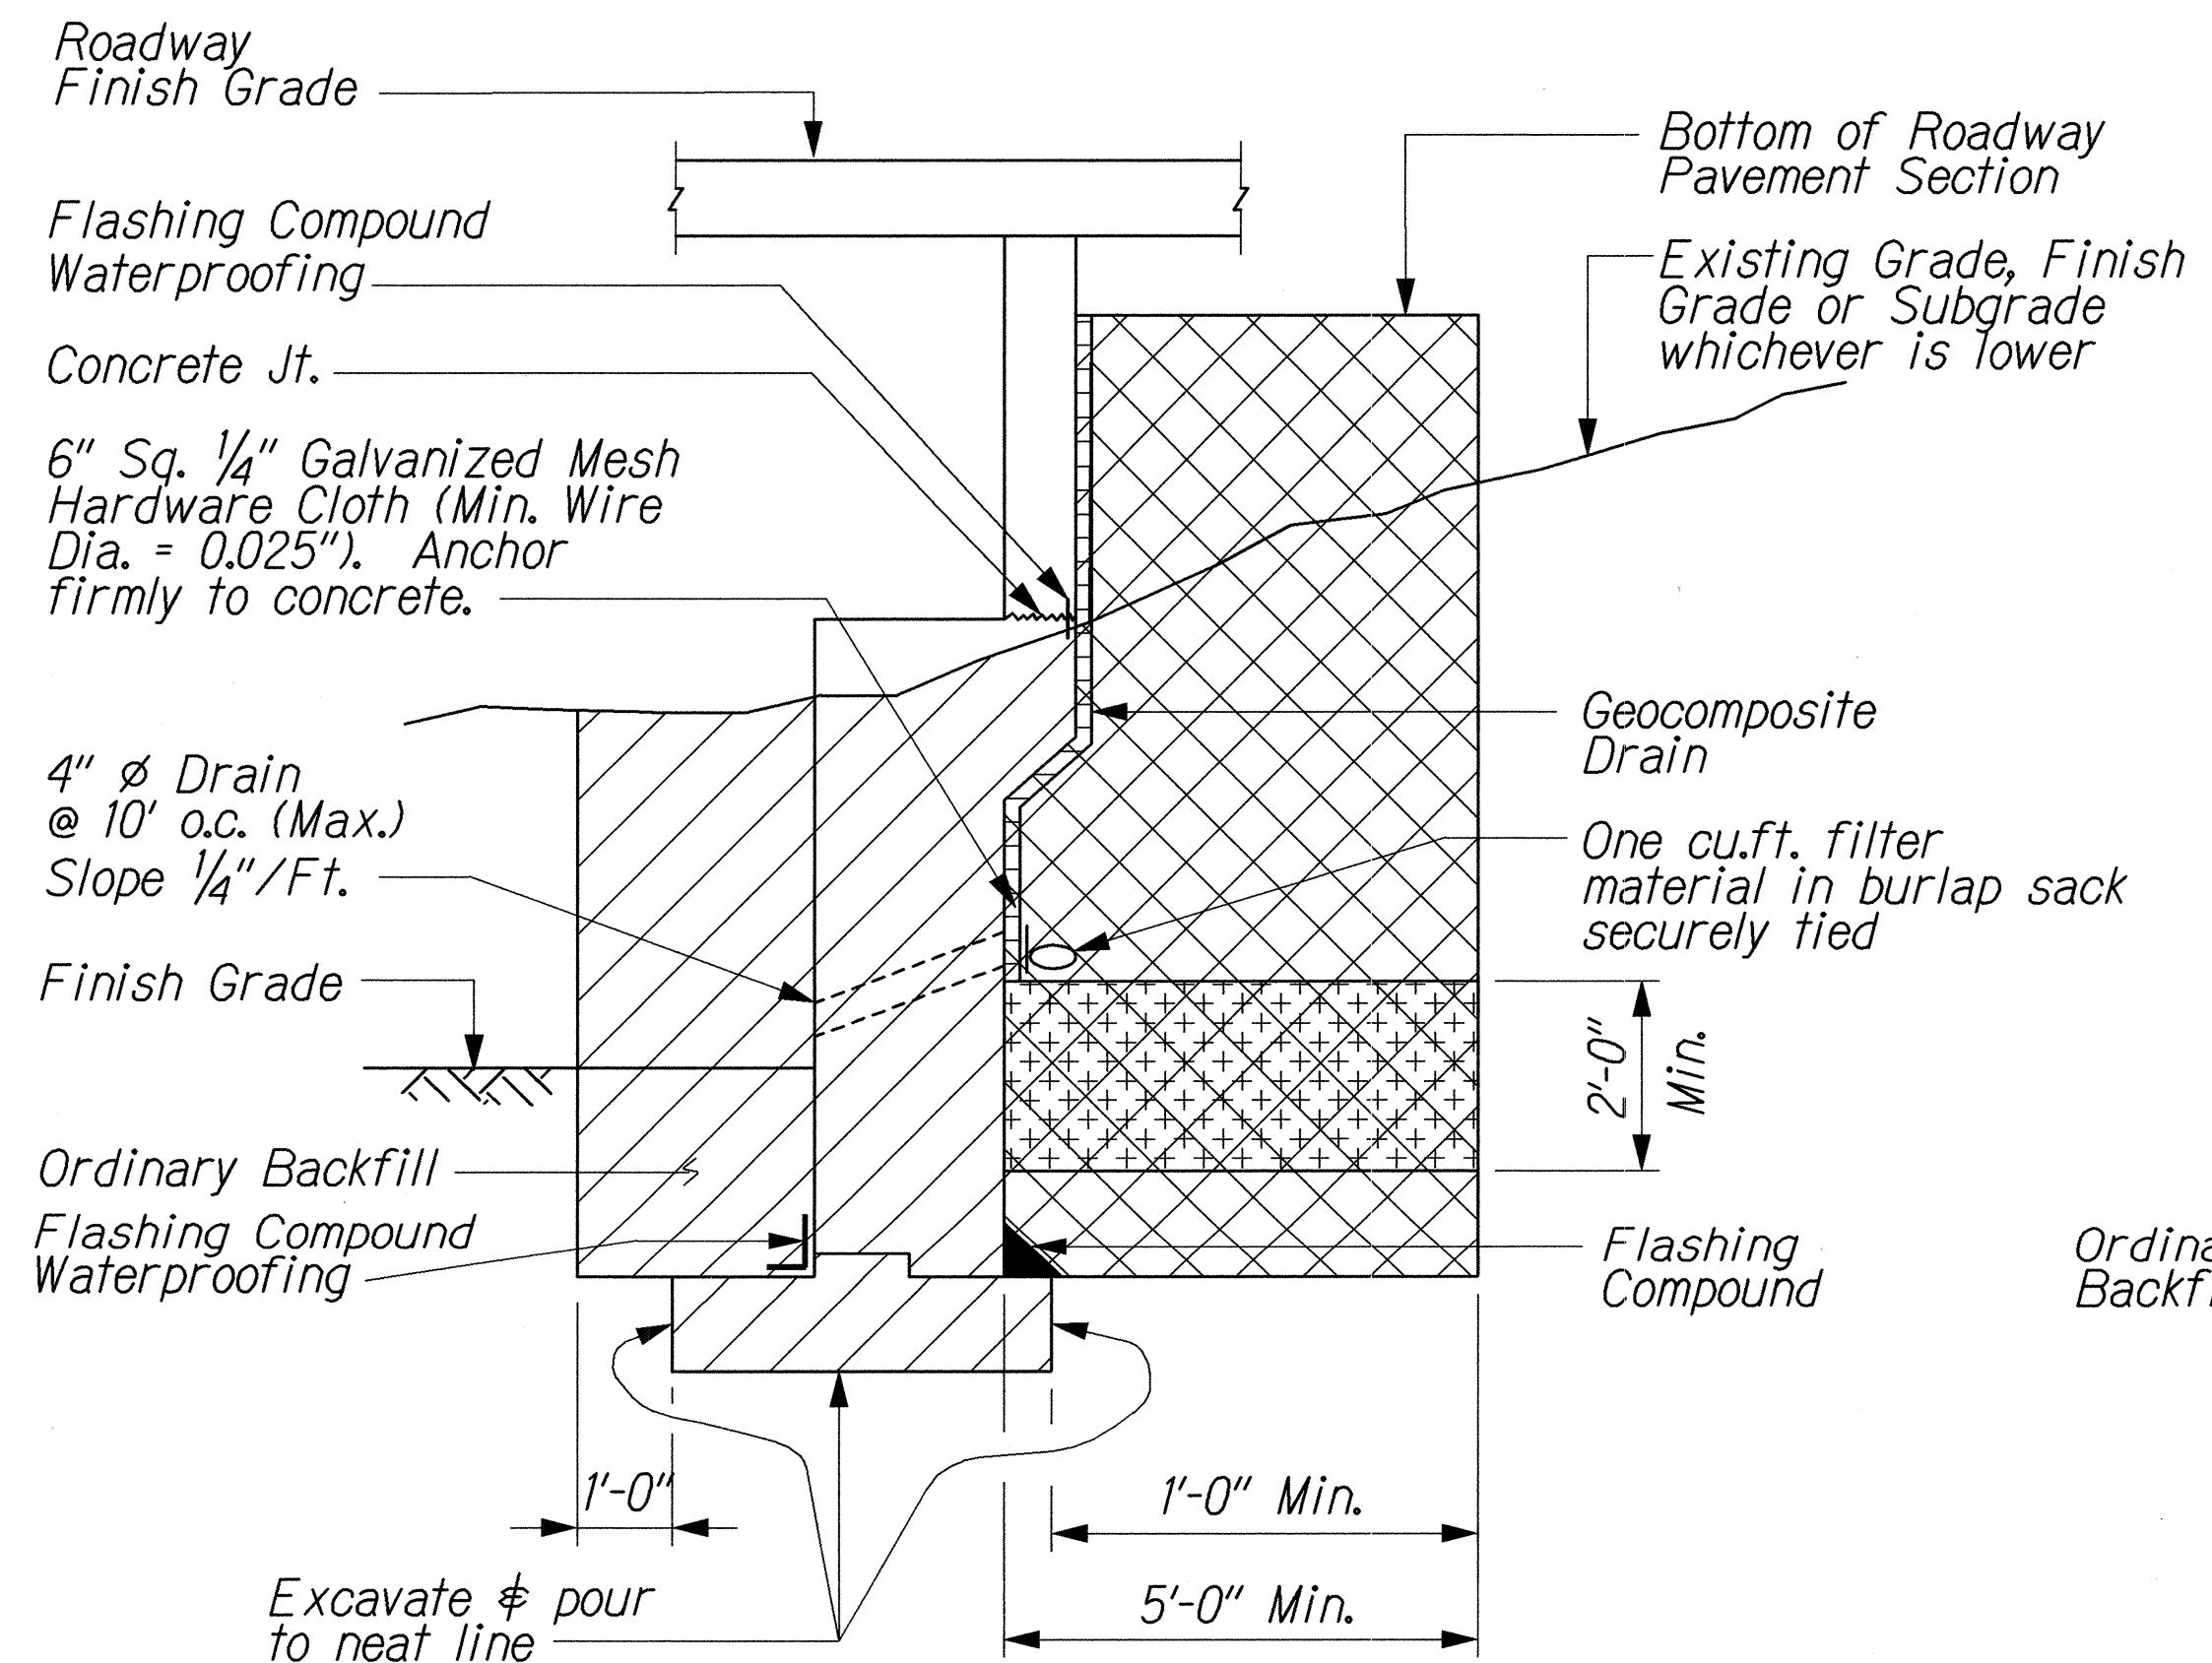

ABUTMENT ON SPREAD FOOTING

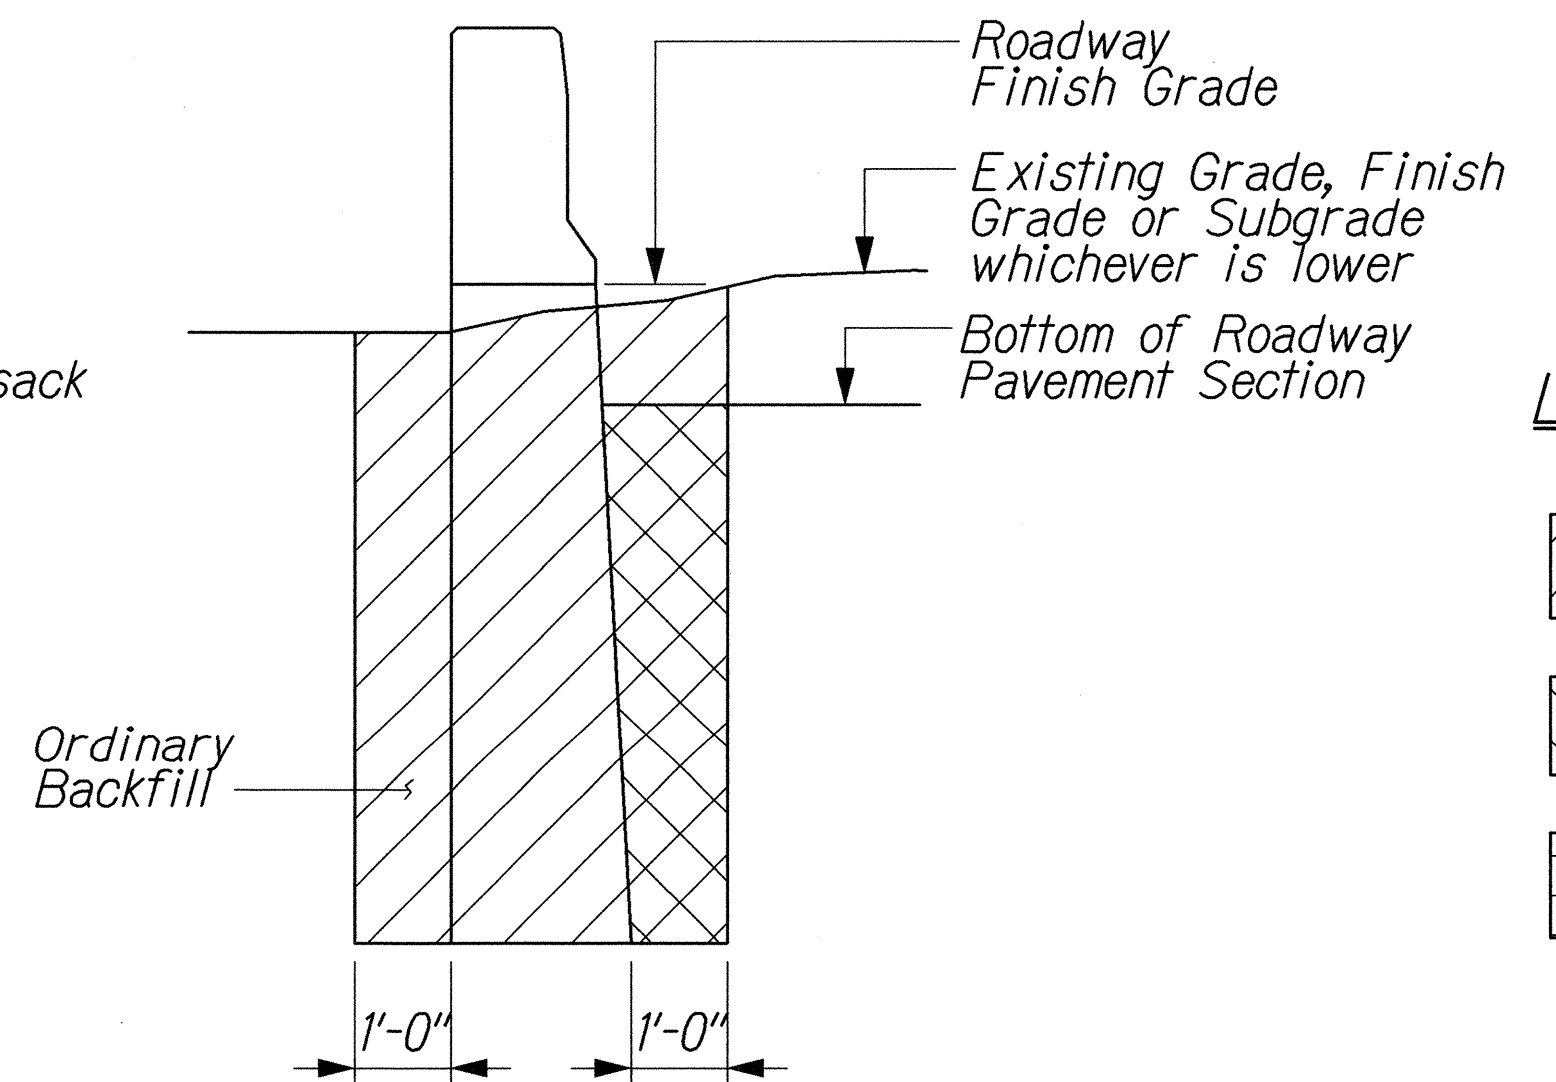

CANTILEVERED WINGWALL SECTION

LEGEND:

- Structure Excavation
- Structure Backfill
- Impervious Material to be incidental to structure

NOTES:

- The one cubic foot filter material in burlap sack and the 6" sq. 1/4" galv. mesh hardware cloth and 4" Ø drain shall be incidental to Geocomposite Drain and will not be paid for separately.
- For Flashing Compound Waterproofing Details, See Sht. No. S-36.

DATE	_____
DESIGNED BY	_____
CHECKED BY	_____
ORIGINAL PLAN	_____
NOTE BOOK	_____
QUANTITIES BY	_____
NO.	_____

3/2 KUIHELANI/STRUCT/EXBAK-DET100

THIS WORK WAS PREPARED BY ME OR UNDER MY SUPERVISION.

Kui Pang Chen

STATE OF HAWAII
DEPARTMENT OF TRANSPORTATION
HIGHWAYS DIVISION

EXCAVATION AND BACKFILL

PAYMENT LIMITS

KUIHELANI HIGHWAY WIDENING
HONOAPIILANI HIGHWAY TO PUUNENE AVENUE
FEDERAL-AID PROJECT NO. NH-0380(9)
Scale: 1/2" = 1'-0" Date: Sept. 14, 2001

FED. ROAD DIST. NO.	STATE	FED. AID PROJ. NO.	FISCAL YEAR	SHEET NO.	TOTAL SHEETS
HAWAII	HAW.	NH-0380(9)	2000	194	380

Metal guardrail connection ref. line #
 ϕ 2-3/4" holes for 3/8" H.S. anchor bolts
w/ bevel cap P, nut & washer.

ϕ 5-1" holes for 7/8" H.S. anchor bolts w/
bevel cap P, nut & washer. See thrie beam
terminal connector detail for spacing.






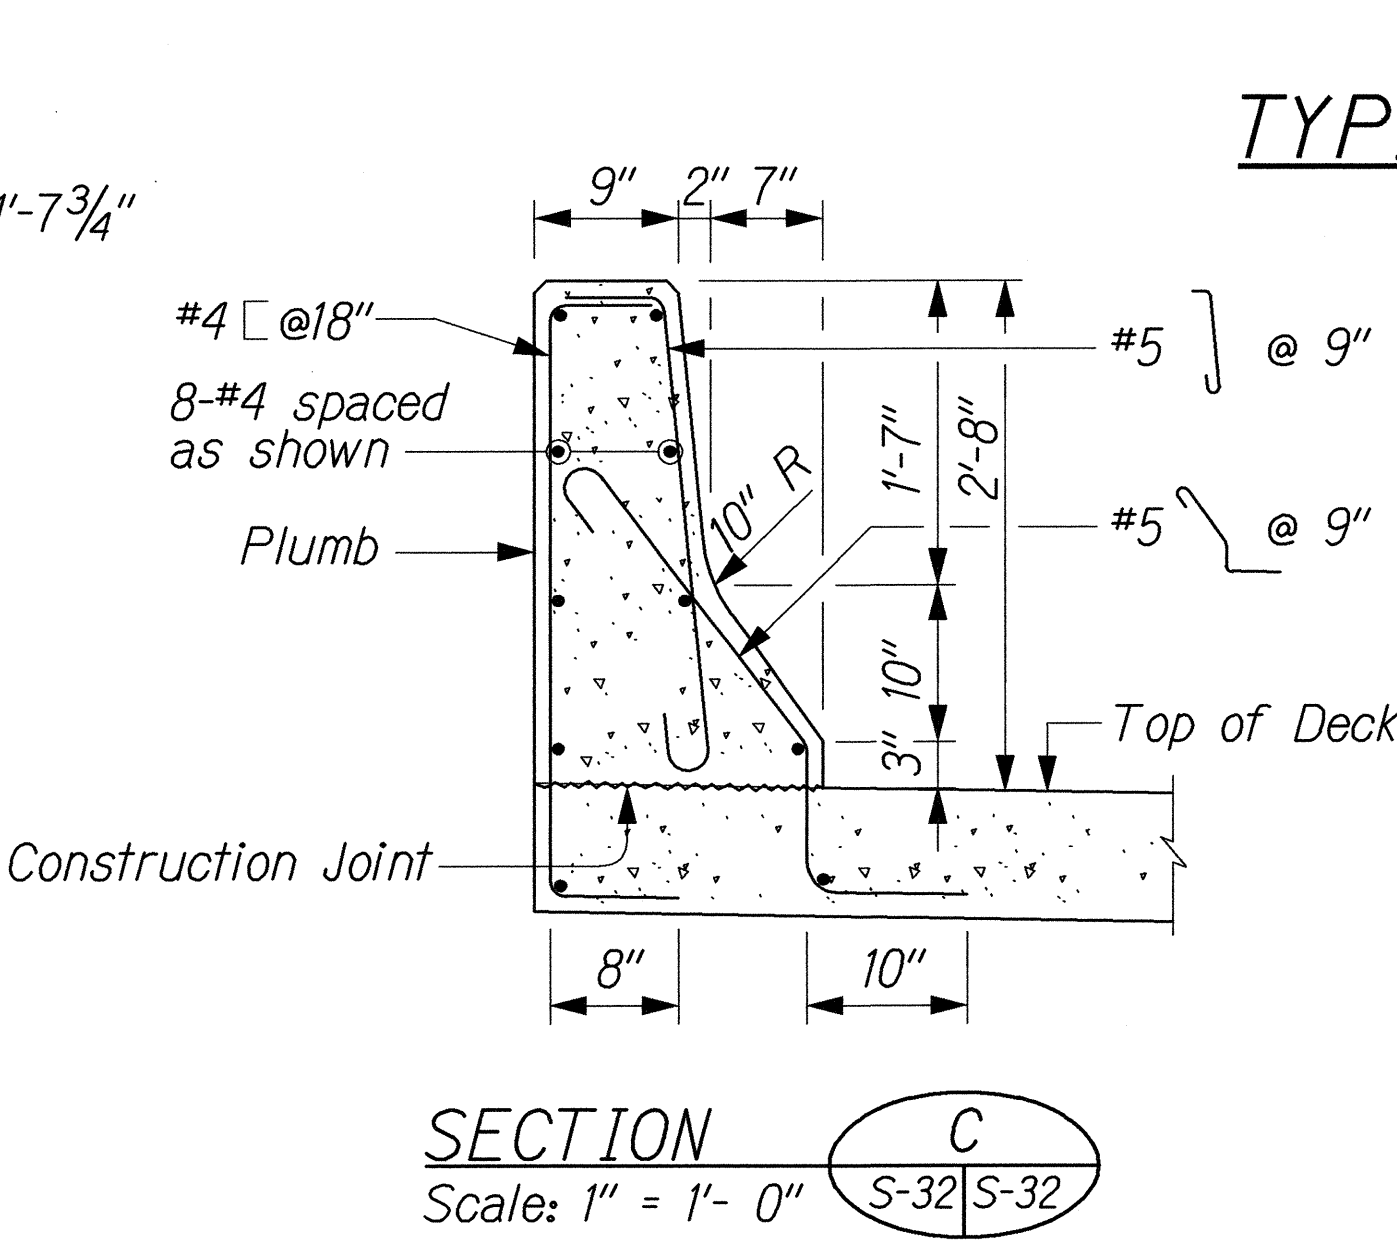


TABLE 1
Portion of Concrete Railing Transition Length On Bridge

Bridge	Locations	L
Palaahu Stream Bridge	Wingwall No. 1	3'-0"
	Wingwall No. 2	3'-0"
	Wingwall No. 3	3'-0"
	Wingwall No. 4	3'-0"
Waikapu Stream Bridge	Wingwall No. 1	0'-0"
	Wingwall No. 2	0'-0"
	Wingwall No. 3	0'-0"
	Wingwall No. 4	0'-0"
Waihee Ditch Bridge	Wingwall No. 1	6'-0"
	Wingwall No. 2	6'-0"
	Wingwall No. 3	6'-0"
	Wingwall No. 4	6'-0"
Kuihelani Three Span Culvert	CRM Wall 'A'	18'-0"
	Wingwall No. 2	6'-0"
	Wingwall No. 3	0'-0"
	Wingwall No. 4	0'-0"

NOTE 1:
1. For Letter size and detail
See Std. Plan B-01.

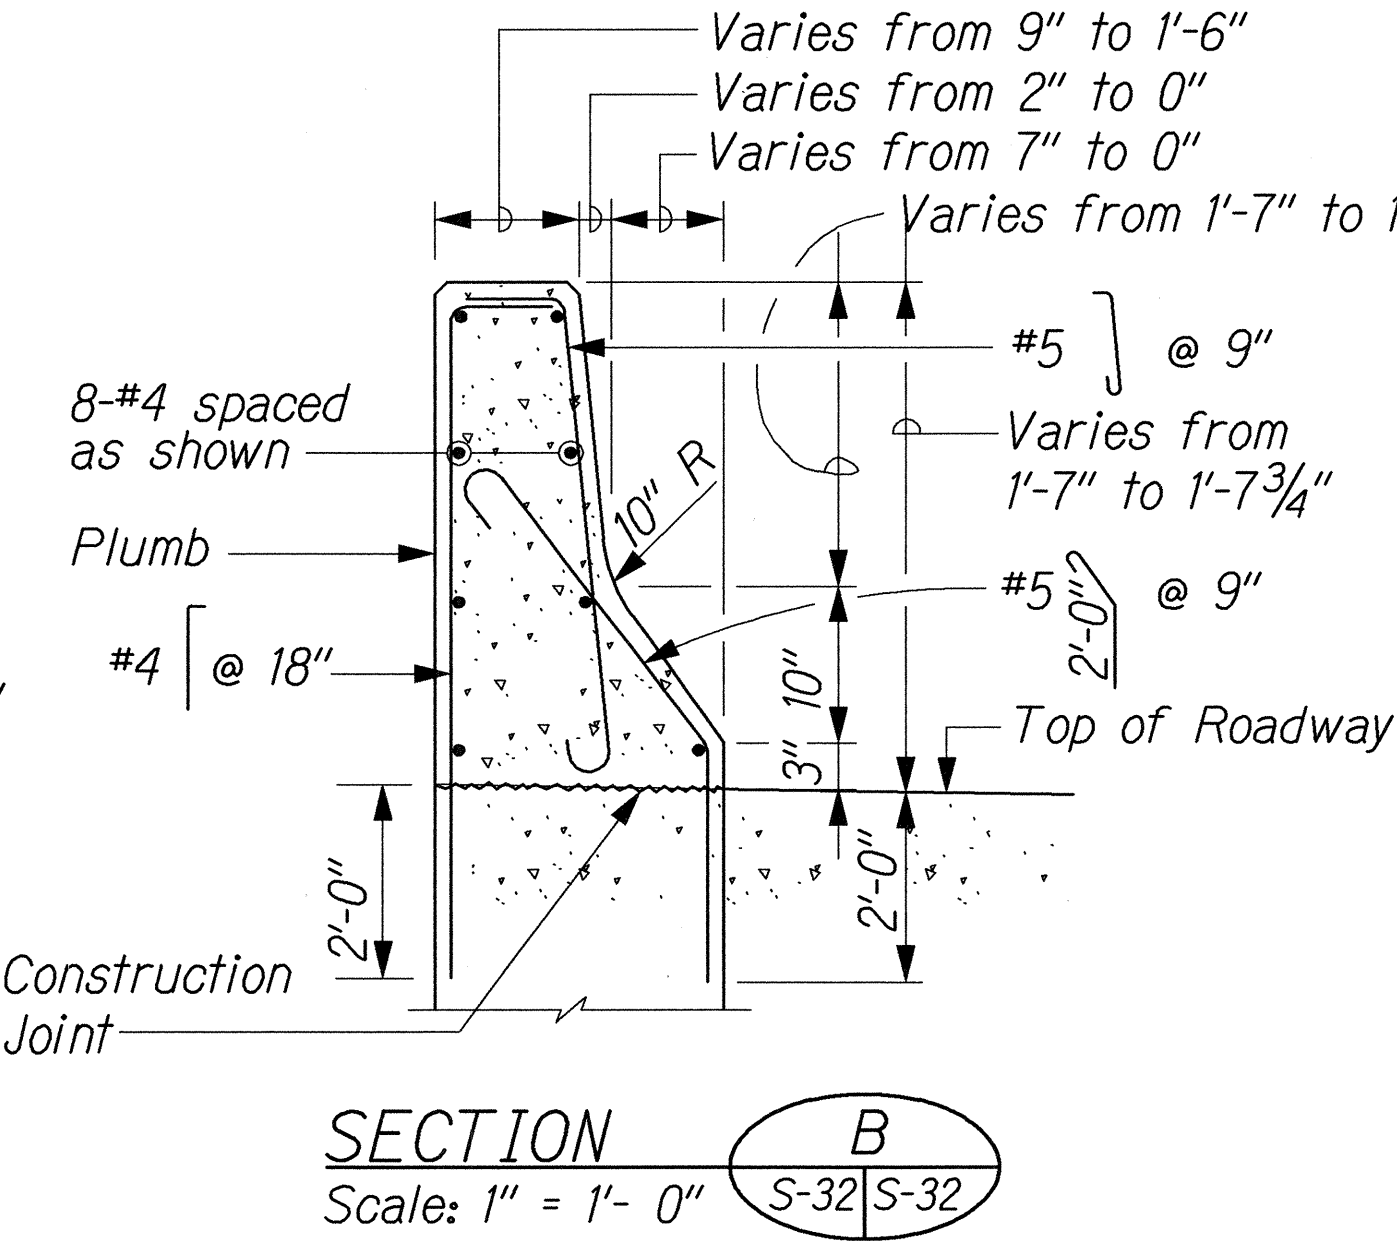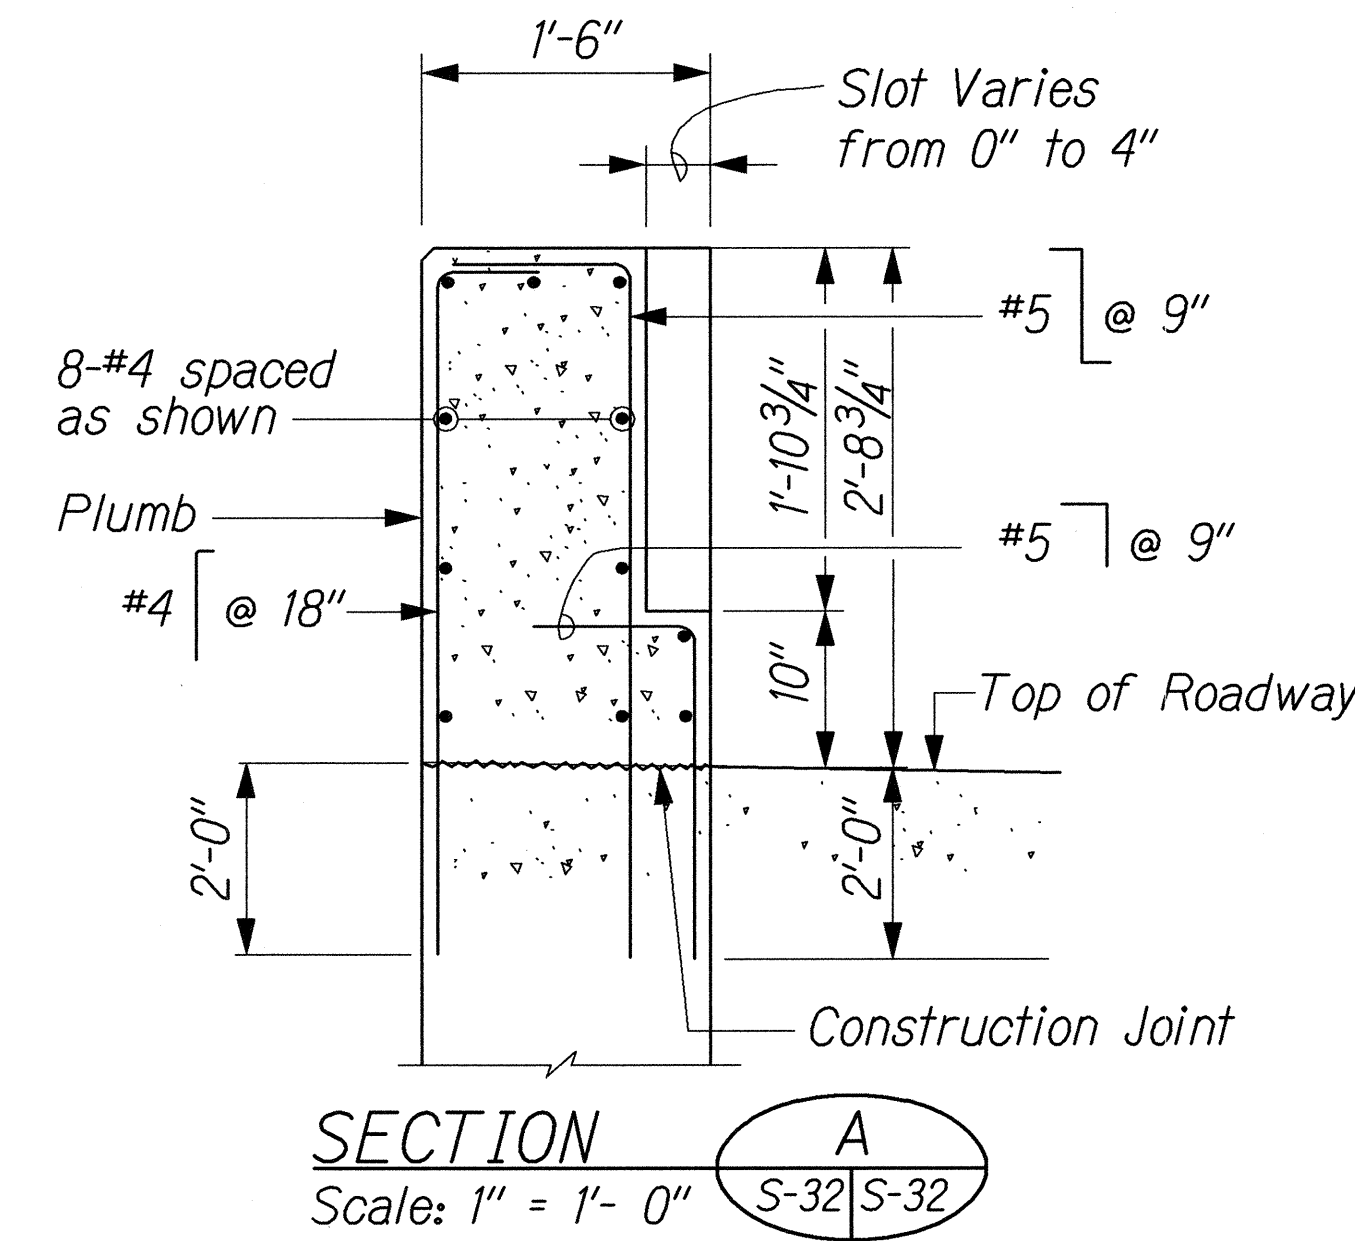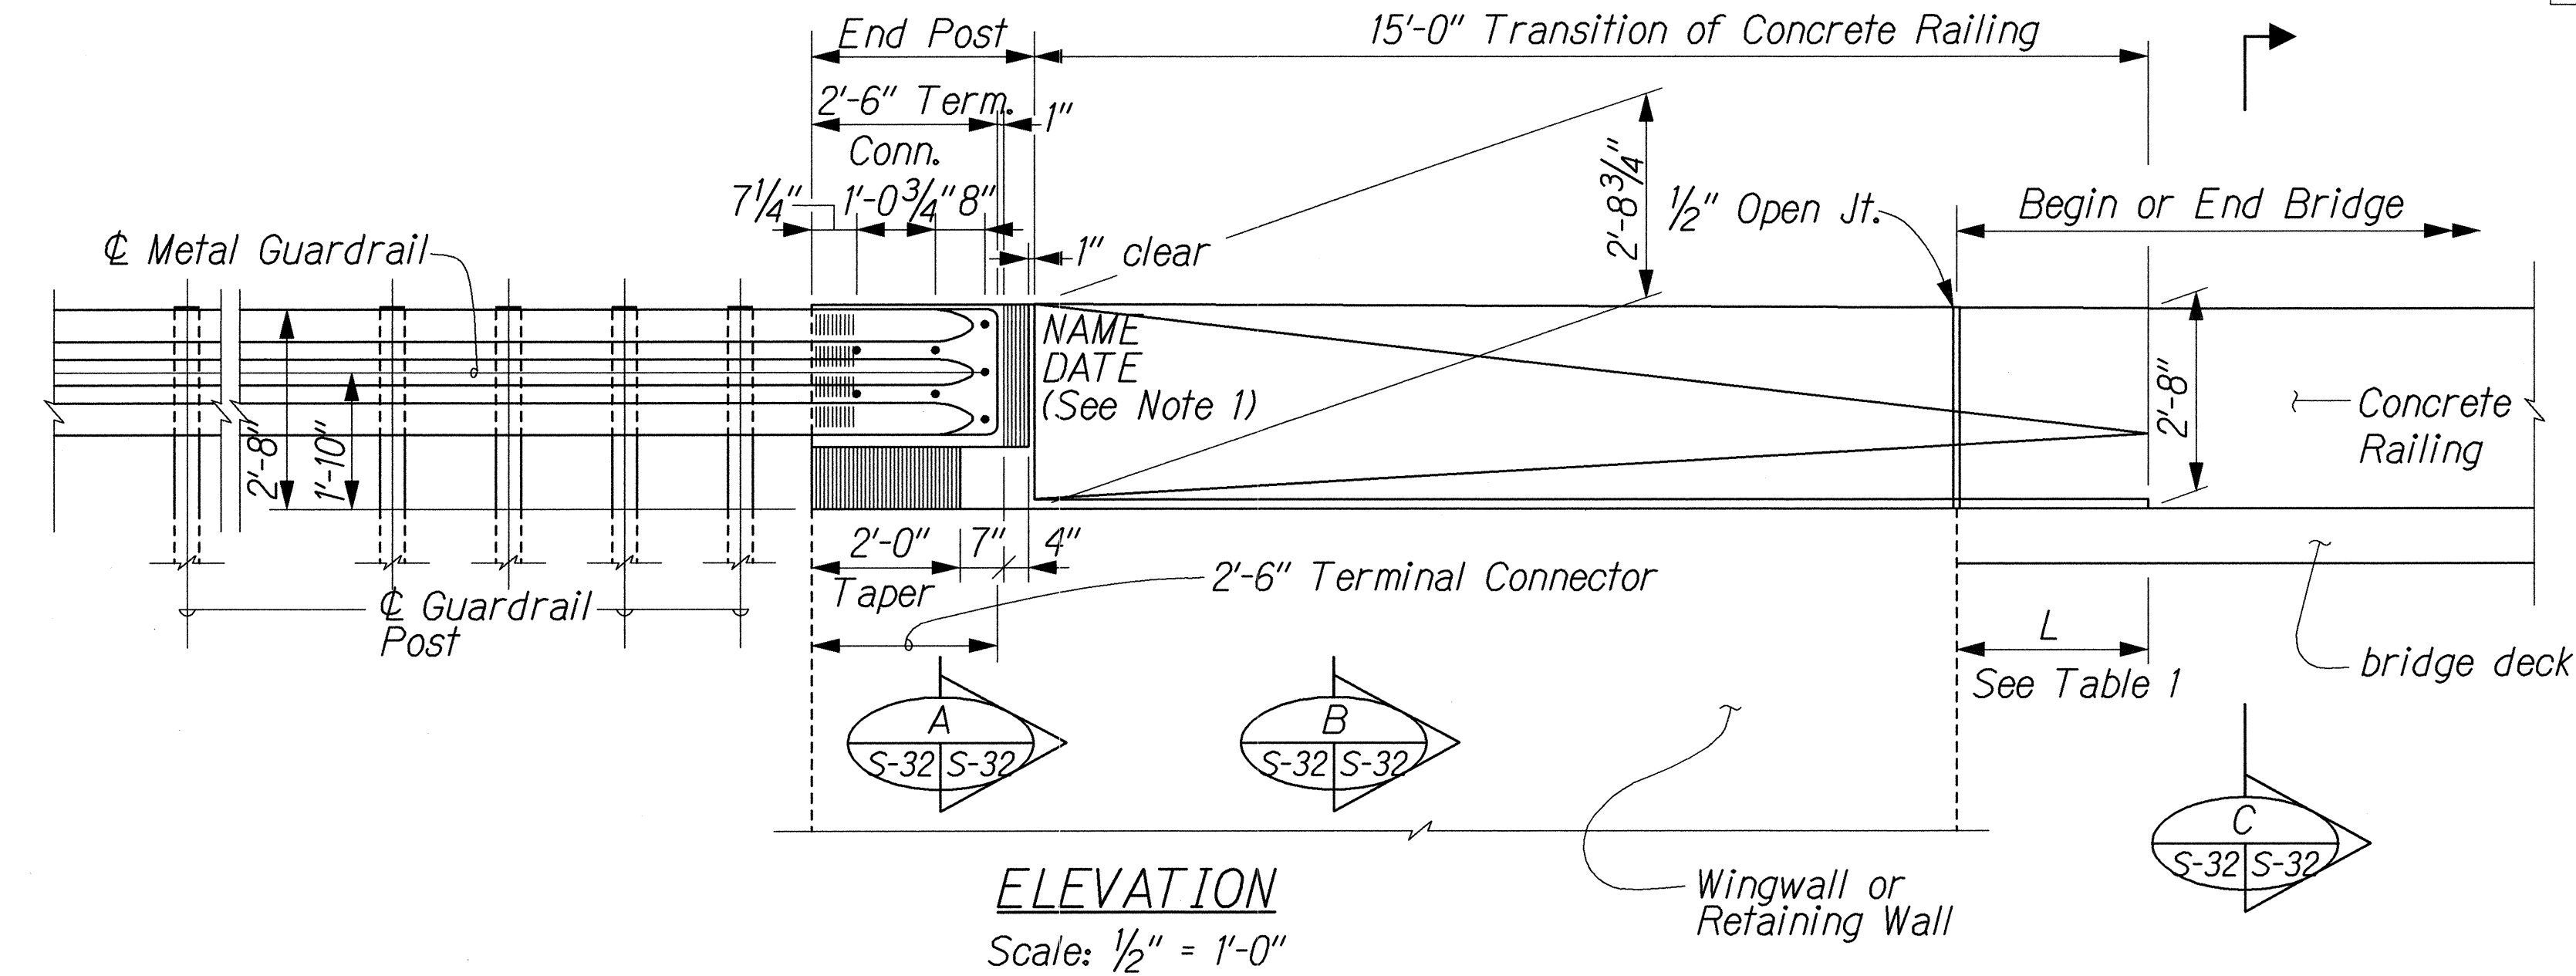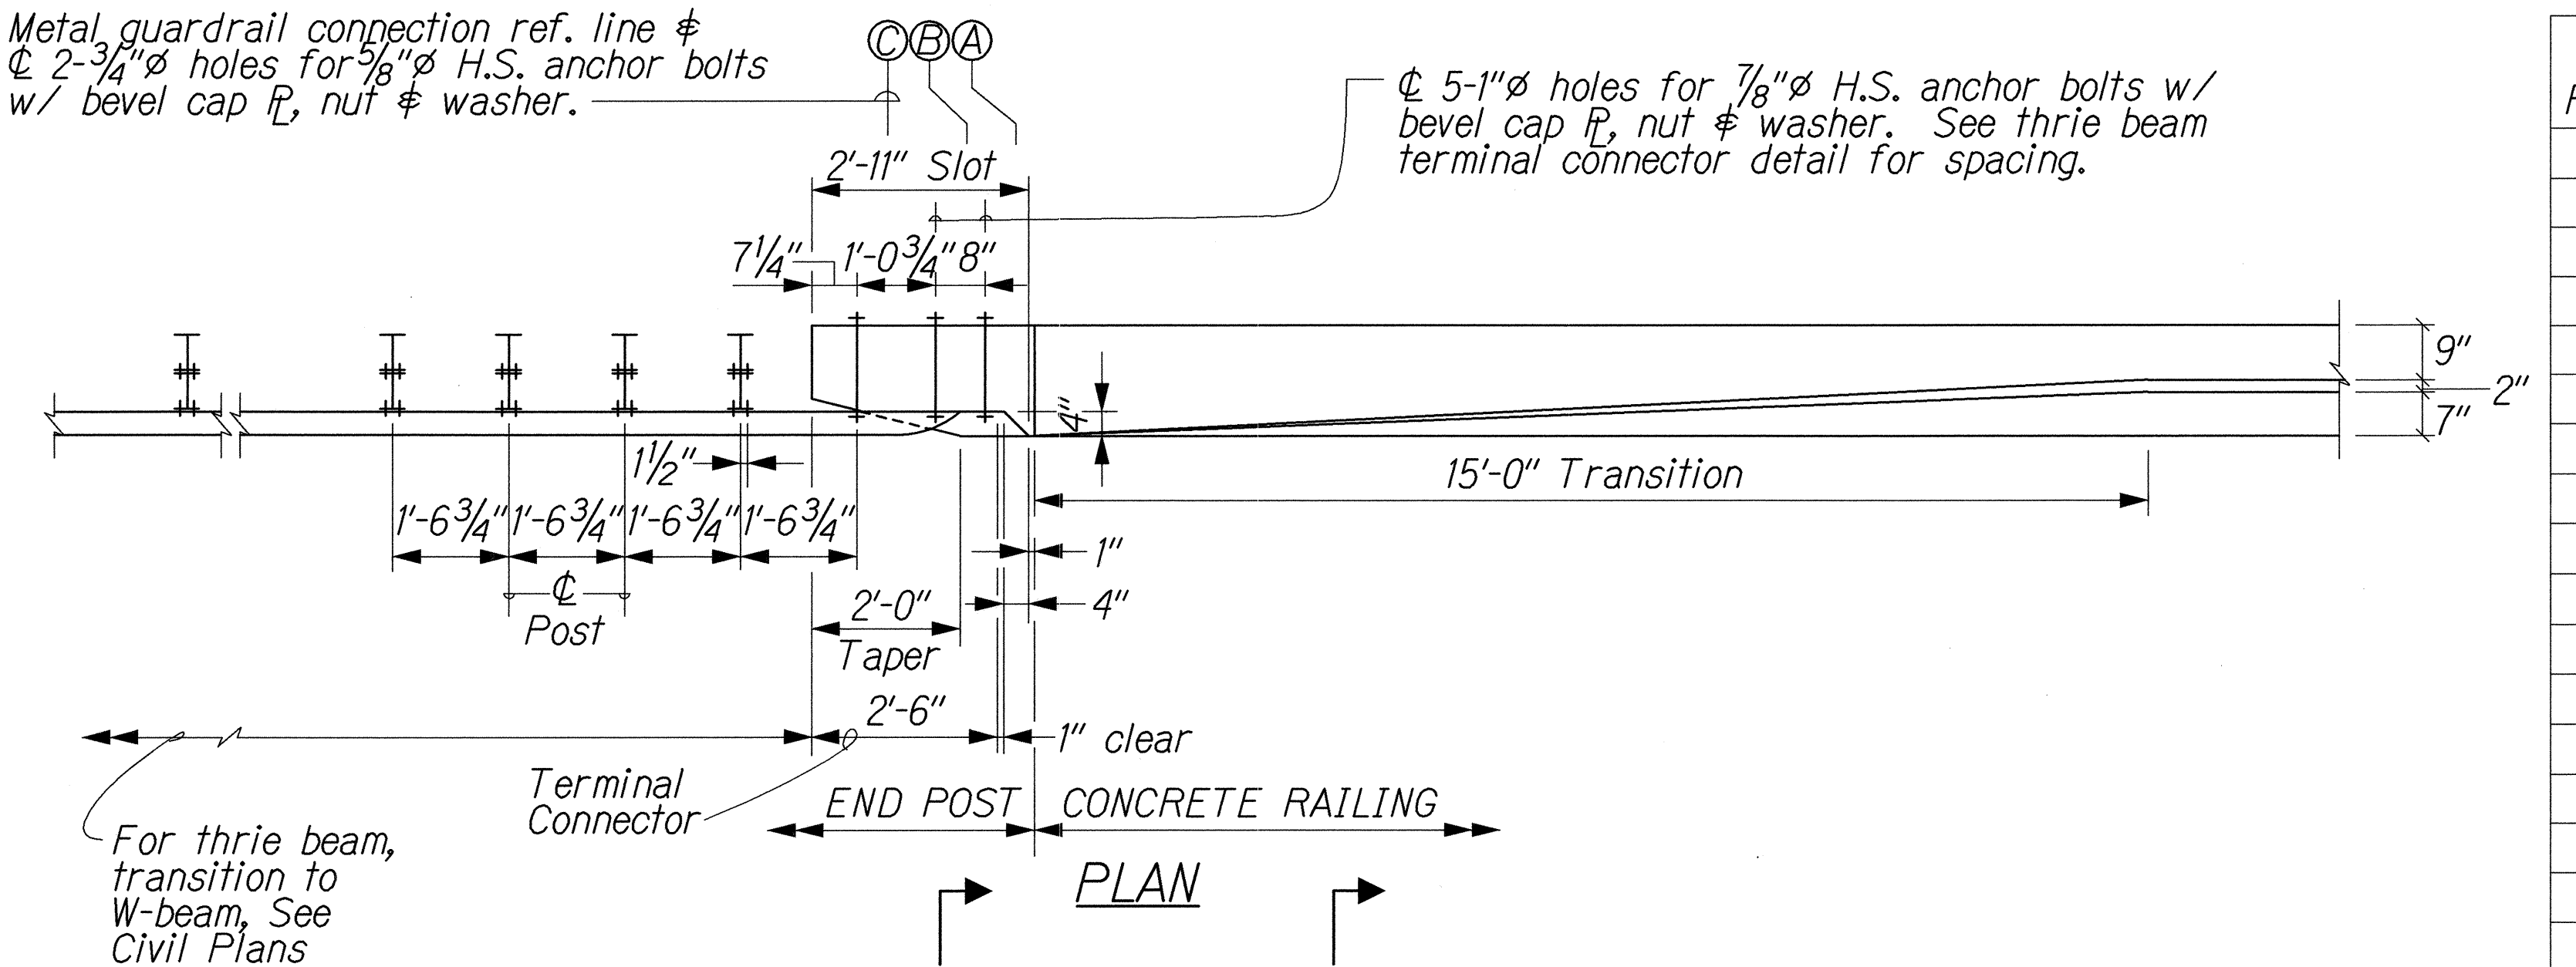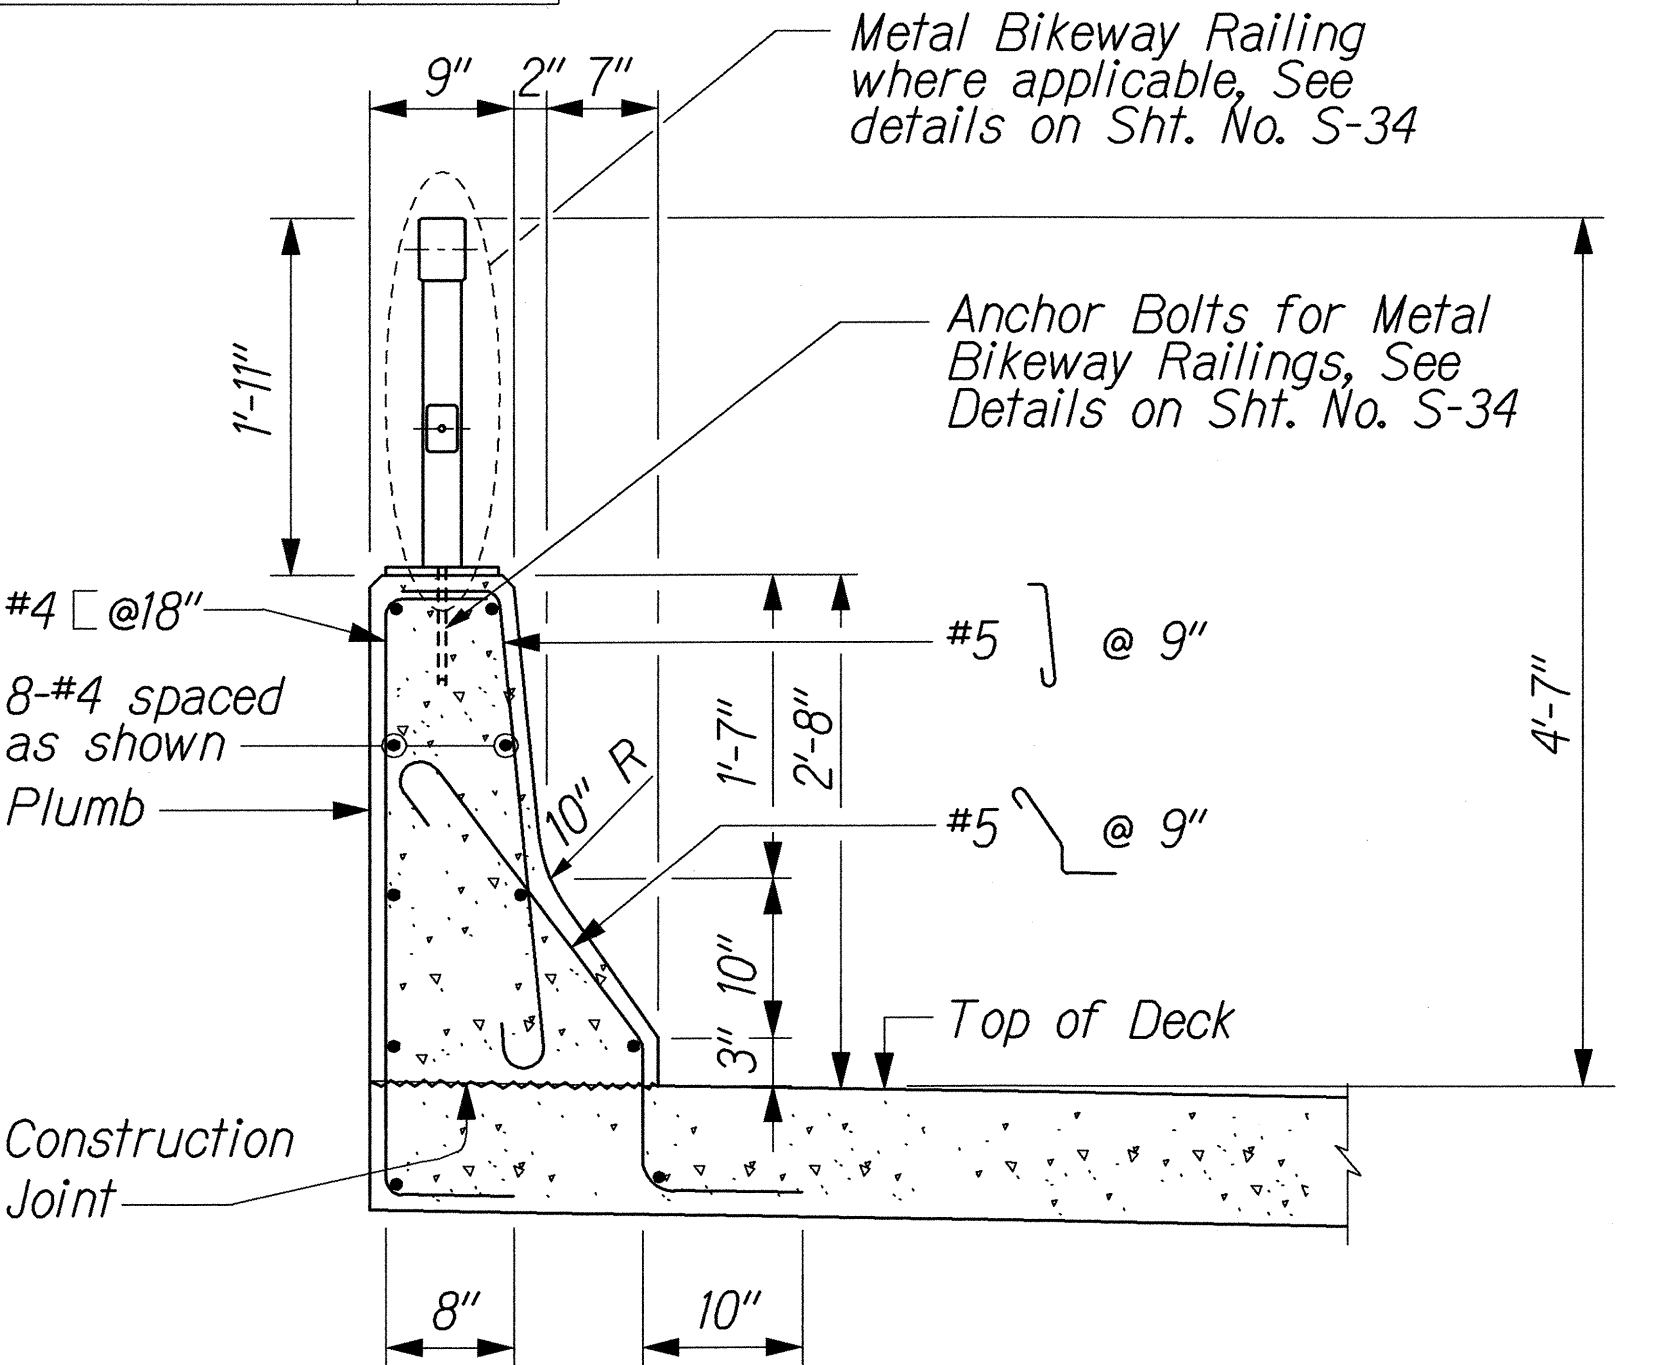

TYPICAL SECTION CONCRETE RAILING
Scale: 1" = 1'-0"

SURVEY PLOTTED BY	DATE
DRAWN BY	
DESIGNED BY	
CHECKED BY	
NOTE BOOK	
NO.	

66/KUIHELANI/STRUCT/ST-BET2dgn




THIS WORK WAS PREPARED BY ME
OR UNDER MY SUPERVISION.
Kui Pang Chen

STATE OF HAWAII
DEPARTMENT OF TRANSPORTATION
HIGHWAYS DIVISION


CONCRETE RAILING DETAILS

KUIHELANI HIGHWAY WIDENING
HONOAPIILANI HIGHWAY TO PUUNENE AVENUE
FEDERAL-AID PROJECT NO. NH-0380(9)
Scale: As Shown Date: Sept. 14, 2001

FED. ROAD DIST. NO.	STATE	FED. AID PROJ. NO.	FISCAL YEAR	SHEET NO.	TOTAL SHEETS
HAWAII	HAW.	NH-0380(9)	2000	195	380

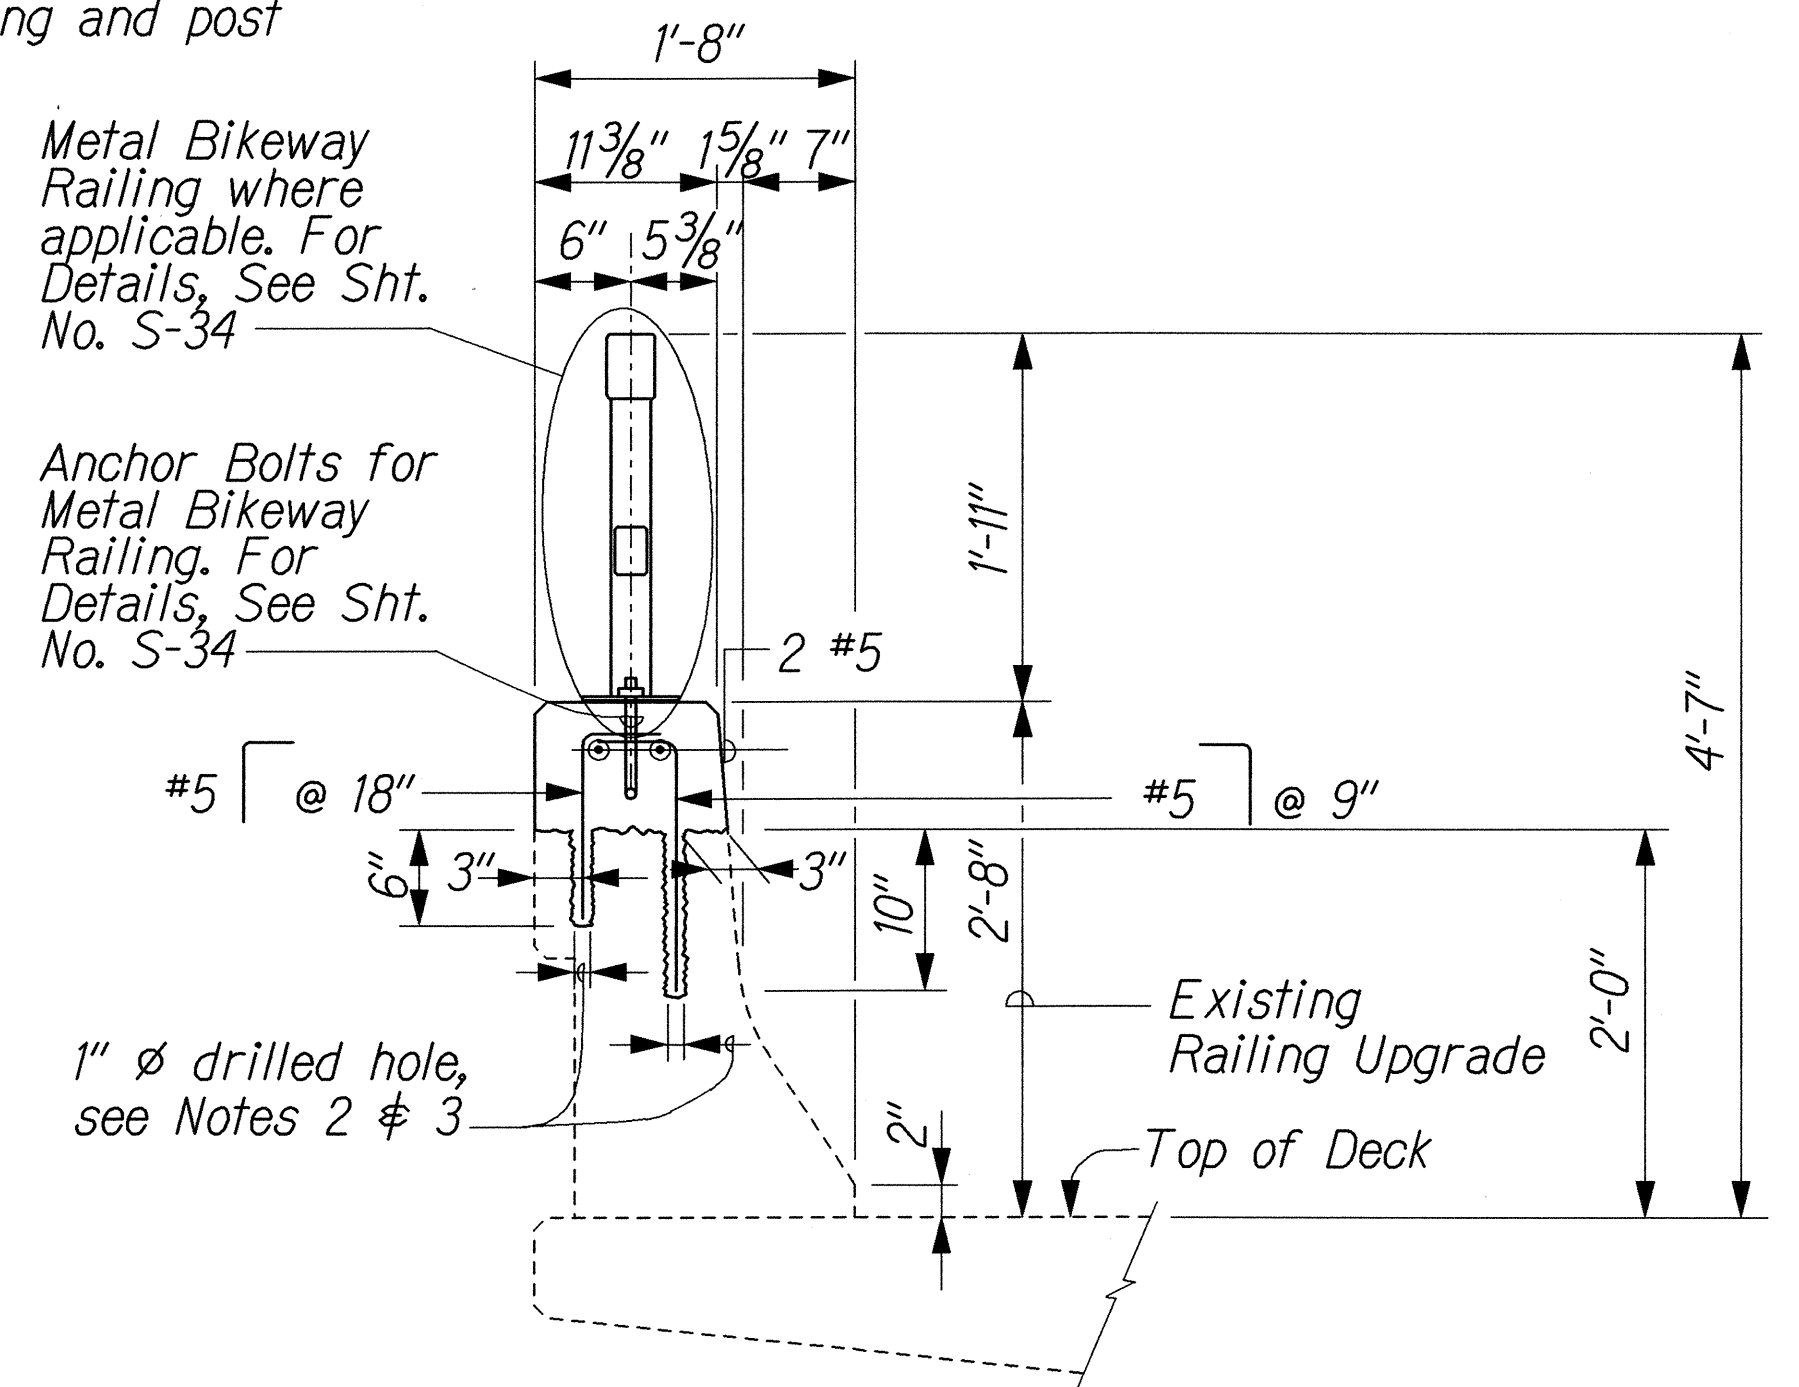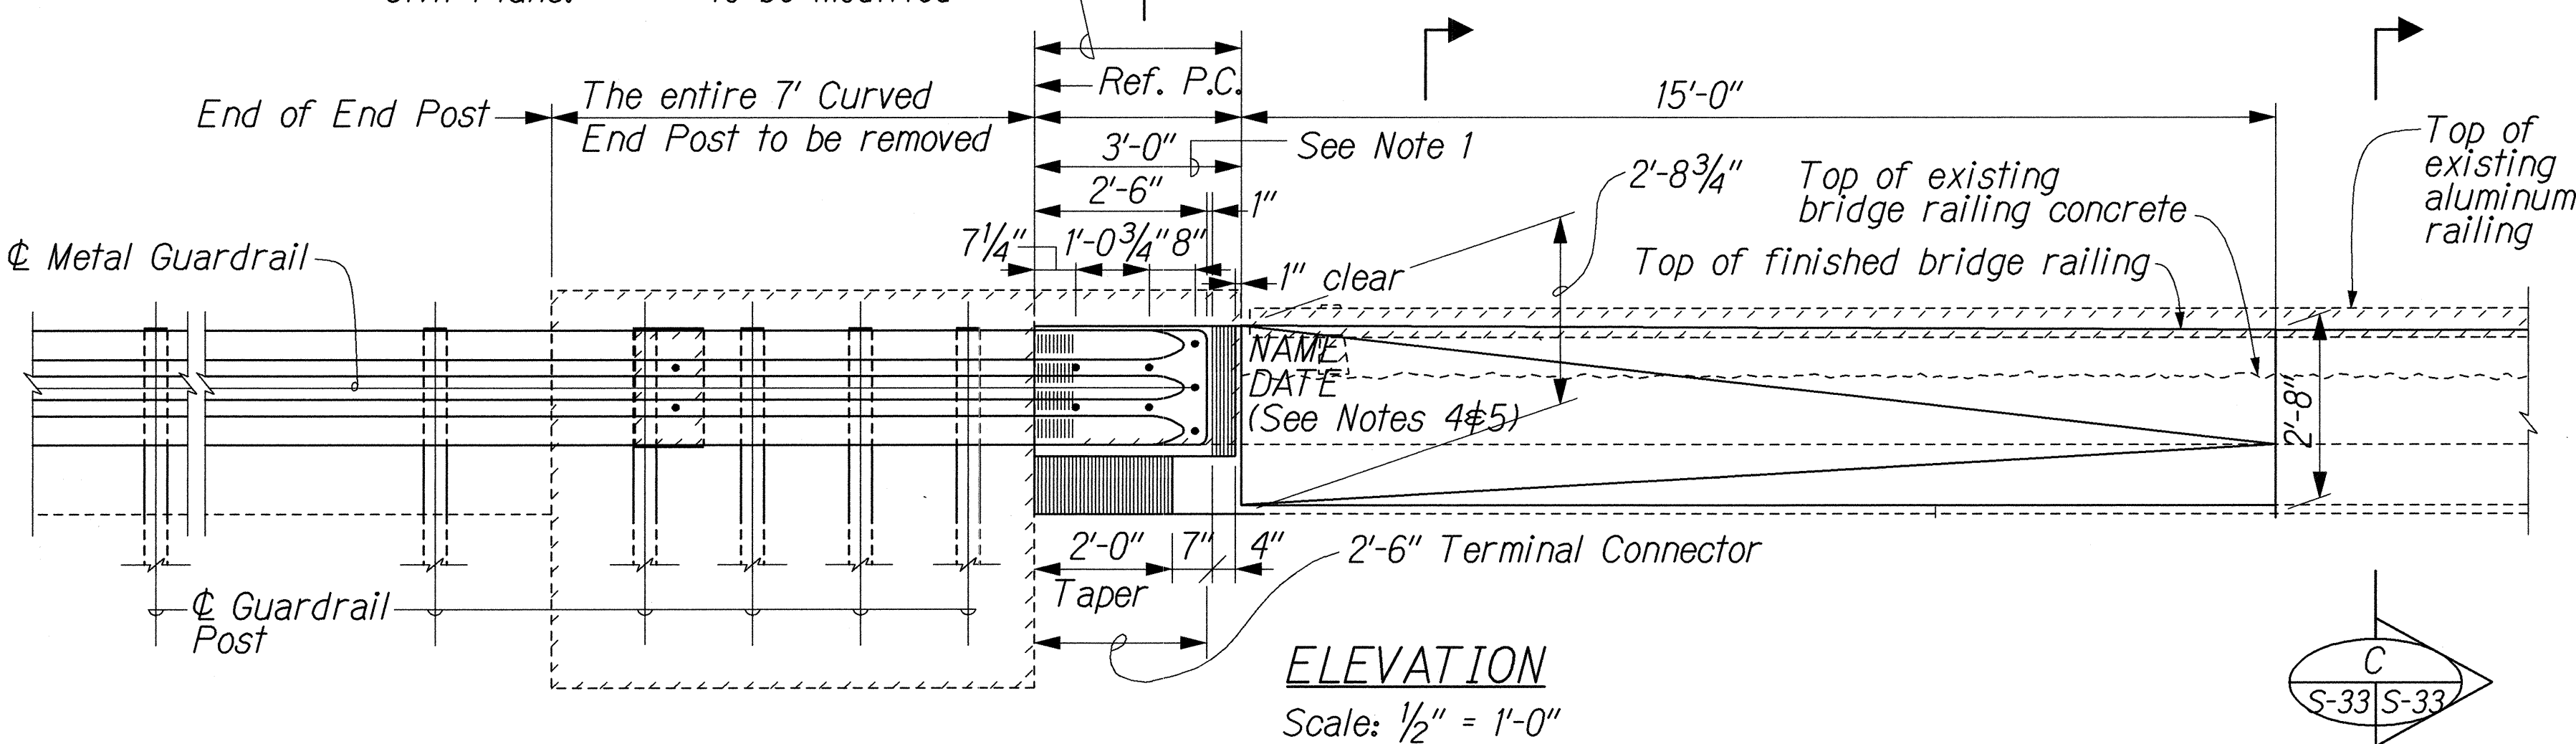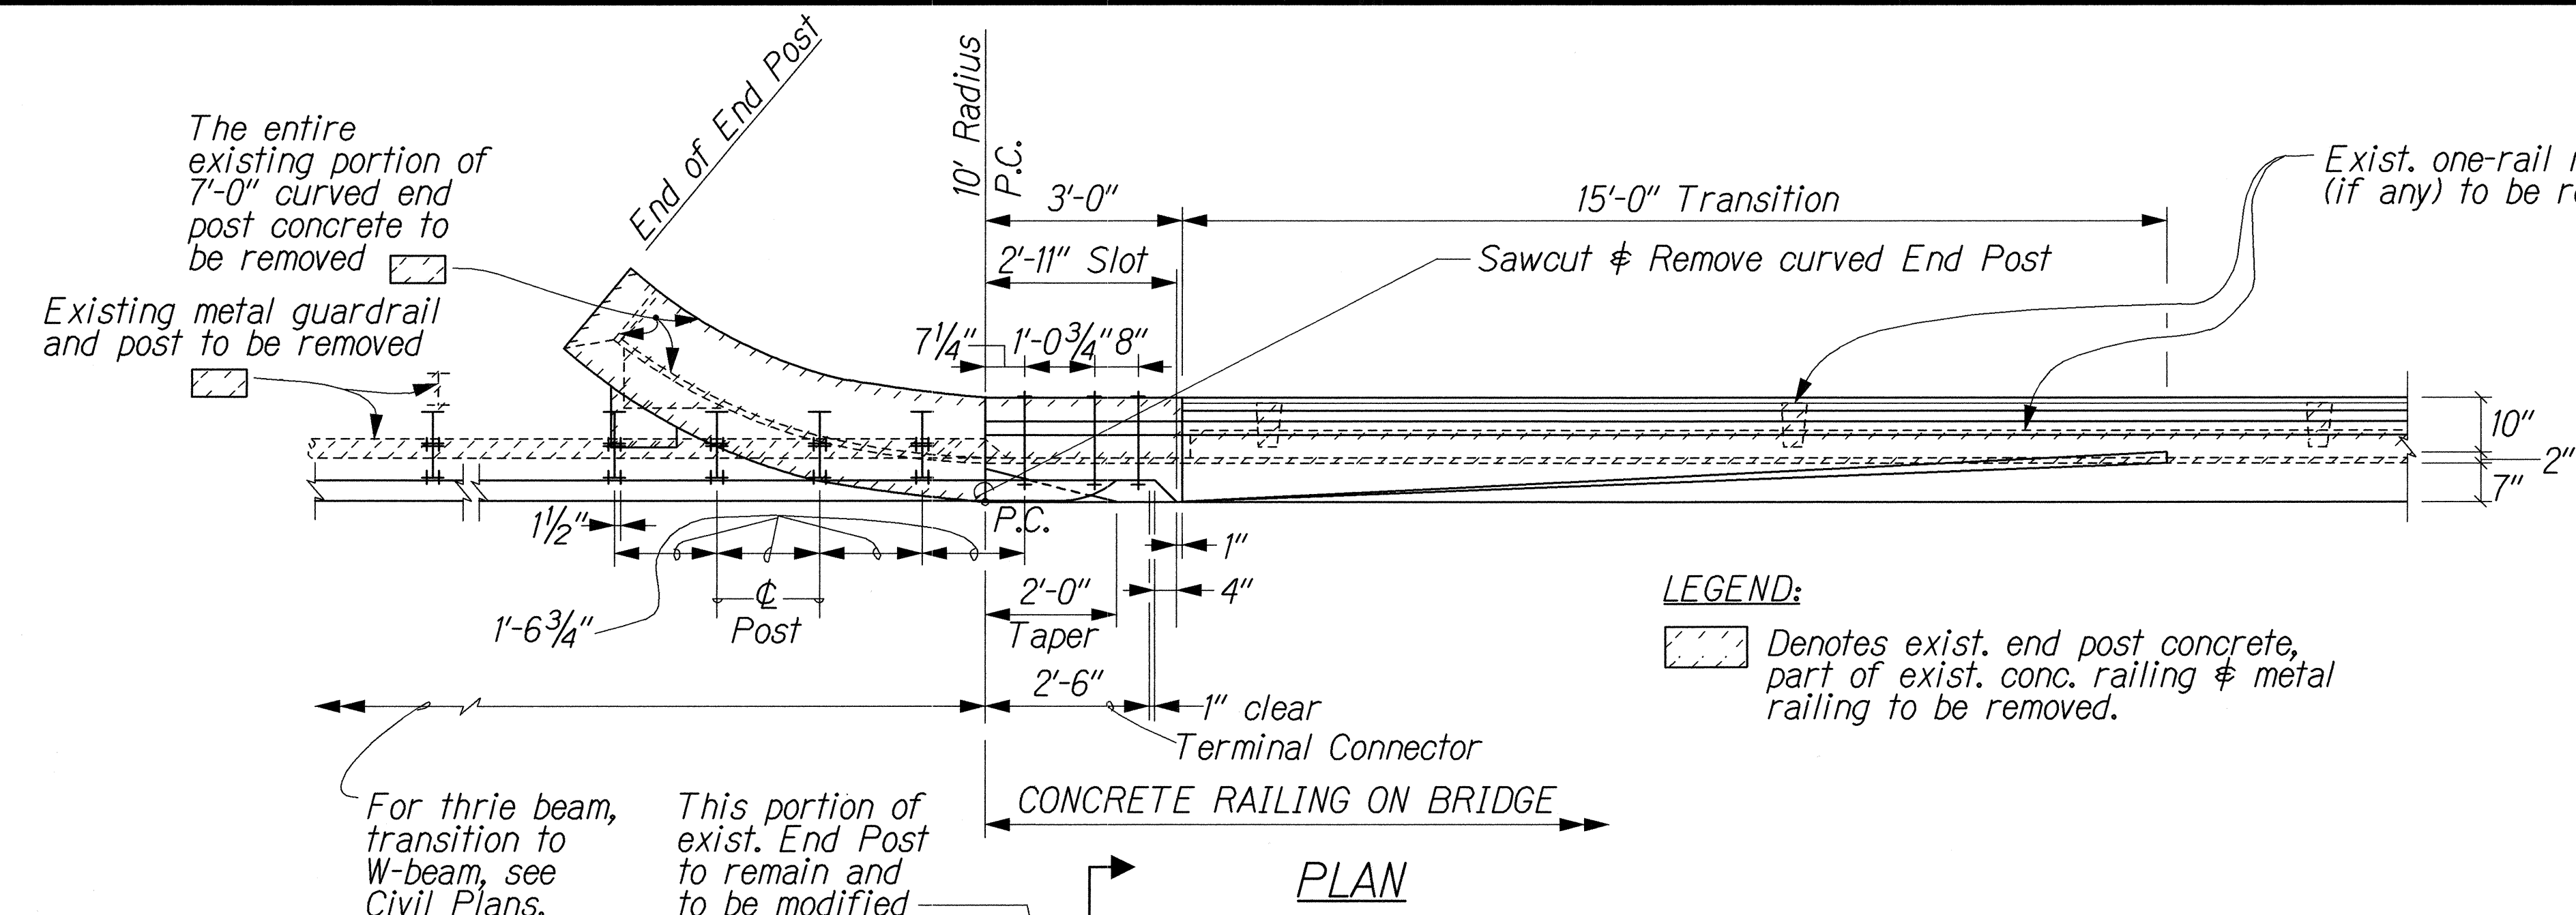

- NOTES:**
- Remove the existing end post concrete as shown. The exposed rebar shall be cut to the dimension shown and bent into finished concrete.
 - The interface between new and old concrete shall be roughened, cleaned and free of laitance. Drill hole $\frac{3}{8}$ " larger in diameter than dowel to be inserted into existing concrete, clean the hole, fill $\frac{2}{3}$ depth of the drilled hole with epoxy grout and insert the dowels.
 - The dowel holes shall be drilled as shown into the existing concrete surfaces. When the drill contacts any existing rebar, the hole shall be filled with epoxy grout and a replacement hole shall be drilled so that the spacing of dowels will be maintained. Contractor shall avoid cutting existing rebars.
 - Prior to removal of end post concrete, Contractor shall record the name and date of each structure. The same name and date of each structure shall be placed on the same side of the finished end post.
 - For letter size and detail of name and date of each structure, see Standard Plan B-01.
 - All concrete shall have a min. 28-day compressive strength (f'c) of 4000 psi.
 - All rebars shall be ASTM A615 Grade 60.
 - All anchor bolts shall be high strength conforming to the requirements of ASTM A325 and shall be galvanized.
 - All anchor rods shall be fully threaded rods conforming to the requirements of ASTM A449 or ASTM 307 as specified and be galvanized after fabrication.
 - All open joints in existing concrete parapet shall be maintained.

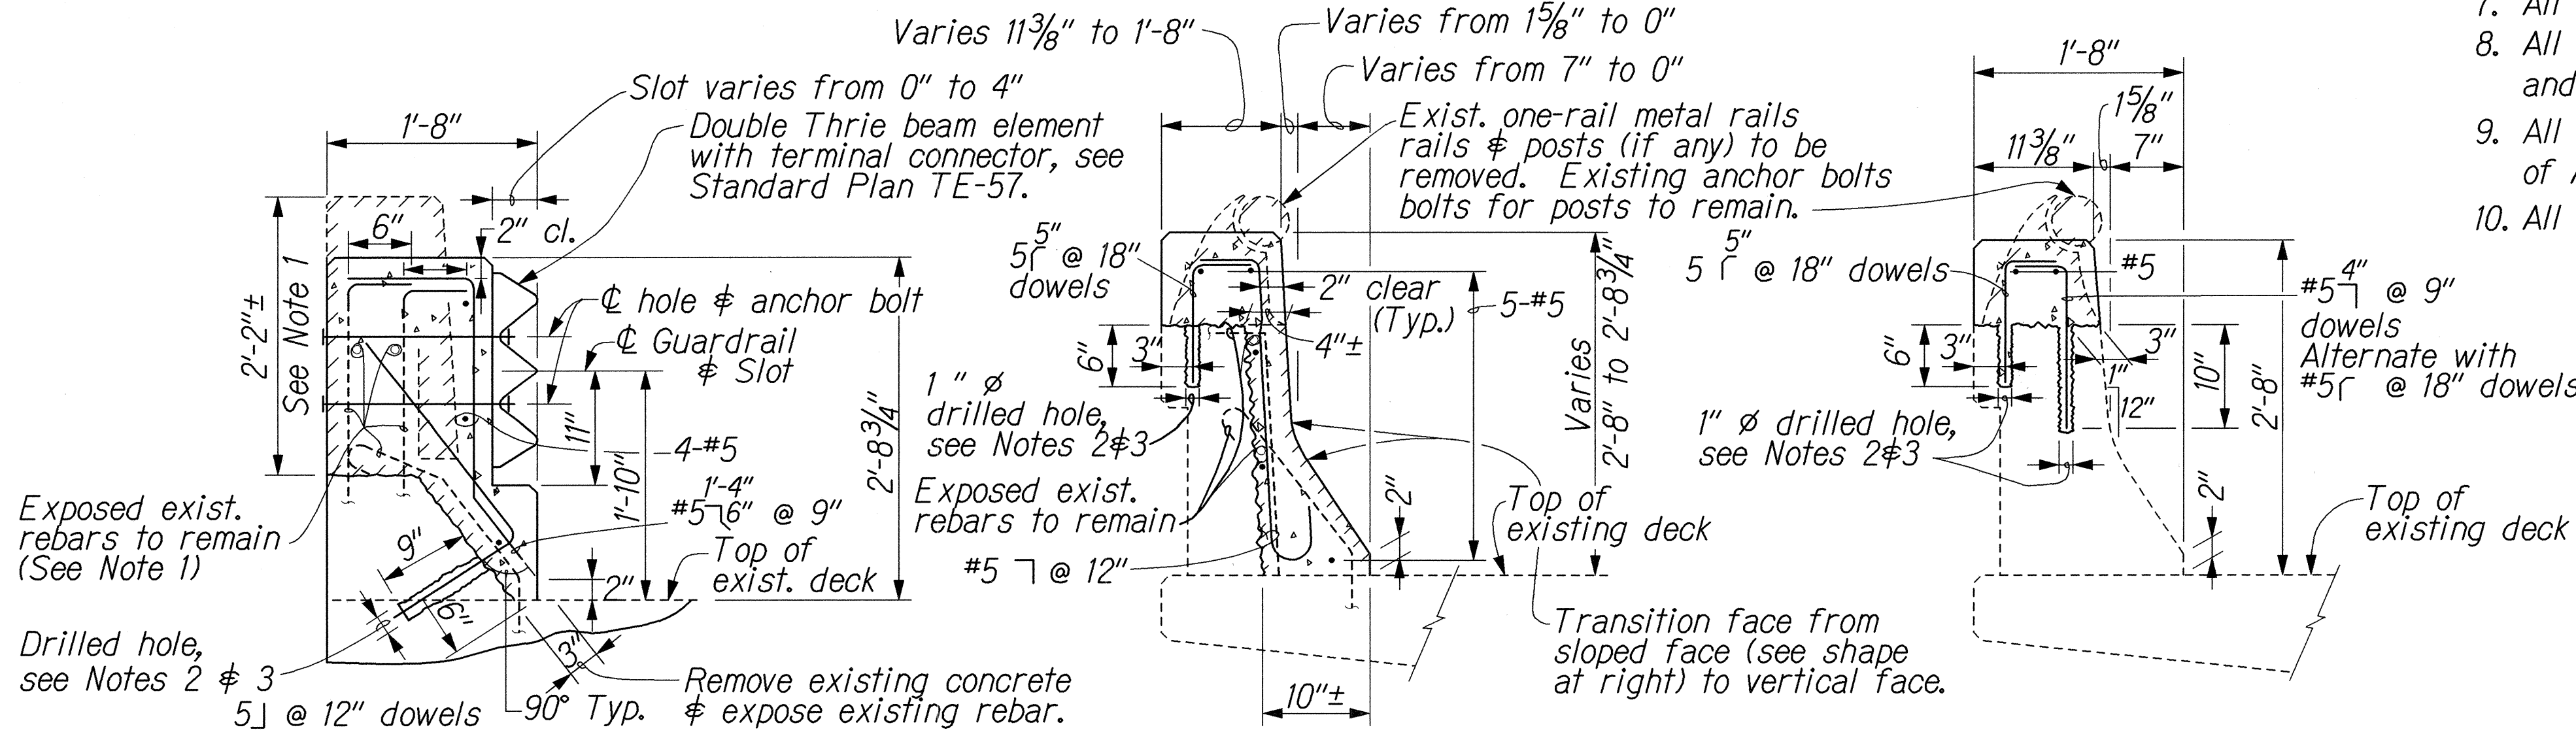

SECTION A
Scale: 1" = 1'-0"
S-33/S-33

SECTION B
Scale: 1" = 1'-0"
S-33/S-33

SECTION C
Scale: 1" = 1'-0"
S-33/S-33

DATE	_____
SURVEY PLOTTED BY	_____
DRAWN BY	_____
DESIGNED BY	_____
CHECKED BY	_____
IN CHARGE	_____

THIS WORK WAS PREPARED BY ME OR UNDER MY SUPERVISION.


Hui Pang Chen

STATE OF HAWAII
DEPARTMENT OF TRANSPORTATION
HIGHWAYS DIVISION

EXISTING CONC. RAILING UPGRADE


KUIHELANI HIGHWAY WIDENING
HONOAPIILANI HIGHWAY TO PUUNENE AVENUE
FEDERAL-AID PROJECT NO. NH-0380(9)
Scale: As Shown Date: Sept. 14, 2001

FED. ROAD DIST. NO.	STATE	FED. AID PROJ. NO.	FISCAL YEAR	SHEET NO.	TOTAL SHEETS
HAWAII	HAW.	NH-0380(9)	2000	196	380

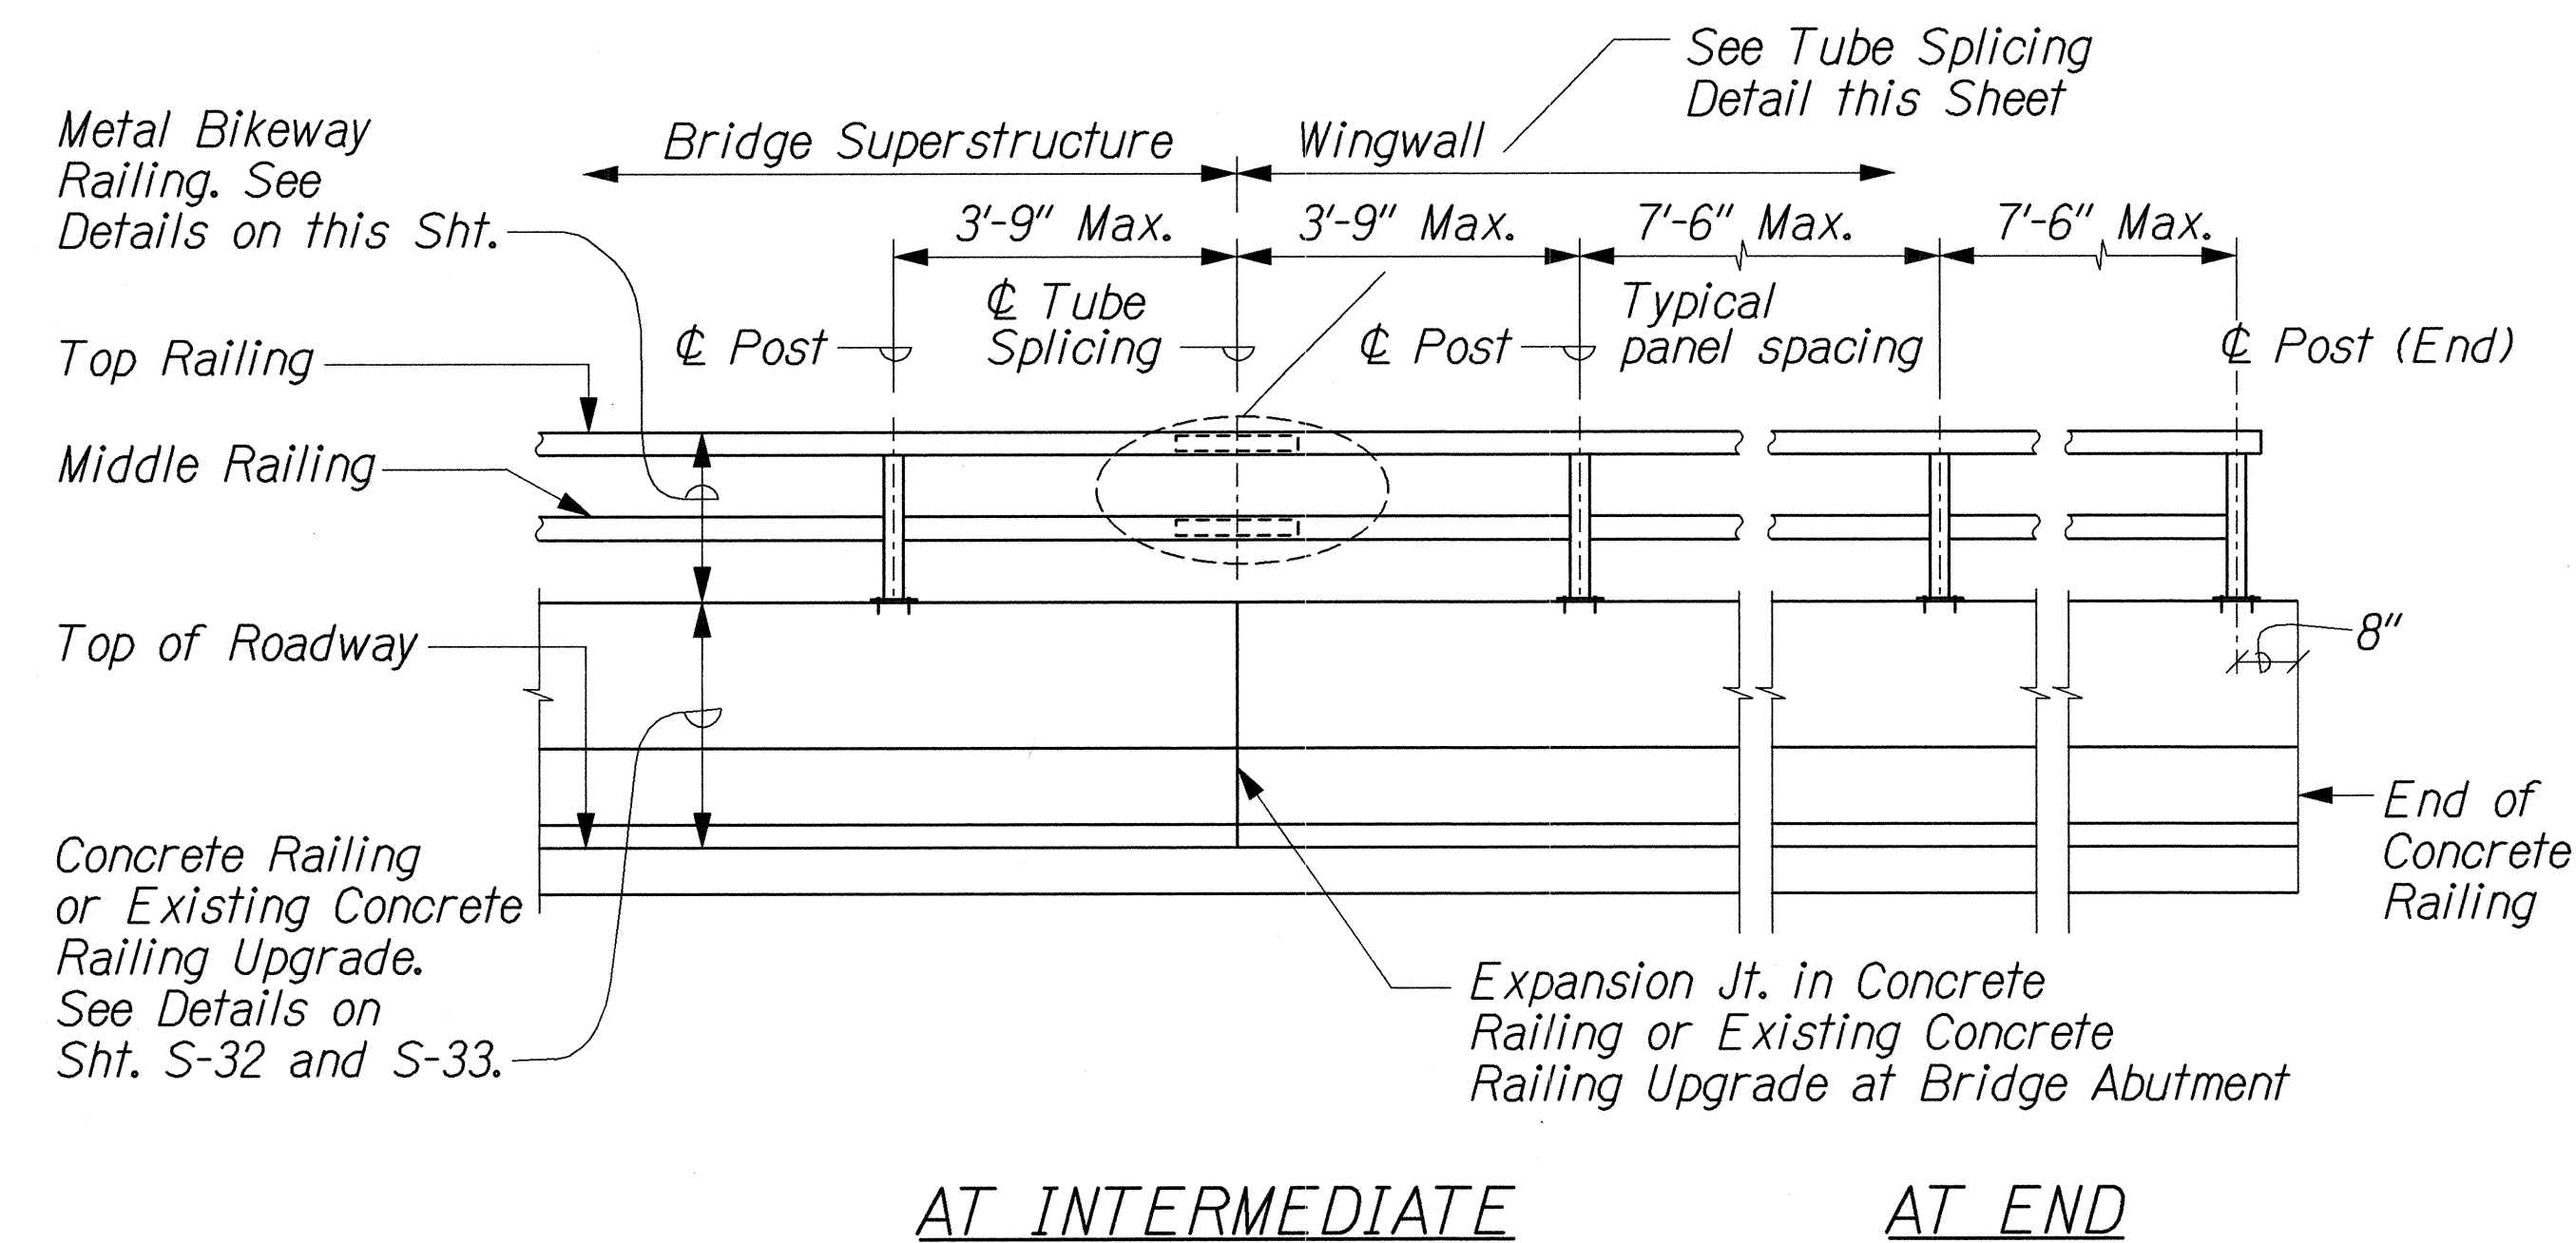

PARTIAL ELEVATION

Scale: 1/2" = 1'-0"

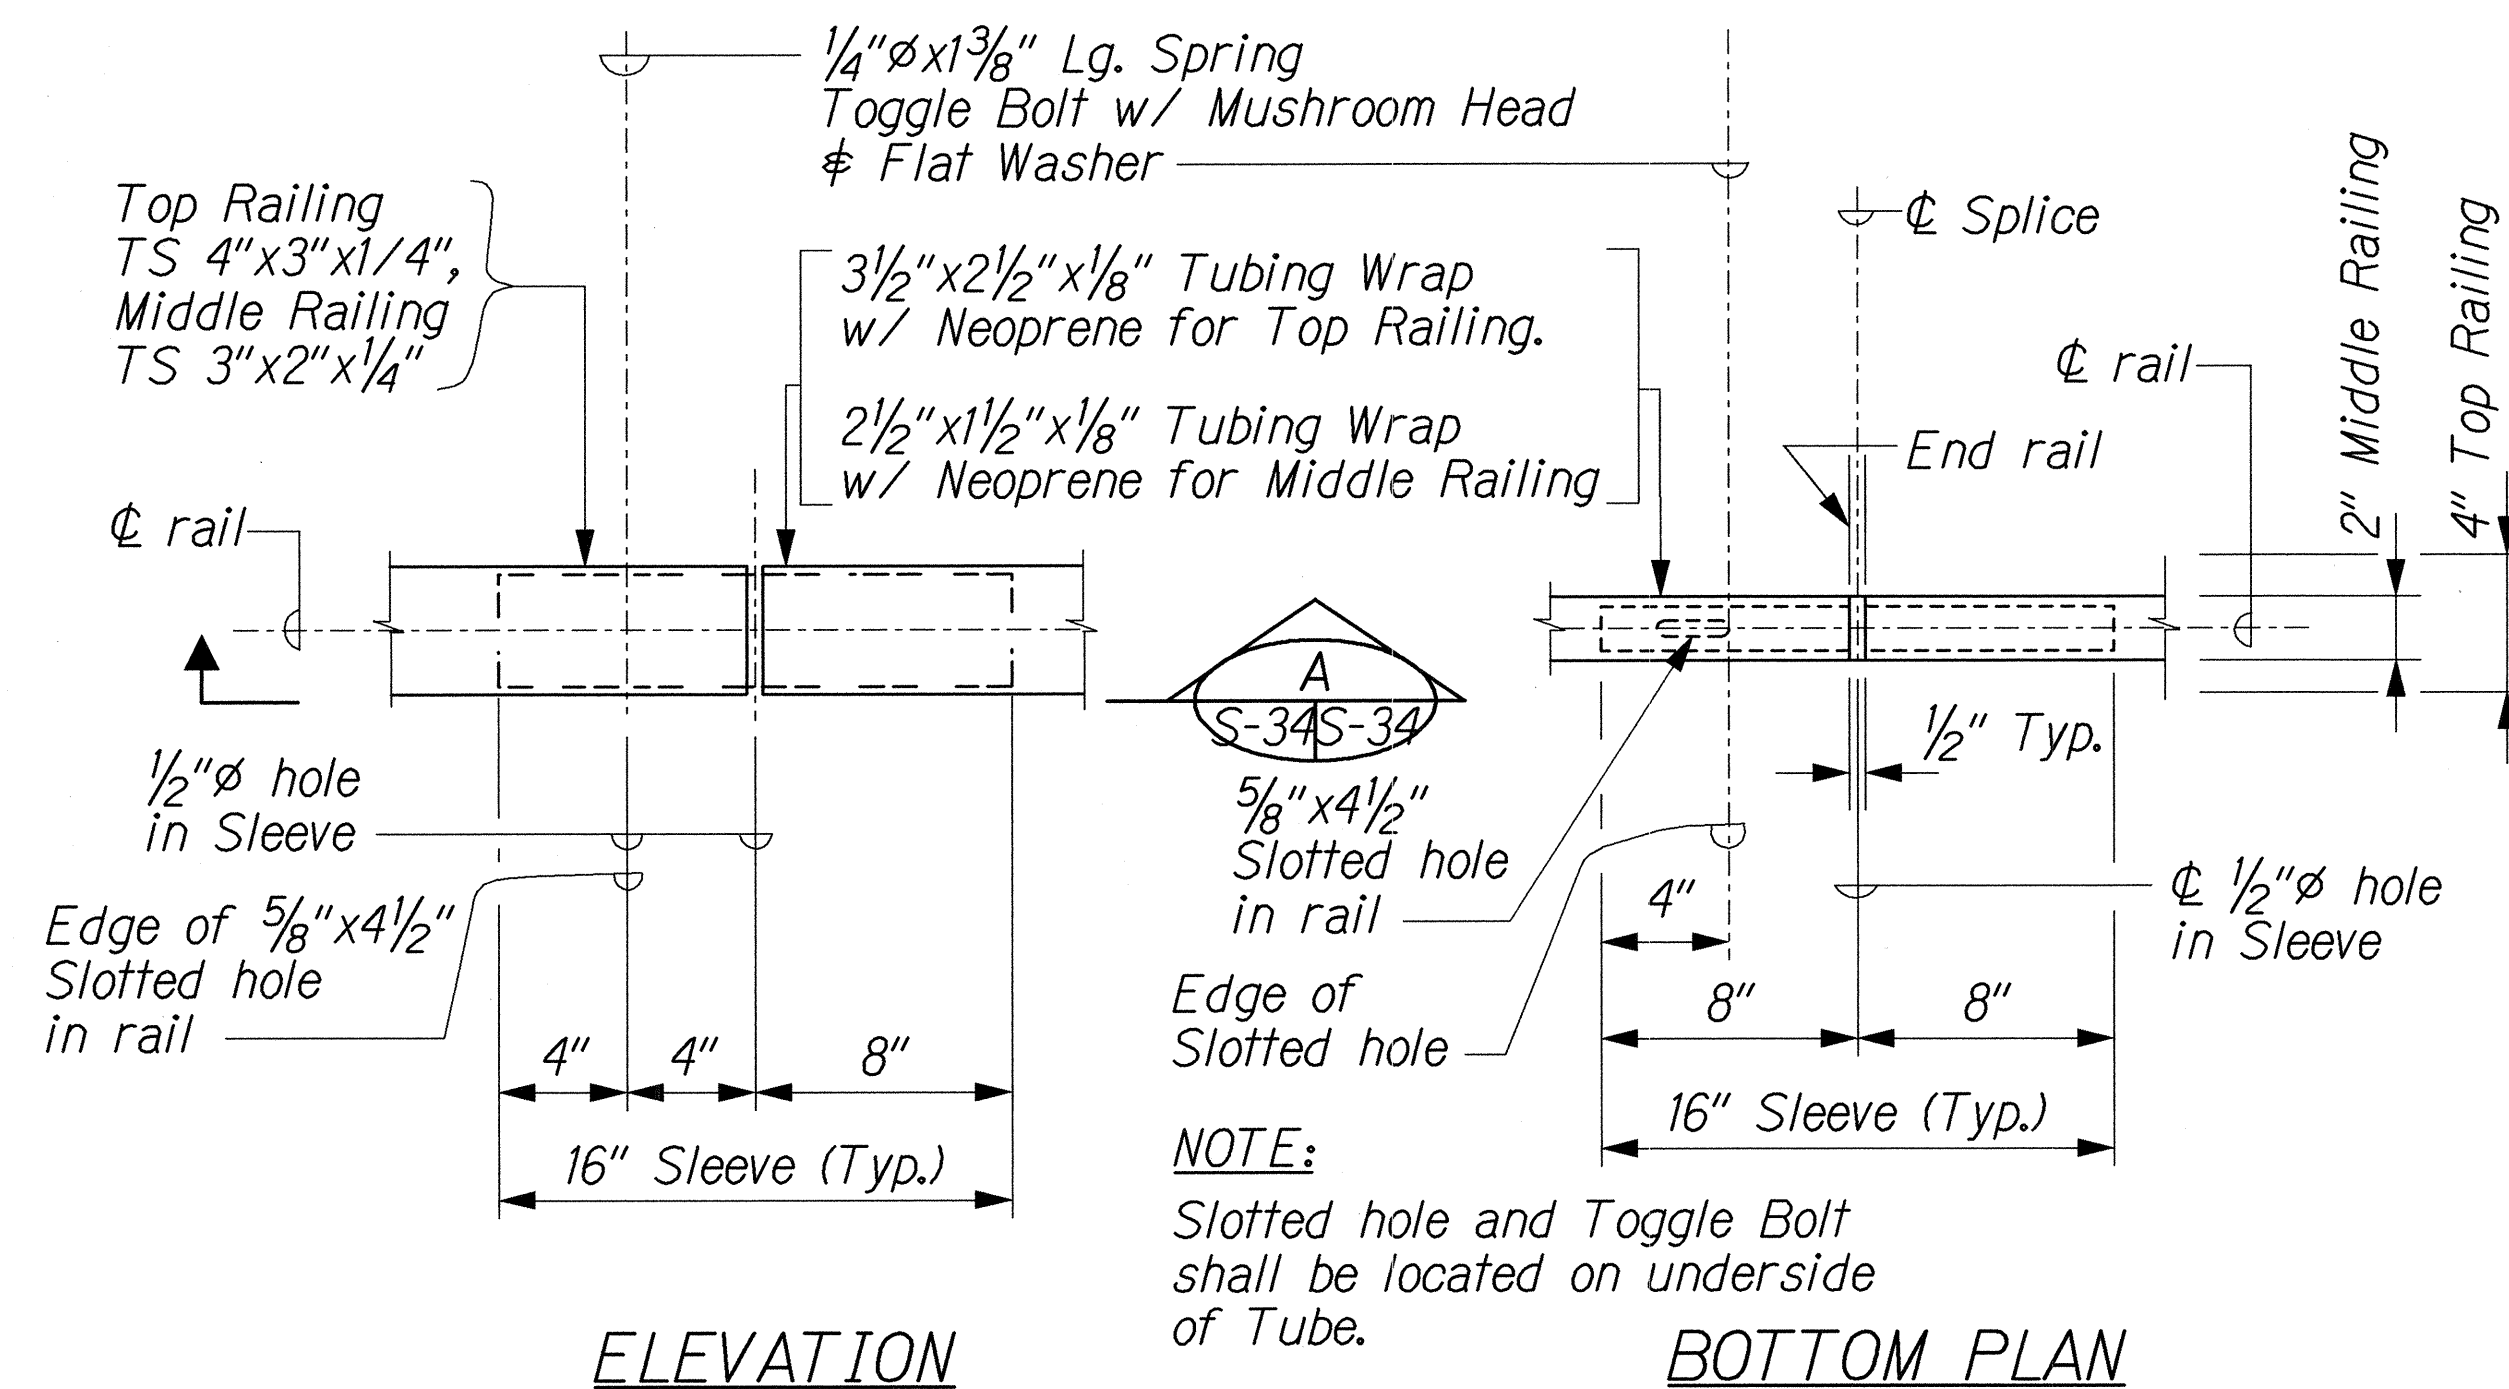


TYPICAL TUBE SPLICING DETAIL

Not to Scale


SECTION A

Not To Scale

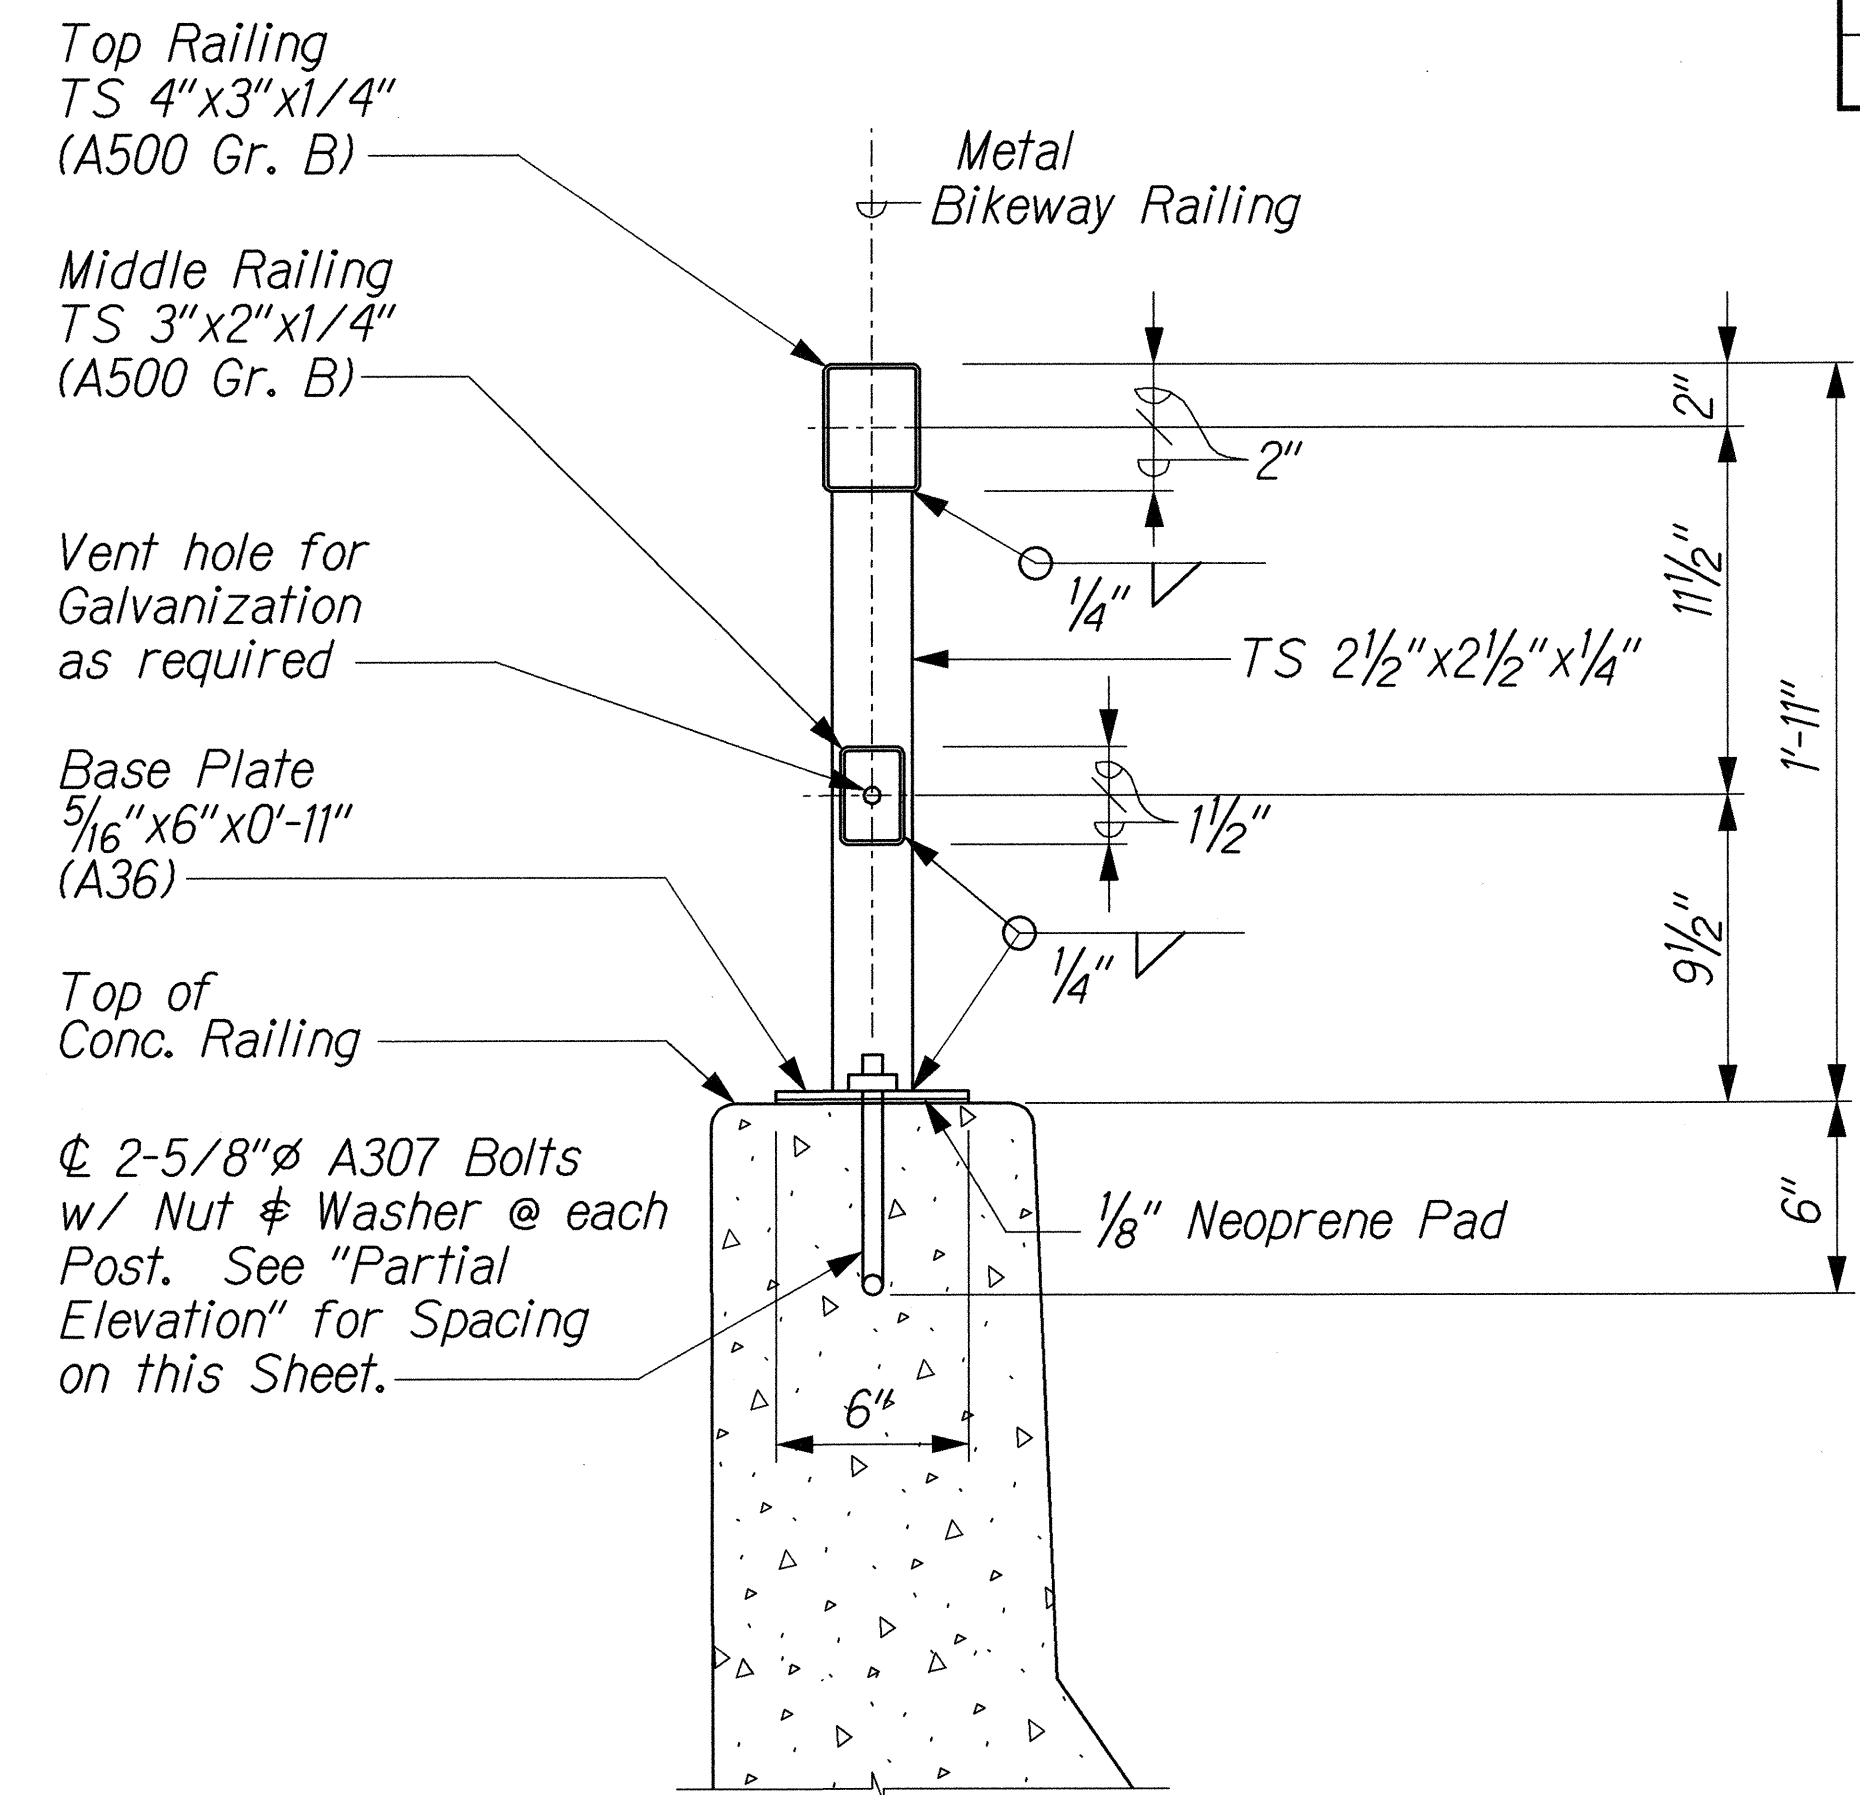

METAL BIKEWAY RAILING TYPICAL SECTION

Scale: 2" = 1'-0"

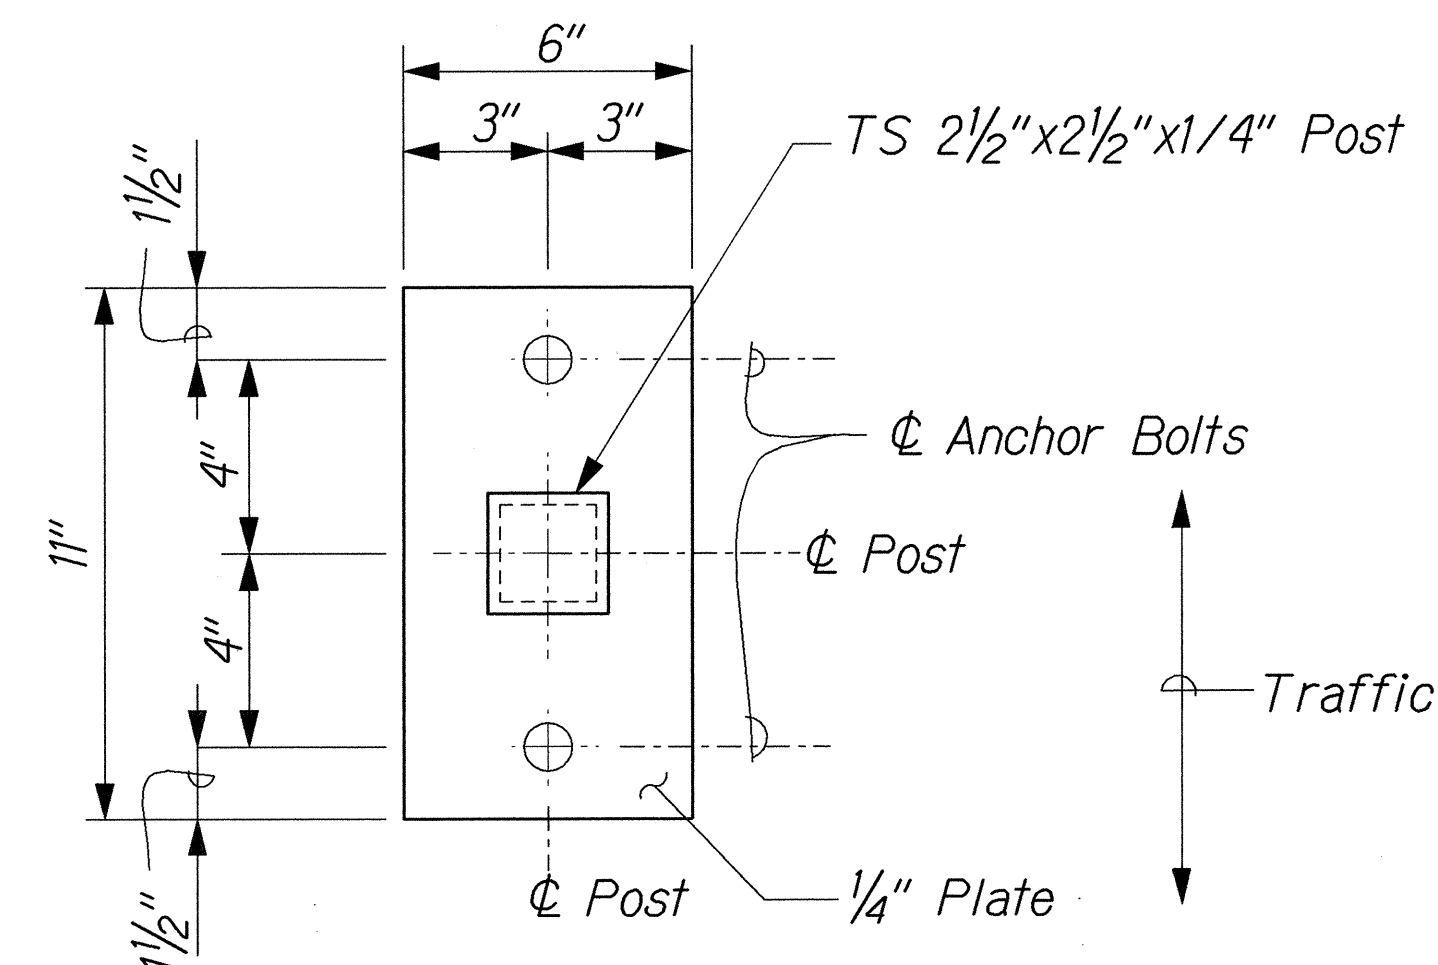

BASE PLATE DETAIL

Scale: 3" = 1'-0"

DATE	_____
SURVEY PLOTTED BY	_____
DRAWN BY	_____
DESIGNED BY	_____
CHECKED BY	_____
IN	_____

3/2 KUIHELANI/STRUCT/ST-Detail.dgn

THIS WORK WAS PREPARED BY ME OR UNDER MY SUPERVISION.

Hui Pang Chen


STATE OF HAWAII
DEPARTMENT OF TRANSPORTATION
HIGHWAYS DIVISION

METAL BIKEWAY RAILING DETAILS

KUIHELANI HIGHWAY WIDENING
HONOAPIILANI HIGHWAY TO PUUNENE AVENUE
FEDERAL-AID PROJECT NO. NH-0380(9)
Scale: As Shown Date: Sept. 14, 2001

SHEET No. S-34 OF 54 SHEETS

FED. ROAD DIST. NO.	STATE	FED. AID PROJ. NO.	FISCAL YEAR	SHEET NO.	TOTAL SHEETS
HAWAII	HAW.	NH-0380(9)	2000	197	380

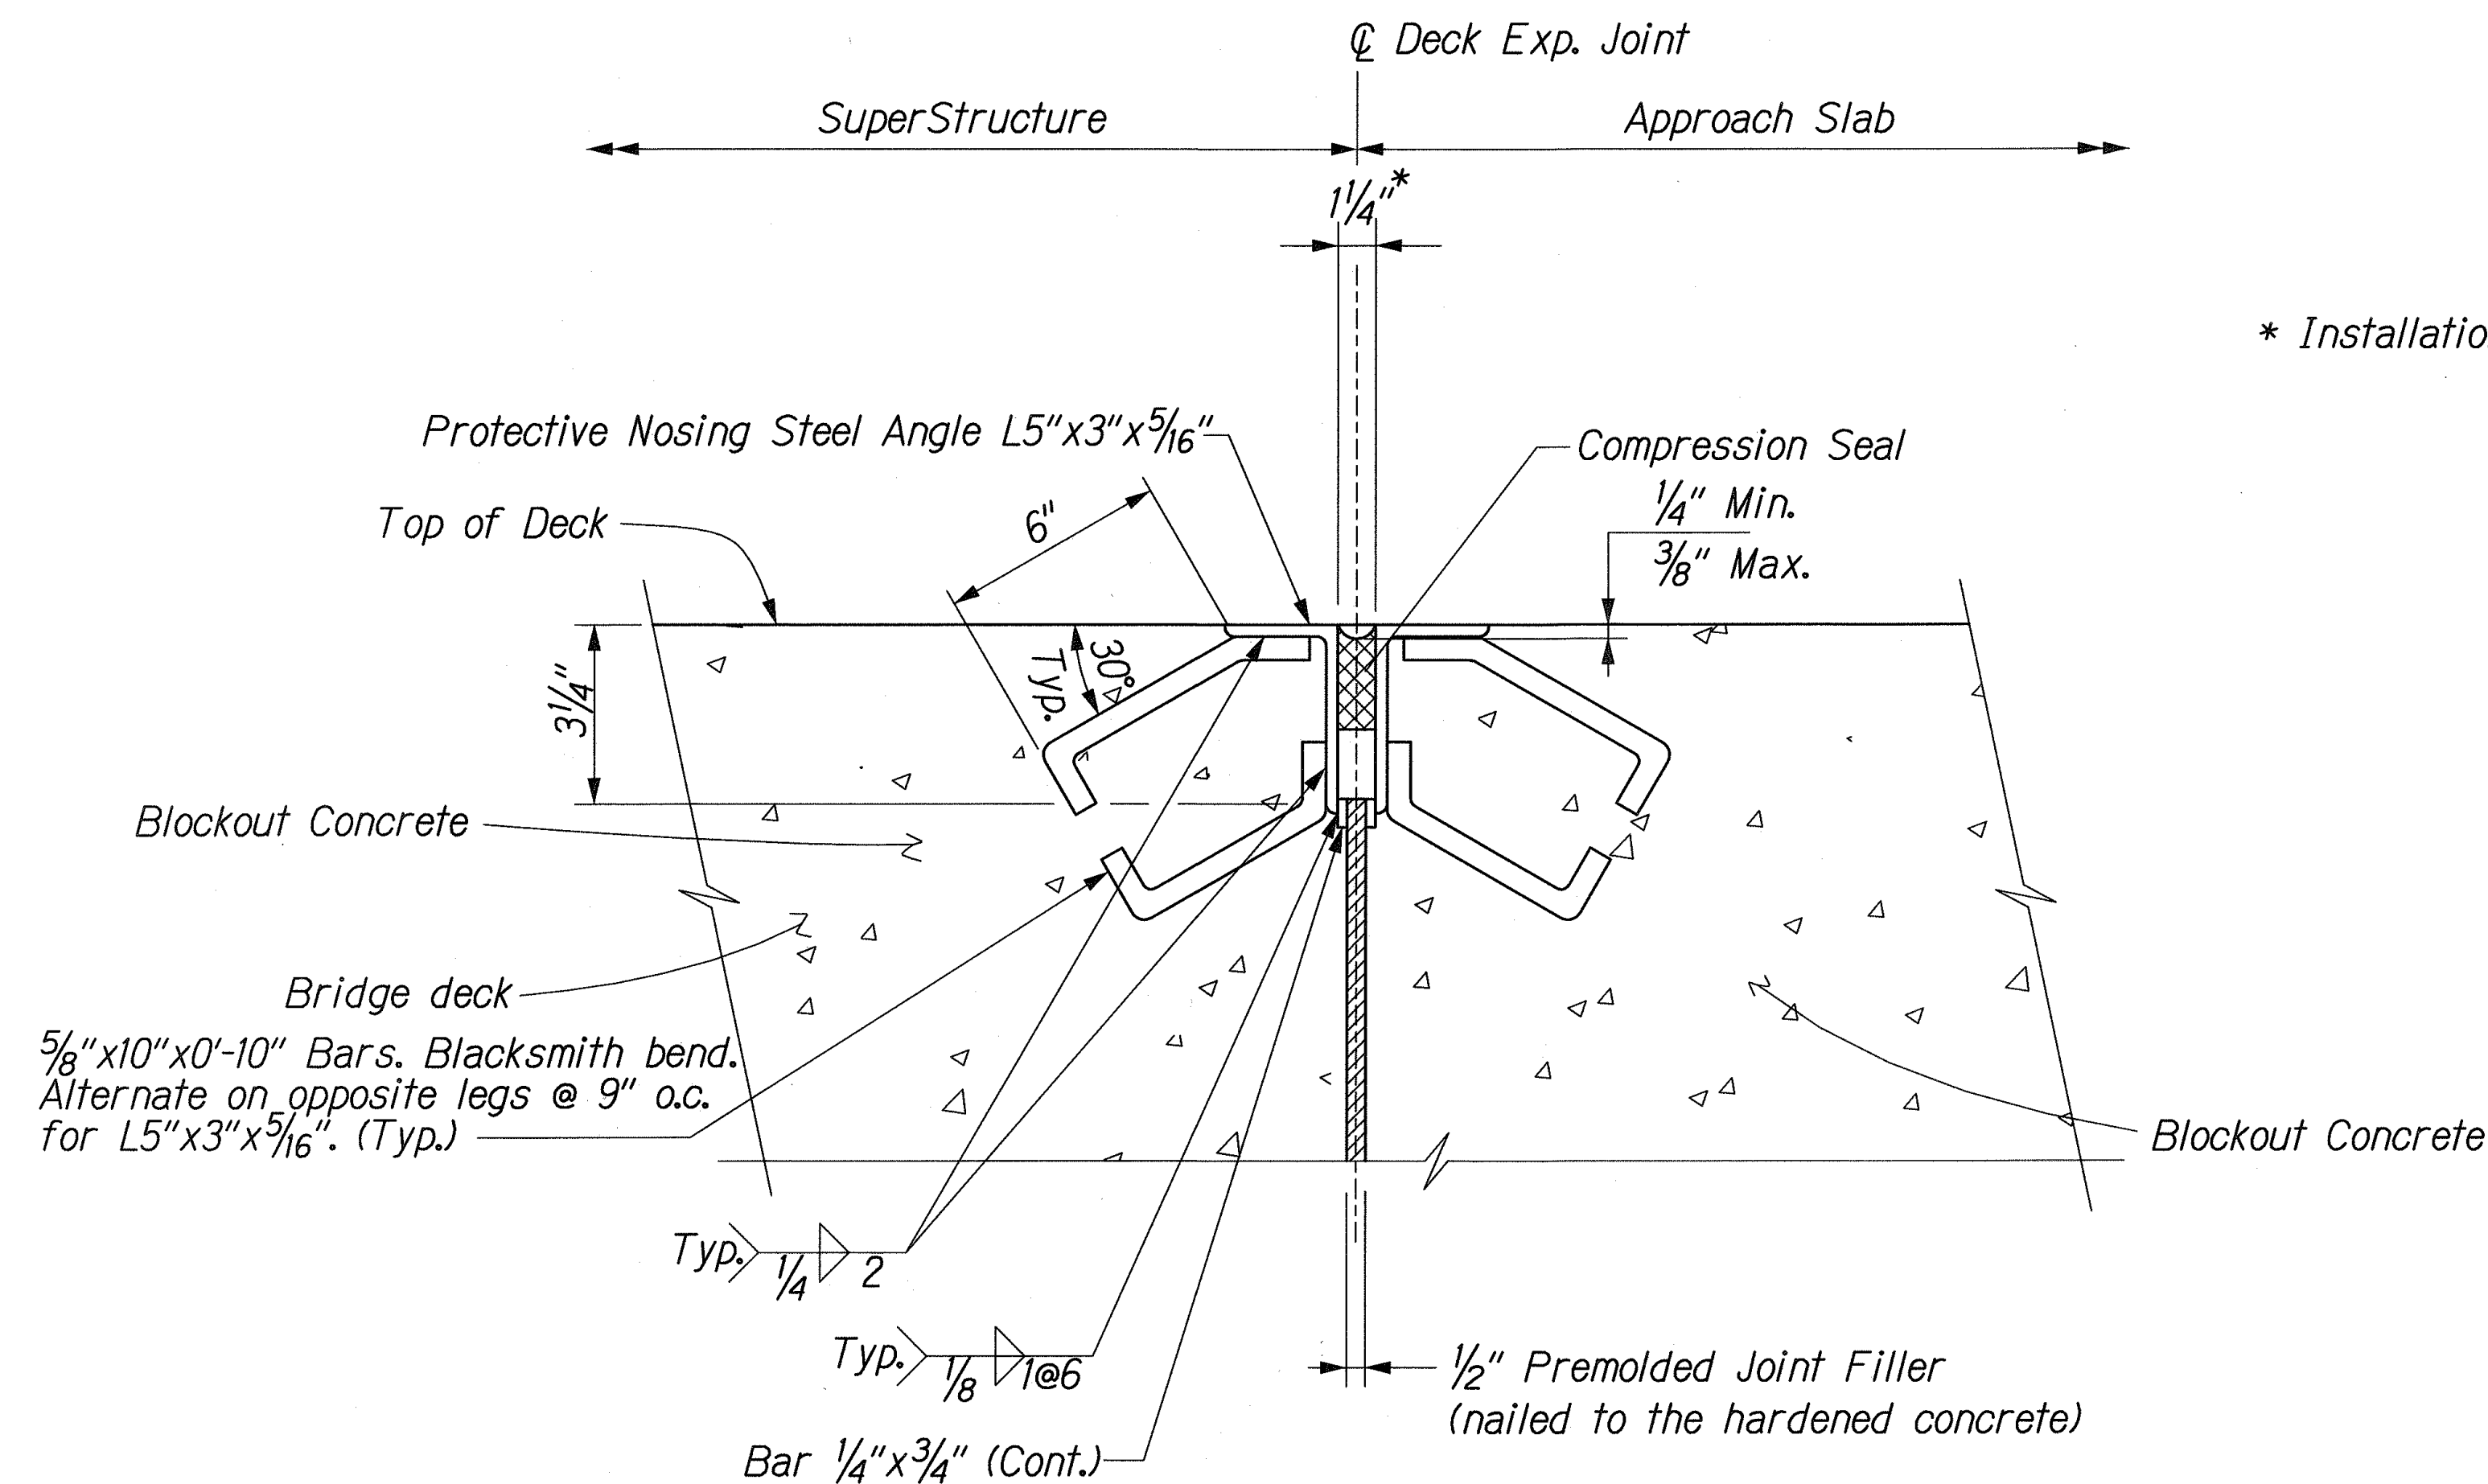


* Installation width at 75° F.


NOTE:

1. Compression seals, joint filler, nosing steel angles, anchor bars, pre-molded joint filler shown on deck expansion joint details shall be incidental to concrete in bridge.

DECK EXPANSION JOINT DETAIL AND WAIHEE DITCH)
(FOR PALEAAHU BRIDGE AND WAIKAPU BRIDGE ~~ONLY~~)
Not to Scale

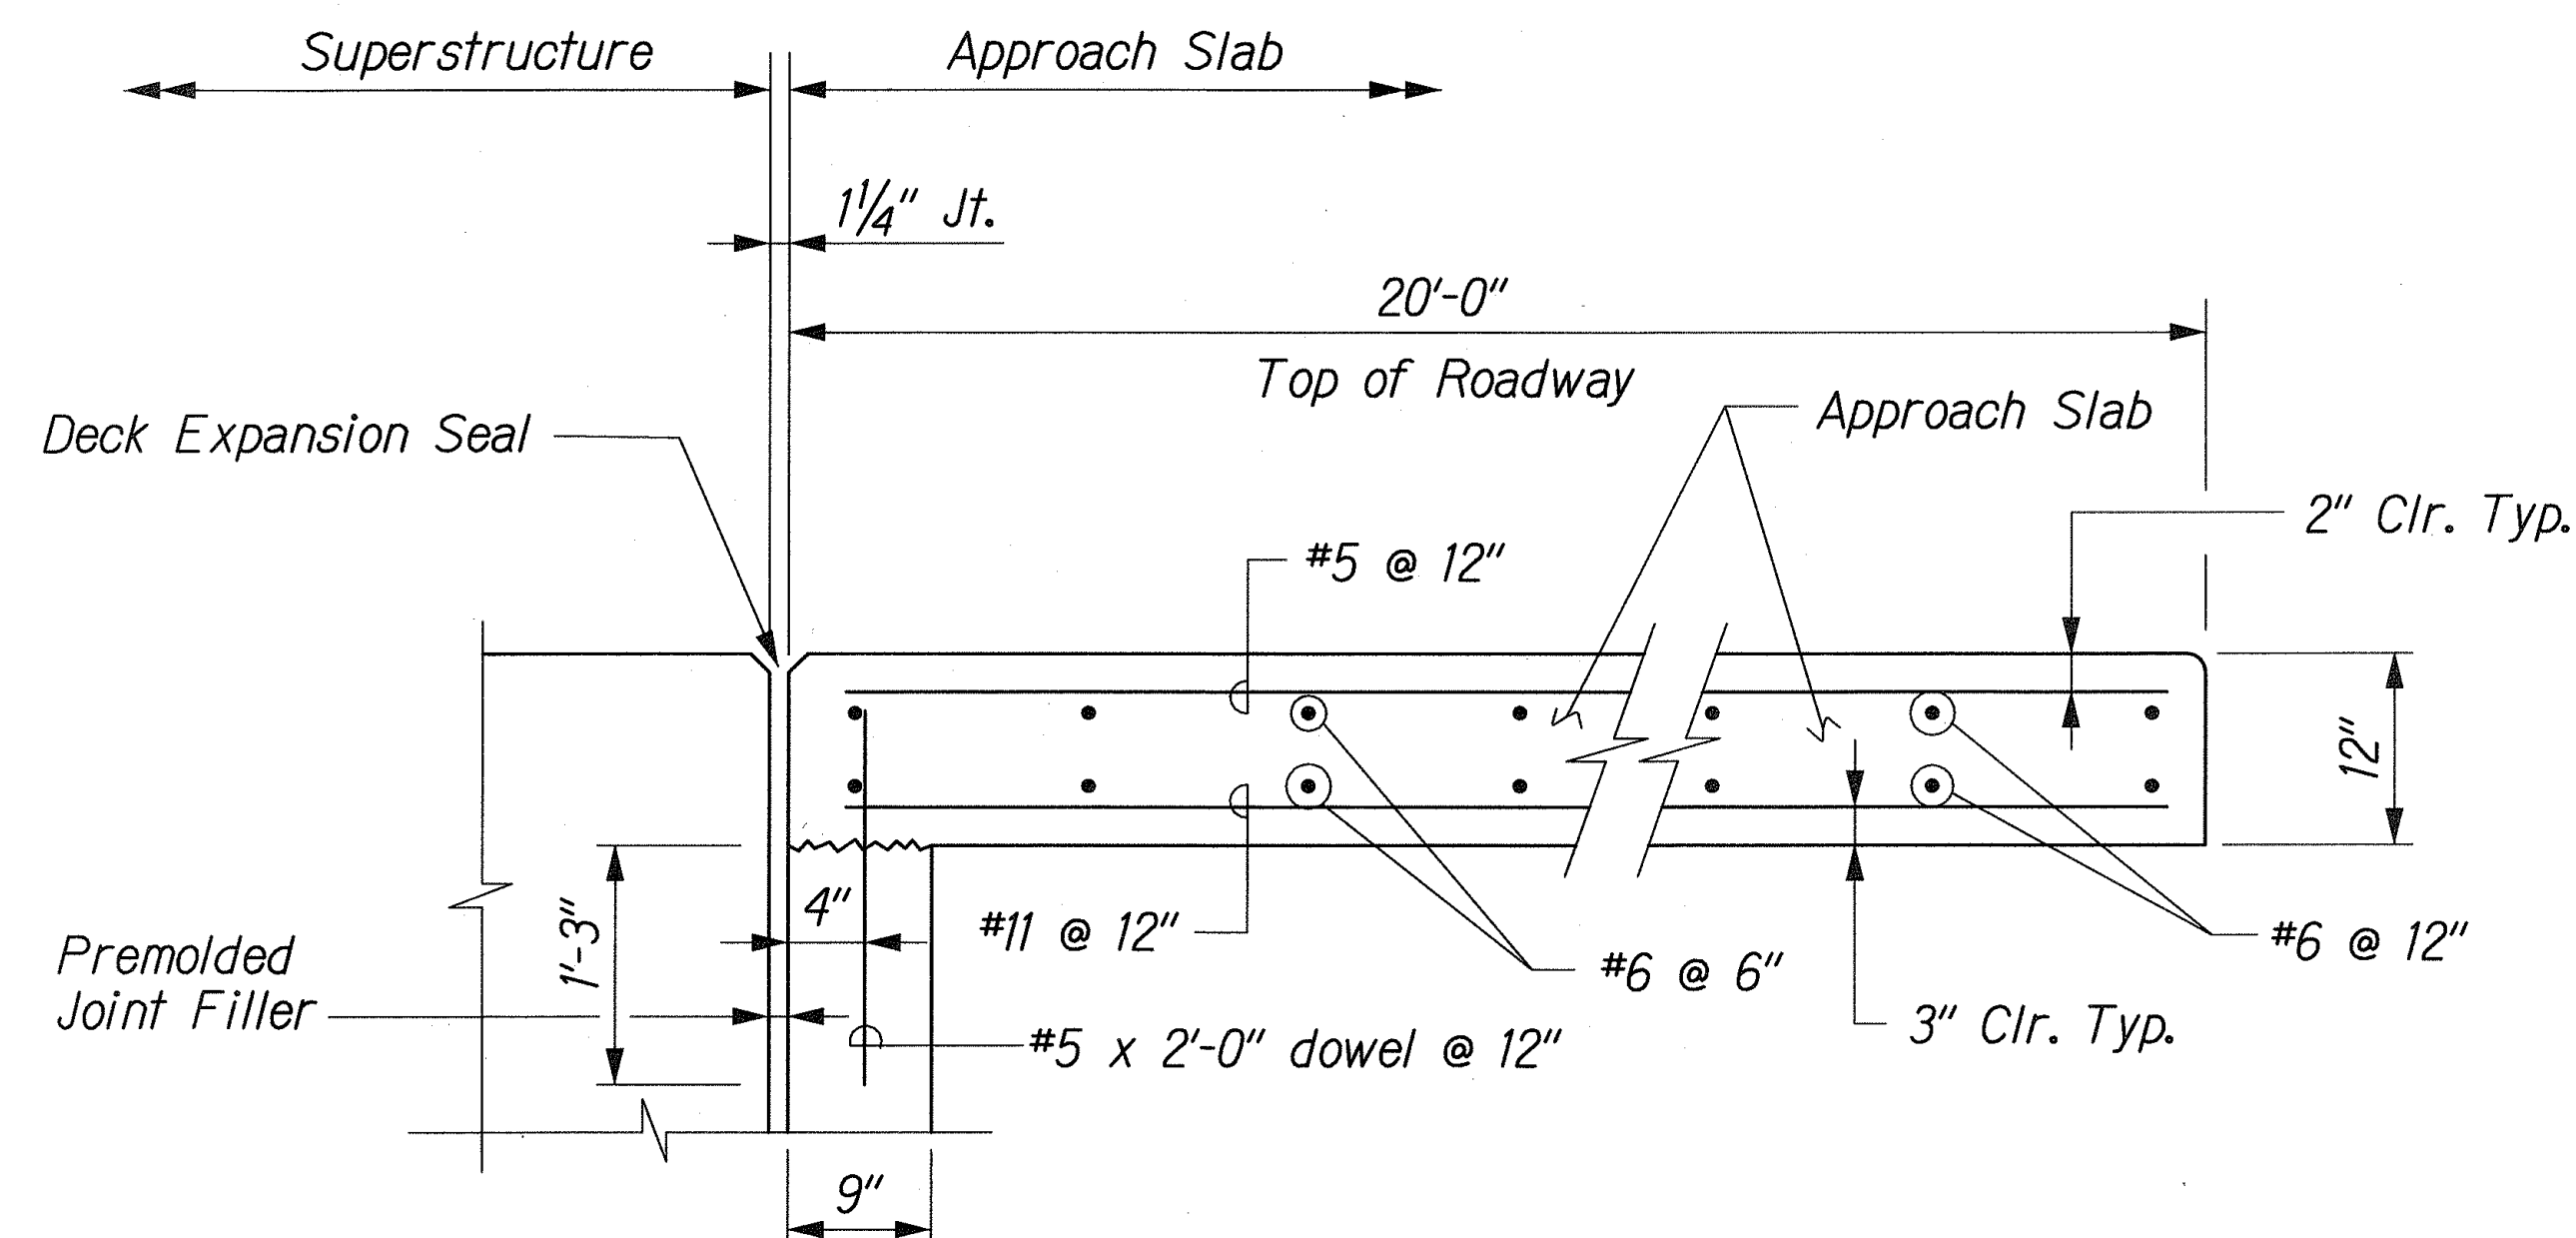

APPROACH SLAB DETAIL
Not to Scale

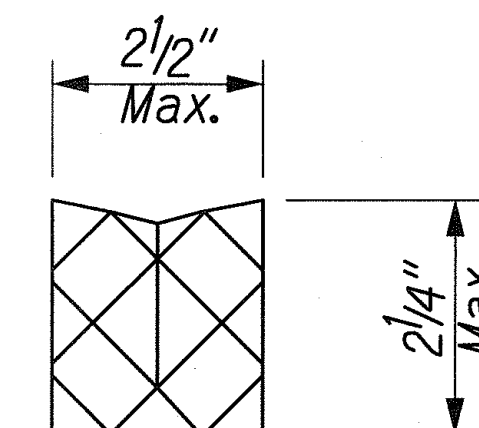

The Compression Seal shall be capable of resisting a maximum movement of 0.9".

DETAIL - COMPRESSION SEAL
Not to Scale

LEGEND FOR AS-BUILT POSTINGS	
	Squiggly line for as-built deletion
	Double line for as-built deletion
Roadway	Text for as-built posting

THIS WORK WAS PREPARED BY ME OR UNDER MY SUPERVISION.





Hui Pang Chen

STATE OF HAWAII
DEPARTMENT OF TRANSPORTATION
HIGHWAYS DIVISION

DECK JOINT AND APPROACH SLAB DETAILS

KUIHELANI HIGHWAY WIDENING
HONOAPIILANI HIGHWAY TO PUUNENE AVENUE
FEDERAL-AID PROJECT NO. NH-0380(9)
Scale: As Shown Date: Sept. 14, 2001

FED. ROAD DIST. NO.	STATE	FED. AID PROJ. NO.	FISCAL YEAR	SHEET NO.	TOTAL SHEETS
HAWAII	HAW.	NH-0380(9)	2000	198	380

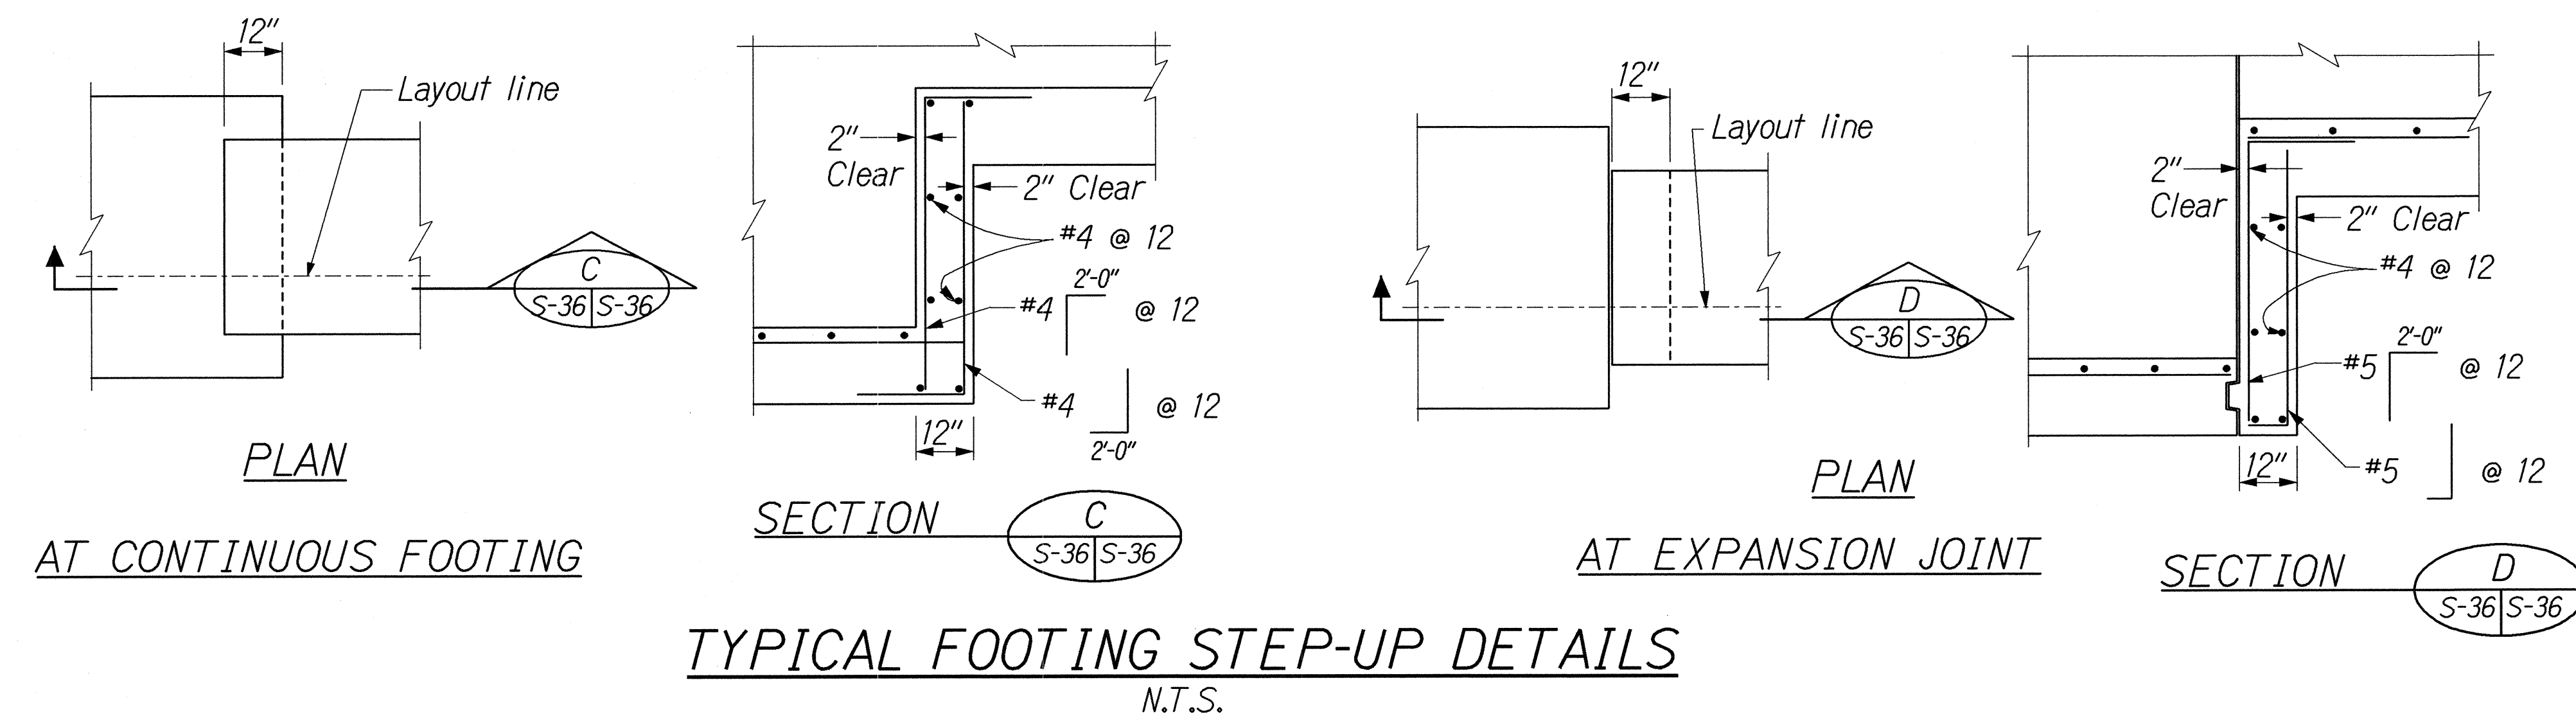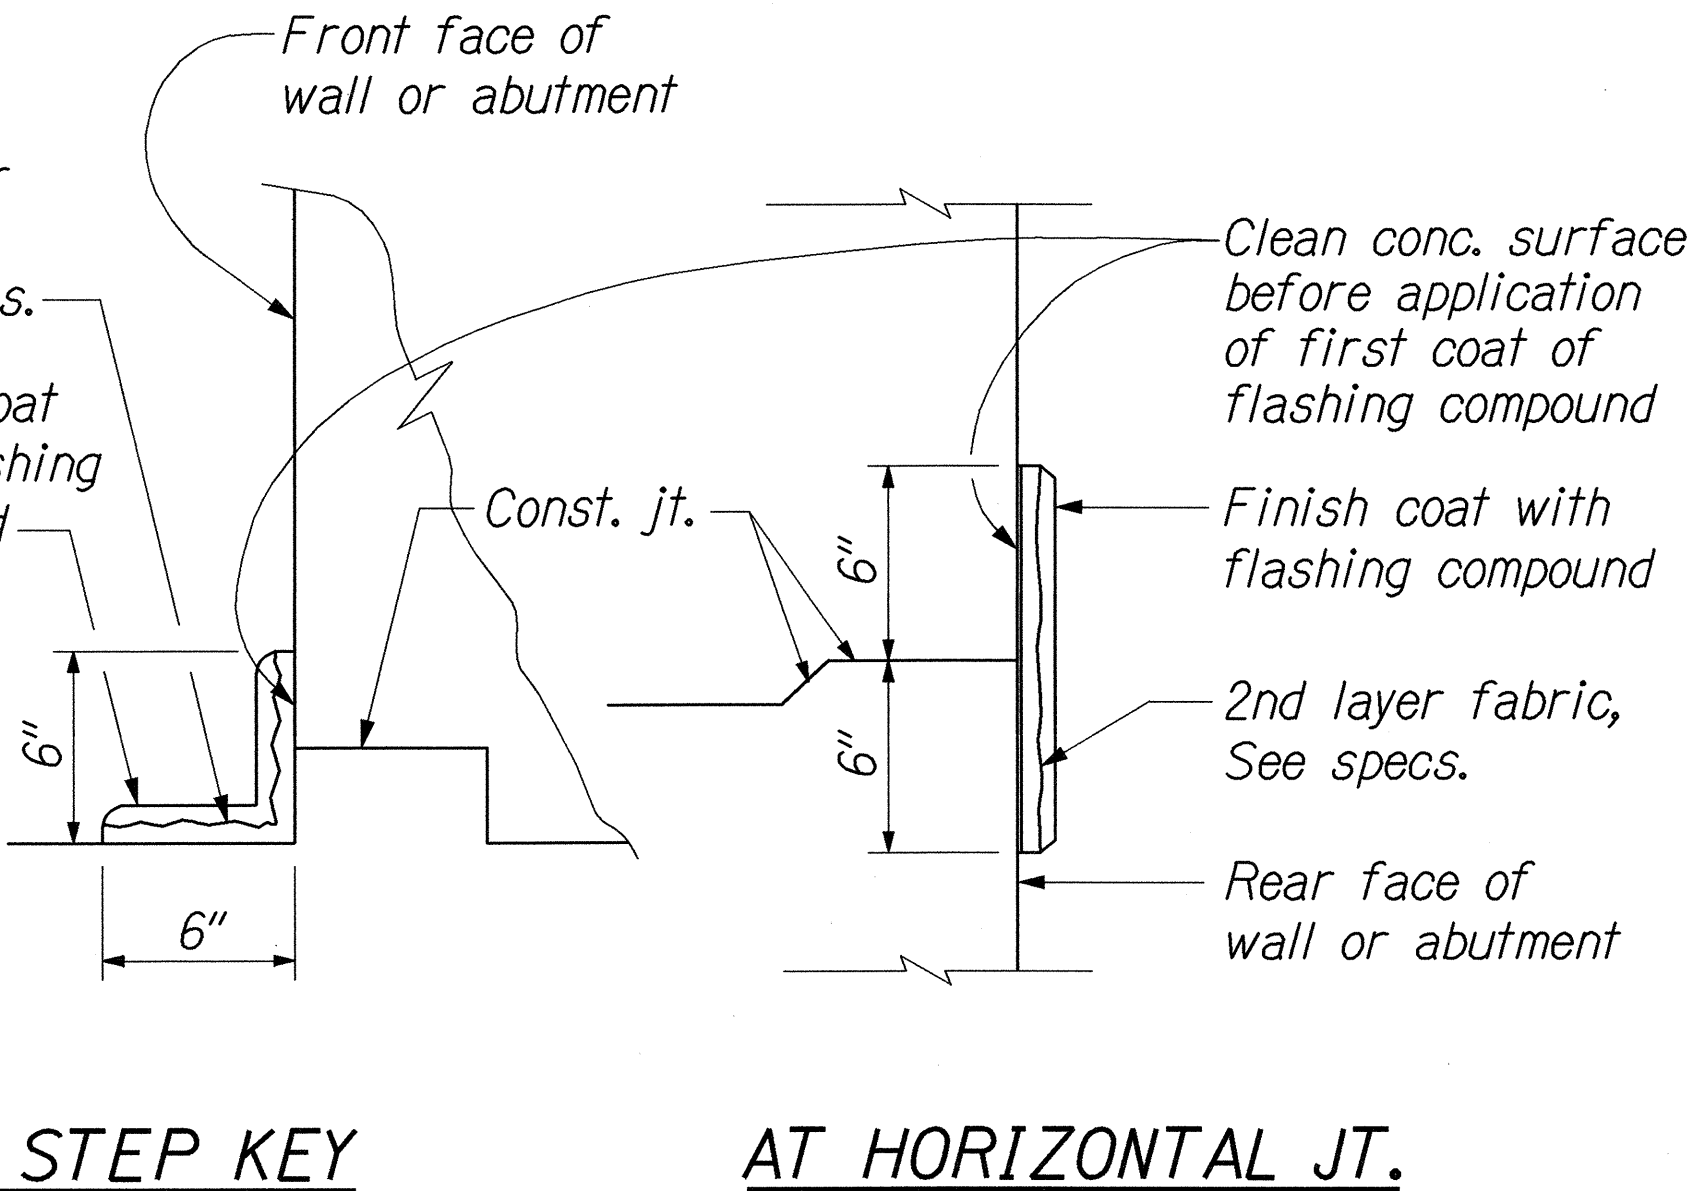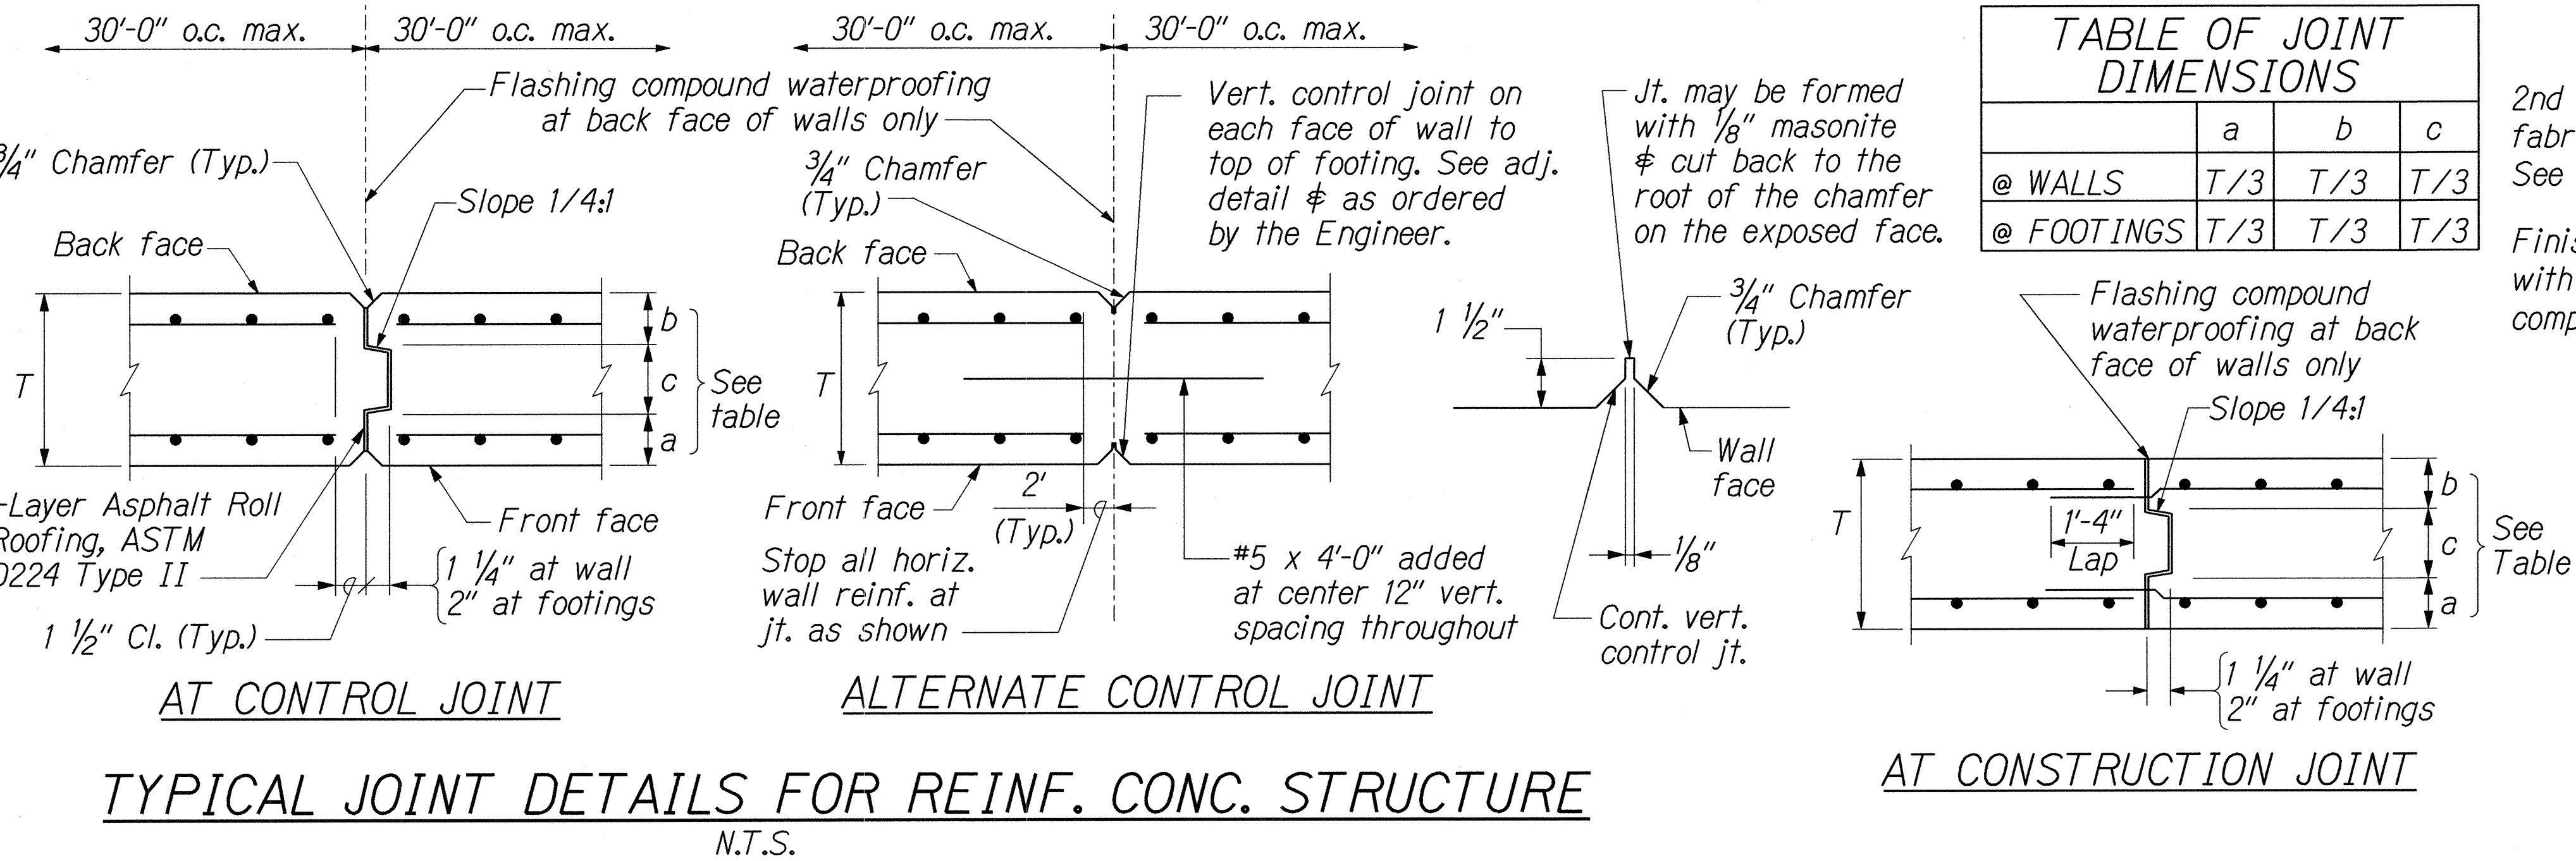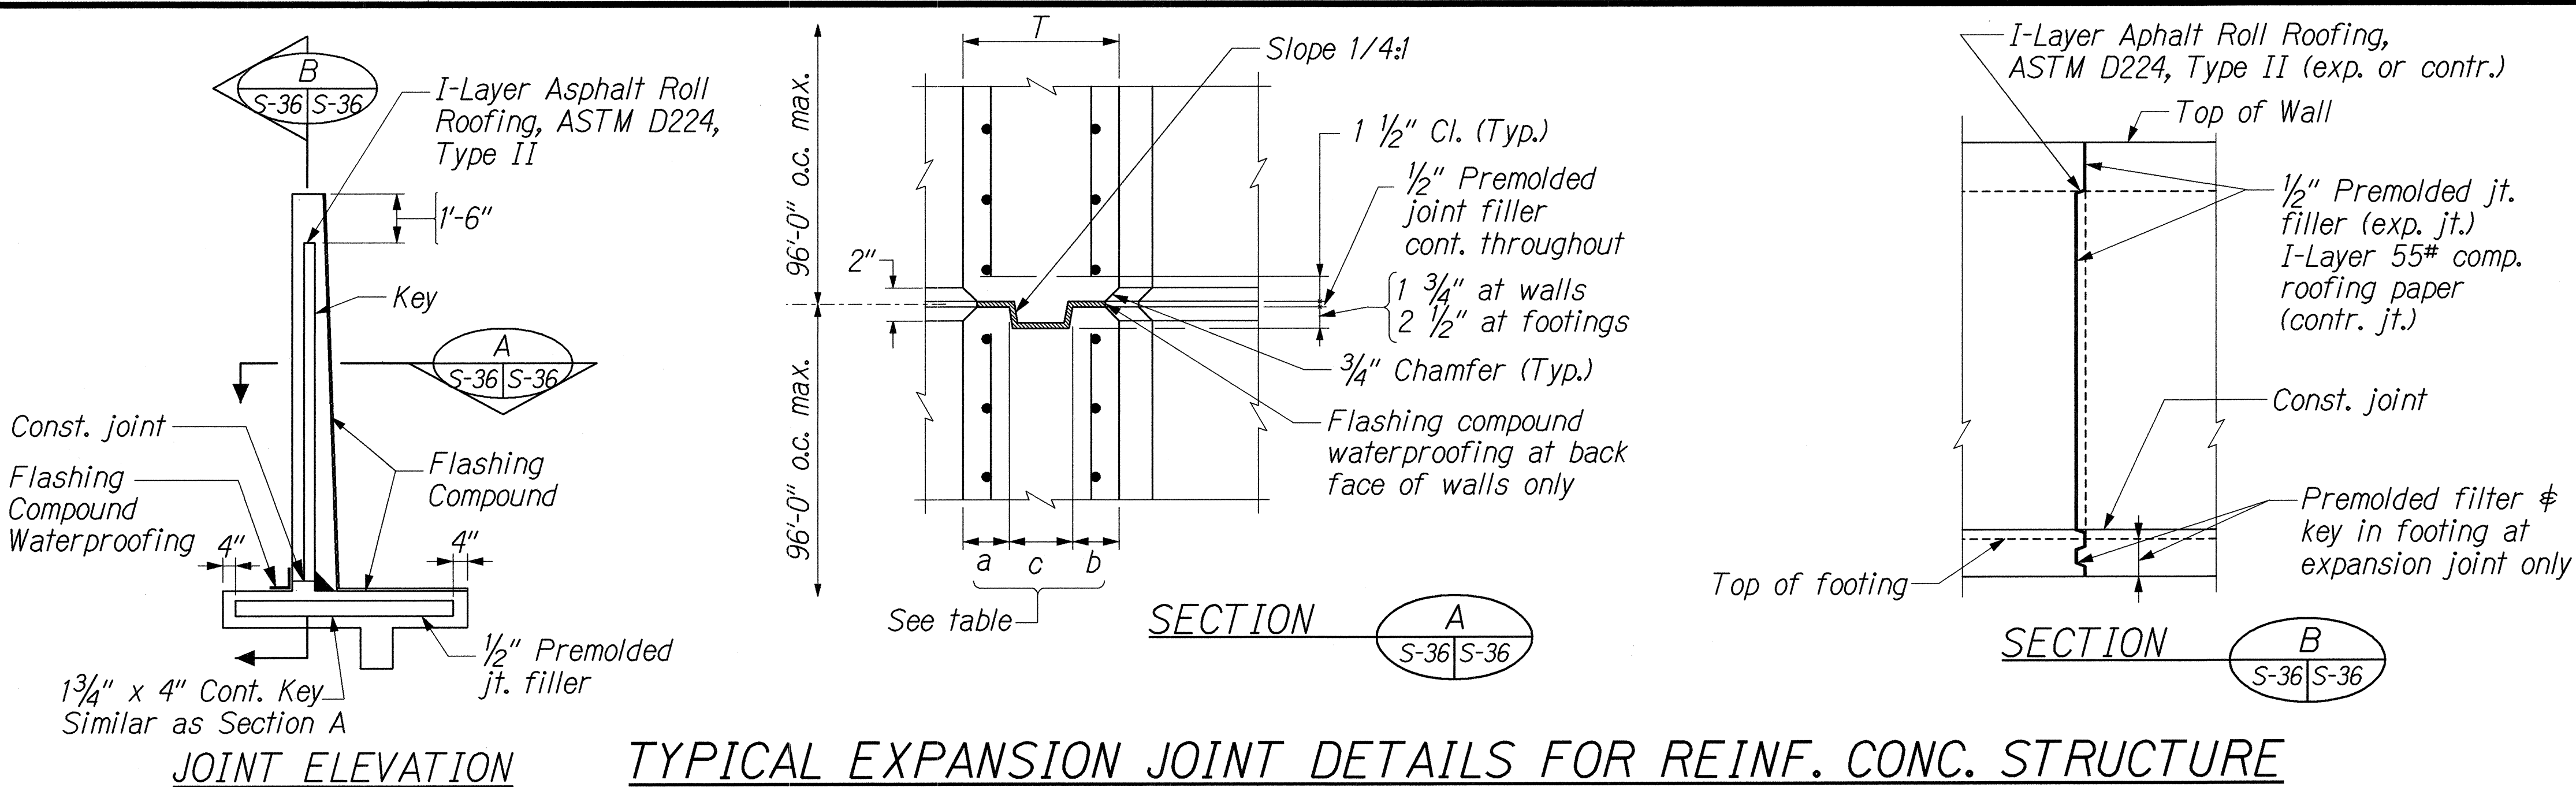

DATE	_____
SURVEY PLOTTED BY	_____
DRAWN BY	_____
DESIGNED BY	_____
CHECKED BY	_____
ORIGINAL PLAN	_____
NOTE BOOK	_____
NO.	_____



THIS WORK WAS PREPARED BY ME OR UNDER MY SUPERVISION.

Rui Pang Chen

STATE OF HAWAII
DEPARTMENT OF TRANSPORTATION
HIGHWAYS DIVISION

MISCELLANEOUS DETAILS-1

KUIHELANI HIGHWAY WIDENING
HONOAPIILANI HIGHWAY TO PUUNENE AVENUE
FEDERAL-AID PROJECT NO. NH-0380(9)
Scale: As Shown Date: Sept. 14, 2001

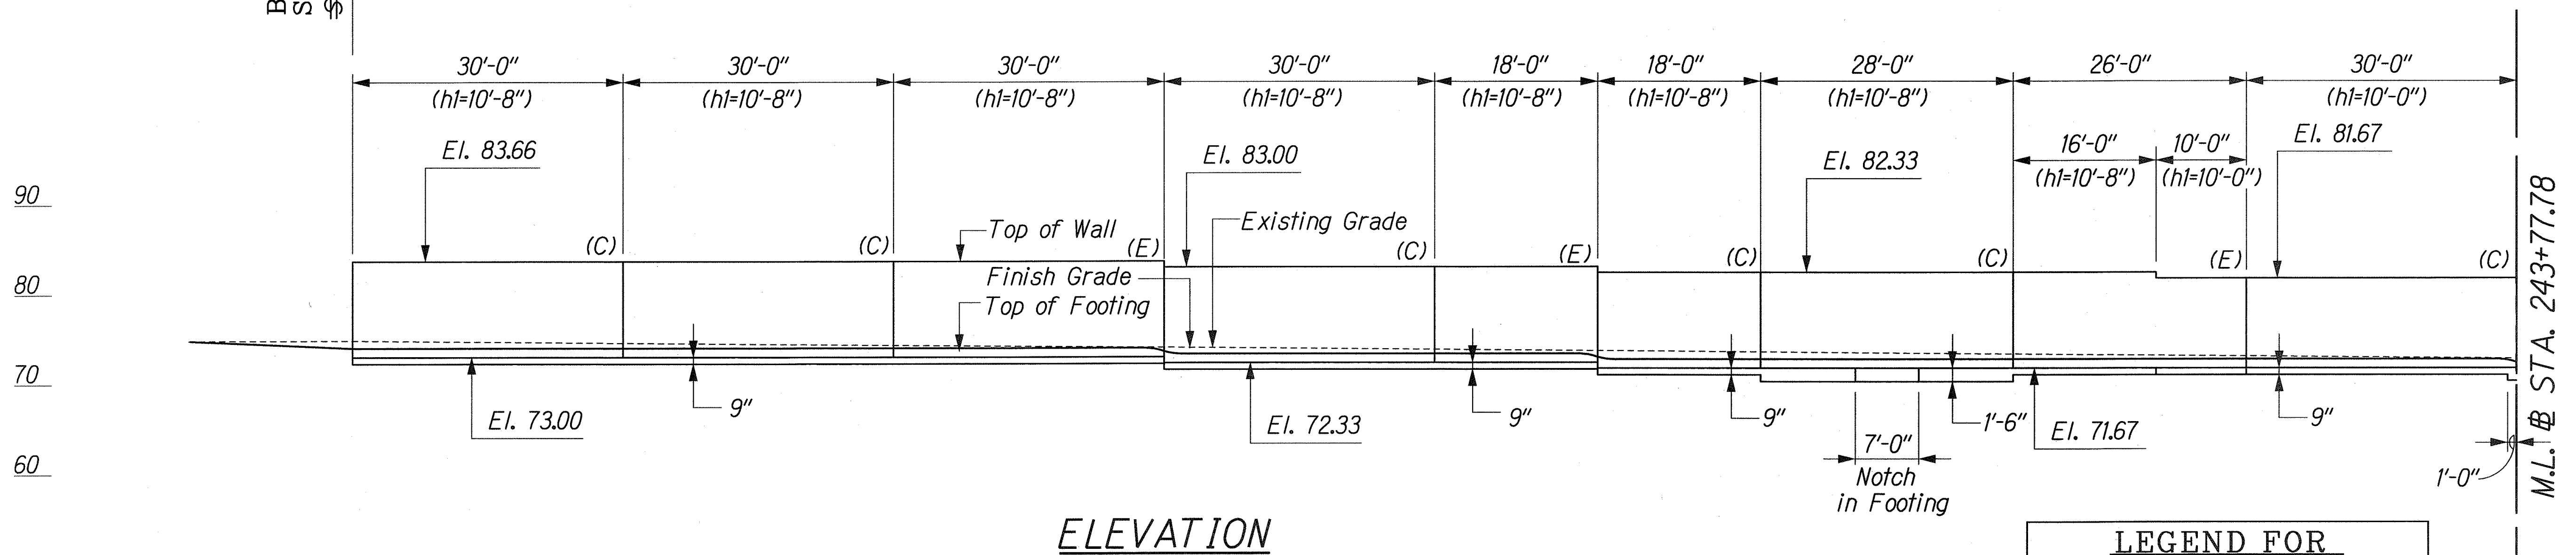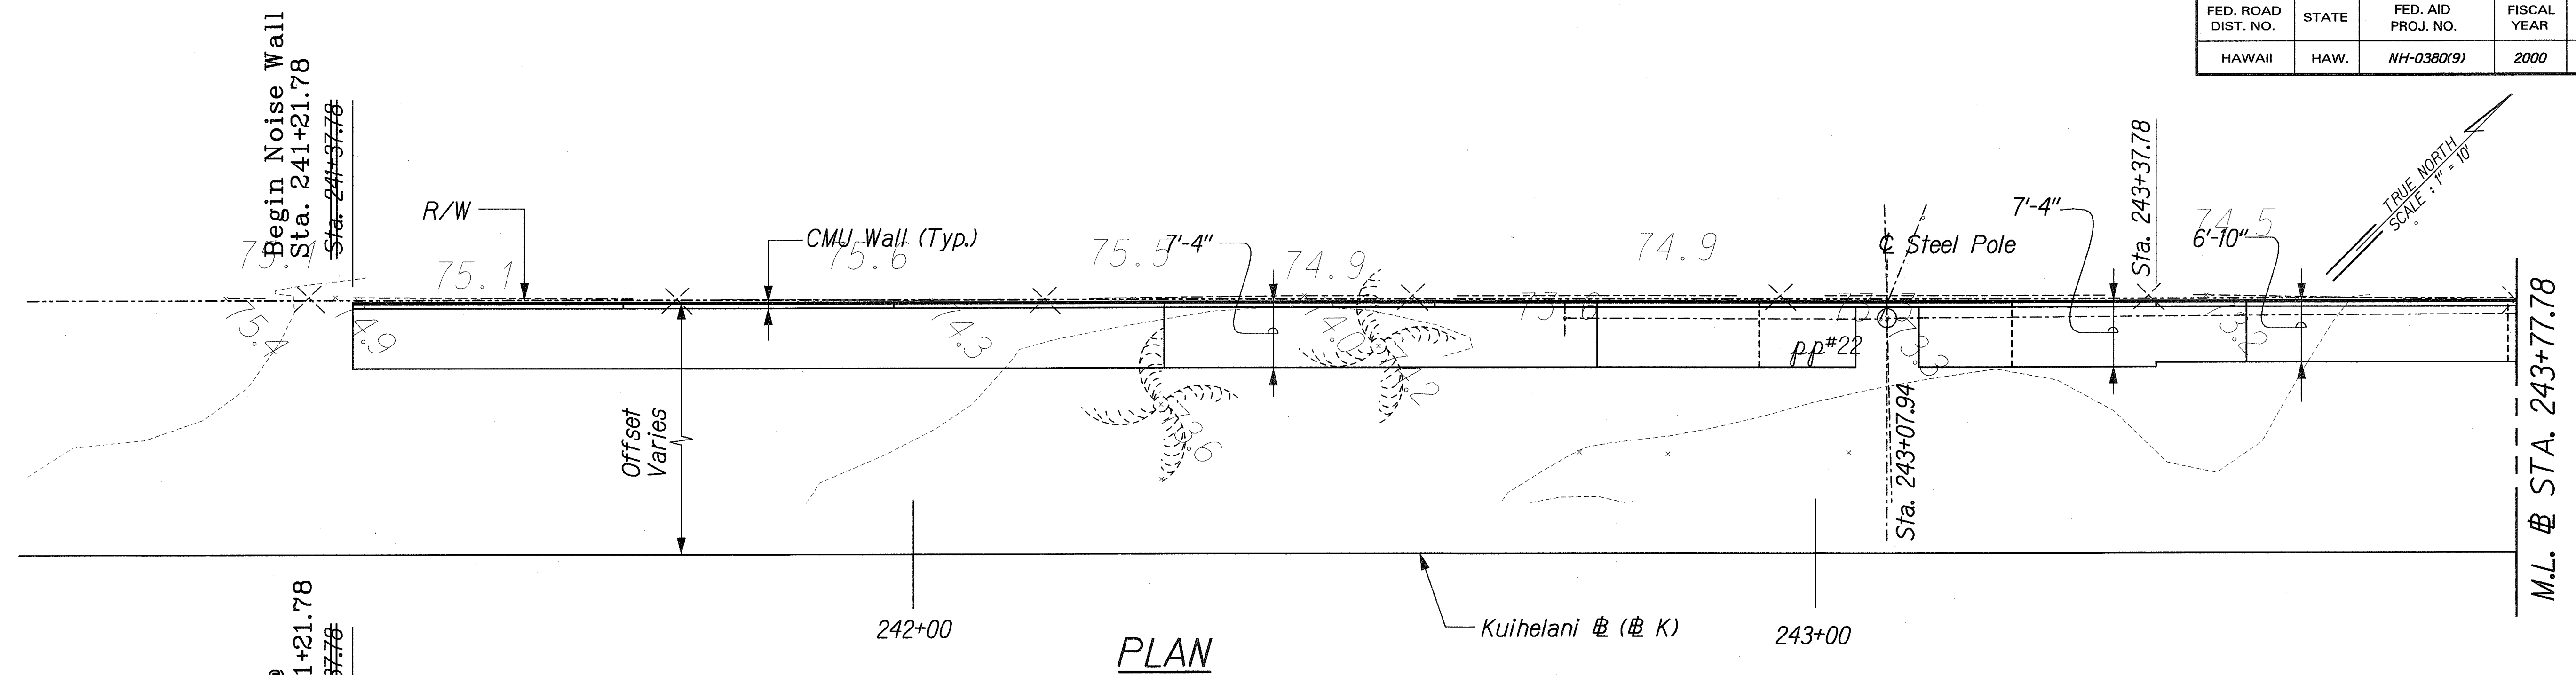

ESTIMATED QUANTITIES

ITEM NO.	ITEM	UNIT	QUANTITIES
513.	8'-0" Height CMU Noise Wall*	LF	300'
513.	8'-8" Height CMU Noise Wall*	LF	700'
513.	10'-0" Height CMU Noise Wall*	LF	1407'
513.	10'-8" Height CMU Noise Wall*	LF	1429'

* Quantities include Concrete Footing, Structure Excavation, Backfill, Class D Concrete Fill, CMU Units, Grout for CMU, and Reinforcing Steel.

LEGEND:

- (C) Denotes Control Joint
- (E) Denotes Expansion Joint
- Denotes Existing Wooden Pole to be removed
- Denotes Steel Pole (See Note 3)

NOTES:

- For detail of notch in footing for steel pole, See Sht. No. S-54.
- For details of control and expansion joints for CMU Wall, See Sht. No. S-53.
- The locations of the relocated steel poles are approximate per MECO. The contractor shall coordinate with MECO on the exact locations of steel poles prior to construction of the CMU wall panels which require a notched footing for the steel poles.
- The length of wall shown on Elevation is measured along the front face of wall.

LEGEND FOR AS-BUILT POSTINGS	
	Squiggly line for as-built deletion
	Double line for as-built deletion
Roadway	Text for as-built posting

STATE OF HAWAII
DEPARTMENT OF TRANSPORTATION
HIGHWAYS DIVISION


CMU NOISE WALL
PLAN & ELEVATION-1
KUIHELANI HIGHWAY WIDENING
HONOAPIILANI HIGHWAY TO PUUNENE AVENUE
FEDERAL-AID PROJECT NO. NH-0380(9)
Scale: 1" = 10' Date: Sept. 14, 2001

HUI PANG CHEN
LICENSED PROFESSIONAL ENGINEER
No. 3865-S
HAWAII, U.S.A.


THIS WORK WAS PREPARED BY ME OR UNDER MY SUPERVISION.
Hui Pang Chen

SHEET No. S-38 OF 54 SHEETS

FED. ROAD DIST. NO.	STATE	FED. AID PROJ. NO.	FISCAL YEAR	SHEET NO.	TOTAL SHEETS
HAWAII	HAW.	NH-0380(9)	2000	201	380

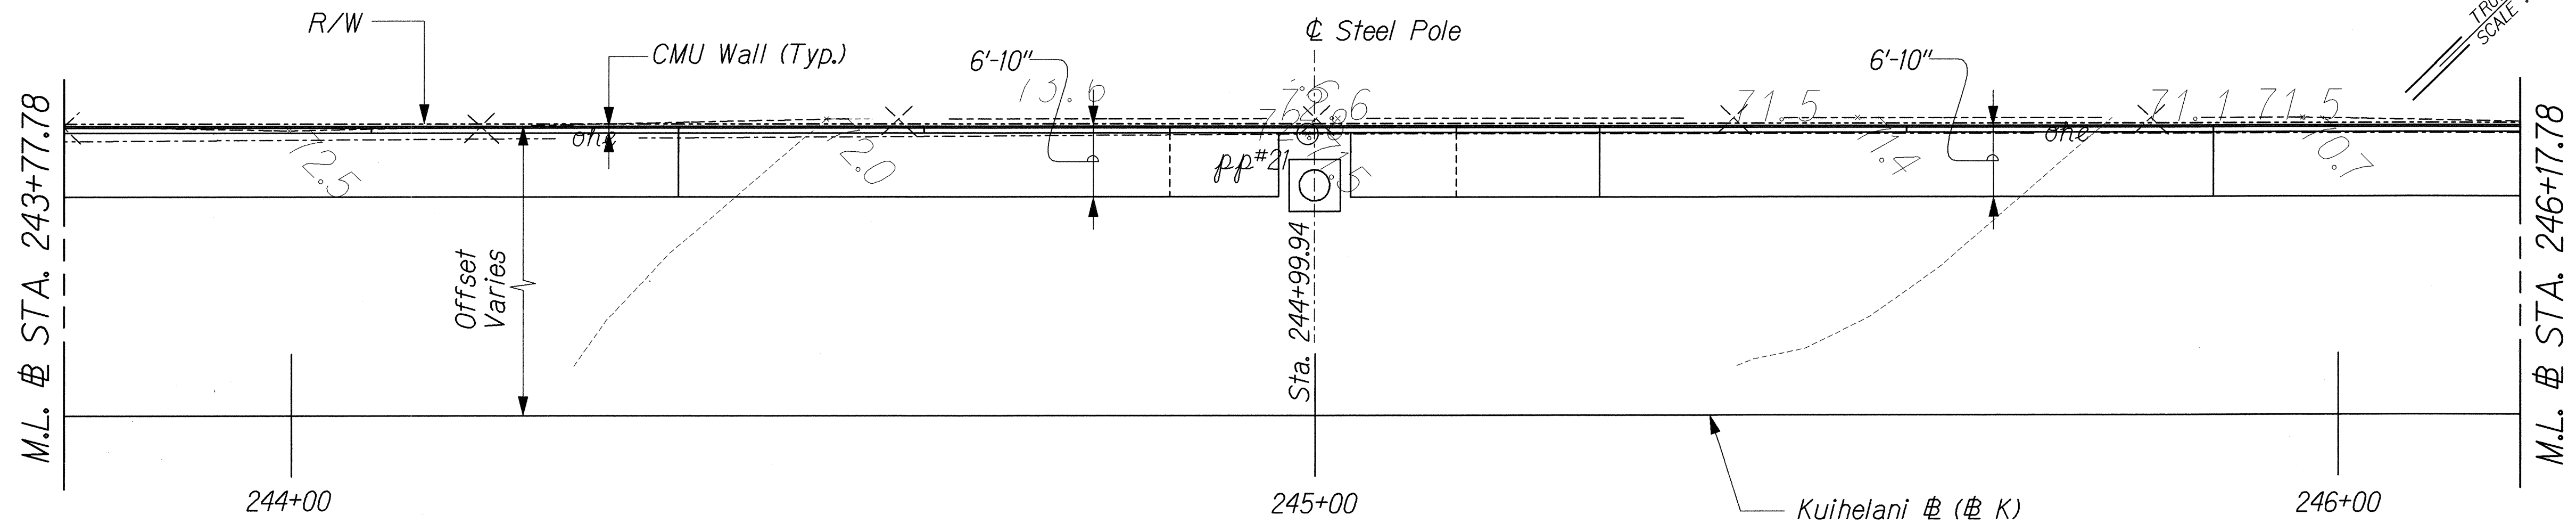

PLAN

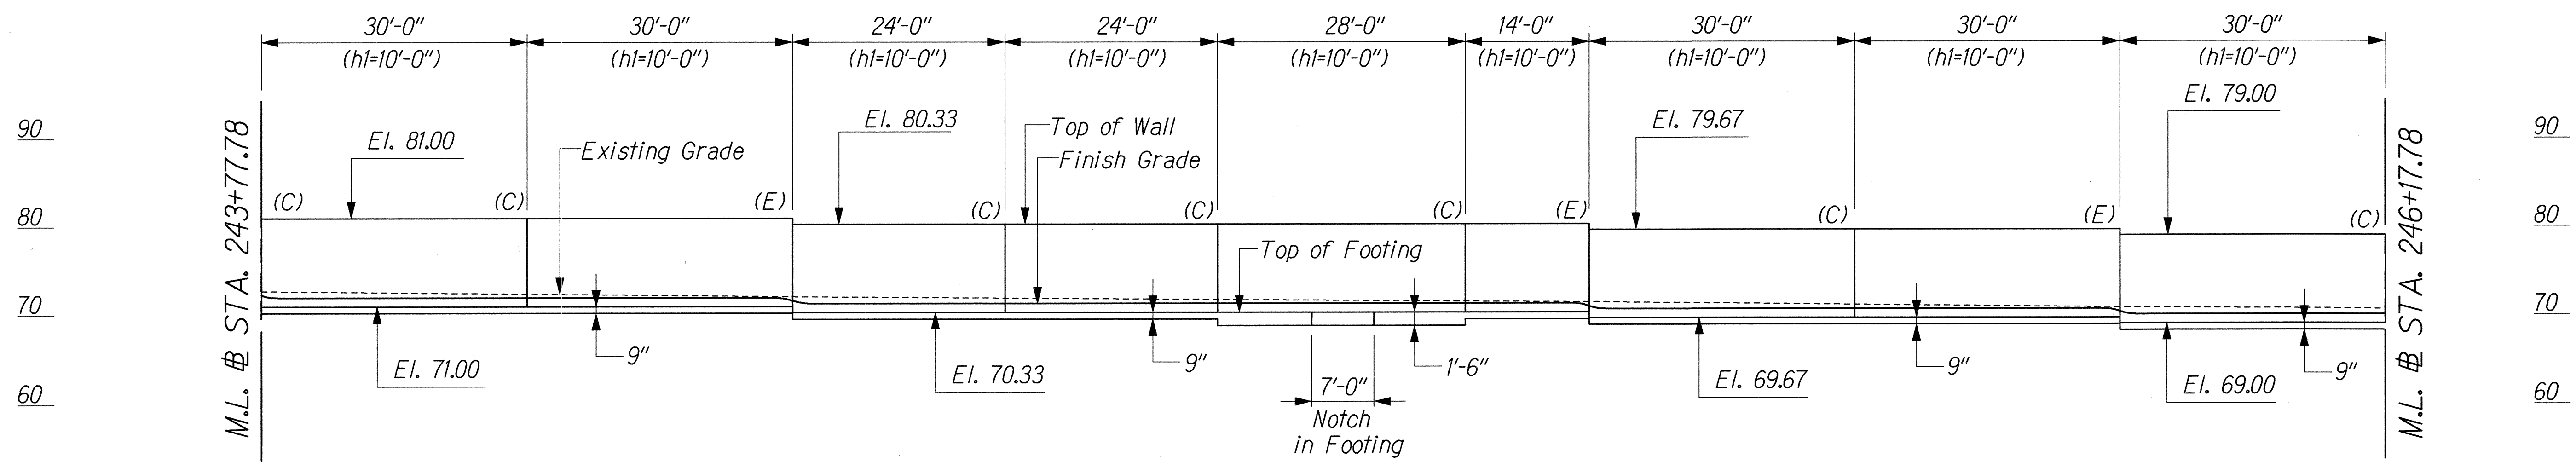

ELEVATION

NOTES:

1. See Legend on Sht. No. S-38.
2. See Notes on Sht. No. S-38.

ORIGINAL PLAN	SURVEY PLOTTED BY	DATE
NOTE BOOK	DRAWN BY	
No.	DESIGNED BY	
	CHECKED BY	

JG/KUIHELANI/STRUCT/11W-02.dgn

THIS WORK WAS PREPARED BY ME OR UNDER MY SUPERVISION.


Hui Pang Chen

STATE OF HAWAII
DEPARTMENT OF TRANSPORTATION
HIGHWAYS DIVISION


CMU NOISE WALL
PLAN & ELEVATION-2

KUIHELANI HIGHWAY WIDENING
HONOAPIILANI HIGHWAY TO PUUNENE AVENUE
FEDERAL-AID PROJECT NO. NH-0380(9)
Scale: 1" = 10' Date: Sept. 14, 2001

FED. ROAD DIST. NO.	STATE	FED. AID PROJ. NO.	FISCAL YEAR	SHEET NO.	TOTAL SHEETS
HAWAII	HAW.	NH-0380(9)	2000	202	380

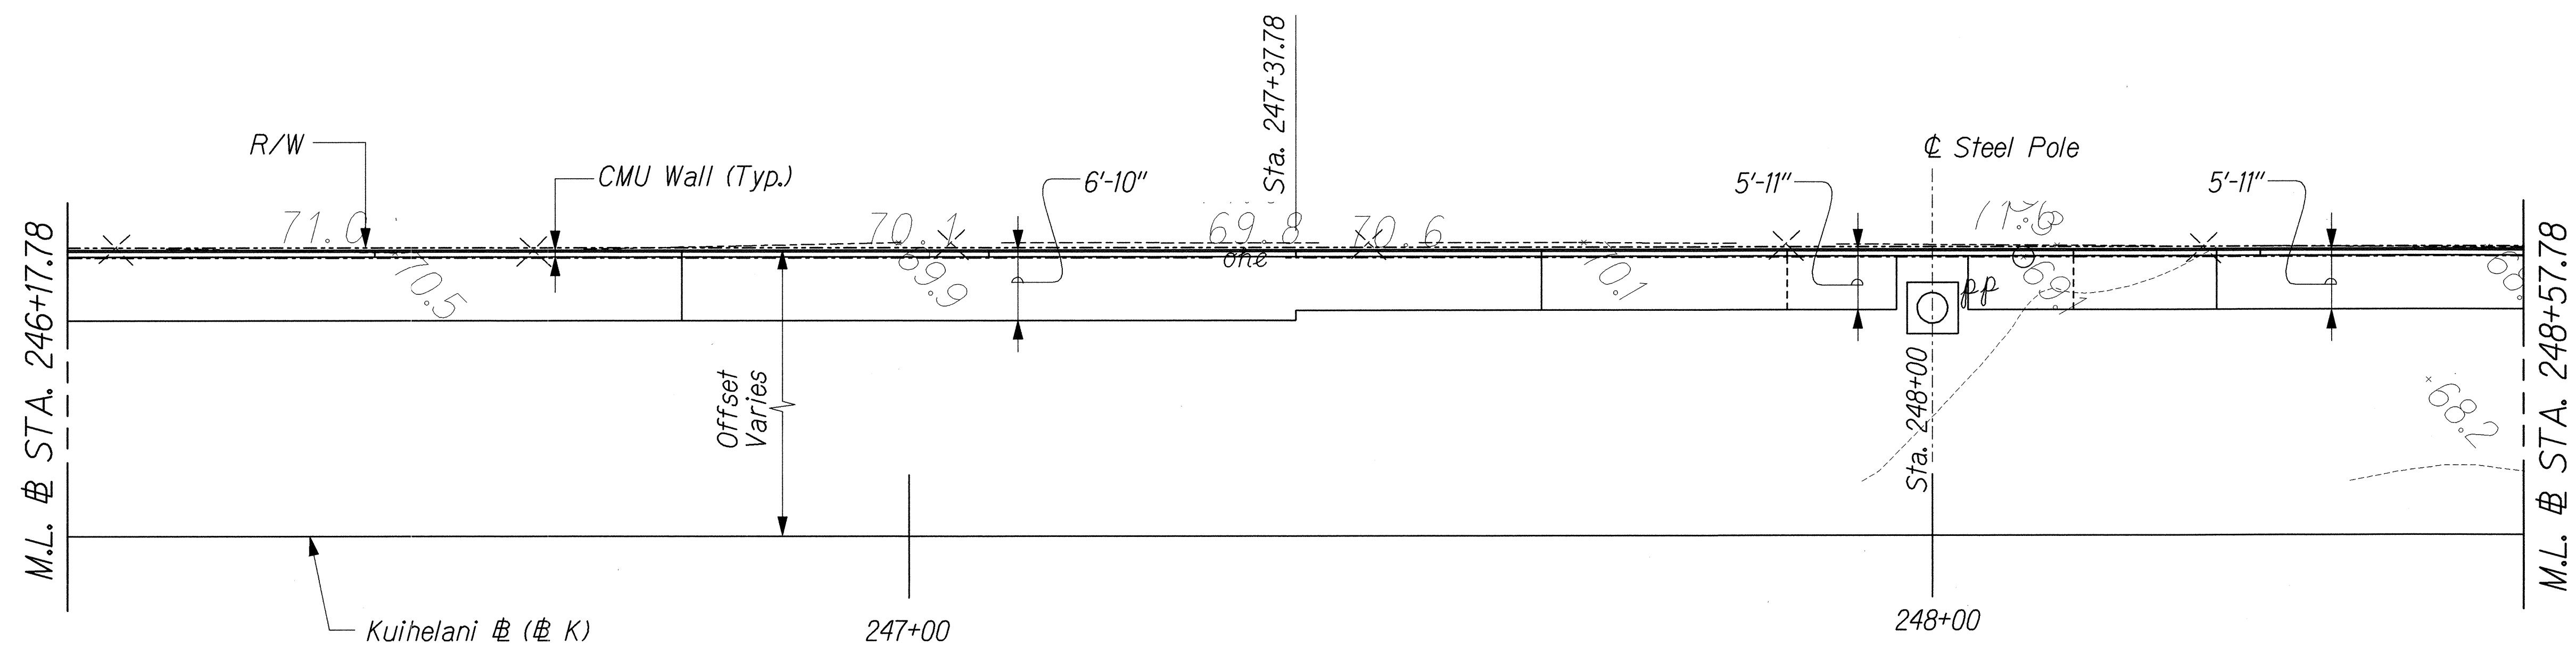

PLAN

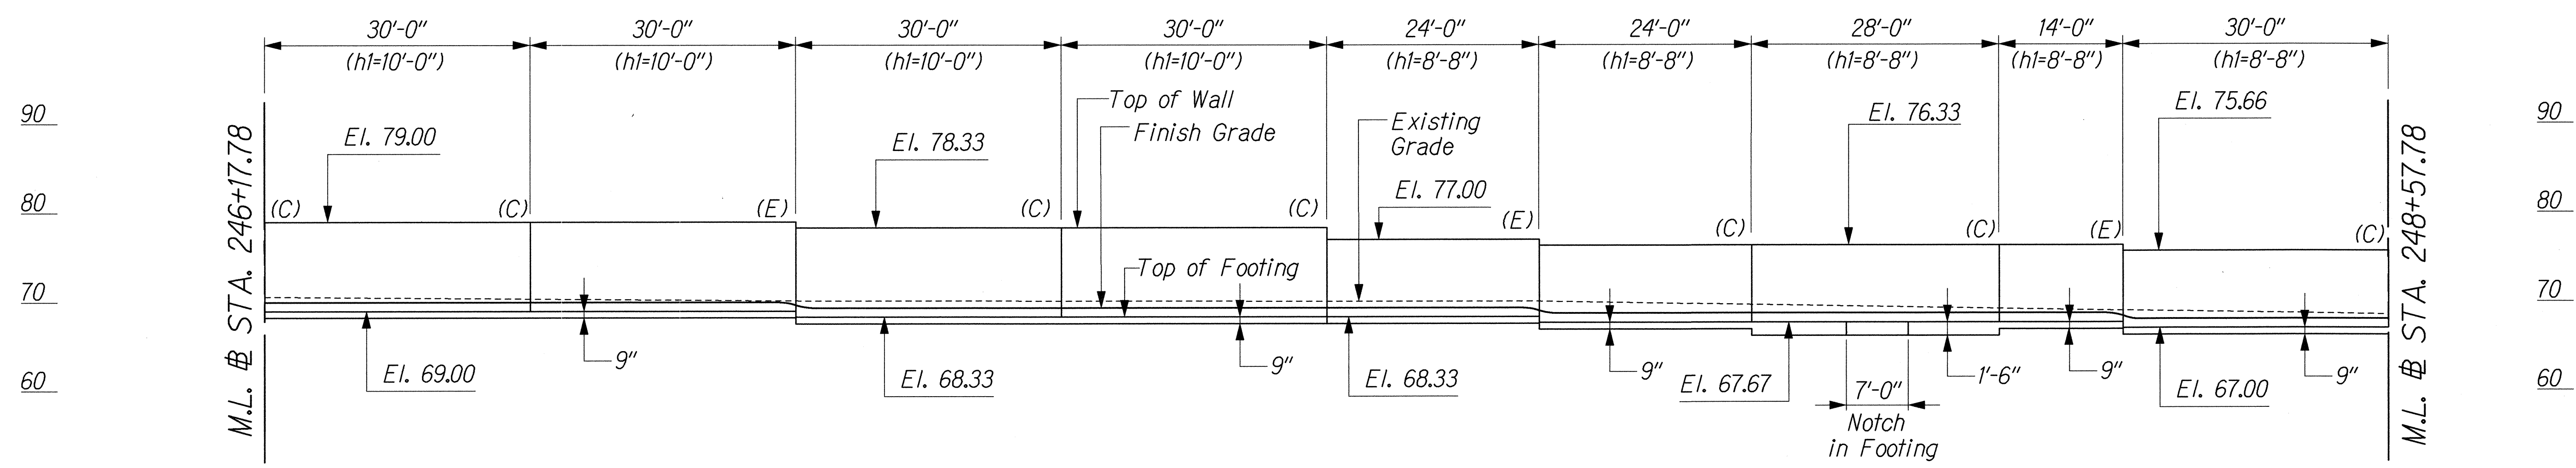

ELEVATION

- NOTES:
1. See Legend on Sht. No. S-38.
 2. See Notes on Sht. No. S-38.

ORIGINAL PLAN	DATE
SURVEY PLOTTED BY	
DRAWN BY	
TRACED BY	
DESIGNED BY	
QUANTITIES BY	
CHECKED BY	
N.	

J:\KUIHELANI\STRUCT\NW-03.dgn

THIS WORK WAS PREPARED BY ME OR UNDER MY SUPERVISION.


Hui Pang Chen

STATE OF HAWAII
DEPARTMENT OF TRANSPORTATION
HIGHWAYS DIVISION


CMU NOISE WALL
PLAN & ELEVATION-3
KUIHELANI HIGHWAY WIDENING
HONOAPIILANI HIGHWAY TO PUUNENE AVENUE
FEDERAL-AID PROJECT NO. NH-0380(9)
Scale: 1" = 10' Date: Sept. 14, 2001

SHEET No. S-40 OF 54 SHEETS

FED. ROAD DIST. NO.	STATE	FED. AID PROJ. NO.	FISCAL YEAR	SHEET NO.	TOTAL SHEETS
HAWAII	HAW.	NH-0380(9)	2000	203	380

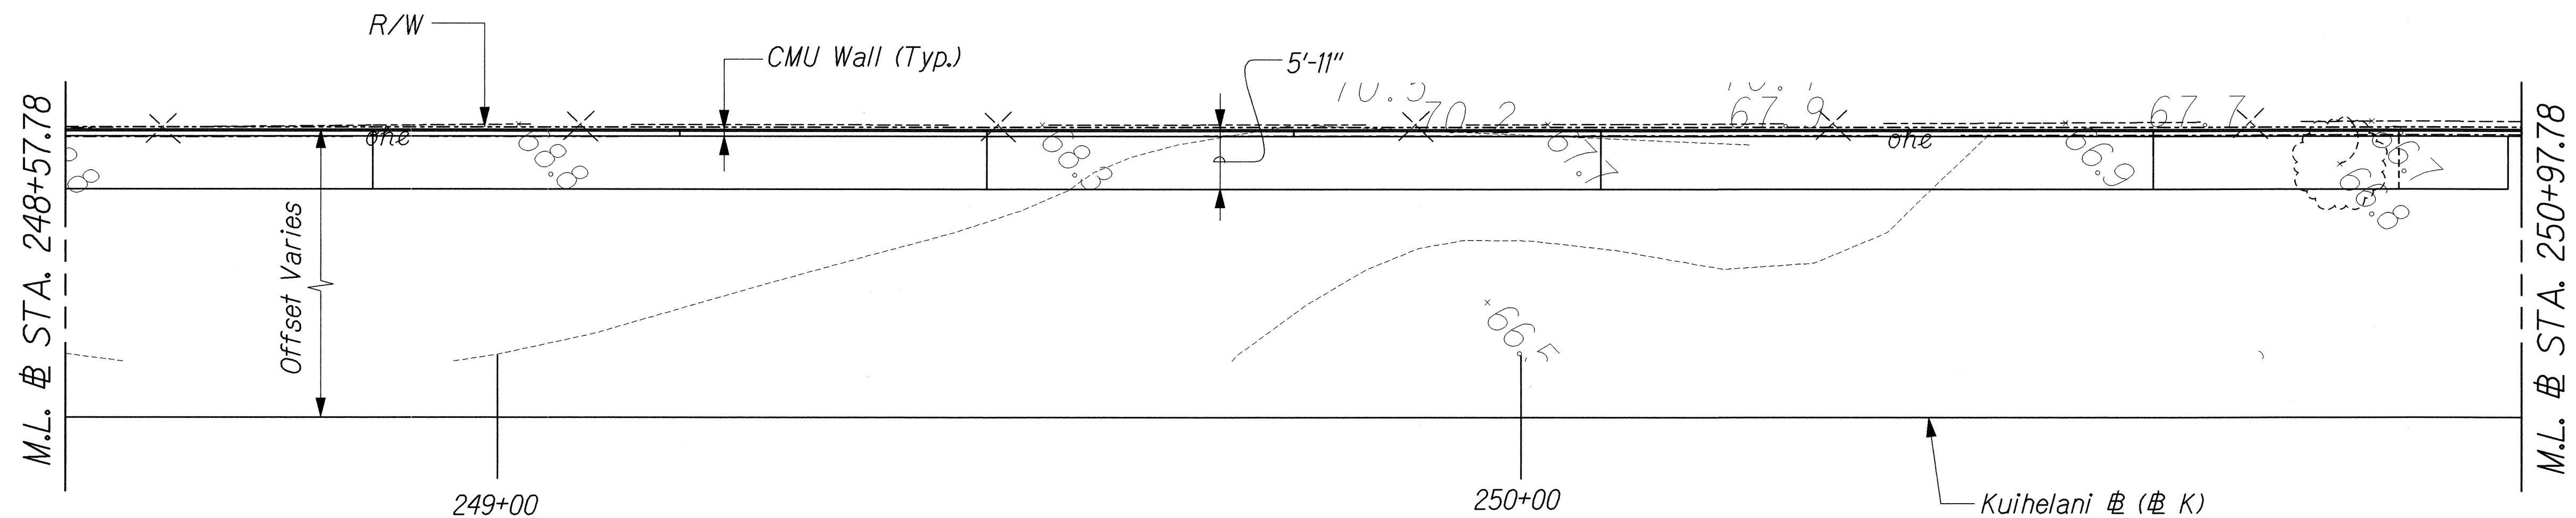

PLAN

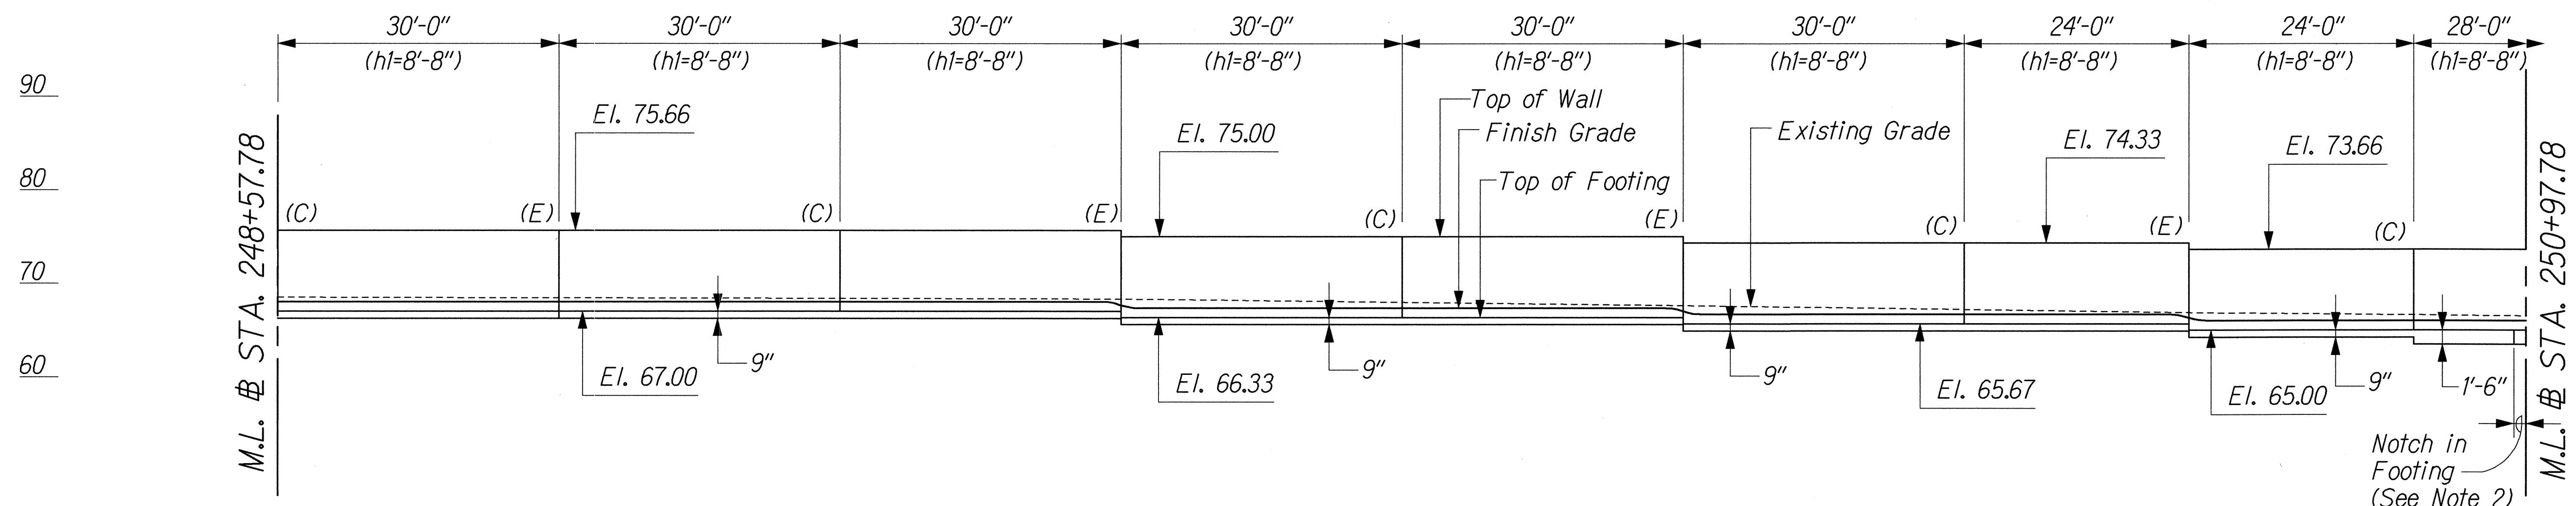

ELEVATION

NOTES:

1. See Legend on Sht. No. S-38.
2. See Notes 1, 2, and 4 on Sht. No. S-38.

ORIGINAL PLAN	SURVEY PLOTTED BY	DATE
NOTE BOOK	DRAWN BY	
	DESIGNED BY	
	CHECKED BY	

J:\KUIHELANI\STRUCT\NW-04.dgn


THIS WORK WAS PREPARED BY ME OR UNDER MY SUPERVISION.

Hui Pang Chen


STATE OF HAWAII
DEPARTMENT OF TRANSPORTATION
HIGHWAYS DIVISION

CMU NOISE WALL
PLAN & ELEVATION-4
KUIHELANI HIGHWAY WIDENING
HONOAPIILANI HIGHWAY TO PUUNENE AVENUE
FEDERAL-AID PROJECT NO. NH-0380(9)
Scale: 1" = 10' Date: Sept. 14, 2001

FED. ROAD DIST. NO.	STATE	FED. AID PROJ. NO.	FISCAL YEAR	SHEET NO.	TOTAL SHEETS
HAWAII	HAW.	NH-0380(9)	2000	205	380

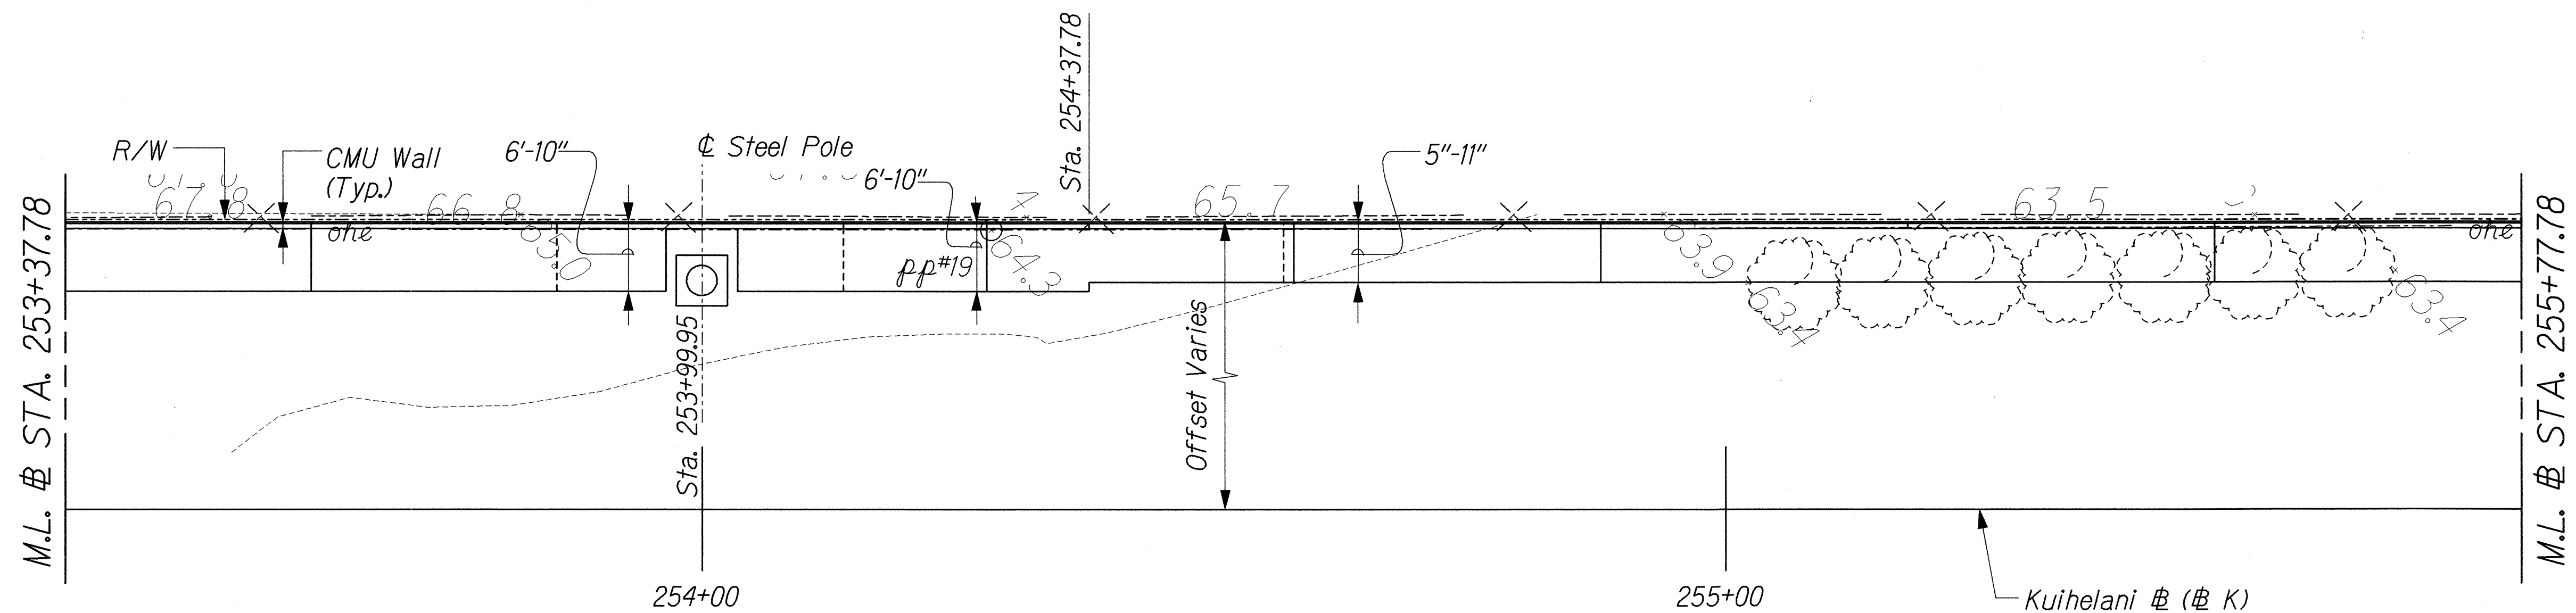

PLAN

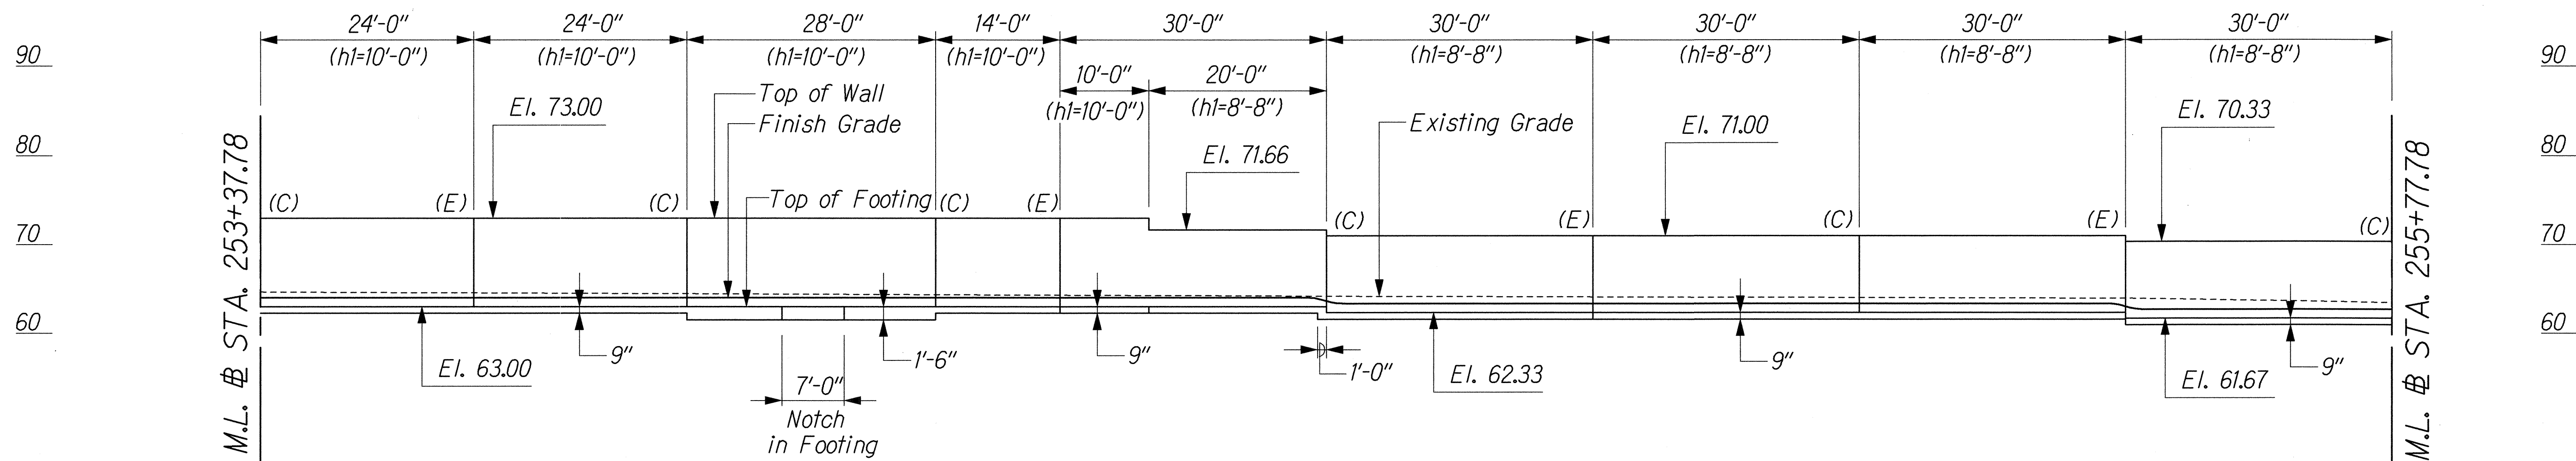

ELEVATION

NOTES:

1. See Legend on Sht. No. S-38.
2. See Notes on Sht. No. S-38.

ORIGINAL PLAN	SURVEY PLOTTED BY	DATE
NOTE BOOK	DRAWN BY	
	DESIGNED BY	
	CHECKED BY	
	IN CHARGE	

J:\KUIHELANI\STRUCT\NW-06.dgn

THIS WORK WAS PREPARED BY ME OR UNDER MY SUPERVISION.


Hui Pang Chen

STATE OF HAWAII
DEPARTMENT OF TRANSPORTATION
HIGHWAYS DIVISION


CMU NOISE WALL
PLAN & ELEVATION-6

KUIHELANI HIGHWAY WIDENING
HONOAPIILANI HIGHWAY TO PUUNENE AVENUE
FEDERAL-AID PROJECT NO. NH-0380(9)
Scale: 1" = 10' Date: Sept. 14, 2001

FED. ROAD DIST. NO.	STATE	FED. AID PROJ. NO.	FISCAL YEAR	SHEET NO.	TOTAL SHEETS
HAWAII	HAW.	NH-0380(9)	2000	206	380

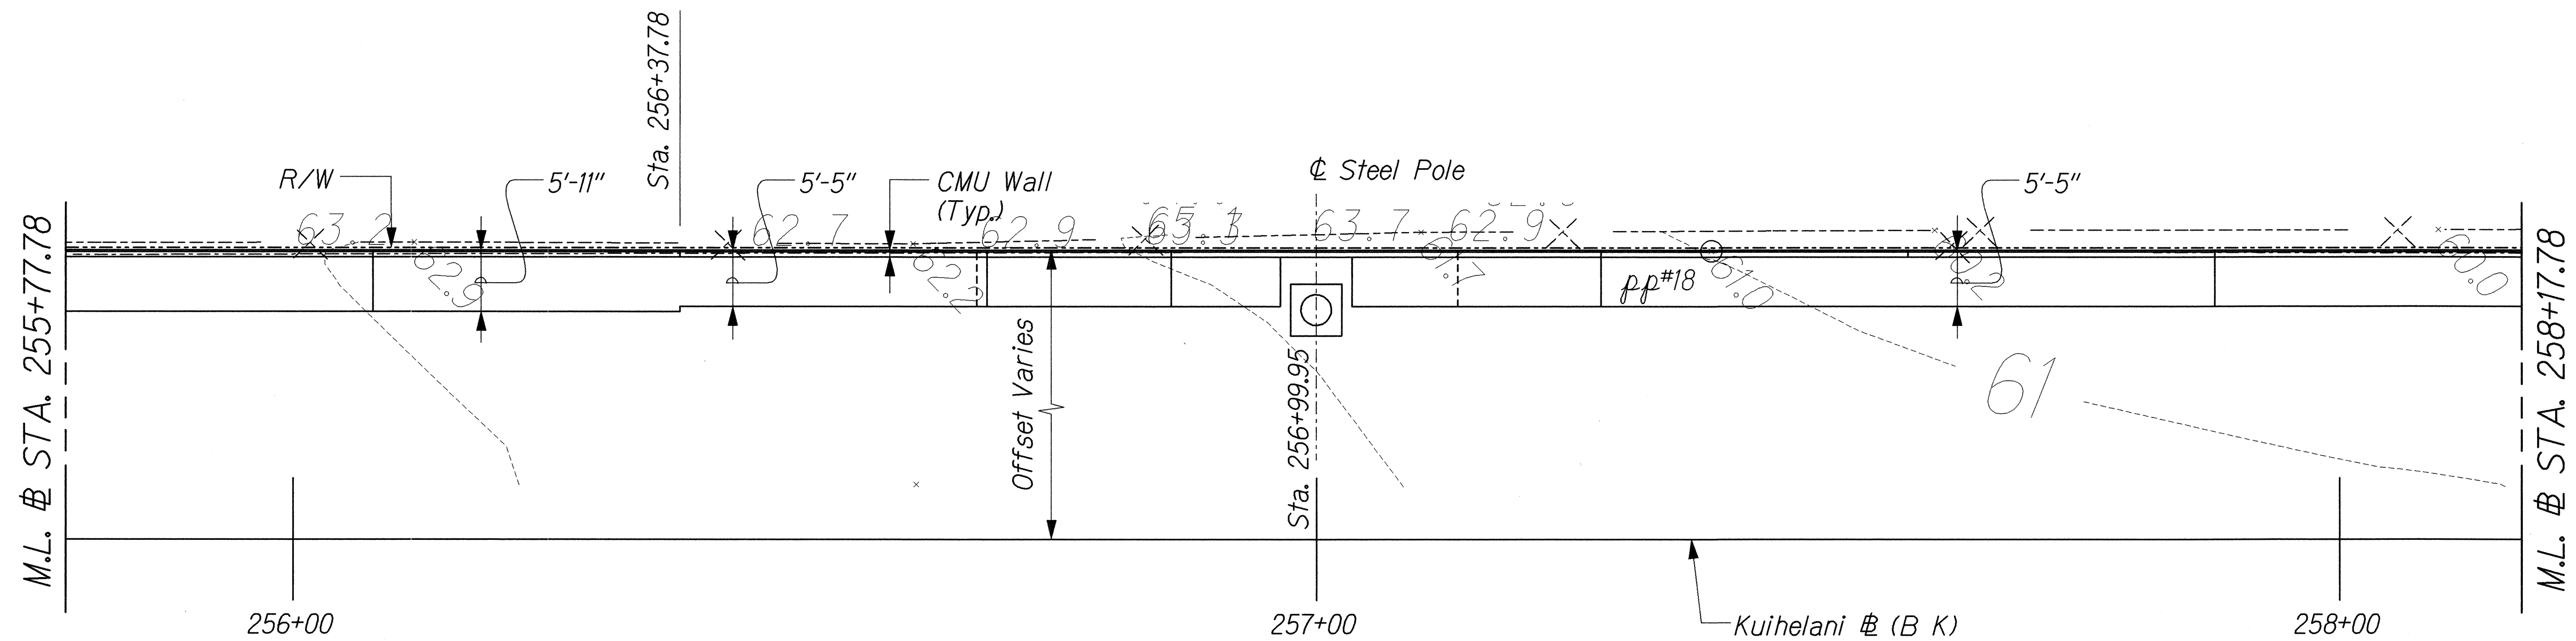

PLAN

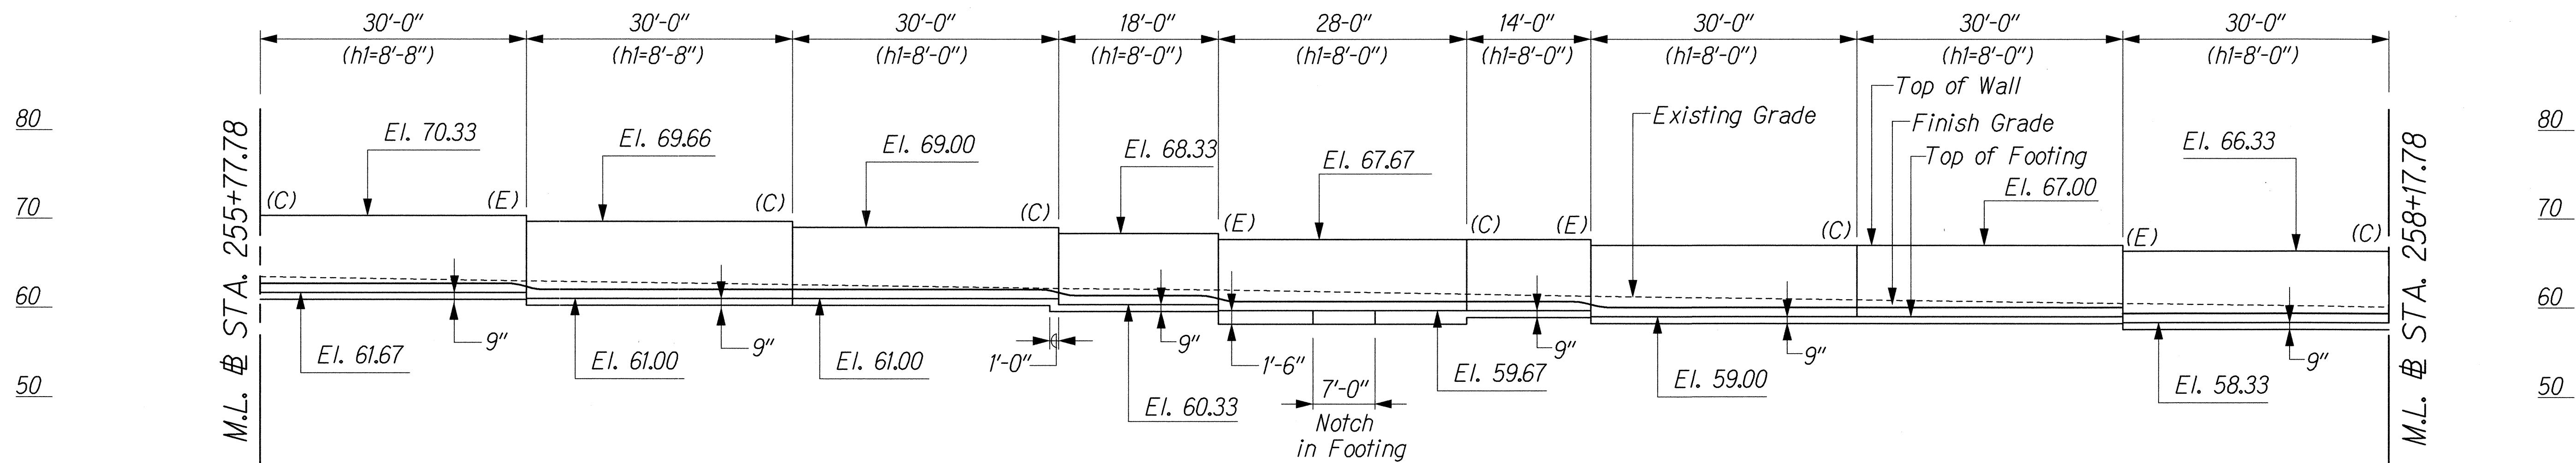

ELEVATION

NOTES:

- See Legend on Sht. No. S-38.
- See Notes on Sht. No. S-38.

ORIGINAL PLAN	SURVEY PLOTTED BY	DATE
NOTE BOOK	DRAWN BY	
NO.	DESIGNED BY	
	CHECKED BY	

J:\KUIHELANI\STRUCT\NH-07.dgn

STATE OF HAWAII
DEPARTMENT OF TRANSPORTATION
HIGHWAYS DIVISION

**CMU NOISE WALL
PLAN & ELEVATION-7**

KUIHELANI HIGHWAY WIDENING
HONOAPIILANI HIGHWAY TO PUUNENE AVENUE
FEDERAL-AID PROJECT NO. NH-0380(9)
Scale: 1" = 10' Date: Sept. 14, 2001


THIS WORK WAS PREPARED BY ME
OR UNDER MY SUPERVISION.

Hui Pang Chen


HUI PANG CHEN
LICENSED PROFESSIONAL ENGINEER
No. 3865-S
HAWAII, U.S.A.

SHEET No. S-44 OF 54 SHEETS

FED. ROAD DIST. NO.	STATE	FED. AID PROJ. NO.	FISCAL YEAR	SHEET NO.	TOTAL SHEETS
HAWAII	HAW.	NH-0380(9)	2000	207	380

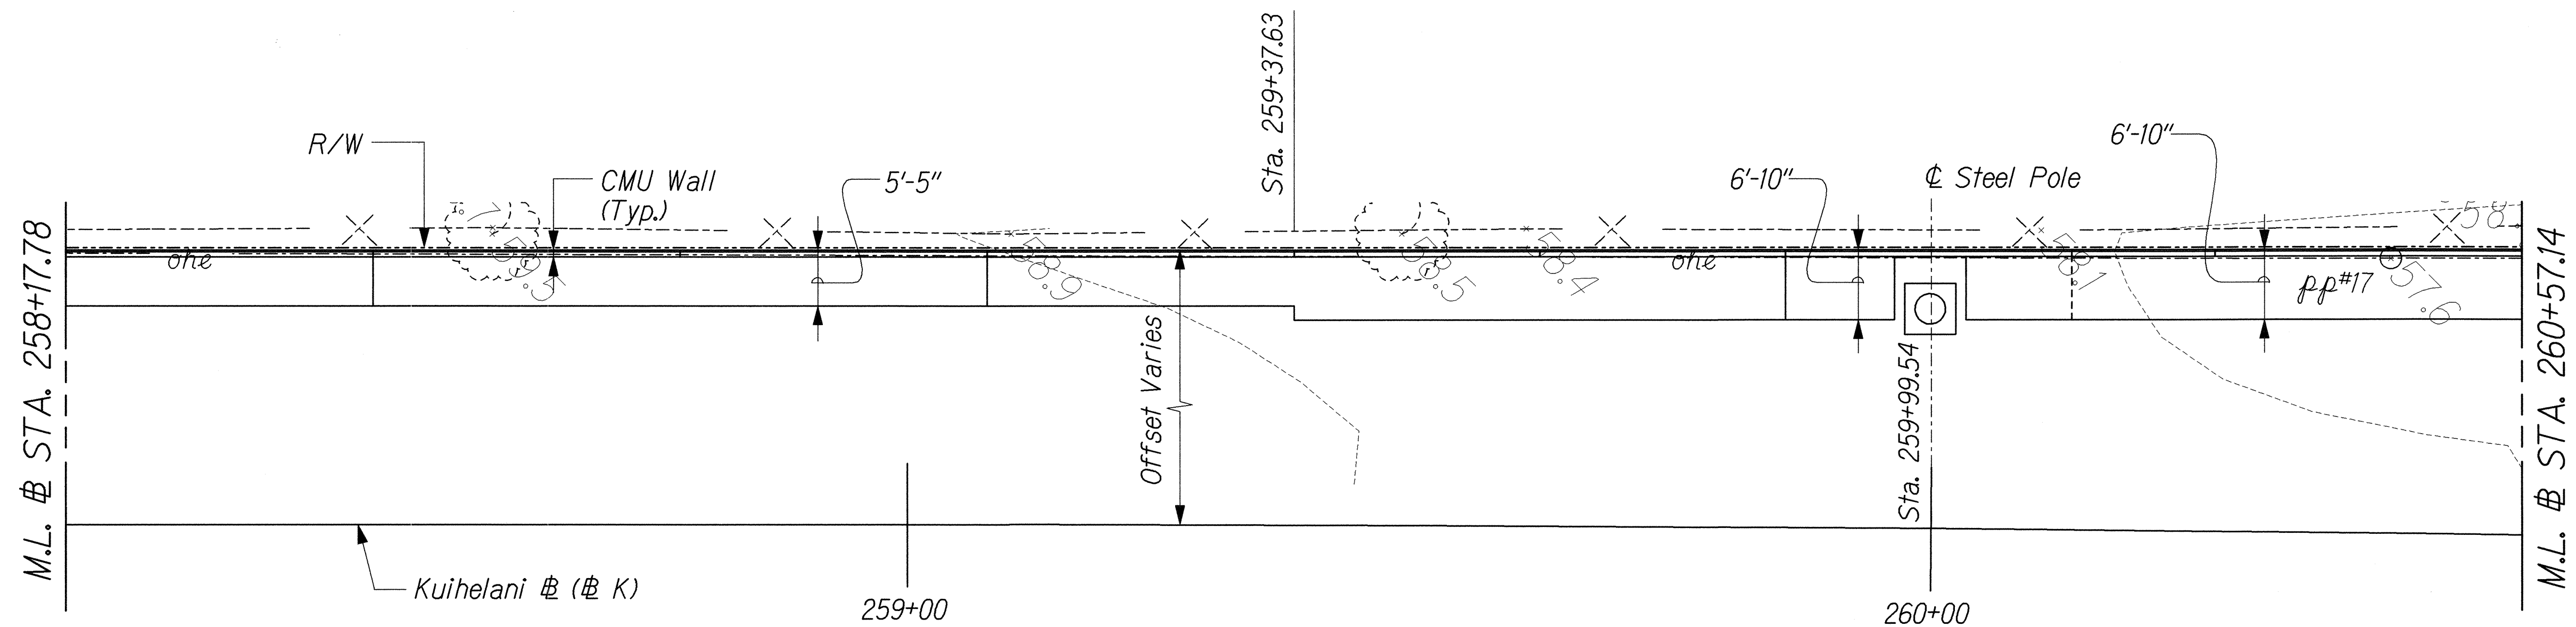

PLAN

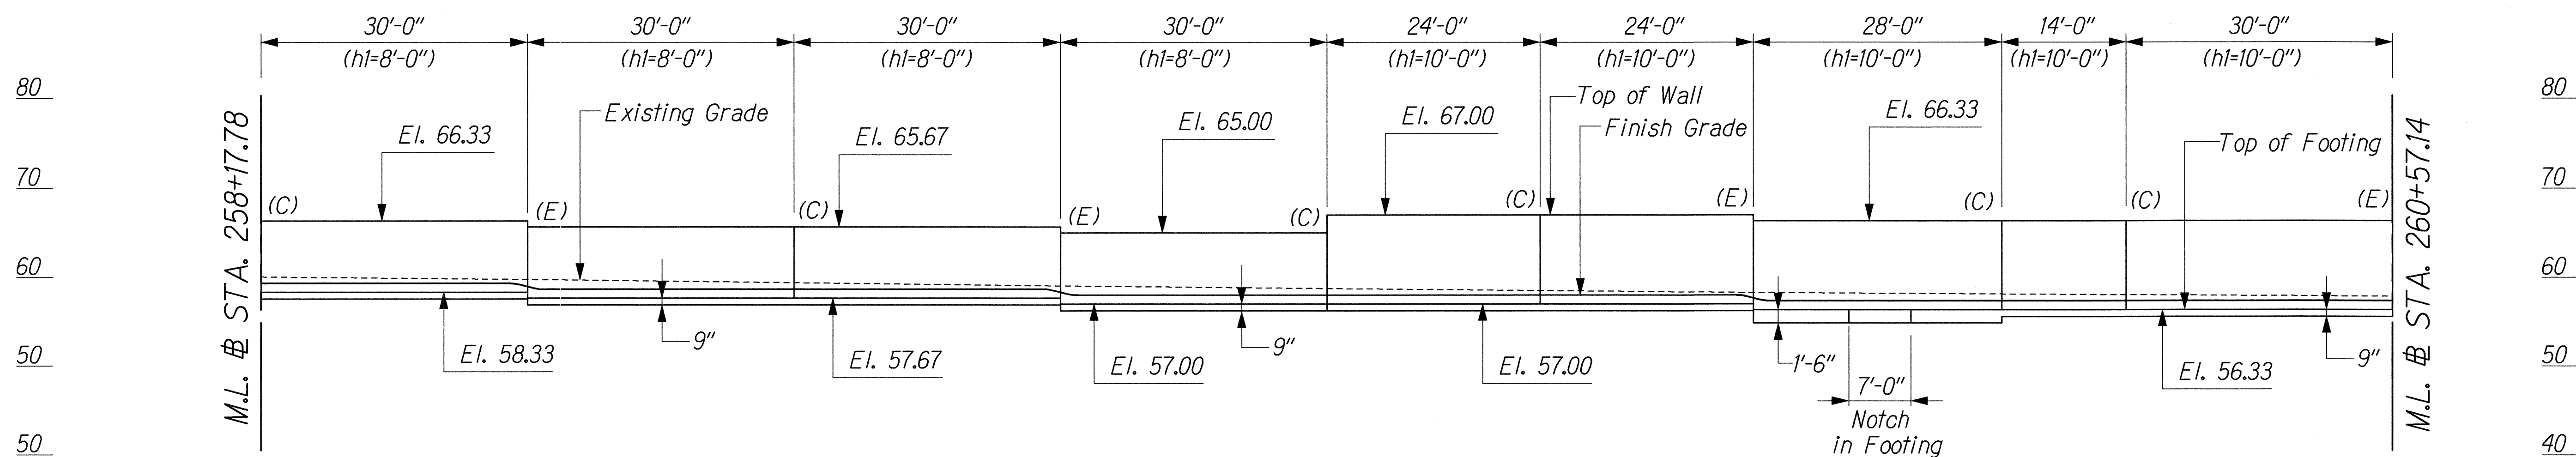

ELEVATION

NOTES:

1. See Legend on Sht. No. S-38.
2. See Notes on Sht. No. S-38.

ORIGINAL PLAN	SURVEY PLOTTED BY	DATE
NOTE BOOK	DRAWN BY	
	DESIGNED BY	
	CHECKED BY	

J:\KUIHELANI\STRUCT\NW-08.dgn

THIS WORK WAS PREPARED BY ME
OR UNDER MY SUPERVISION.


Hui Pang Chen

STATE OF HAWAII
DEPARTMENT OF TRANSPORTATION
HIGHWAYS DIVISION


CMU NOISE WALL
PLAN & ELEVATION-8

KUIHELANI HIGHWAY WIDENING
HONOAPIILANI HIGHWAY TO PUUNENE AVENUE
FEDERAL-AID PROJECT NO. NH-0380(9)
Scale: 1" = 10' Date: Sept. 14, 2001

FED. ROAD DIST. NO.	STATE	FED. AID PROJ. NO.	FISCAL YEAR	SHEET NO.	TOTAL SHEETS
HAWAII	HAW.	NH-0380(9)	2000	208	380

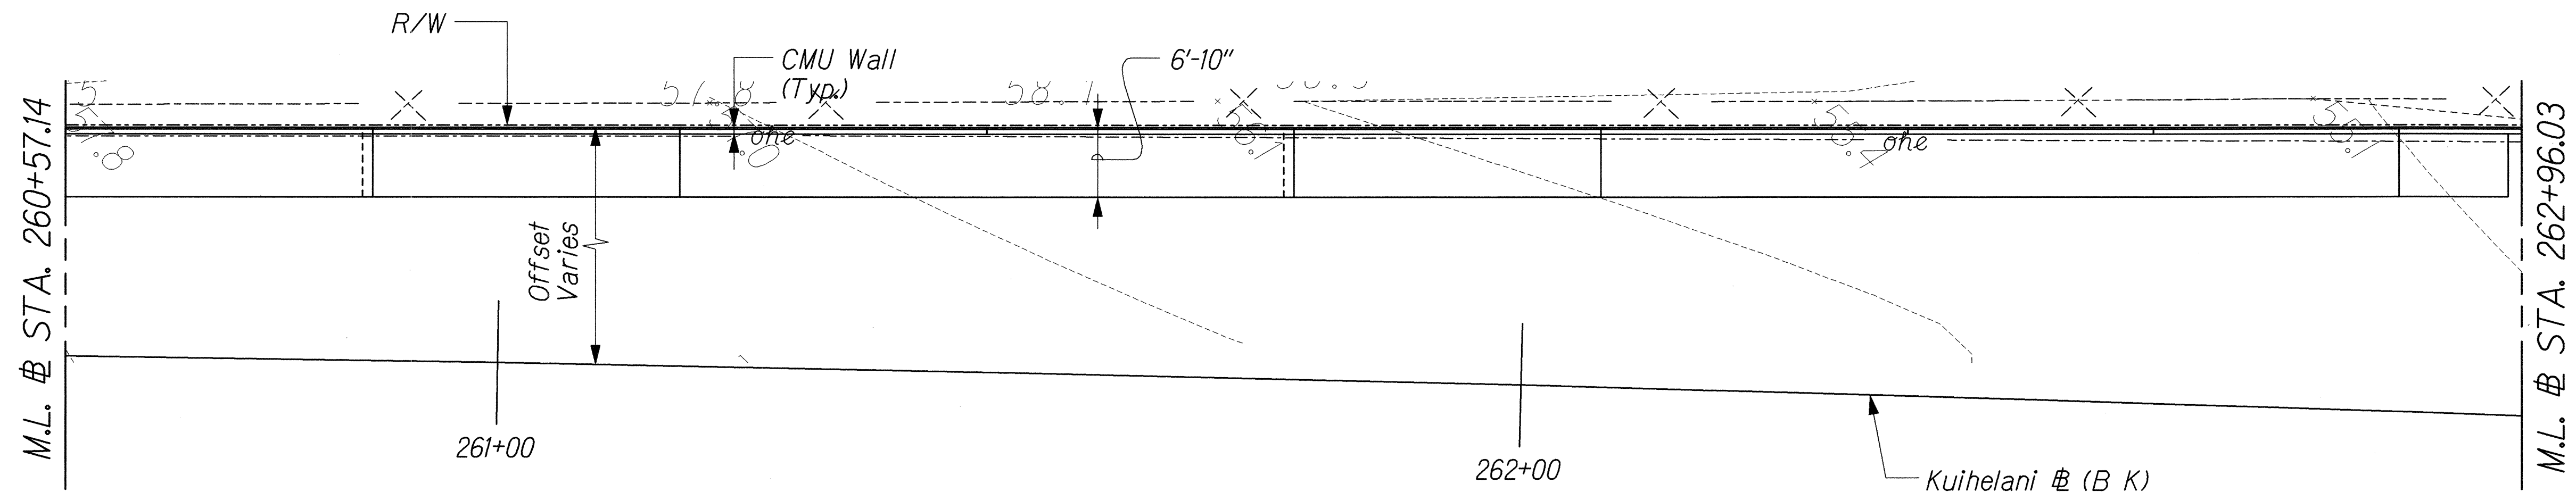

PLAN

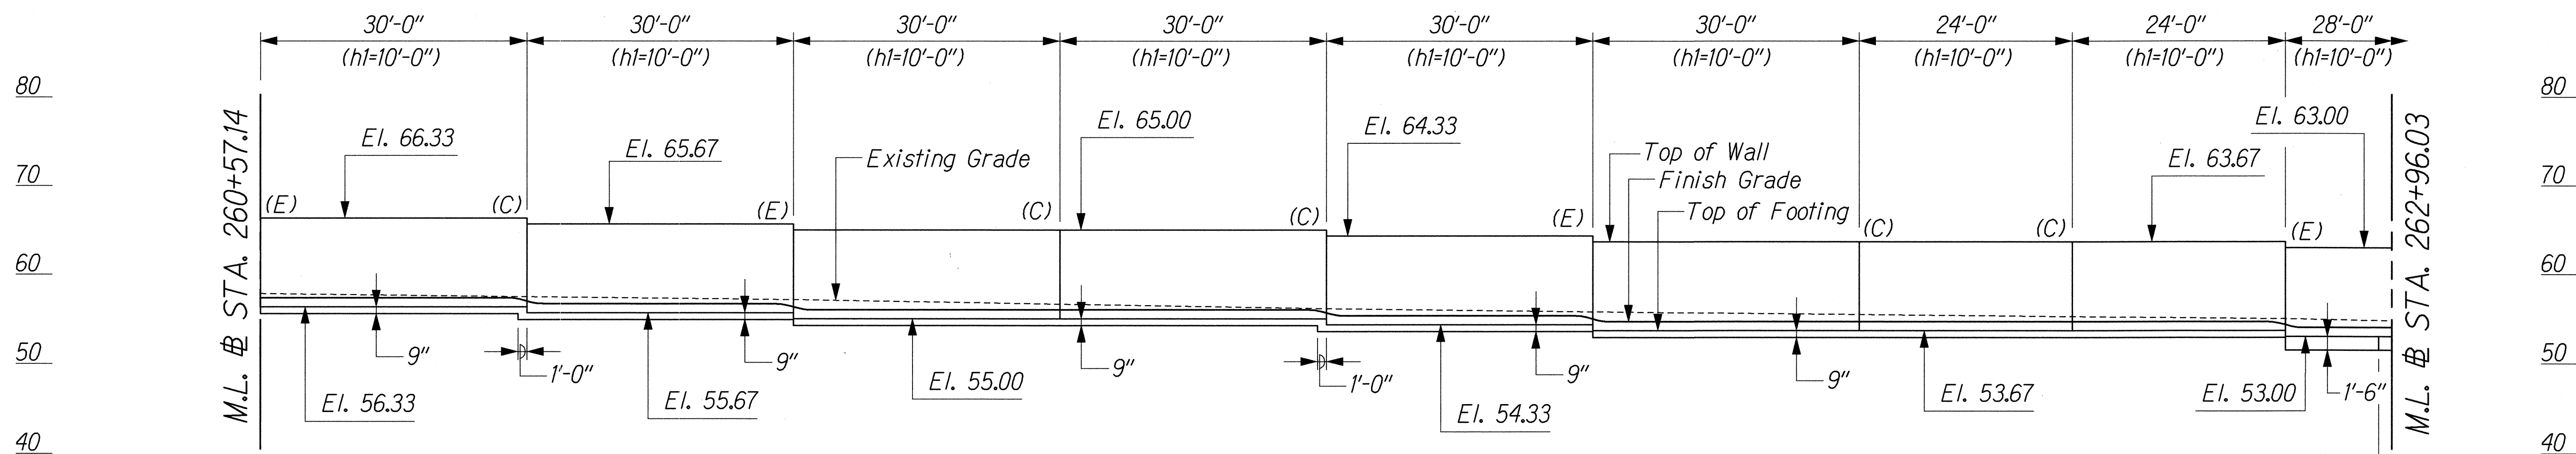


ELEVATION

NOTES:


1. See Legend on Sht. No. S-38.
2. See Notes 1, 2, and 4 on Sht. No. S-38.

ORIGINAL PLAN	SURVEY PLOTTED BY	DATE
NOTE BOOK	DRAWN BY	
NO.	DESIGNED BY	
	CHECKED BY	


J:\KUIHELANI\STRUCT\NH-09.dgn

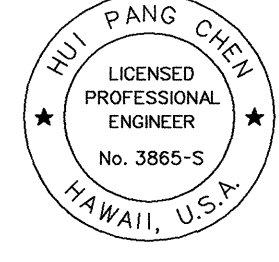 THIS WORK WAS PREPARED BY ME OR UNDER MY SUPERVISION. <i>Rui Pang Chen</i>	STATE OF HAWAII DEPARTMENT OF TRANSPORTATION HIGHWAYS DIVISION CMU NOISE WALL PLAN & ELEVATION-9 KUIHELANI HIGHWAY WIDENING HONOAPIILANI HIGHWAY TO PUUNENE AVENUE FEDERAL-AID PROJECT NO. NH-0380(9) Scale: 1" = 10' Date: Sept. 14, 2001
	SHEET No. S-46 OF 54 SHEETS
	208

FED. ROAD DIST. NO.	STATE	FED. AID PROJ. NO.	FISCAL YEAR	SHEET NO.	TOTAL SHEETS
HAWAII	HAW.	NH-0380(9)	2000	209	380

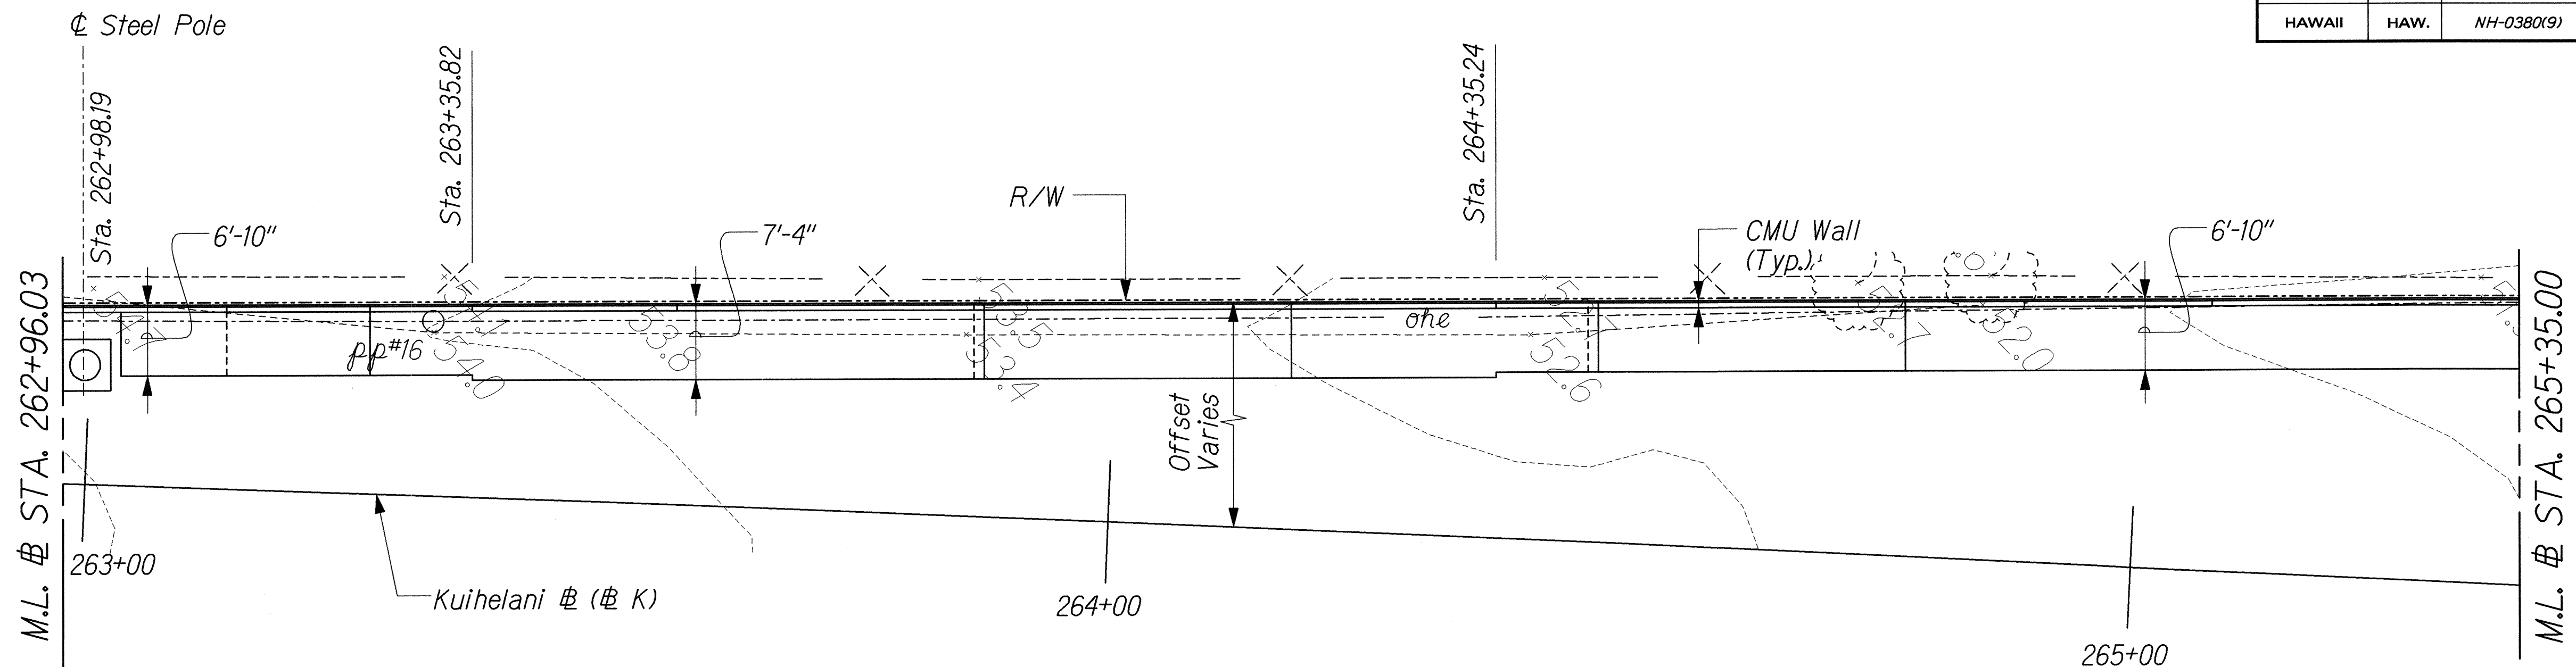

PLAN

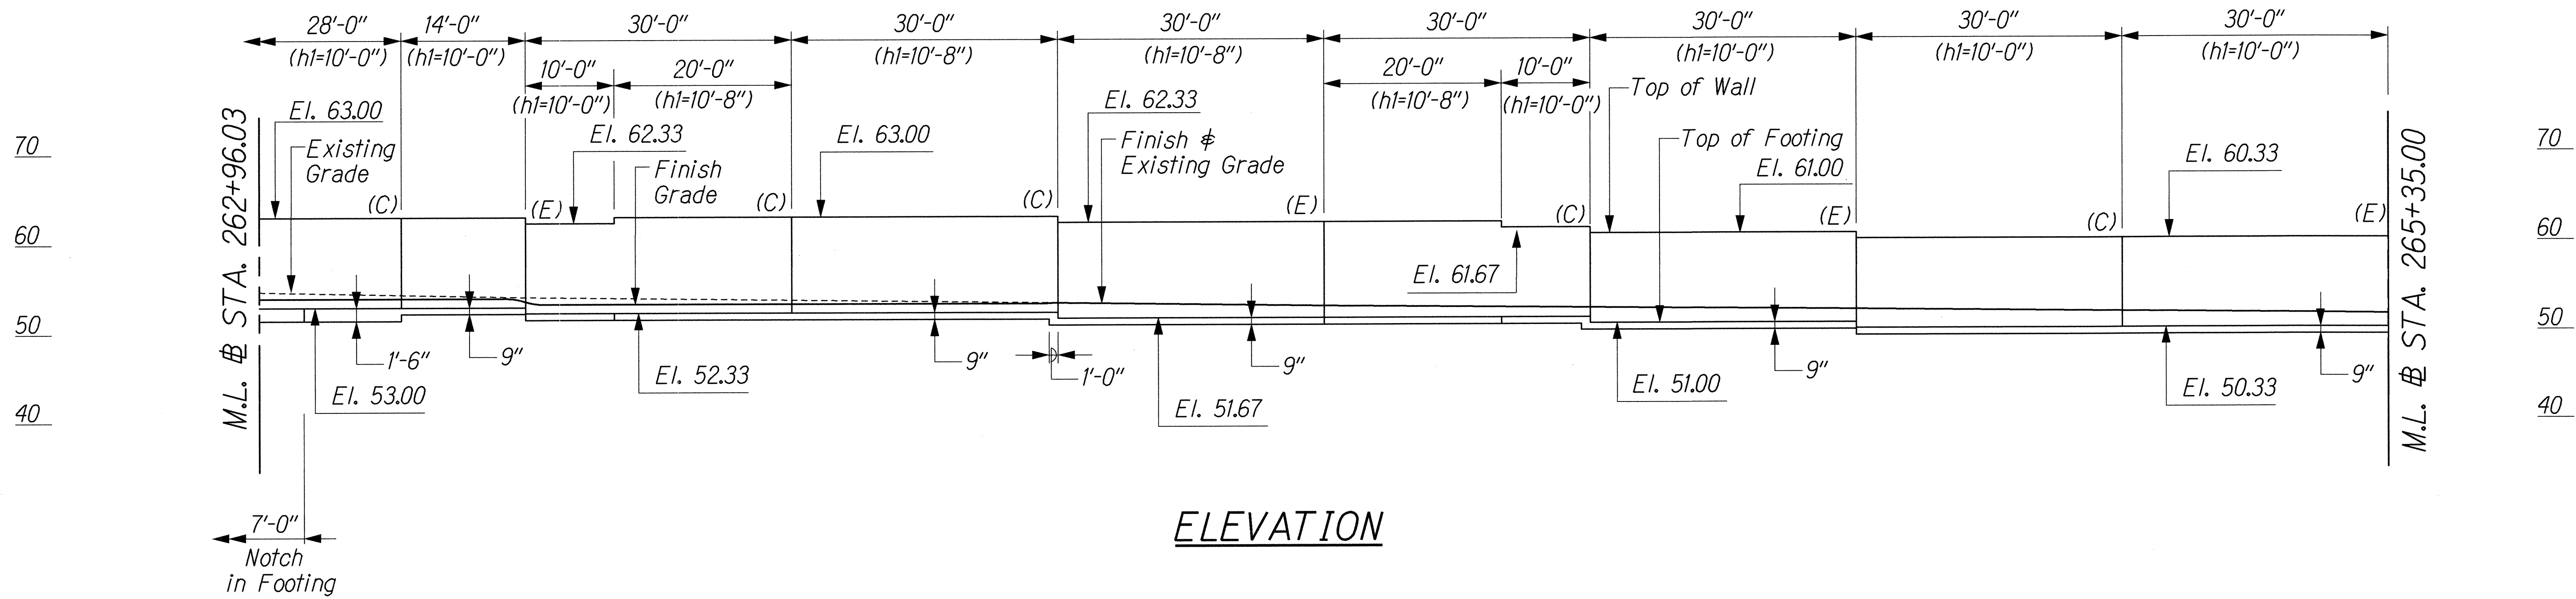

ELEVATION

NOTES:

1. See Legend on Sht. No. S-38.
2. See Notes on Sht. No. S-38.

ORIGINAL PLAN	SURVEY PLOTTED BY	DATE
NOTE BOOK	DRAWN BY	
	DESIGNED BY	
	CHECKED BY	

36/KUIHELANI/STRUCT/NW-10.dgn

THIS WORK WAS PREPARED BY ME
OR UNDER MY SUPERVISION


Rui Pang Chen

STATE OF HAWAII
DEPARTMENT OF TRANSPORTATION
HIGHWAYS DIVISION


CMU NOISE WALL
PLAN & ELEVATION-10

KUIHELANI HIGHWAY WIDENING
HONOAPIILANI HIGHWAY TO PUUNENE AVENUE
FEDERAL-AID PROJECT NO. NH-0380(9)
Scale: 1" = 10' Date: Sept. 14, 2001

FED. ROAD DIST. NO.	STATE	FED. AID PROJ. NO.	FISCAL YEAR	SHEET NO.	TOTAL SHEETS
HAWAII	HAW.	NH-0380(9)	2000	210	380

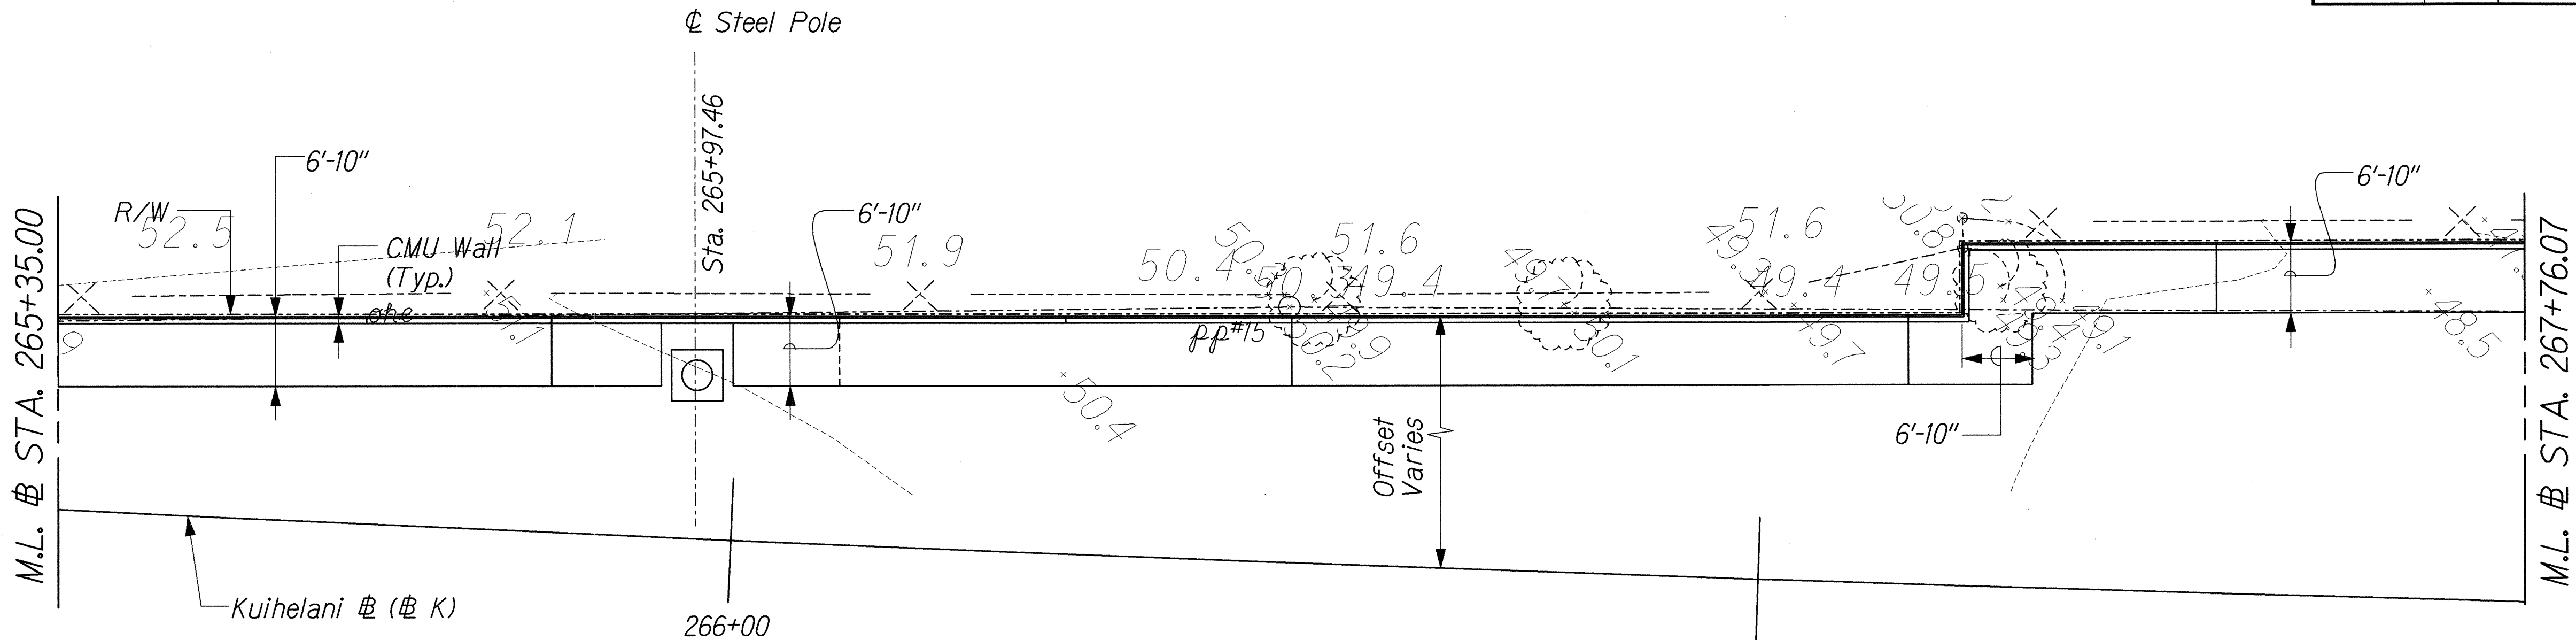

PLAN

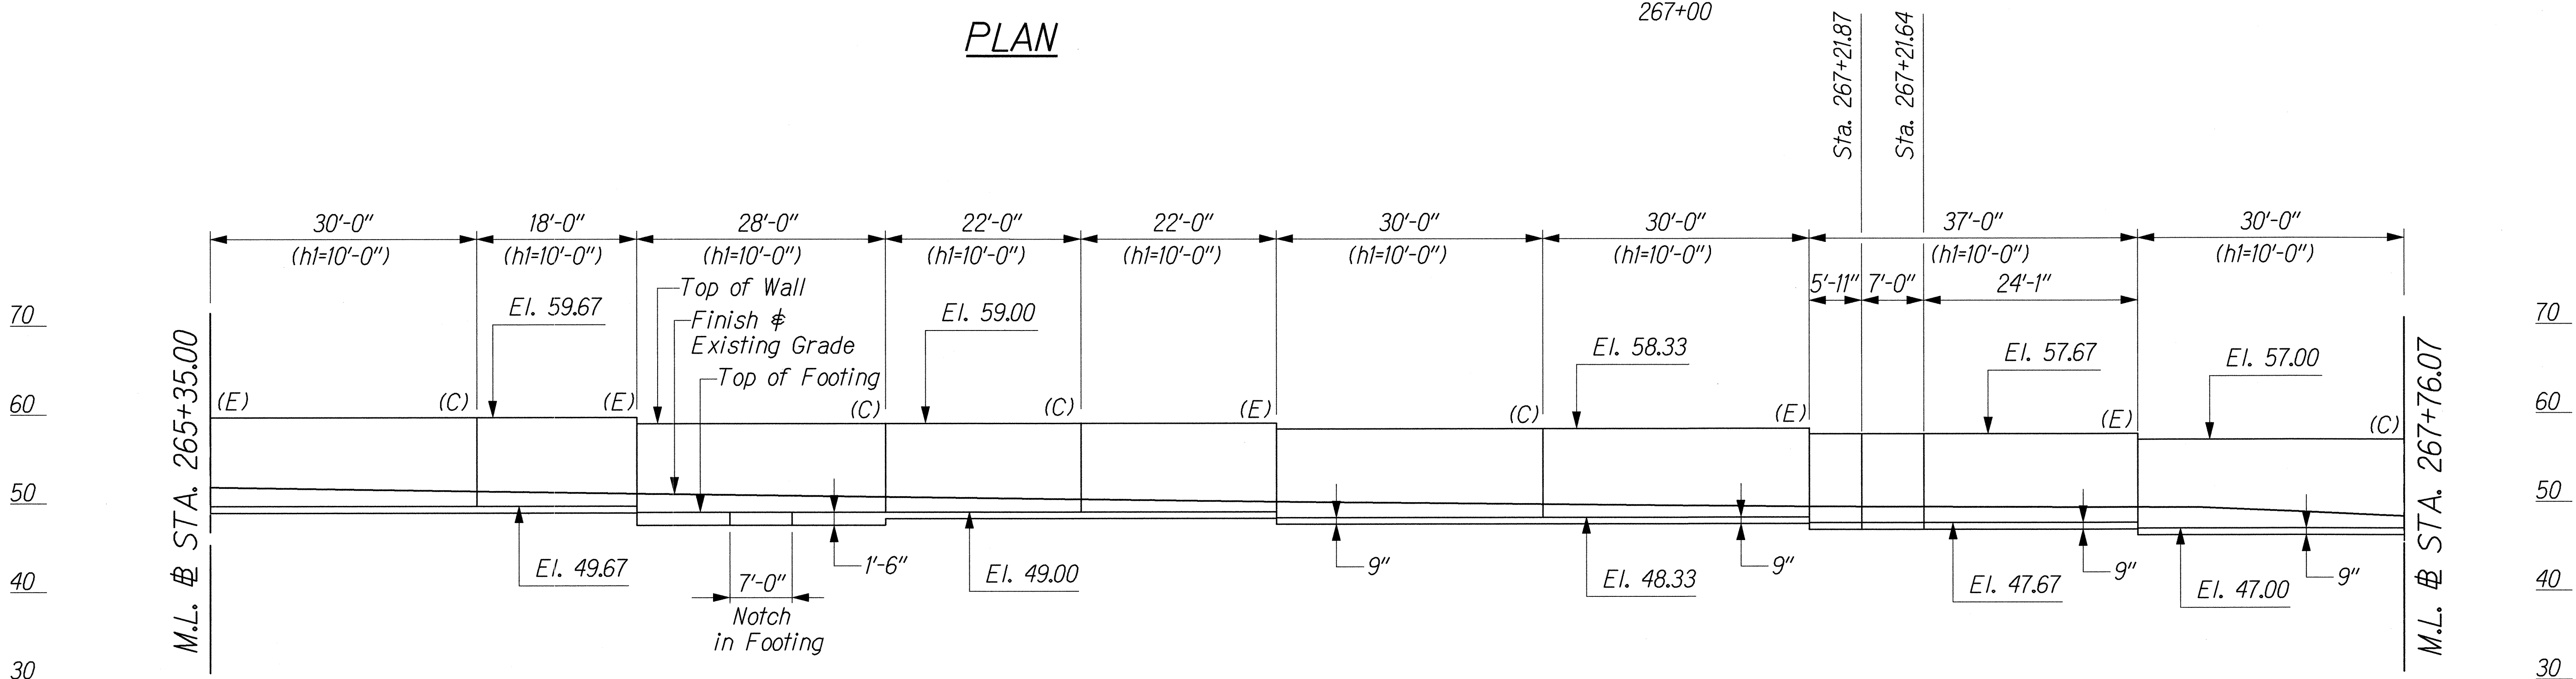

ELEVATION

NOTES:

1. See Legend on Sht. No. S-38.
2. See Notes on Sht. No. S-38.

SURVEY PLOTTED BY	DATE
DRAWN BY	
DESIGNED BY	
CHECKED BY	


THIS WORK WAS PREPARED BY ME OR UNDER MY SUPERVISION.

Hui Pang Chen


STATE OF HAWAII
DEPARTMENT OF TRANSPORTATION
HIGHWAYS DIVISION

CMU NOISE WALL
PLAN & ELEVATION-II
KUIHELANI HIGHWAY WIDENING
HONOAPILANI HIGHWAY TO PUUNENE AVENUE
FEDERAL-AID PROJECT NO. NH-0380(9)
Scale: 1" = 10' Date: Sept. 14, 2001

FED. ROAD DIST. NO.	STATE	FED. AID PROJ. NO.	FISCAL YEAR	SHEET NO.	TOTAL SHEETS
HAWAII	HAW.	NH-0380(9)	2000	213	380

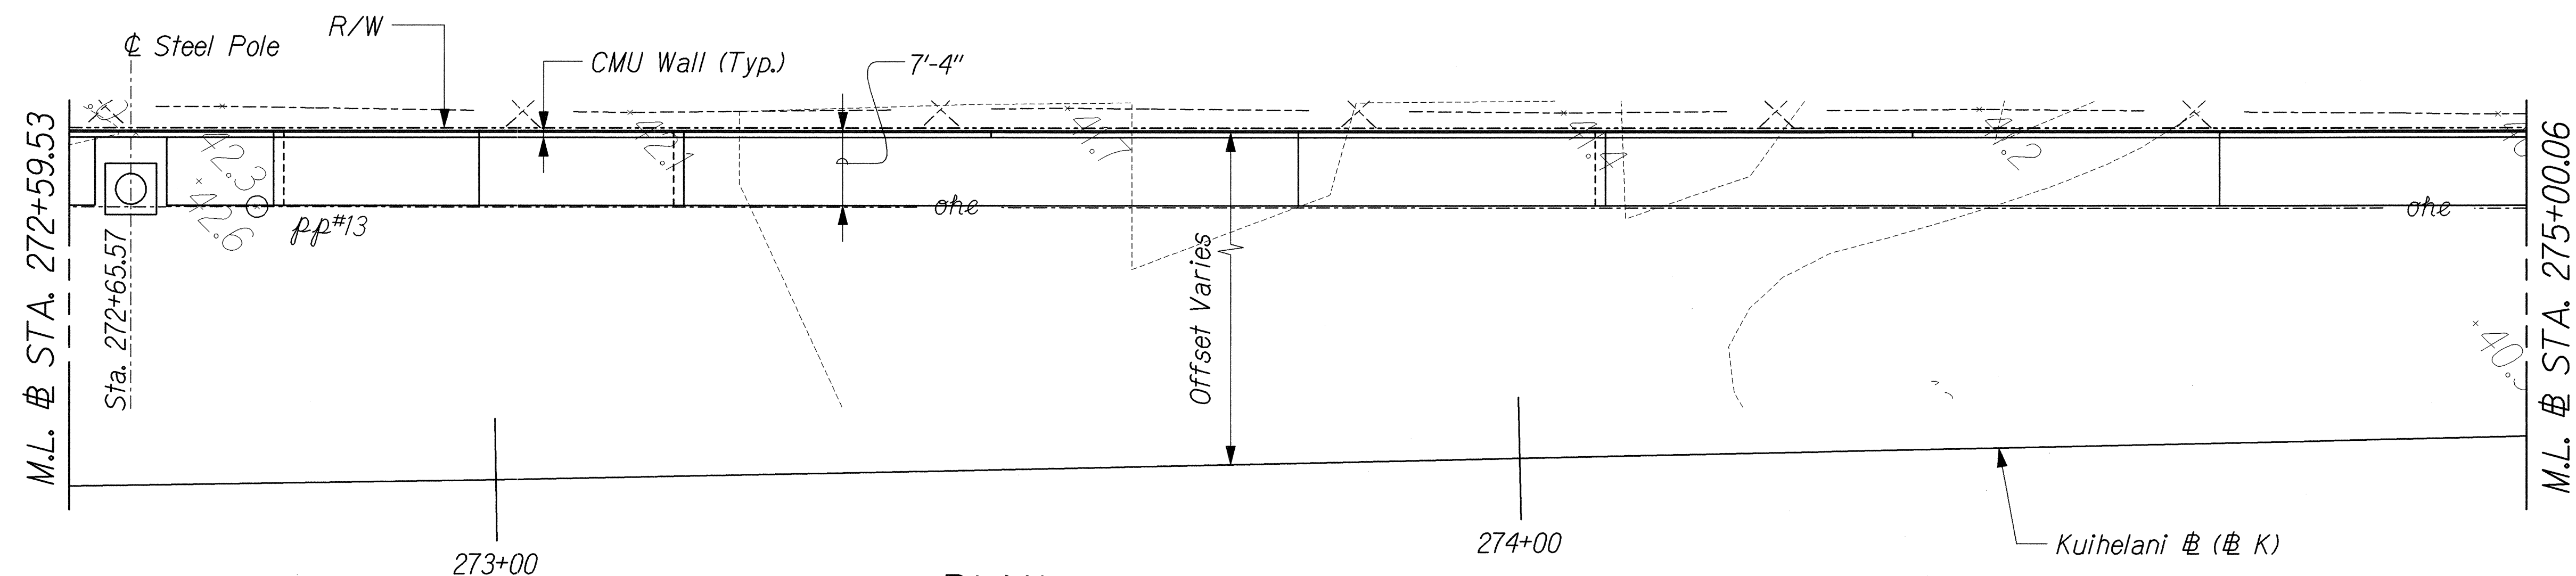

PLAN

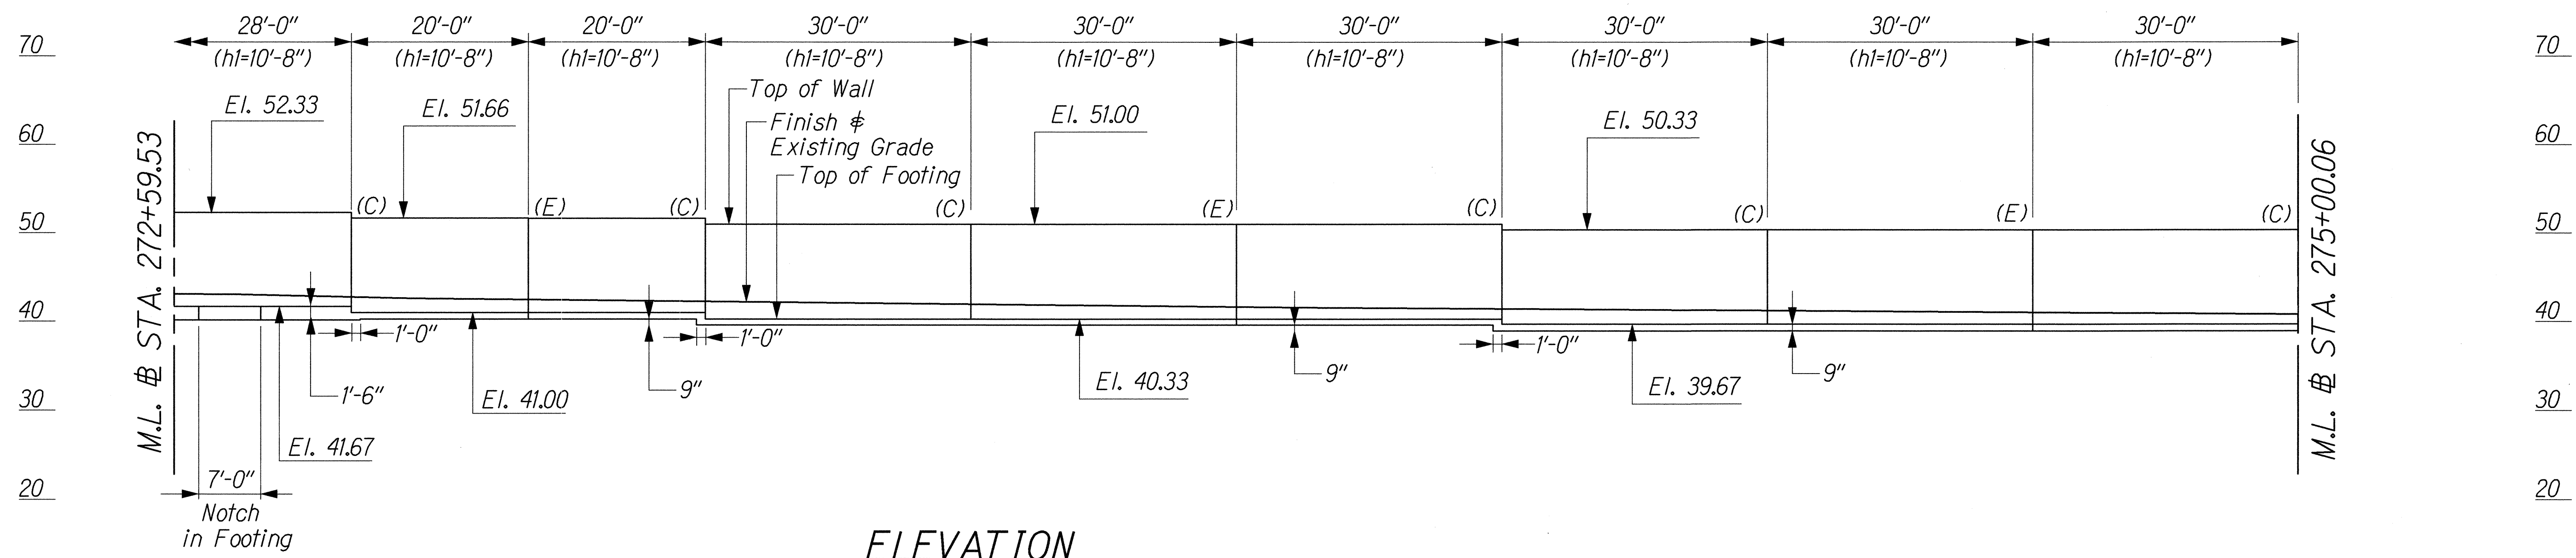

ELEVATION

NOTES:

1. See Legend on Sht. No. S-38.
2. See Notes on Sht. No. S-38.

ORIGINAL PLAN	SURVEY PLOTTED BY	DATE
NOTE BOOK	DRAWN BY	
	DESIGNED BY	
	CHECKED BY	
	IN CHARGE	

3/2 KUIHELANI/STRUCT/WW-14dgn



THIS WORK WAS PREPARED BY ME
OR UNDER MY SUPERVISION

Hui Pang Chen

STATE OF HAWAII
DEPARTMENT OF TRANSPORTATION
HIGHWAYS DIVISION

CMU NOISE WALL
PLAN & ELEVATION-14
KUIHELANI HIGHWAY WIDENING
HONOAPIILANI HIGHWAY TO PUUNENE AVENUE
FEDERAL-AID PROJECT NO. NH-0380(9)
Scale: 1" = 10' Date: Sept. 14, 2001

FED. ROAD DIST. NO.	STATE	FED. AID PROJ. NO.	FISCAL YEAR	SHEET NO.	TOTAL SHEETS
HAWAII	HAW.	NH-0380(9)	2000	214	380

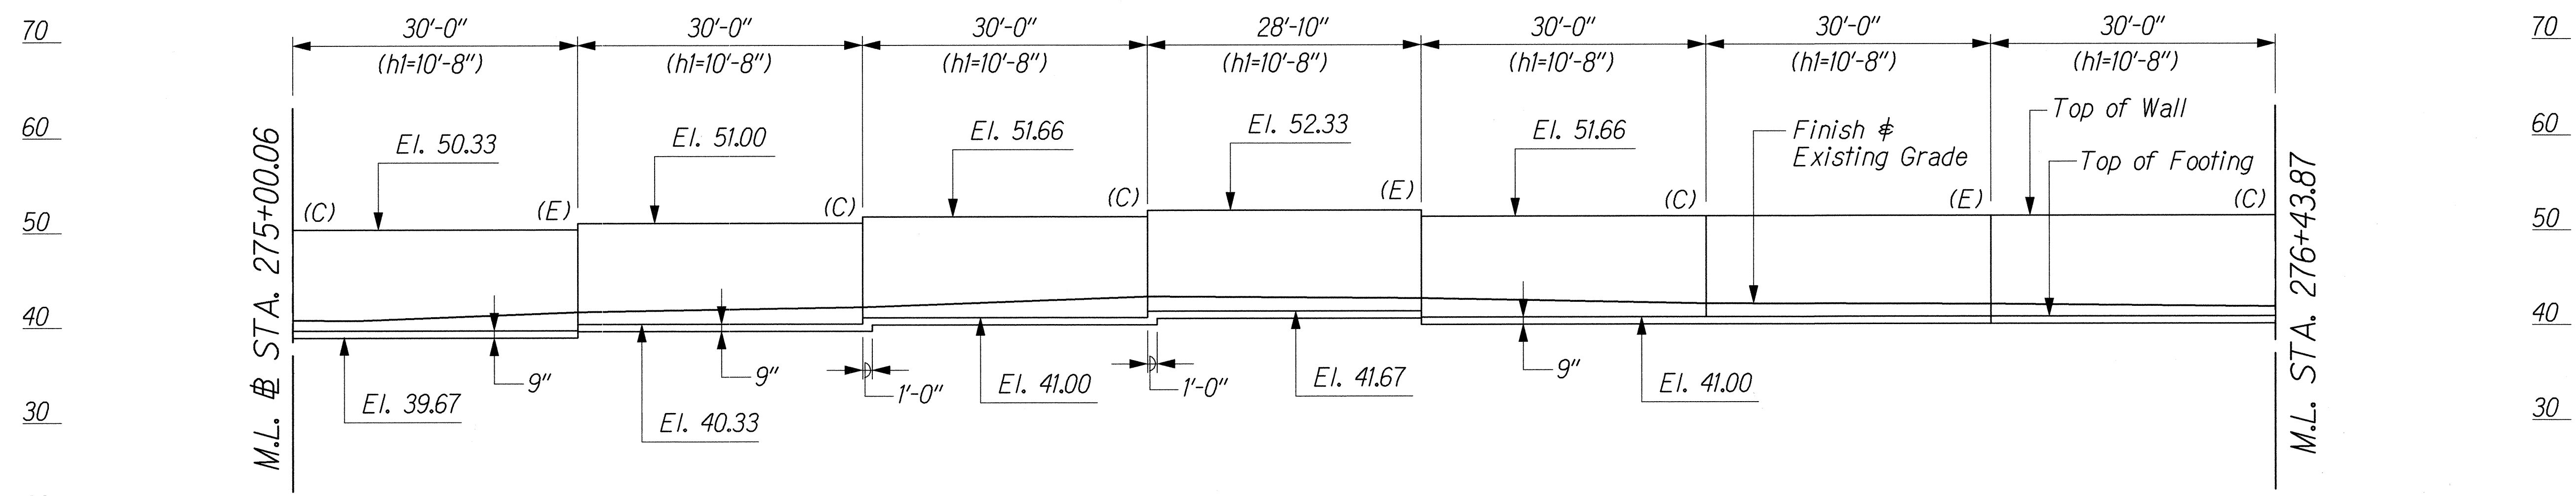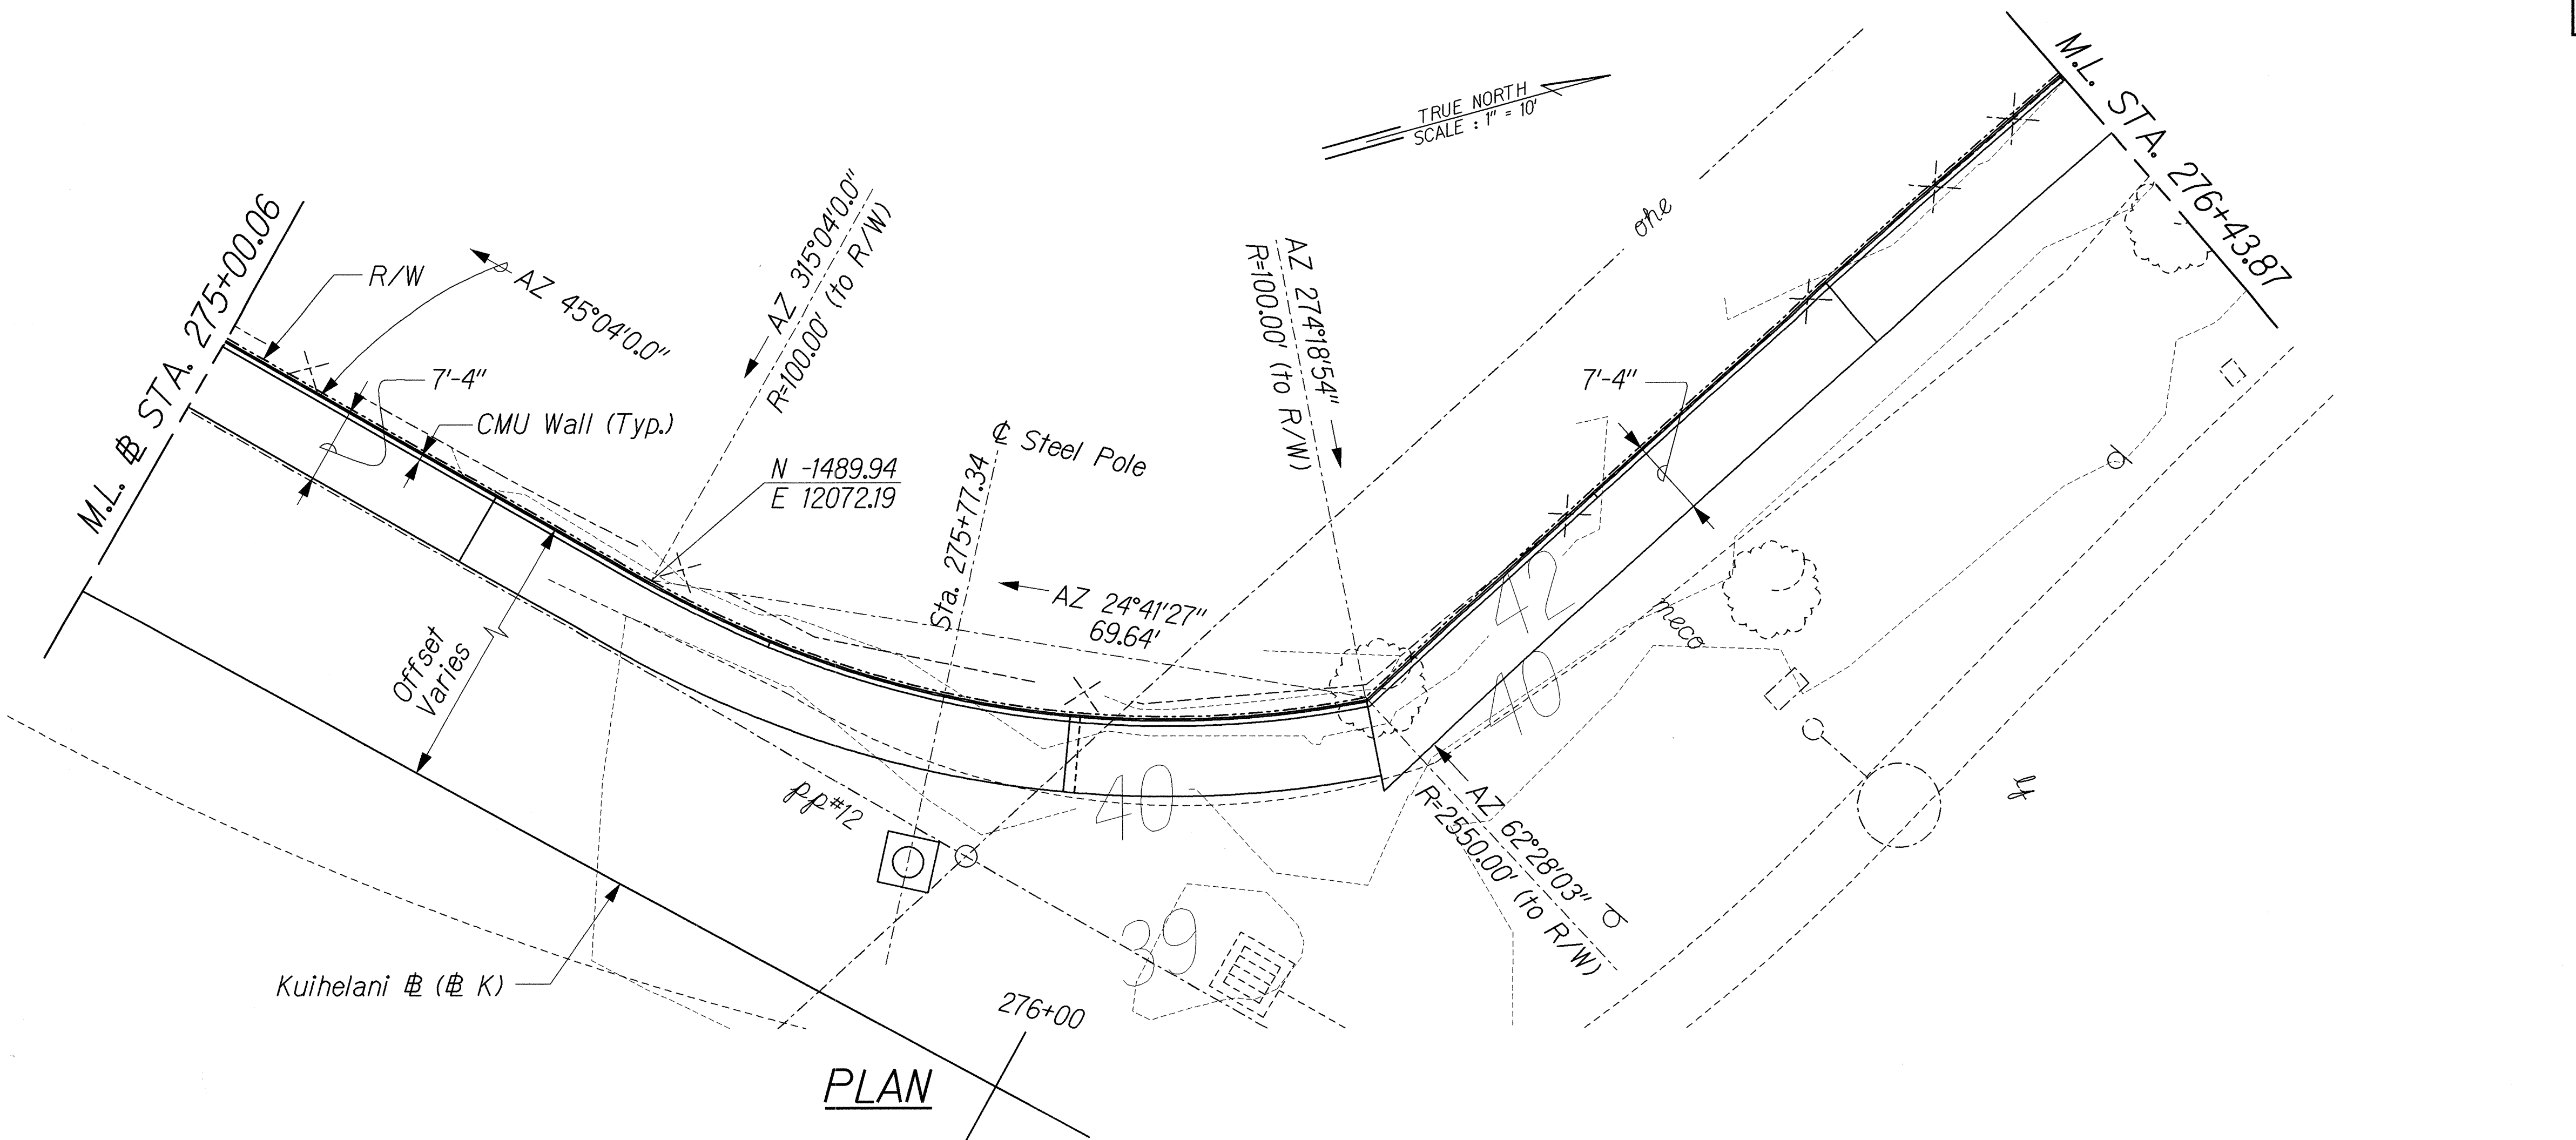

DEVELOPED ELEVATION

NOTES:

1. See Legend on Sht. No. S-38.
2. See Notes 2 and 4 on Sht. No. S-38.

DESIGNED BY	DATE
DRAWN BY	
CHECKED BY	
IN CHARGE	
NOTED BY	
DATE	

J:\KUIHELANI\STRUCT\NW-15.dgn



THIS WORK WAS PREPARED BY ME OR UNDER MY SUPERVISION.

Rui Pang Chen


STATE OF HAWAII
DEPARTMENT OF TRANSPORTATION
HIGHWAYS DIVISION

CMU NOISE WALL
PLAN & ELEVATION-15
KUIHELANI HIGHWAY WIDENING
HONOAPIILANI HIGHWAY TO PUUNENE AVENUE
FEDERAL-AID PROJECT NO. NH-0380(9)
Scale: 1" = 10' Date: Sept. 14, 2001
SHEET No. S-52 OF 54 SHEETS

FED. ROAD DIST. NO.	STATE	FED. AID PROJ. NO.	FISCAL YEAR	SHEET NO.	TOTAL SHEETS
HAWAII	HAW.	NH-0380(9)	2000	215	380

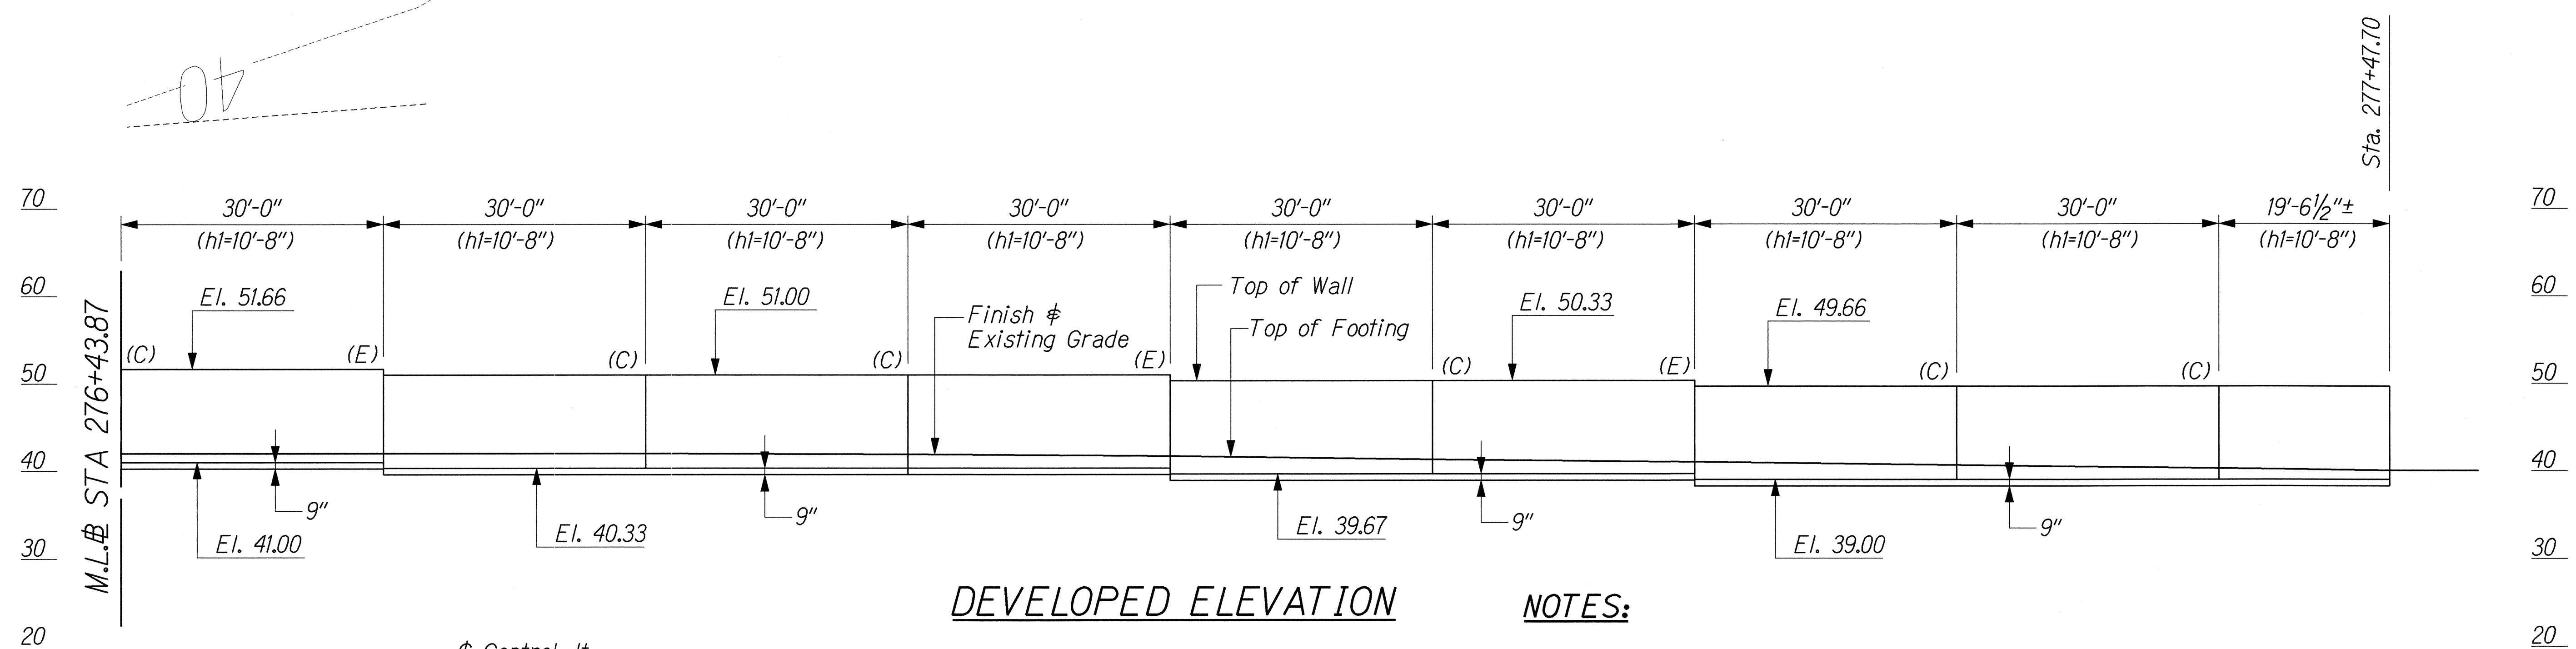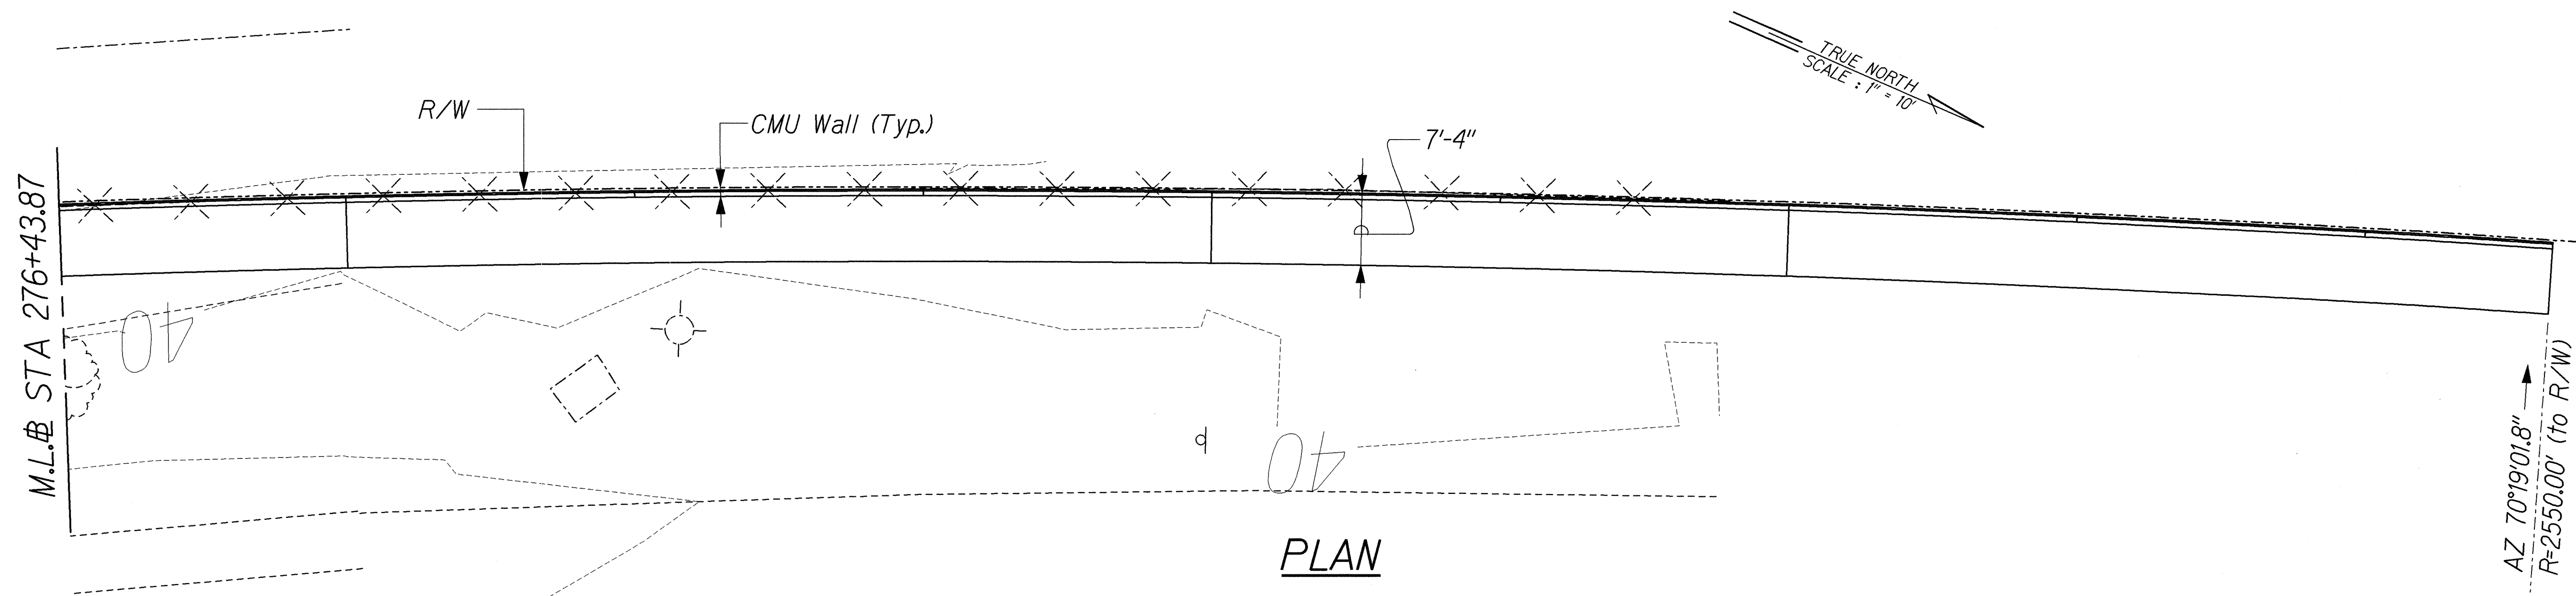

- NOTES:**
- See Legend on Sht. No. S-38.
 - See Notes 2 and 4 on Sht. No. S-38.

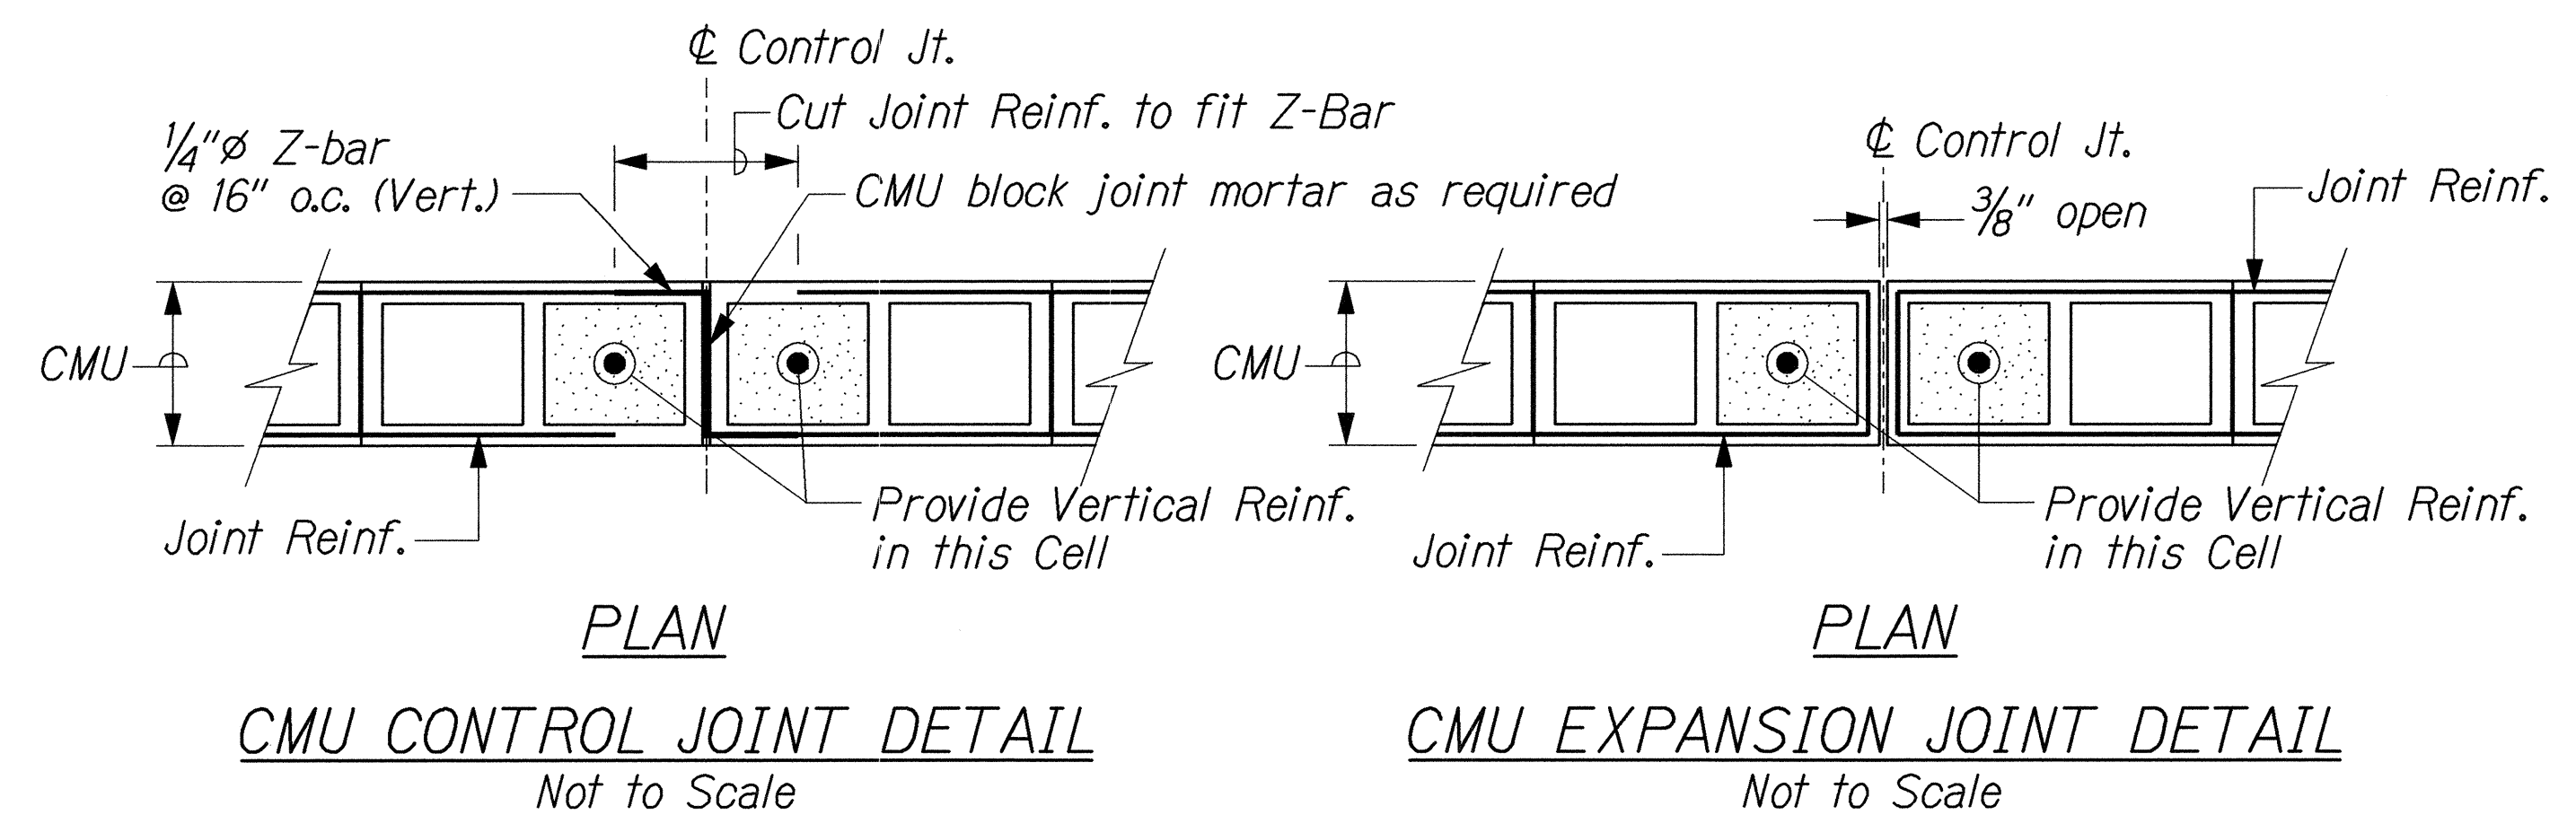

DESIGNED BY	DATE
DRAWN BY	
CHECKED BY	
NOTED BY	
DATE	

THIS WORK WAS PREPARED BY ME OR UNDER MY SUPERVISION

Rui Pang Chen


STATE OF HAWAII
DEPARTMENT OF TRANSPORTATION
HIGHWAYS DIVISION

CMU NOISE WALL
PLAN & ELEVATION-16
KUIHELANI HIGHWAY WIDENING
HONOAPIILANI HIGHWAY TO PUUNENE AVENUE
FEDERAL-AID PROJECT NO. NH-0380(9)
Scale: 1" = 10' Date: Sept. 14, 2001

NOISE WALL TABLE									
Station Locations	H	h1	h2	h3	L	T	Bar "a"	Bar "b"	Bar "c"
256+37.78 to 256+86.00	6'-4"	8'-0"	6'-0"	2'-0"	5'-5"	9"	#4 @ 16"	#4 @ 16"	#4 @ 16"
256+85.95 to 257+13.95	6'-4"	8'-0"	6'-0"	2'-0"	5'-5"	1'-6"	#4 @ 8"	#4 @ 8"	#4 @ 16"
257+14.00 to 259+37.63	6'-4"	8'-0"	6'-0"	2'-0"	5'-5"	9"	#4 @ 16"	#4 @ 16"	#4 @ 16"
247+37.78 to 247+86.00	7'-0"	8'-8"	6'-0"	2'-8"	5'-11"	9"	#4 @ 16"	#4 @ 16"	#4 @ 16"
247+86.00 to 248+14.00	7'-0"	8'-8"	6'-0"	2'-8"	5'-11"	1'-6"	#4 @ 8"	#4 @ 8"	#4 @ 16"
248+14.00 to 250+86.00	7'-0"	8'-8"	6'-0"	2'-8"	5'-11"	9"	#4 @ 16"	#4 @ 16"	#4 @ 16"
250+85.95 to 251+13.95	7'-0"	8'-8"	6'-0"	2'-8"	5'-11"	1'-6"	#4 @ 8"	#4 @ 8"	#4 @ 16"
251+14.00 to 252+37.78	7'-0"	8'-8"	6'-0"	2'-8"	5'-11"	9"	#4 @ 16"	#4 @ 16"	#4 @ 16"
254+37.78 to 256+37.78	7'-0"	8'-8"	6'-0"	2'-8"	5'-11"	9"	#4 @ 16"	#4 @ 16"	#4 @ 16"
243+37.78 to 244+85.94	8'-4"	10'-0"	6'-0"	4'-0"	6'-10"	9"	#4 @ 8"	#4 @ 16"	#4 @ 16"
244+85.94 to 245+13.94	8'-4"	10'-0"	6'-0"	4'-0"	6'-10"	1'-6"	#4 @ 8"	#4 @ 8"	#4 @ 8"
245+13.94 to 247+37.78	8'-4"	10'-0"	6'-0"	4'-0"	6'-10"	9"	#4 @ 8"	#4 @ 16"	#4 @ 16"
252+37.78 to 253+85.95	8'-4"	10'-0"	6'-0"	4'-0"	6'-10"	9"	#4 @ 8"	#4 @ 16"	#4 @ 16"
253+85.95 to 254+13.95	8'-4"	10'-0"	6'-0"	4'-0"	6'-10"	1'-6"	#4 @ 8"	#4 @ 8"	#4 @ 8"
242+93.94 to 243+21.94	9'-0"	10'-8"	6'-0"	4'-8"	7'-4"	1'-6"	#4 @ 8"	#4 @ 8"	#4 @ 8"
243+21.94 to 243+37.78	9'-0"	10'-8"	6'-0"	4'-8"	7'-4"	9"	#4 @ 8"	#4 @ 8"	#4 @ 16"
263+35.82 to 264+35.24	9'-0"	10'-8"	6'-0"	4'-8"	7'-4"	9"	#4 @ 8"	#4 @ 8"	#4 @ 16"
268+36.48 to 268+85.11	9'-0"	10'-8"	6'-0"	4'-8"	7'-4"	9"	#4 @ 8"	#4 @ 8"	#4 @ 16"
268+85.11 to 269+13.11	9'-0"	10'-8"	6'-0"	4'-8"	7'-4"	1'-6"	#4 @ 8"	#4 @ 8"	#4 @ 8"
269+13.11 to 272+51.57	9'-0"	10'-8"	6'-0"	4'-8"	7'-4"	9"	#4 @ 8"	#4 @ 8"	#4 @ 16"
272+51.57 to 272+79.57	9'-0"	10'-8"	6'-0"	4'-8"	7'-4"	1'-6"	#4 @ 8"	#4 @ 8"	#4 @ 8"
272+79.57 to 277+47.70	9'-0"	10'-8"	6'-0"	4'-8"	7'-4"	9"	#4 @ 8"	#4 @ 8"	#4 @ 16"




CMU NOISE WALL NOTES:

- Only Type M Mortar shall be used for CMU wall. The minimum ultimate compressive strength of mortar at 28 days shall be 2500 psi.
- The CMU (Concrete Masonry Unit) shall be Smooth Surface Hollow Concrete Units - Grade N, grouted solid as required. The minimum ultimate compressive strength of CMU at 28 days (F'm) shall be 1500 psi.
- All rebars shall be ASTM A 615, Grade 60. Joint reinforcement (wire) shall be ASTM A 82.
- All cells below grade and/or containing vertical reinforcement shall be filled solidly with grout. The minimum ultimate compressive strength of grout at 28 days shall be 2000 psi.
- For construction requirements for concrete masonry unit placing, see Special Provisions.
- The horizontal and vertical mortar joints between CMU's shall be tooled to concave finish at all exposed faces.
- At the time of laying, all masonry units shall be free of excessive dust and dirt.
- The space between the CMU wall and excavated existing ground shall be backfilled with Class D concrete.
- The strength of footing concrete, See Note 4 A(2) on Sht. No. S-2.

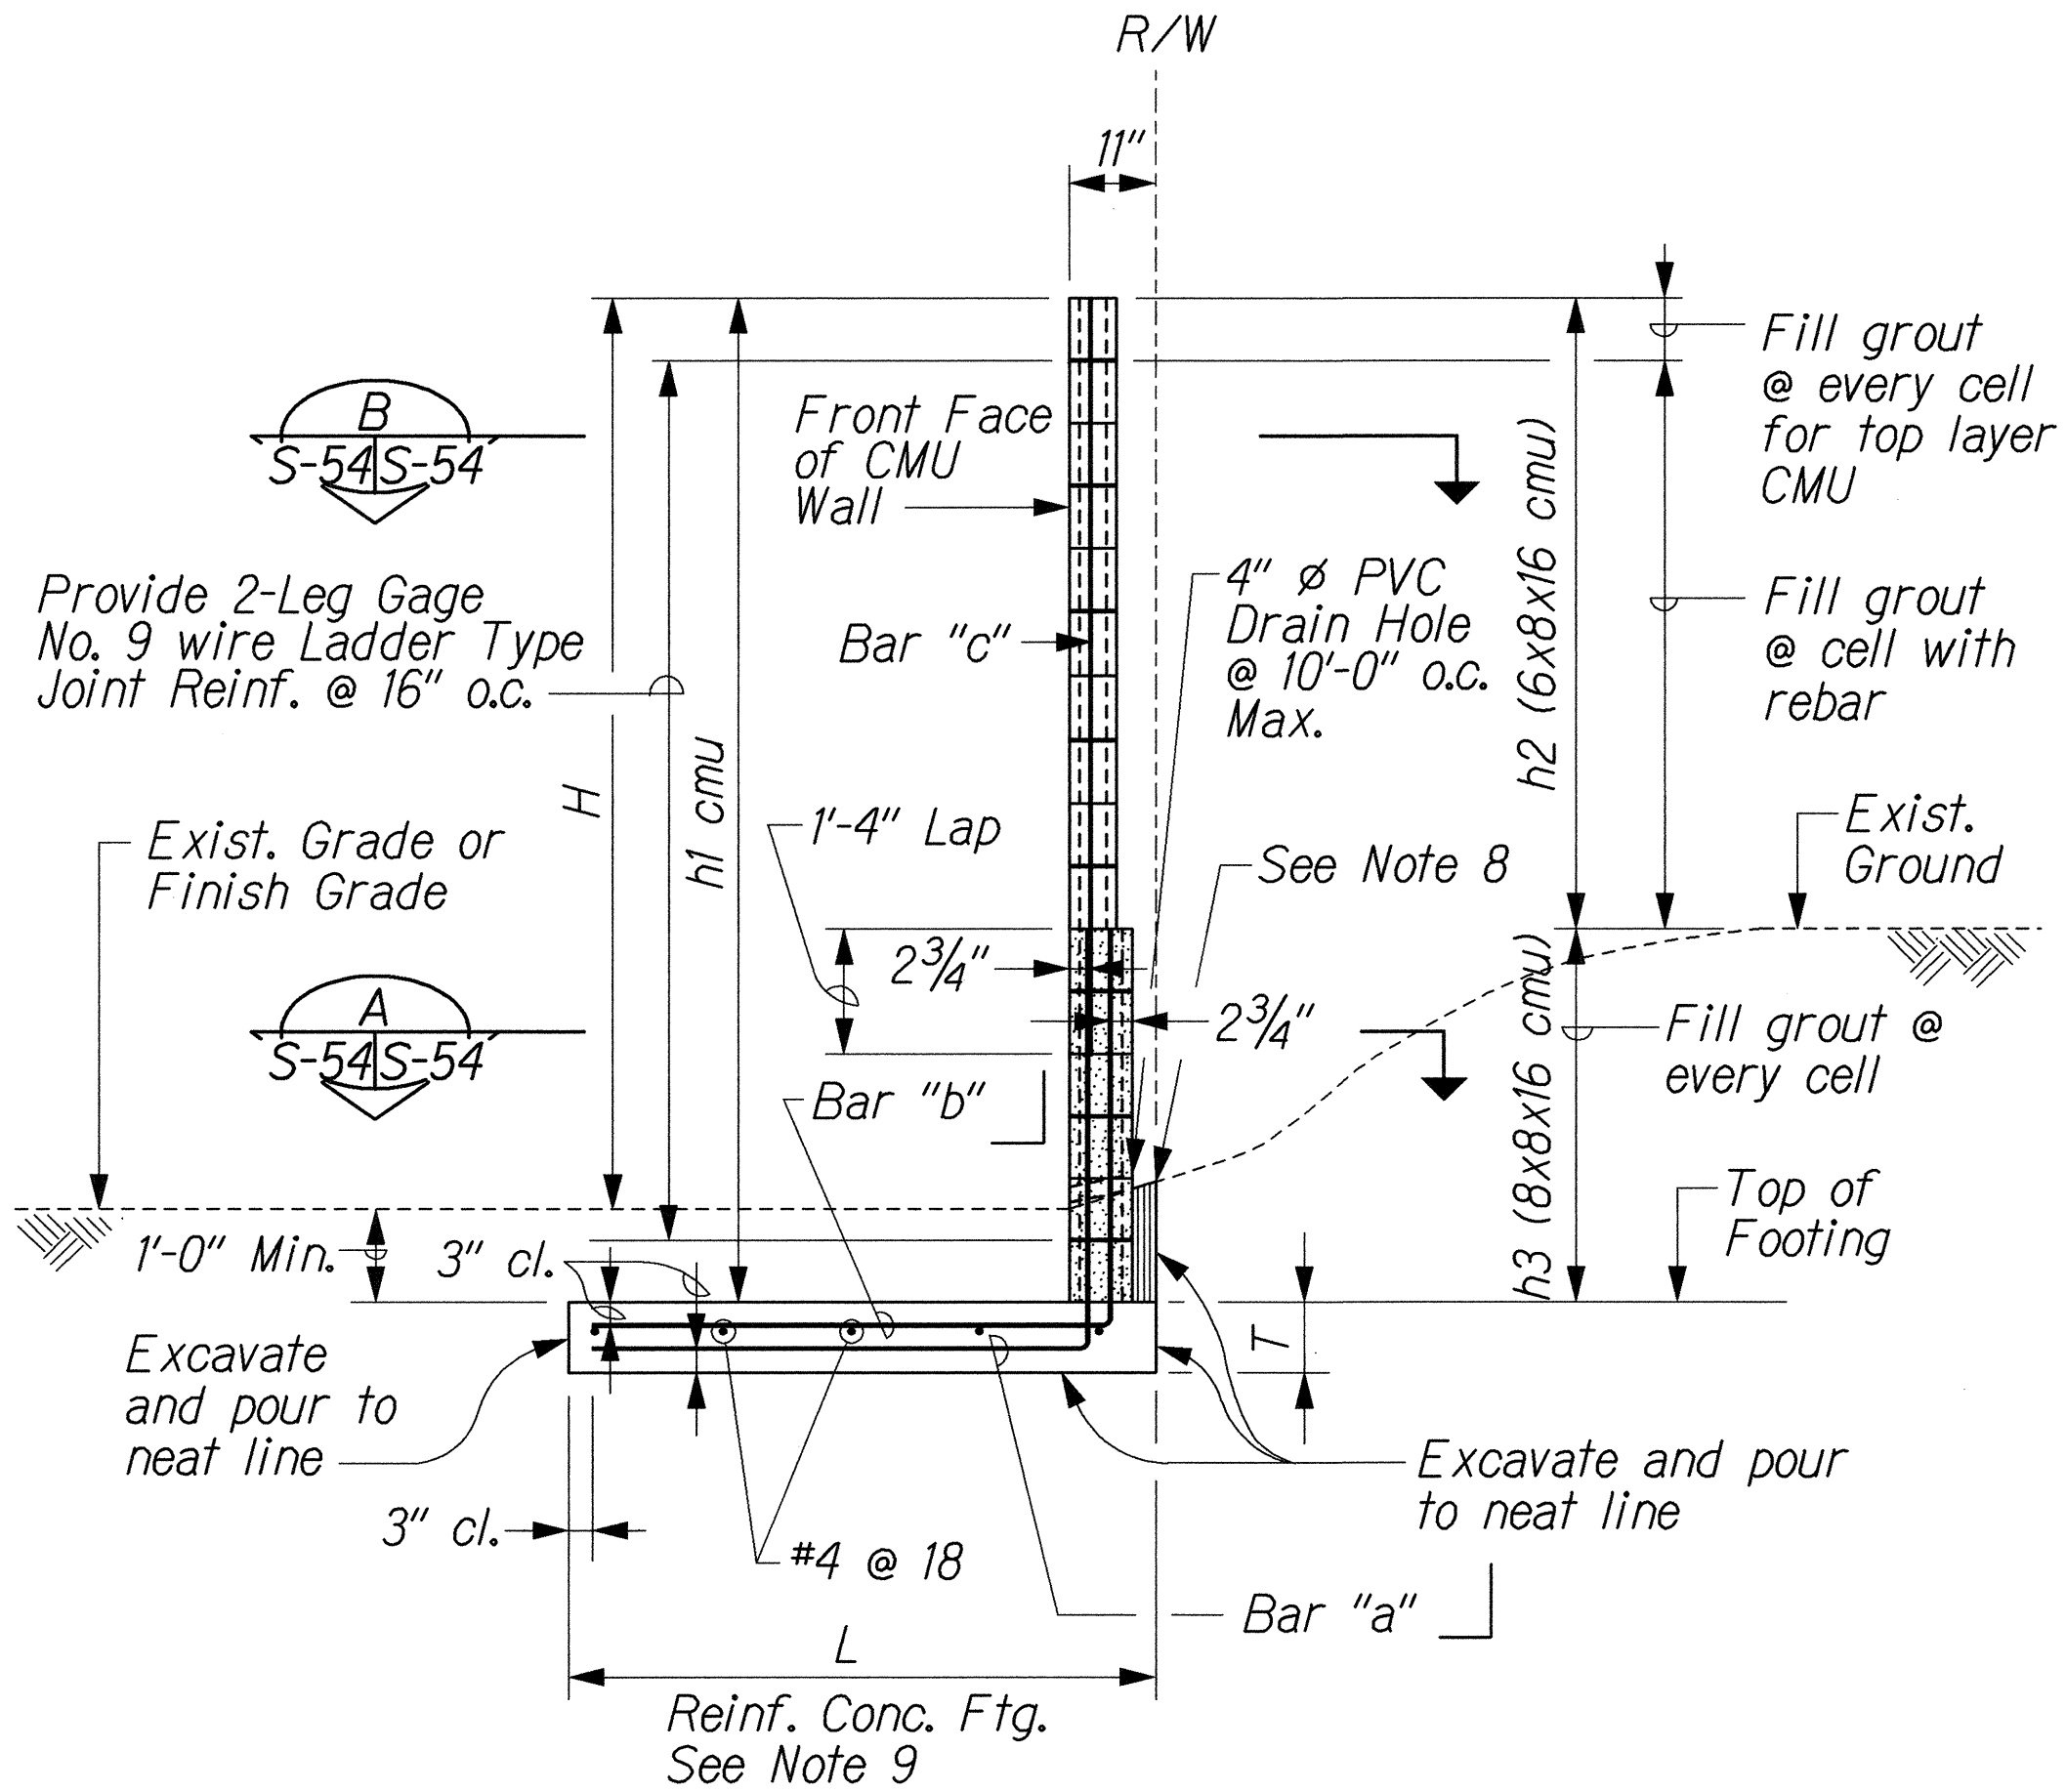

TYPICAL SECTION FOR CMU NOISE WALL

Scale: 1/2" = 1'-0"

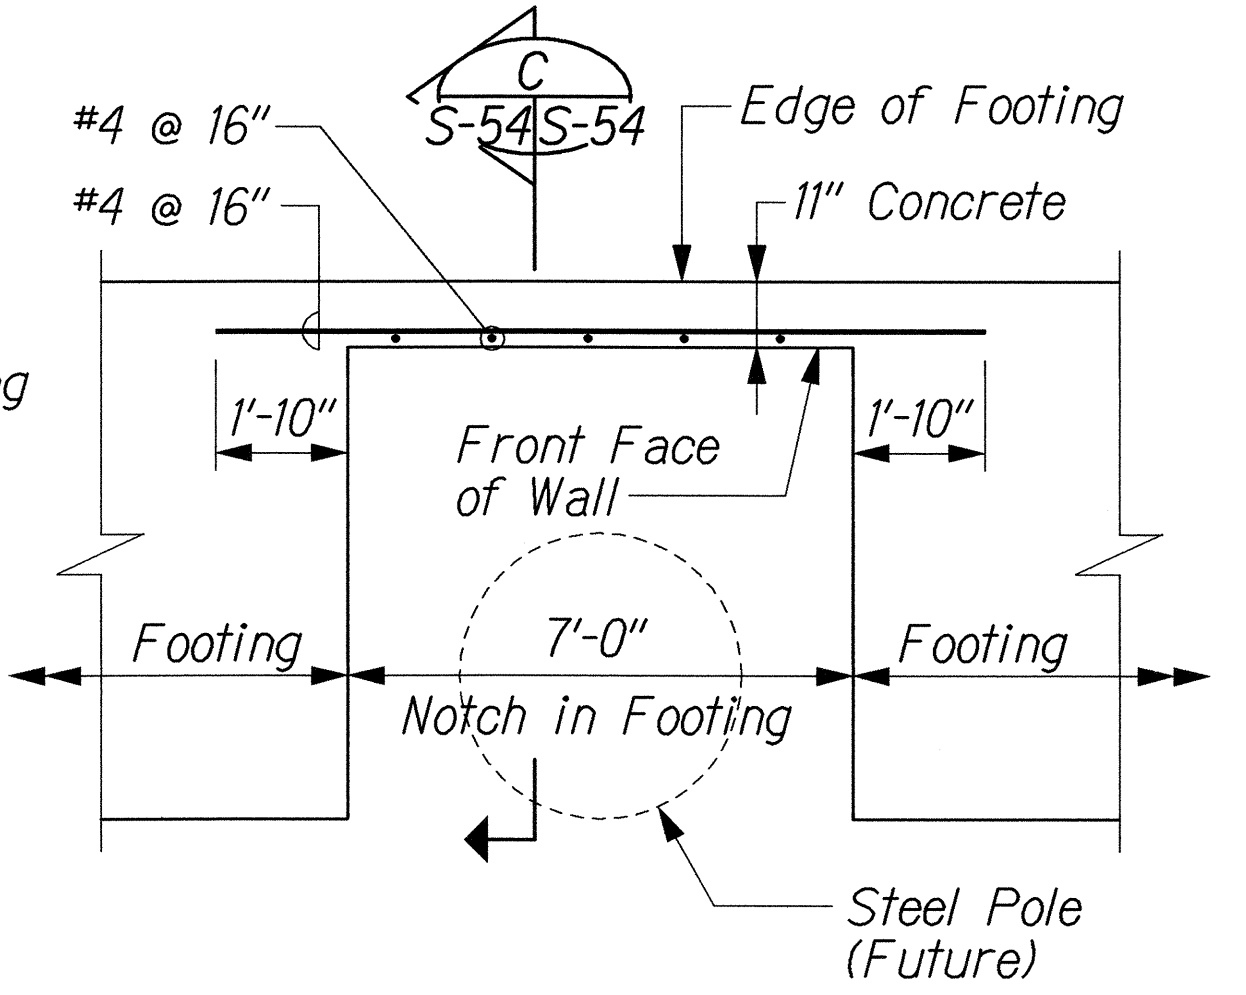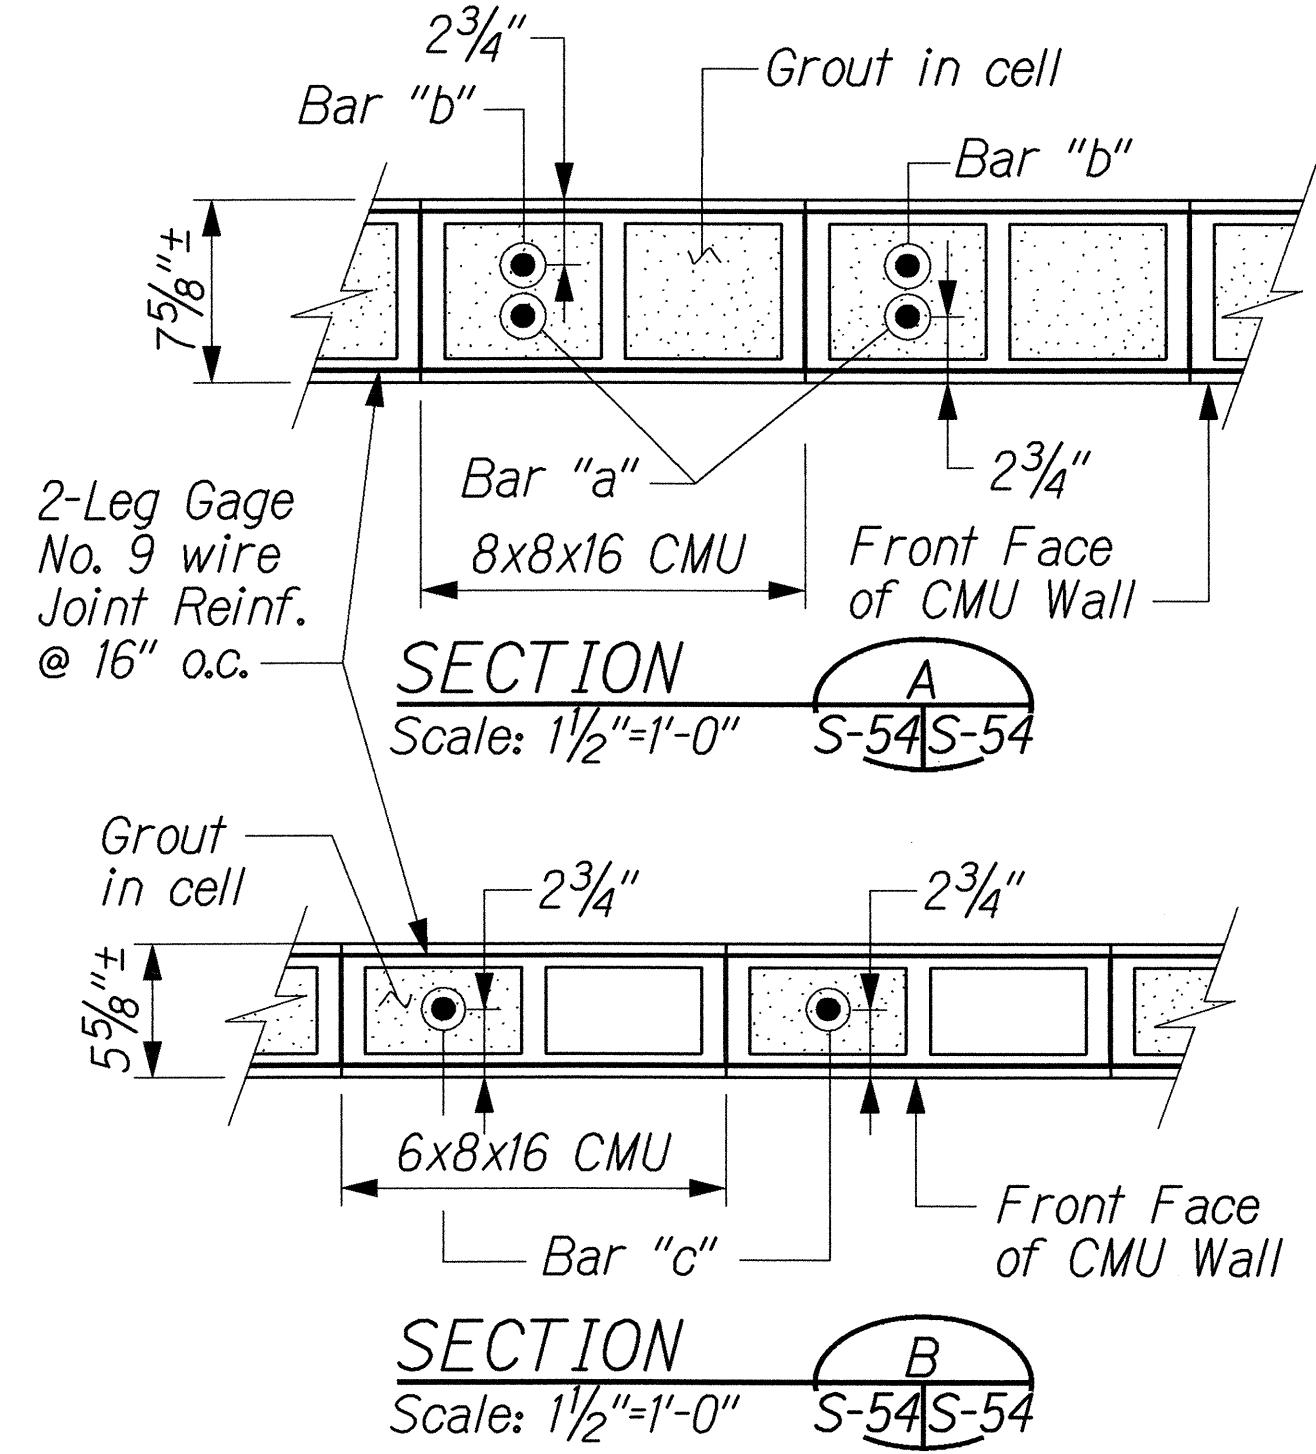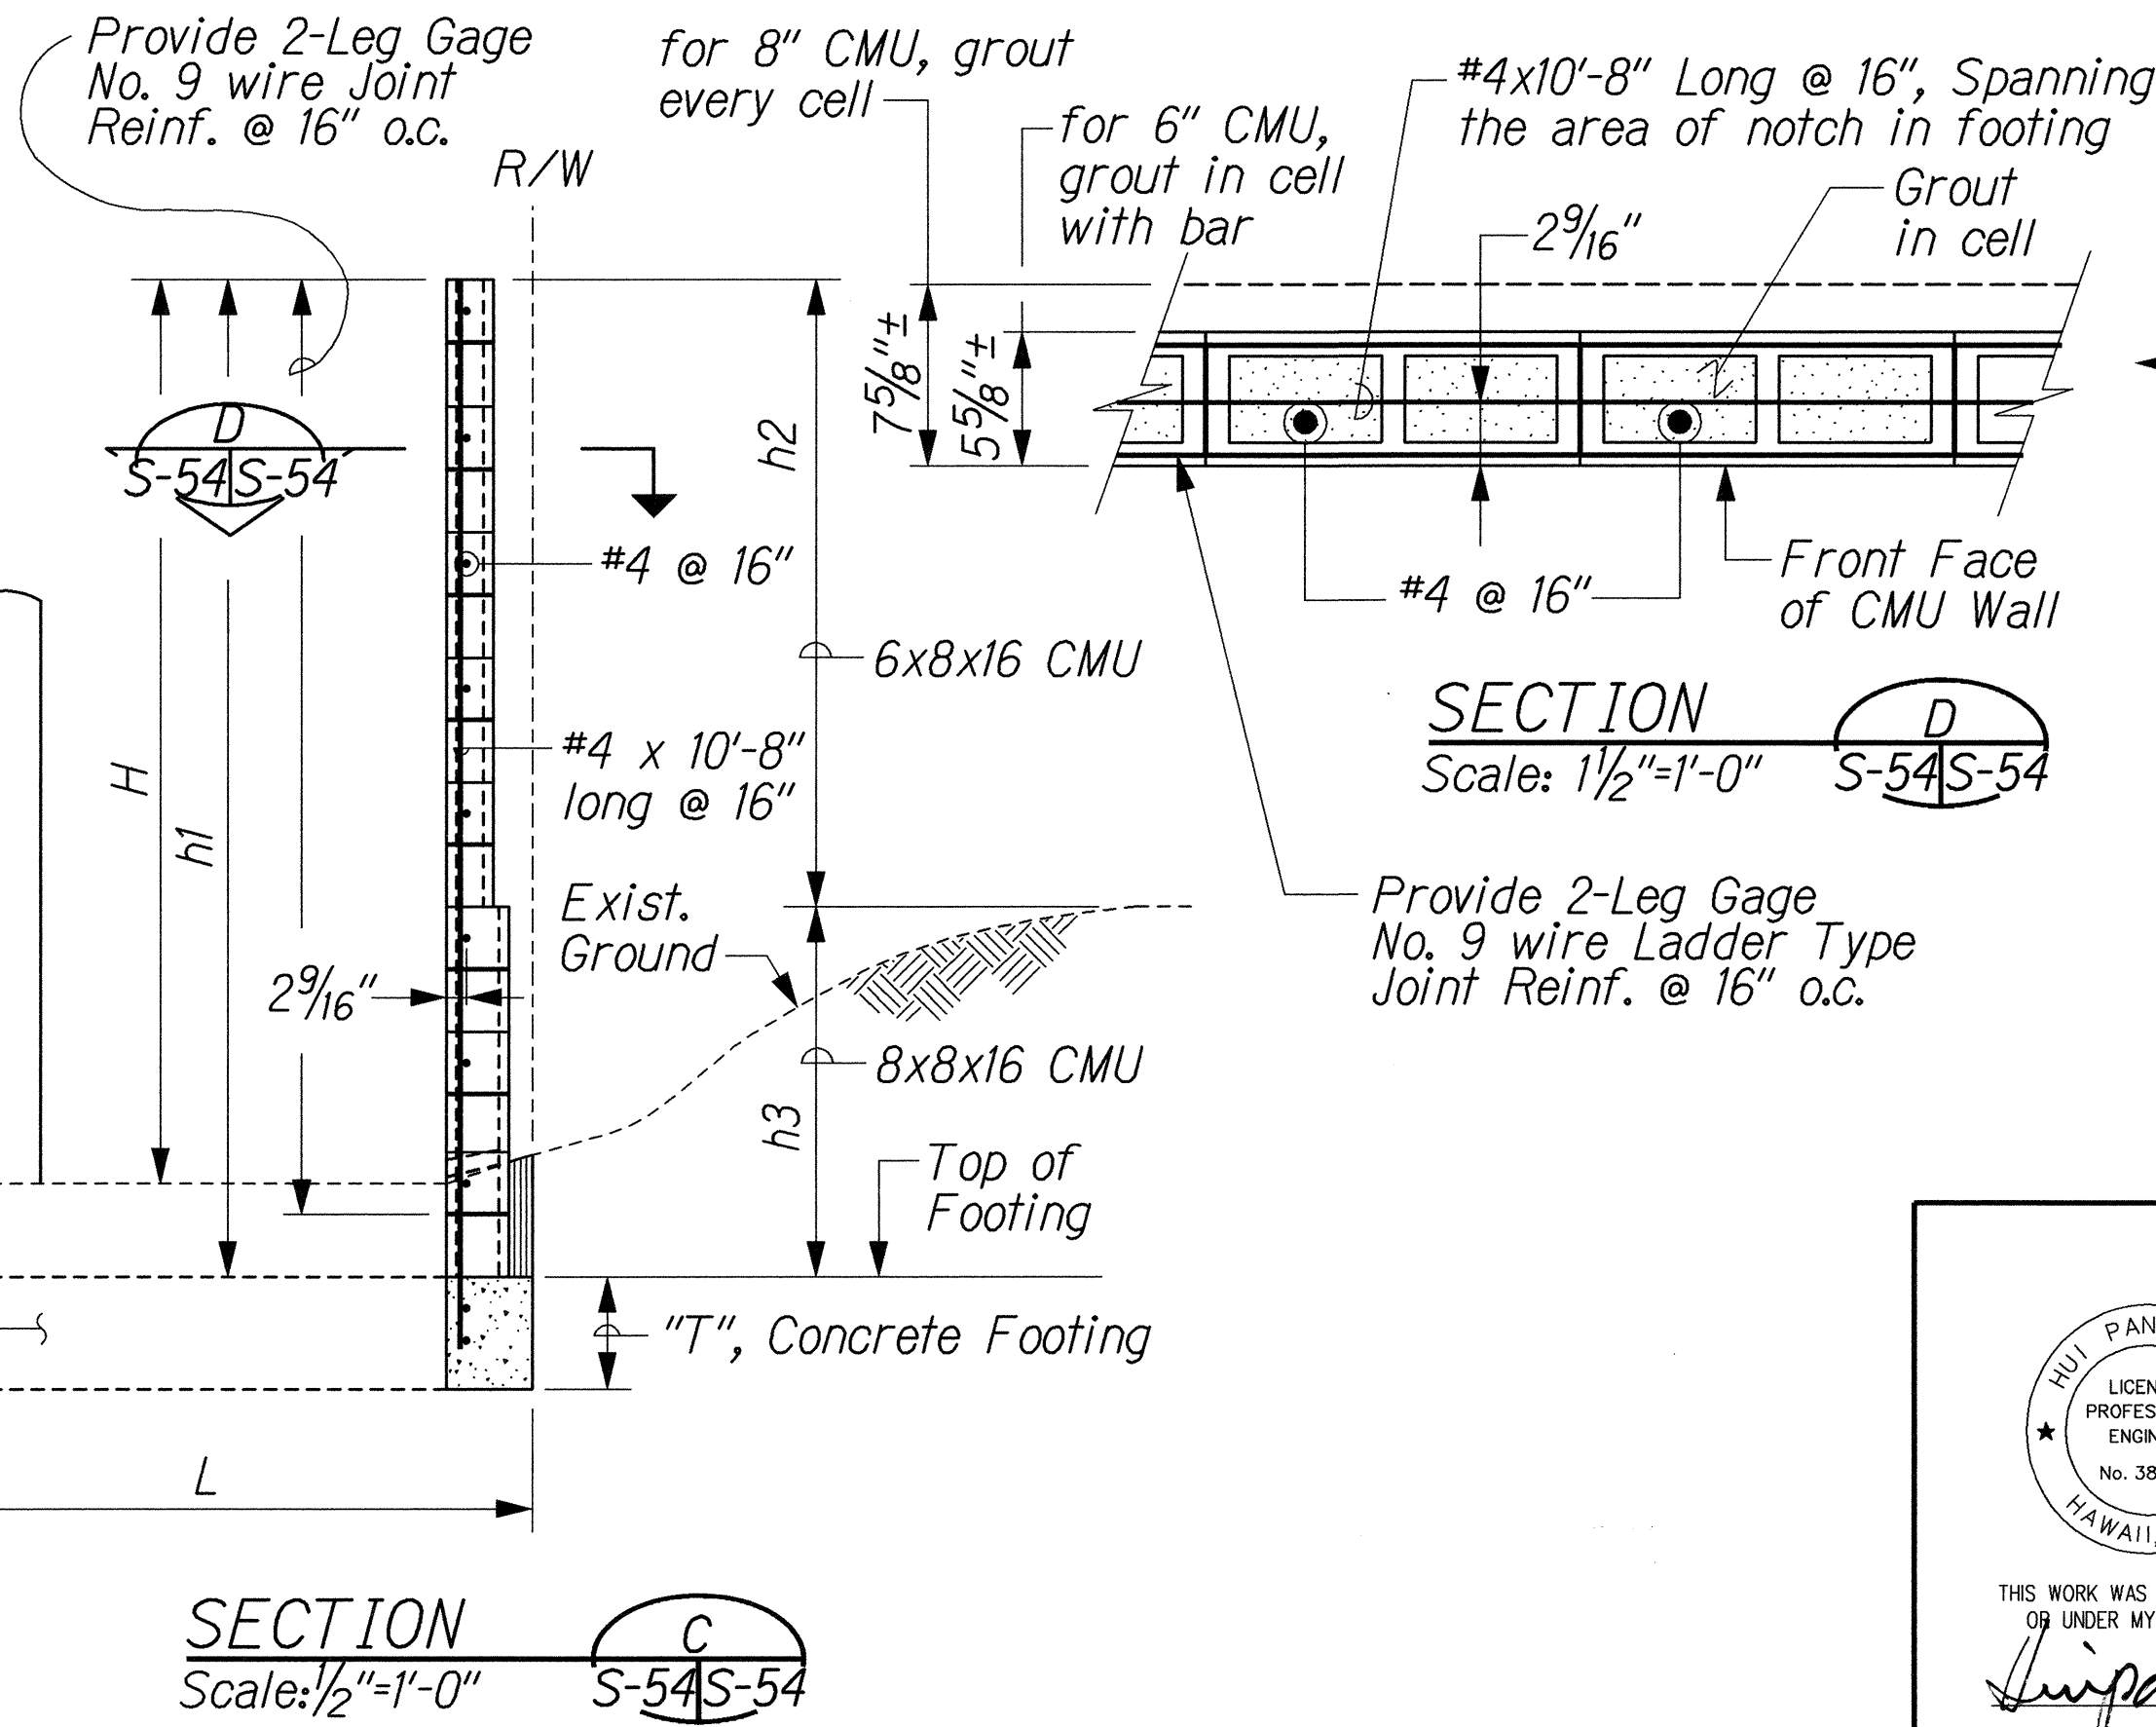

PARTIAL WALL PLAN @ STEEL POLE

Not to Scale

THIS WORK WAS PREPARED BY ME OR UNDER MY SUPERVISION.

Hui Pang Chen

STATE OF HAWAII
DEPARTMENT OF TRANSPORTATION
HIGHWAYS DIVISION

CMU NOISE WALL DETAILS

KUIHELANI HIGHWAY WIDENING
HONOAPIILANI HIGHWAY TO PUUNENE AVENUE
FEDERAL-AID PROJECT NO. NH-0380(9)
Scale: 1/2" = 1'-0" Date: Sept. 14, 2001

SHEET No. S-54 OF 54 SHEETS