


FED. ROAD DIST. NO.	STATE	FED. AID PROJ. NO.	FISCAL YEAR	SHEET NO.	TOTAL SHEETS
HAWAII	HAW.	NH-0380(11)	2007	7	33

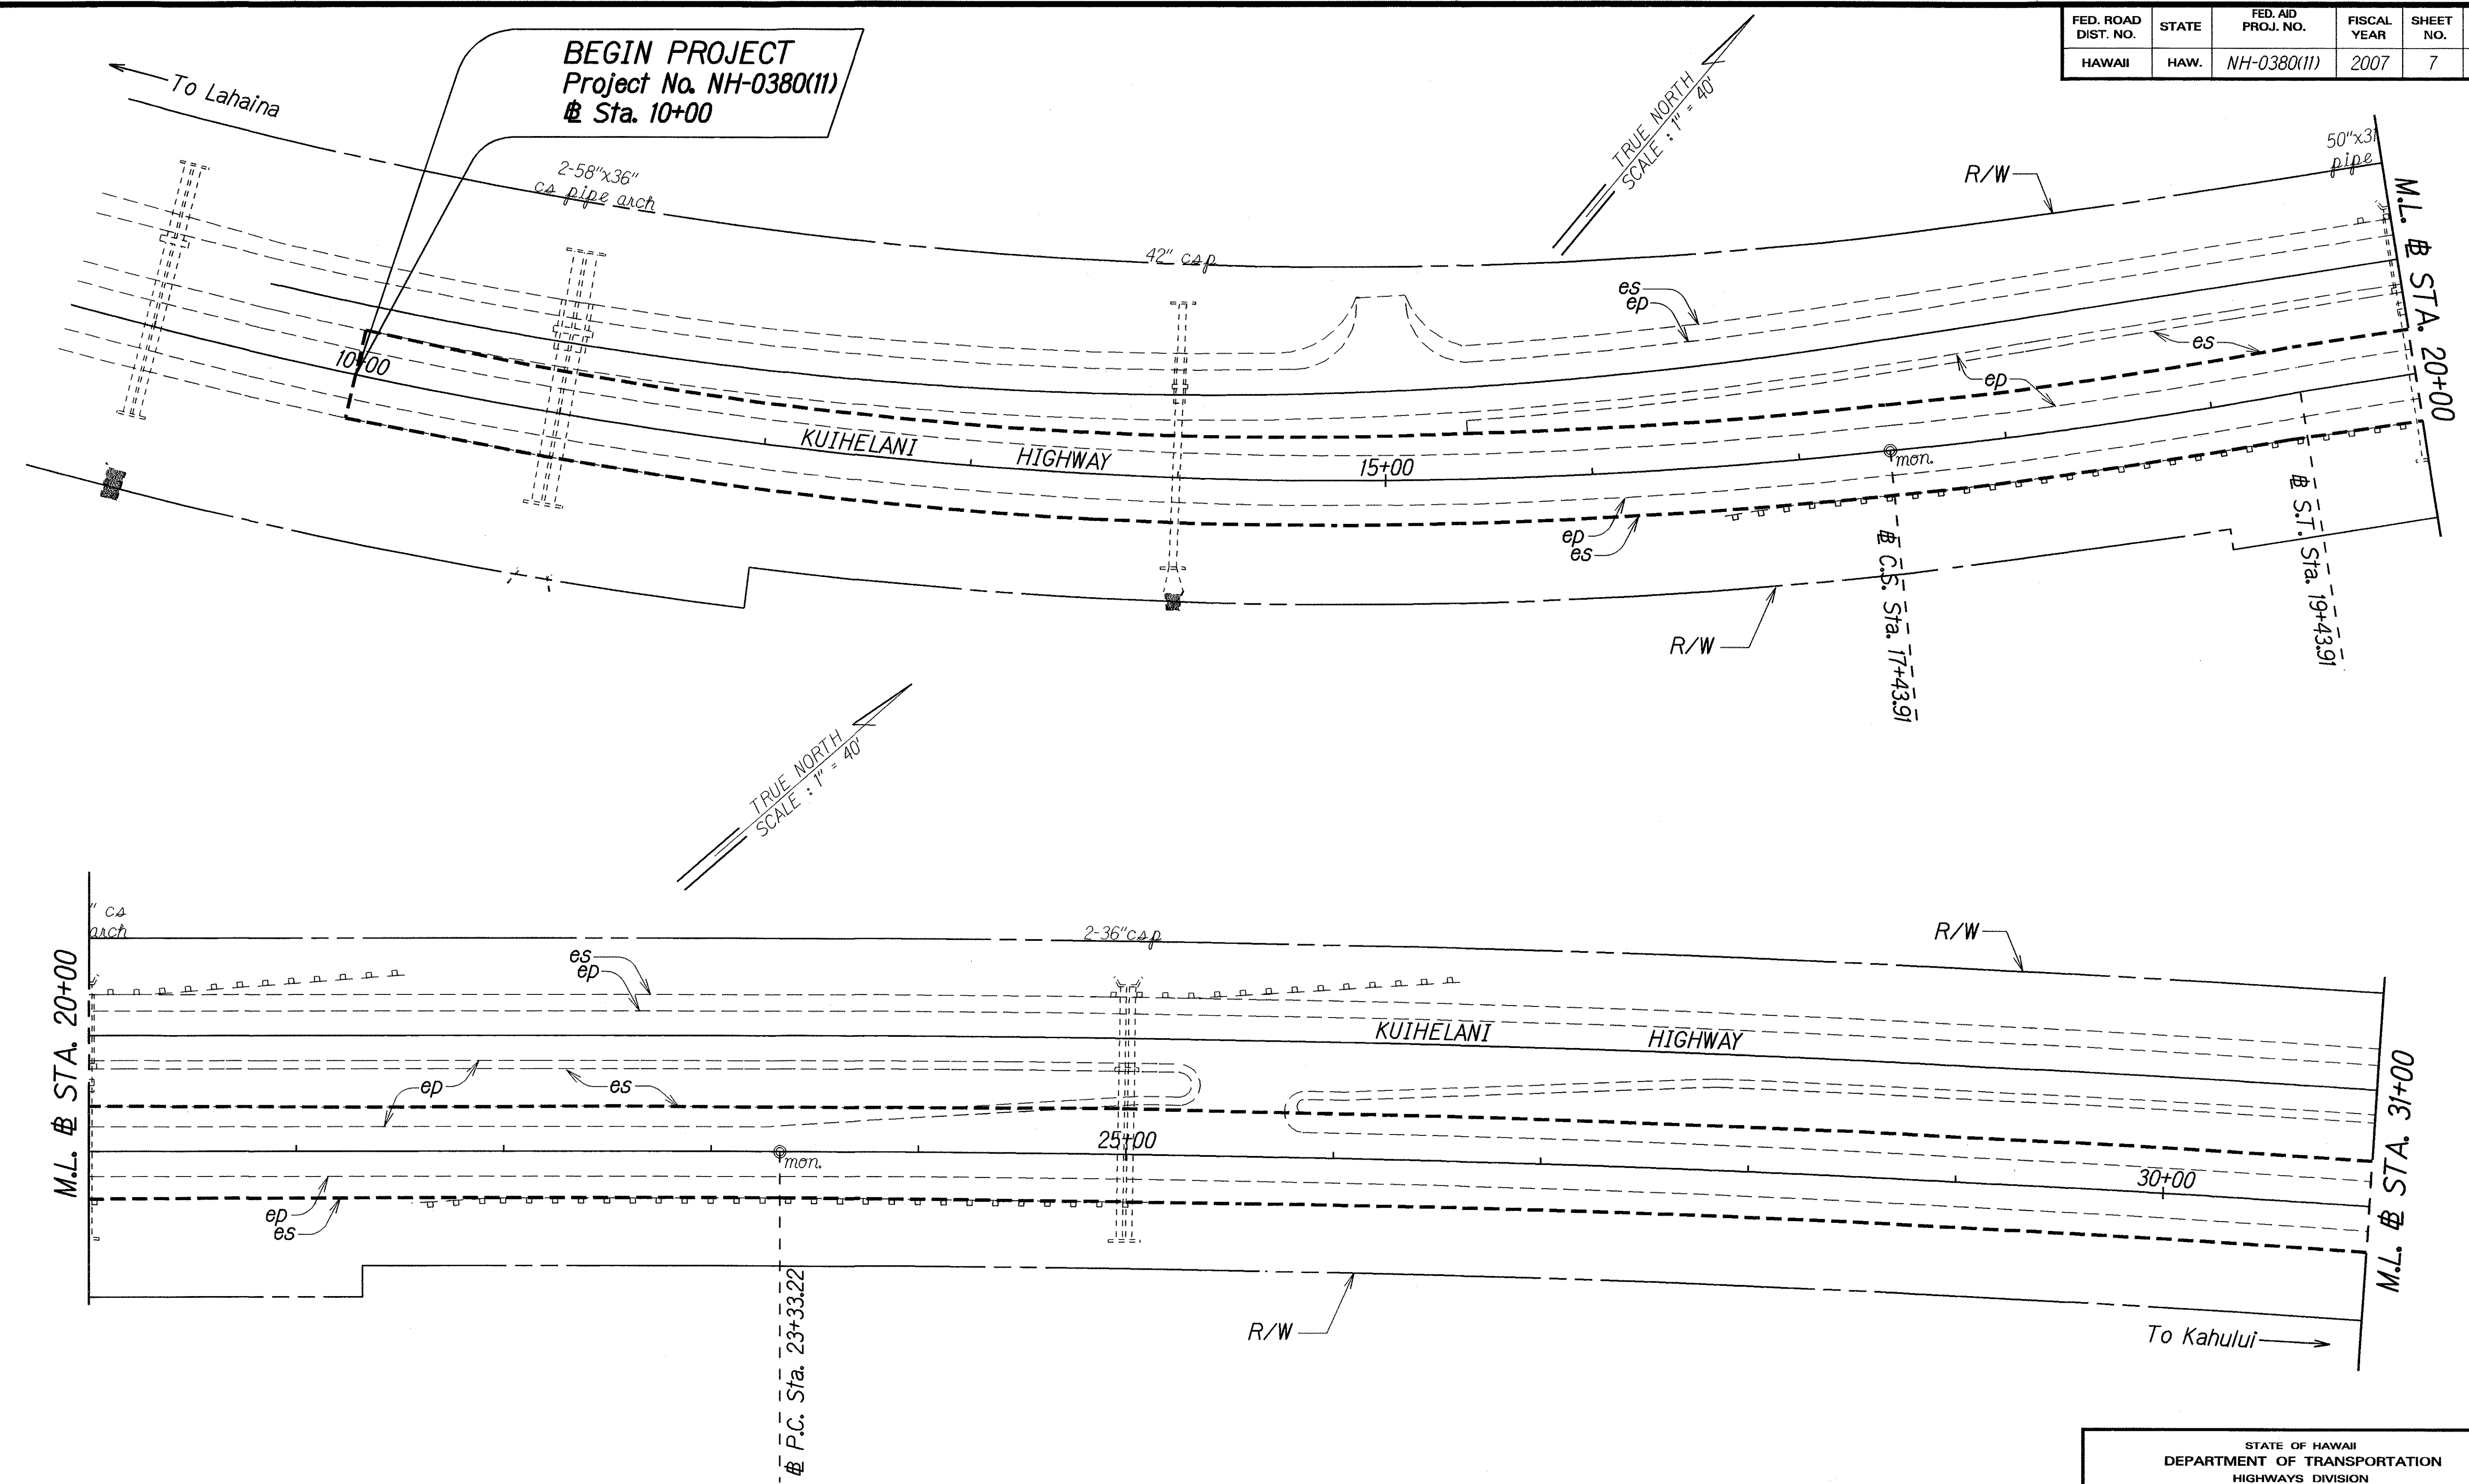

ORIGINAL PLAN	SURVEY PLOTTED BY	DATE
TRACED BY		
DESIGNED BY		
CHECKED BY		
NO.		


STATE OF HAWAII
DEPARTMENT OF TRANSPORTATION
HIGHWAYS DIVISION

ROADWAY PLAN
KUIHELANI HIGHWAY PAVEMENT
PREVENTIVE MAINTENANCE
Honopiihane Highway to Puunene Avenue
Federal-Aid Project No. NH-0380(11)

Scale: 1" = 40' Date: August, 2007

SHEET No. 1 OF 13 SHEETS

FED. ROAD DIST. NO.	STATE	FED. AID PROJ. NO.	FISCAL YEAR	SHEET NO.	TOTAL SHEETS
HAWAII	HAW.	NH-0380(11)	2007	8	33

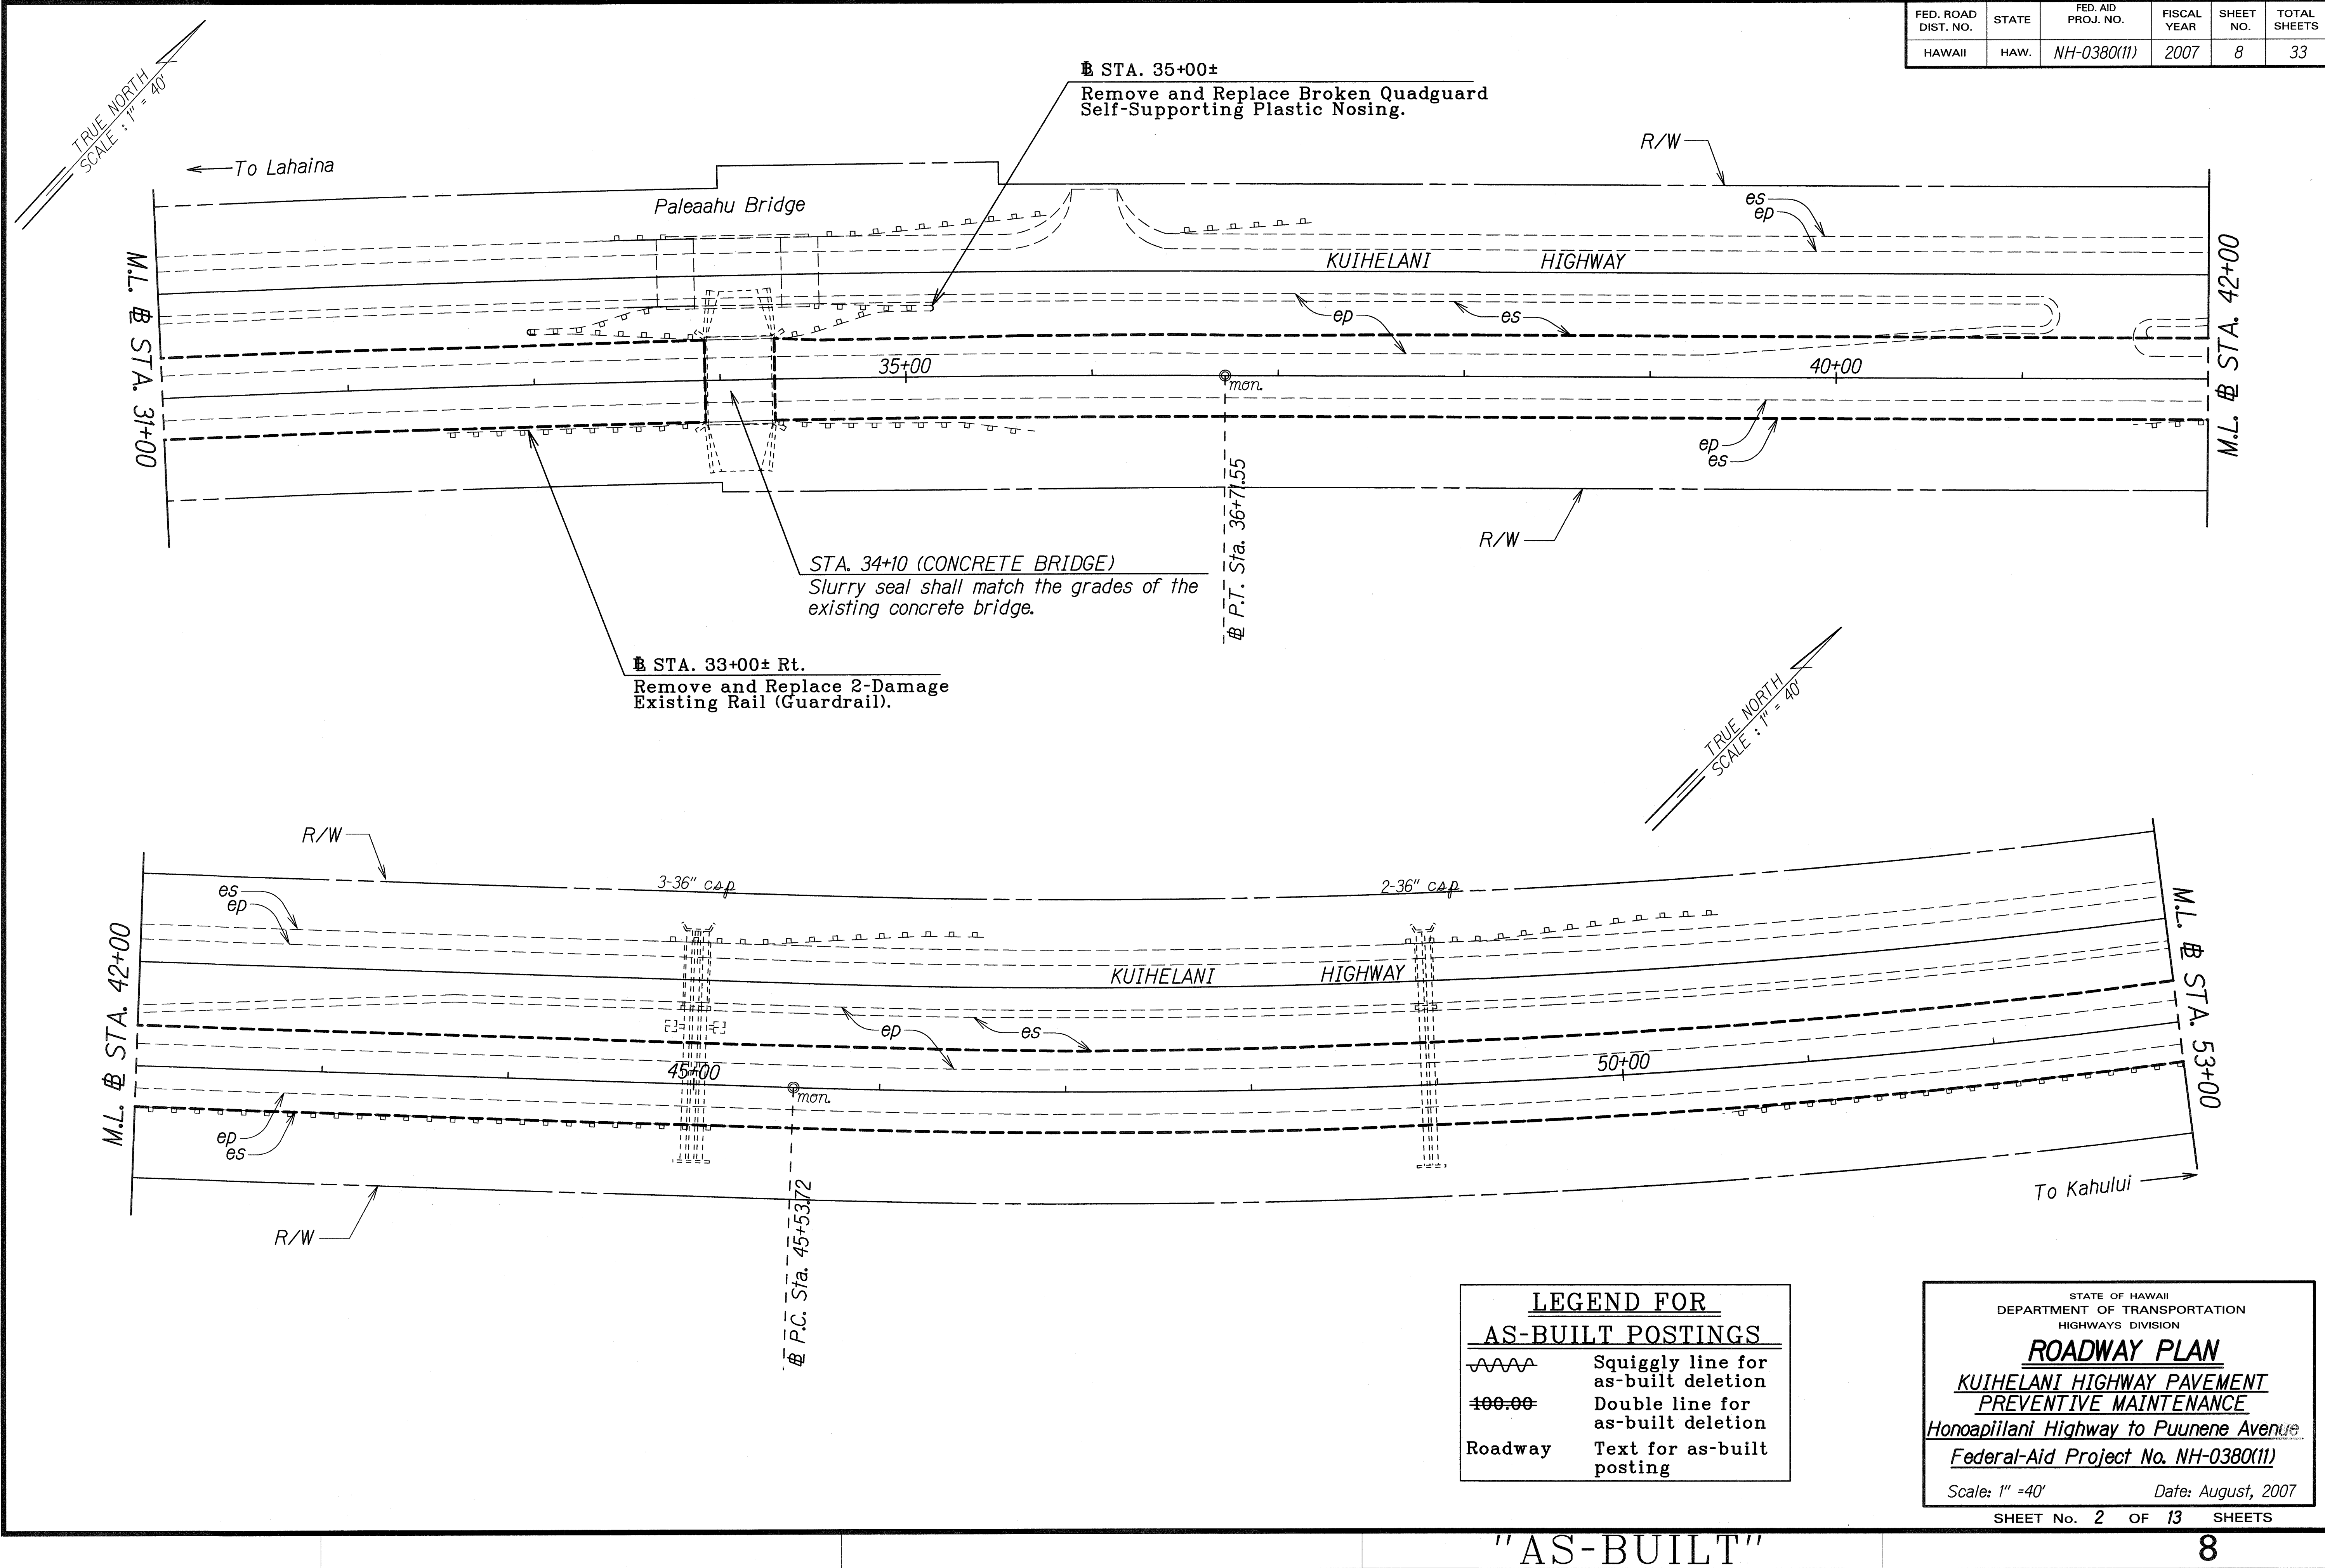



SURVEY PLOTTED BY	DATE
DRAWN BY	
TRACED BY	
QUANTITIES BY	
CHECKED BY	
ORIGINAL PLAN	
NOTE BOOK	
N.	

LEGEND FOR AS-BUILT POSTINGS	
	Squiggly line for as-built deletion
	Double line for as-built deletion
Roadway	Text for as-built posting

STATE OF HAWAII
DEPARTMENT OF TRANSPORTATION
HIGHWAYS DIVISION
ROADWAY PLAN
KUIHELANI HIGHWAY PAVEMENT PREVENTIVE MAINTENANCE
Honoapiilani Highway to Puunene Avenue
Federal-Aid Project No. NH-0380(11)
Scale: 1" = 40'

Date: August, 2007
SHEET No. 2 OF 13 SHEETS

FED. ROAD DIST. NO.	STATE	FED. AID PROJ. NO.	FISCAL YEAR	SHEET NO.	TOTAL SHEETS
HAWAII	HAW.	NH-0380(11)	2007	9	33

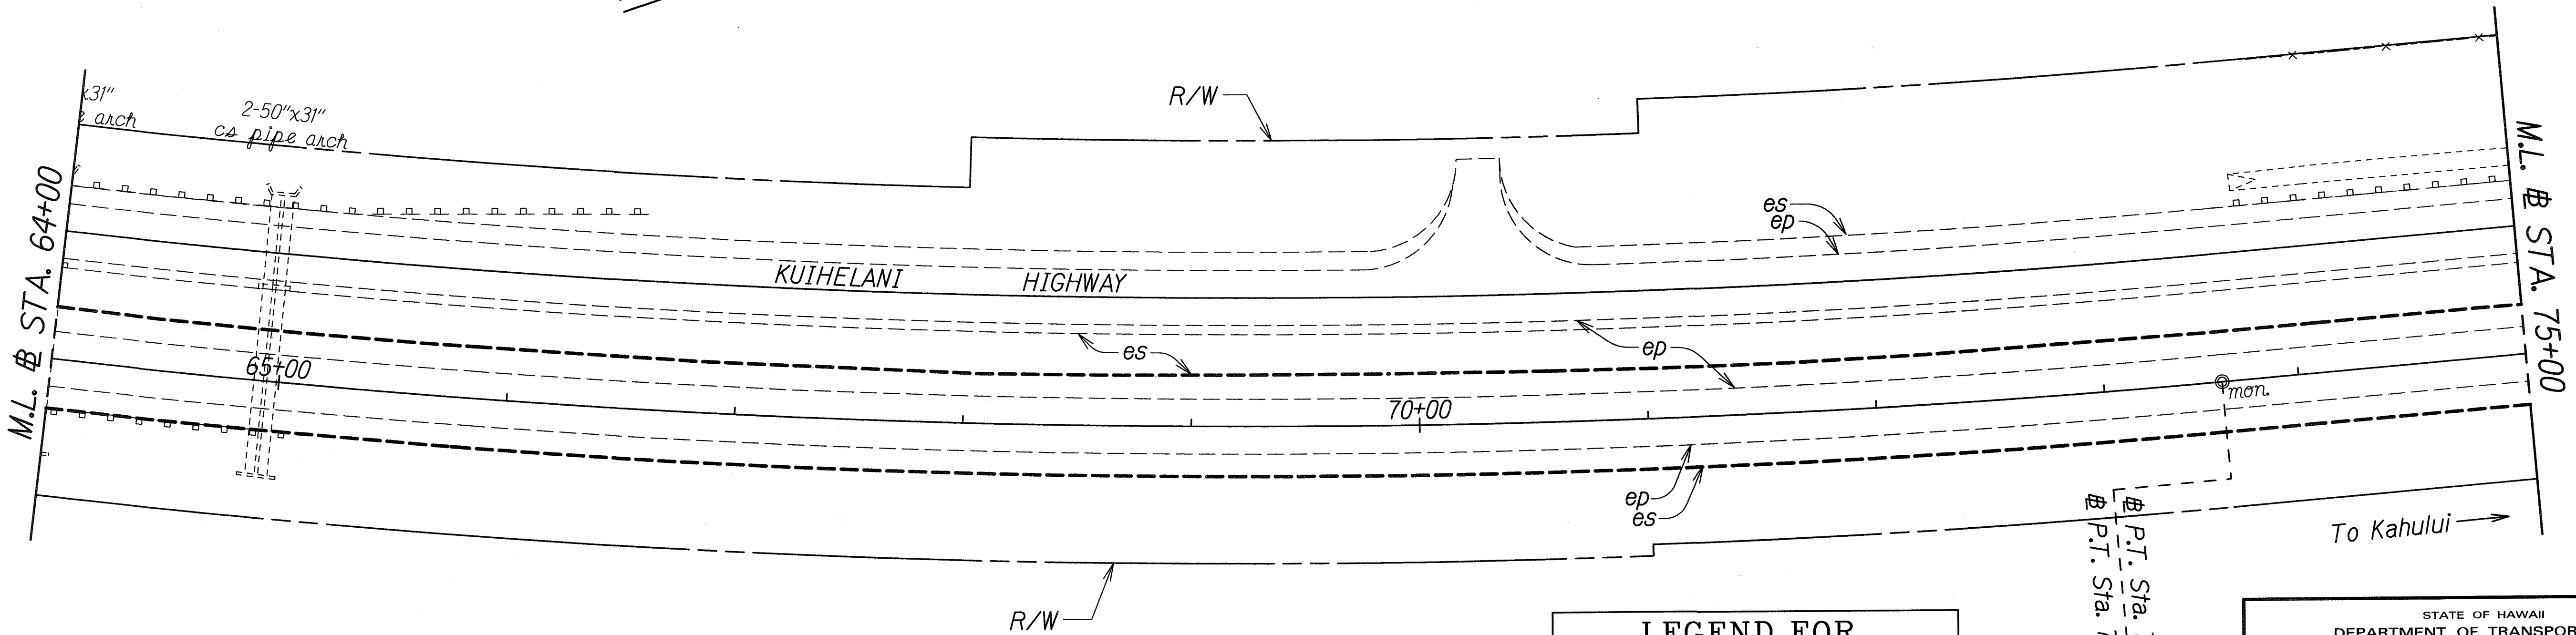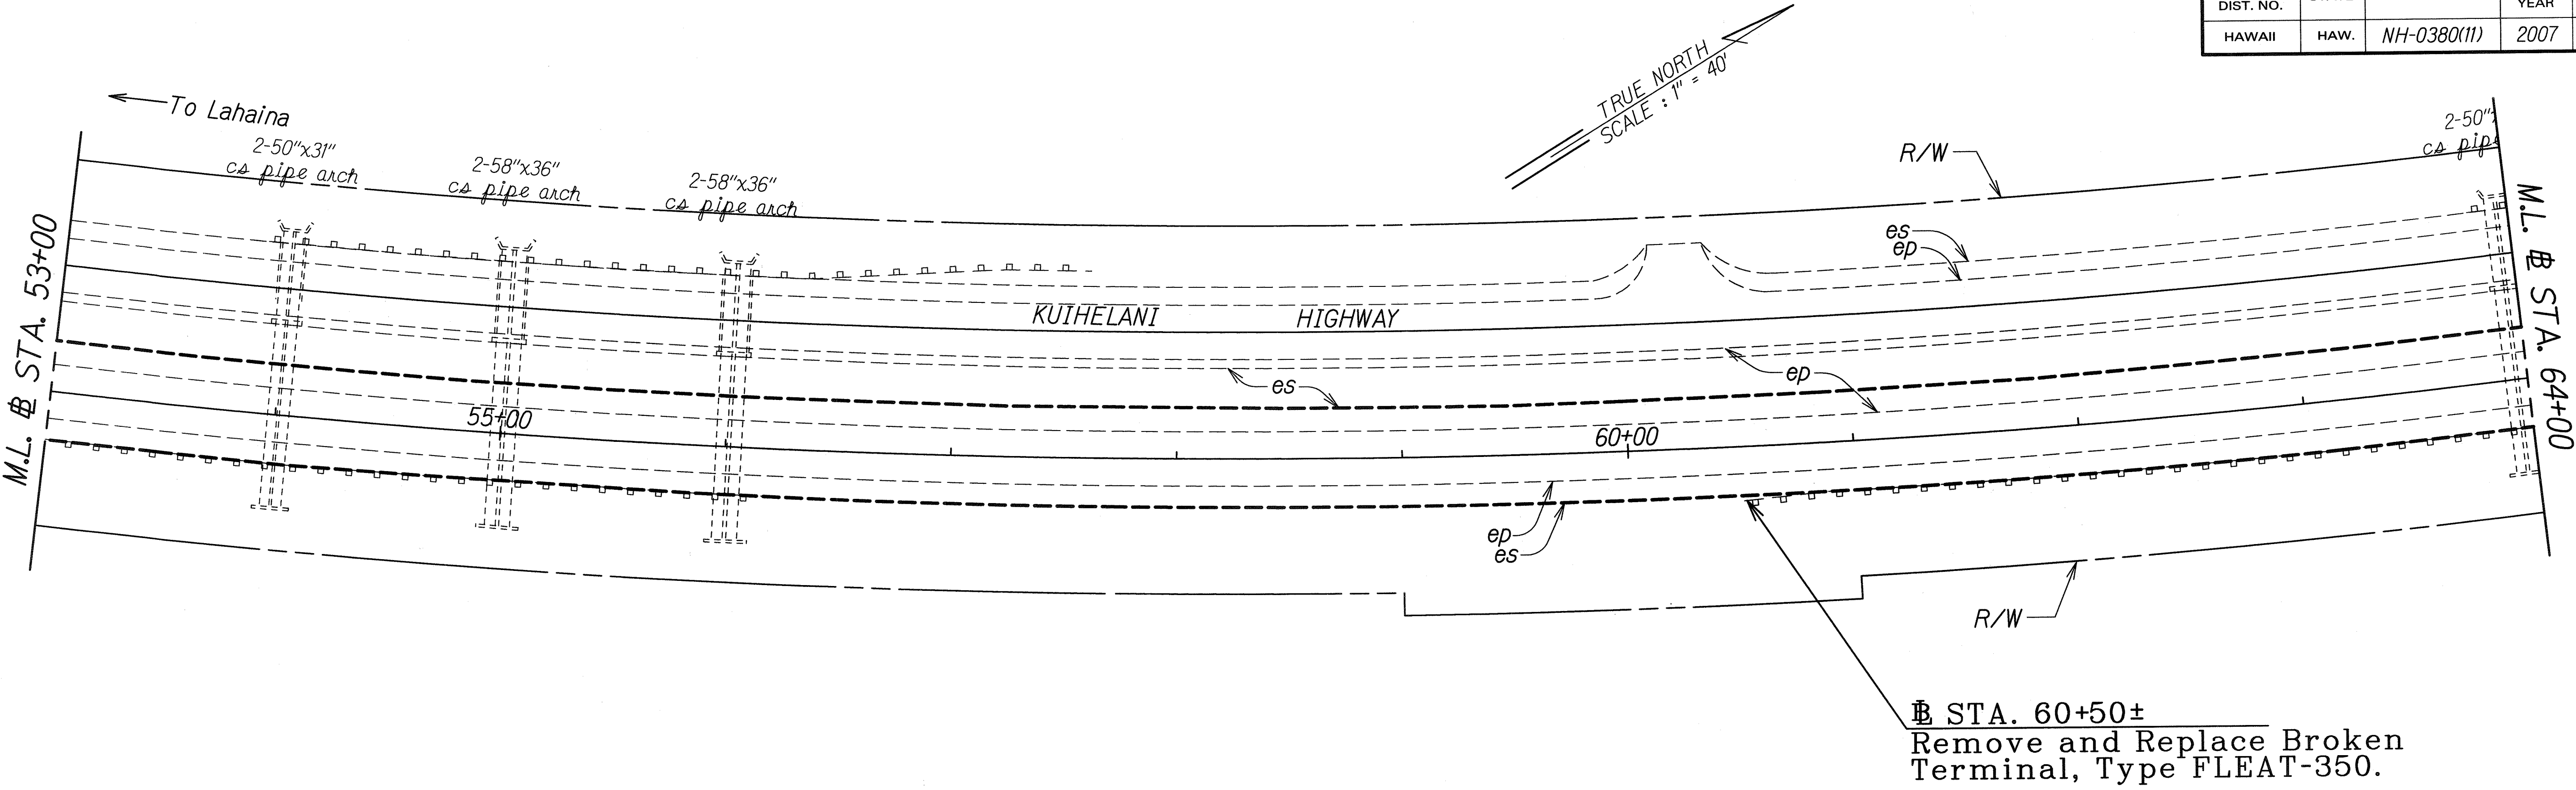

DATE	_____
DESIGNED BY	_____
TRACED BY	_____
NOTE BOOK	_____
QUANTITIES BY	_____
CHECKED BY	_____
N.	_____

LEGEND FOR AS-BUILT POSTINGS	
	Squiggly line for as-built deletion
	Double line for as-built deletion
Roadway	Text for as-built posting

P.T. Sta. 73+66.51 (AH)
P.T. Sta. 73+51.72 (BK) =

STATE OF HAWAII
DEPARTMENT OF TRANSPORTATION
HIGHWAYS DIVISION

ROADWAY PLAN


KUIHELANI HIGHWAY PAVEMENT
PREVENTIVE MAINTENANCE

Honoapiilani Highway to Puunene Avenue
Federal-Aid Project No. NH-0380(11)

Scale: 1" = 40'

Date: August, 2007

FED. ROAD DIST. NO.	STATE	FED. AID PROJ. NO.	FISCAL YEAR	SHEET NO.	TOTAL SHEETS
HAWAII	HAW.	NH-0380(11)	2007	10	33

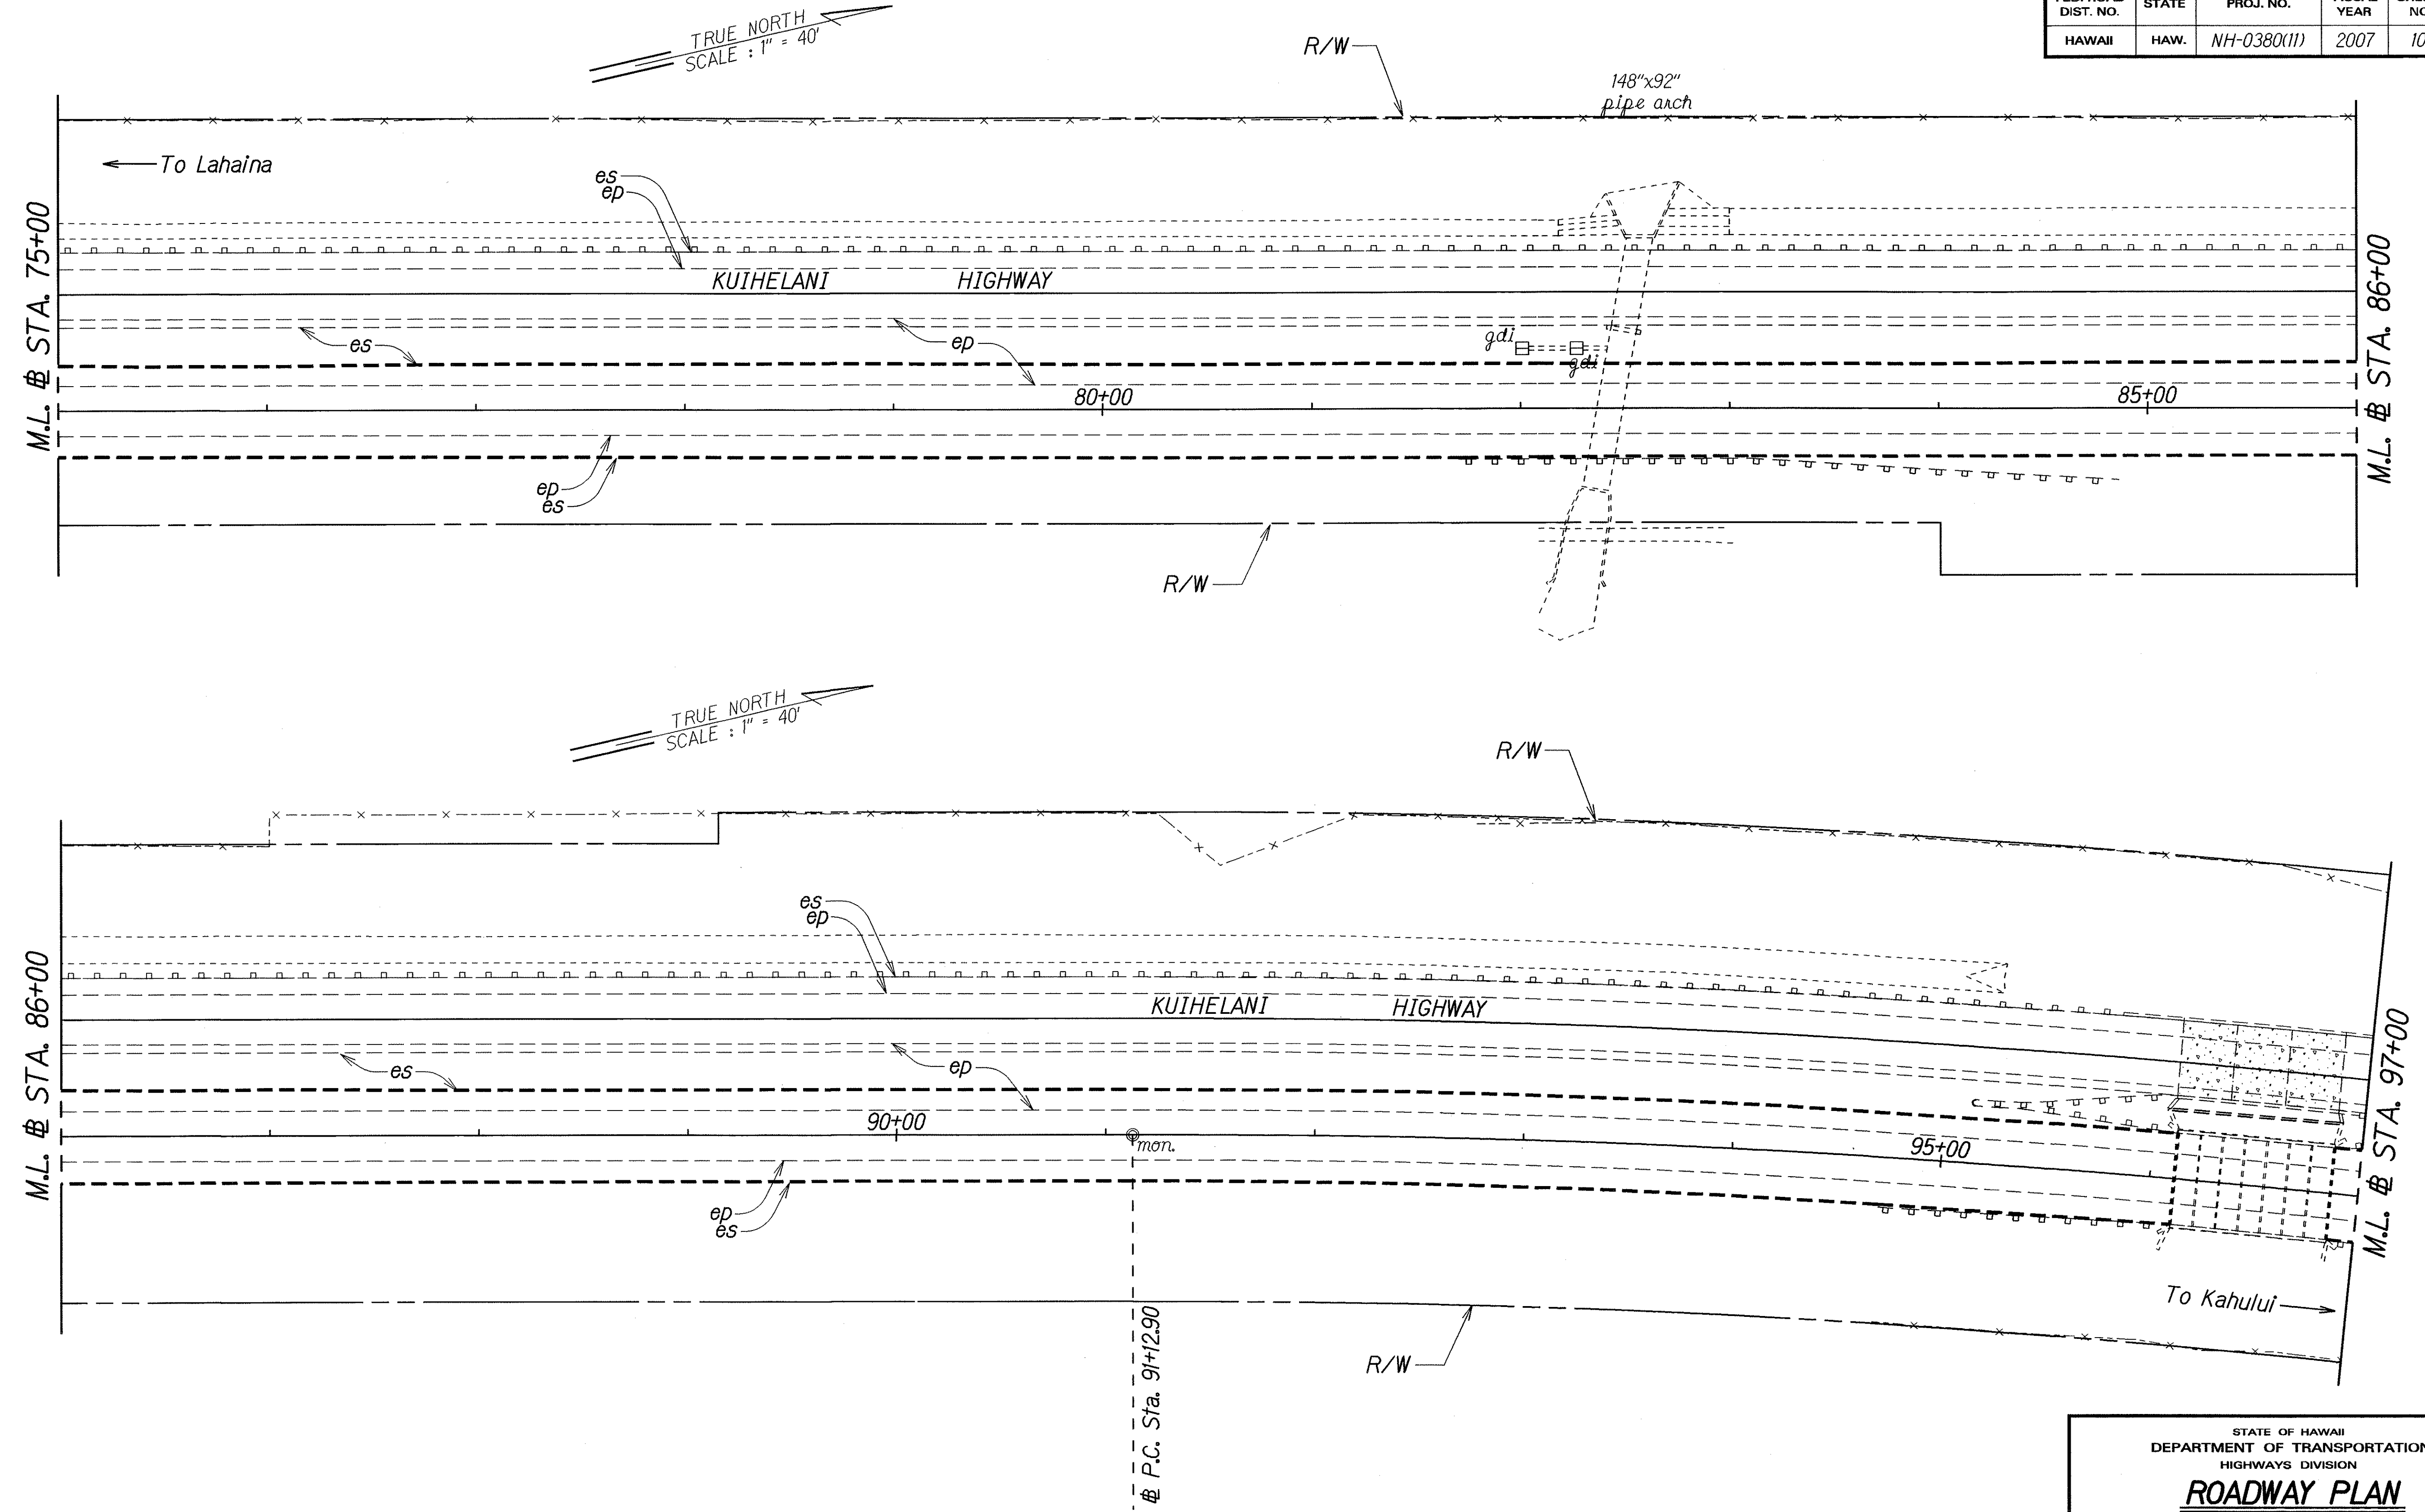

ORIGINAL PLAN	SURVEY PLOTTED BY	DATE
NOTE BOOK	DRAWN BY	
	DESIGNED BY	
	CHECKED BY	


STATE OF HAWAII
DEPARTMENT OF TRANSPORTATION
HIGHWAYS DIVISION

ROADWAY PLAN
KUIHELANI HIGHWAY PAVEMENT
PREVENTIVE MAINTENANCE
Honoapiilani Highway to Puunene Avenue
Federal-Aid Project No. NH-0380(11)


Scale: 1" = 40' Date: August, 2007

SHEET No. 4 OF 13 SHEETS

FED. ROAD DIST. NO.	STATE	FED. AID PROJ. NO.	FISCAL YEAR	SHEET NO.	TOTAL SHEETS
HAWAII	HAW.	NH-0380(11)	2007	11	33

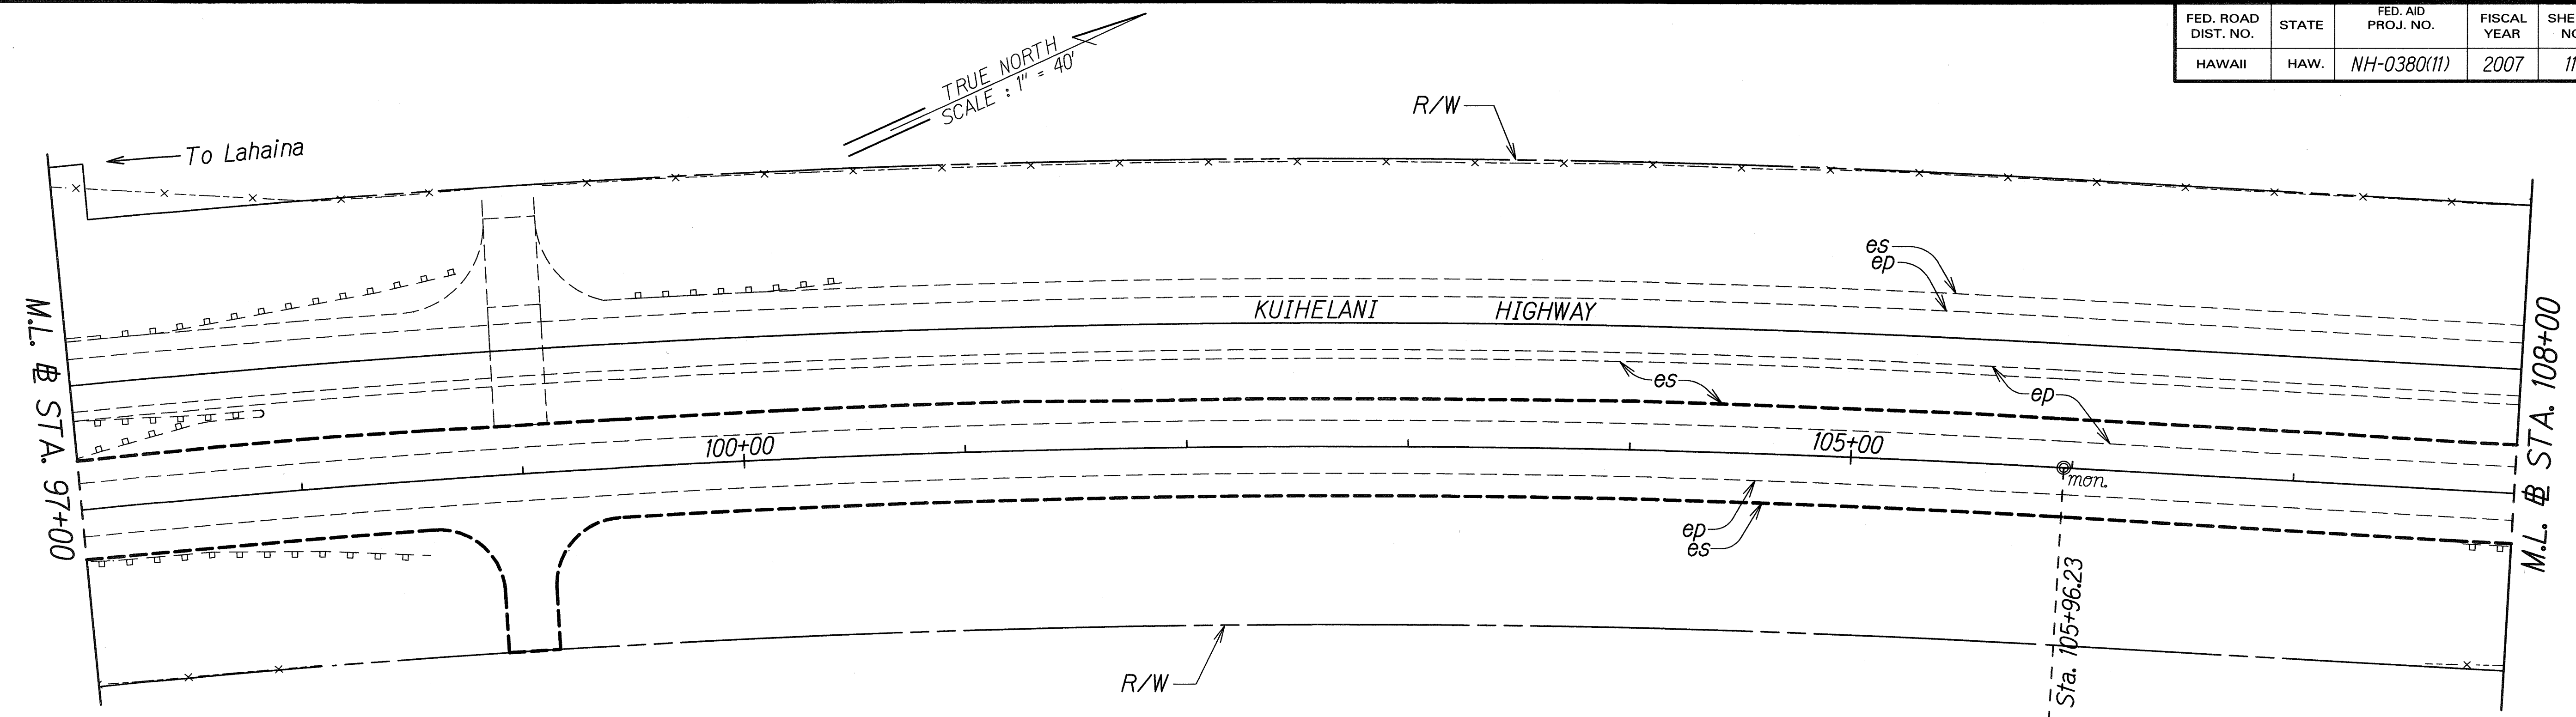

± STA. 108+50±
Remove and Replace Broken Quadguard
Self-Supporting Plastic Nosing.

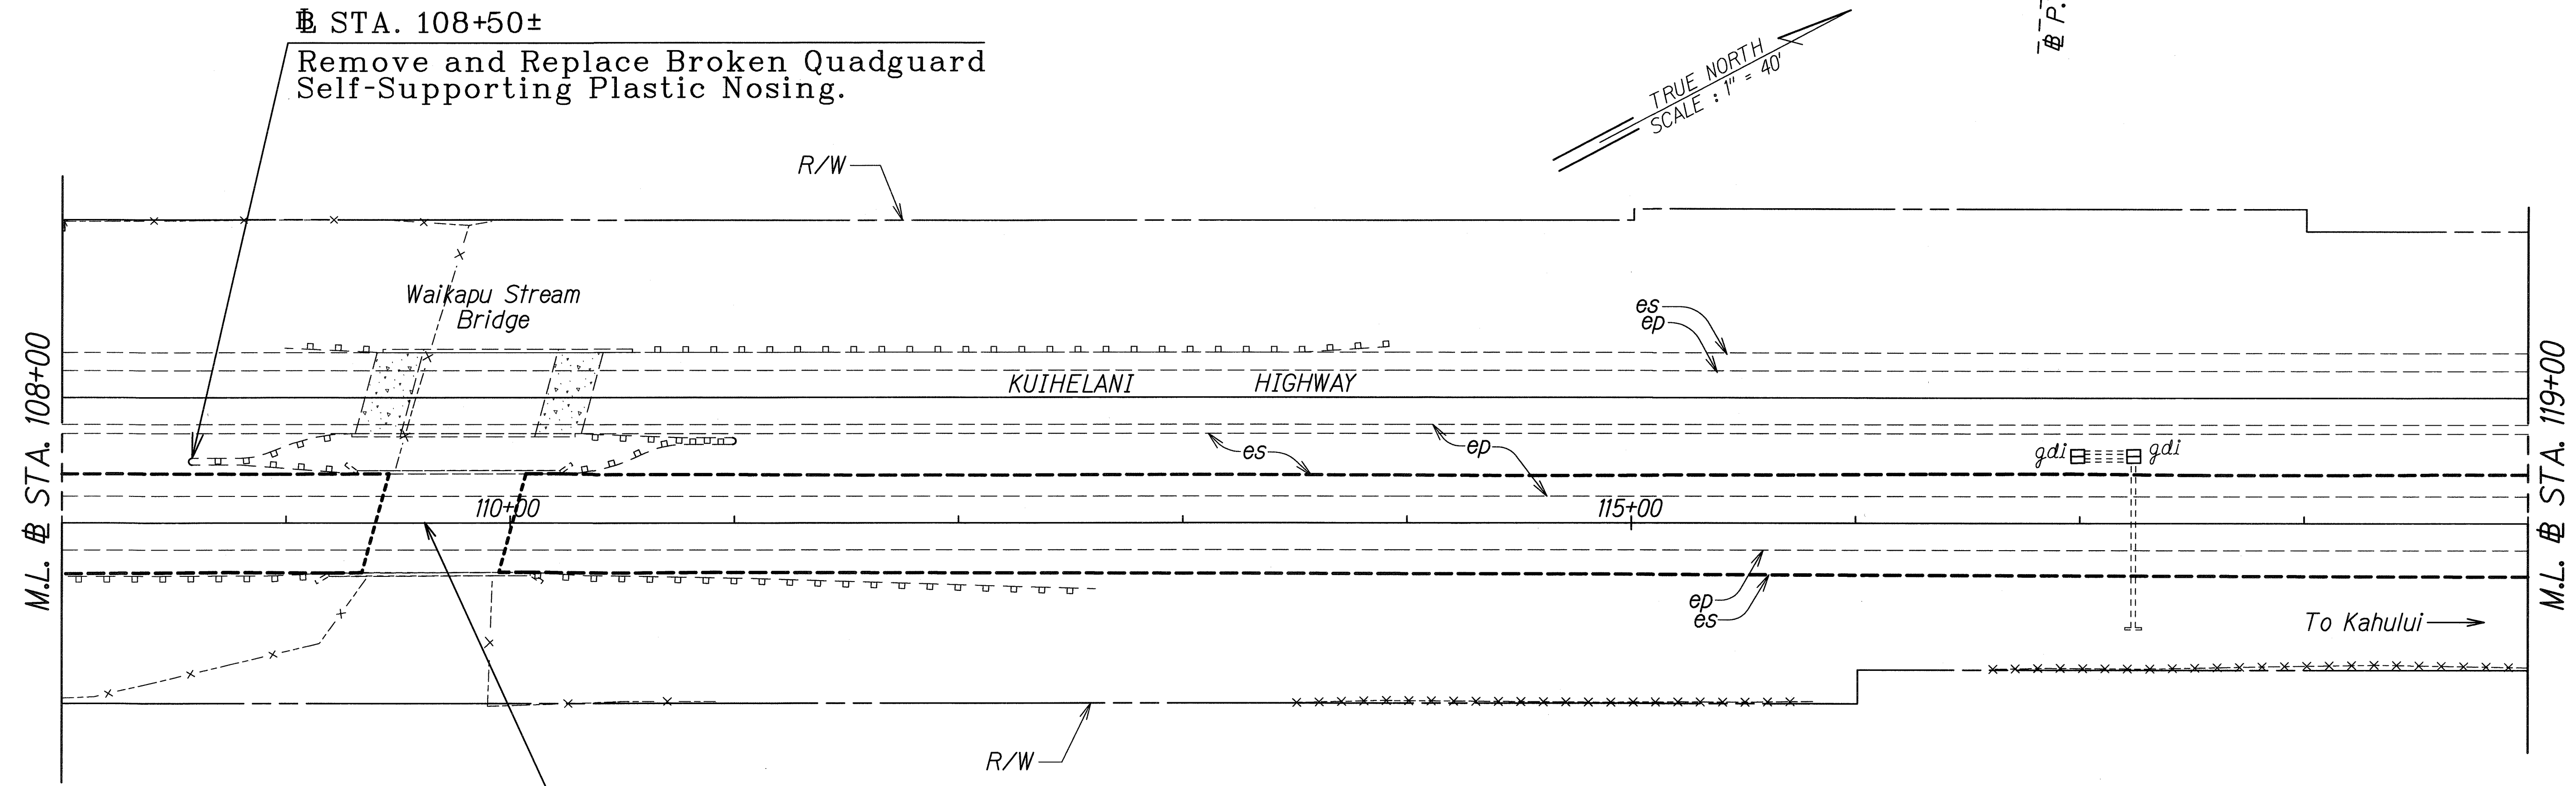

STA. 109+70± (CONCRETE BRIDGE)
Slurry seal shall match the grades of existing
concrete bridge

LEGEND FOR AS-BUILT POSTINGS	
	Squiggly line for as-built deletion
	Double line for as-built deletion
Roadway	Text for as-built posting

STATE OF HAWAII
DEPARTMENT OF TRANSPORTATION
HIGHWAYS DIVISION

ROADWAY PLAN
**KUIHELANI HIGHWAY PAVEMENT
PREVENTIVE MAINTENANCE**
Honoapiʻilani Highway to Puunene Avenue
Federal-Aid Project No. NH-0380(11)


Scale: 1" = 40'
Date: August, 2007

SHEET No. 5 OF 13 SHEETS

"AS-BUILT"

ORIGINAL PLAN	SURVEY PLOTTED BY	DATE
NOTE BOOK	DRAWN BY	
	DESIGNED BY	
	QUANTITIES BY	
	CHECKED BY	

FED. ROAD DIST. NO.	STATE	FED. AID PROJ. NO.	FISCAL YEAR	SHEET NO.	TOTAL SHEETS
HAWAII	HAW.	NH-0380(11)	2007	12	33

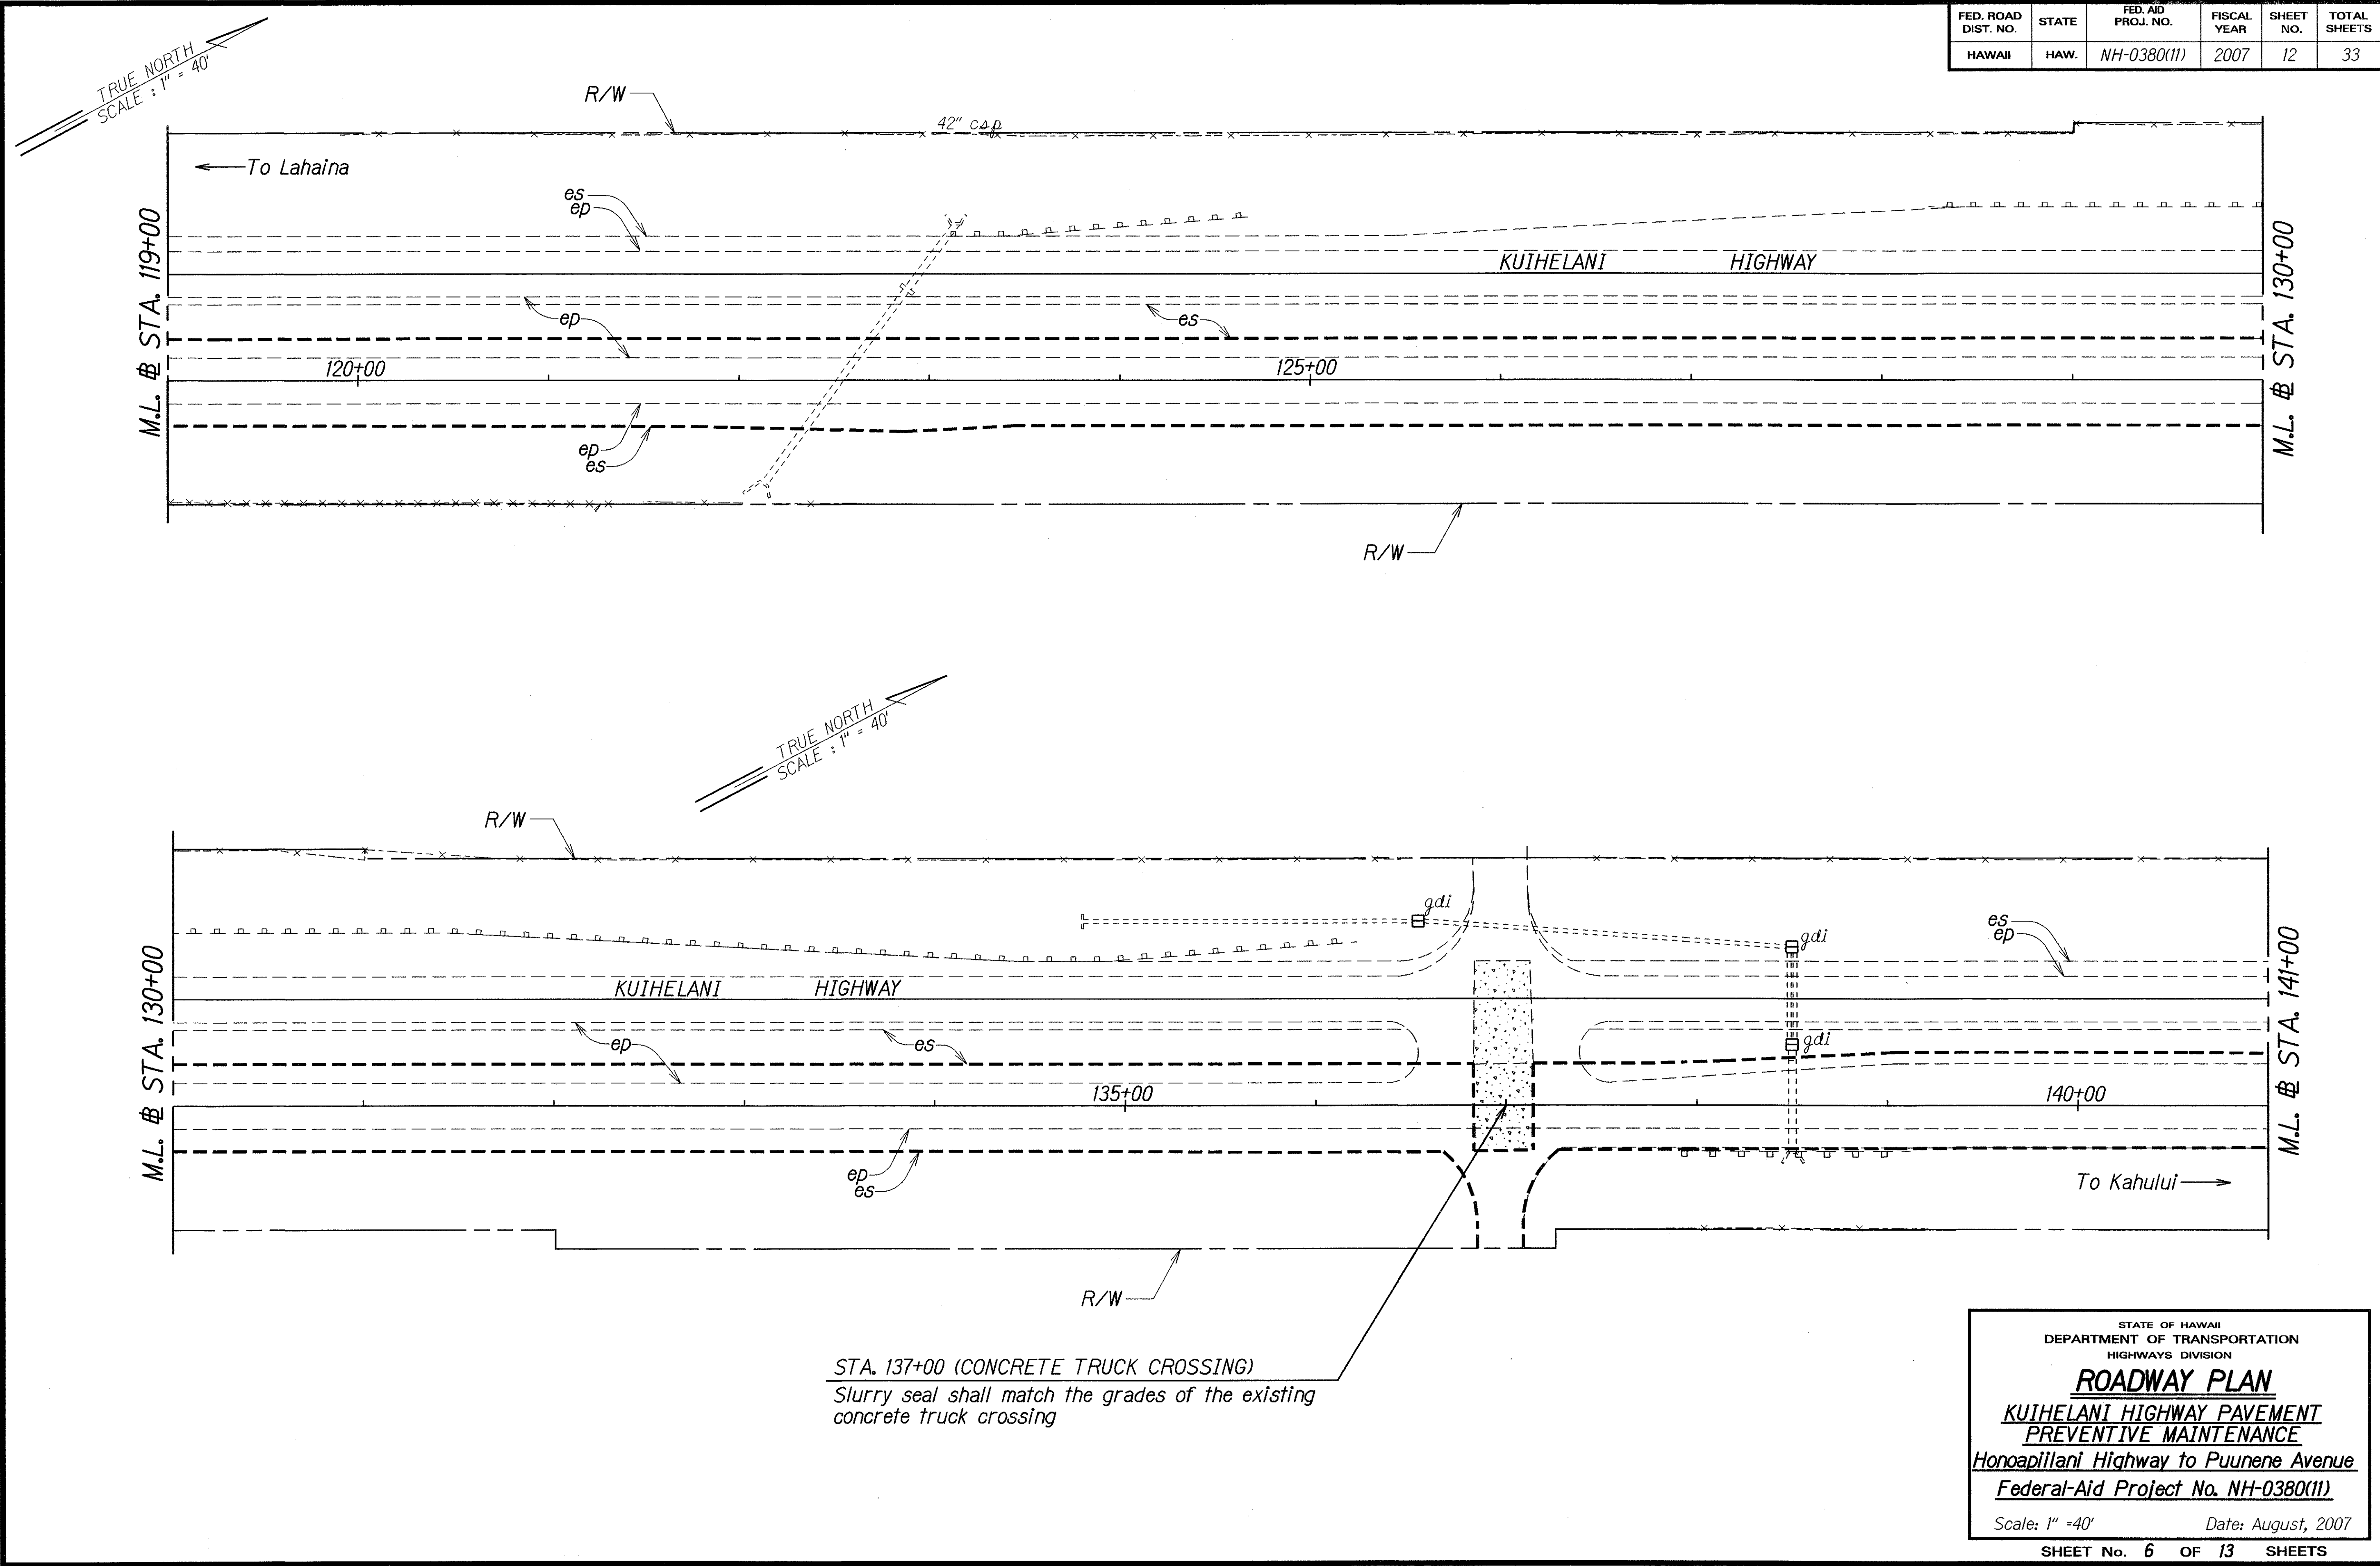


ORIGINAL PLAN	SURVEY PLOTTED BY	DATE
DESIGNED BY	DRAWN BY	
CHECKED BY	TRACED BY	
	NOTED BY	
	CHECKED BY	

STATE OF HAWAII
DEPARTMENT OF TRANSPORTATION
HIGHWAYS DIVISION

ROADWAY PLAN
**KUIHELANI HIGHWAY PAVEMENT
PREVENTIVE MAINTENANCE**
Honoapiʻilani Highway to Puunene Avenue
Federal-Aid Project No. NH-0380(11)

Scale: 1" = 40' Date: August, 2007

FED. ROAD DIST. NO.	STATE	FED. AID PROJ. NO.	FISCAL YEAR	SHEET NO.	TOTAL SHEETS
HAWAII	HAW.	NH-0380(11)	2007	13	33

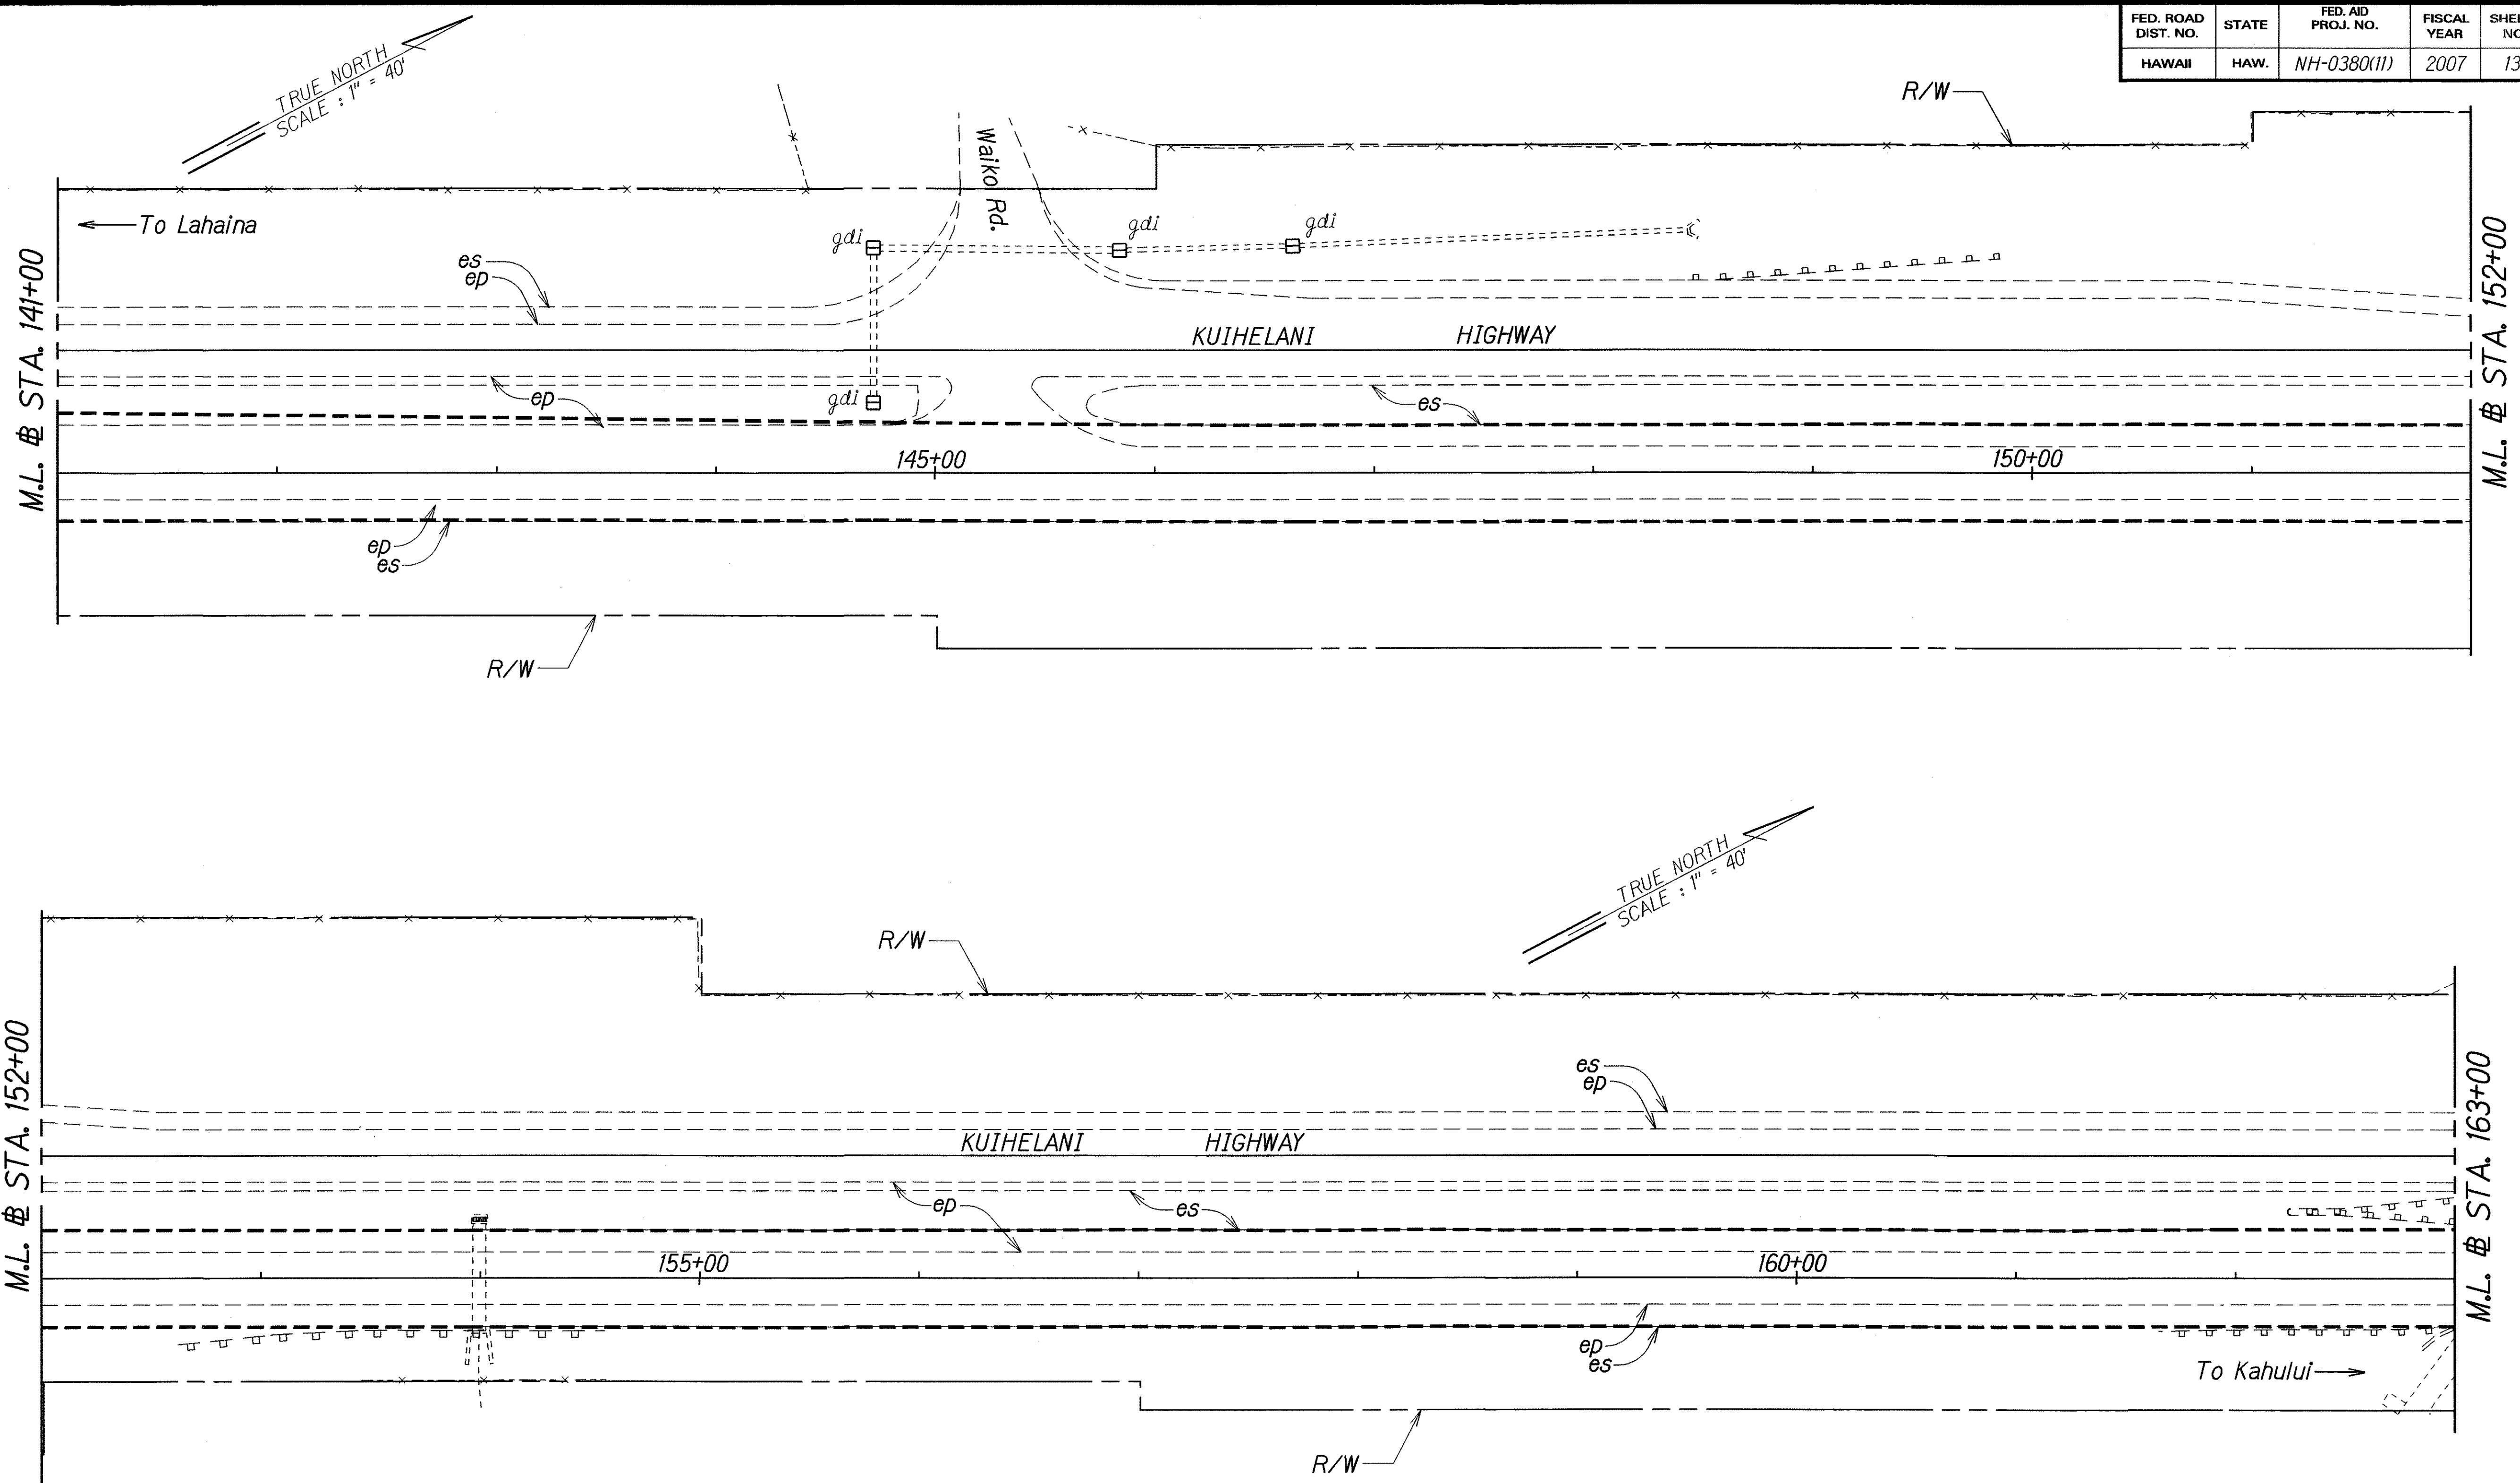


ORIGINAL PLAN	DATE
DESIGNED BY	
CHECKED BY	
NOTED BY	
DATE	

STATE OF HAWAII
DEPARTMENT OF TRANSPORTATION
HIGHWAYS DIVISION

ROADWAY PLAN
KUIHELANI HIGHWAY PAVEMENT
PREVENTIVE MAINTENANCE
Honoapiʻilani Highway to Puunene Avenue
Federal-Aid Project No. NH-0380(11)

Scale: 1" = 40' Date: August, 2007

FED. ROAD DIST. NO.	STATE	FED. AID PROJ. NO.	FISCAL YEAR	SHEET NO.	TOTAL SHEETS
HAWAII	HAW.	NH-0380(11)	2007	14	33

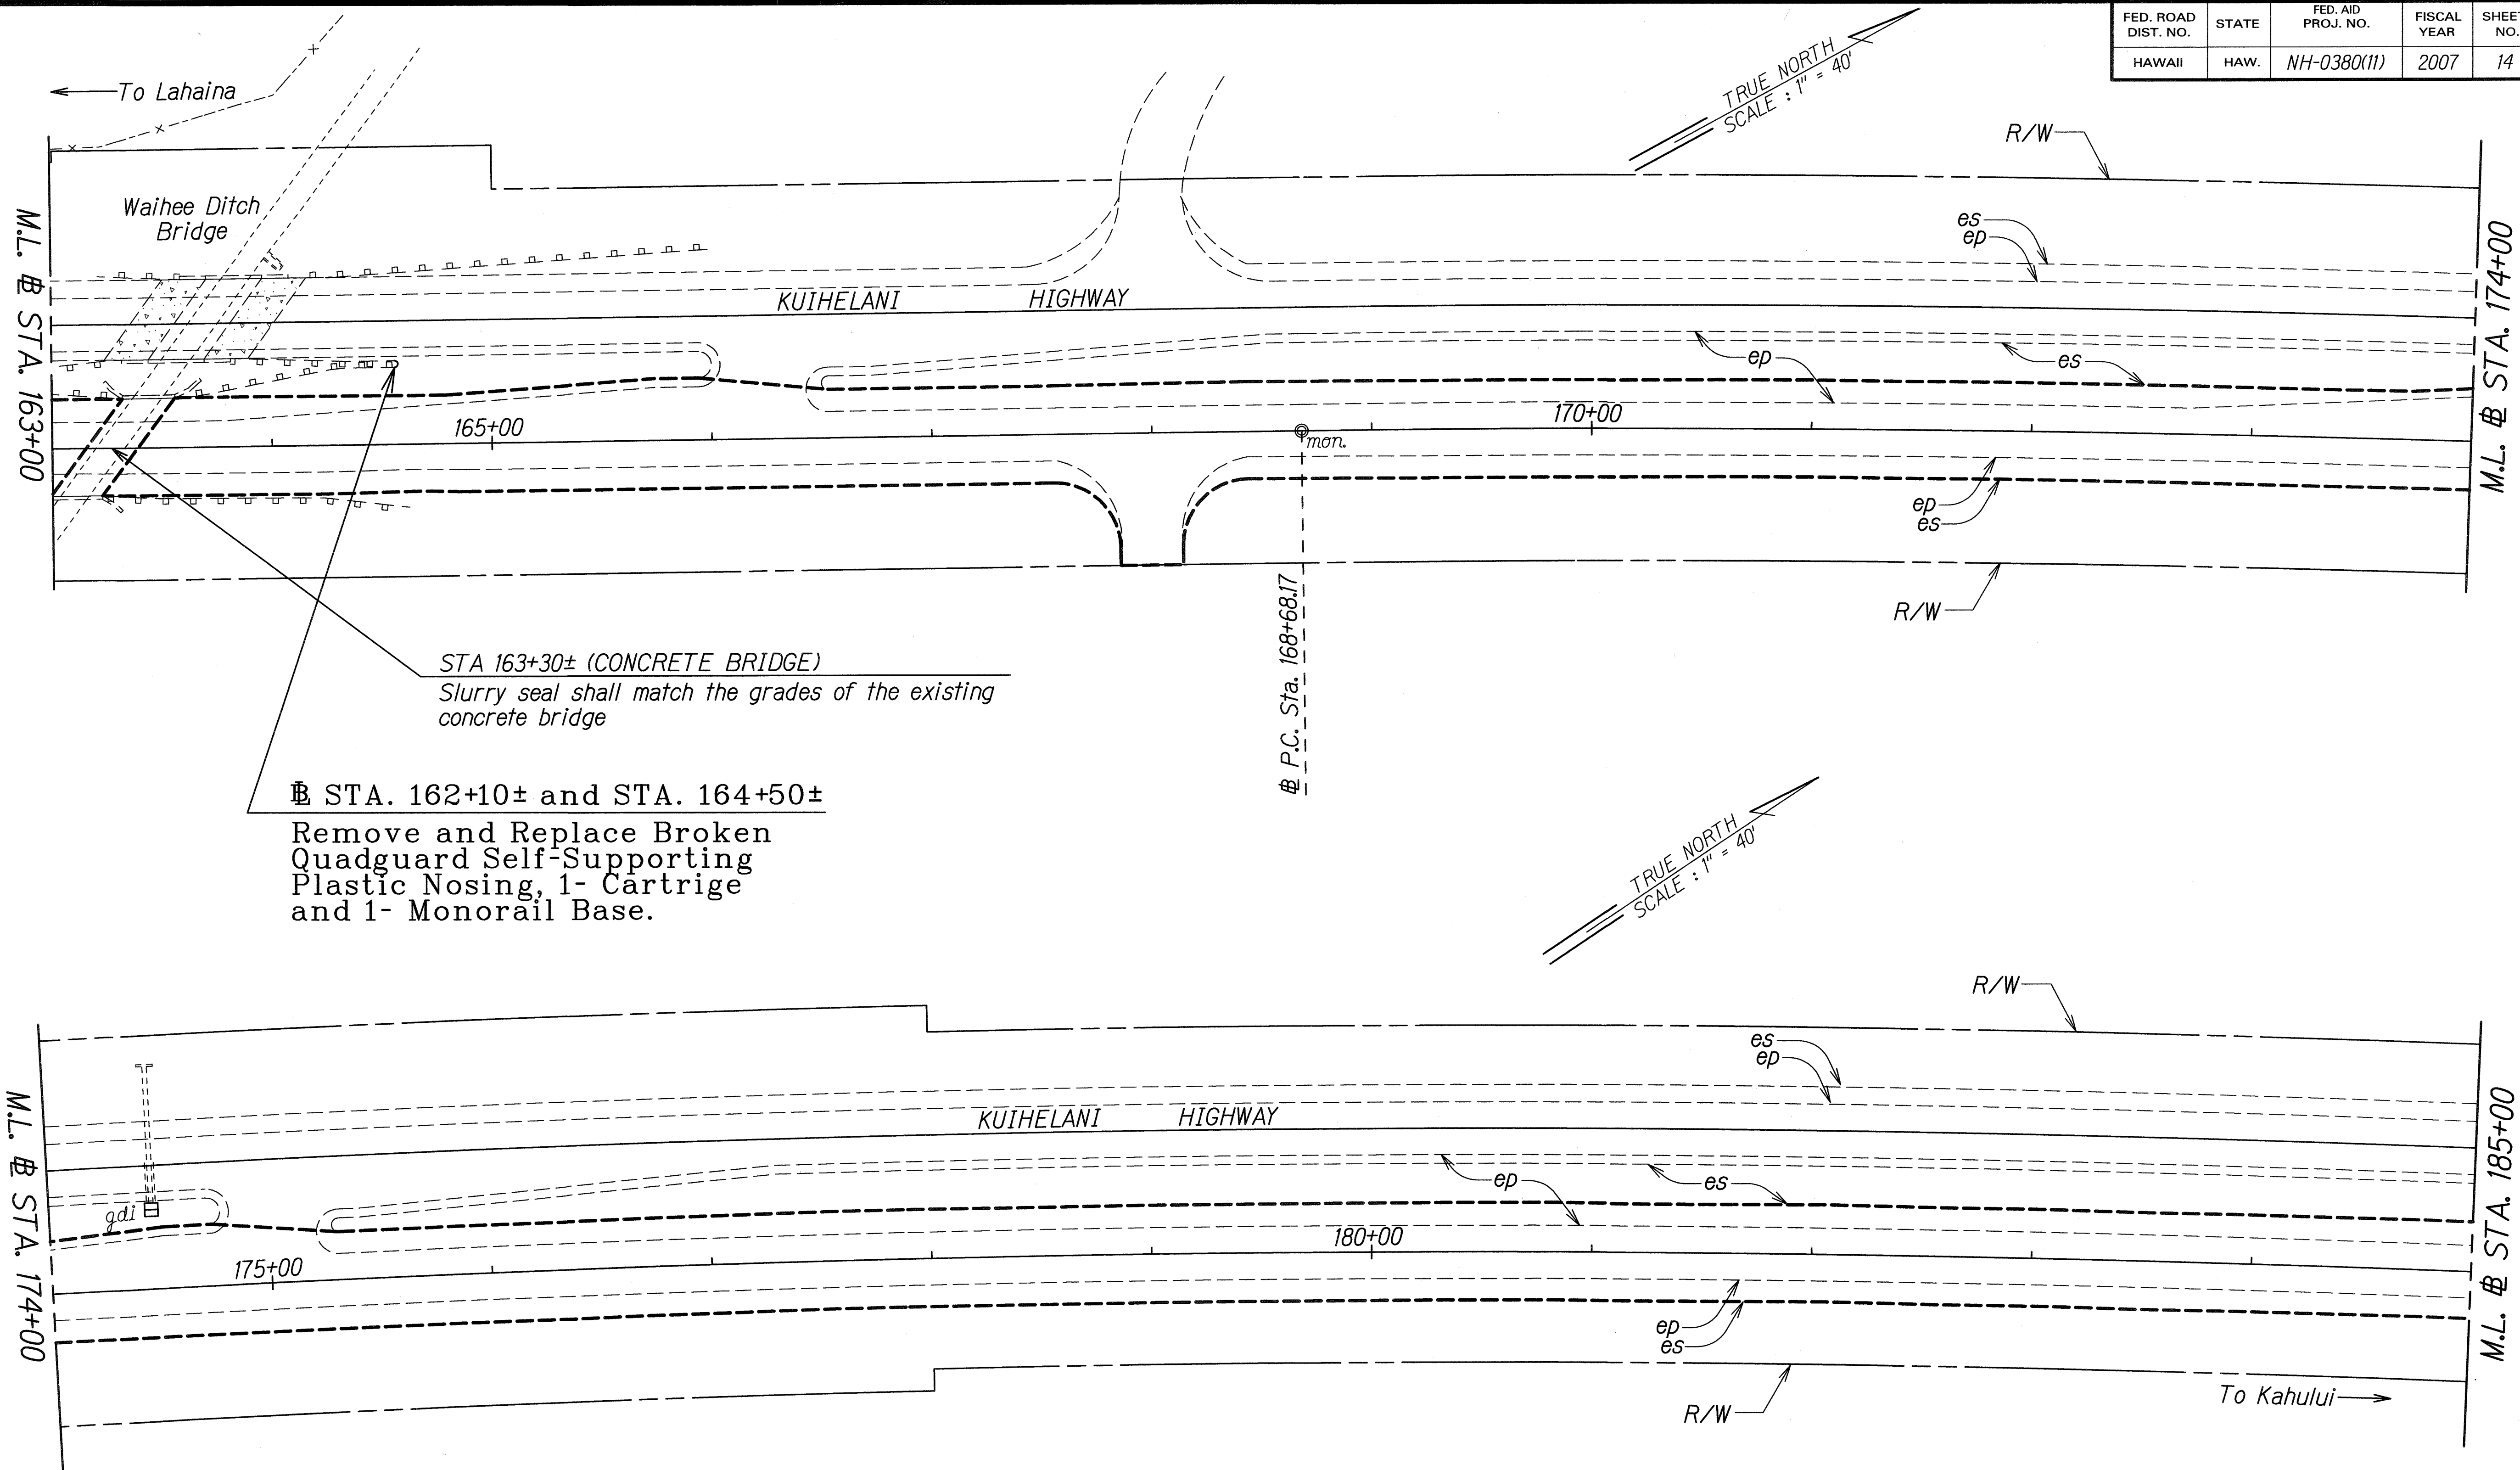

STA 163+30± (CONCRETE BRIDGE)
Slurry seal shall match the grades of the existing concrete bridge

Remove and Replace Broken Quadguard Self-Supporting Plastic Nosing, 1- Cartrige and 1- Monorail Base.

SURVEY PLOTTED BY	DATE
DRAWN BY	
TRACED BY	
CHECKED BY	
NOTED BY	
ORIGINAL PLAN	
NOTE BOOK	
NO.	

LEGEND FOR AS-BUILT POSTINGS	
	Squiggly line for as-built deletion
	Double line for as-built deletion
Roadway	Text for as-built posting


STATE OF HAWAII
DEPARTMENT OF TRANSPORTATION
HIGHWAYS DIVISION

ROADWAY PLAN
KUIHELANI HIGHWAY PAVEMENT
PREVENTIVE MAINTENANCE
Honoapiilani Highway to Puunene Avenue
Federal-Aid Project No. NH-0380(11)

Scale: 1" = 40' Date: August, 2007

SHEET No. 8 OF 13 SHEETS

FED. ROAD DIST. NO.	STATE	FED. AID PROJ. NO.	FISCAL YEAR	SHEET NO.	TOTAL SHEETS
HAWAII	HAW.	NH-0380(11)	2007	15	33

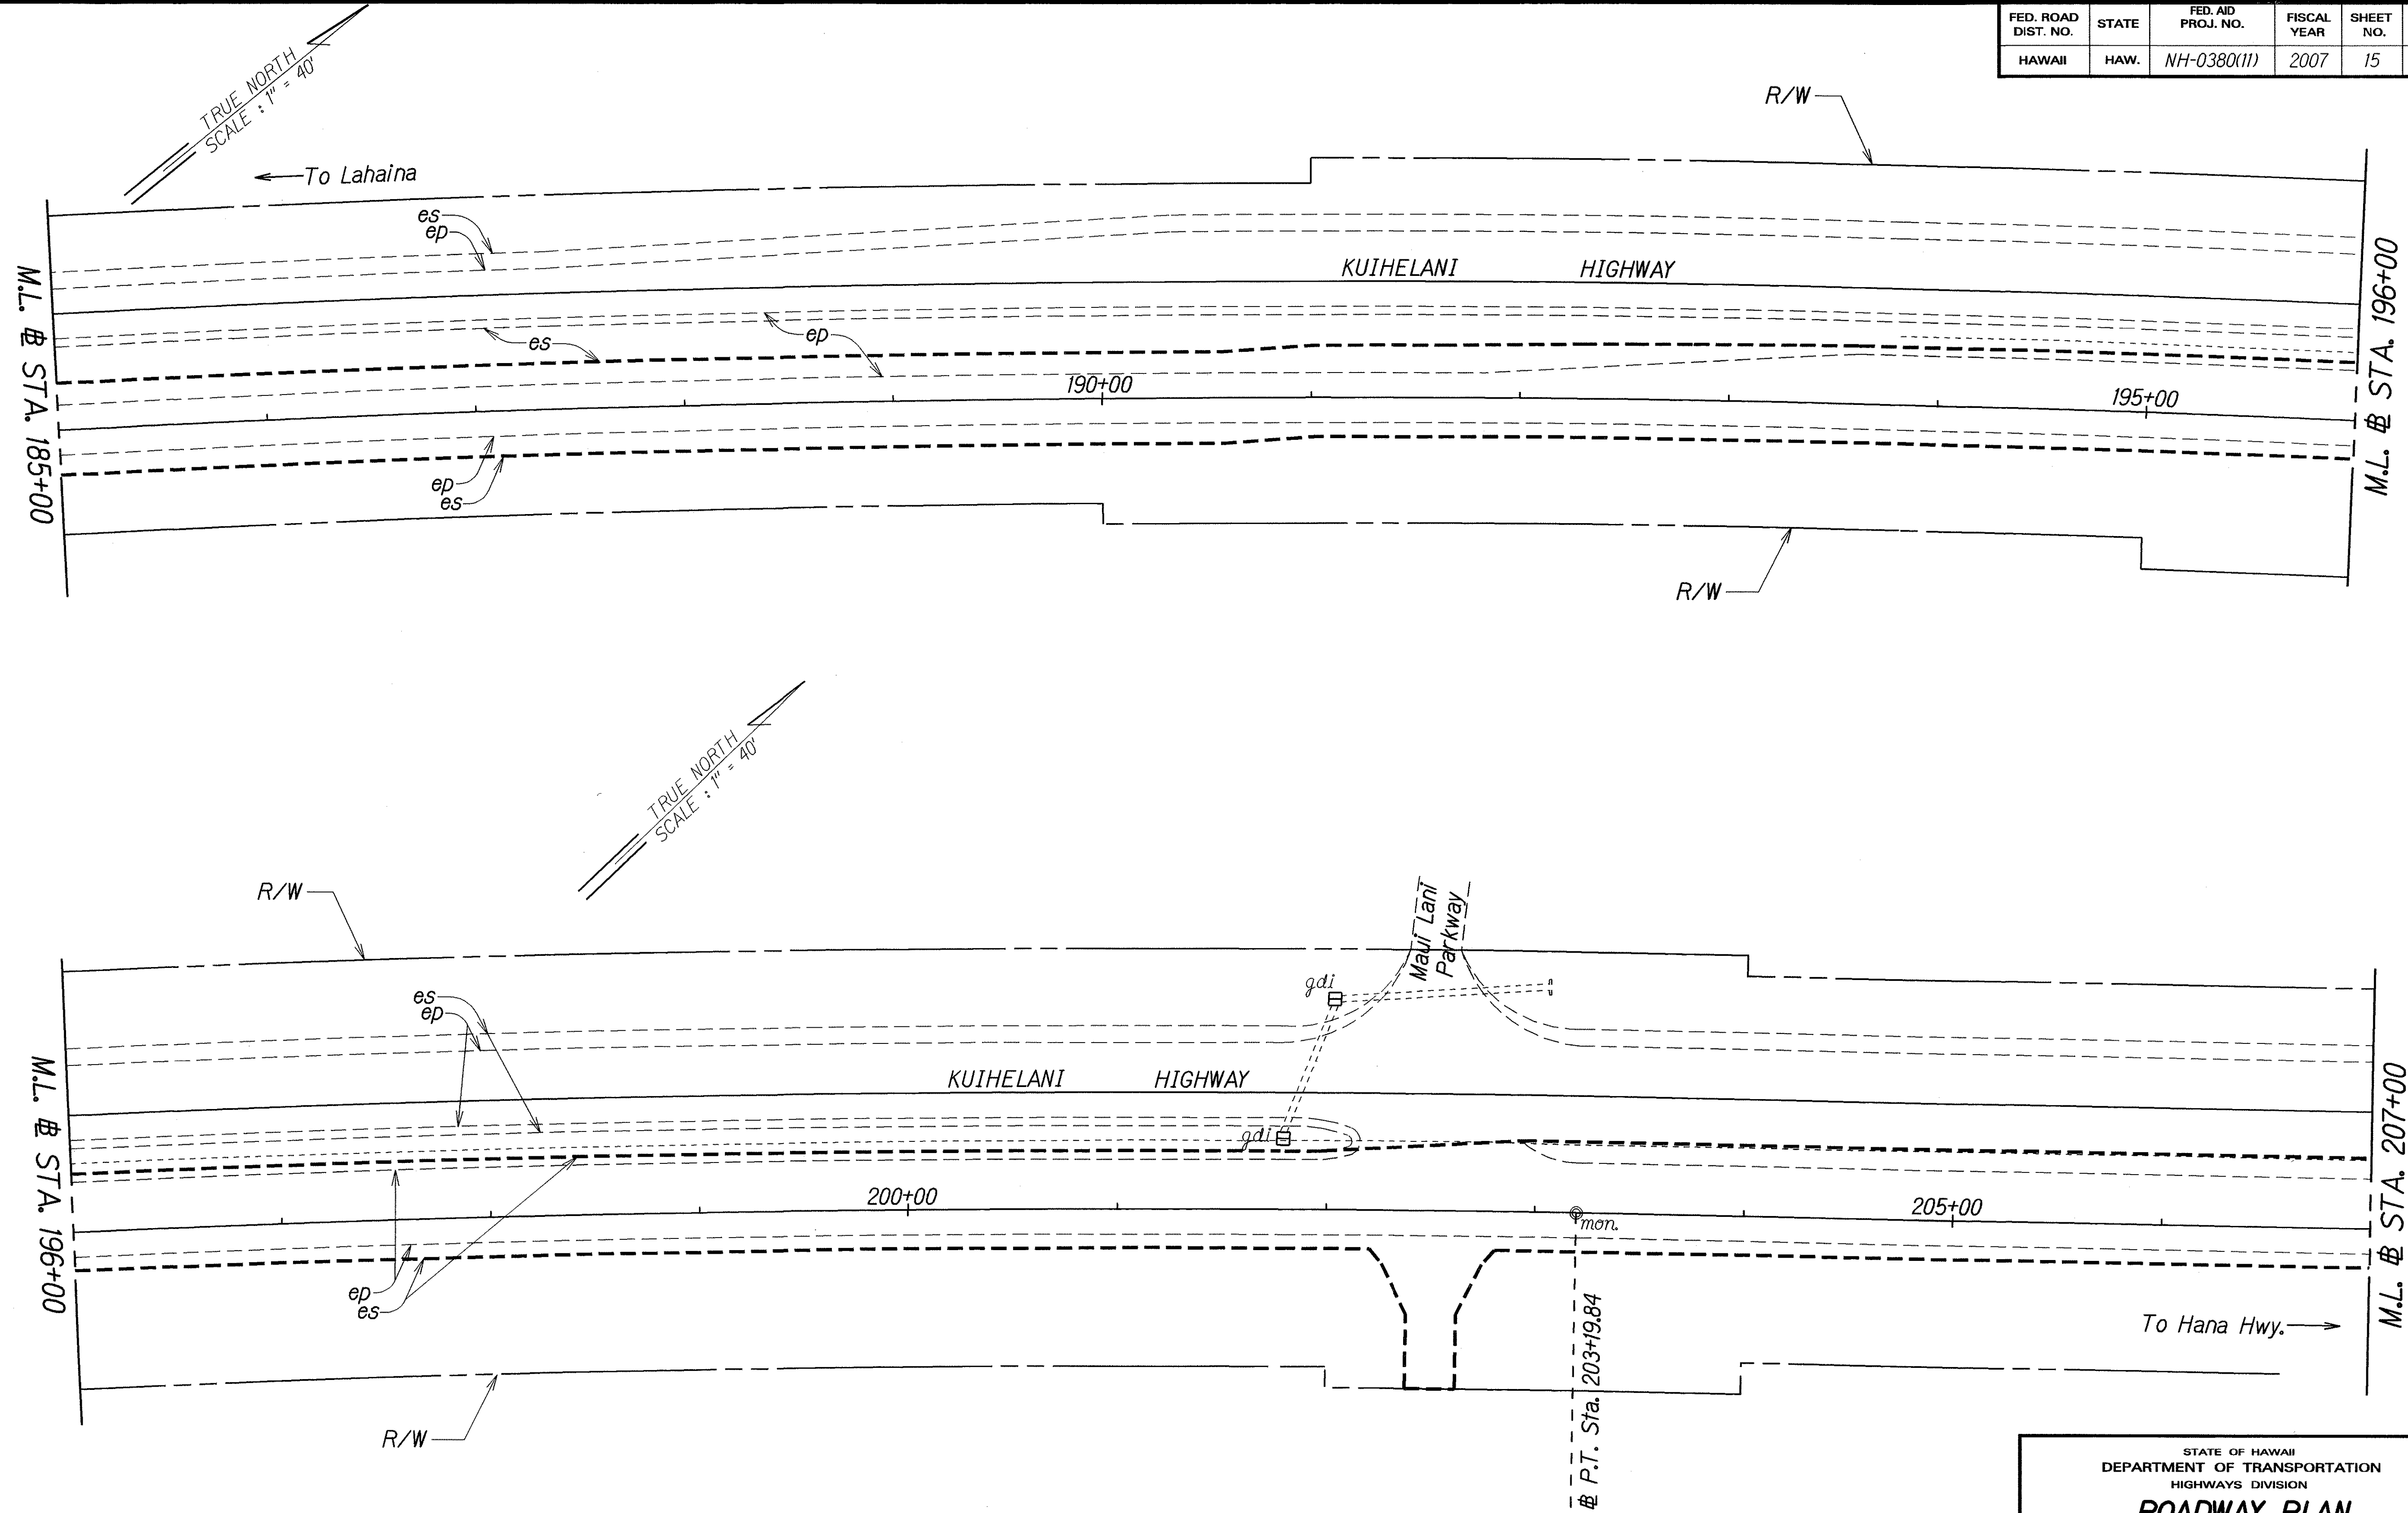

STATE OF HAWAII
DEPARTMENT OF TRANSPORTATION
HIGHWAYS DIVISION

ROADWAY PLAN

**KUIHELANI HIGHWAY PAVEMENT
PREVENTIVE MAINTENANCE**


Honoapiilani Highway to Puunene Avenue

Federal-Aid Project No. NH-0380(11)

Scale: 1" = 40' Date: August, 2007

ORIGINAL PLAN	SURVEY PLOTTED BY	DATE
NOTE BOOK	DRAWN BY	
	DESIGNED BY	
	CHECKED BY	

FED. ROAD DIST. NO.	STATE	FED. AID PROJ. NO.	FISCAL YEAR	SHEET NO.	TOTAL SHEETS
HAWAII	HAW.	NH-0380(11)	2007	16	33

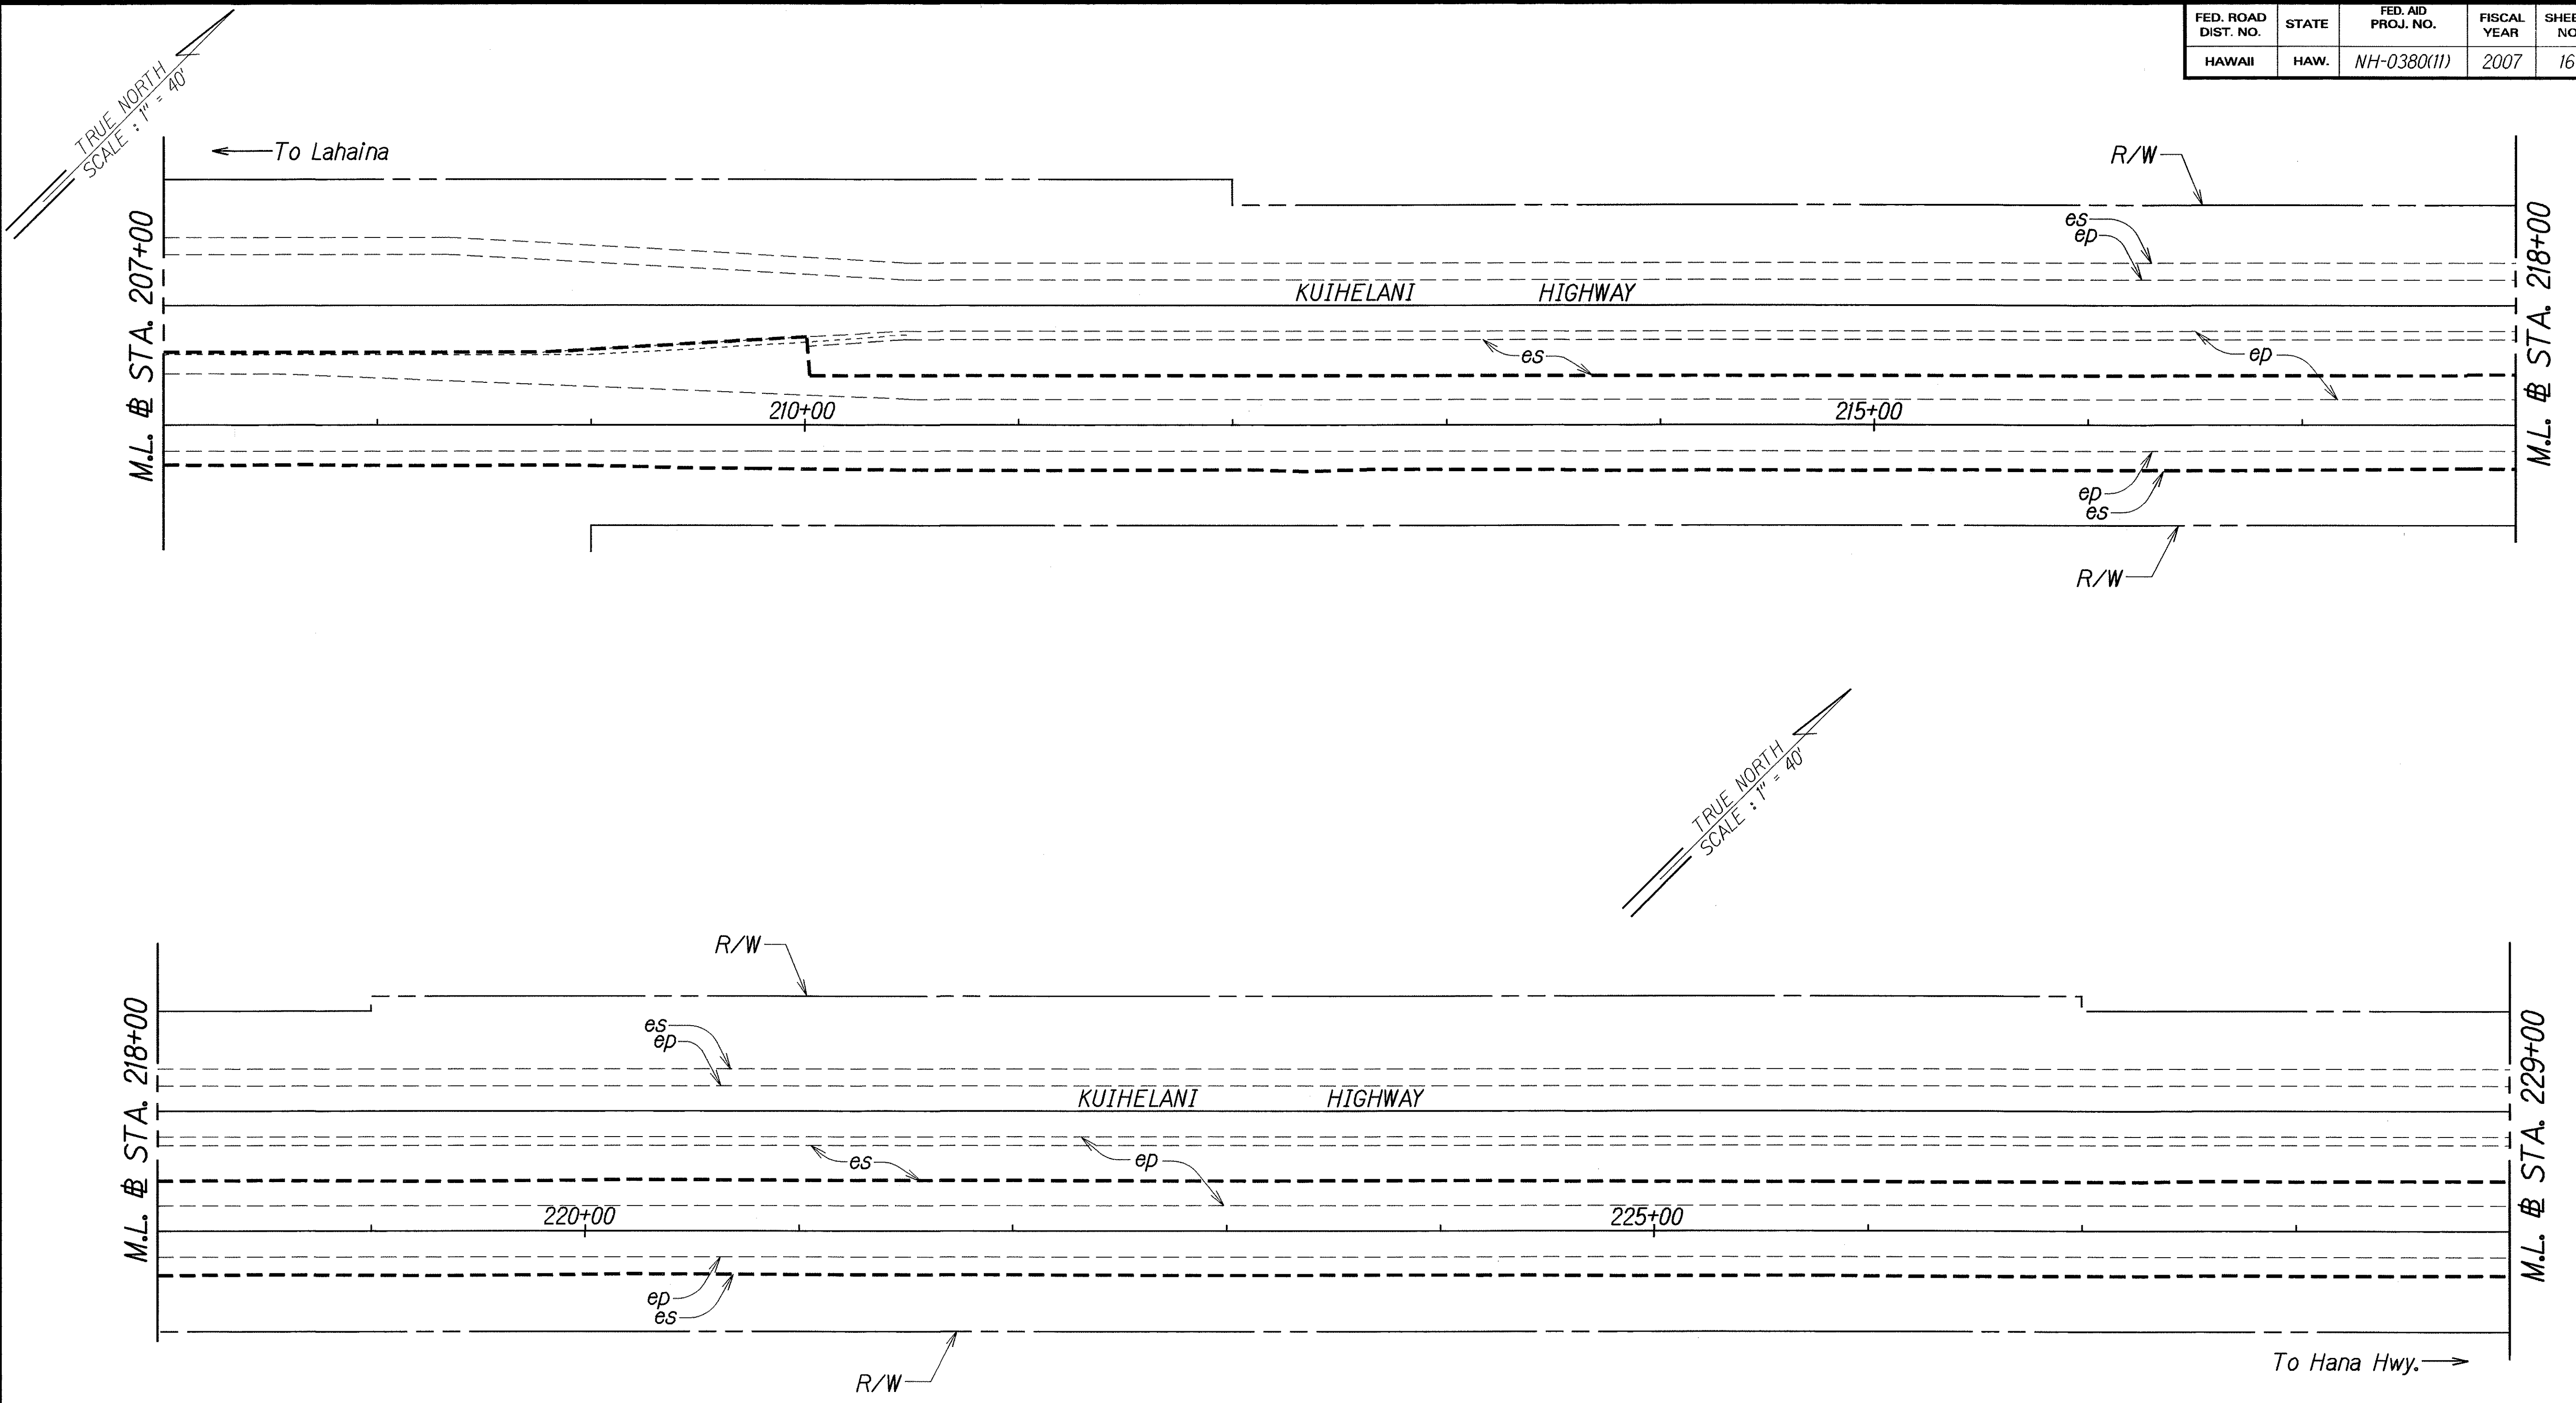

ORIGINAL PLAN	SURVEY PLOTTED BY	DATE
NOTE BOOK	DRAWN BY	
	RECHECKED BY	
	QUANTITIES BY	
	CHECKED BY	

STATE OF HAWAII
DEPARTMENT OF TRANSPORTATION
HIGHWAYS DIVISION

ROADWAY PLAN


**KUIHELANI HIGHWAY PAVEMENT
PREVENTIVE MAINTENANCE**

Honoapiilani Highway to Puunene Avenue

Federal-Aid Project No. NH-0380(11)

Scale: 1" = 40' Date: August, 2007

FED. ROAD DIST. NO.	STATE	FED. AID PROJ. NO.	FISCAL YEAR	SHEET NO.	TOTAL SHEETS
HAWAII	HAW.	NH-0380(11)	2007	17	33

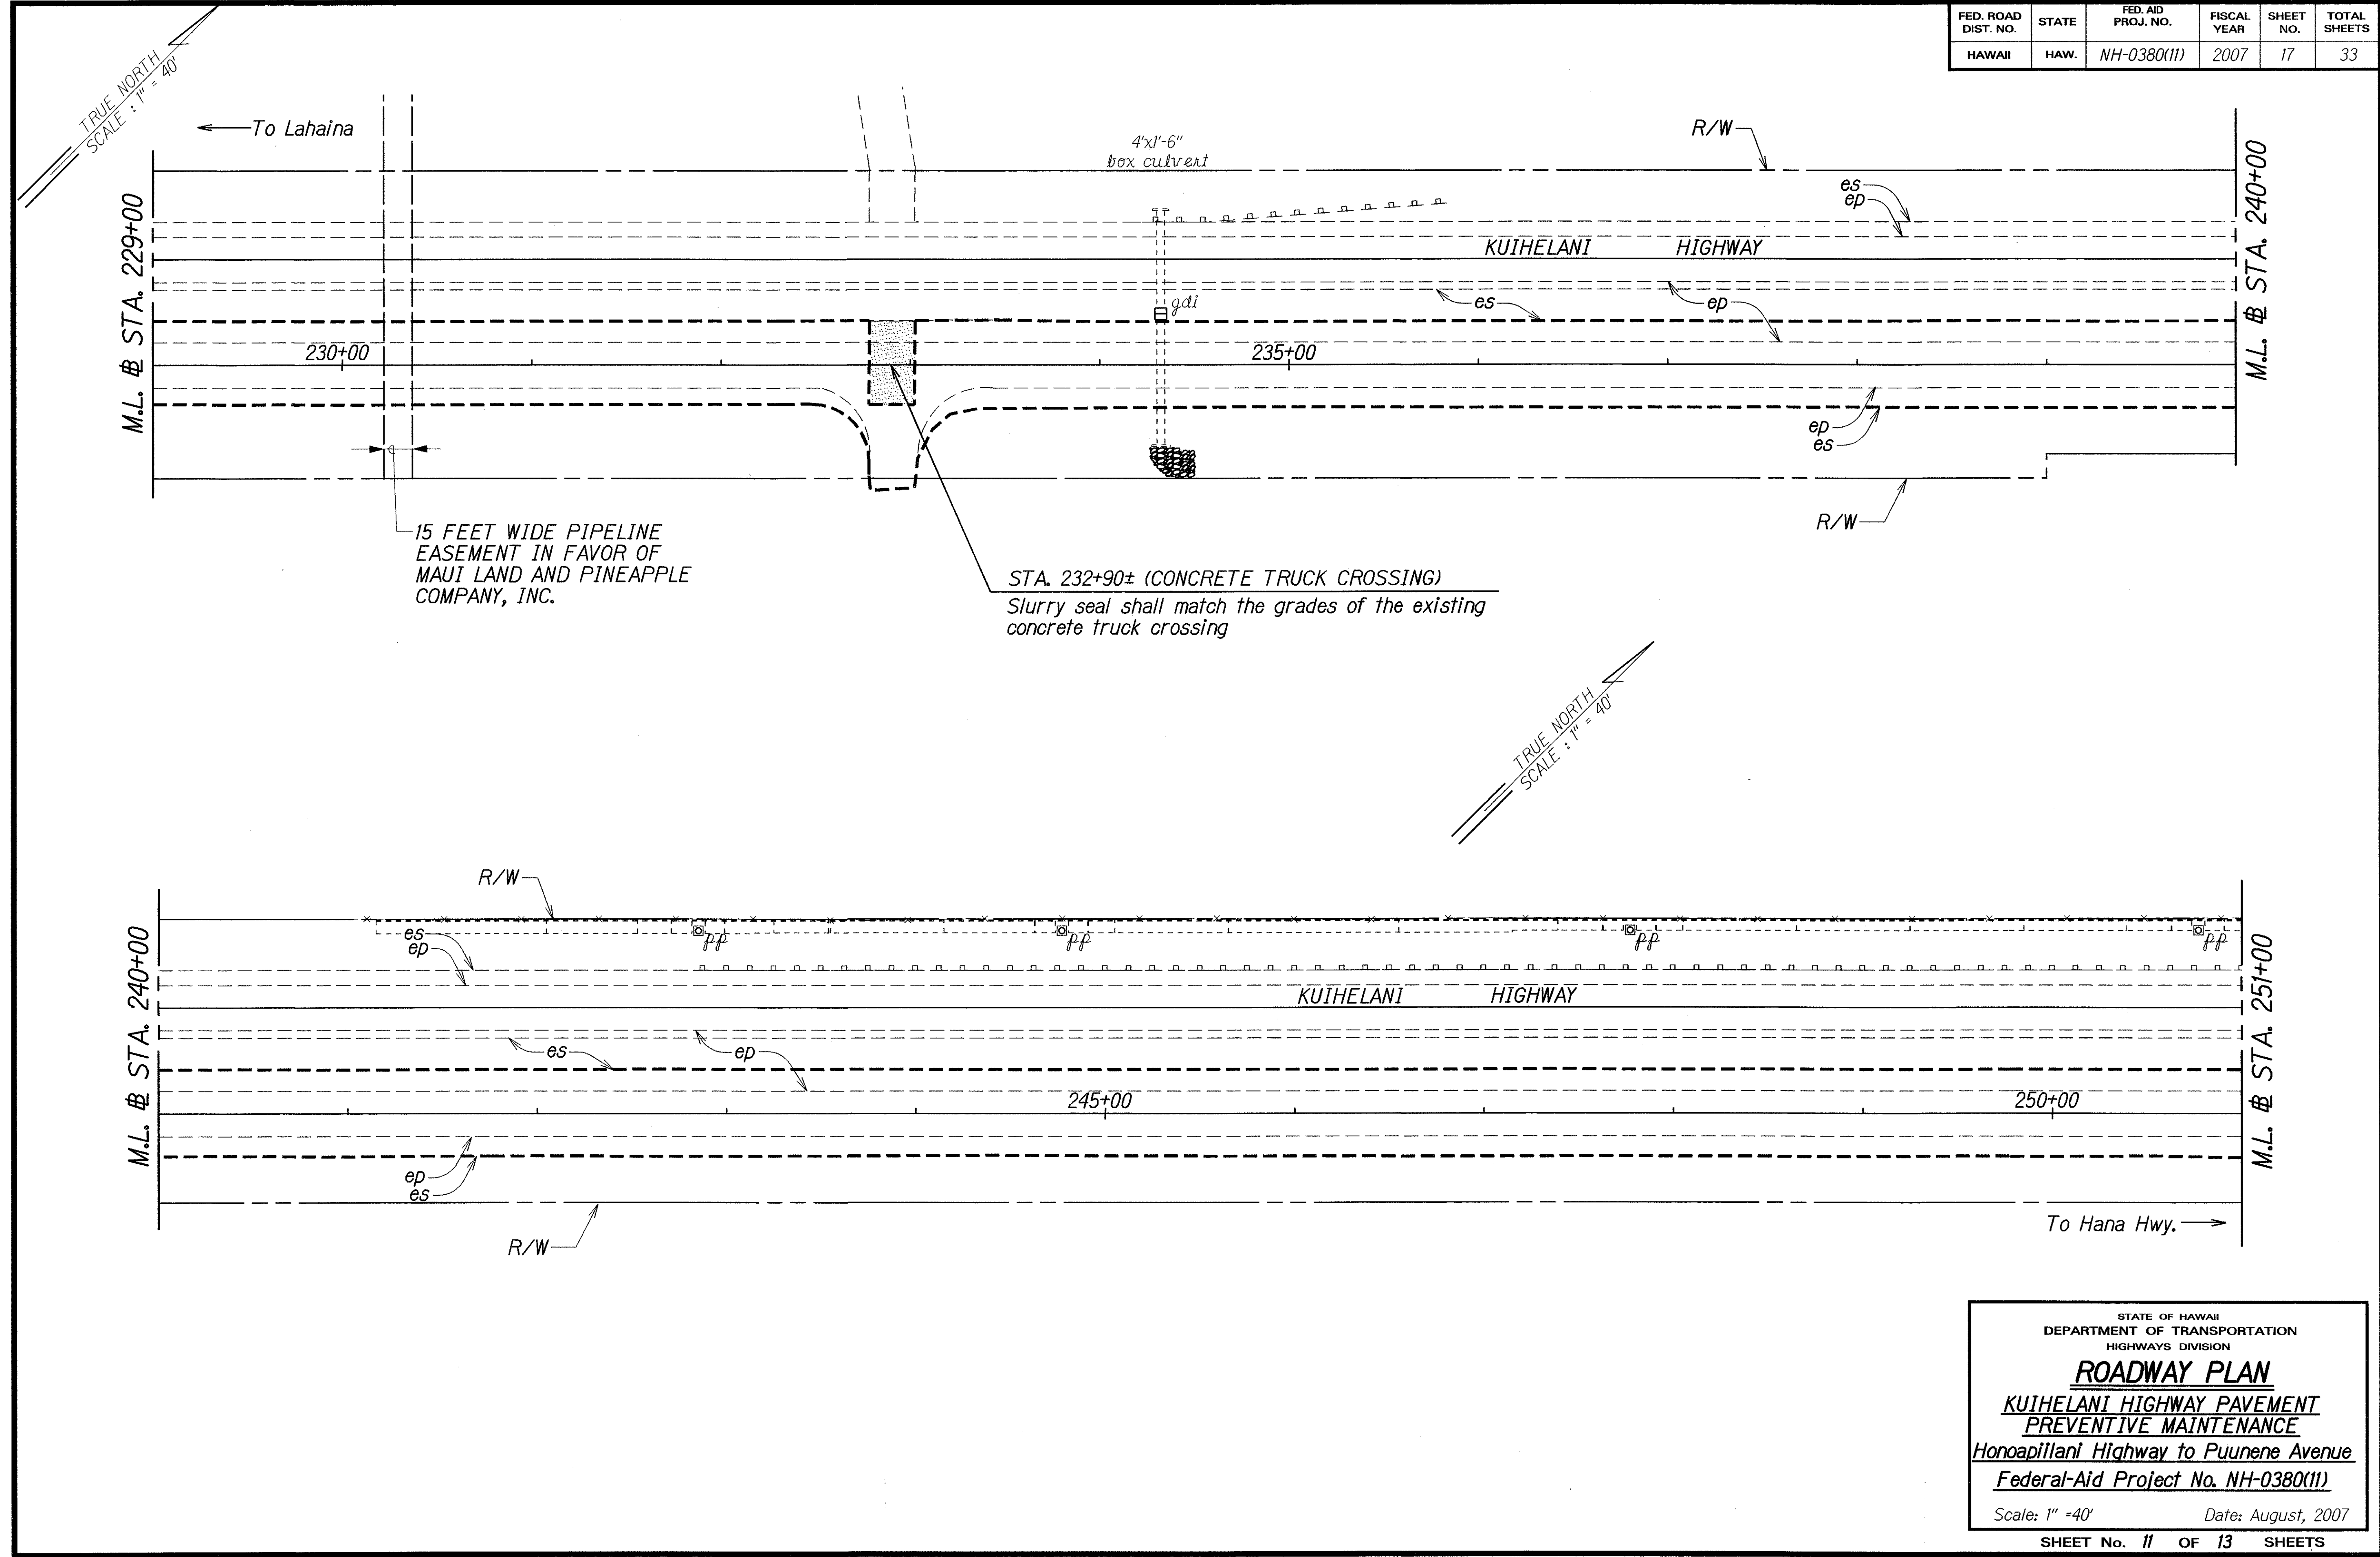

ORIGINAL PLAN	SURVEY PLOTTED BY	DATE
NOTE BOOK	DRAWN BY	
	TRACED BY	
	QUANTITIES BY	
	CHECKED BY	


STATE OF HAWAII
DEPARTMENT OF TRANSPORTATION
HIGHWAYS DIVISION

ROADWAY PLAN
KUIHELANI HIGHWAY PAVEMENT PREVENTIVE MAINTENANCE
Honoapiilani Highway to Puunene Avenue
Federal-Aid Project No. NH-0380(11)


Scale: 1" = 40' Date: August, 2007

SHEET No. 17 OF 13 SHEETS

FED. ROAD DIST. NO.	STATE	FED. AID PROJ. NO.	FISCAL YEAR	SHEET NO.	TOTAL SHEETS
HAWAII	HAW.	NH-0380(11)	2007	18	33

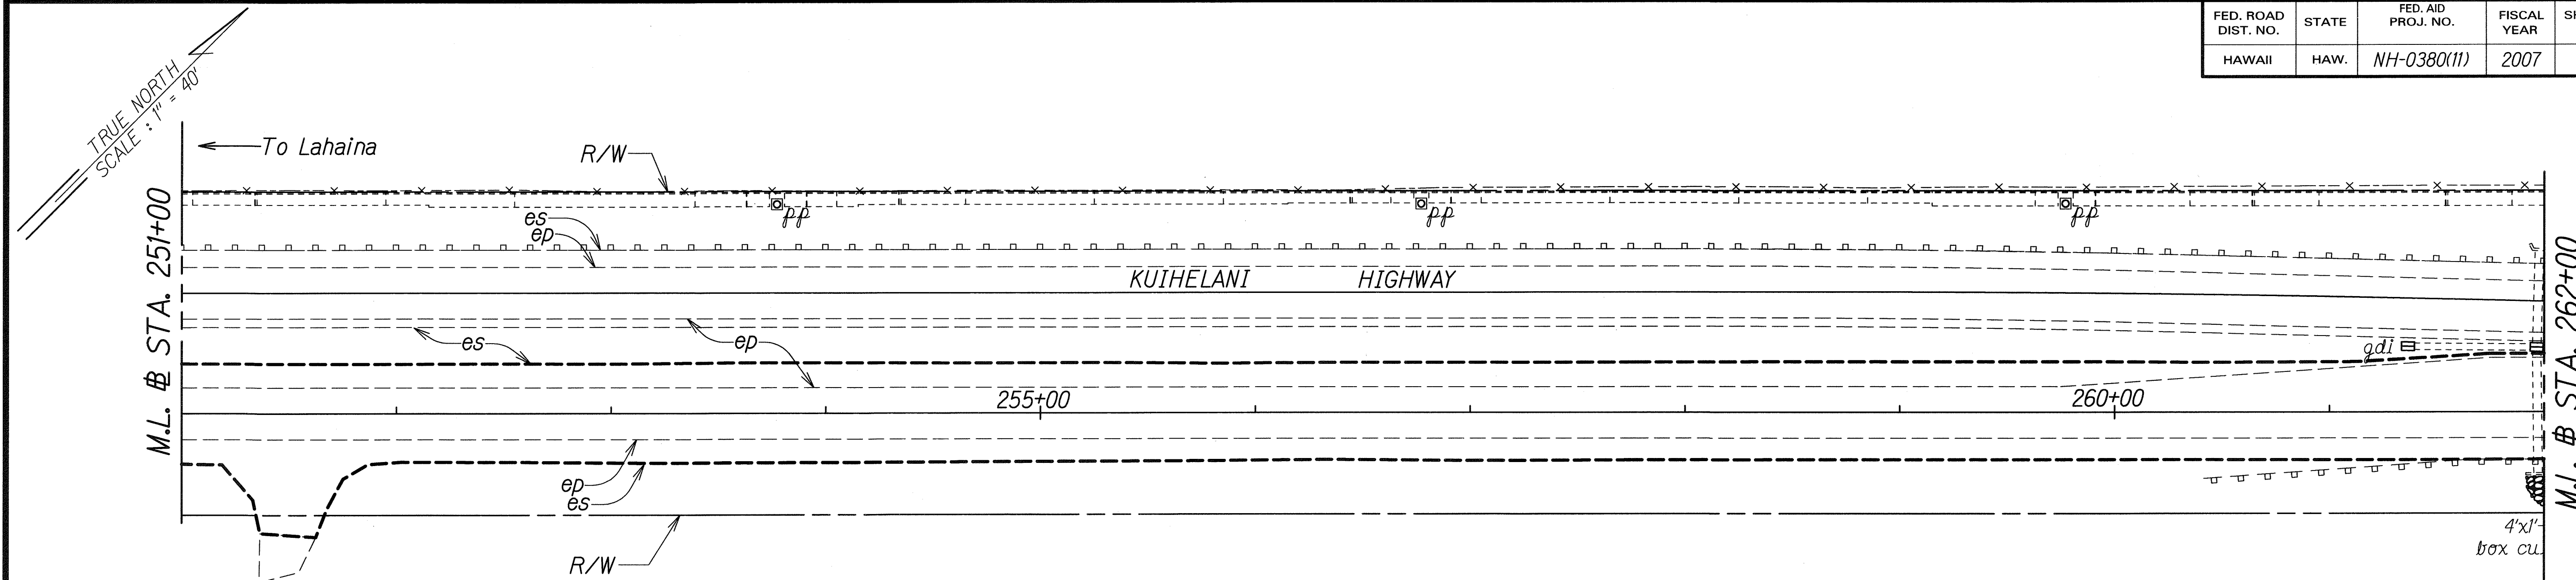

STA. 262+05± LT. To STA 271+30± LT.
 Delete Slurry Seal Work on this Area (Outbound Lane Only)

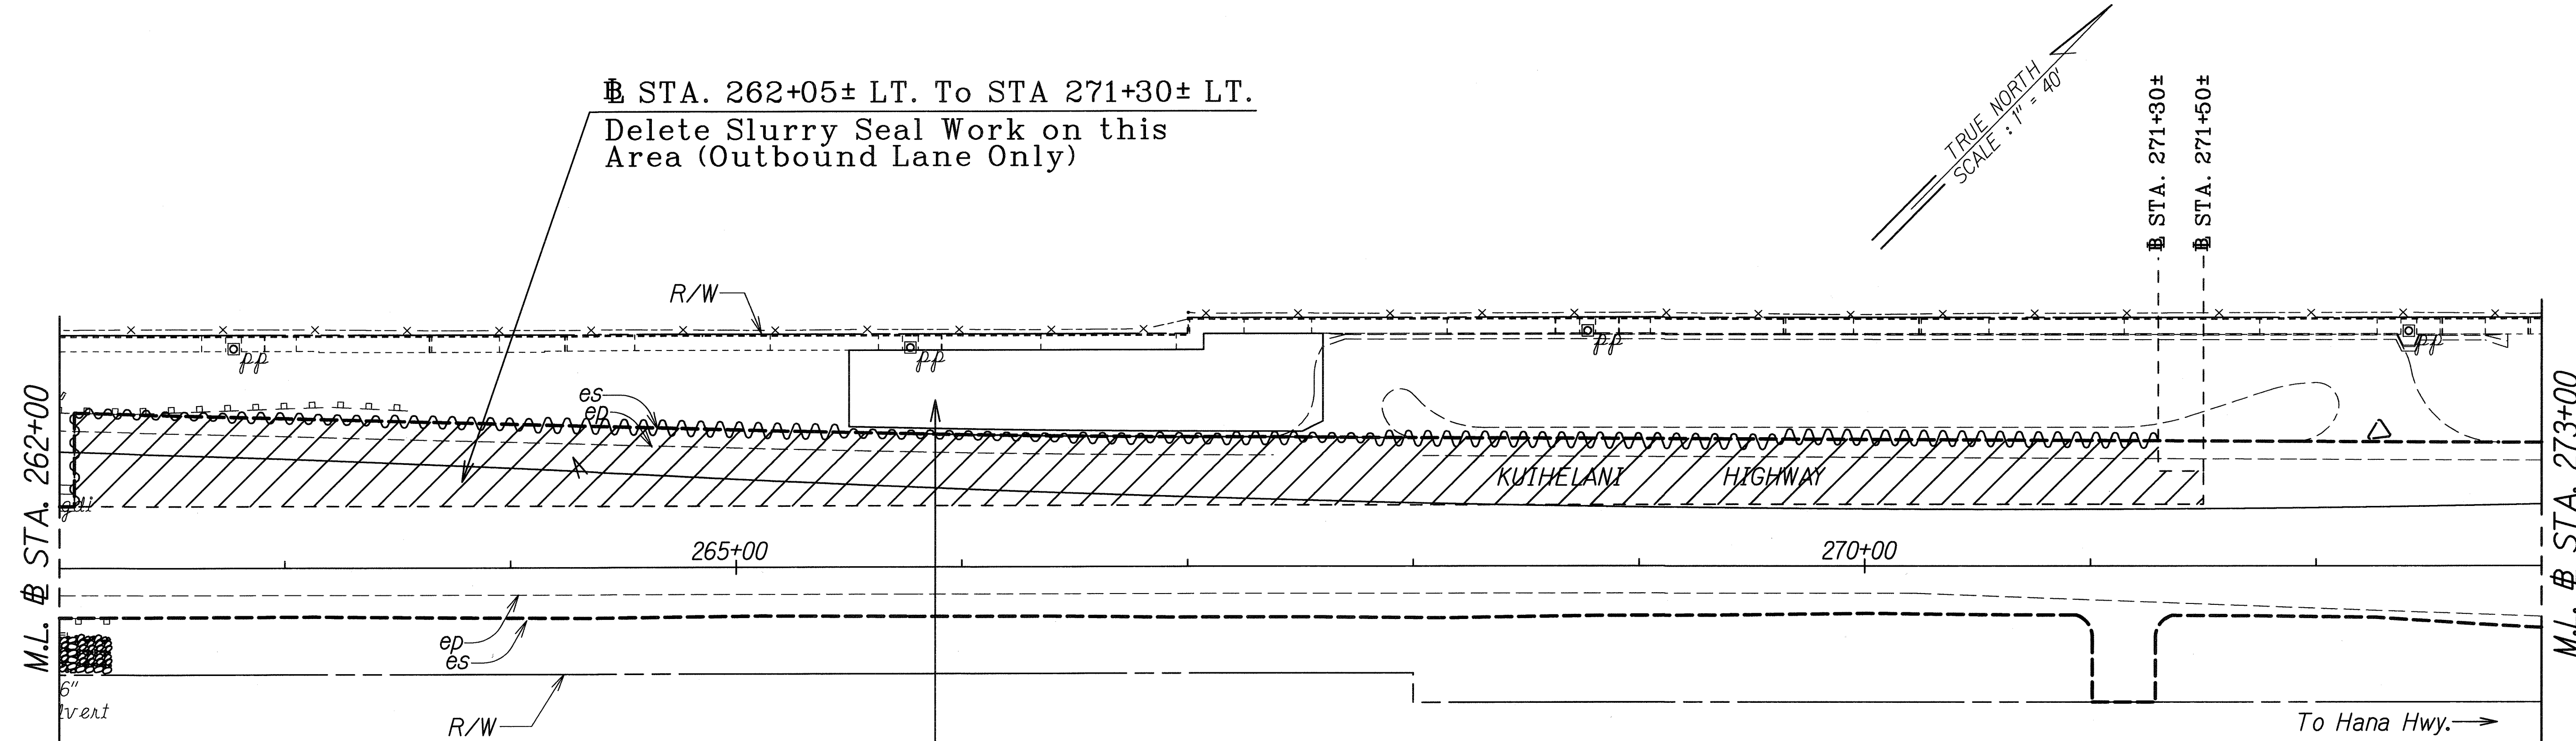

STA. 265+50± To STA. 267+60±
 Construct Additional Park and Ride
 See Detail on Sheet No. 19



ORIGINAL PLAN	SURVEY PLOTTED BY	DATE
NOTE BOOK	DRAWN BY	
	TRACED BY	
	QUANTITIES BY	
	CHECKED BY	

LEGEND FOR AS-BUILT POSTINGS	
	Squiggly line for as-built deletion
	Double line for as-built deletion
Roadway	Text for as-built posting

STATE OF HAWAII
 DEPARTMENT OF TRANSPORTATION
 HIGHWAYS DIVISION
ROADWAY PLAN
 KUIHELANI HIGHWAY PAVEMENT
 PREVENTIVE MAINTENANCE
 Honoapiilani Highway to Puunene Avenue
 Federal-Aid Project No. NH-0380(11)
 Scale: 1" = 40' Date: August, 2007

SHEET No. 12 OF 13 SHEETS

FED. ROAD DIST. NO.	STATE	FED. AID PROJ. NO.	FISCAL YEAR	SHEET NO.	TOTAL SHEETS
HAWAII	HAW.	X	2007	19	33

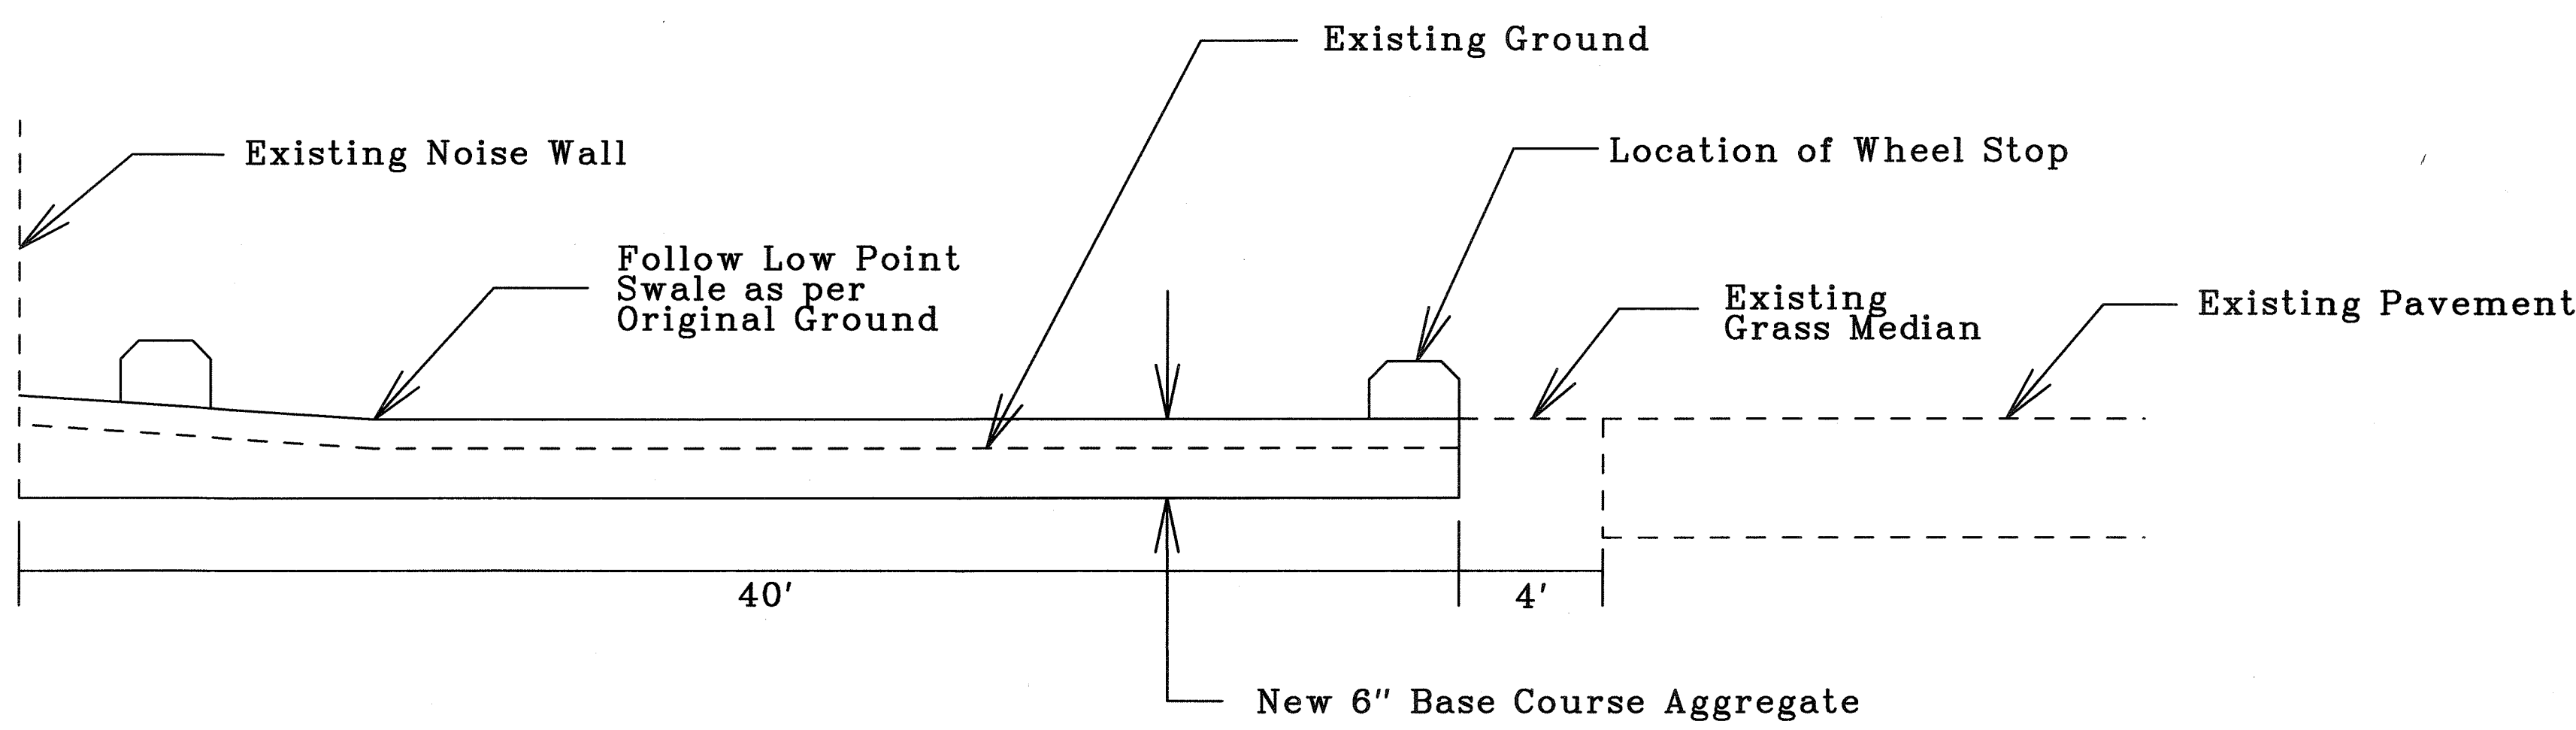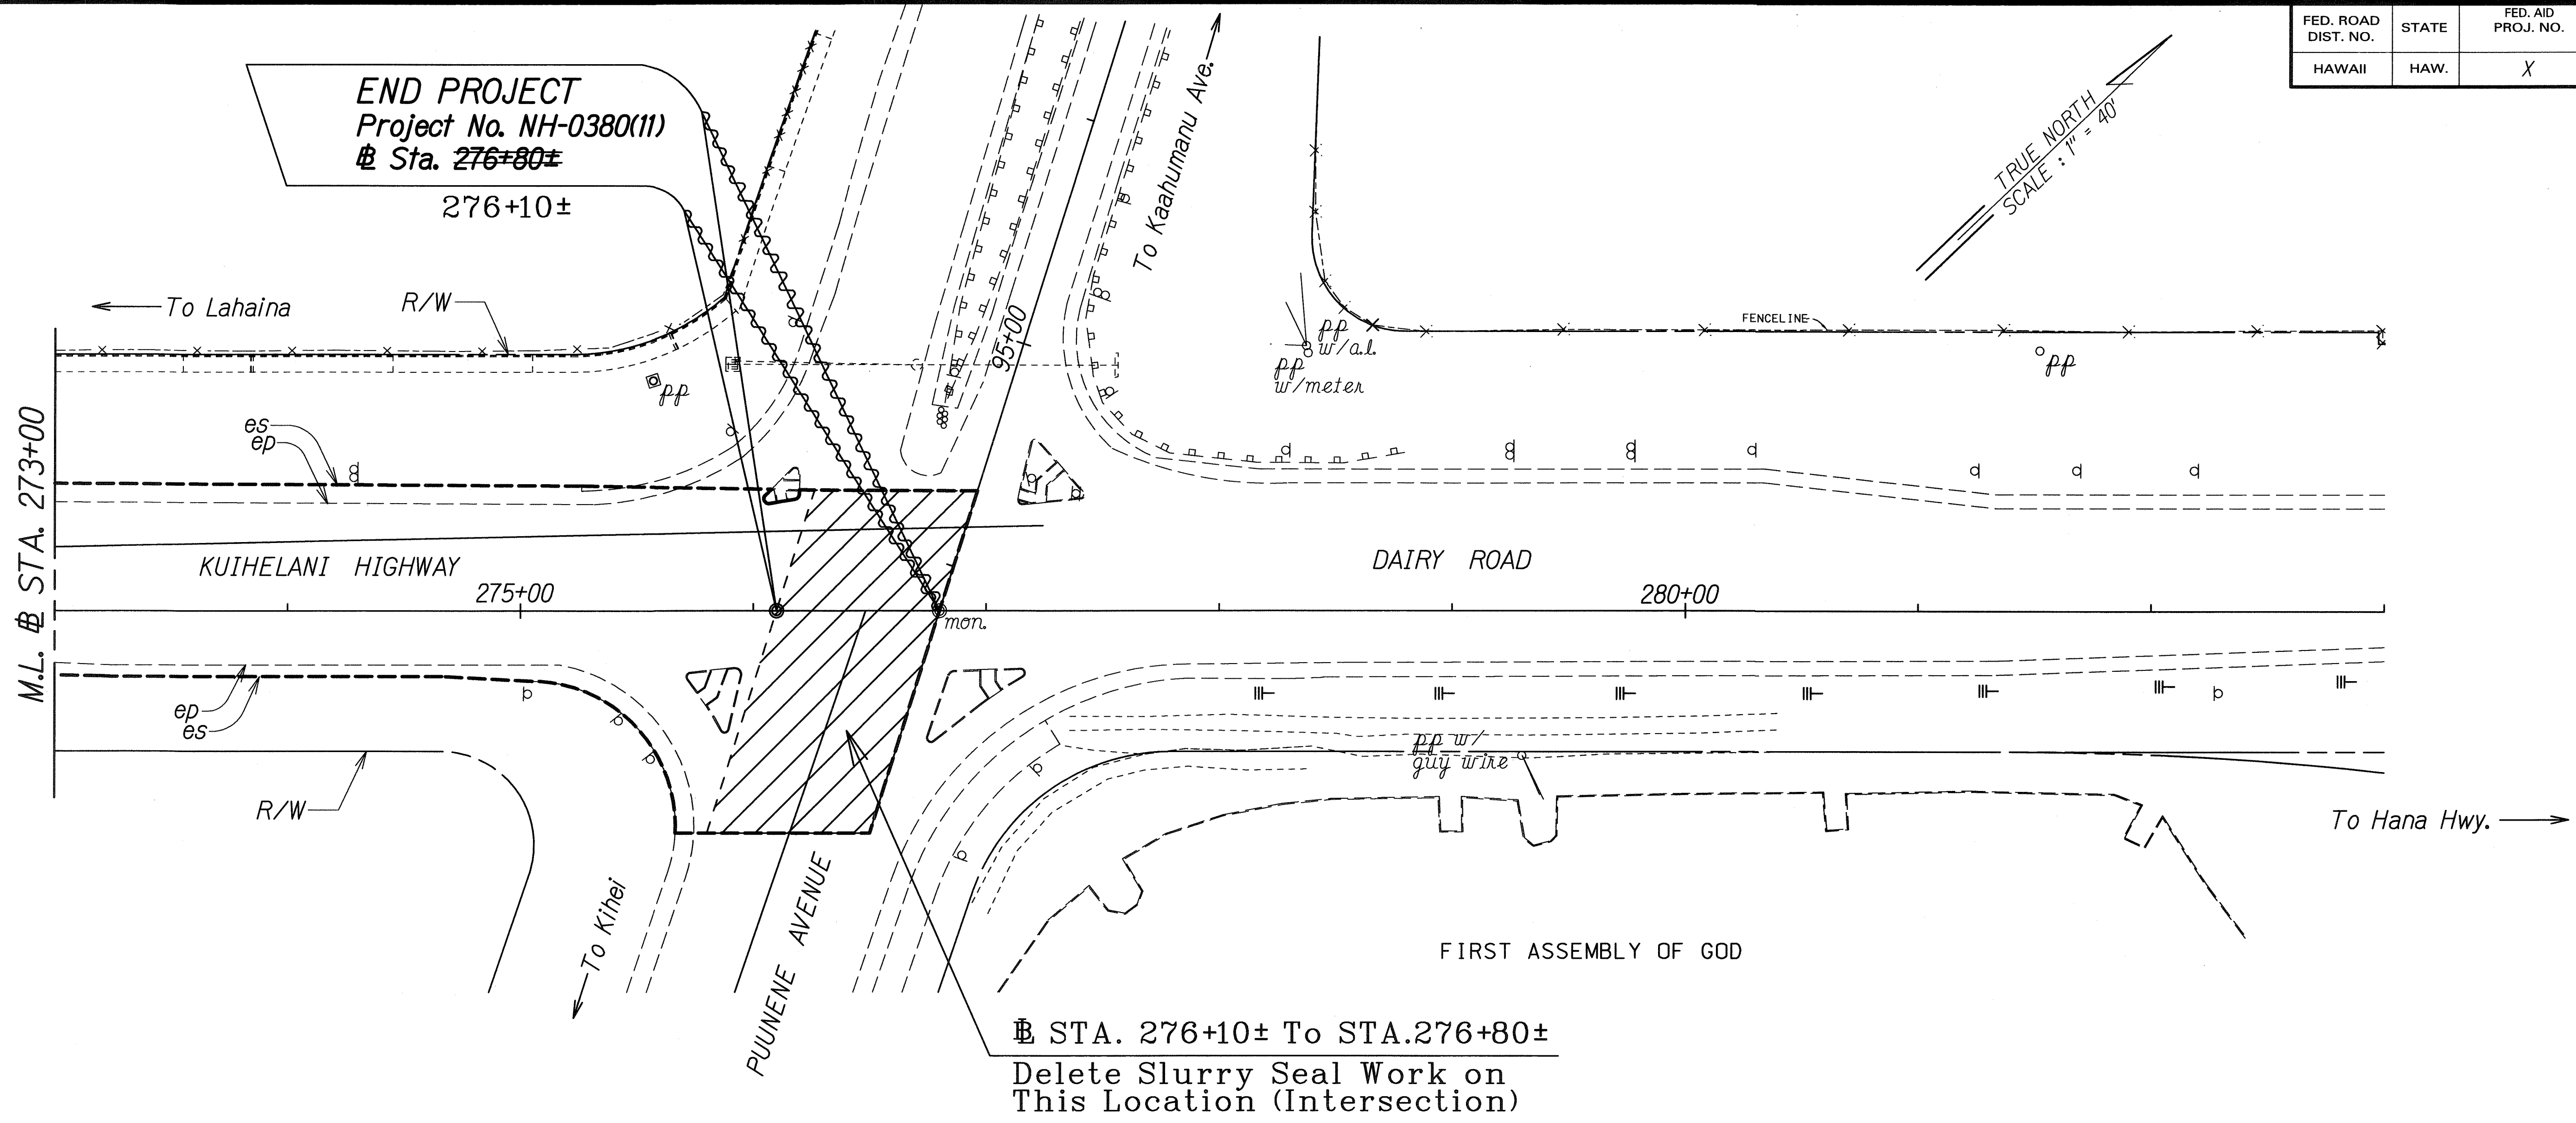

NTS: Section A-A

LEGEND FOR AS-BUILT POSTINGS	
	Squiggly line for as-built deletion
	Double line for as-built deletion
Roadway	Text for as-built posting

STATE OF HAWAII
DEPARTMENT OF TRANSPORTATION
HIGHWAYS DIVISION

ROADWAY PLAN
KUIHELANI HIGHWAY PAVEMENT PREVENTIVE MAINTENANCE
Honoapiilani Highway to Puunene Avenue
Federal-Aid Project No. NH-0380(11)

Scale: 1" = 40'
Date: August, 2007

SHEET No. 13 OF 13 SHEETS

"AS-BUILT"